

Township T. 14 N. of the Base line Range R. 13 W. of the 2d Principal Meridian

page 61 vol 6




aggregate area - 22542.09 acres

Pursuant to a contract with and instructions from William Vector, Surveyor of the land of the United States for the States of Illinois - Missouri, and Territory of Arkansas bearing date the 1st day of April 1871 I have Adamsoned and surveyed the above described Township and do hereby certify that it has such marks and bounds both natural and as are represented on said plat and described in the field notes made thereof and returned into the Office of Surveyor of the land of the United States for the States of Illinois - Missouri and Territory of Arkansas

Burlington 18th July 1871

John P. Jones Surveyor


Township N. 15 North of the Base line Range N. 13 West of the 2nd Meridian

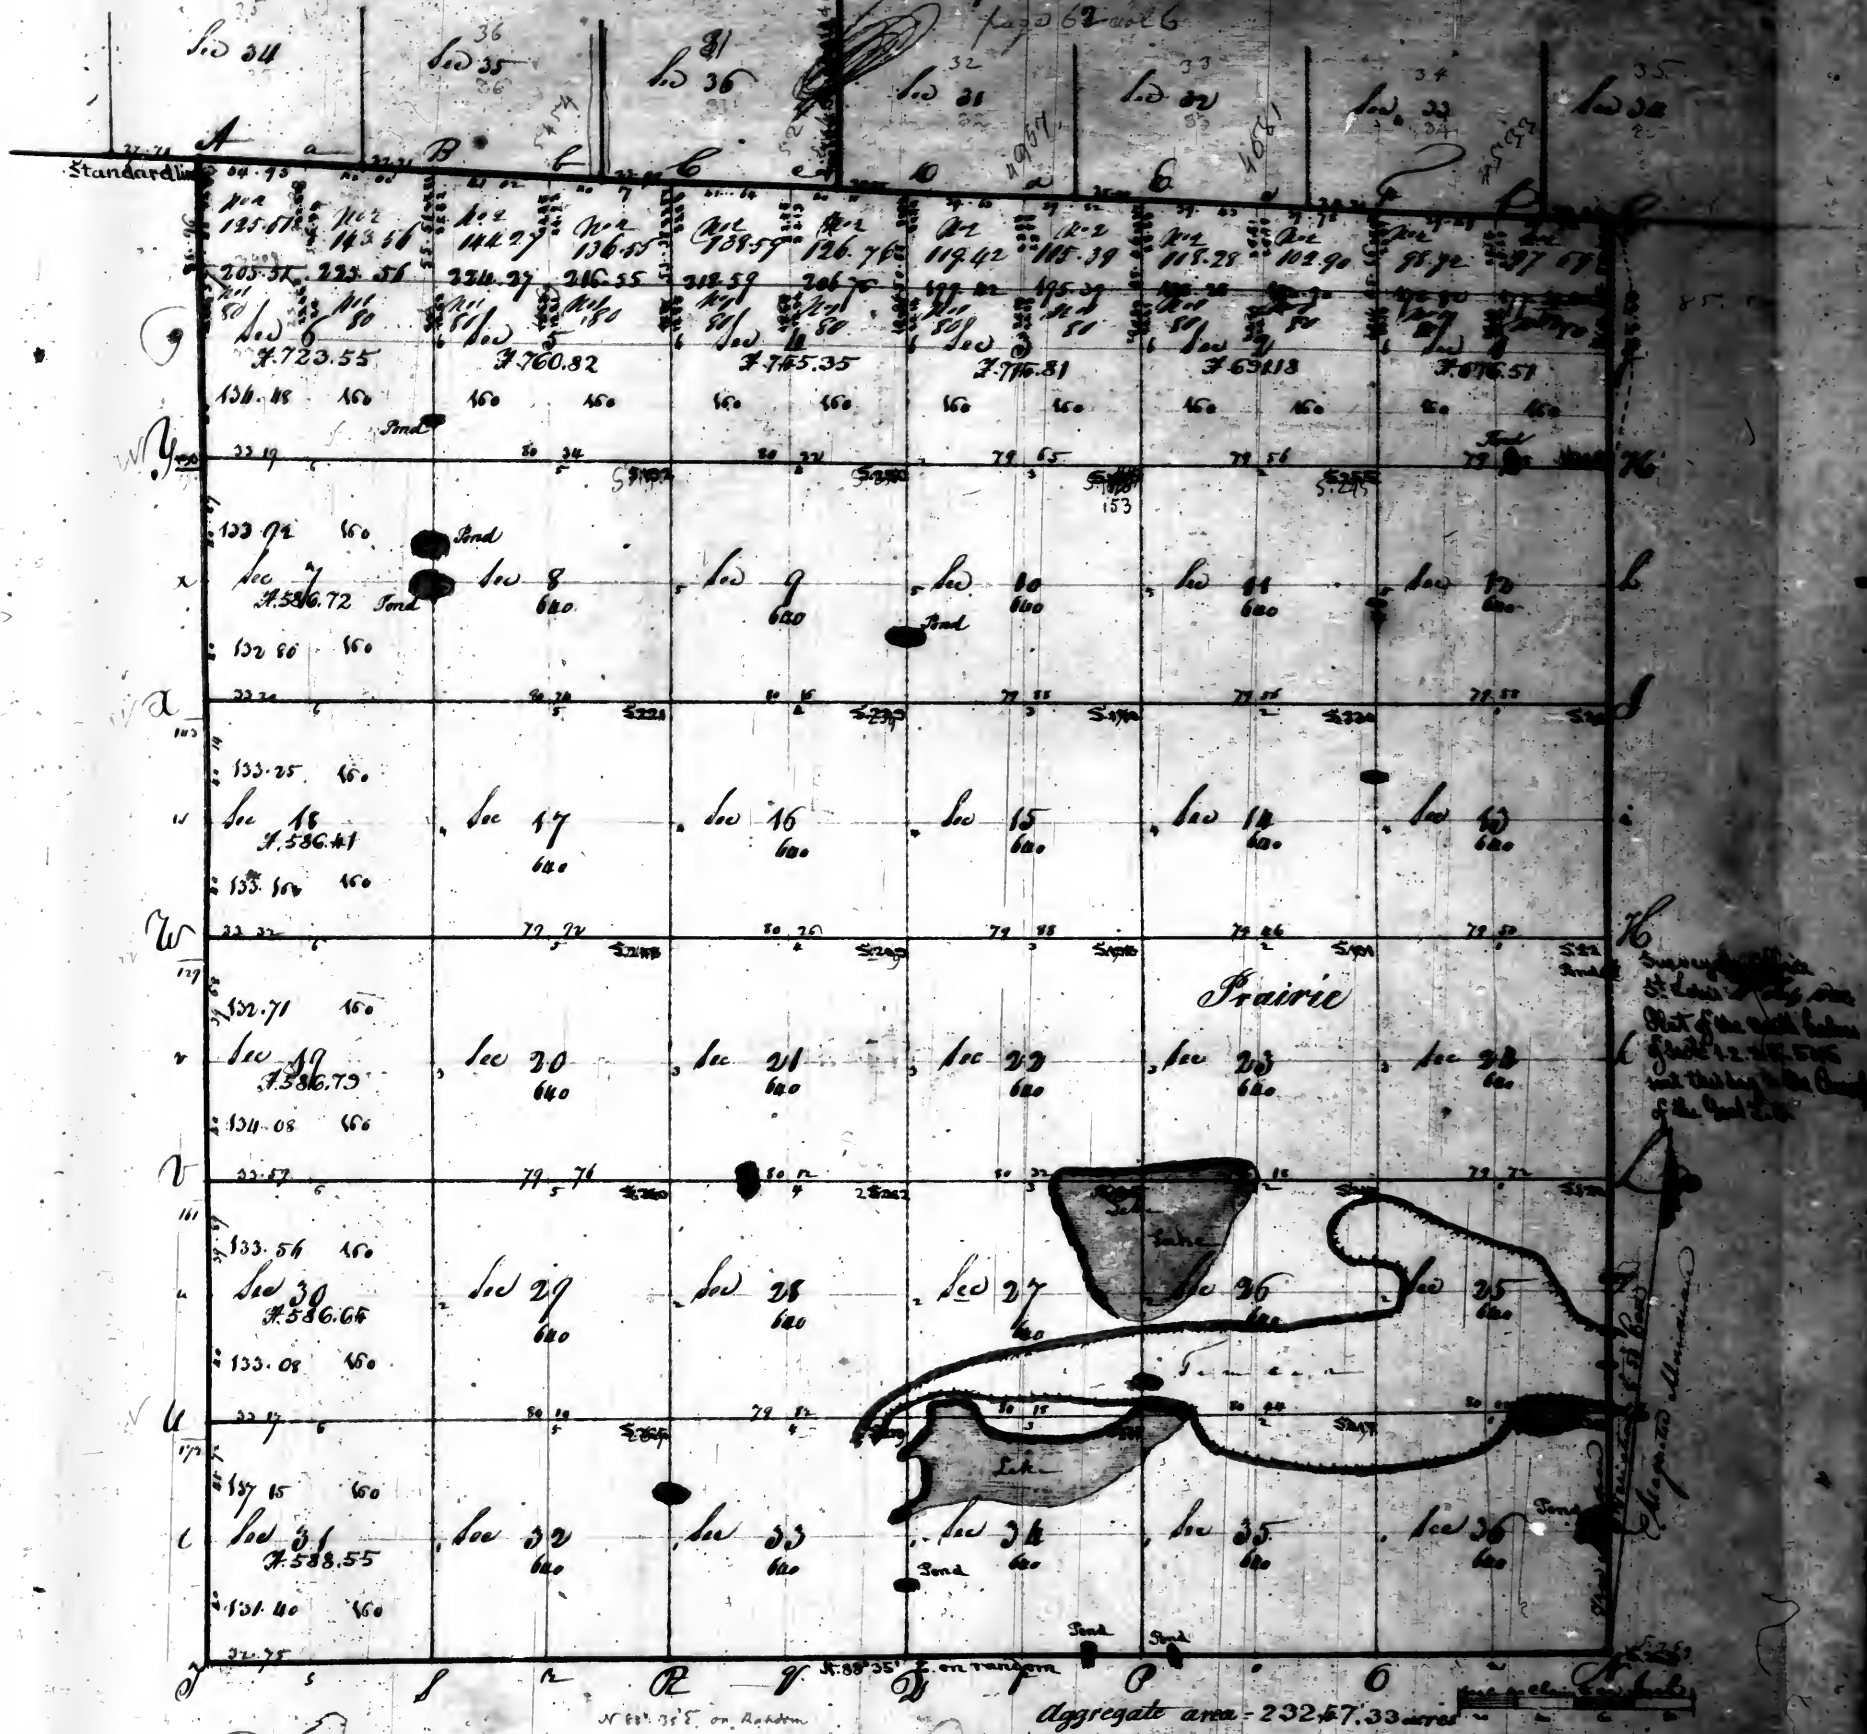

Pursuant to a contract with and instruction from William H. C. Surveyor of the lands of the United States for the States of Illinois, Missouri and Territory of Arkansas bearing date the 4th day of April 1820. I have examined the above described Township of land and do hereby certify that it has been surveyed and bounded both Natural and Artificial as are represented on said plot and described in the field notes and returned with this plot into the Office of the Surveyor of the lands of the United States for the States of Illinois, Missouri and Territory of Arkansas

Witnessed 16th July 1820

Schmidt

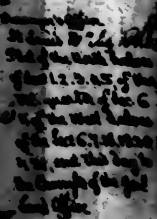




Surgeon's Office
 St. Louis 10 Sept. 1864
 Place of the fort 12. 24
 N.E. of the N.E. corner of Sec 6
 end of the West halves of
 Sec 6. 7. 18. 19. 30 & 31.
 west their bay to the Can.
 suspicious of the Genl. 10

Pursuant to a contract with and Instructions from William Rector Surveyor of the lands of the United States in the State of Illinois and Missouri and Territory of Arkansas bearing date the 19th day of March 1821. I have examined, laid out and surveyed the above described Township and do hereby certify that it has such marks and boundaries both natural and artificial as are represented on said plat and described in the preceding plat made thereof and returned with this plat into the office of the Surveyor of the lands of the United States for the State of Illinois and Missouri and Territory of Arkansas.


Certified this 5th day of July 1821.

Brice Greenup Depy Surveyor


Township No. 14 North of The Base Line Range No. 13 West of the 2^d Meridian

page 65 vol 6

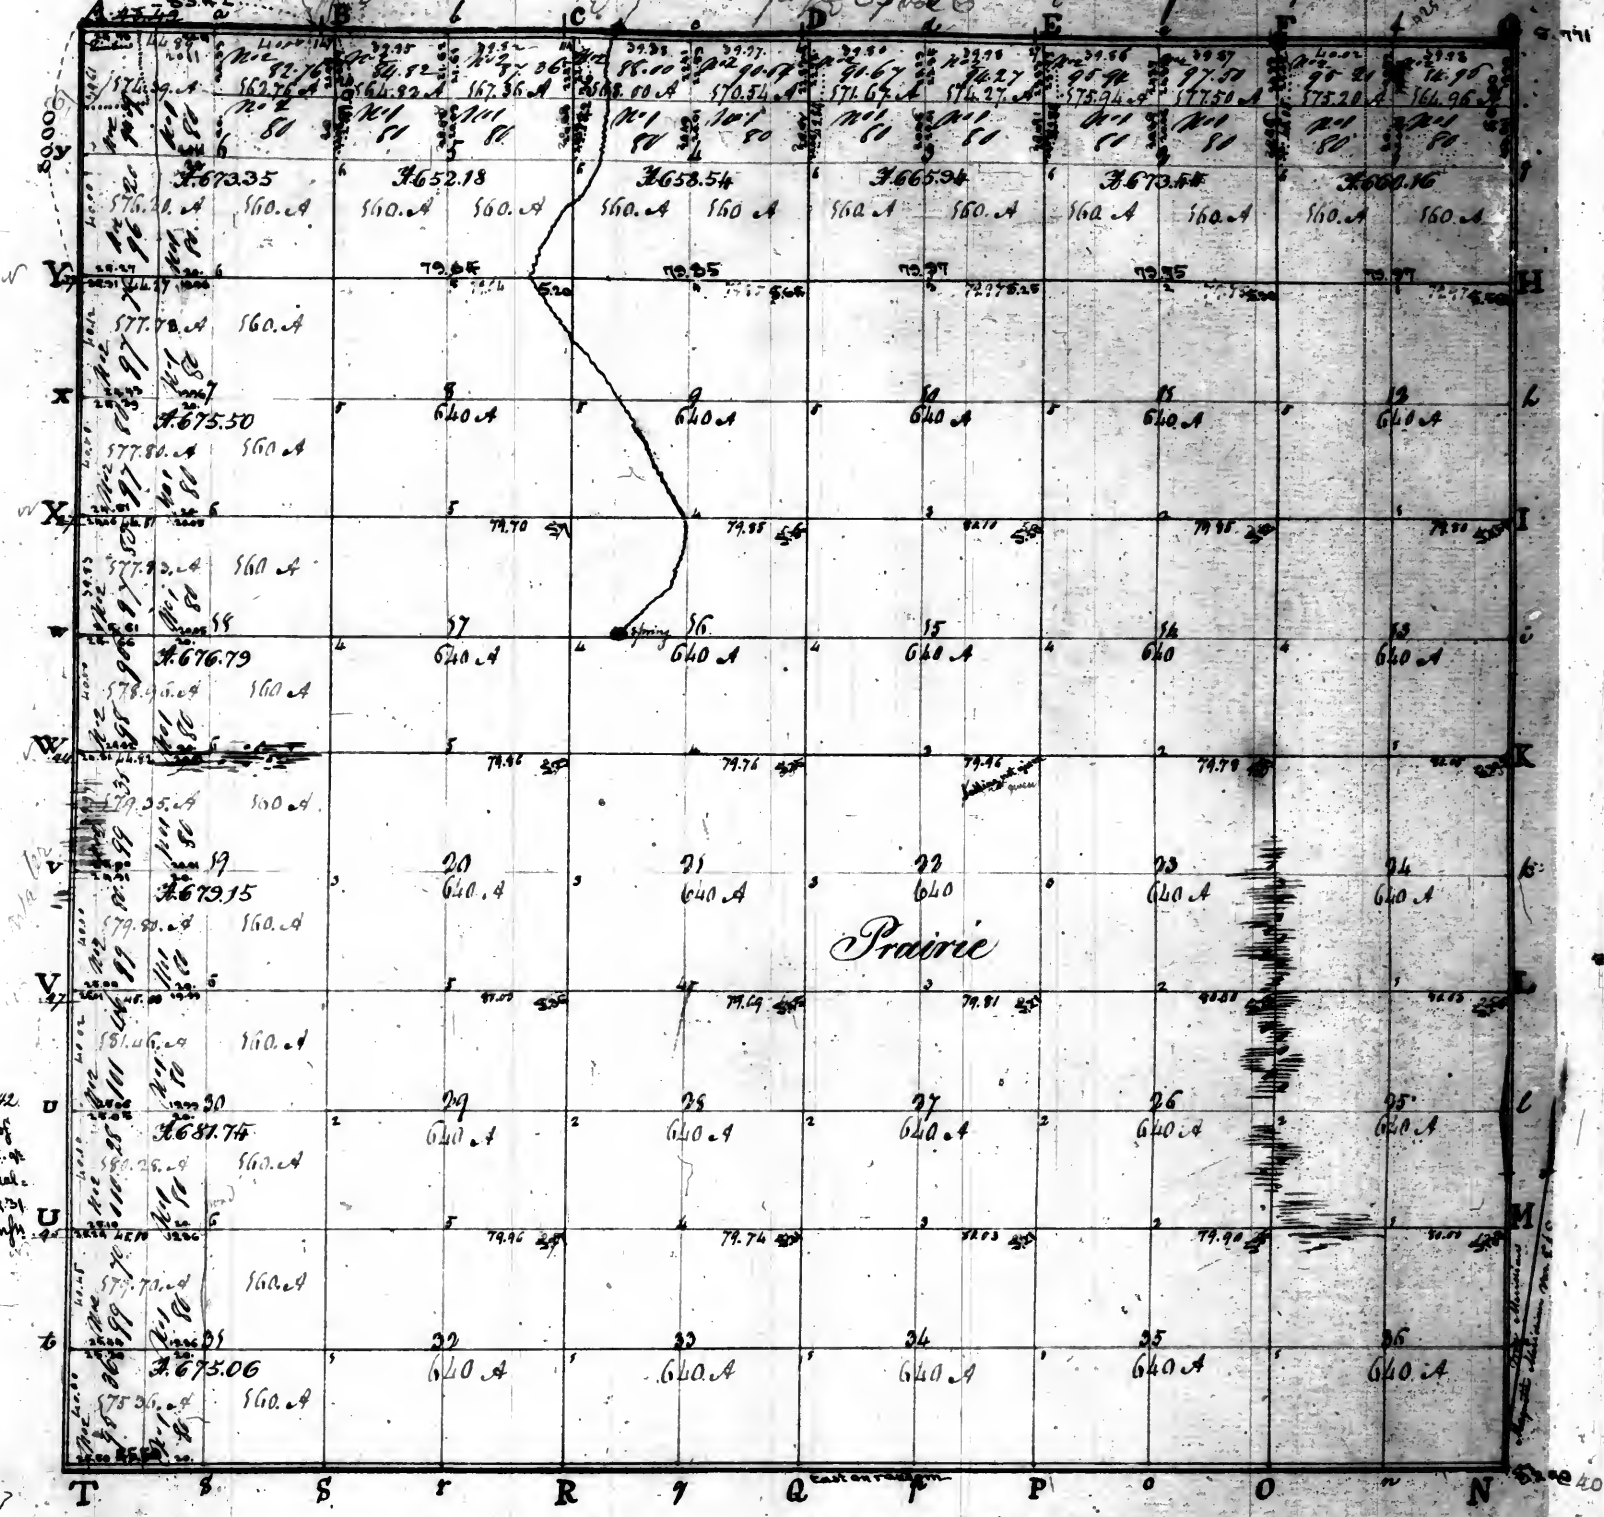

Surveyor's Office
St. Louis 10th Sept. 1842.
Plat of the North halves of
Secs 1, 2, 3 & 4, 5, of the N.E. 1/4
of Sec. 6, and of the West hal-
ves of Secs 6, 7, 18, 19, 30 & 31
sent this day to the Comm^r
of the Genl. L. O.

Aggregate area = 23371.85 acres


Scale of 40 chains to an inch

Pursuant to a contract with, and Instructions from William Butler Surveyor of the lands of the United States for the States of Illinois & Missouri & Territory of Arkansas, bearing date the twelfth of March 1831. I have examined, laid out and surveyed the above described Township, and do hereby certify that it has such marks and boundaries, both natural and artificial, as are represented on said plat, and described in the field notes made thereof, and returned with this plat into the office of the Surveyor of the lands of the United States for the States of Illinois & Missouri & Territory of Arkansas.

Certified this fifth day of July 1831

Ben Greenup Supt Surveyor

Township N^o 19 North of The Base Line Range N^o 13 West of the

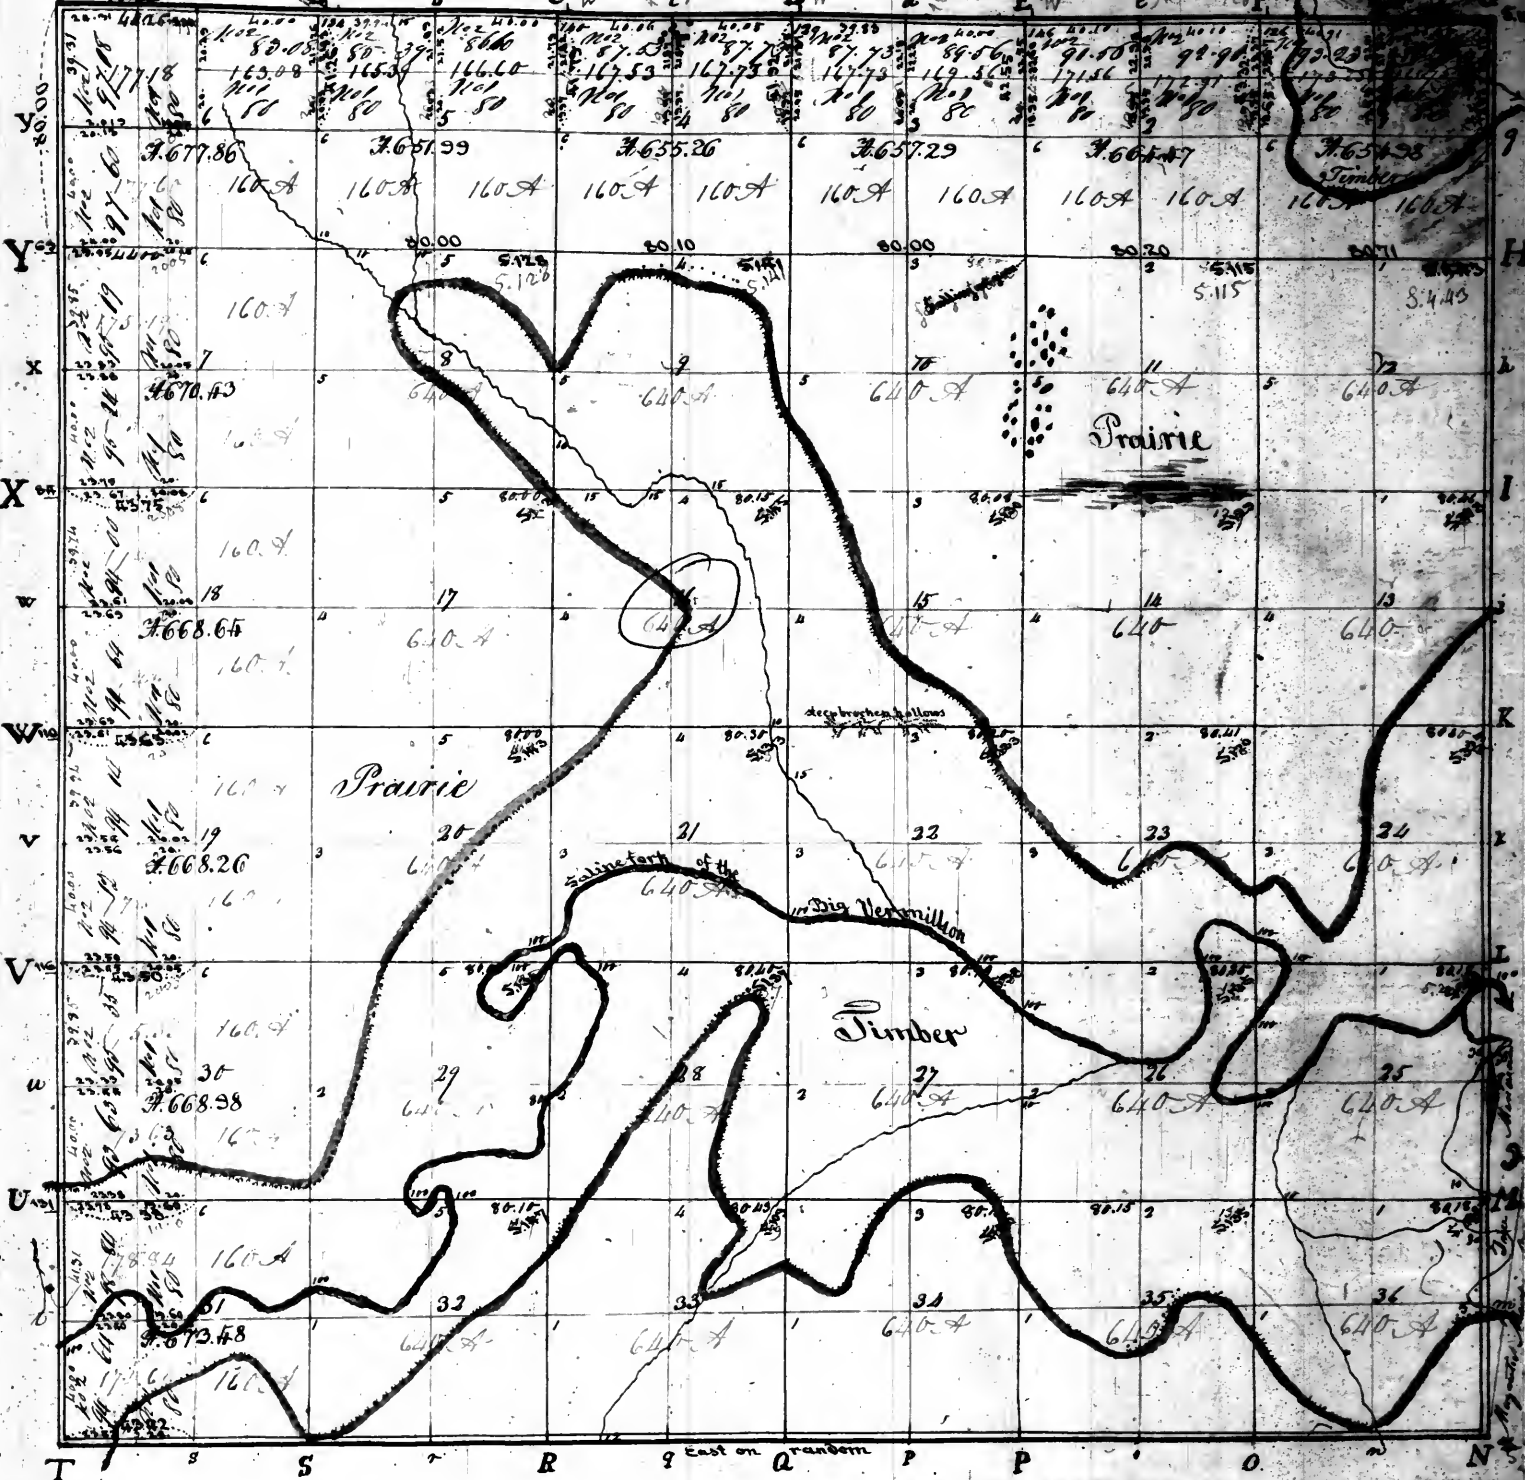

Surveyor's Office
St. Louis Mo. Sept 1842.
Plat of the North halves of Secs. 2, 3,
4 & 5 of the N.E. q^r of Sec. 6, and of
the West halves of Secs. 6, 7, 18, 19,
20 & 31, sent this day to the Com-
missioner of the Genl. Land Office.

Aggregate area - 23310.6 Acres


Scale of 40 Chains to an acre.

Pursuant to a contract with and Instructions from William Rector Surveyor of the lands of the United States in the States of Illinois & Missouri & Territory of Arkansas, Bearing date the twentieth day of March 1831 I have measured, laid out and Surveyed the above described Township, and do hereby certify, that its true and correct Marks and bounds, both Natural and artificial, as are represented on said plat, and described in the field Notes made thereof, and returned with this plat into the office of the Surveyor of the lands, of the United States for the States of Illinois & Missouri & Territory of Arkansas

Certified this fifth day of July 1831—

Real Greenup Supt. Surveyor


Township No. 20 North of the Base Line Range No. 13 West of the 2^d Meridian
 Standard Line between Townships No. 20 & 21 North of the base line

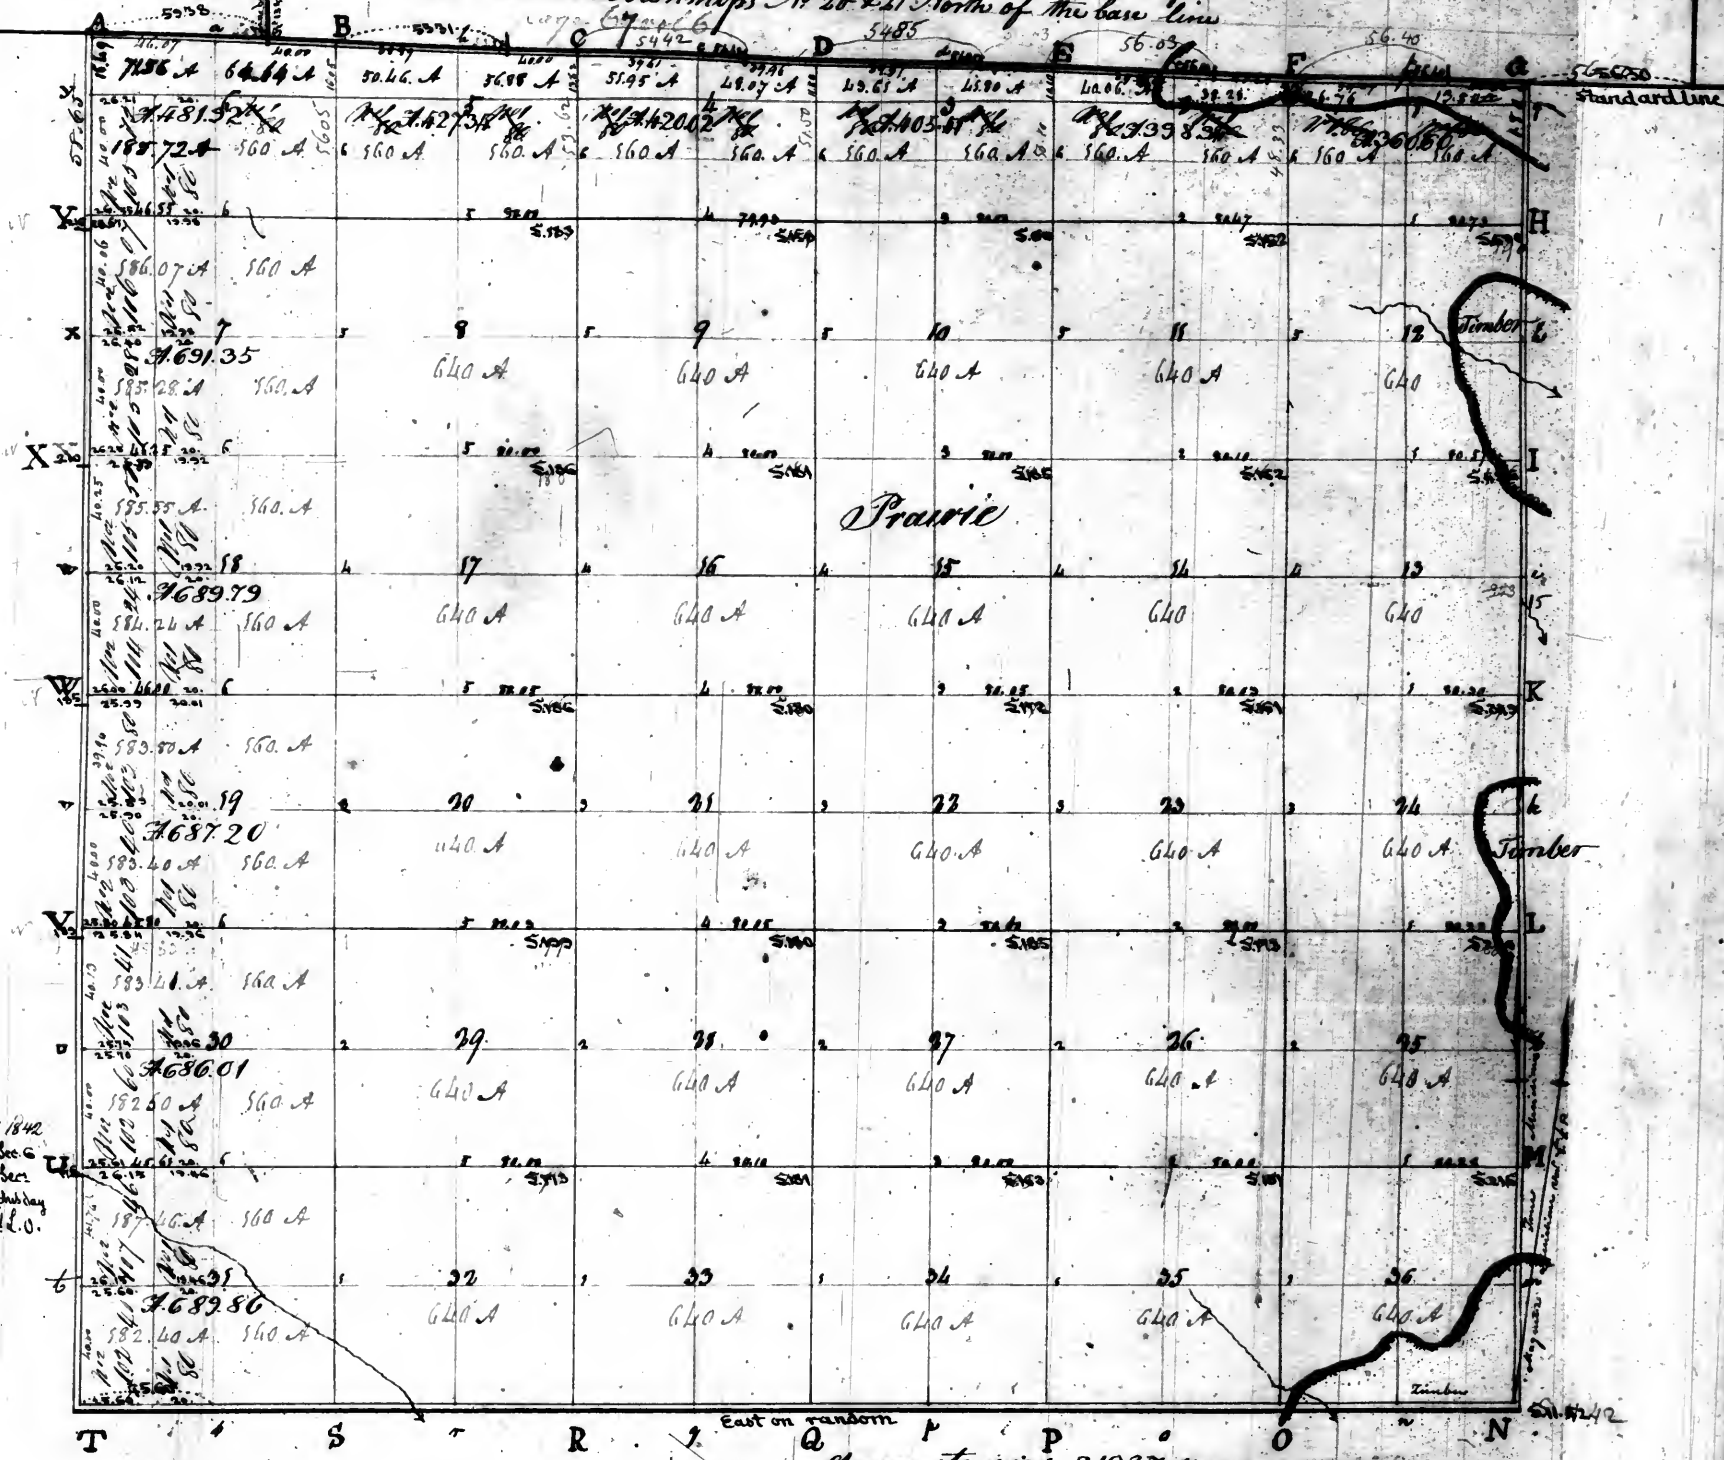

Pursuant to a contract with and instructions from William Rector Surveyor of the Lands of the United States for the State of Missouri and Territory of Arkansas bearing date the 12th day of March 1833. I have assumed said land, and surveyed the above described Township and do hereby certify that it has been marked and bounded both natural and artificial as are represented on said plat and described in the field notes made therefor and returned with this plat into the Office of the Surveyor of the Lands of the United States for the State of Missouri and Territory of Arkansas.

Certified this 5th day of July 1833.

Beal Greenup, Sept. Survey

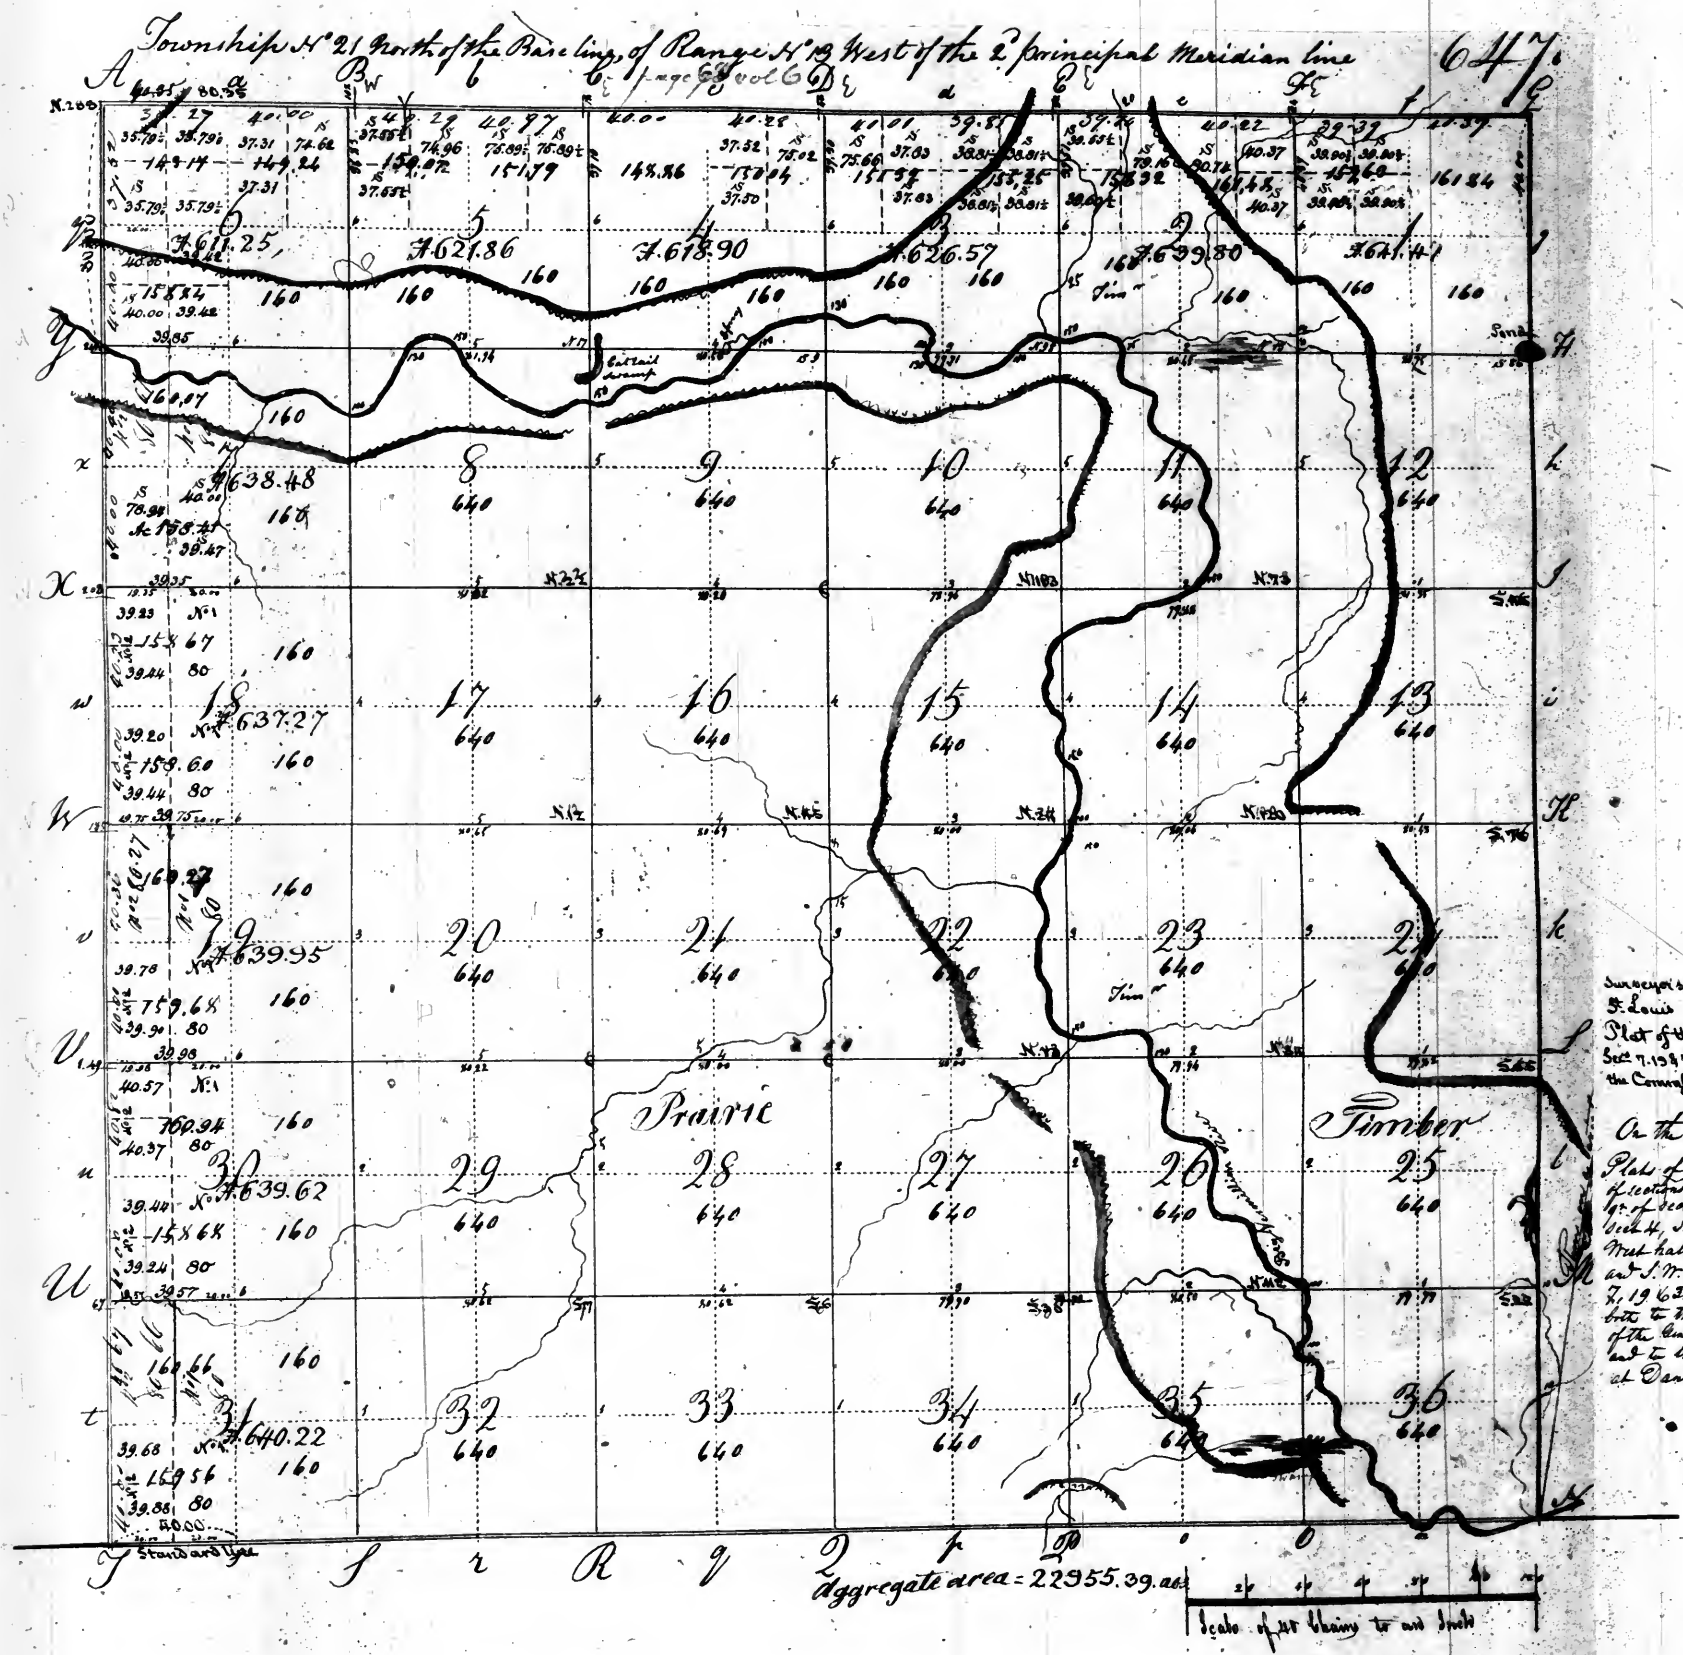

Surveyor's Office



Pursuant to a Contract with and instructions from William Reuter, Surveyor of the Lands of the United States in the State of Illinois
Missouri, bearing date the day of March 1891, I have measured, laid out & surveyed the above described Township & do
certify that it has such marks & bounds both natural & artificial as are represented on said Plat & described in the
Notes made thereof & returned with this Plat into the Office of the Surveyor of the Lands of the United States for the State
Illinois and Missouri

Certified June 18th 1891

John M. Simpson S.S.


page 69 vol 6

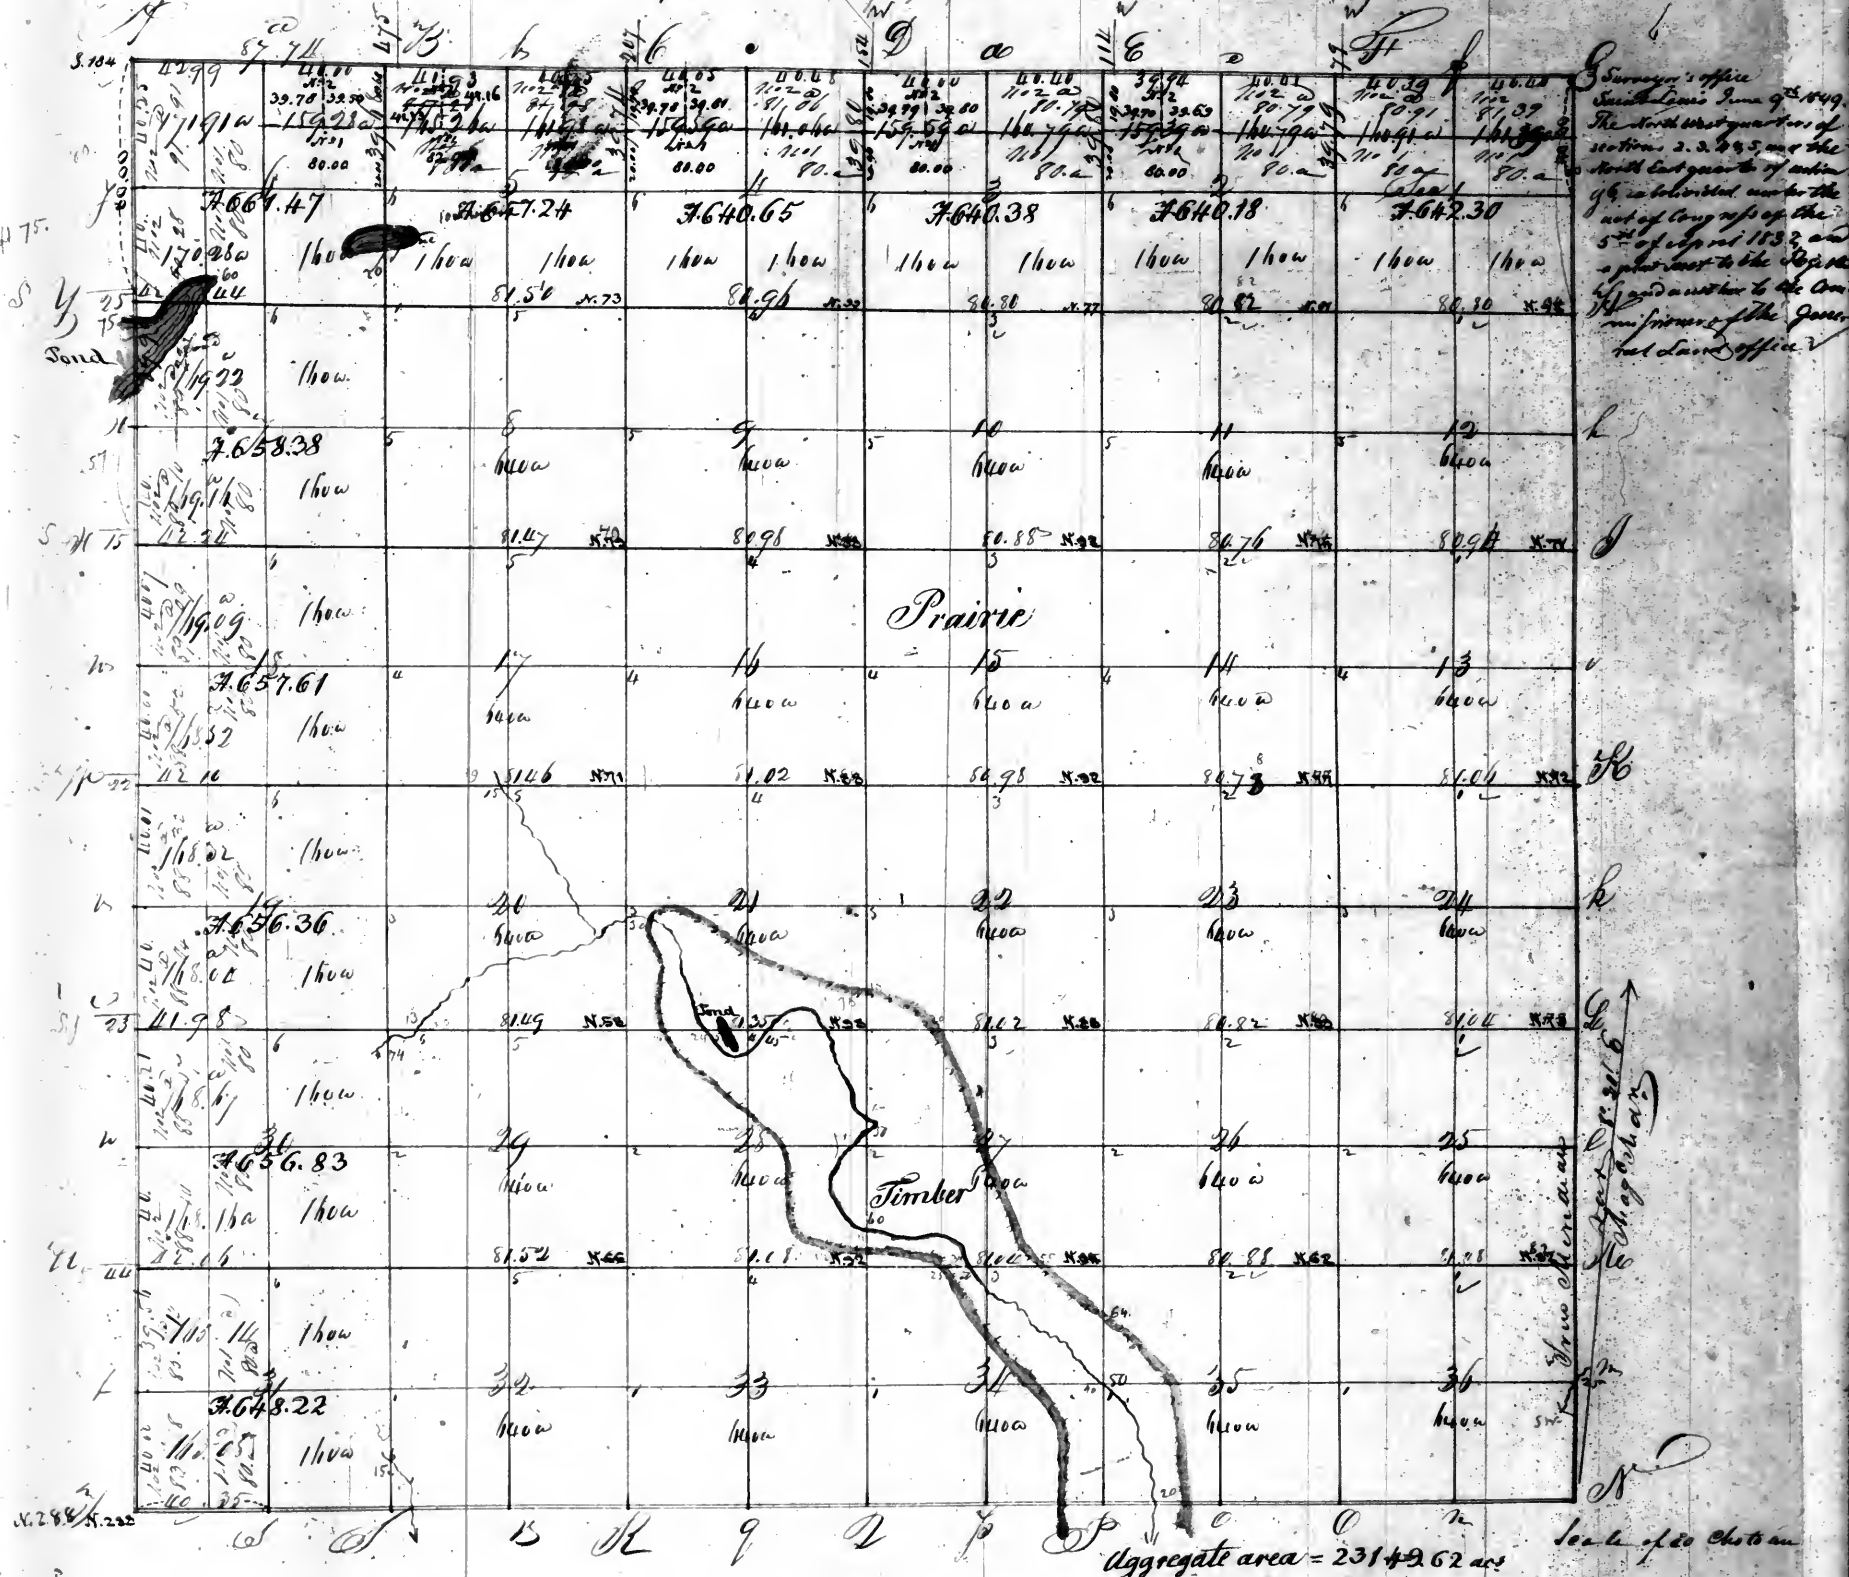

the field notes made thereof and returned with this plat to the office of the Surveyor of the Lands of the U.S. in the State of Illinois & Territory of Arkansas.


Certified this 15 Day of November 1892

Examined

Estee Surveyor

Township N^o 28 North of the Base line Range N^o 13 West of the 3^d P^{ri}ncipal Meridian

page 70 vol 6

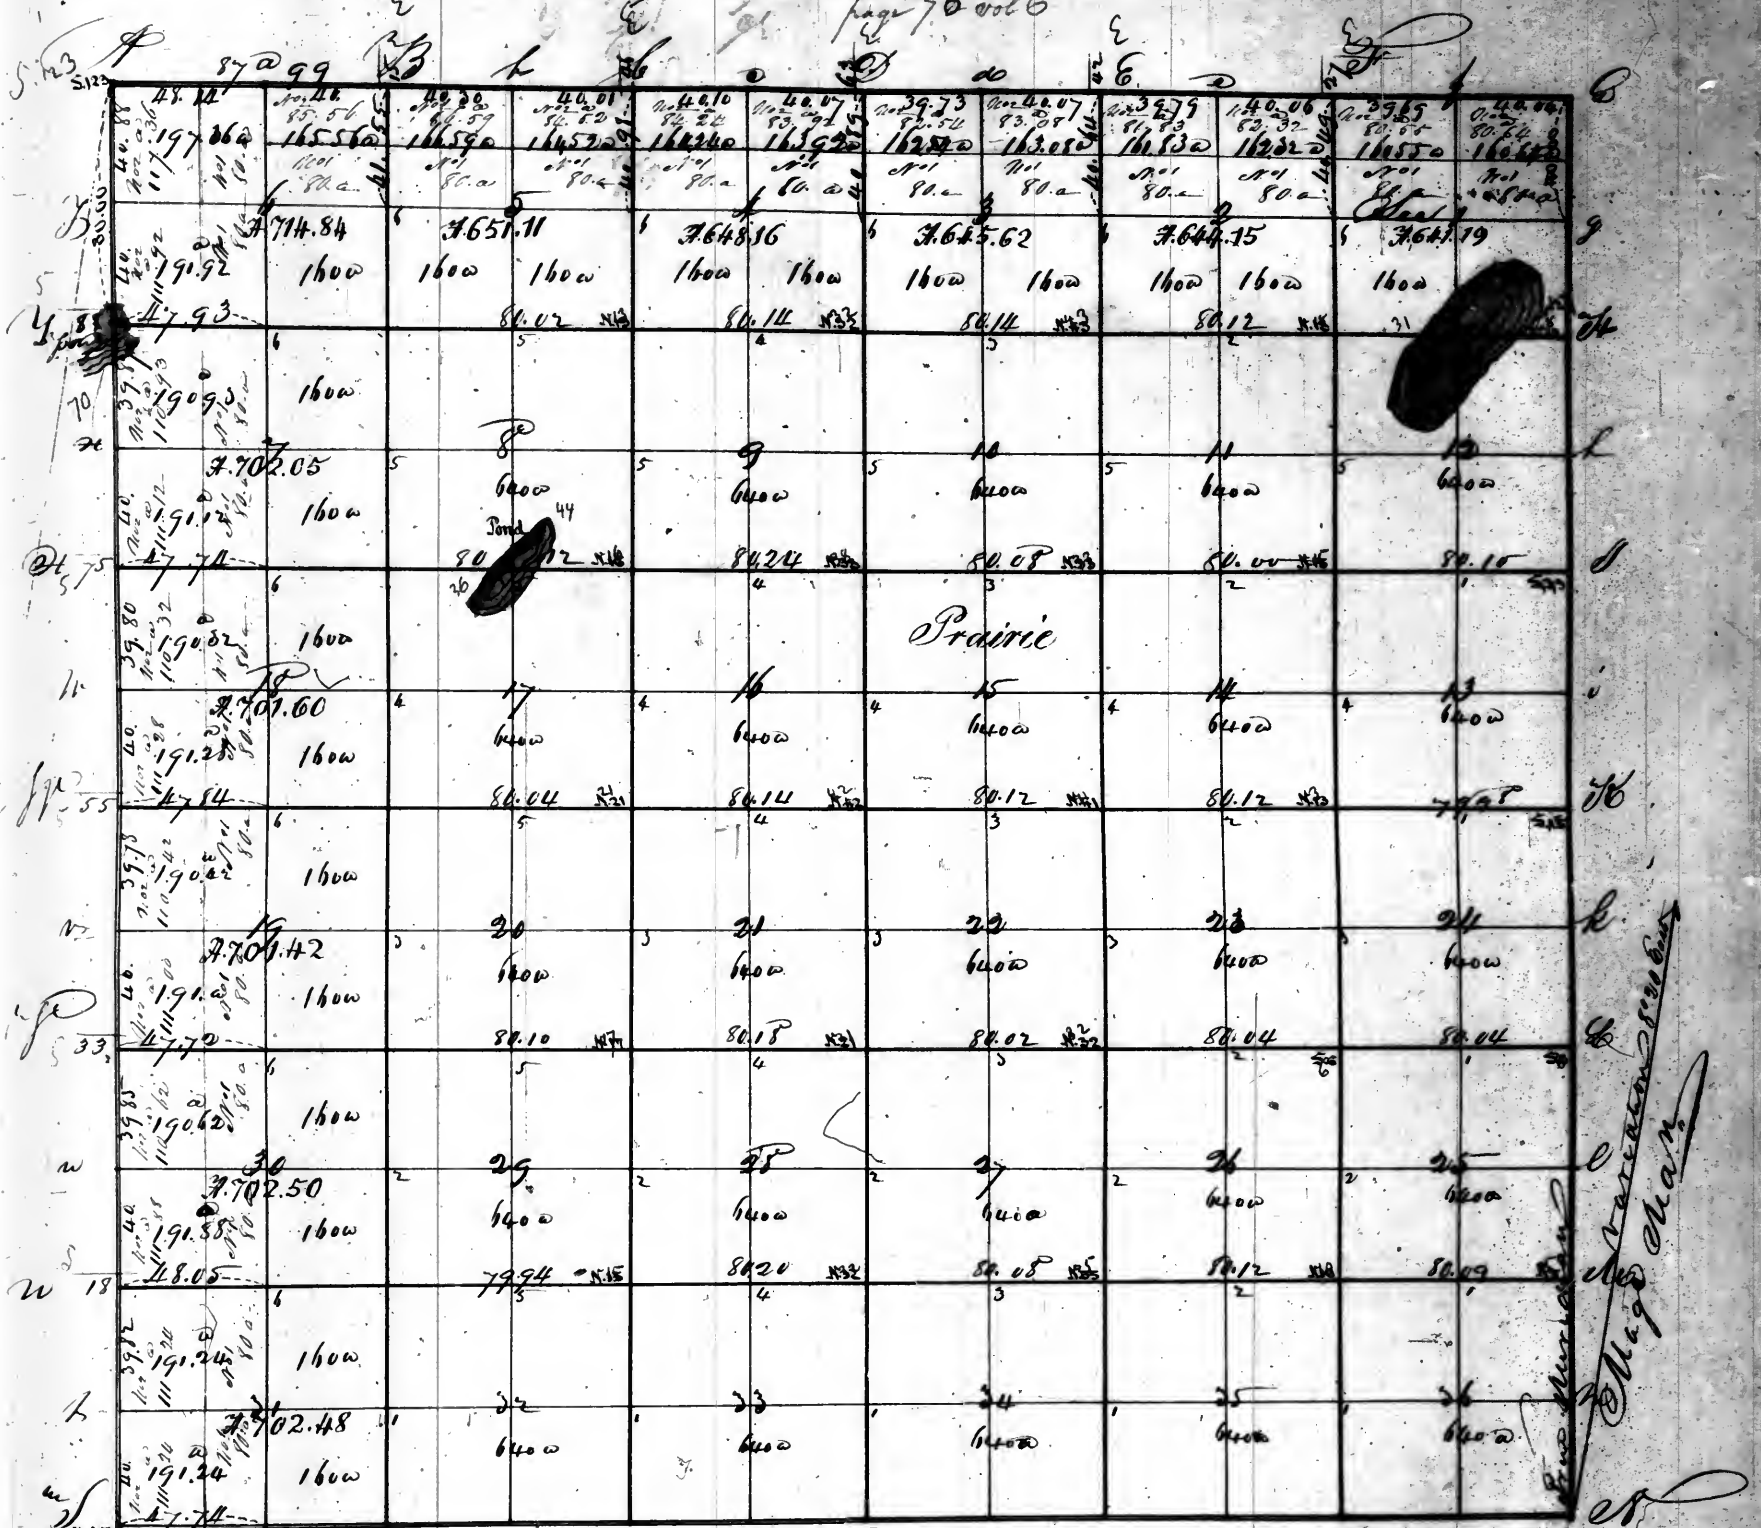

Pursuant to a contract with and instructions from William B. Rector Surveyor of the Lands of the United States
 State of Illinois & Missouri & Territory of Arkansas bearing date the 9th day of March 1822
 I have a demarcation laid out and surveyed the above described Township & do hereby certify
 that such marks and bounds both natural and artificial as are represented on said plat and described
 the field notes made thereof and returned with this plat into the office of the Surveyor of the Lands of
 United States in the State of Illinois & Missouri & Territory of Arkansas
 Certified this Day of November 1822
 Examined
 E. Stearns Surveyor

Page 72 vol 6

Standard line

Prairie


Jumber

Chapman

Standard line

I J W R Q
Aggregate area 29846.77 acres ^{more or less}
Pursuant to a contract with and instructions from William Pictors Surveyor of the Lands of the United States in Illinois & Missouri & Territory of Arkansas bearing date the 9th day of March 1832 — I have examined and surveyed the above described Township & do hereby certify that it has such marks and bounds both natural and artificial as are represented on said plat and described in the field notes made thereof and returned with this plat into the office of the Surveyor of the Lands of the U.S. in the State of Illinois & Missouri & Territory of Arkansas,
testified this 15th Day of November 1832.
C. Stearns

Township No. 26 *North* of the base line, Range No. 13 *West* of the 2nd principal Meridian.

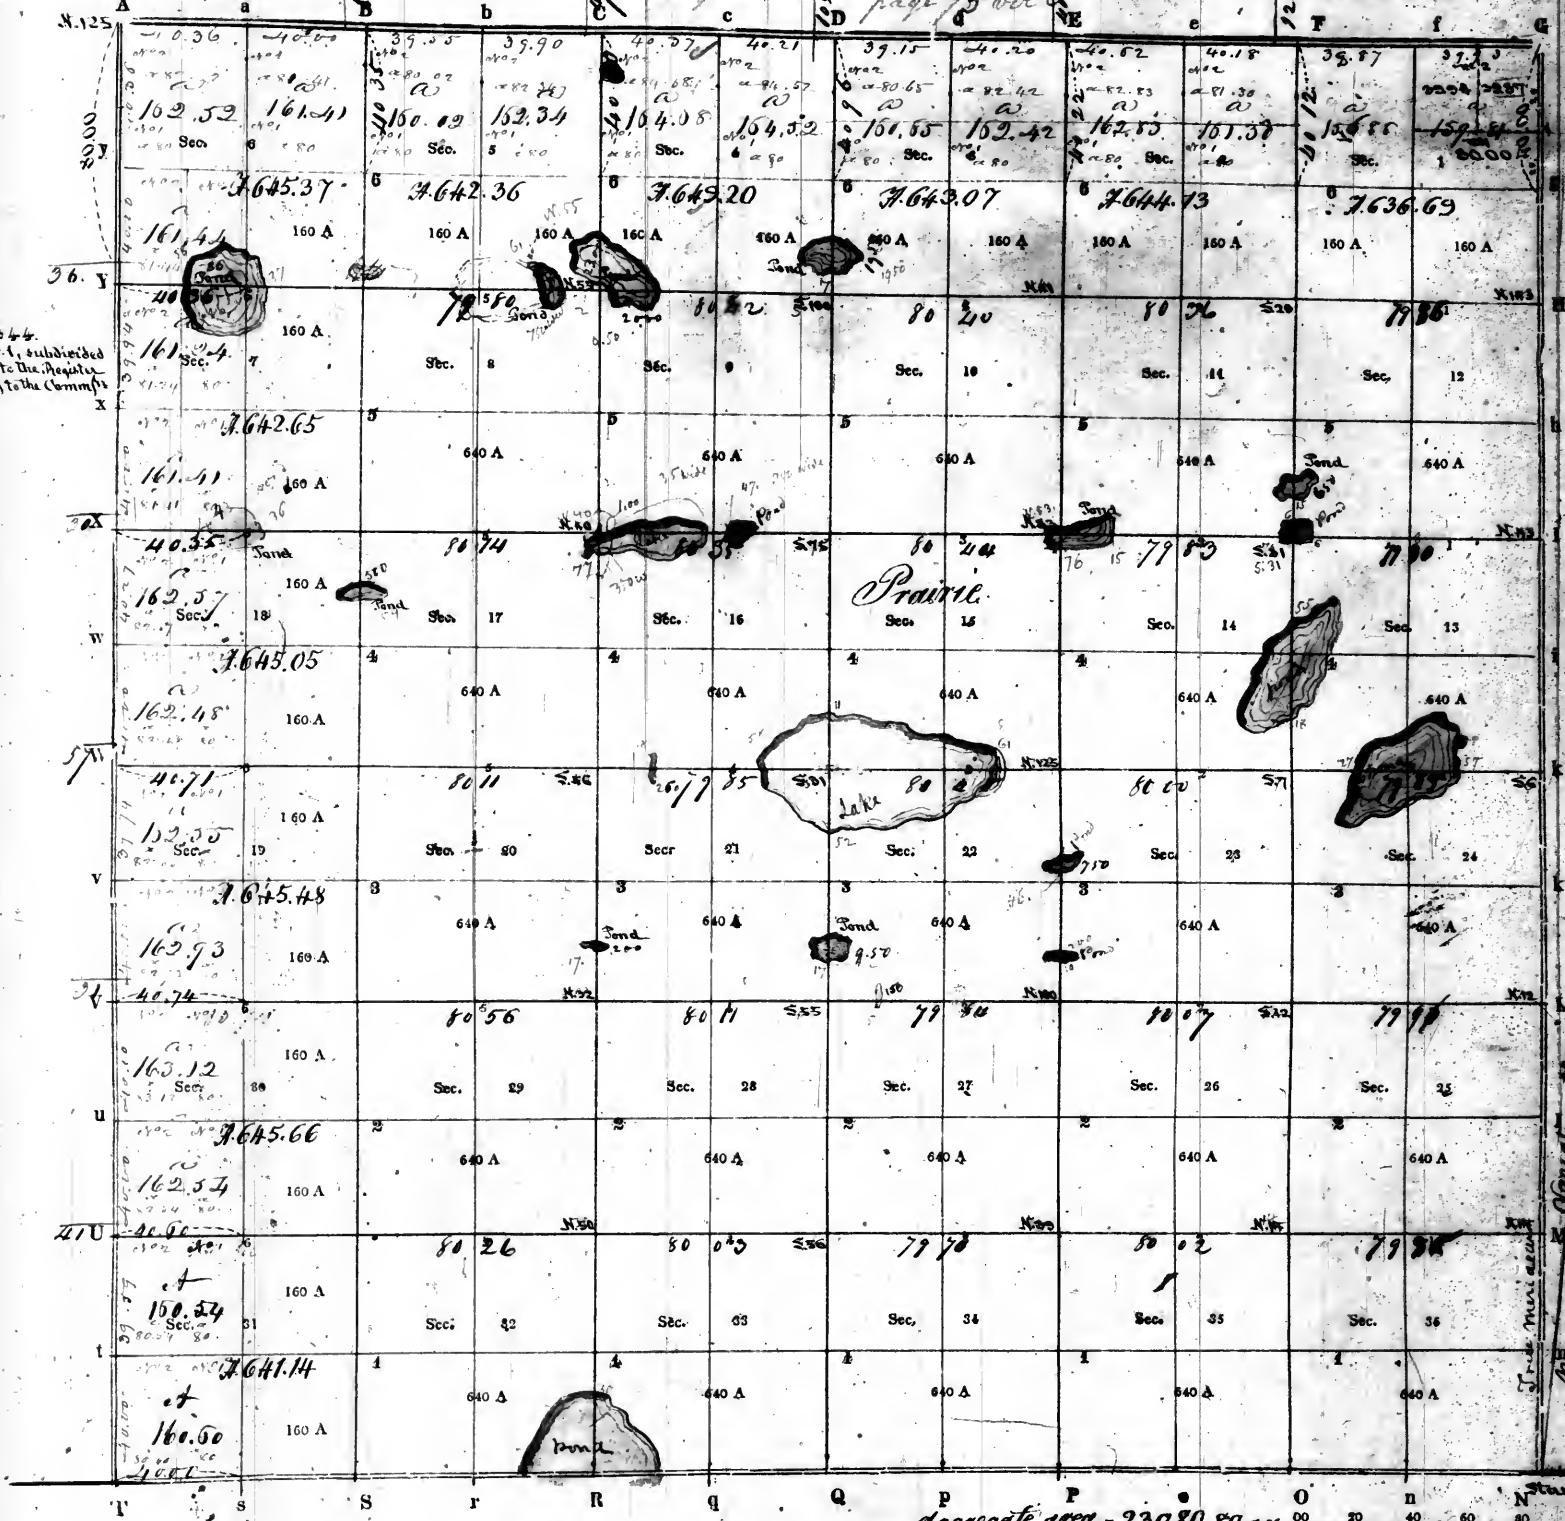


Surety Office
St. Louis 26 June 1844
Plat of the NE 1/4 of Sec. 1, subdivided
this day, & sent one copy to the Register
& another to the Commissioner of the Genl. Land Office.

PURSUANT to a contract with, and instructions from William Rector, Surveyor of the lands of the United States in the State of Missouri, bearing date the 15th day of March 1842, we have measured, laid out and surveyed the above described Township; and do hereby certify, that it had such marks and bounds, both natural and artificial, as are represented on said plat, and described in the field notes made thereof, and returned with this plat into the Office of the Surveyor of the Lands of the United States, in the

Certified this 1st day of December 1842

EXAMINED.

Wm. J. Hamilton D. SURVEYOR.
Elias Rector

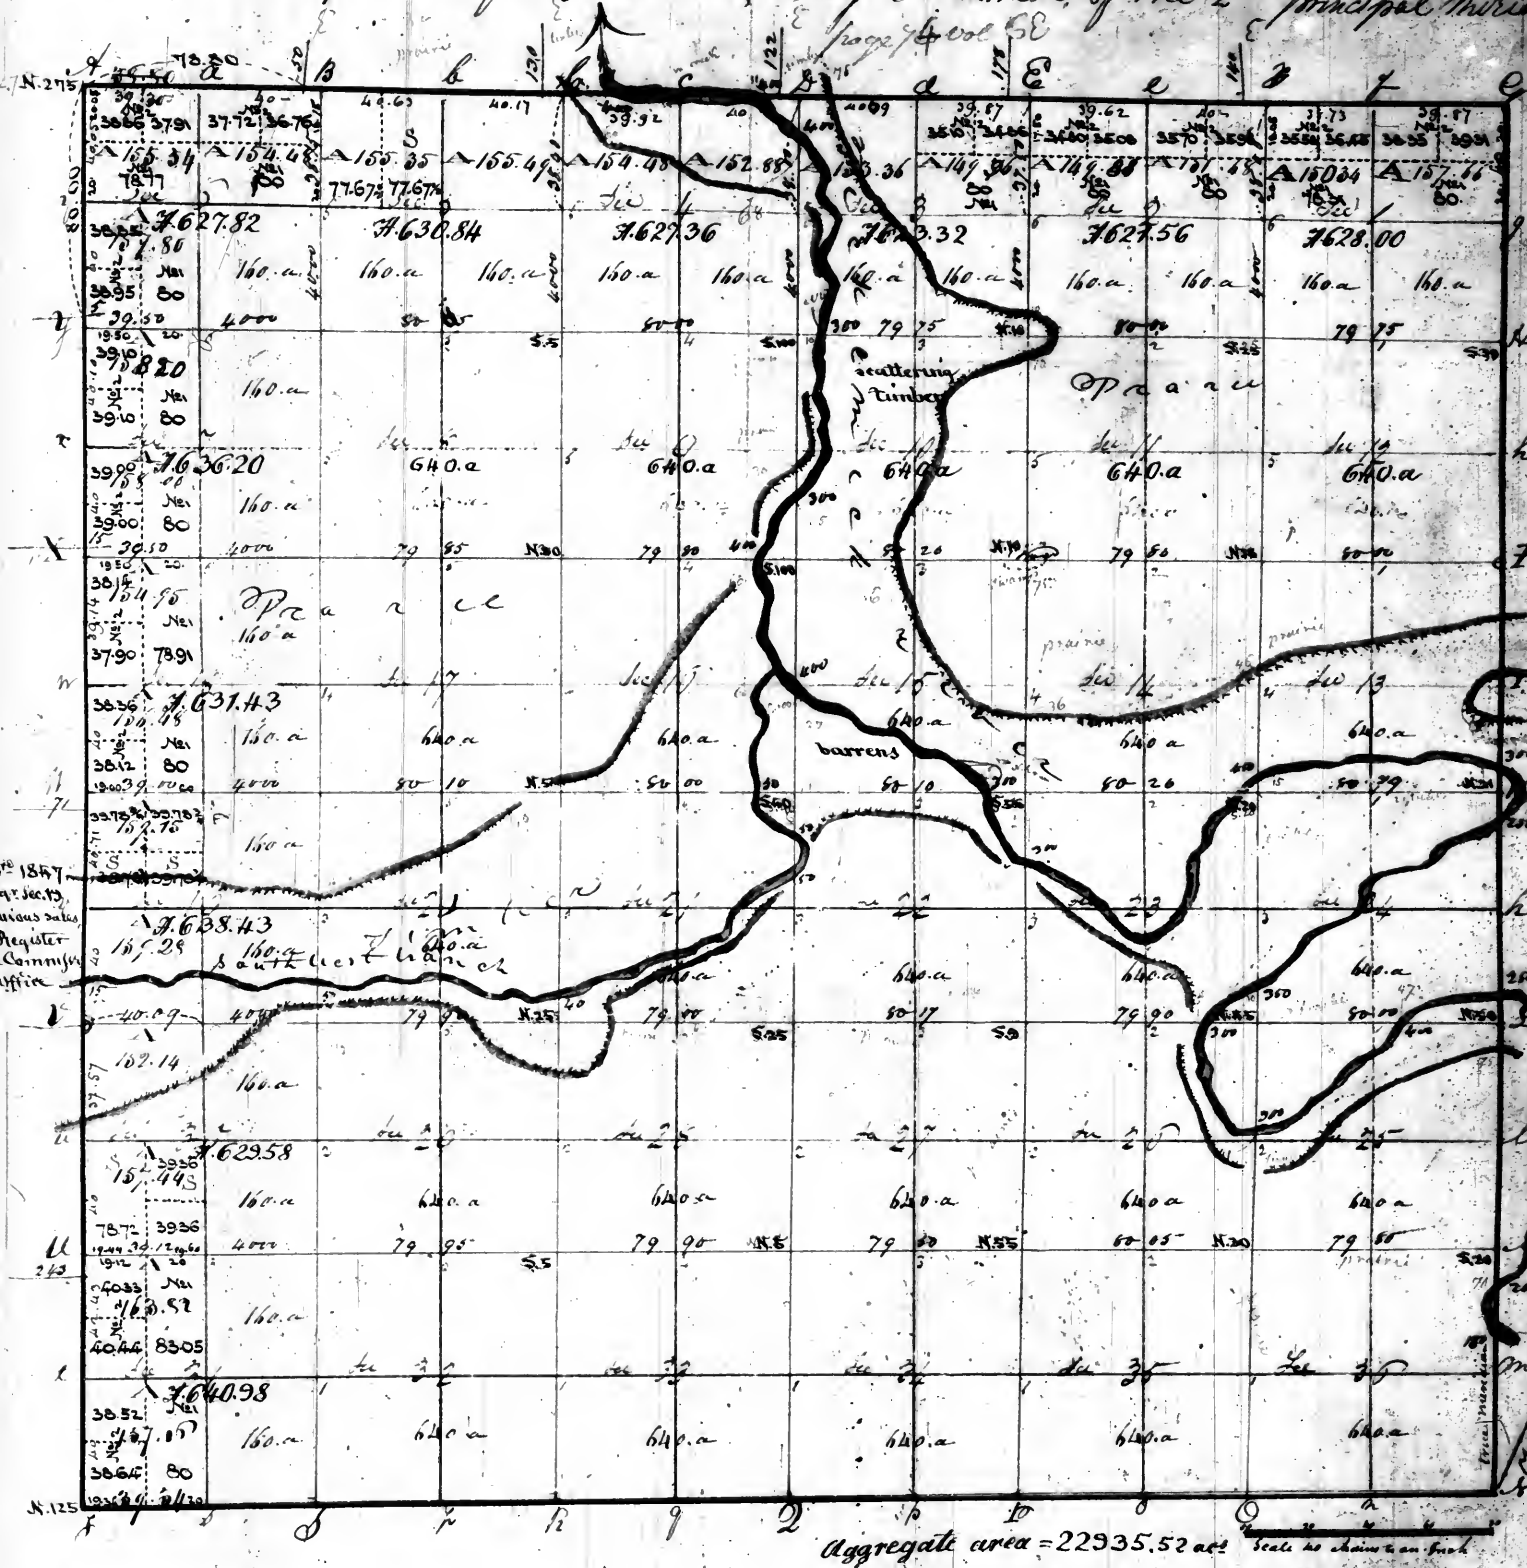

and do certify that it had such marks & bounds, both natural and artificial, as are represented on said plat, and described in the field notes made by me, and returned with plat into the Office of the Surveyor of the Lands of the United States, for the State of Illinois & Territory of Arkansas. - Certified this 12th day of March 1822 -
 Surveyor of the Lands of the United States in the State of Illinois & Territory of Arkansas.

[illegible]

Wm. Hall D. Singer


Each of eight subdivisions not
on record.
a copy of this plat was sent
to the Genl Land Office on 10th
August 1842.

TOWNSHIP N^o RANGE N^o XIV N

317

5 1/2 6

in areas of Sec 1, 12, 14, 23, 26, 27
34 & 35 see enr. 1st

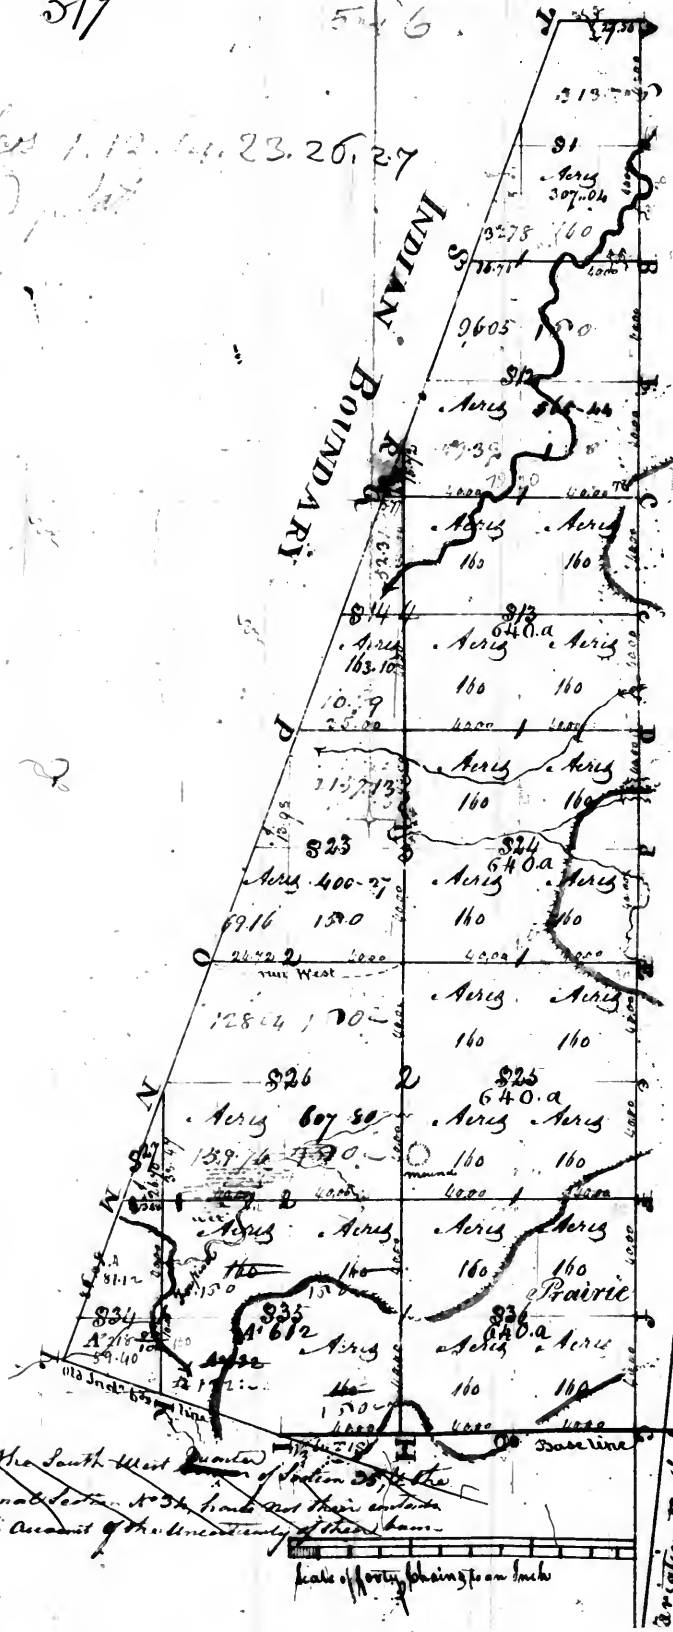

Aggregate area = 5433.58 acres


N.B. The South West Quarter of Section 35 is the fractional section. A 34.16 acre tract is shown and is not on account of the uncertainty of the boundaries.




*Date of origl. Subdivision not recorded.
A copy of this plat sent to the Gen
Land Office on 10 Aug 1862.*


Date of orig^l. Subdivision not recorded.
a copy of this plat sent to the Genl.
Land Office on 10 May 1842.

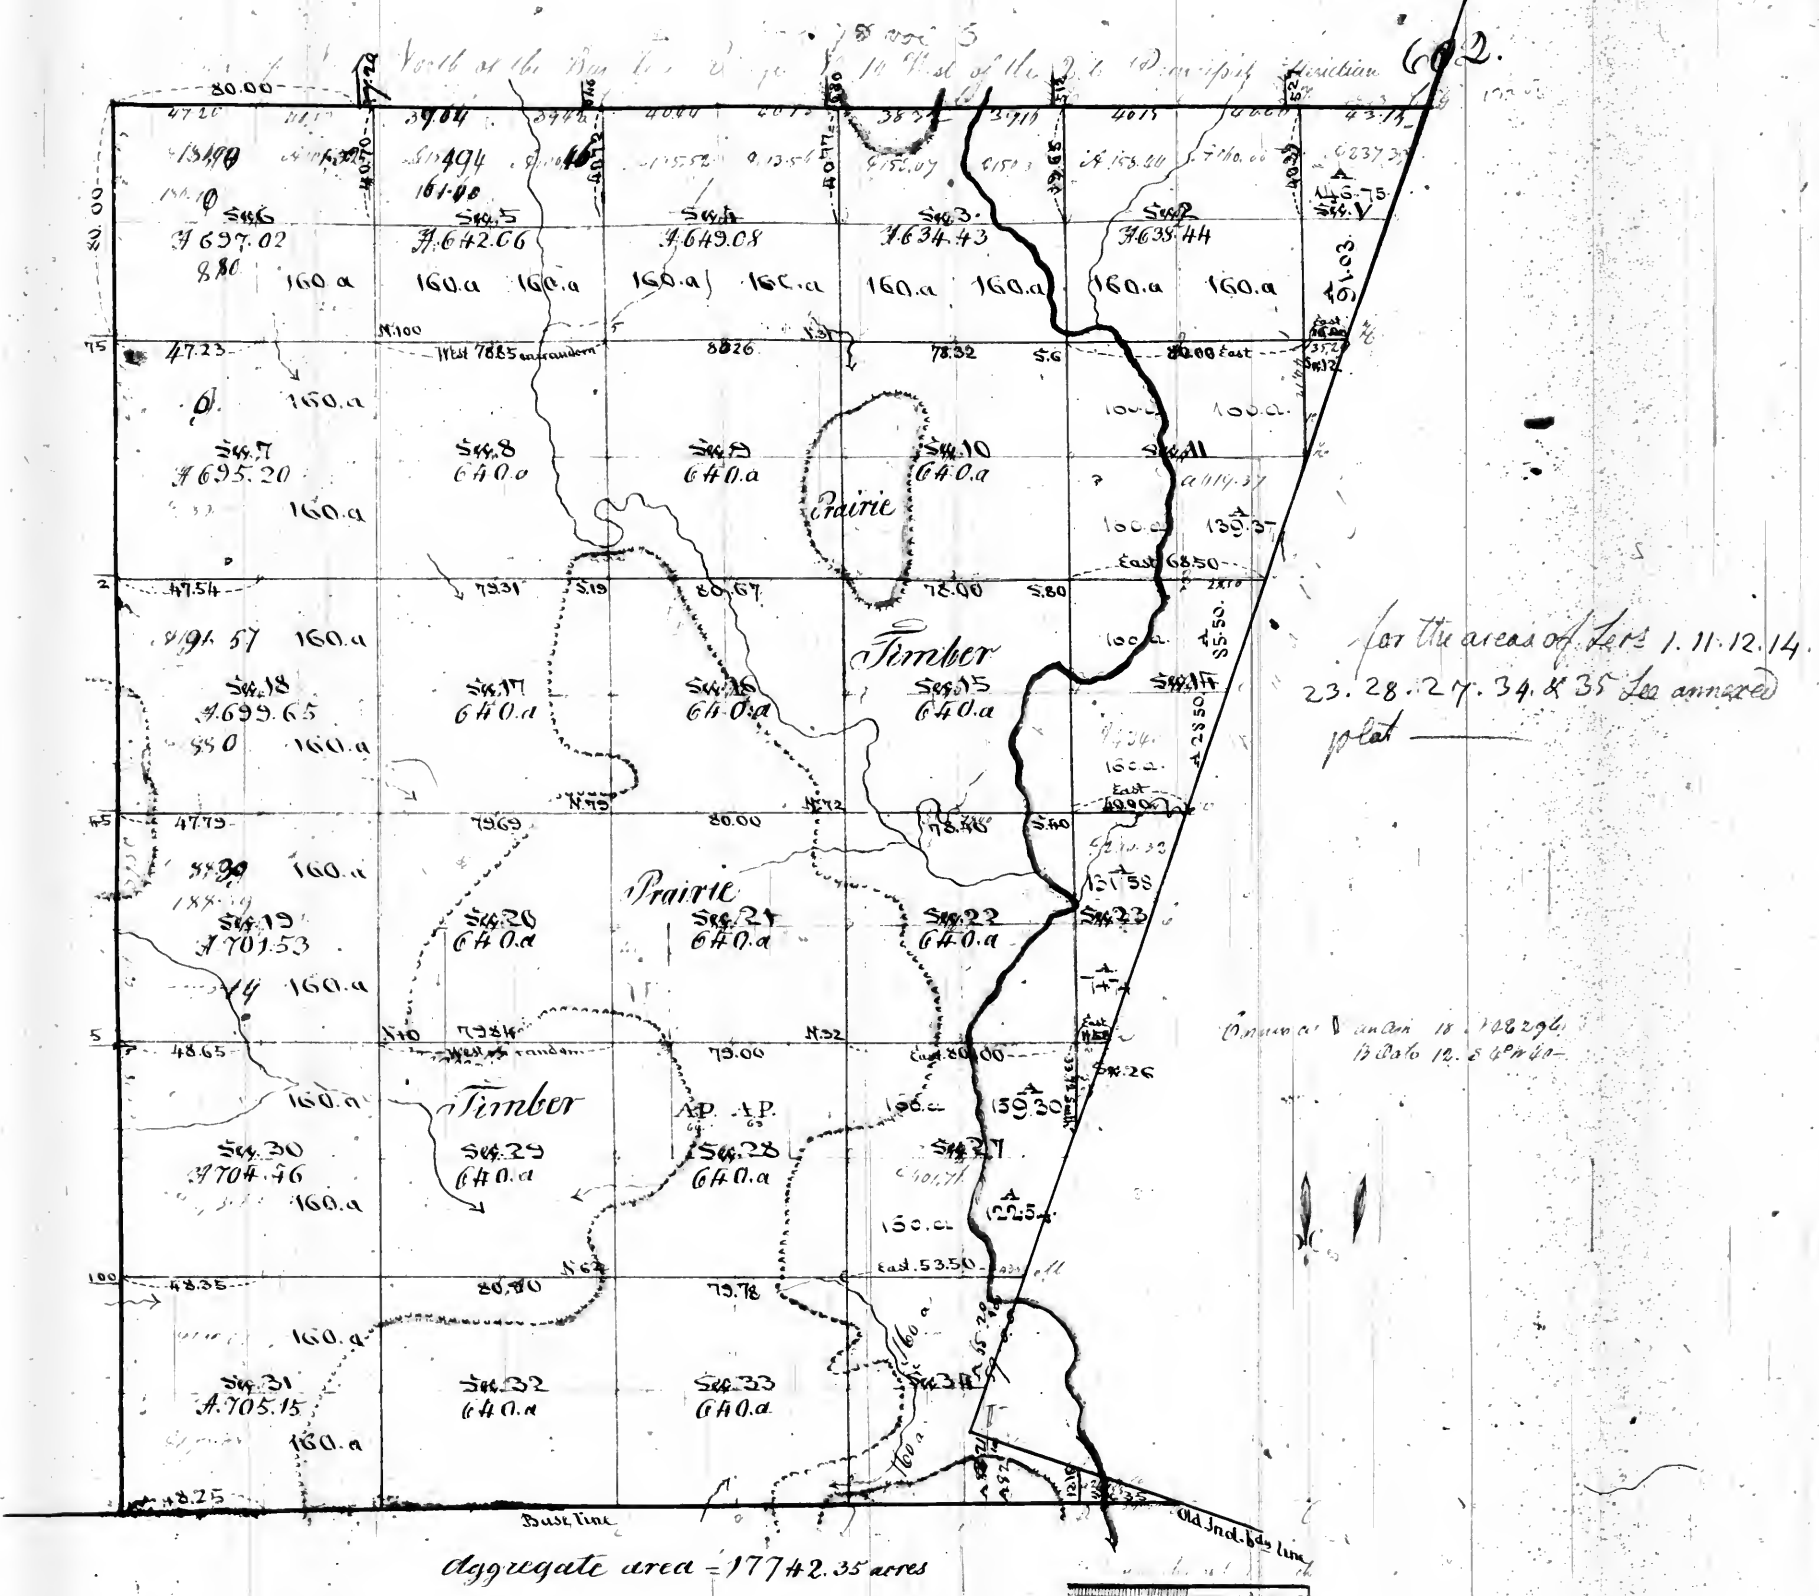

...to the ... of the ... State ...
... November 1888 ...
... to the ... of the ... State ...


L. Sullivan D.

Plat of Fractional Section 36 Township 2 North of the Base line
 Range 14 West of the 2nd Principal Meridian, and West of the Old Indian
 Boundary Subdivided under the Act of Congress of the 5th of April 1832.

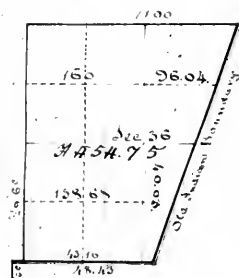

Plat of original Subdivision not
 on record.
 a copy of this plat sent to the
 Genl. Land Office on 10th Aug 1842.

for area of sec. 36 see annexed plat

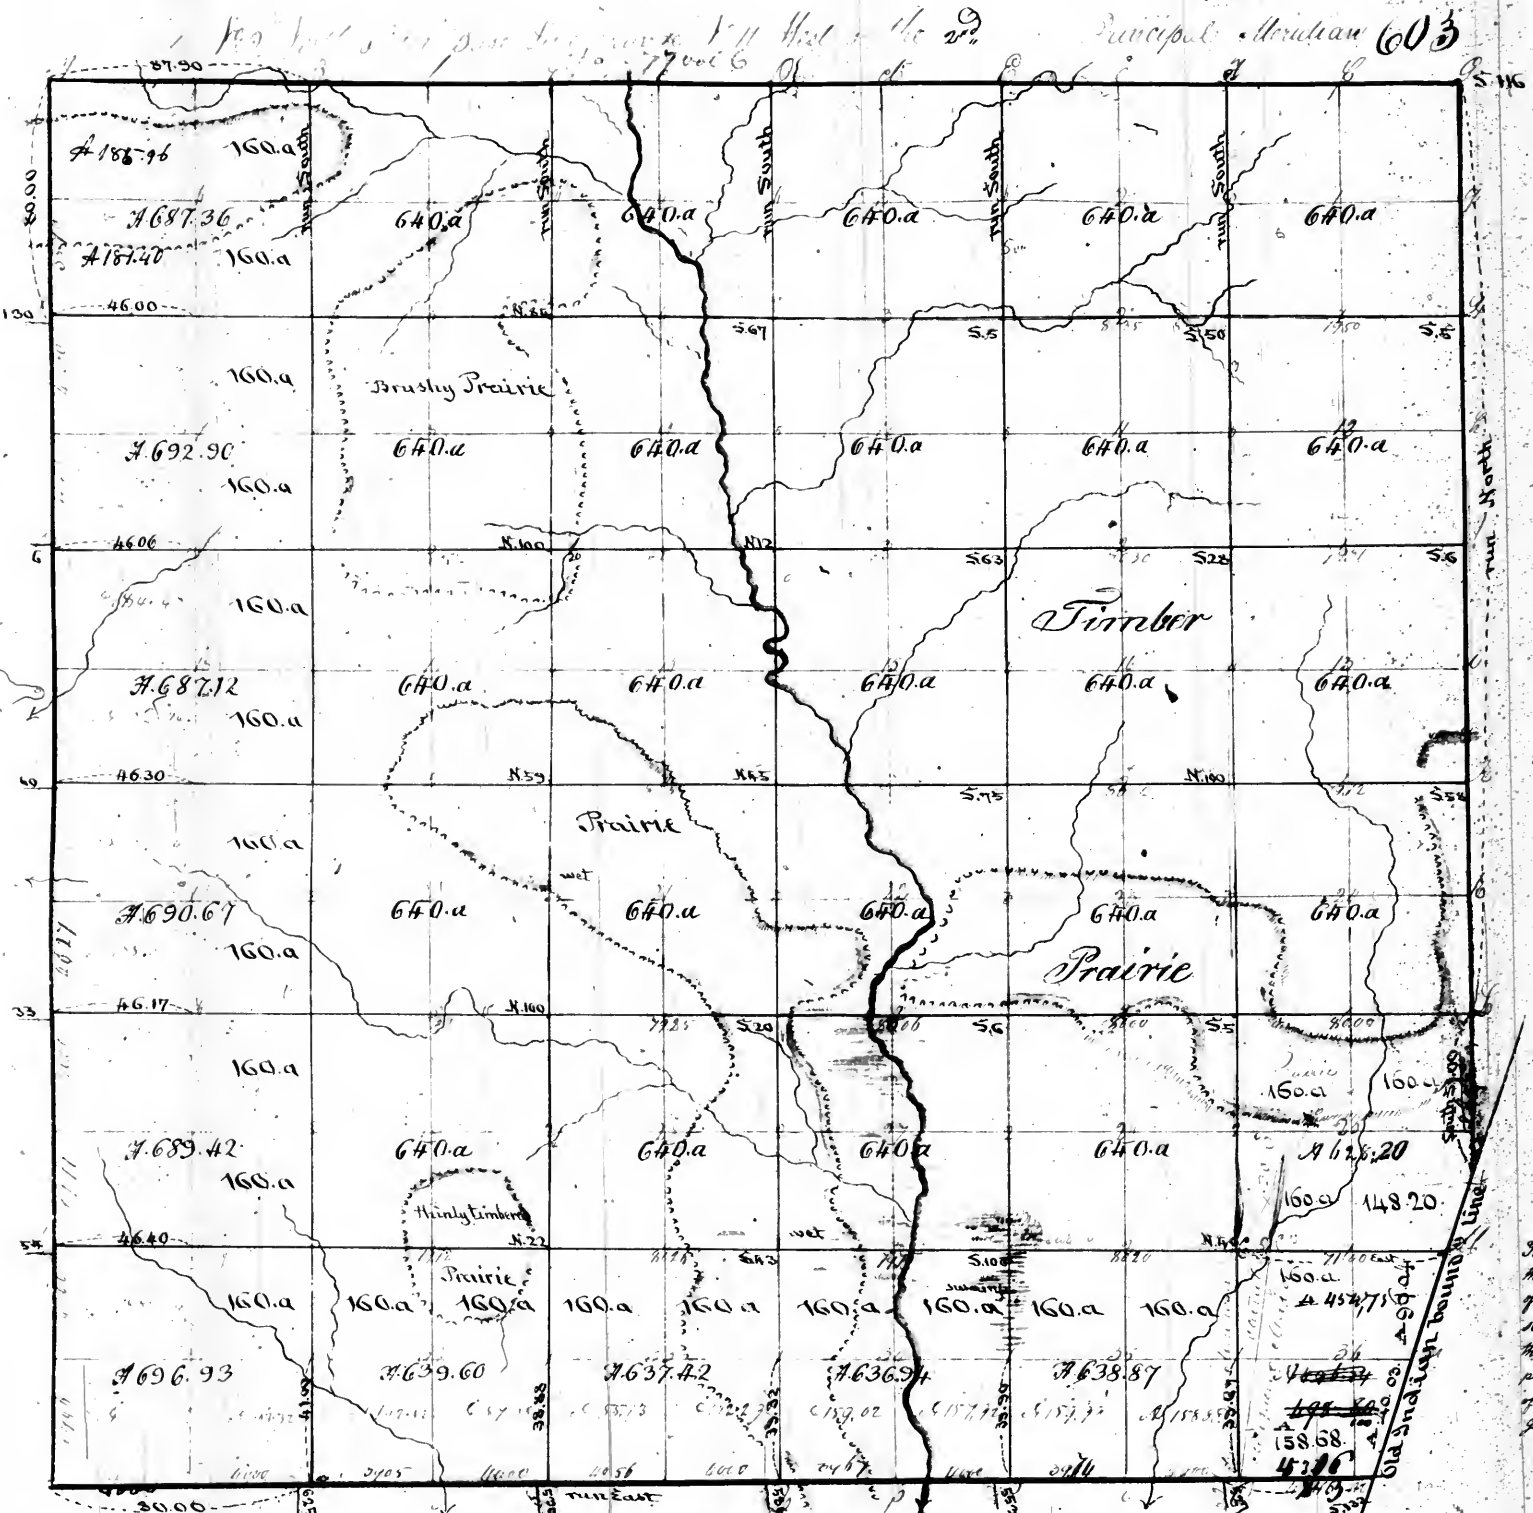


Aggregate area = 23140.18 acres


For plat of that part of this township which lies east of the old land line see plat numbered 2 of this volume (also one detached plat thereto annexed) a copy of which was sent to the State Lands off. 10. Aug. 1942



John L. Dieringer

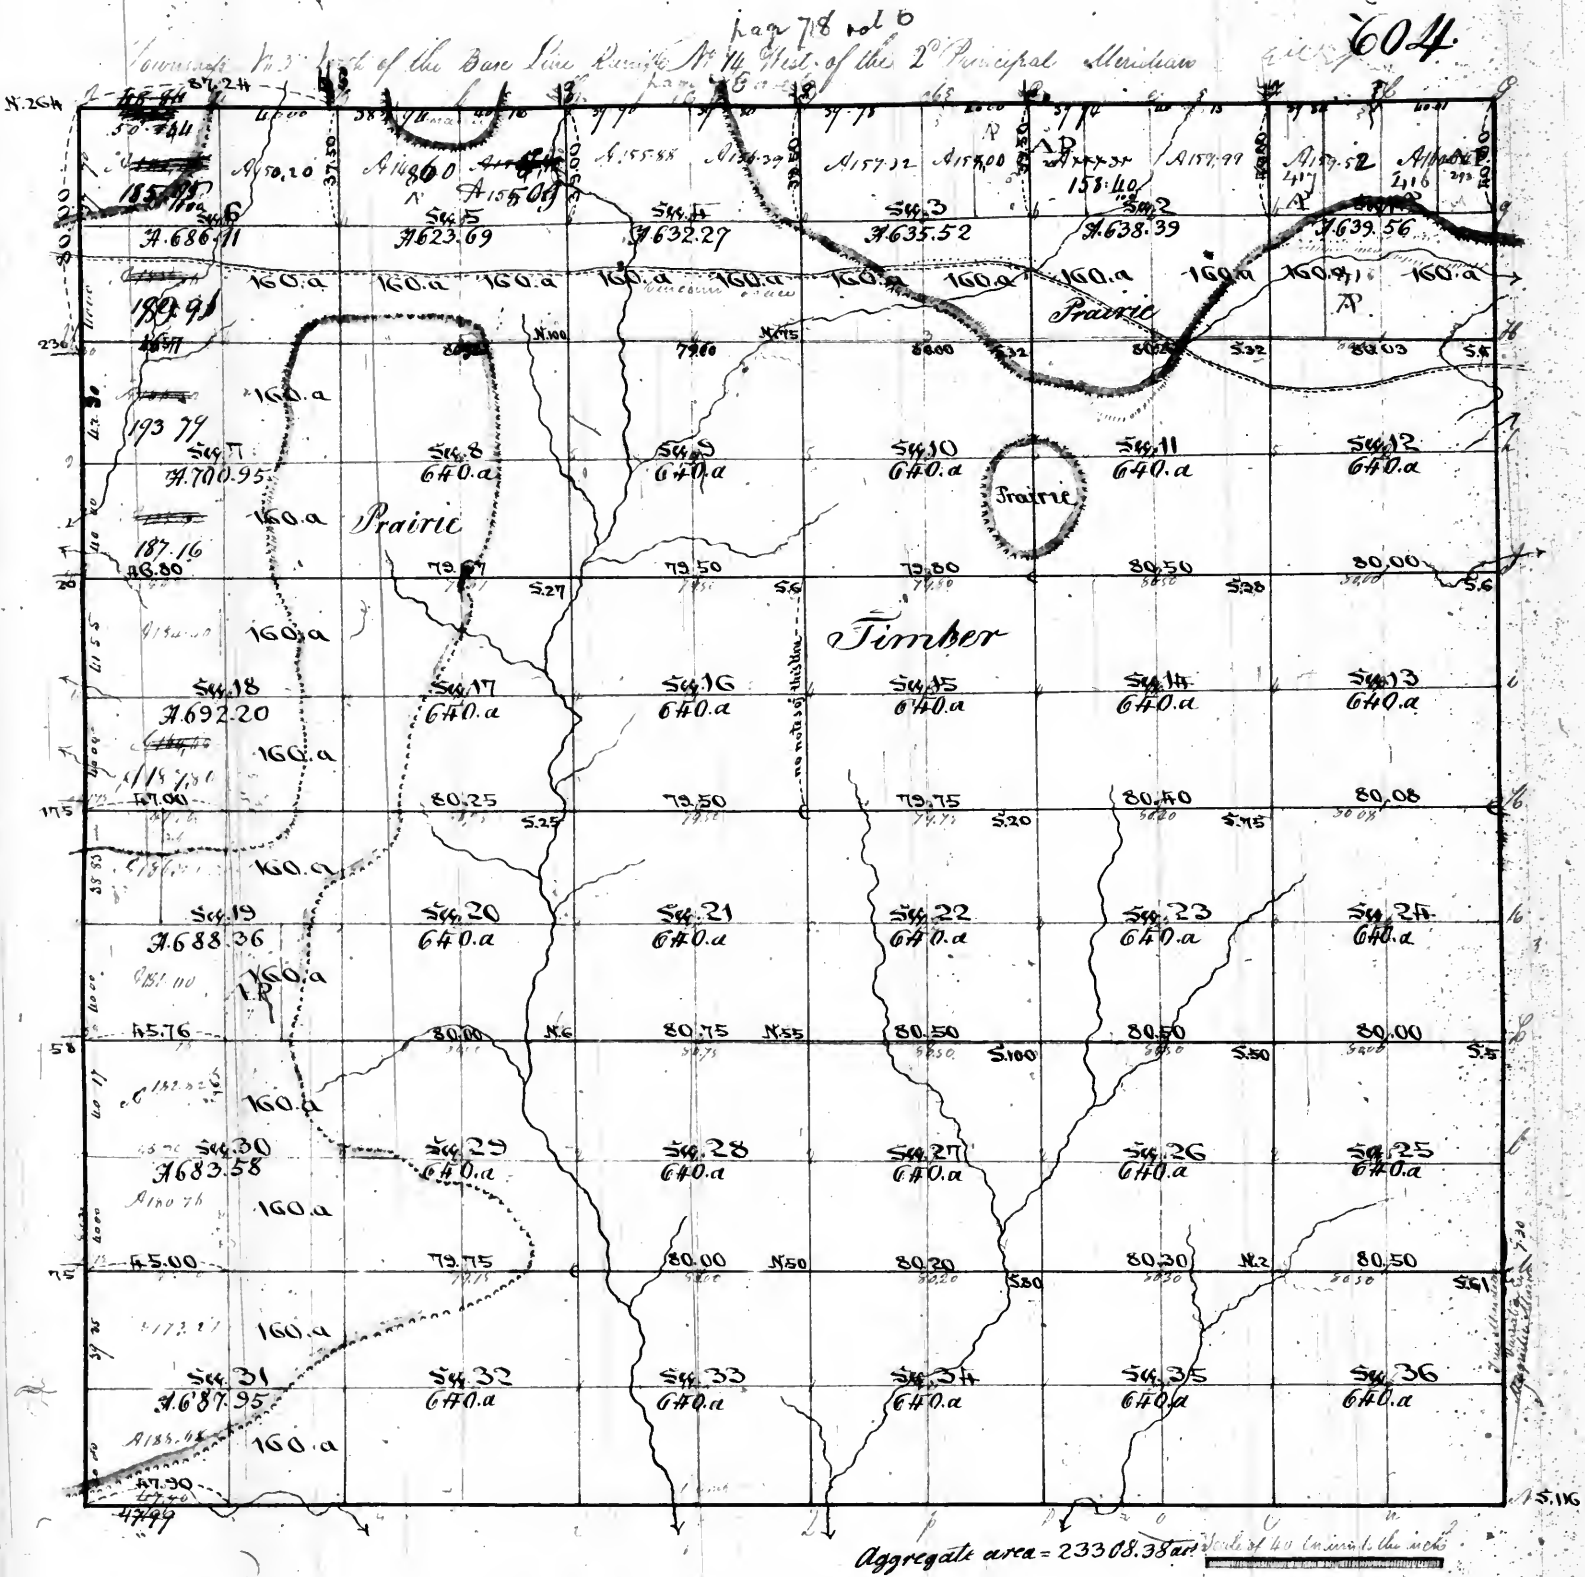

Surveyed by D. Sullivan, D.S.
June 1879

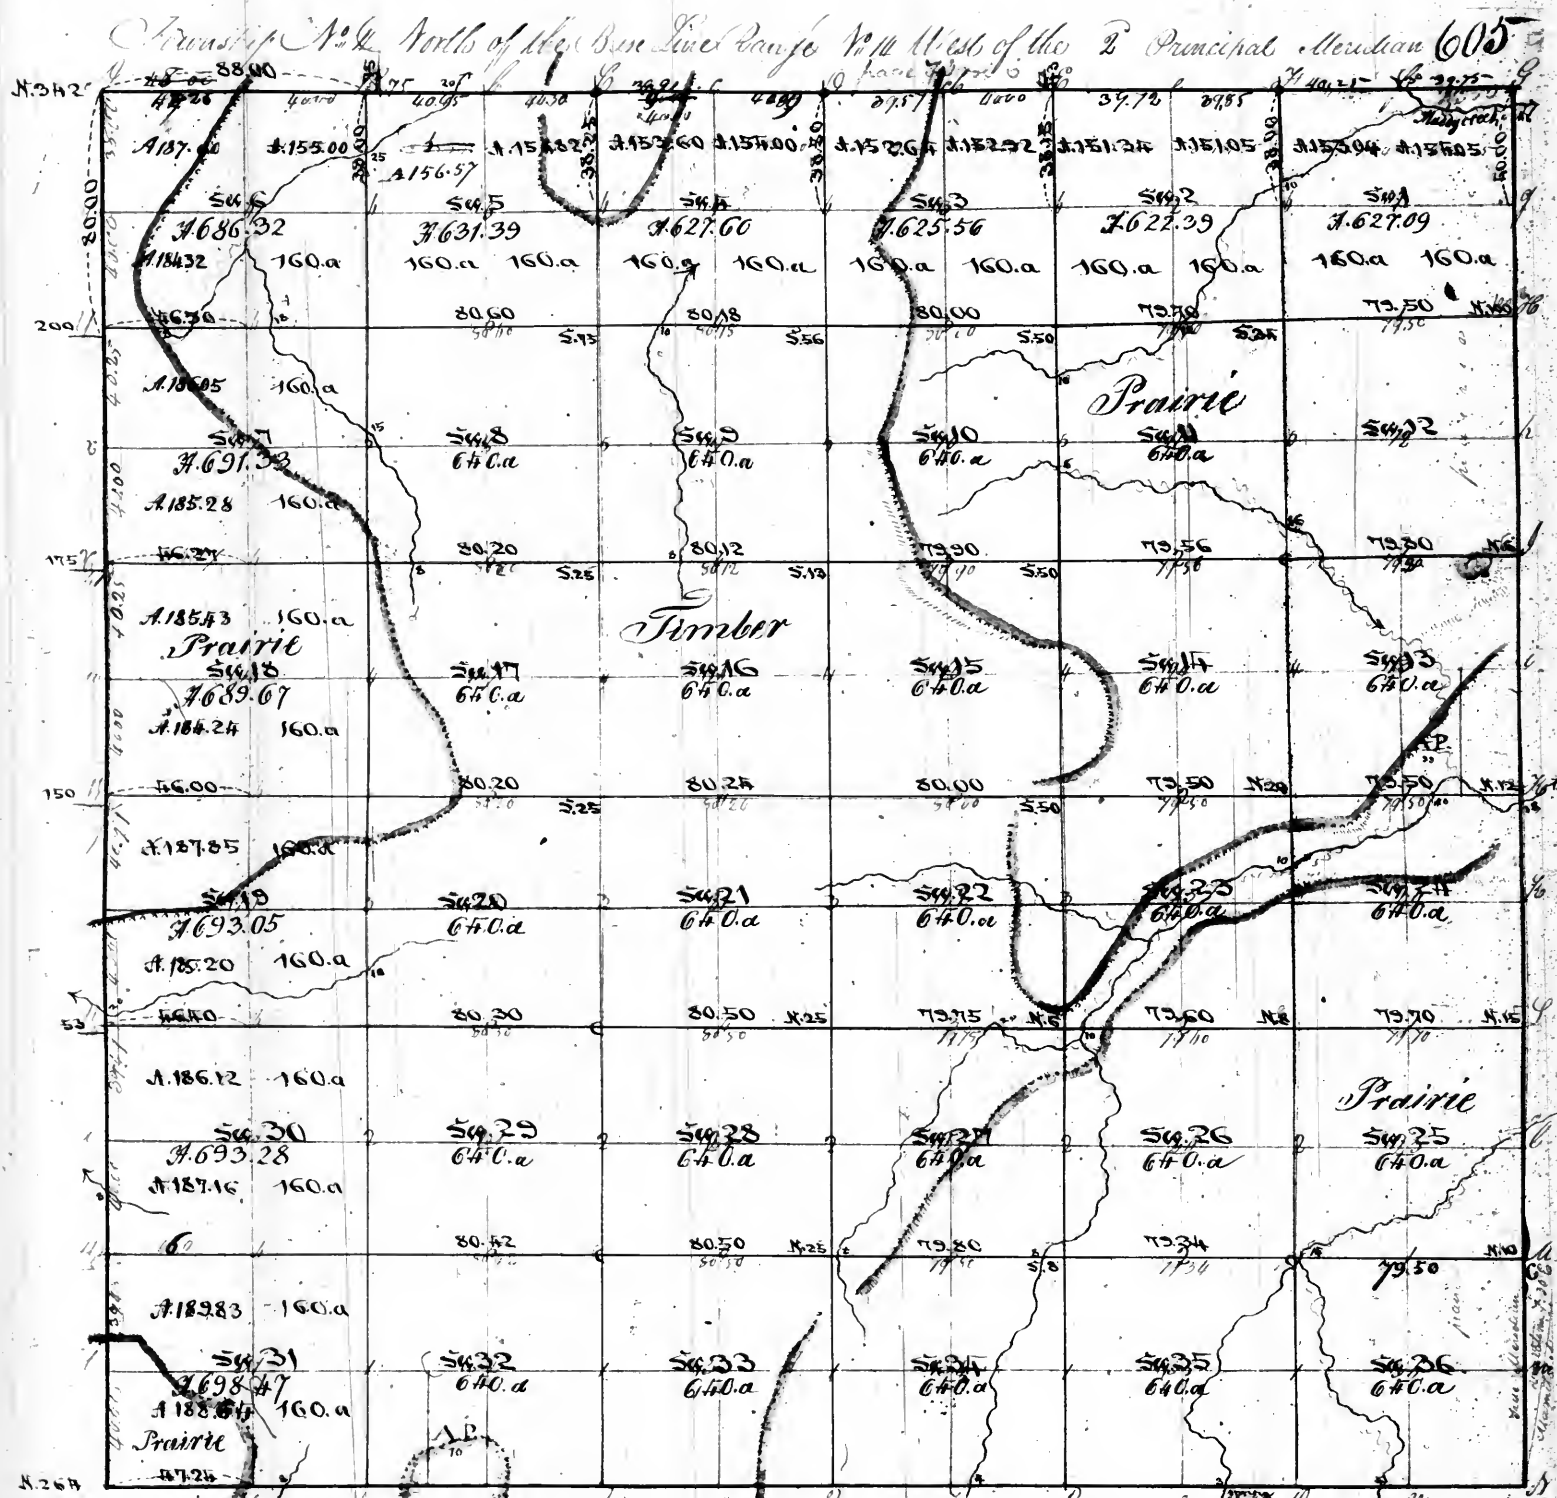


Aggregate area = 23286.15 ac


Survey of N. 1/4 181

D. Sullivan D. Sawyer

Township No. 6 North of the base line, Range No. 14 West of the 2nd principal Meridian.

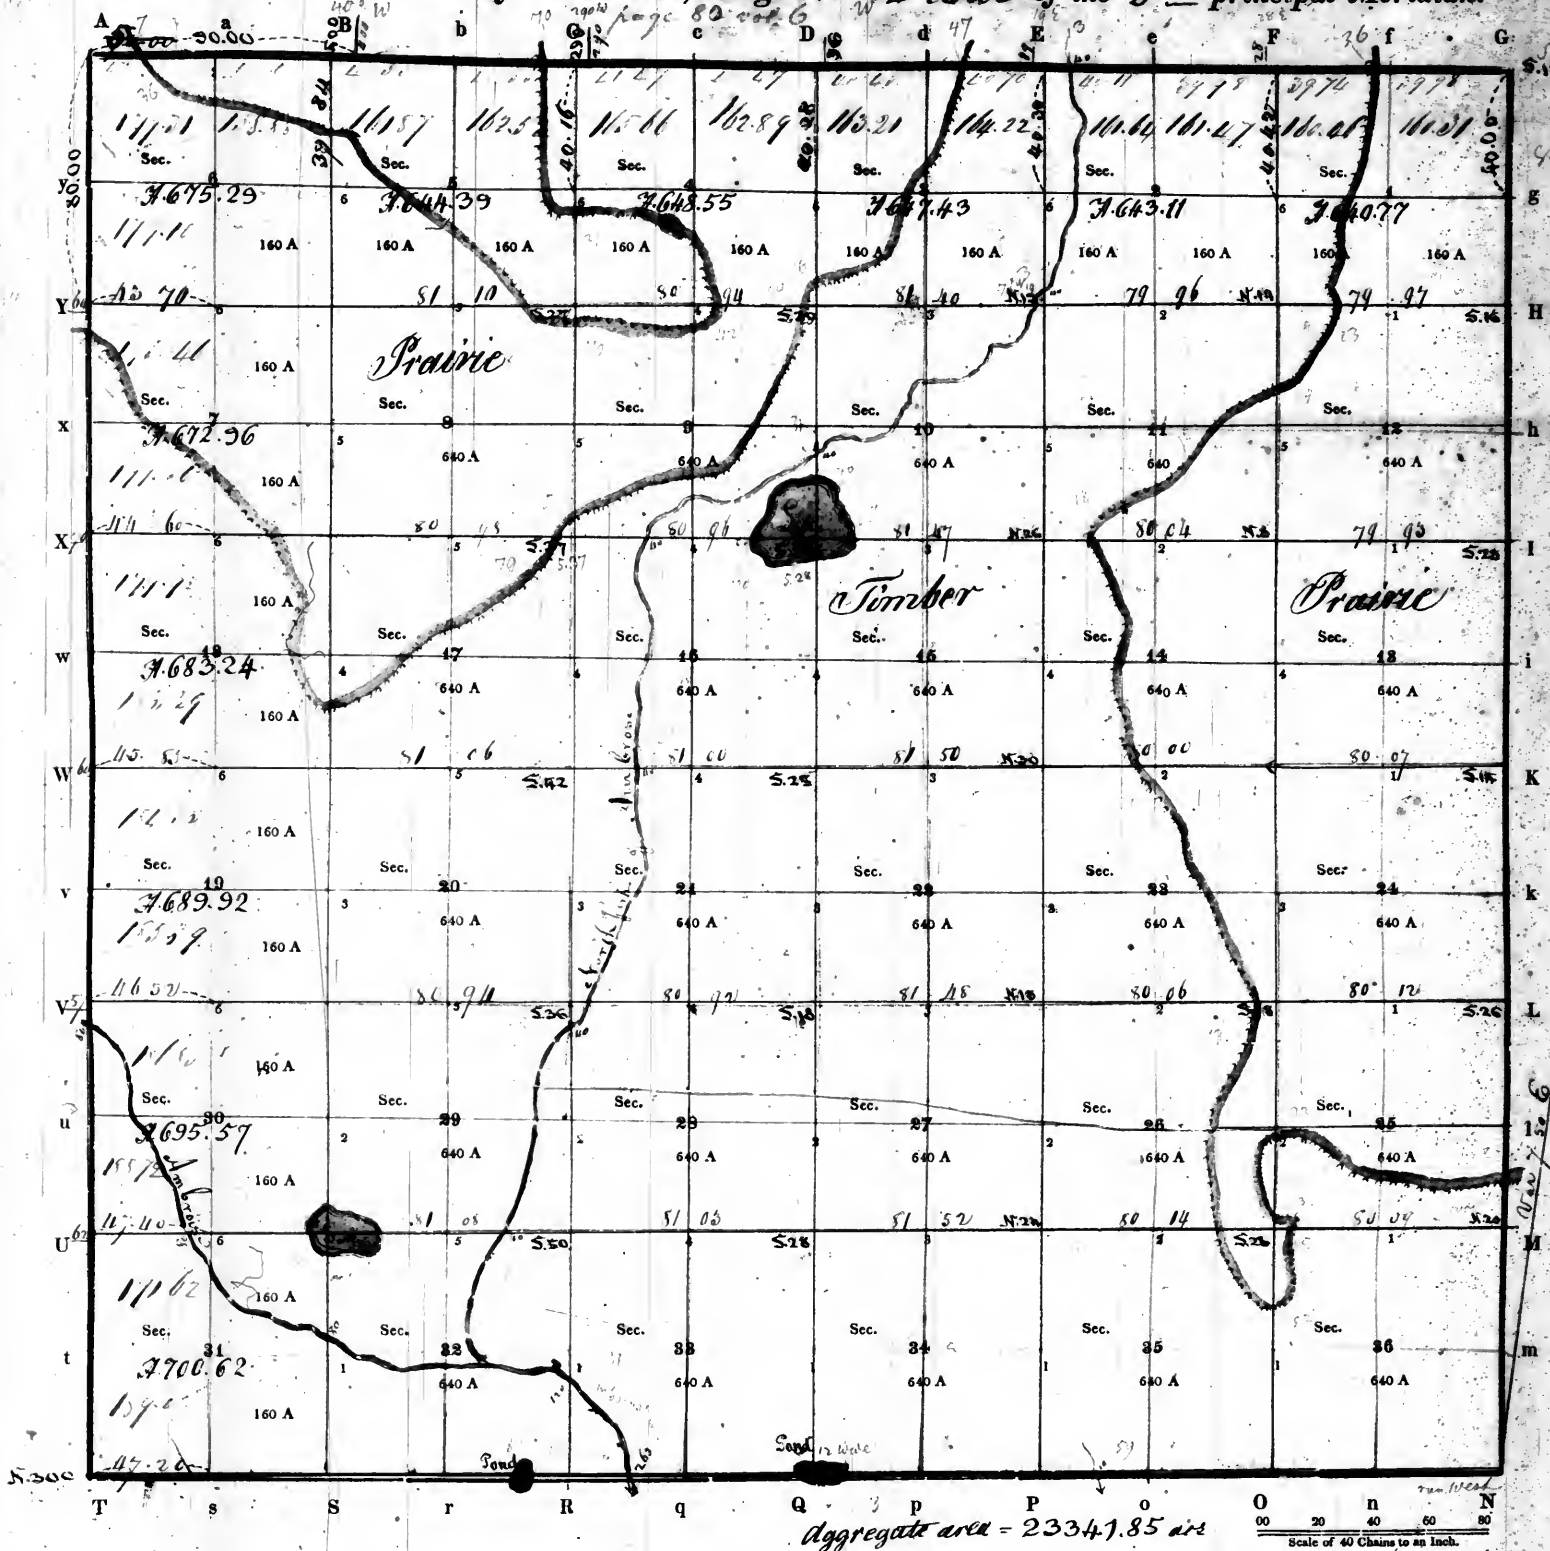

PURSUANT to a contract with, and instructions from WILLIAM RECTOR, Surveyor of the lands of the United States in the State of Illinois and Territories of Missouri and Arkansas bearing date the _____ day of _____

I have admeasured, laid out and surveyed the above described Township; and do hereby certify, that it had such marks and bounds, both natural and artificial, as are represented on said plat, and described in the field notes made thereof, and returned with this plat into the Office of the Surveyor of the lands of the United States, for the State of Illinois and Territories of Missouri and Arkansas.


Certified this _____ day of _____

EXAMINED.

D. SURVEYOR.

Notarially attested & attested 15th

Township No. 7 North of the base line, Range No. 14 West of the 2nd principal Meridian.

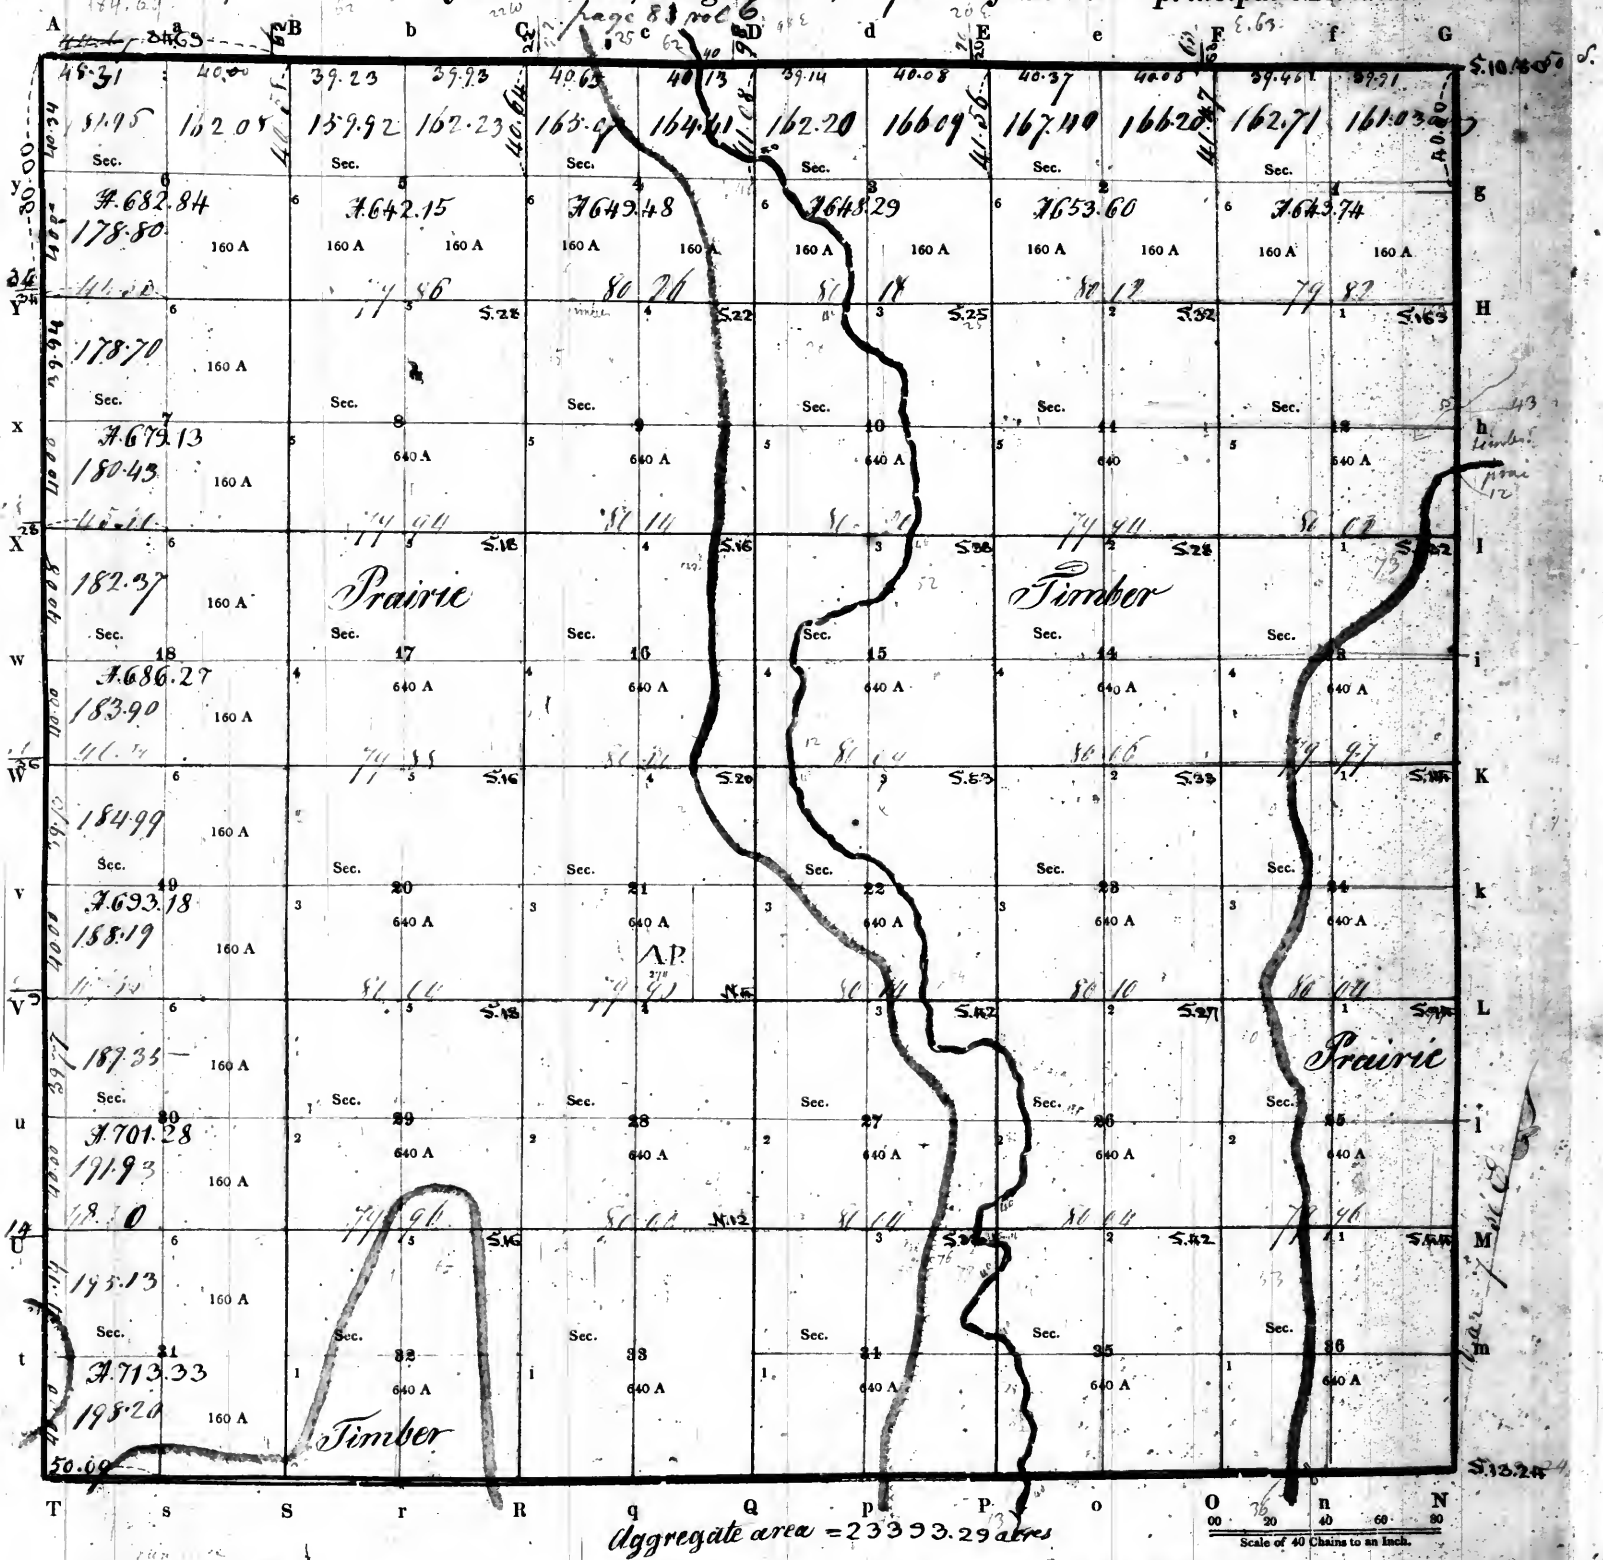

PURSUANT to a contract with, and instructions from WILLIAM RECTOR, Surveyor of the lands of the United States in the State of Illinois and Territories of Missouri and Arkansas bearing date the day of


I have admeasured, laid out and surveyed the above described Township; and do hereby certify, that it had such marks and bounds, both natural and artificial, as are represented on said plat, and described in the field notes made thereof, and returned with this plat into the Office of the Surveyor of the lands of the United States, for the State of Illinois and Territories of Missouri and Arkansas

Certified this day of

EXAMINED.

D. SURVEYOR.

Township No. ³¹ North of the base line, Range No. 14 West of the 2nd principal Meridian.

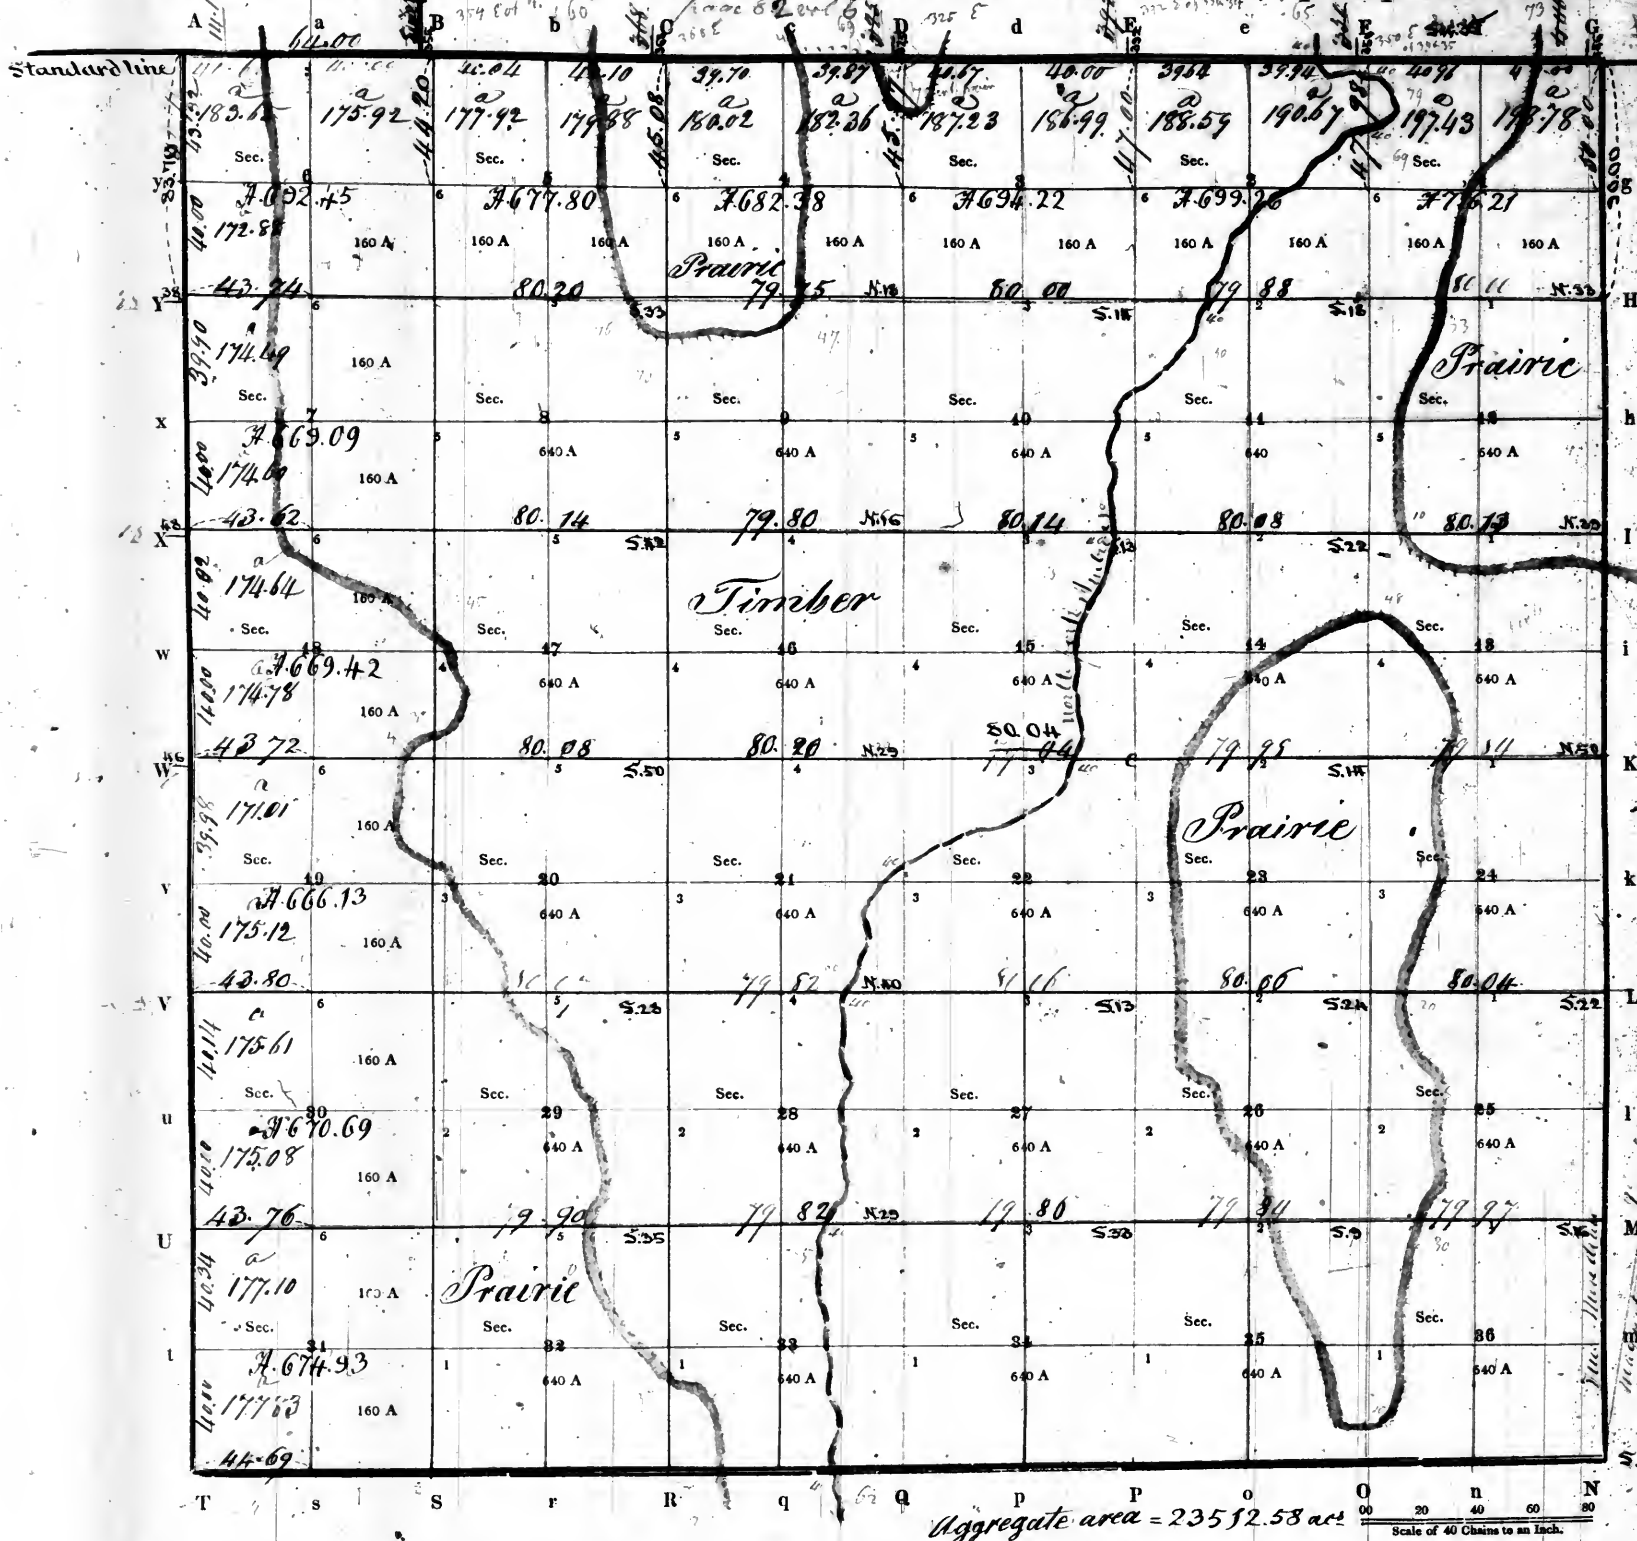

PURSUANT to a contract with, and instructions from WILLIAM RECTOR, Surveyor of the lands of the United States in the State of Illinois, bearing date the 10th day of


I have admeasured, laid out and surveyed the above described Township; and do hereby certify, that it had such marks and bounds, both natural and artificial, as are represented on said plat, and described in the field notes made thereof, and returned with this plat into the Office of the Surveyor of the lands of the United States, for the *State of Illinois and Territories of Michigan and Arkansas*

Certified this day of

EXAMINED.

D. SURVEYOR

Township No. Nine North of the base line, Range No. 14 West of the second principal Meridian.

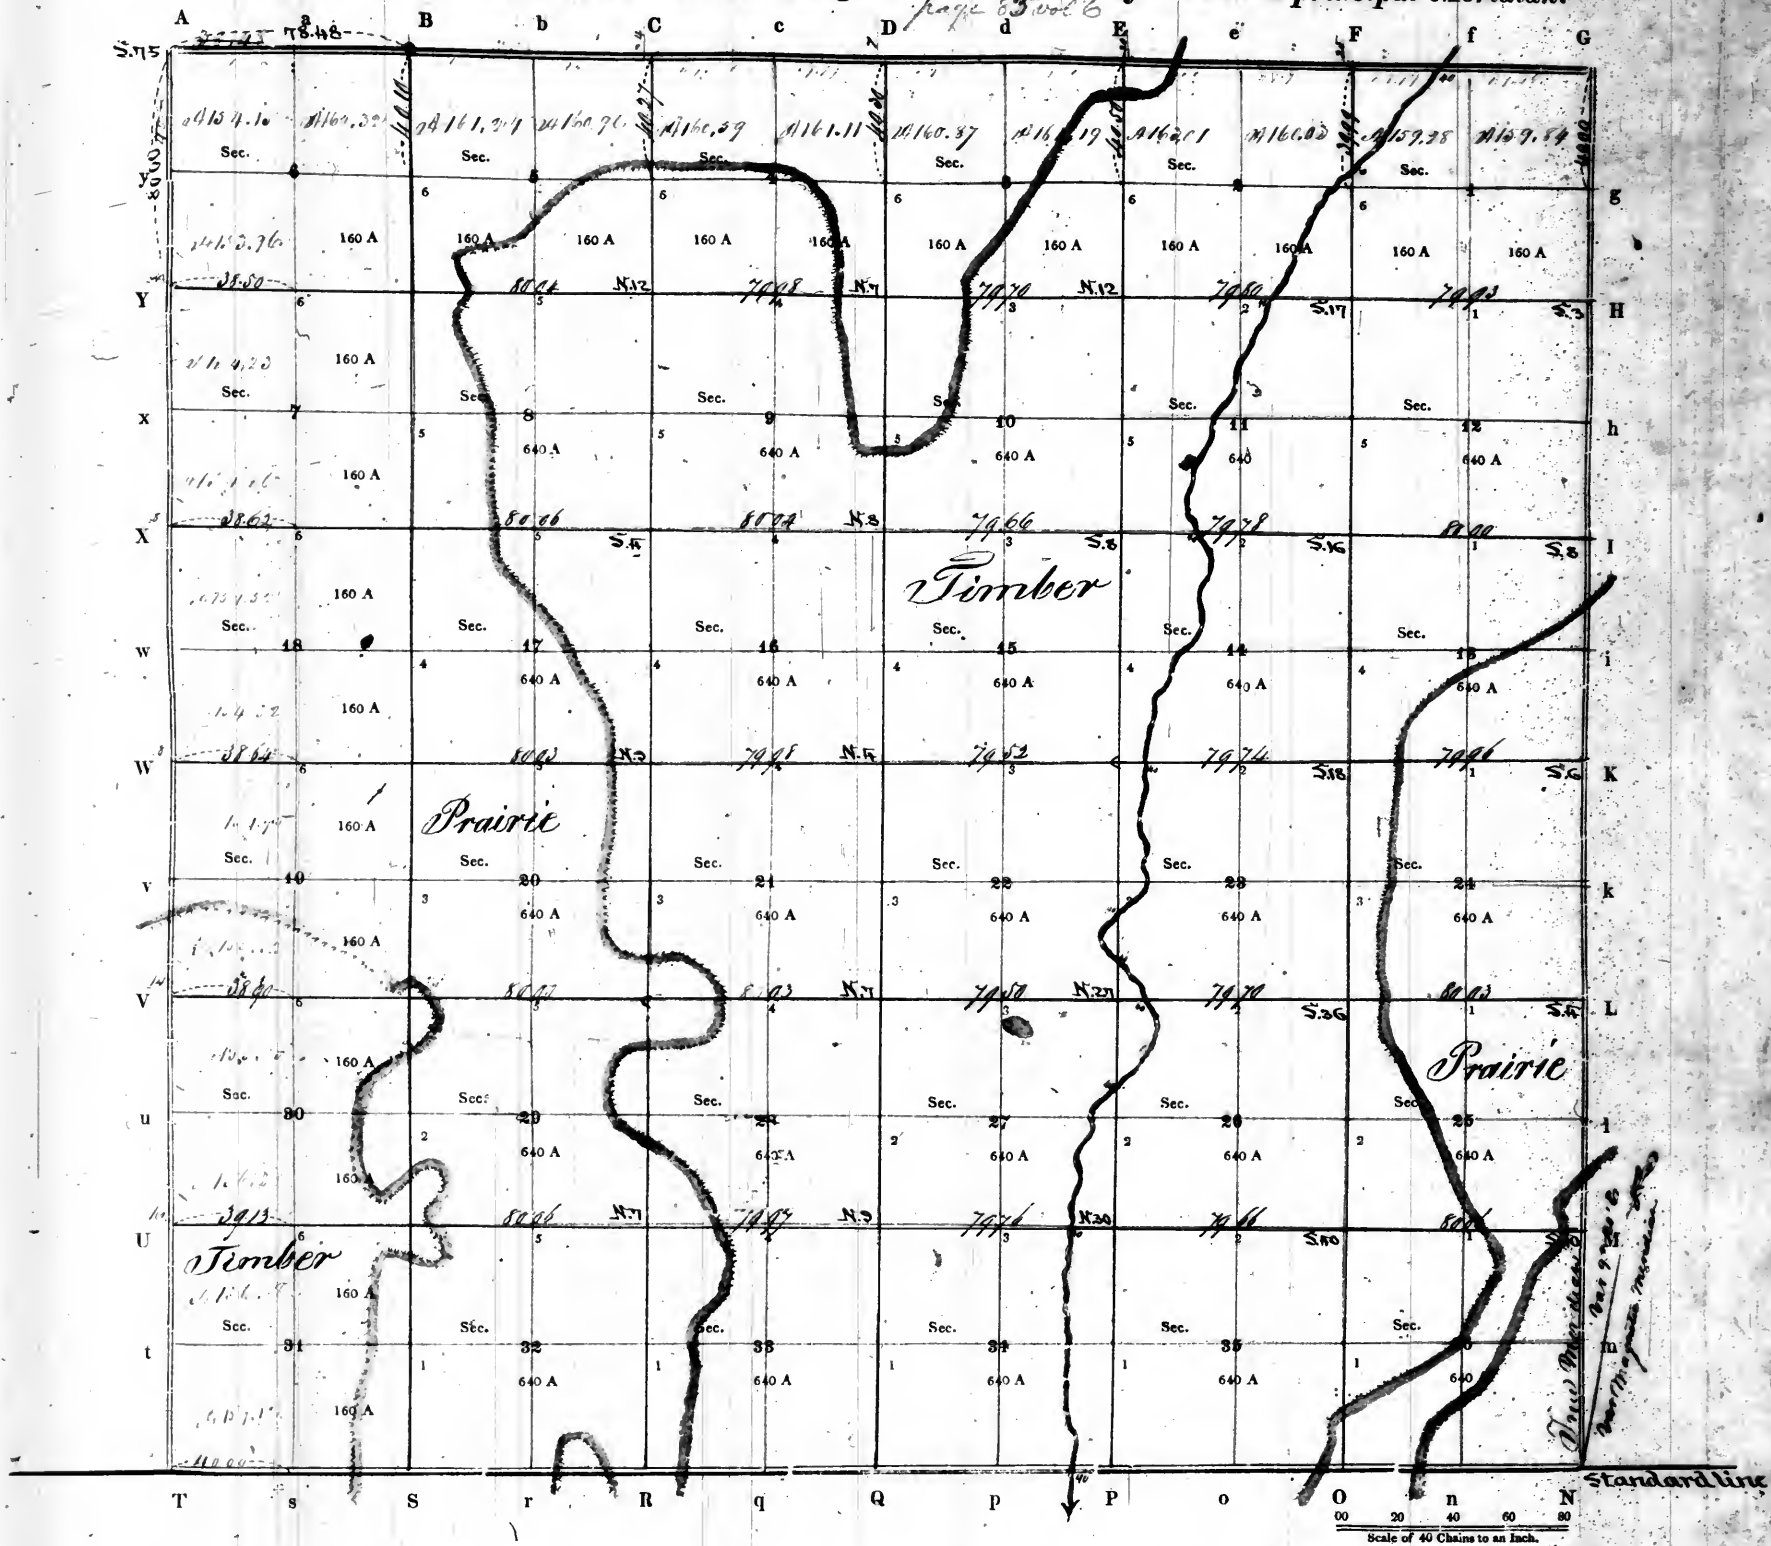

PURSUANT to a contract with, and instructions from WILLIAM RECTOR, Surveyor of the lands of the United States in the *State of Illinois*
and *Territories of Missouri and Arkansas* bearing date the _____ day of _____

I have admeasured, laid out and surveyed the above described Township; and do hereby certify, that it had such marks and bounds, both natural and artificial, as are represented on said plat, and described in the field notes made thereof, and returned with this plat into the Office of the Surveyor of the lands of the United States, for the *State of Illinois and territories of Missouri & Arkansas*


Certified this _____ day of _____

EXAMINED.

D. SURVEYOR

August 1820

Township No. 16 North of the base line, Range No. 14 West of the second principal Meridian.

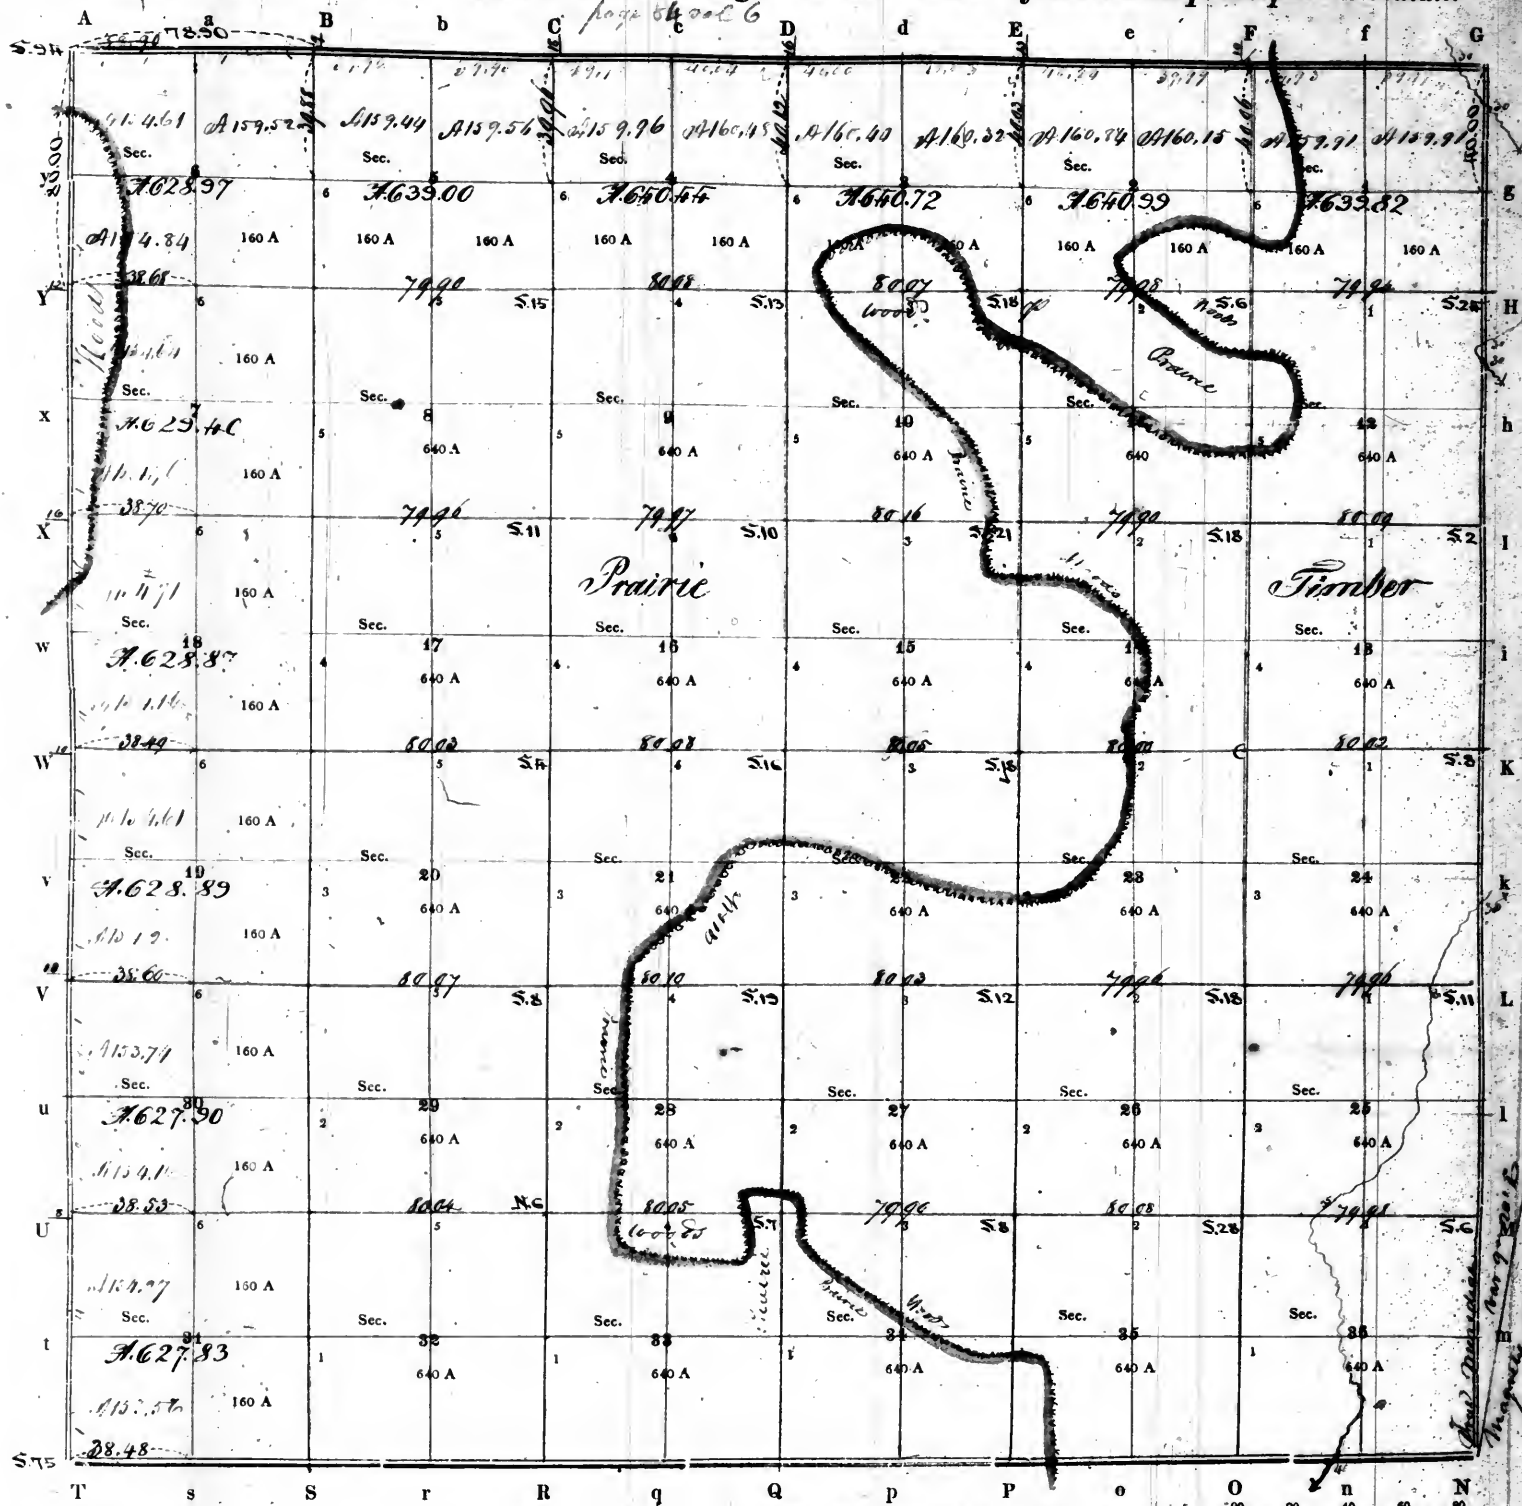

Aggregate area = 22972.83 acres.

Scale of 40 Chains to an Inch.

PURSUANT to a contract with, and instructions from WILLIAM RECTOR, Surveyor of the lands of the United States in the State of Illinois and Territory of Missouri and Arkansas — bearing date the _____ day of _____

I have admeasured, laid out and surveyed the above described Township; and do hereby certify, that it had such marks and bounds, both natural and artificial, as are represented on said plat, and described in the field notes made thereof, and returned with this plat into the Office of the Surveyor of the lands of the United States, for the State of Illinois and Territory of Missouri and Arkansas.


Certified this _____ day of _____

EXAMINED.

D. SURVEYOR

August 1820


Township No. 11 North of the base line, Range No. 14 West of the 2nd principal Meridian.

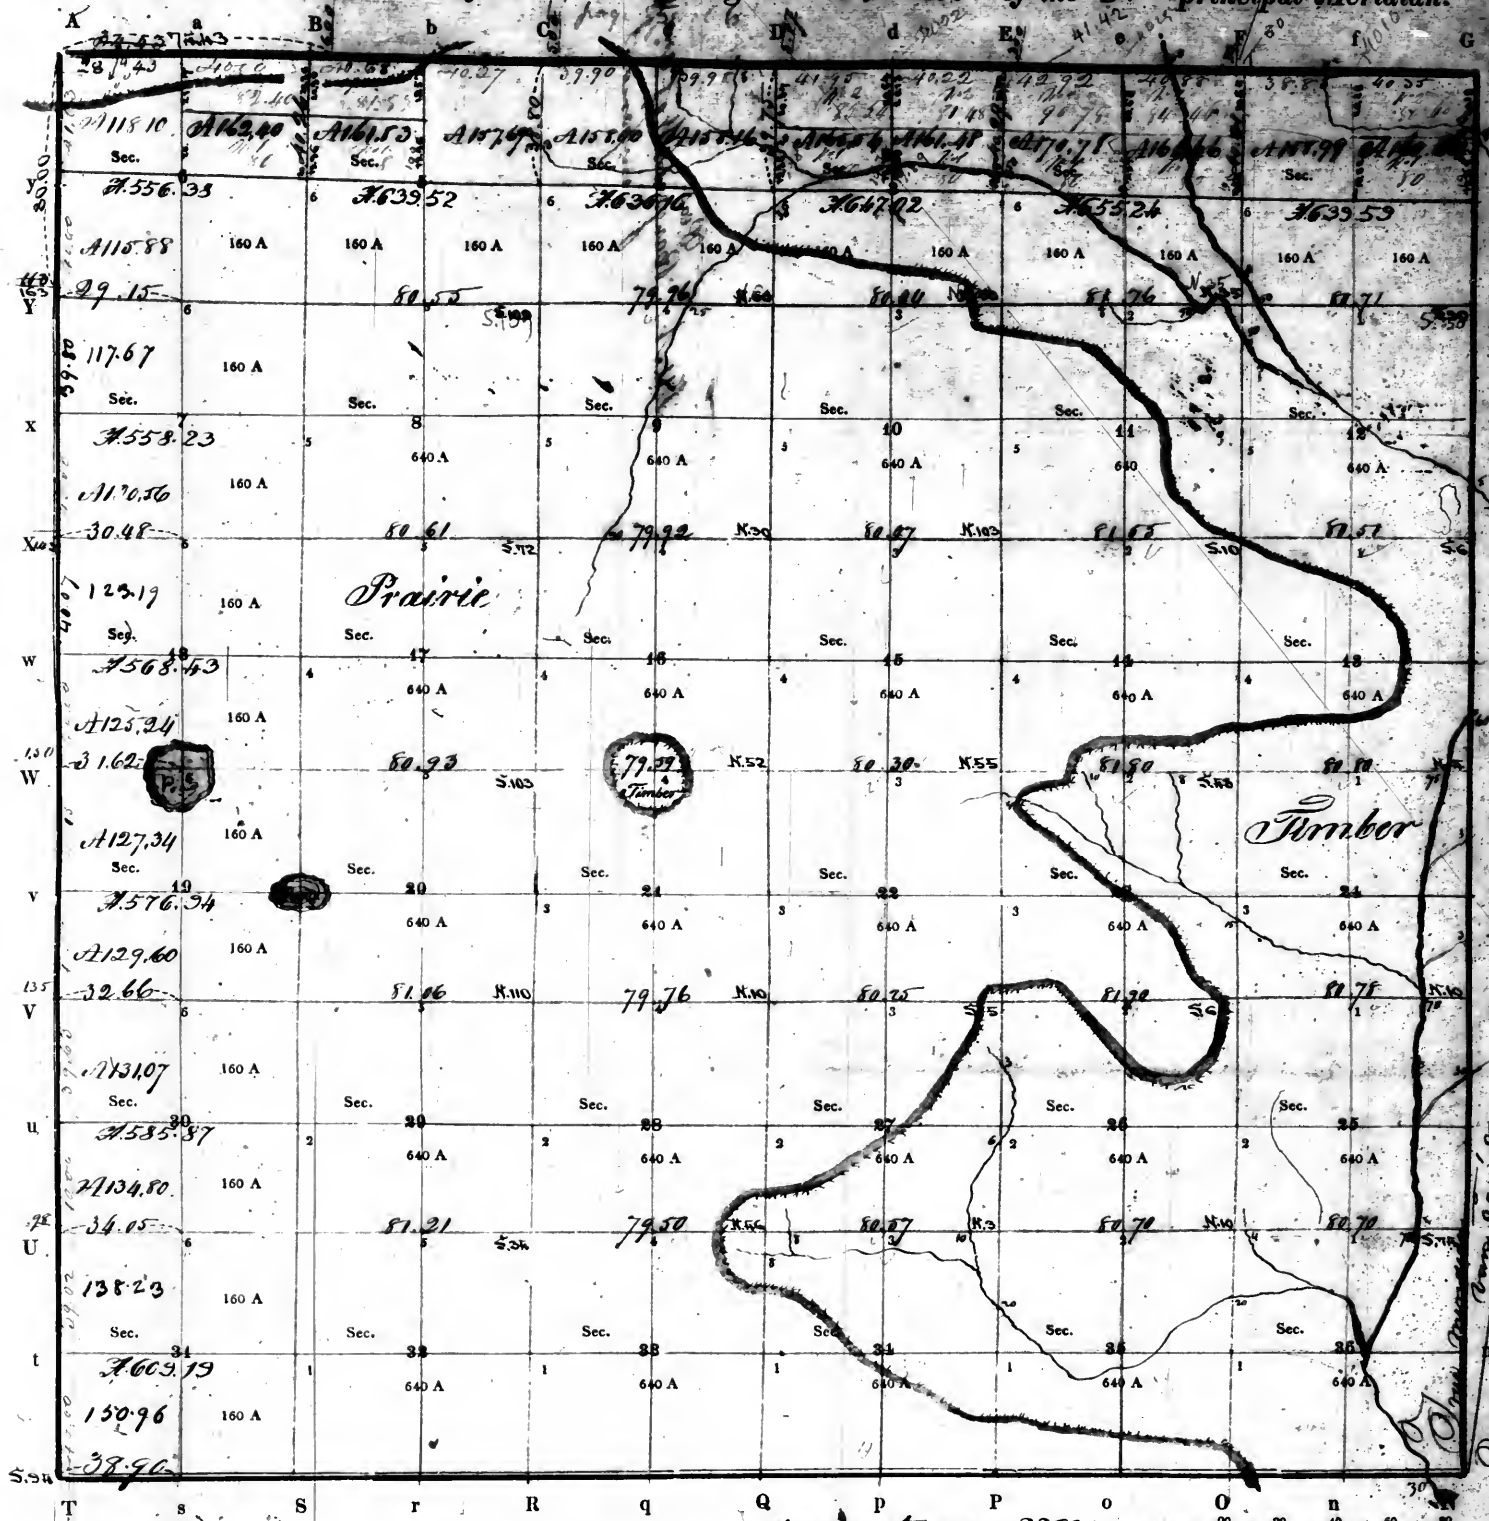

PURSUANT to a contract with, and instructions from WILLIAM RECTOR, Surveyor of the lands of the United States in the *State of Illinois*
 I have admeasured, laid out and surveyed the above described Township; and do hereby certify, that it had such marks and bounds, both natural
 and artificial, as are represented on said plat, and described in the field notes made thereof, and returned with this plat into the Office of the Sur-
 veyor of the lands of United States, for the *State of Illinois and Wisconsin and Territory of Arkansas*
 Certified this *10* day of *September* 1821

Wm R. Thriston D. SURVEYOR

Township N. 12. North of the Base line Range N. 14 West of the principal Meridian.
page 86 vol. 6

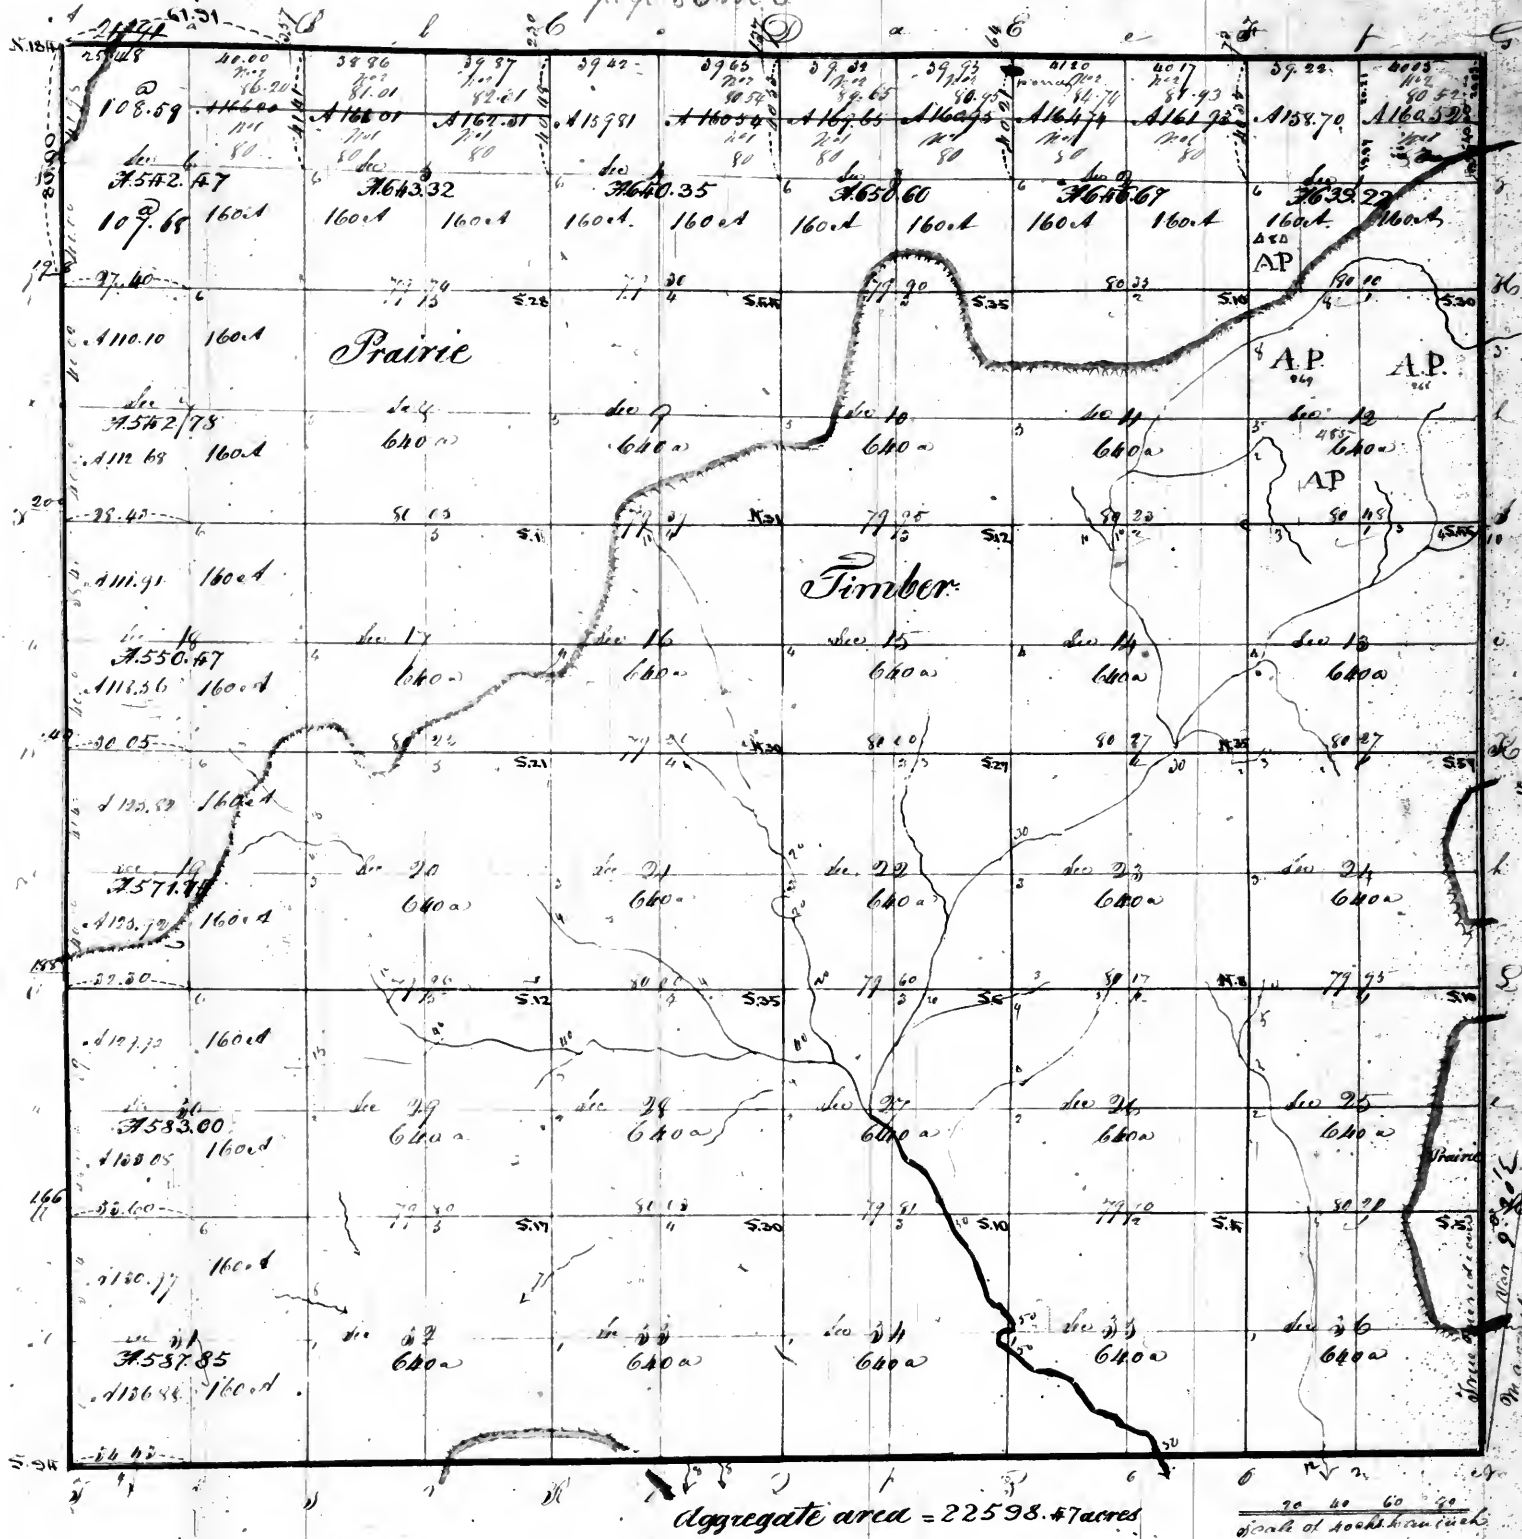


Examined


J. W. Throckmorton Surveyor

Township No. 15 North

of the base line, Range No. 14 West

of the 2^d

principal Meridian.

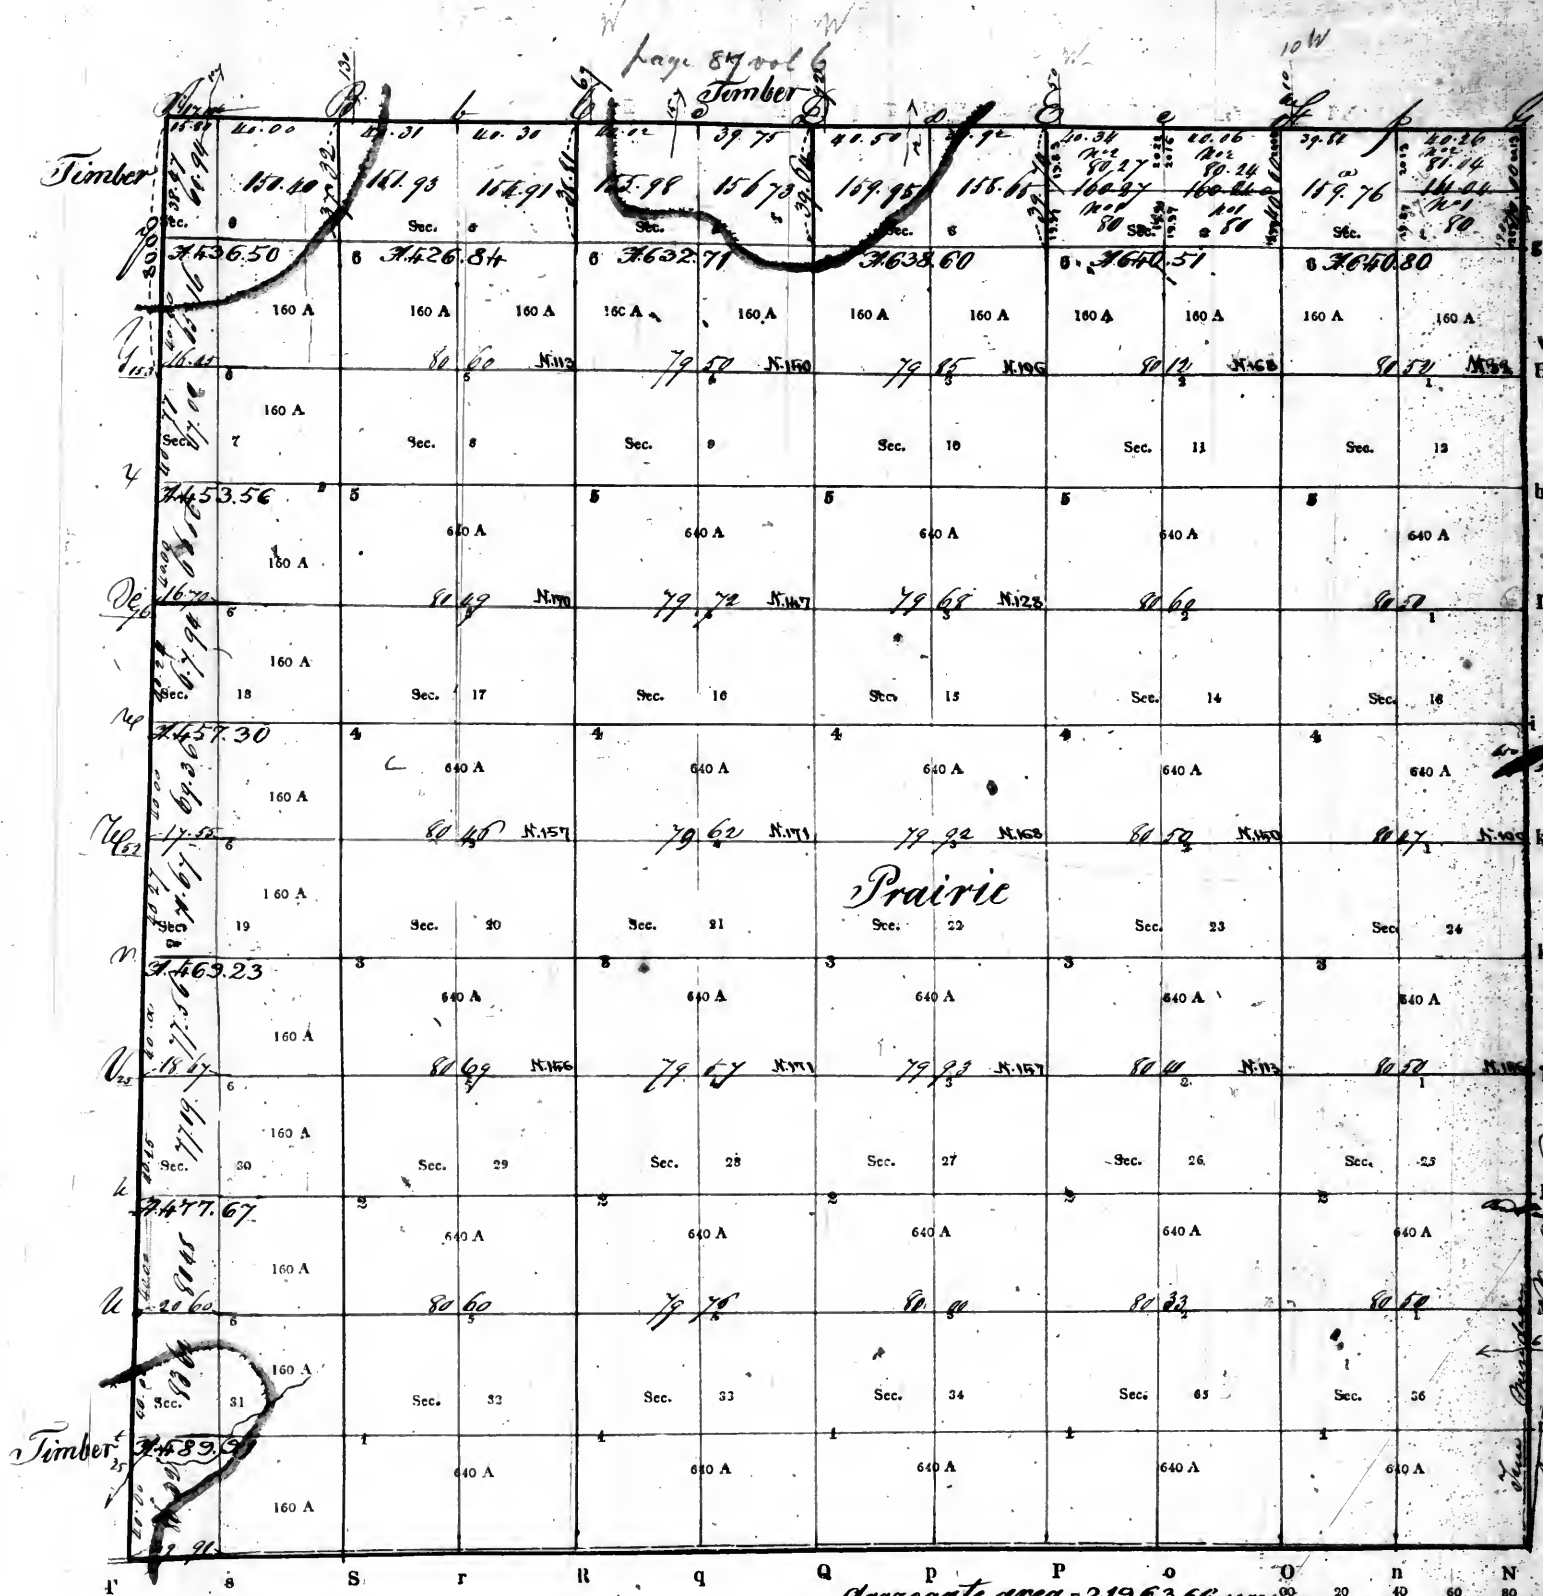




Certified this 28th day of July 1821

EXAMINED.

Martin Jones D. SURVEYOR.

Township N. 111 North of the Base line Range N. 14 West of the 2^d principal Meridian

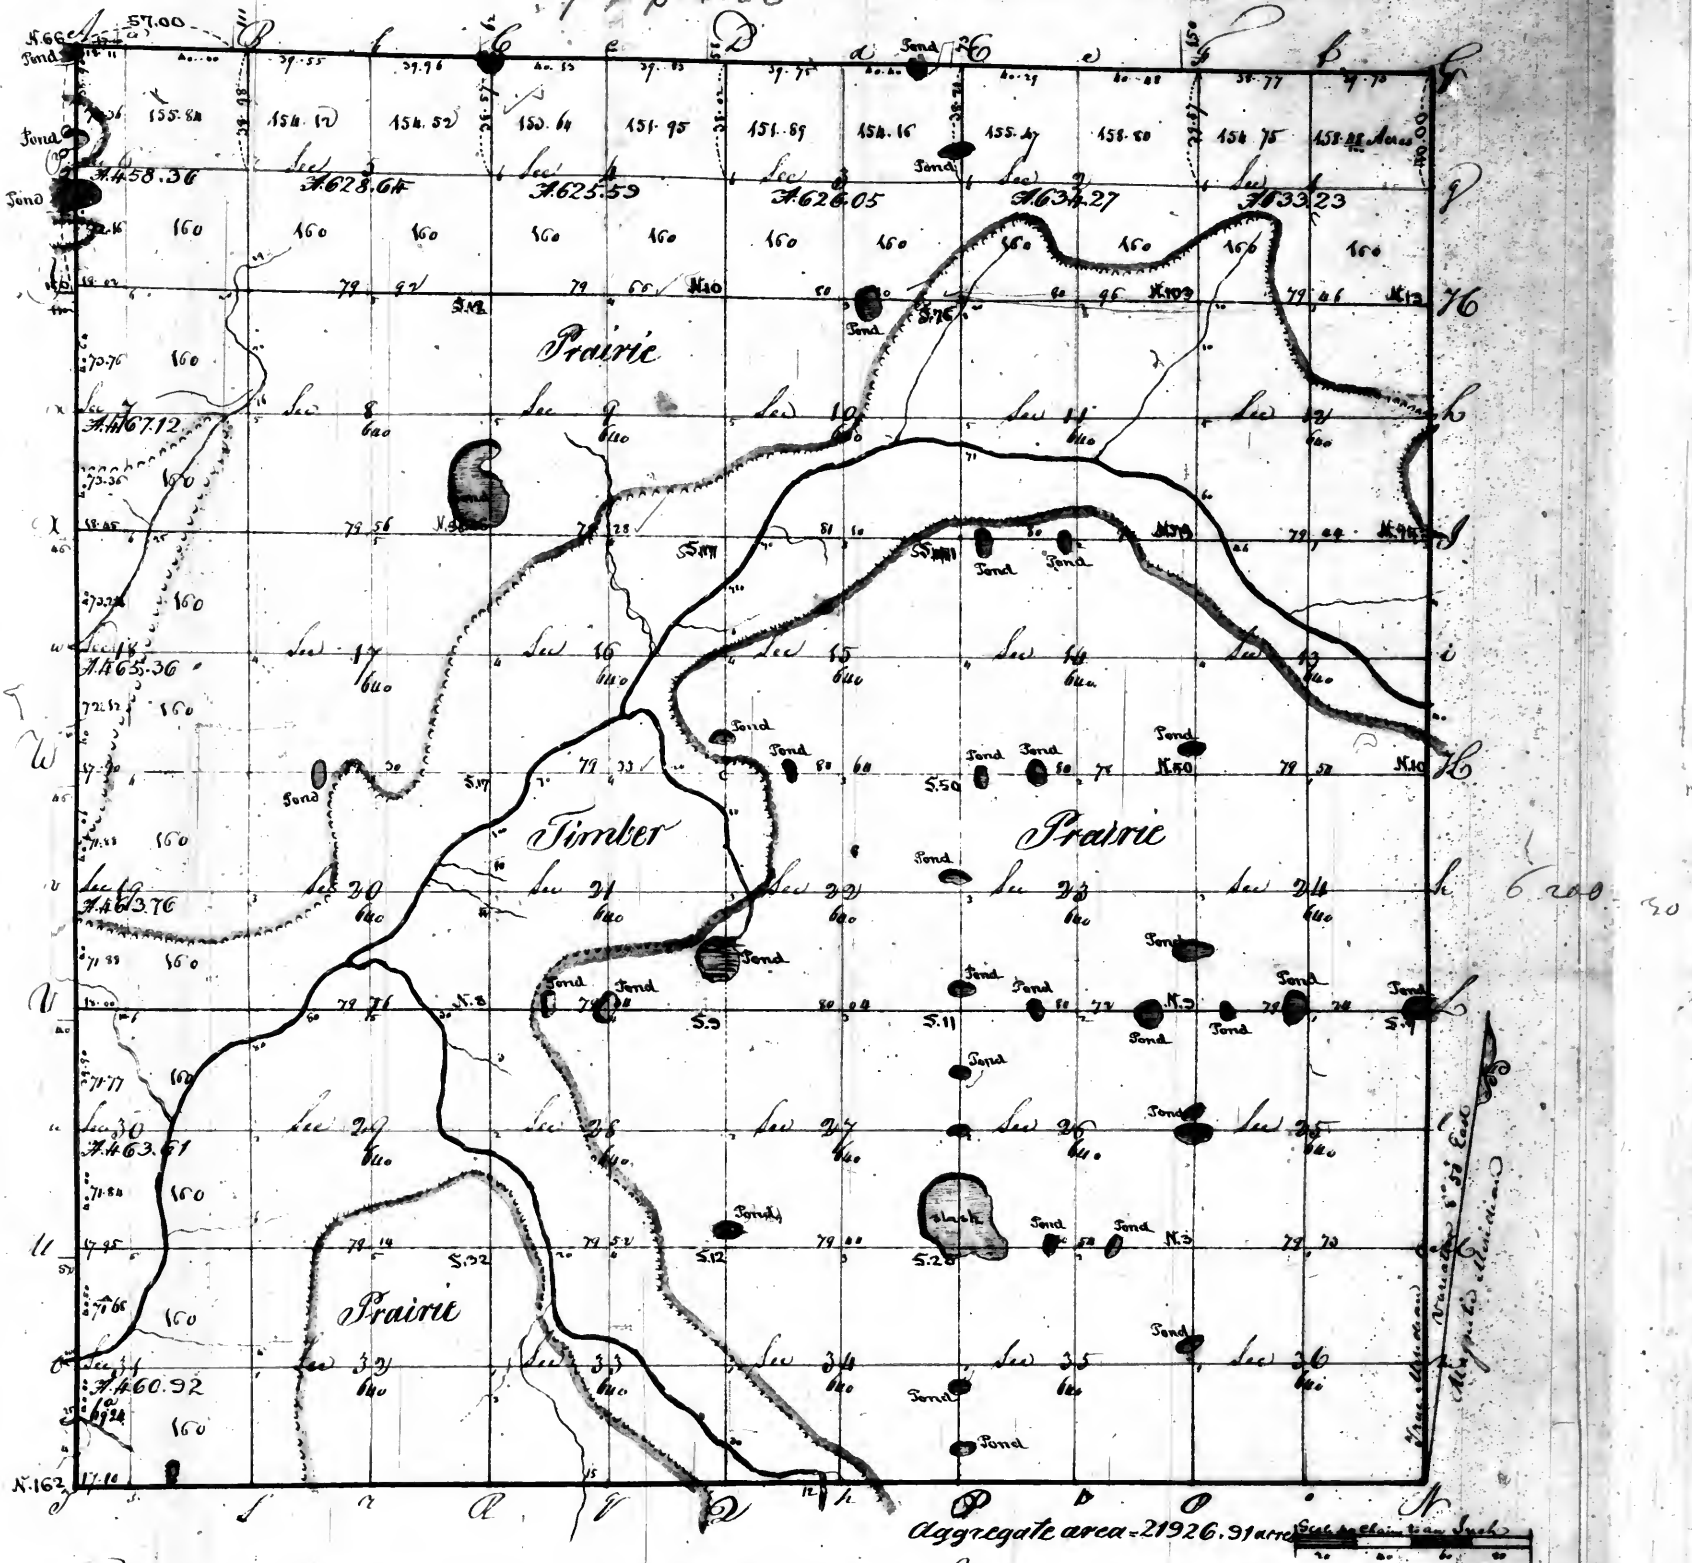





J. D. West Surveyor

Township N. 15 South of the Base line Range N. 10 West of the 2nd principal Meridian

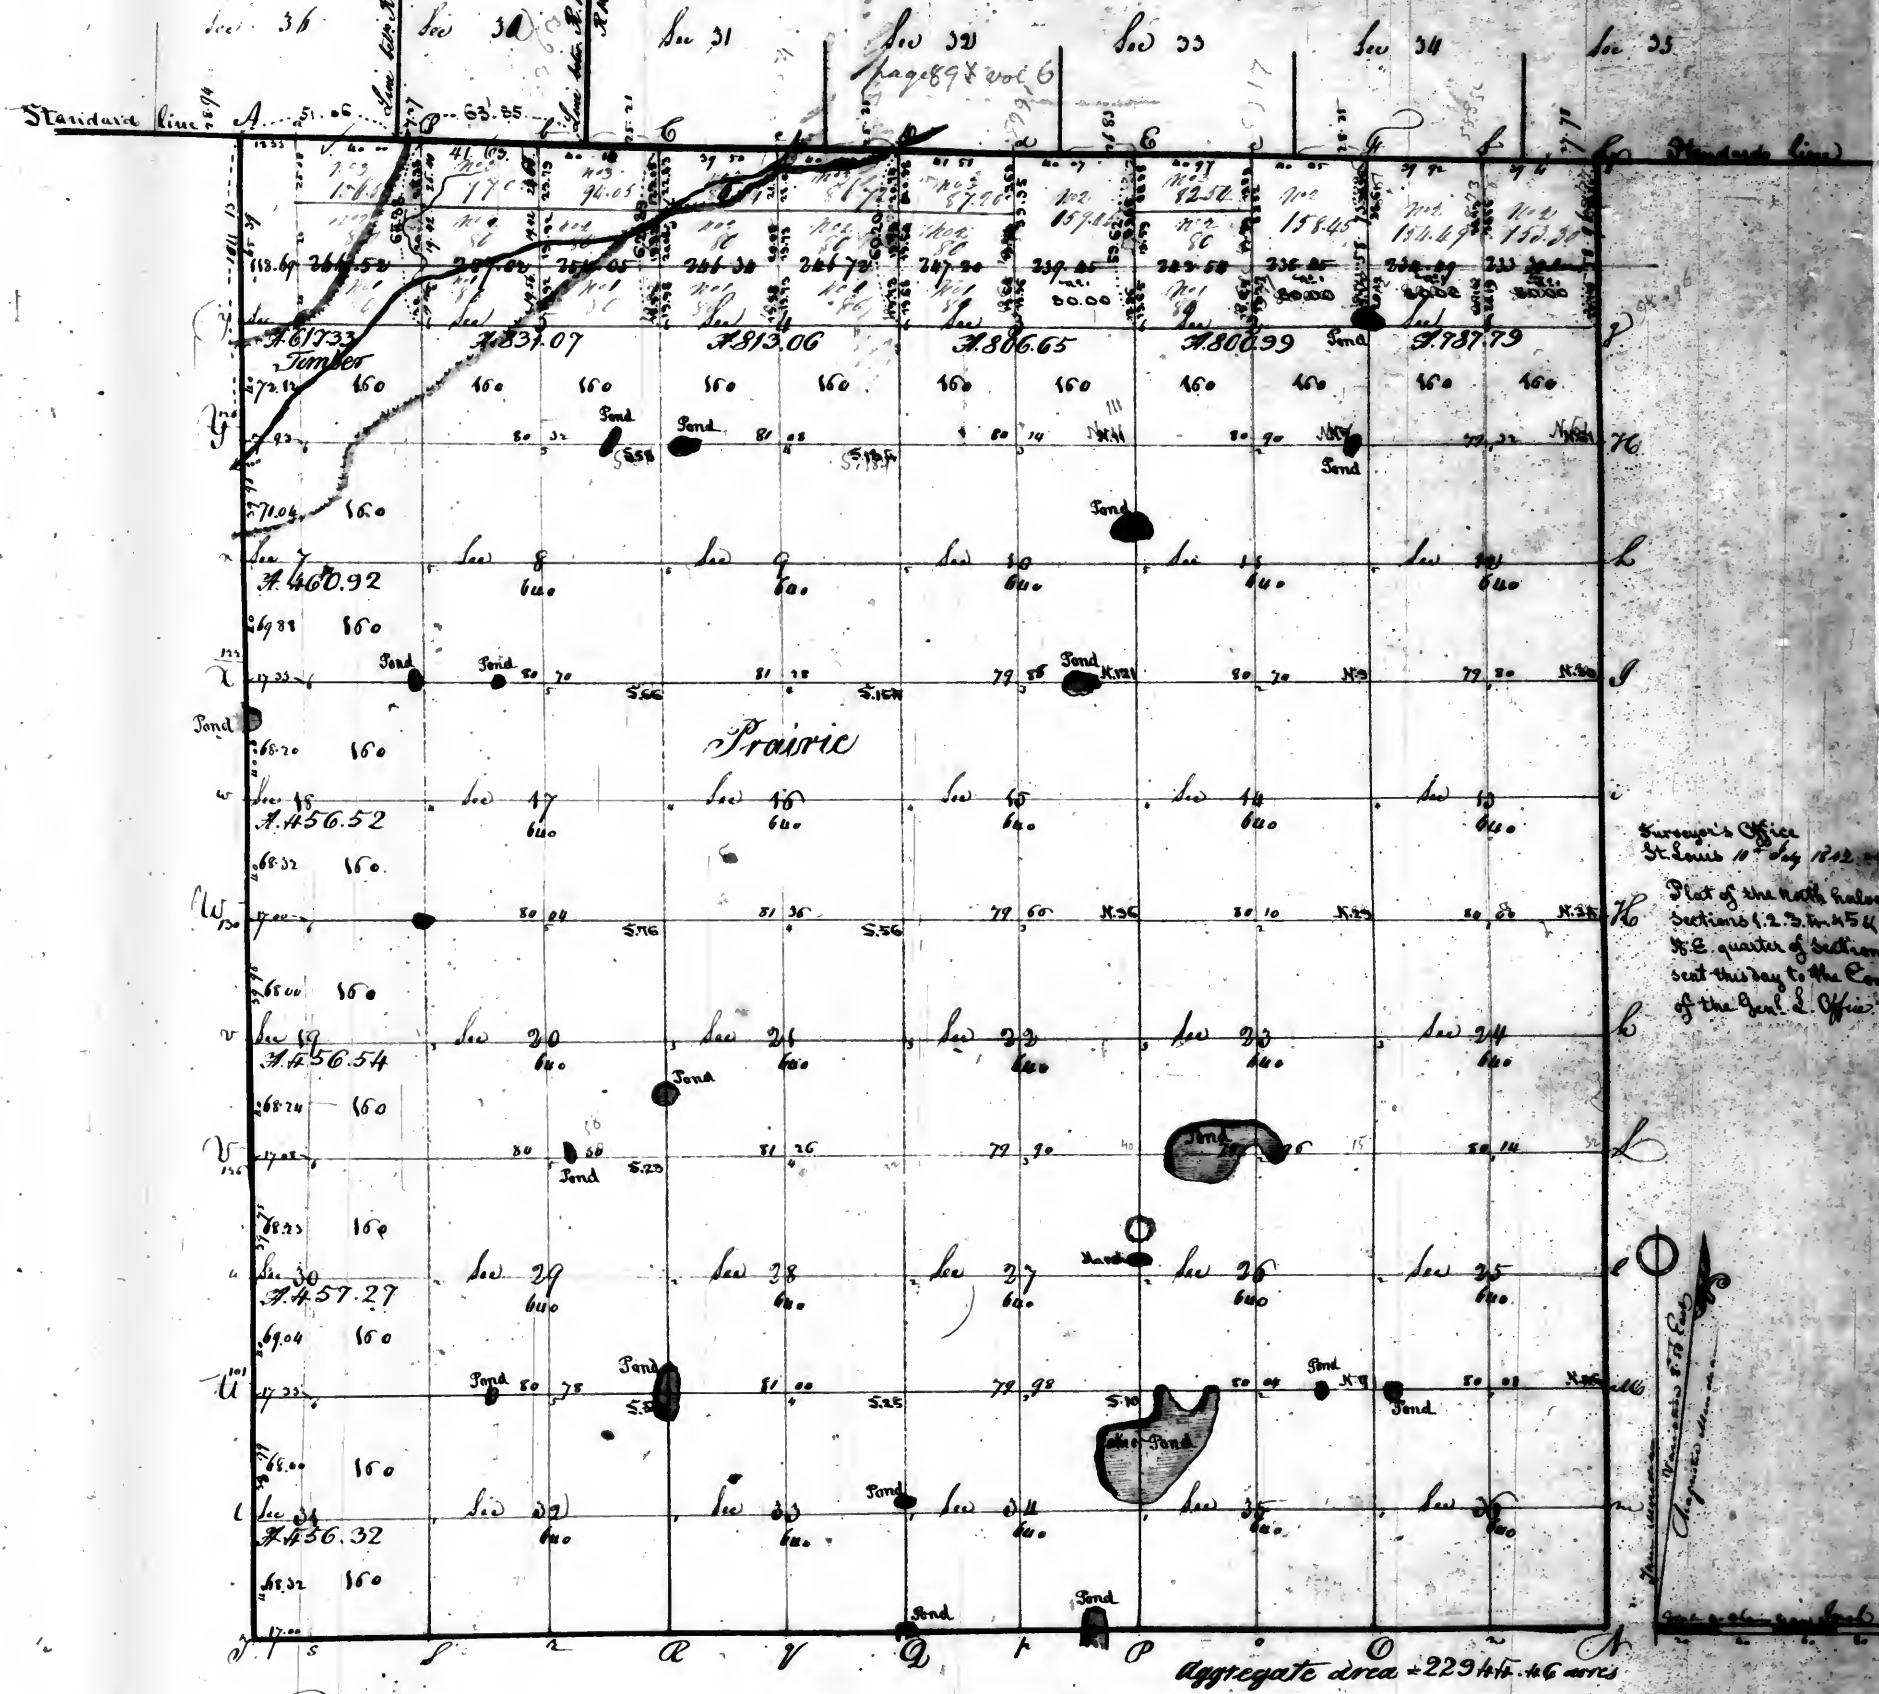


Pursuant to a Contract with and instructions from William B. Rector Surveyor of the lands of the United States for the States of Illinois, Missouri and Territory of Arkansas bearing date the 4th day of April 1821. I have accompanied said land and surveyor to above described Township and do hereby certify that it had such marks and bounds both natural and artificial as are represented on said plat and described in the field notes made then and returned with this plat into the Office of the Surveyor of the lands of the United States for the States of Illinois, Missouri and Territory of Arkansas

Given 15th July 1822

John R. Potter Surveyor

Township N. 16 North of the Base line. Range N. 14 West of the principal Meridian 616.

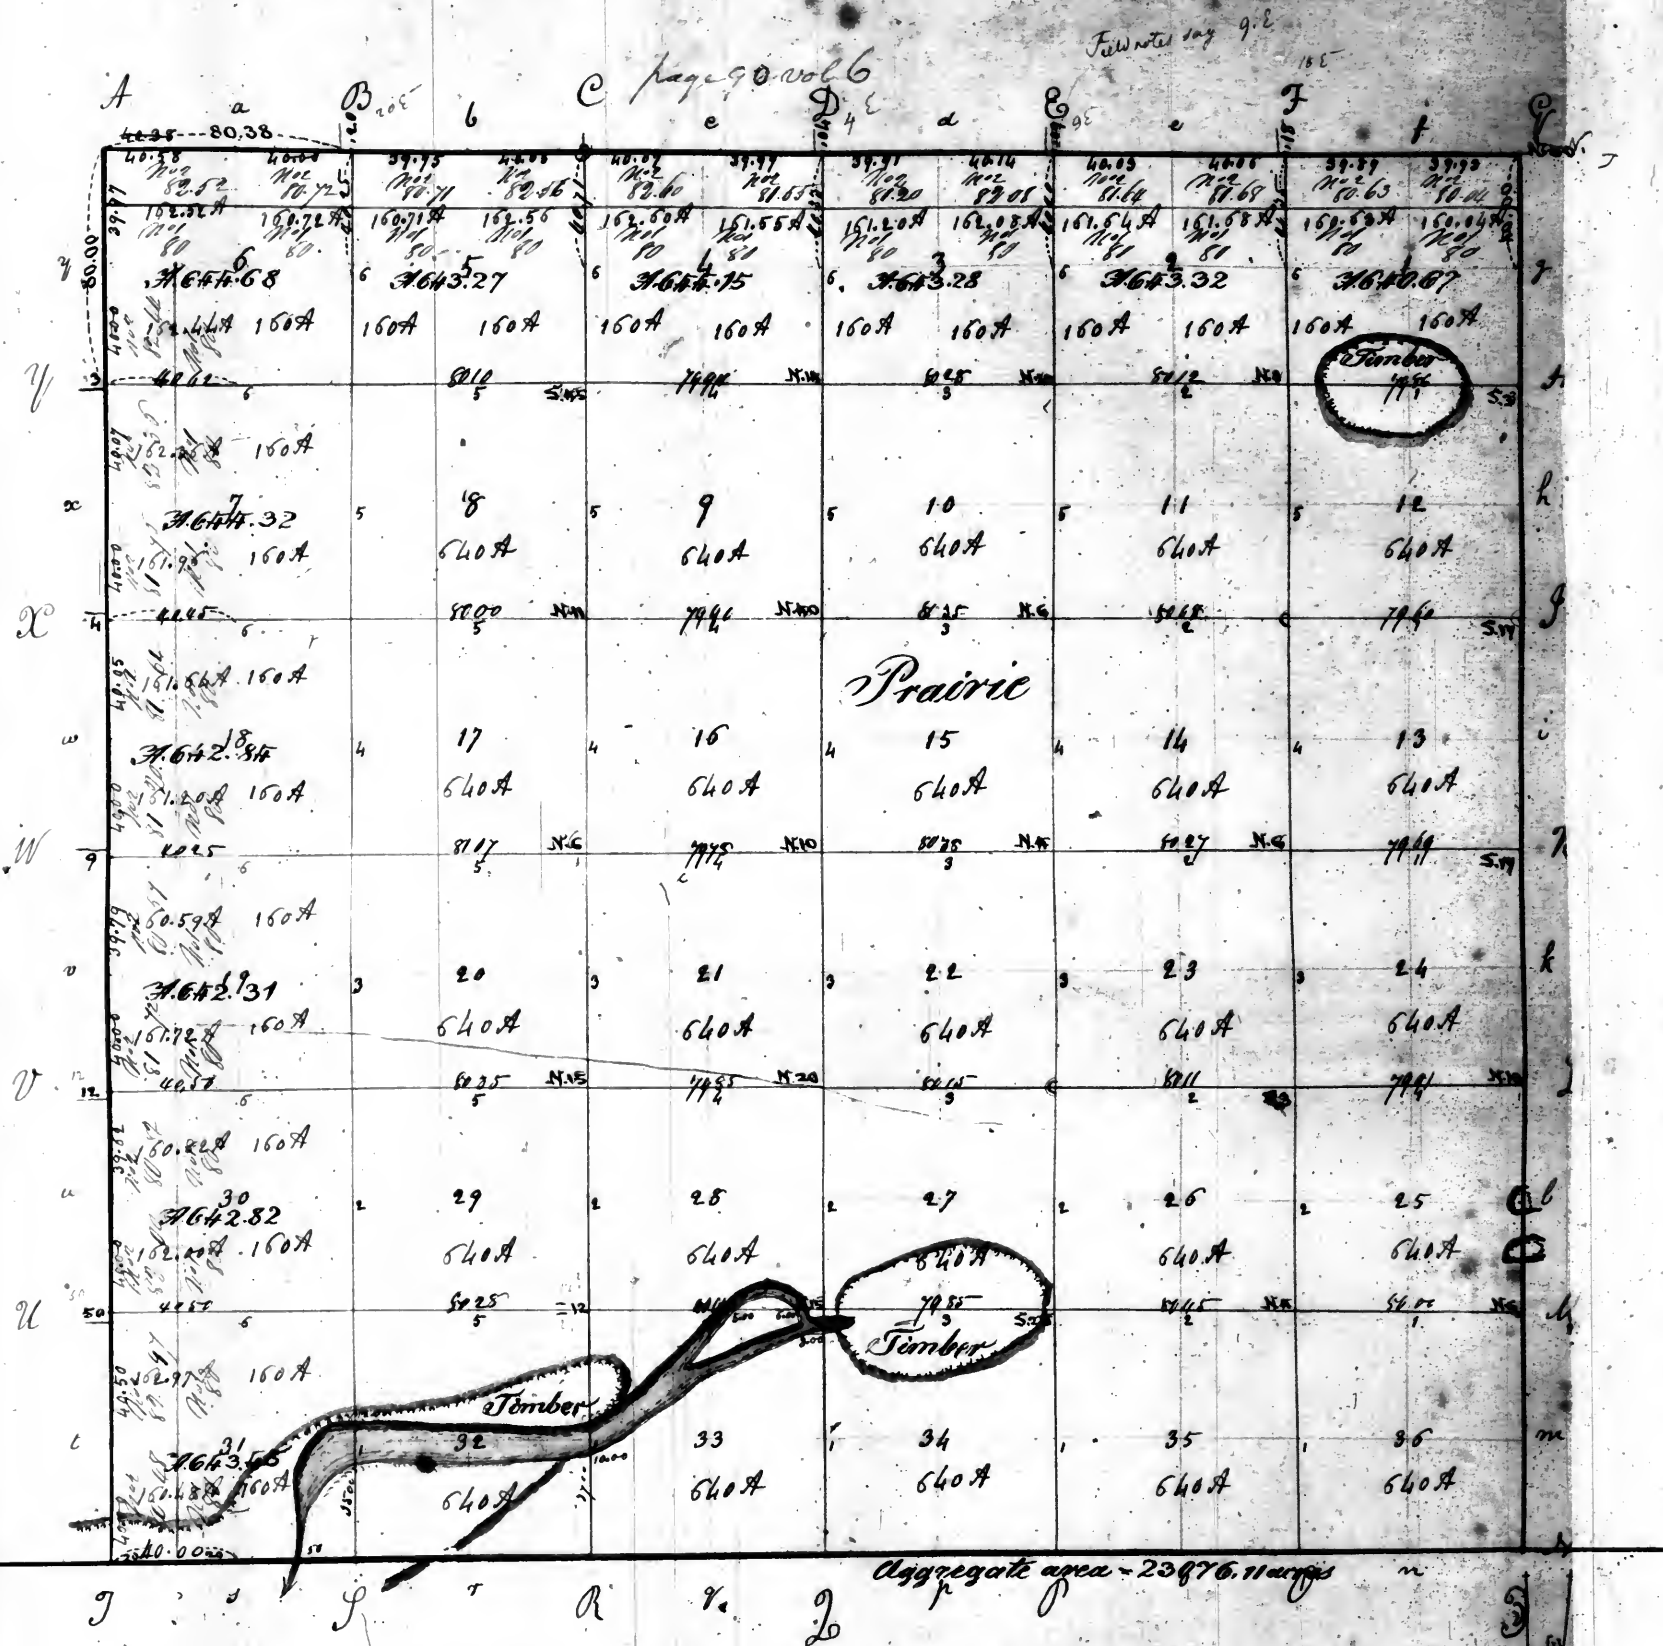

Pursuant to a contract with, and instructions from William Reector Surveyor of the lands of the United States in the state of Illinois and Territories of Missouri and Arkansas, bearing date the ninth day of March 1821, I have measured, laid out and surveyed the above described Township; and do hereby certify, that it had such marks and bounds, both natural and artificial, as are represented on said plat, and described in the field notes made thereof, and returned with this plat into the Office of the Surveyor of the lands of the United States for the State of Illinois and Territories of Missouri and Arkansas

Certified this 25th August 182


James Thompson, D. Sur.

Scale 40 Chs. per. Inch

Township No. 17 North of the Base line, Range No. 14 West of the principal Meridian

page 91, vol 6

Surveyor's office
Saint Louis, June 9th 1849
The North West quarter of section 5, the South West quarter of section 6, the West halves of sections 7 & 18, subdivided under the act of Congress of the 5th of April 1832, and the North West quarter of section 6, subdivided 1000 to conform to a previous sale made of, and a plat sent to the Register and Law Officer to the Commissioners of the General Land Office.

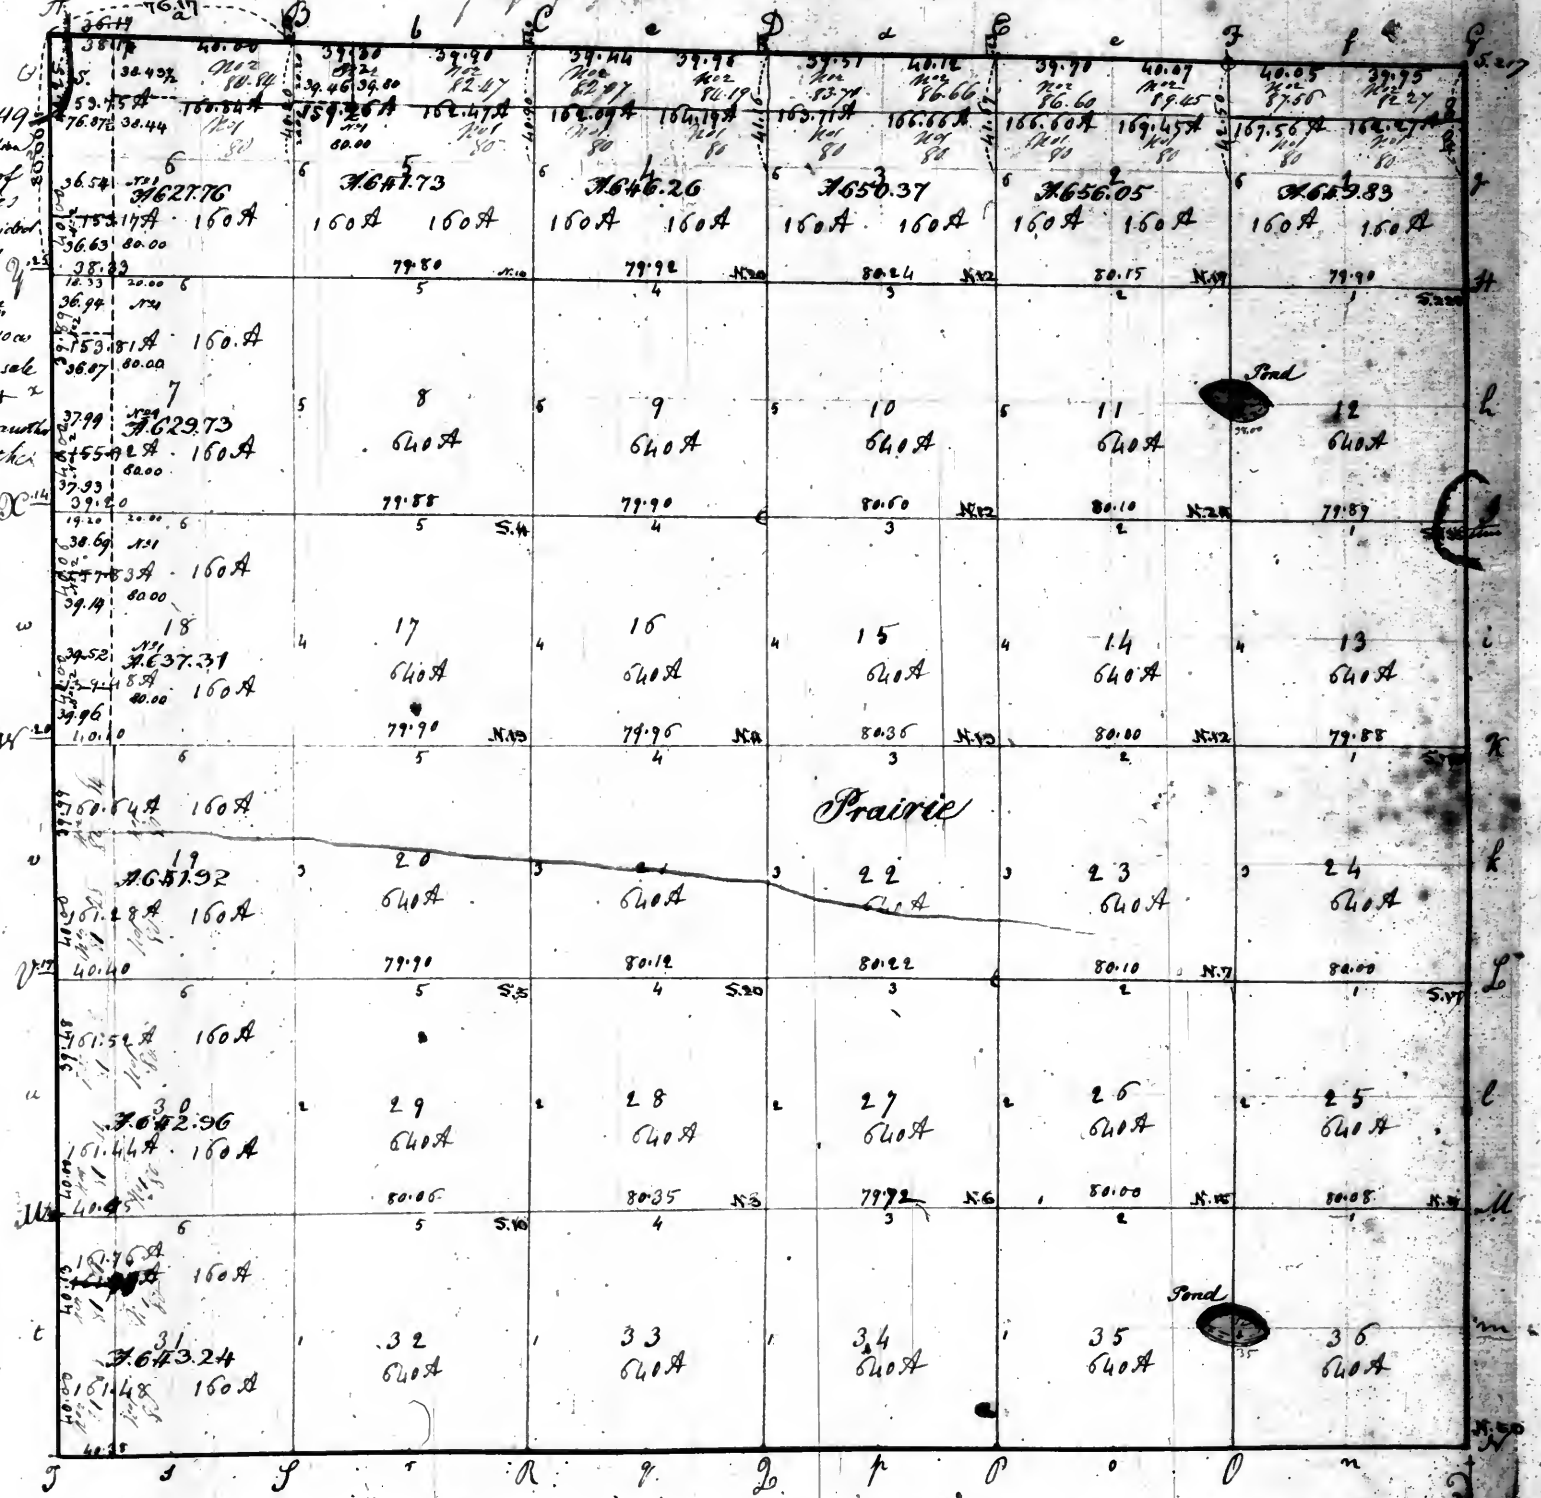

Pursuant to a contract with, and instructions from William Bector, Surveyor of the lands of the United States in the State of Illinois, and Territories of Missouri and Arkansas bearing date the ninth day of March 1821. I have admeasured, laid out and surveyed the above described township, and do hereby certify that it has such marks and bounds, both natural and artificial, as are represented in said plat, and described in the field notes made thereof, and returned with this plat into the Office of the Surveyor of the lands of the United States, for the State of Illinois and Territories of Missouri and Arkansas.

Certified August 28th 1821

James Thompson D. Surveyor

Scale 4000 ft per inch

Township No. 18 North of the Base line, Range No. 14 West of the 2 principal meridian.

Page 92 vol 6



Surveyor's office
Saint Louis June 9th 1849
The West halves of sections 31, 32, 33, 100
and the South west quarter of section 31 subdivided into 10 cts to conform to a previous sale by recorded plat and a plat sent to the Register and another to the Commissioner of the General Land office

Aggregate area = 22839.13 acres

Permitted to a contract with and instructions from William Bector Surveyor of the United States for the State of Illinois and Territories of Missouri and Arkansas bearing date the ninth day of March 1821
I have admeasured laid out and Surveyed the above described Township and do hereby Certify that it has such marks and bounds both natural and artificial as are represented on said plat and described in the field notes made thereof and returned with this map into the office of the Surveyor of the lands of the United States for the State of Illinois and Territories of Missouri and Arkansas


Certified this 25th August 1821 James Thompson D. Surveyor

Scale 4000 feet to an inch

Township N. 19 North of the Base line, Range W. 14 West of the II principal meridian.

619.

page 95 vol 6

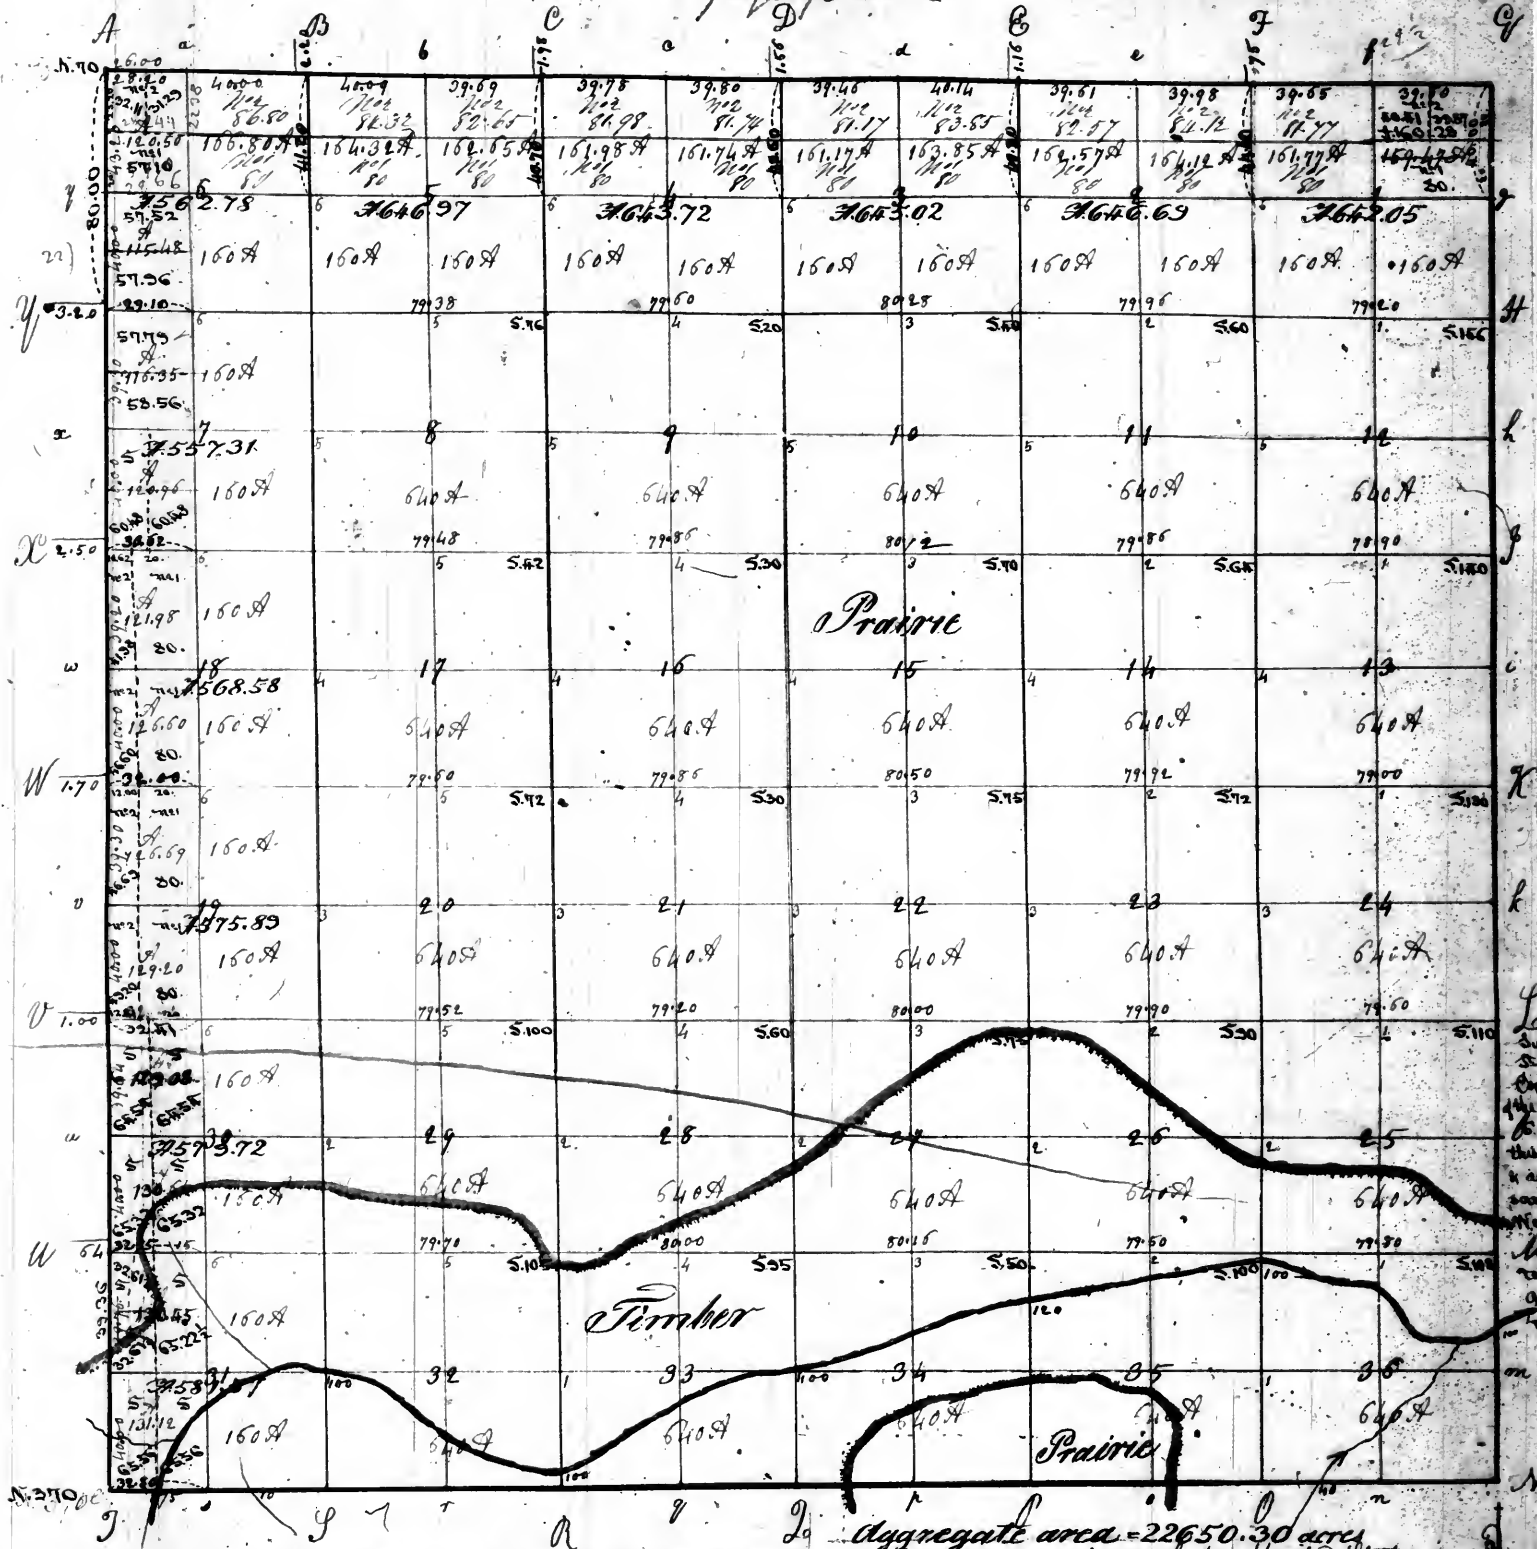

Surveyor's Office
St. Louis, Mo. 1821
Copy of H. L. E. 1821
of the West of the
6. 7. 1821 19 west
this day to the
another copy of the
same and also of the
West of the
1821 21, was sent
to the Commr of the
genl land office on

Pursuant to a contract with, and instructions from William Prector Surveyor of the lands of the United States in the State of Illinois and Territories of Missouri and Arkansas bearing date the ninth day of March 1821 I have admeasured laid out and Surveyed the above described Township; and do hereby Certify, that it had such marks and bounds both natural and artificial as are represented on said plat and described in the field notes made thereof and returned with this plat into the Office of the Surveyor of the lands of the United States for the State of Illinois and Territories of Missouri and Arkansas.


Certified This 20th August 1821 James Thompson D. Surveyor

Scale 1000 ft per inch

Township N. 20 North of the Base line, Range R. 14 West of the principal meridian.

620

page 94 vol 6

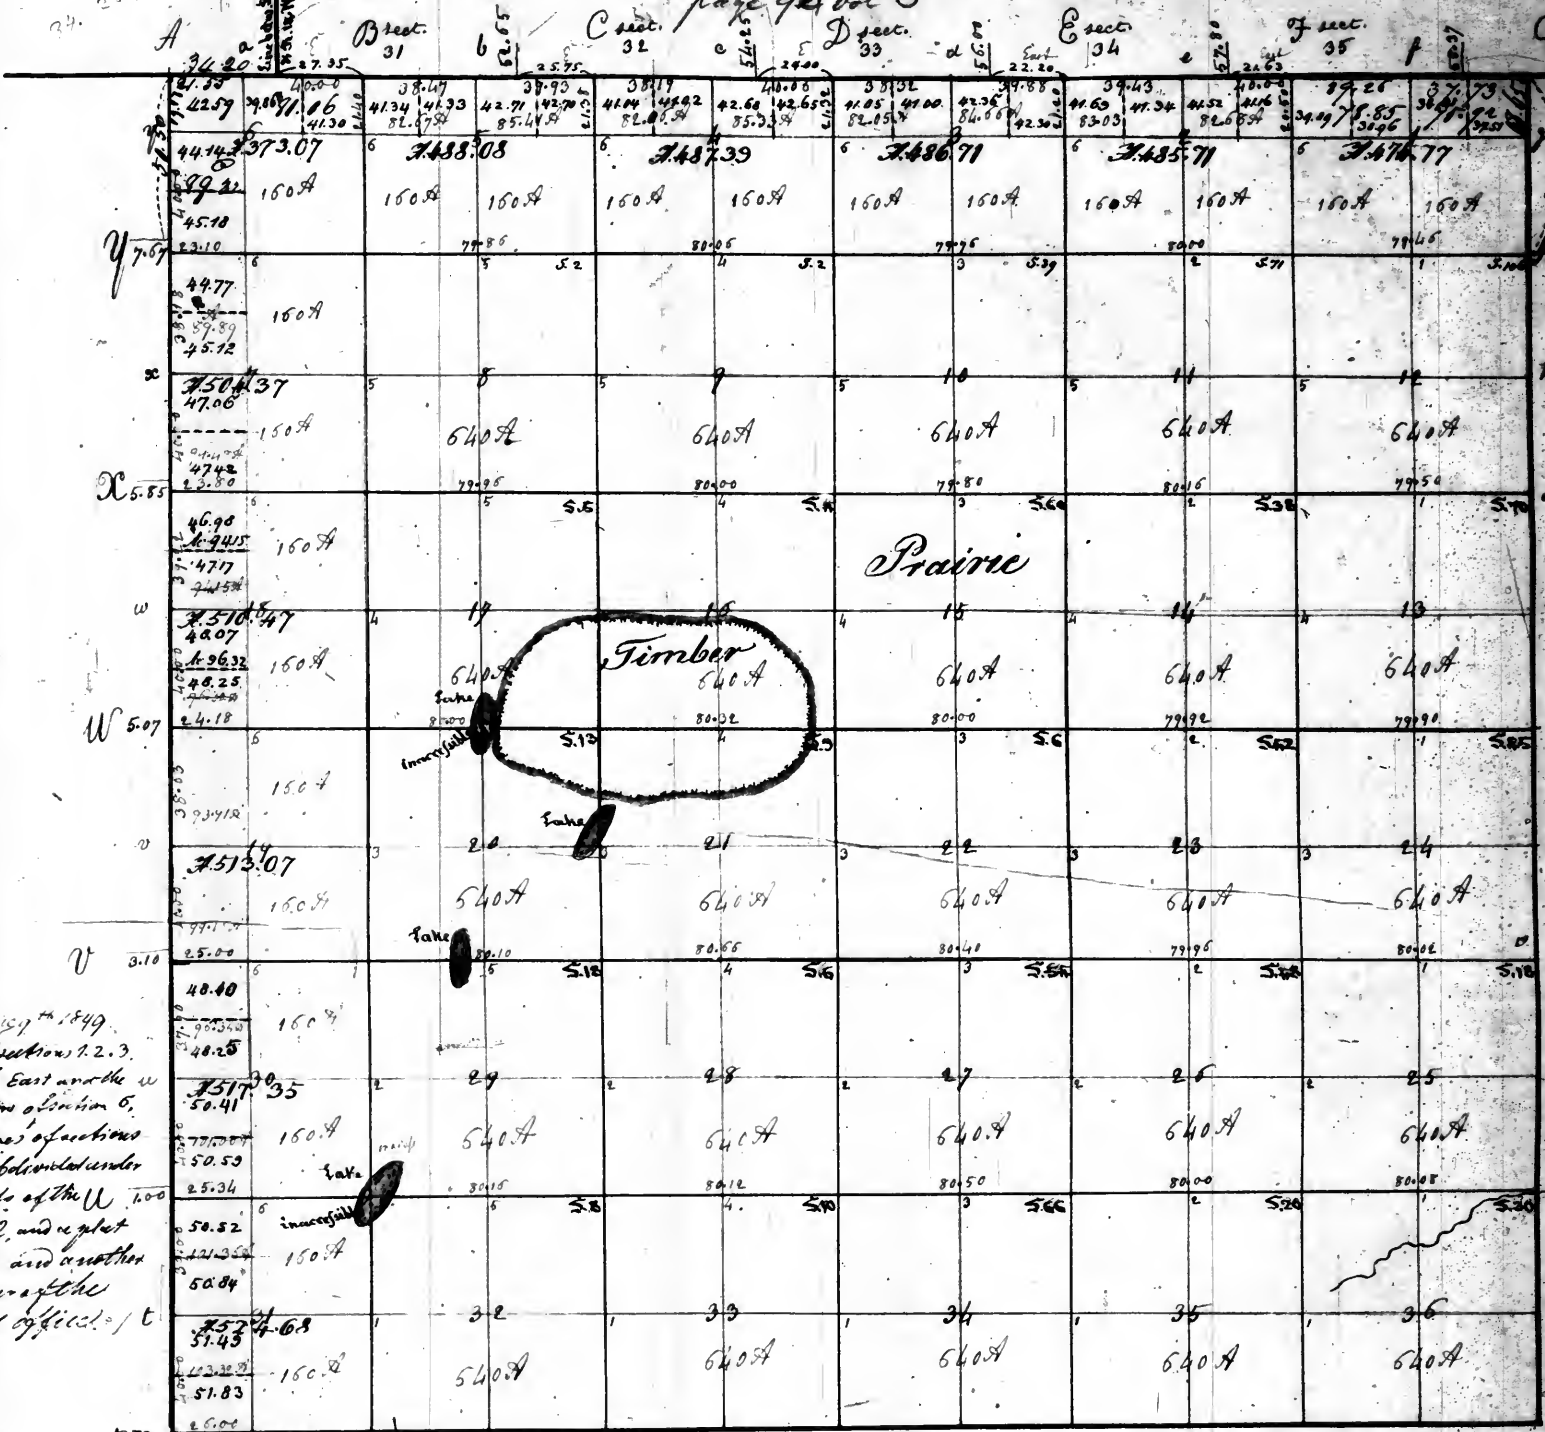


Surveyor's Office
Saint Louis, Mo. Aug. 20, 1849.
The North halves of sections 1, 2, 3,
4 & 5, the North East and the W
South West quarters of section 6,
and the West halves of sections
7, 18, 30 & 31 subdivided under
the act of Congress of the U. S.
5th of April 1832, and a plat
sent to the Register and another
to the Commissioner of the
General Land Office. J. T.

Pursuant to a contract with and instructions from William Reister Surveyor of the lands of the United States in the State of Illinois and Territories of Missouri and Arkansas bearing date the ninth day of March 1841 I have measured laid out and surveyed the above described Township; and do hereby certify that it had such marks and bounds both natural and artificial as are represented on said plat and described in the field notes made thereof and returned into the Office of the Surveyor of the lands of the United States, for the State of Illinois and Territories of Missouri and Arkansas.

Certified This 20th August 1841 James Thompson D. Surv.

Scale 40 Chaps. inch

Township No. 21 North of the Base line, of Range No. 14 West of the 2^d Principal Meridian line

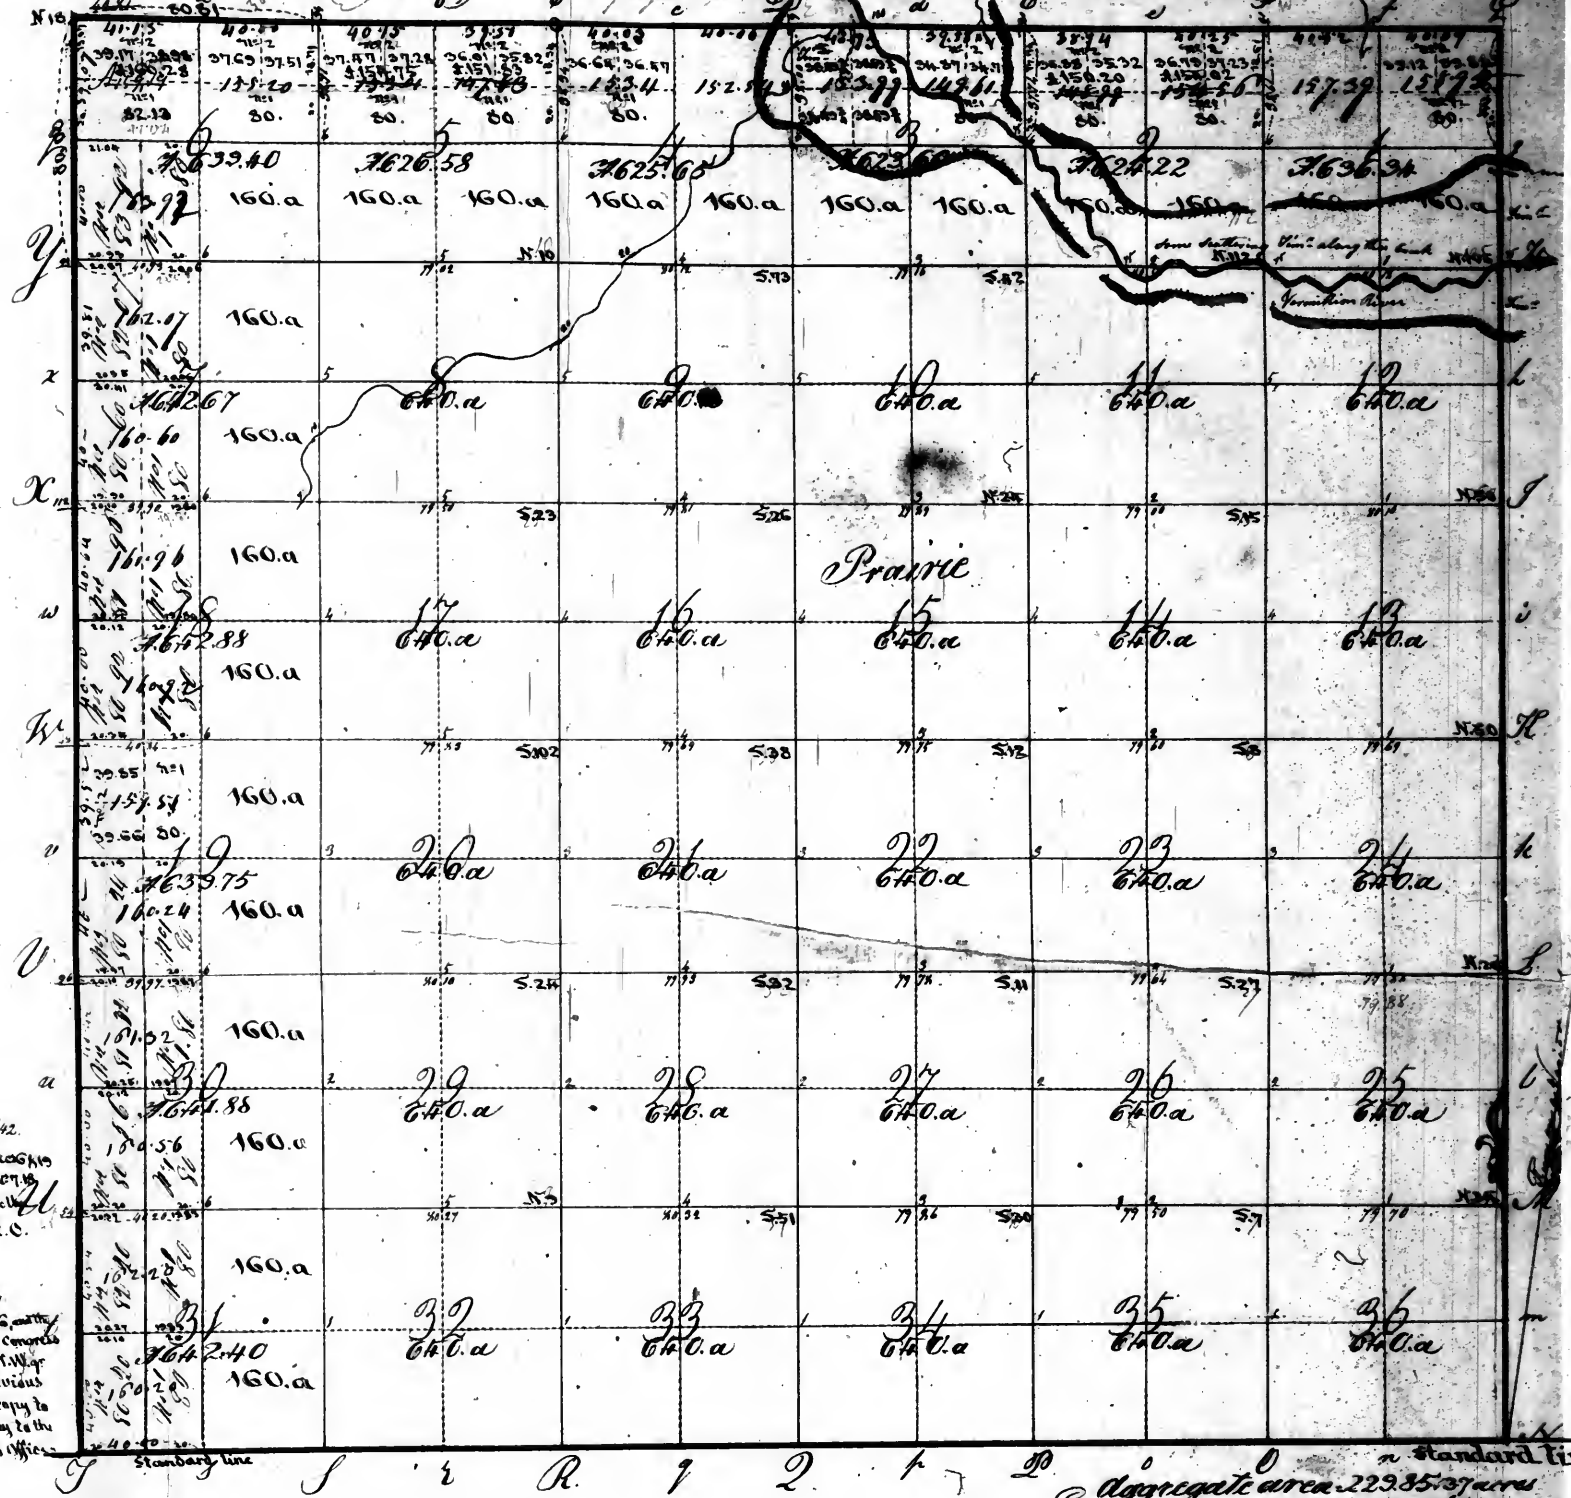

Surveyor's Office
St. Louis 10th April 1842.
Plat of the S.W. 1/4 Sec. 36
of the West half of Sec. 36
20th 21st sent this day to the
Commiss of the Gen. L. O.

Surveyor's Office
St. Louis 16th February 1847
Subd. plat of Sec. 2, 3, 4, 1000.


Aggregate area 22385.37 acres
Laid down on a scale of 40 chains to an inch

Pursuant to a contract with & instructions from William B. Reilly, Surveyor of the lands of the United States in the States of Illinois, Kentucky, & Territory of Arkansas, bearing date the 11th day of March 1841, I have measured, laid out and surveyed the above described Township, & do hereby certify that it has such marks, & bounds both natural & artificial, as are represented by said Plat, & described in the field notes made thereof, & returned with this plat into the Office of the Surveyor of the Lands of the United States, for the States and Territory above named.

Certified June 13th 1841

John M. Sprague S.


Township 22 North of the Base line Range 14 West of the 2^d principal Meridian

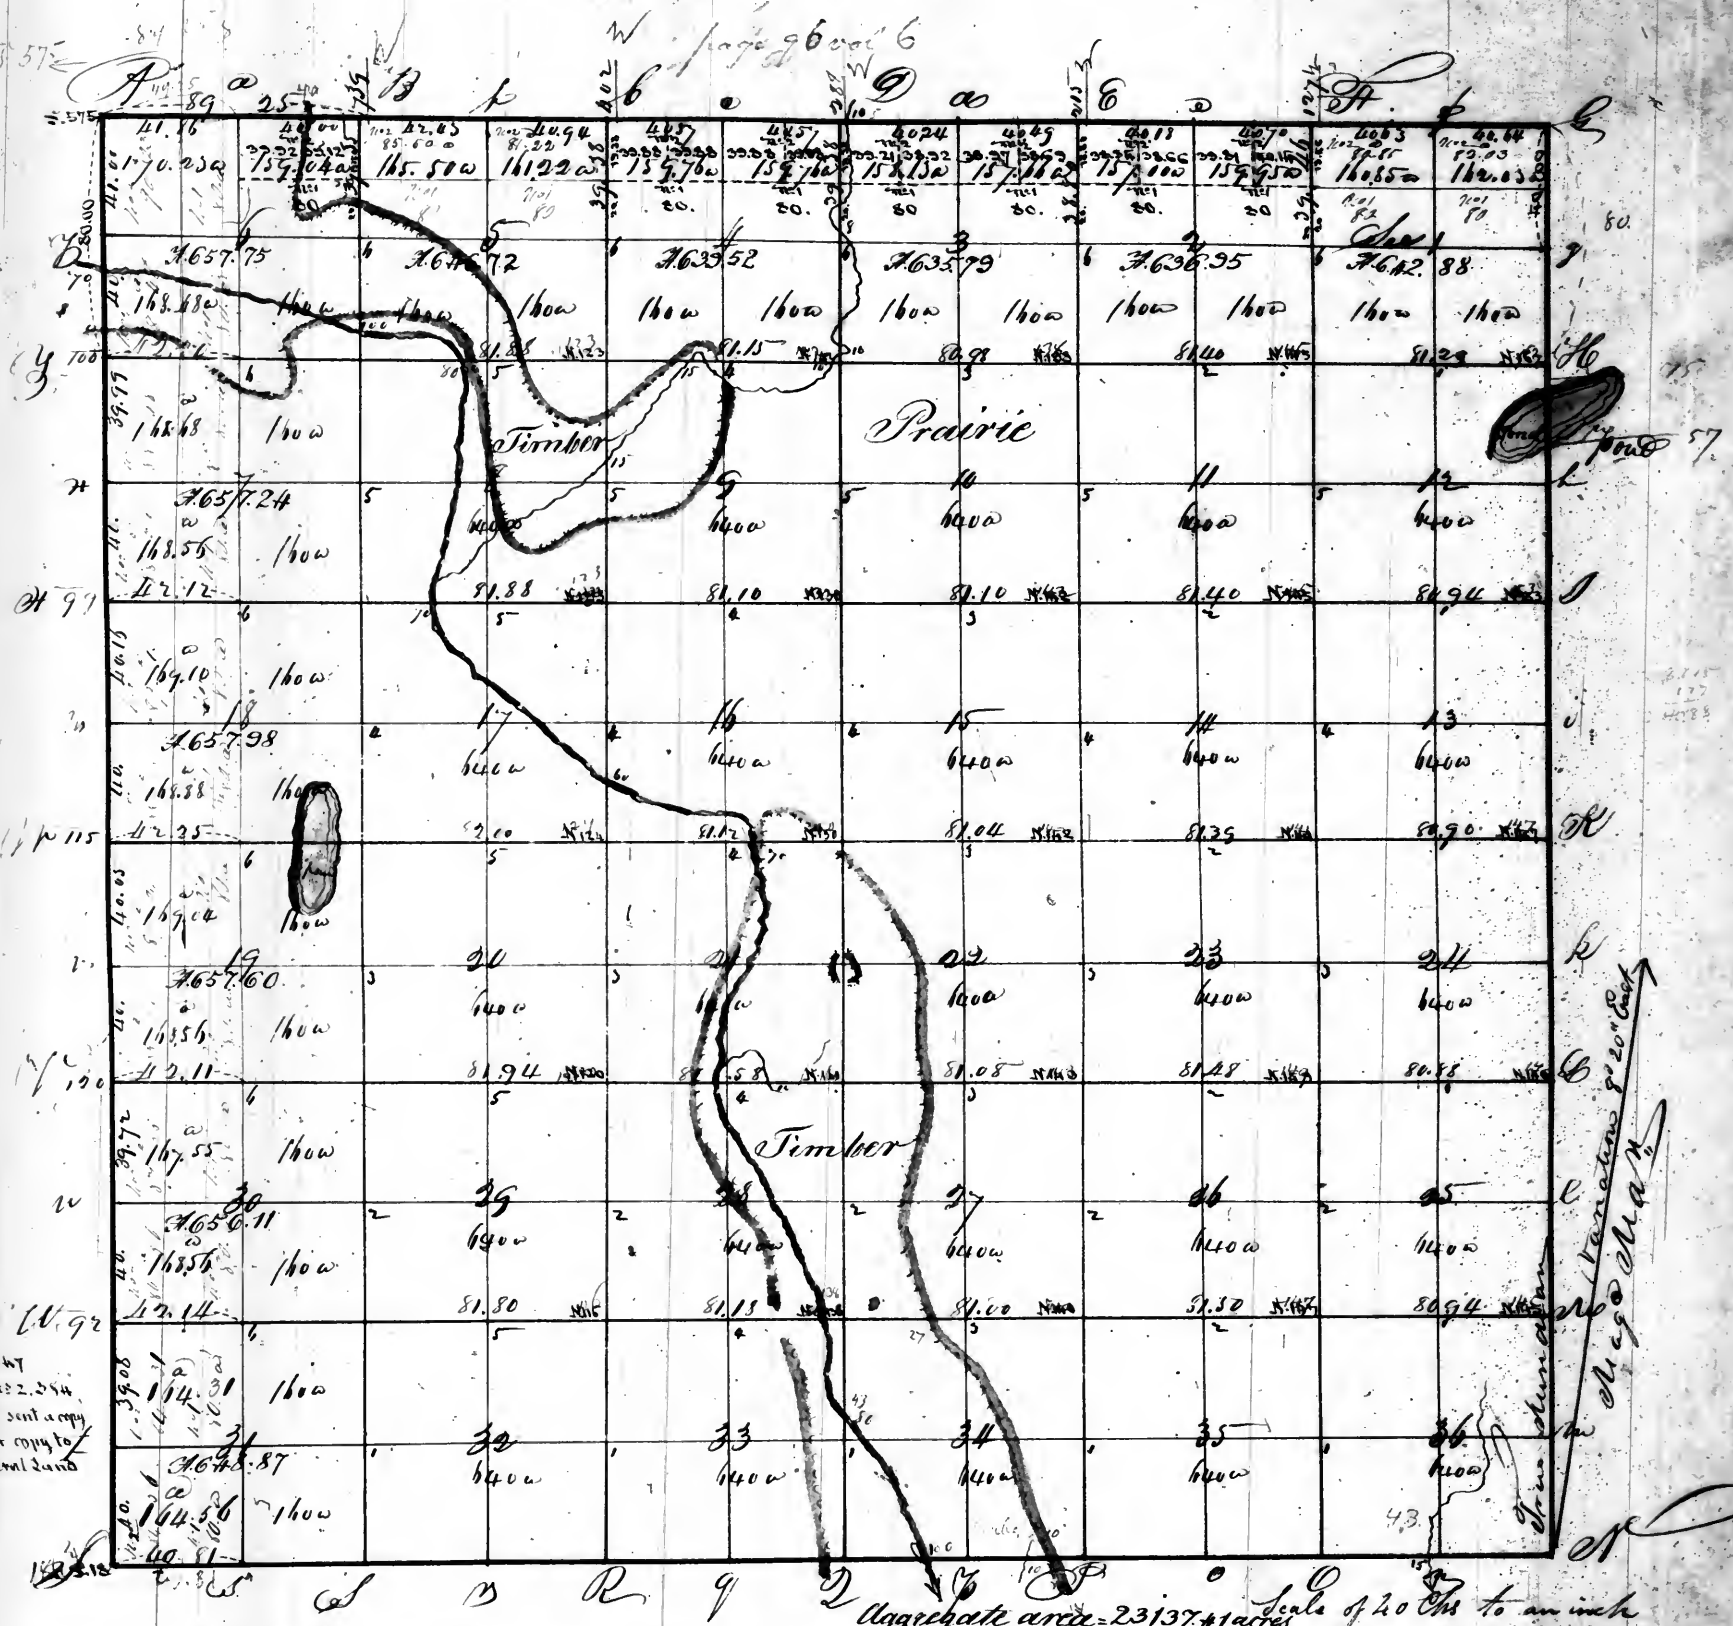

Surveyor's Office
St. Louis, Mo. 16th February 1847
Delivered the North 1/2 of Sec 2, 24, 26, 28,and sent a copy to the Register another copy to the Comptroller of the General Land Office.

Whereas by a contract with and instructions from William Rector Surveyor of the Lands of the United States in the State of Illinois & Missouri Territory of Arkansas bearing date the 5th day of March 1822
I have administered laid out and surveyed the above described Township & do hereby certify that
said such marks and bounds, both natural and artificial as are represented on said plat and described in the plat
notes made thereof and returned with this plat into the office of the Surveyor of the Lands of the United States
in the State of Illinois & Missouri Territory of Arkansas
certified this 18th day of November 1842
J. C. Stearns
Surveyor

Township 23 North of the Base line Range 14 West of the 2^d Pl. Meridian

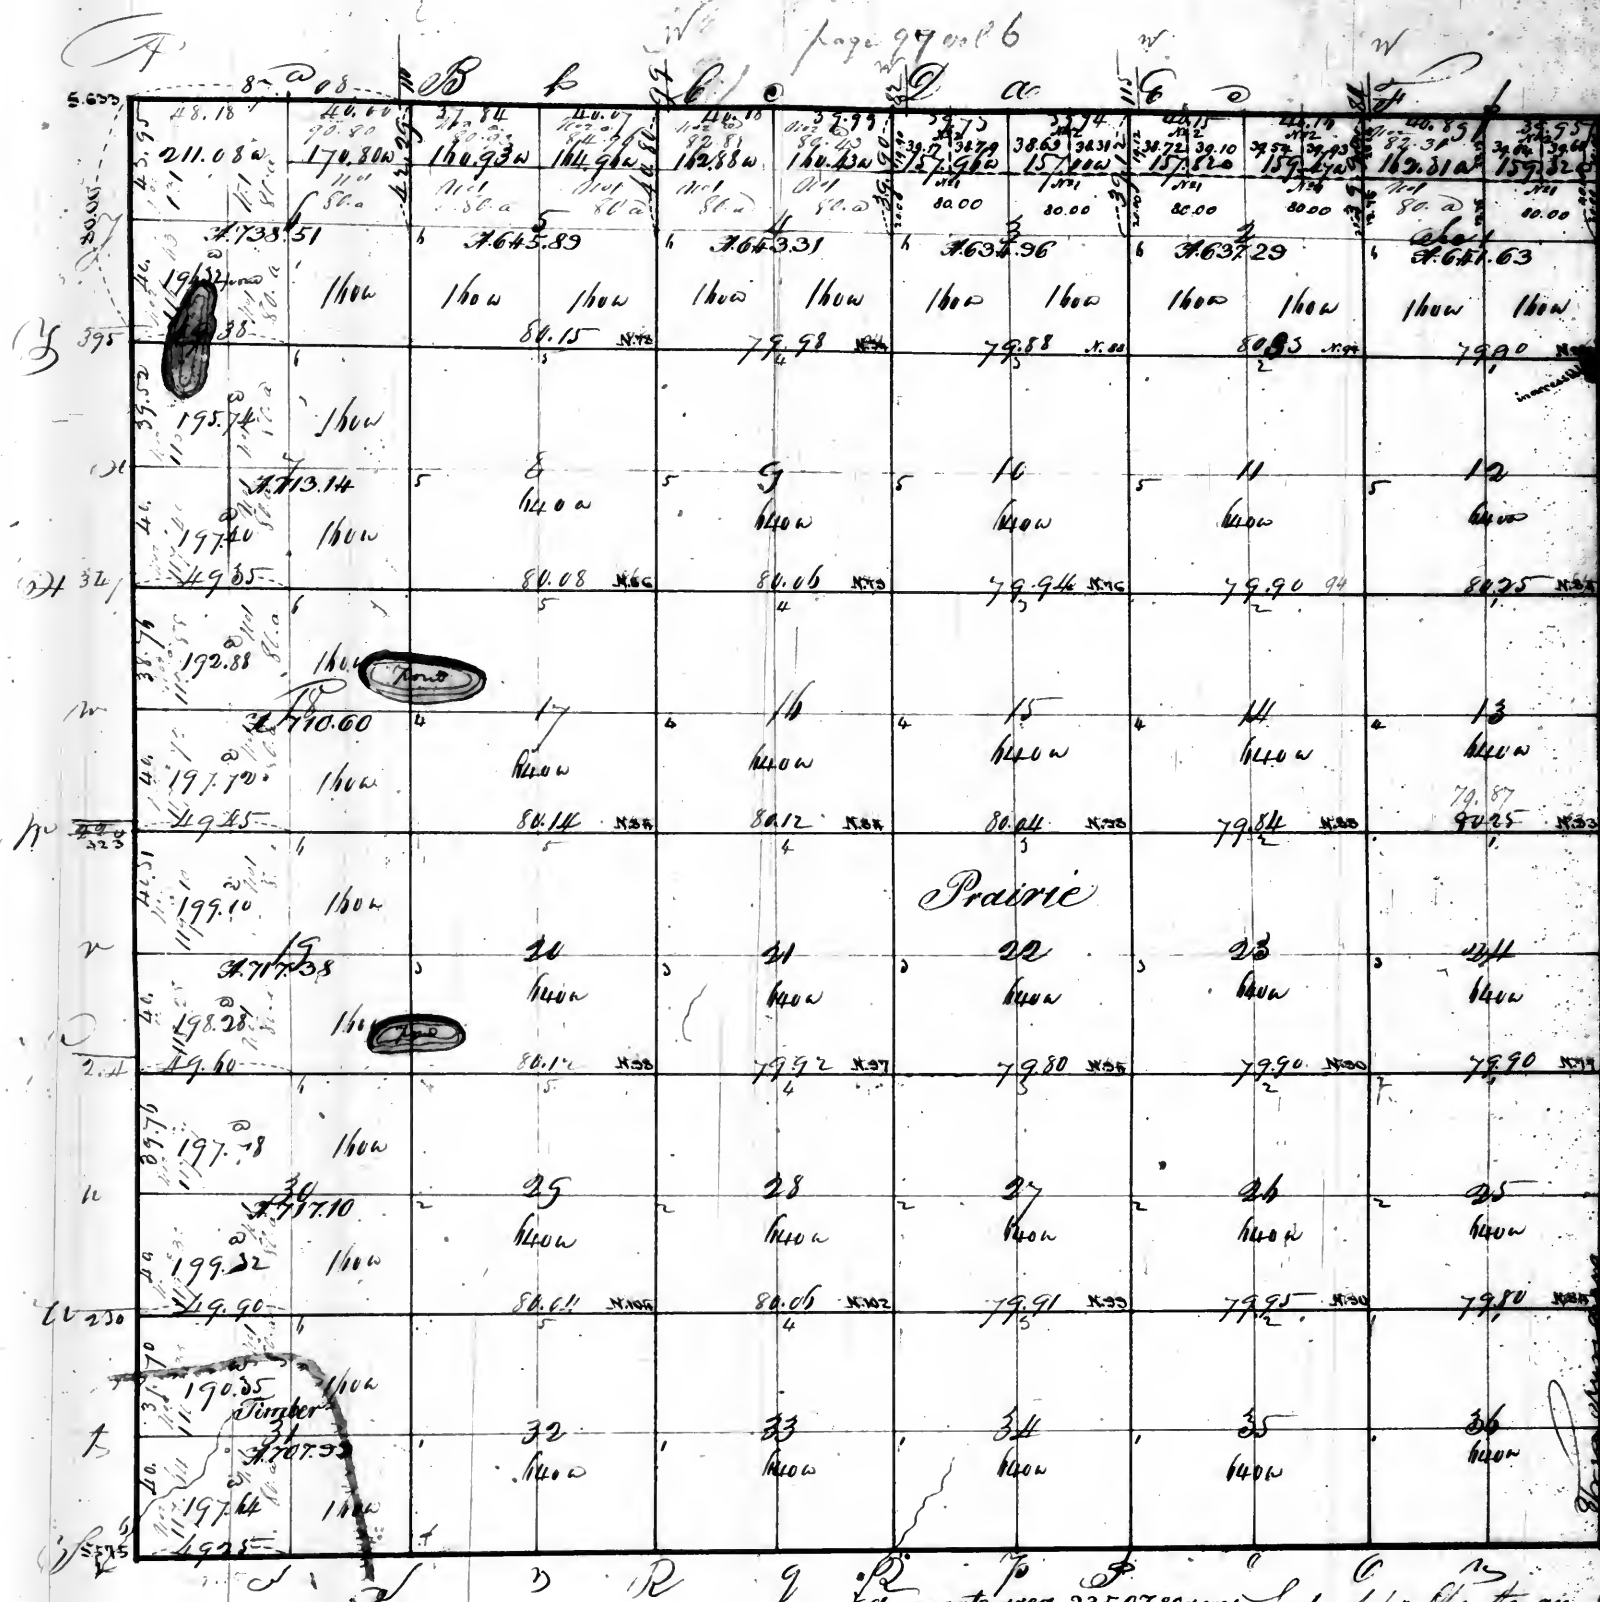

Surveyor's Office
St. Louis N. 10th Sept. 1829
Plat of the N. W. 1/4 of Sec. 6
and this day to the Comptroller
of the Public Land Office.




Pursuant to a contract with and instructions from William Rector, Surveyor of the Lands of the United States in the State of Illinois & Missouri & Territory of Arkansas, bearing date the 9th day of March 1822 - I have administered and surveyed the above described Township & do hereby certify that it has such marks and bounds both natural & artificial as are represented on said plat and described in the field notes made thereof and returned with this plat into the office of the Surveyor of the Lands of the United States in the State of Illinois, Missouri & Territory of Arkansas.

Witness this 15 day of November 1829
Examined
C. Rector
D. Surveyor

Township N^o 24 North of the Base line Range N^o 14 West 3^d Principal Meridian

Page 98 vol 6

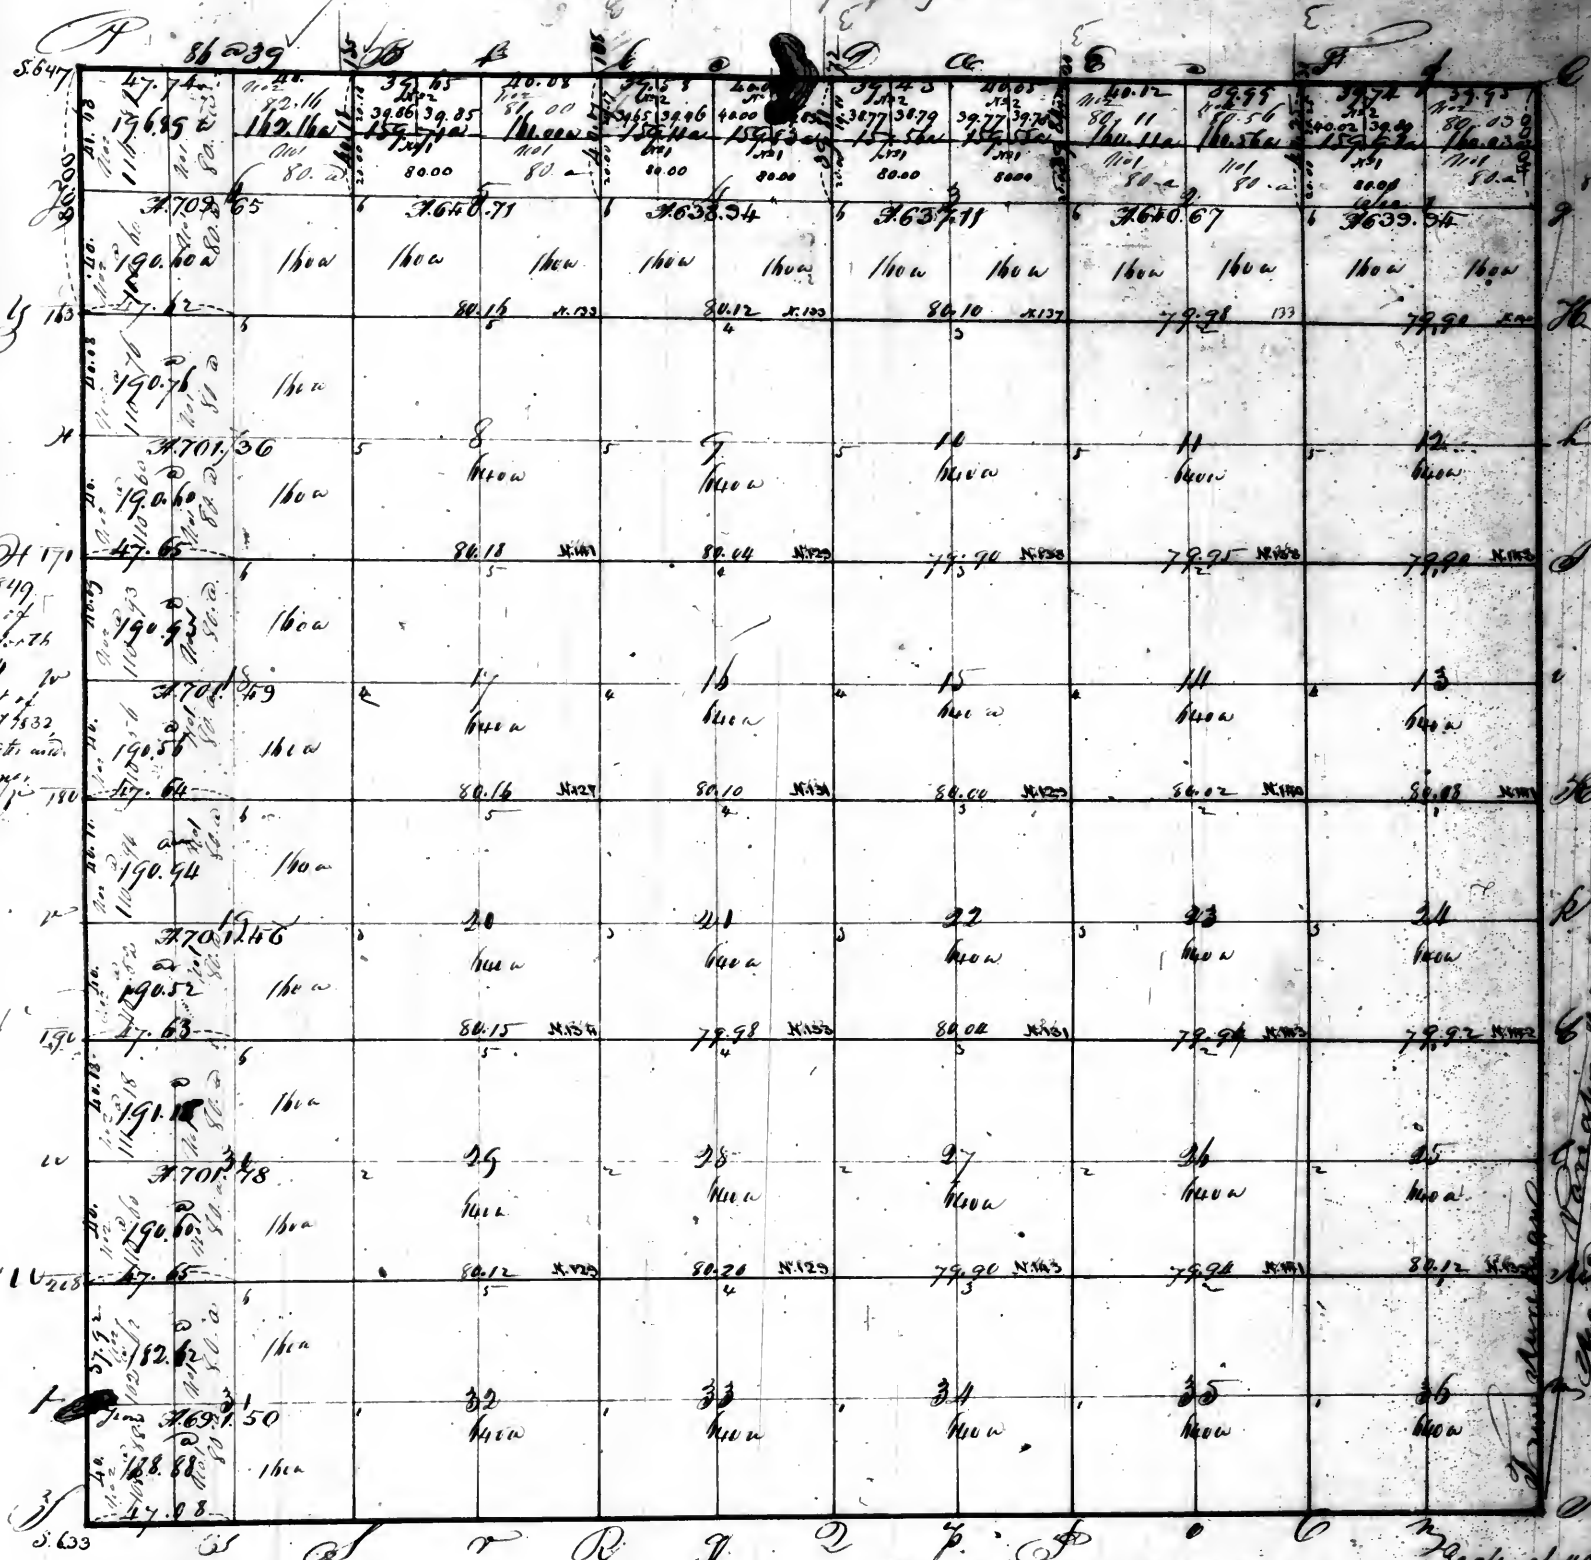

Aggregate area = 23404.69 acres

Scale of 40 Cts to an

Pursuant to a contract with and instructions from William Reclus Surveyor of the Lands of the United States in the State of Illinois & Territory of Arkansas, bearing date the 9th day of March 1842 - I have examined last and all surveys covering Township 3 & do hereby certify that it has such marks and bounds both natural and artificial as are represented said plat and assented in the field notes made thereof and returned with this plat into the office of the Surveyor of the Lands of the United States in the State of Illinois & Territory of Arkansas.

Exchanged this 18 Day of November 1822

Examiné

Officer Sawyer





Prairie

Timber

[illegible]

5.647. S S D R 9 2 P
 Original of us this is an
 aggregate area - 29342.55 ac.
 of the lands of the United States in the State of Illinois
 Pursuant to a contract with and instructions from William Reister, Attorney
 of Missouri & Territory of Arkansas, bearing date the 9th day of March 1892 - I have advanced laid out and surveyed the
 described Township & do hereby certify that it has such marks and bounds both natural & artificial as are represented on said plat
 and described in the field notes made thereon and returned with this plat into the office of the Attorney of the State of Illinois
 W. S. in the State of Illinois & Missouri & Territory of Arkansas
 Witness my hand, this 18th Day of November 1892
 C. Allen

Township No. 26 North of the base line, Range No. 14 West of the principal Meridian.
page 102 vol 6

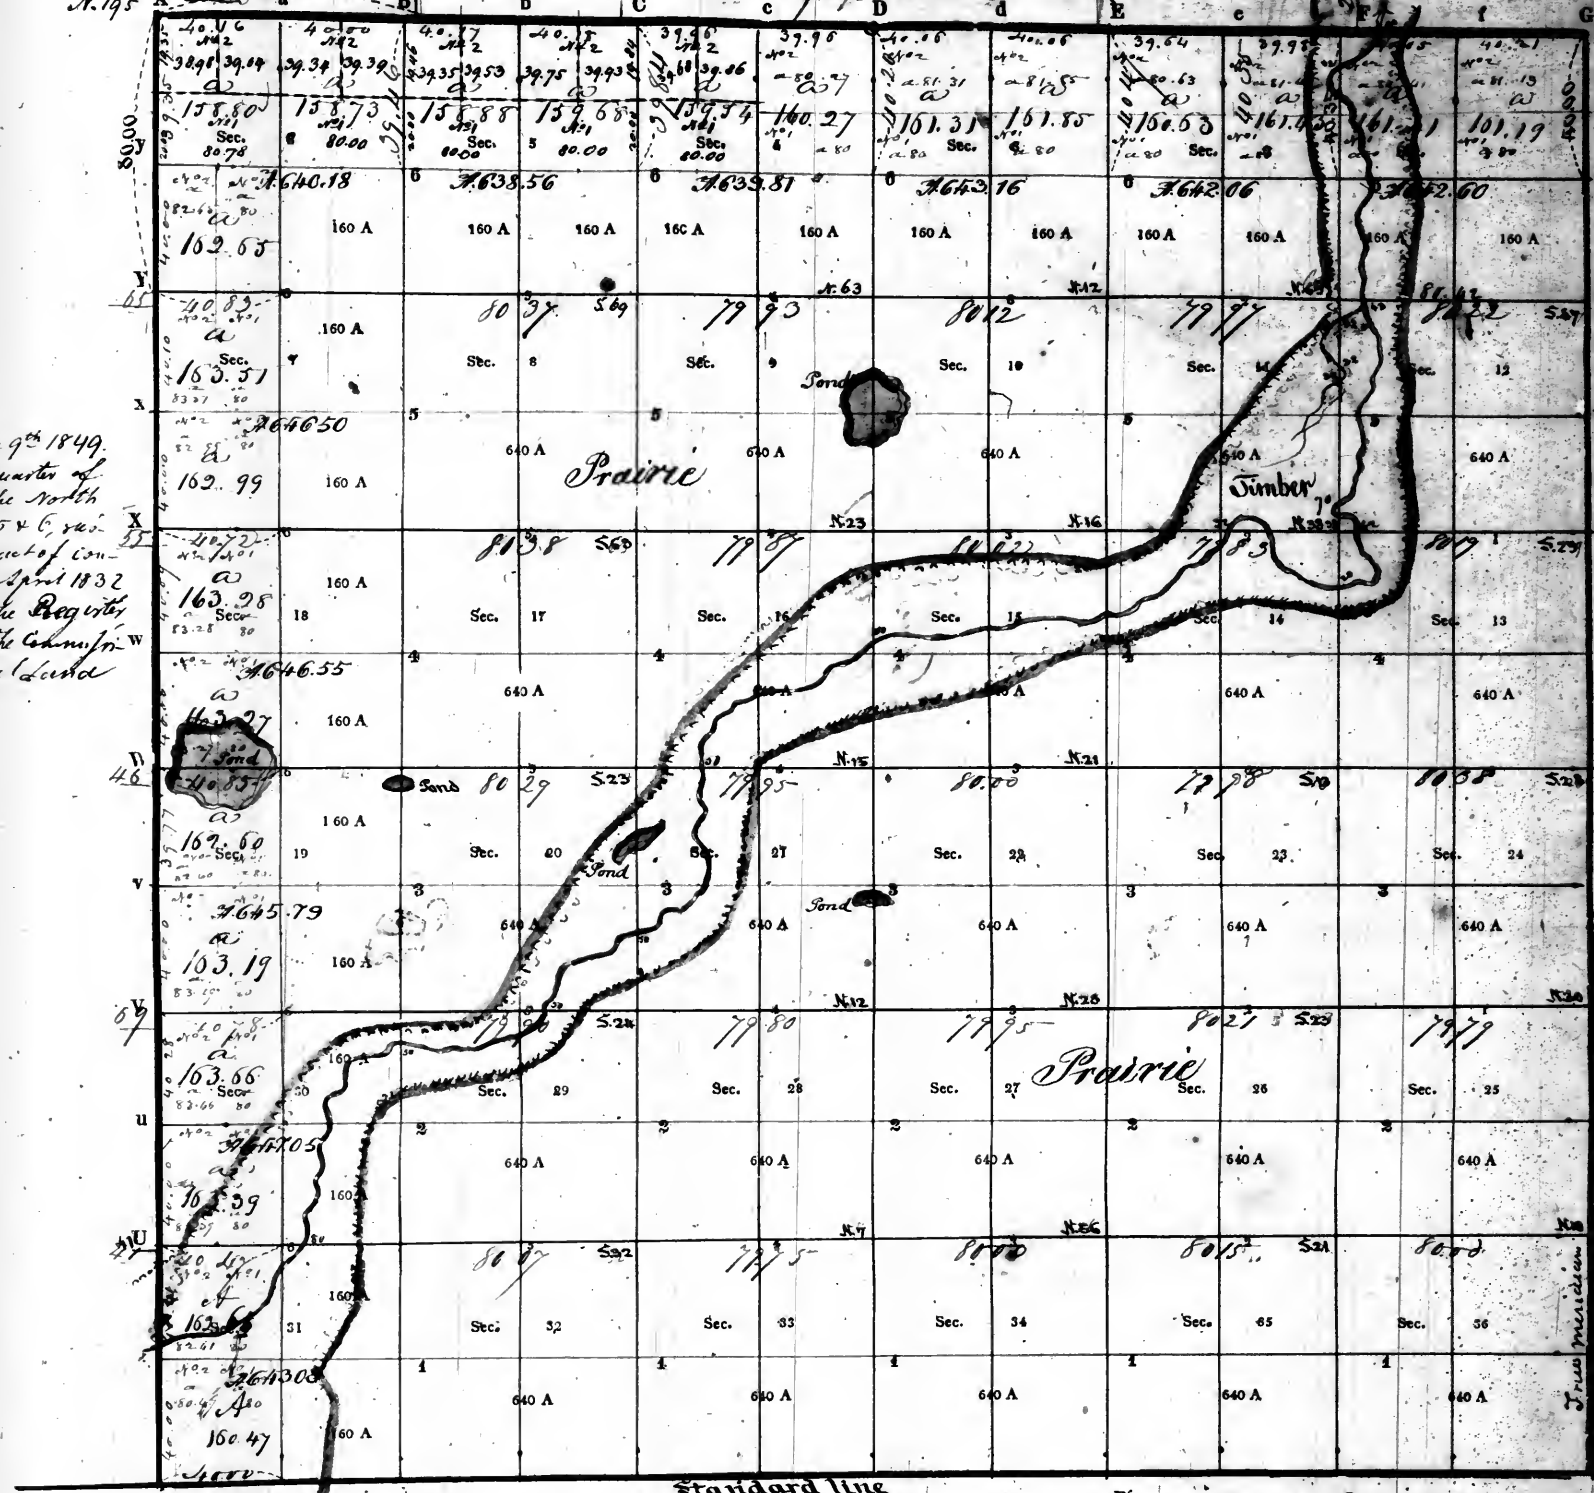

Surveyor's office
Saint Louis June 9th 1849.
The North West quarter of
section 4, and the North
half of sections 5 & 6, were
divided under the act of con-
gress of the 5th of April 1832
and a plat sent to the Register
and another to the Commis-
sioner of the General Land
Office.

True meridian
Magnetic meridian


Standard line
aggregate area = 23075.34 acres
Scale of 40 Chains to an Inch.

PURSUANT to a contract with, and instructions from William Rector, Surveyor of the lands of the United States in the State of Illinois and Territory of Arkansas, bearing date the 11th day of March 1842, I have measured, laid out and surveyed the above described Township; and do hereby certify, that it had such marks and bounds, both natural and artificial, as are represented on said plat, and described in the field notes made thereof, and returned with this plat into the Office of the Surveyor of the Lands of the United States, in the State of Illinois and Territory of Arkansas.

Certified this 11th day of December 1842
EXAMINED.

Wm Rector D. SURVEYOR.
Thos Hamilton

Township 27 North of the base line Range No 14 East of the 2^d Meridian
 page 103 vol 6

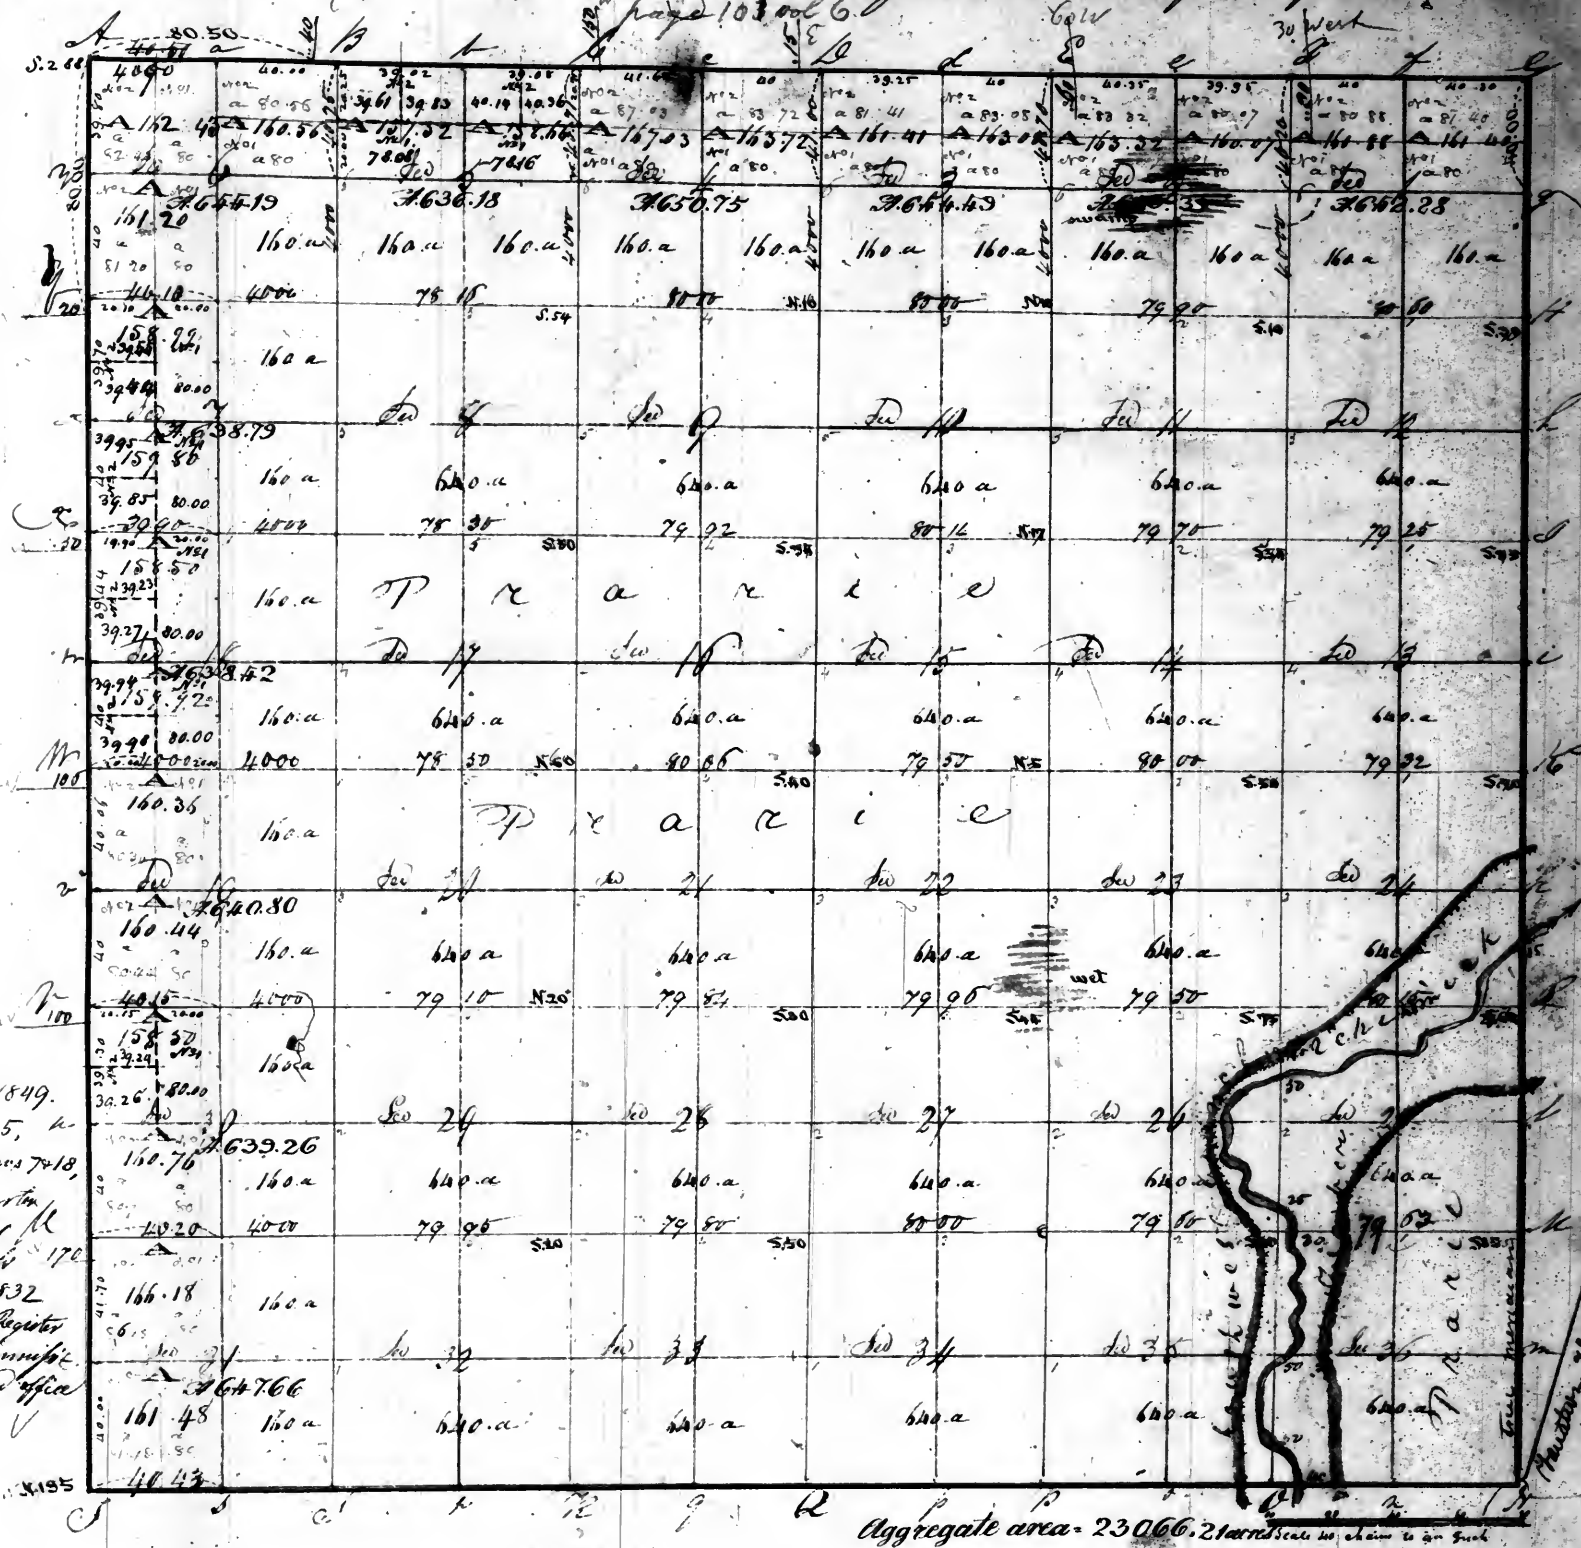

Surveyor's office
 June 9th 1849.
 The North half of section 5,
 the West halves of sections 7 & 18,
 the North west quarter
 of section 30 subdivided
 under the act of Congress
 of the 5th of April 1832
 as a plat sent to the Register
 and another to the Committee
 of the General Land Office


Pursuant to instructions from William West, Surveyor of the Lands
 of the United States in the States of Illinois, Missouri, & Territory of Arkansas: bearing date the Eighteen
 day of April 1822. I have accompanied, laid out and surveyed the above described Township
 and do hereby certify that it had such marks and bounds, both natural and artificial,
 are represented on said plat, and described in the field notes made thereof and returned with
 this plat into the Office of the Surveyor of the Lands of the United States for the States of Illi-
 nois, Missouri and Territory of Arkansas - Certified this 12th day of November 1822 -

J. M. Ball, Surveyor

VOL. 9

Township No. 1 South of the base line of Range No. 1 E. Section 364
 Page 1067

Record

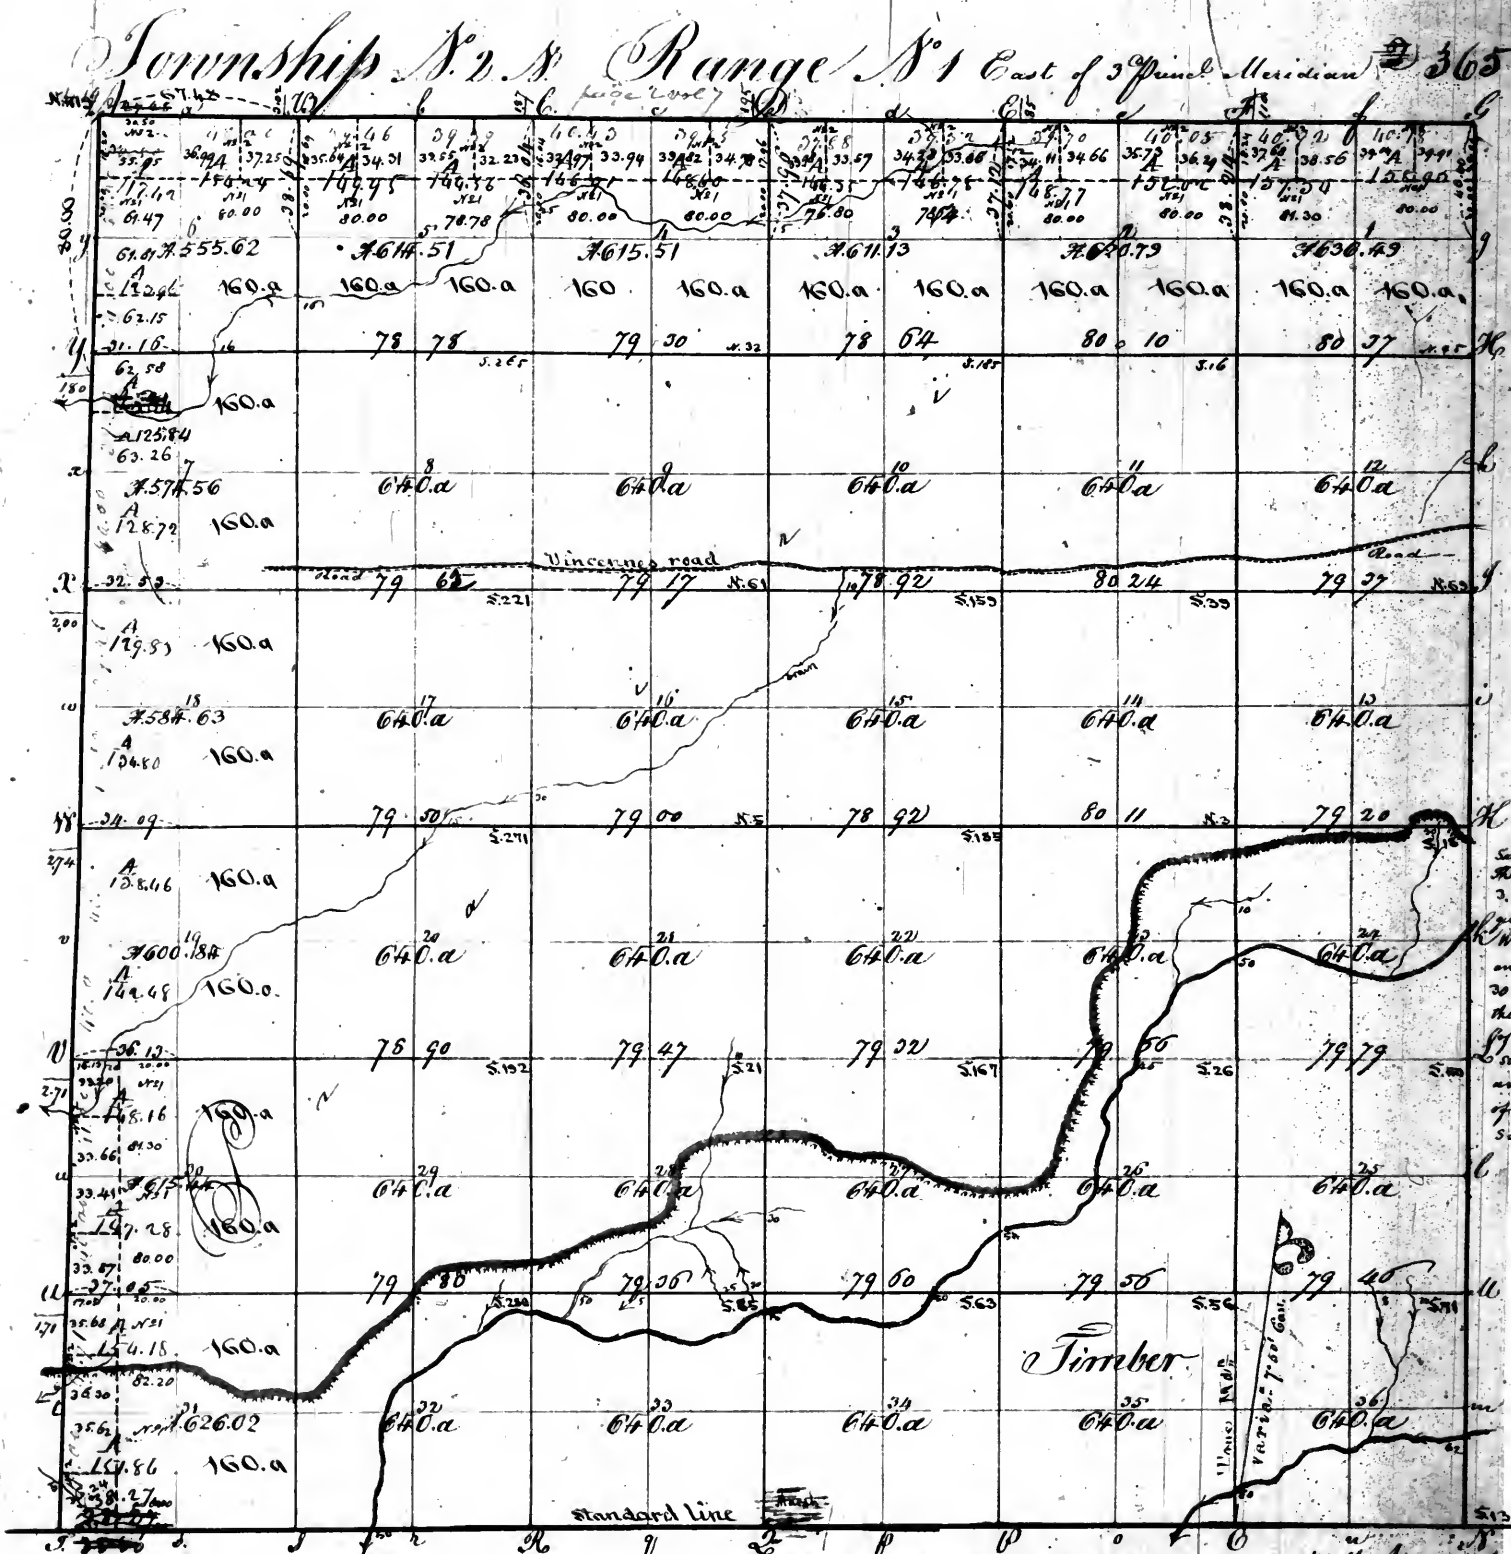


Pursuant to a contract with & instructions from William Hector Surveyor of the Lands of the United States in the Territories of Illinois & Missouri bearing date the 24th day of October 1818 I have examined laid out and surveyed the above described Township & do hereby certify that it had such marks & bounds both natural & artificial as are represented on said Plat & described in the Field notes made thereof and returned with the Plat into the Office of the Surveyor of the Lands of the United States for the Territories of Illinois and Missouri

Edw. Humphreys Surveyor

3

366

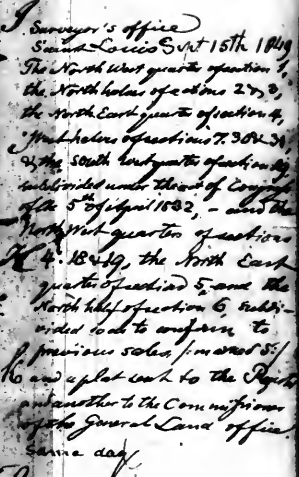


Pursuant to a contract with instructions from William Victor Surveyor of the Lands of the United States in the Territories of Illinois & Missouri bearing date the 24th October 1818 I have examined laid out & surveyed the above described Township & do hereby certify that it had such marks & bounds both natural & artificial as are represented on said plat & described in the Field notes made thereof & returned with this plat into the Office of the Surveyor of the Lands of the United States for the Territories of Illinois & Missouri.

B. Humphreys Depy Sur


5

~~4~~ 367

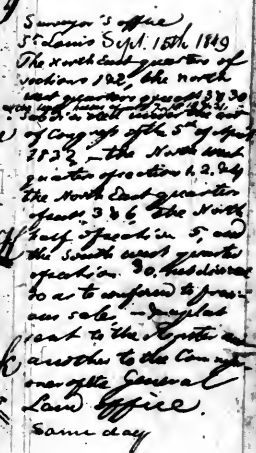

Edmunds, Secy. Sur.

5

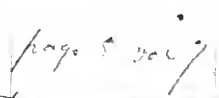

Maria Anna

Directed by Edward Humphreys Esq
February 1819


A Plat of sections 32 & 33 in Township 6 North of the
Base line, Range 1 East of the 3rd principal meridian—
subdivided under the Act of Congress of the 5th of April 1832—



Surveyors Office
Saint Louis June 4th 1834
The above Plat of sec^s 32 & 33, in Township 6 North, Range 1 East
of the 3rd principal meridian are conformable to the field notes on file
in this office—
E. J. Humphreys

Surveyor's Office
St. Louis 20th September 1832
The area of the A. & E. fractional quarter
of section 29. T. 2. N. R. 12. of the 3^d. P. 1. E.
as represented on this unauthenticated Town
ship plat, was this day subdivided under
the act of Congress of the 5th May of the present
year.

370

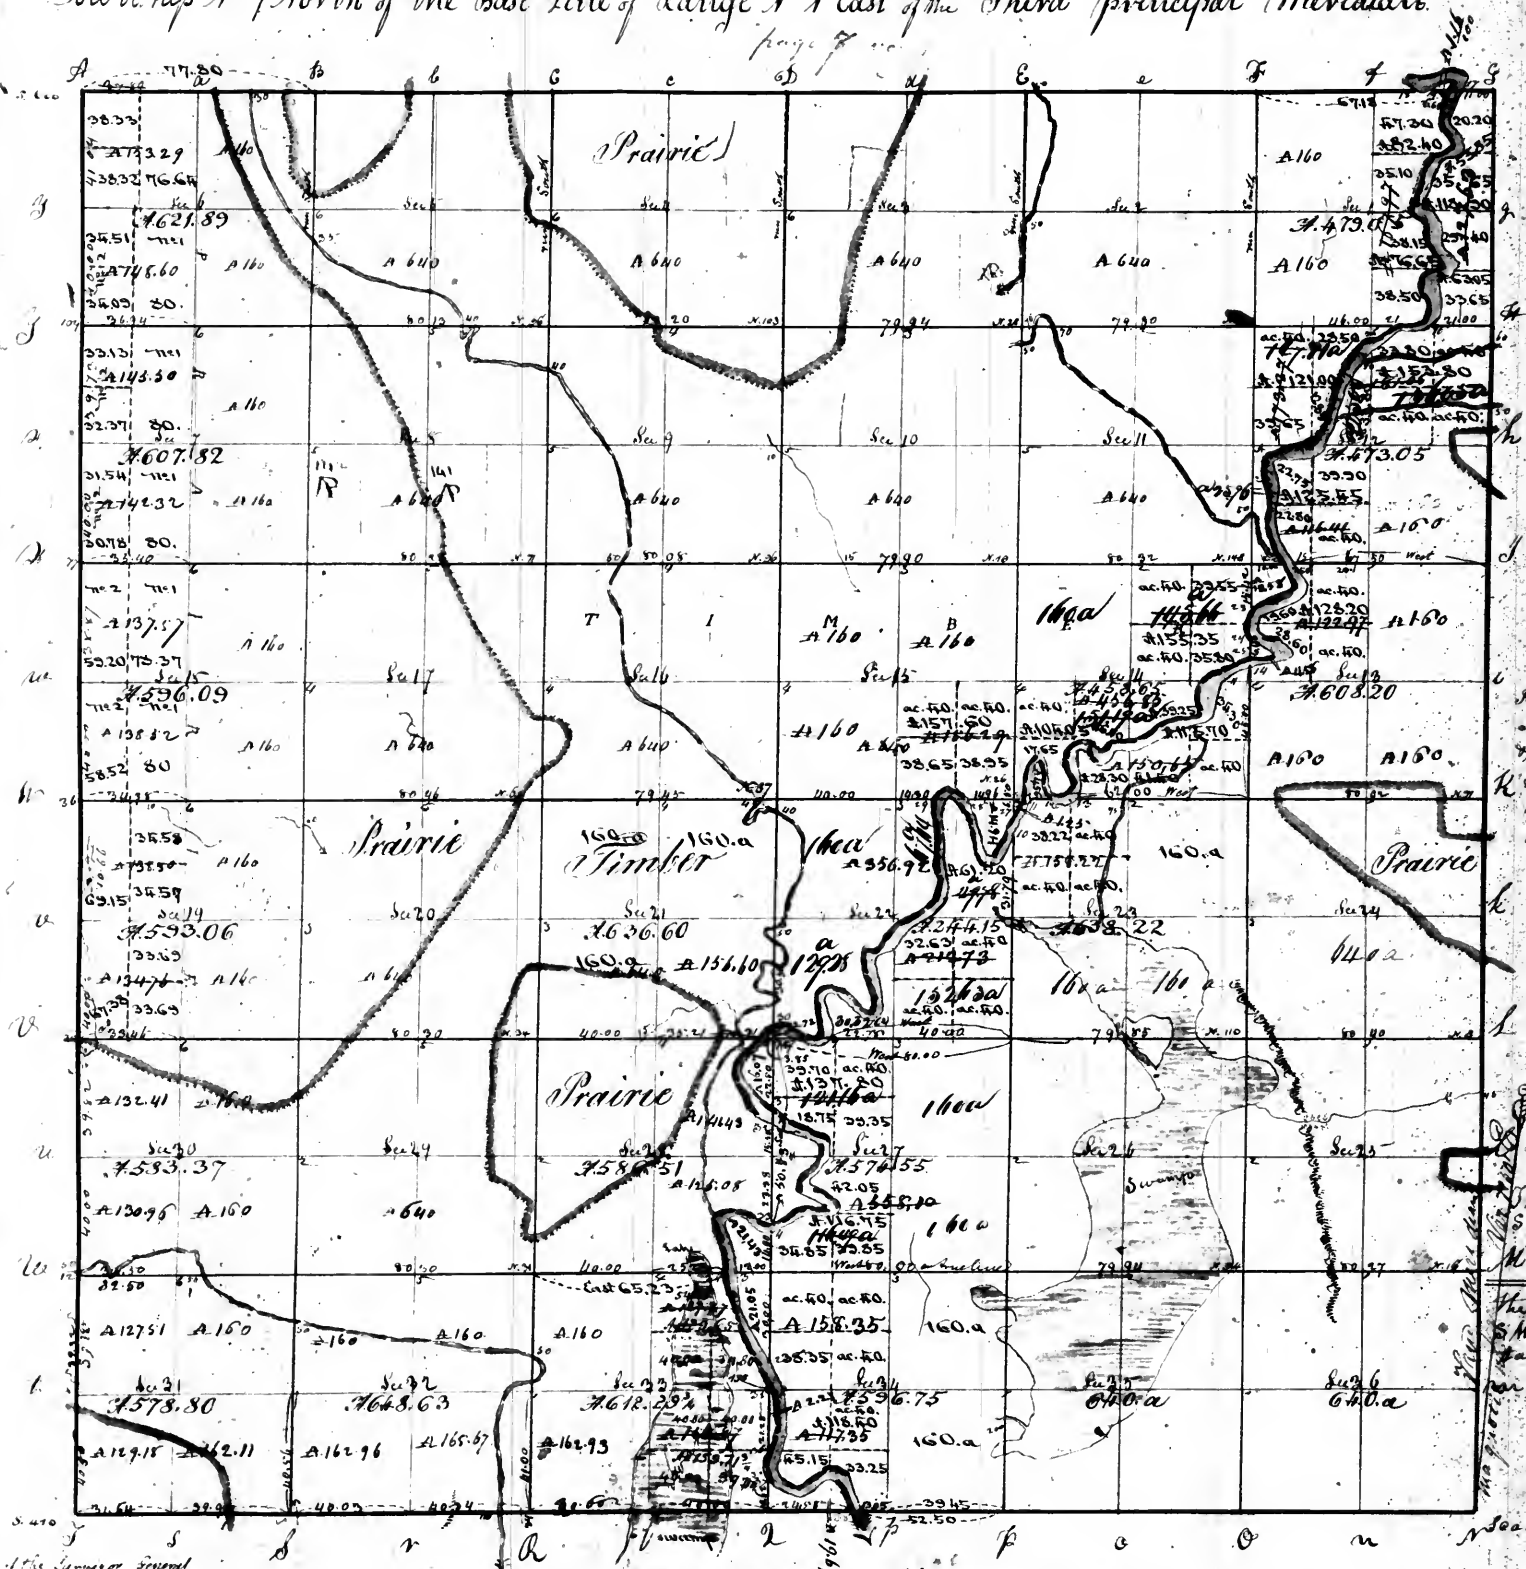

St. Louis May 18th 1855.
 another to the Committee
 of the General Land Office
 on the 26th May 1855.

That part of Iron
Set 21 S.E. of the
river contains
M 400, 61

The S. M. Corner of the
S. M. $\frac{1}{4}$ of Sect-22/Con-
tain/A. 1. 16.


Office of the Surveyor General
for the State of Illinois and Missouri

The East half of section 1, the North half and South West quarter of section 12,
the South West quarter of section 6, the North East quarter of section 17, the
quarters 13 & 23, the East and South West quarter of section 14, the South East
fractional quarter of section 15, the West halves of sections 7 & 23, the East half
and South West quarter of section 22, part of Kaskaskia river and the West
halves of sections 27 & 34 East of Kaskaskia river subdivided under the act of
Congress of the 5th of April 1832, - and the North West quarter of section 6,
and the West half of section 19, subdivided in accordance to previous sales,
and a plot of the same sent to the Register, and another to the Commissioner
to the General Land Office. -

For the subdivisions above mentioned see map plat.

Aggregate area of public land = 22594.00 acres
 Estimated area of the river = 138.00
Total = 22732.00 acres


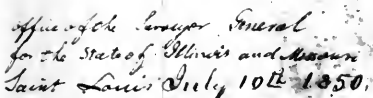

The North West quarter of section 1, the North lower quarters 2, 3, 4, 5, the North East quarter of section 5, the South West quarter of section 7, and the East half of section 36 East of Neasheche river, subdivided under the act of Congress of the 5th of April 1832, and the Northern fractions 18, 19, & 30, the North West quarter of section 34 and the North East quarter of section 35, North of the river, subdivided so as to conform to previous sales marked 3, and a plot sent to the Register and another to the Commissioner of the General Land Office.


Aggregate area of public land = 23086.92 acres
 Affiliated area of the river = 28.25
 Total = 23115.17 acres



Edw. Humphreys, Surveyor

Revised

Township No. 9. North of the Base line, of Range No. 1 East of the 3^d P.

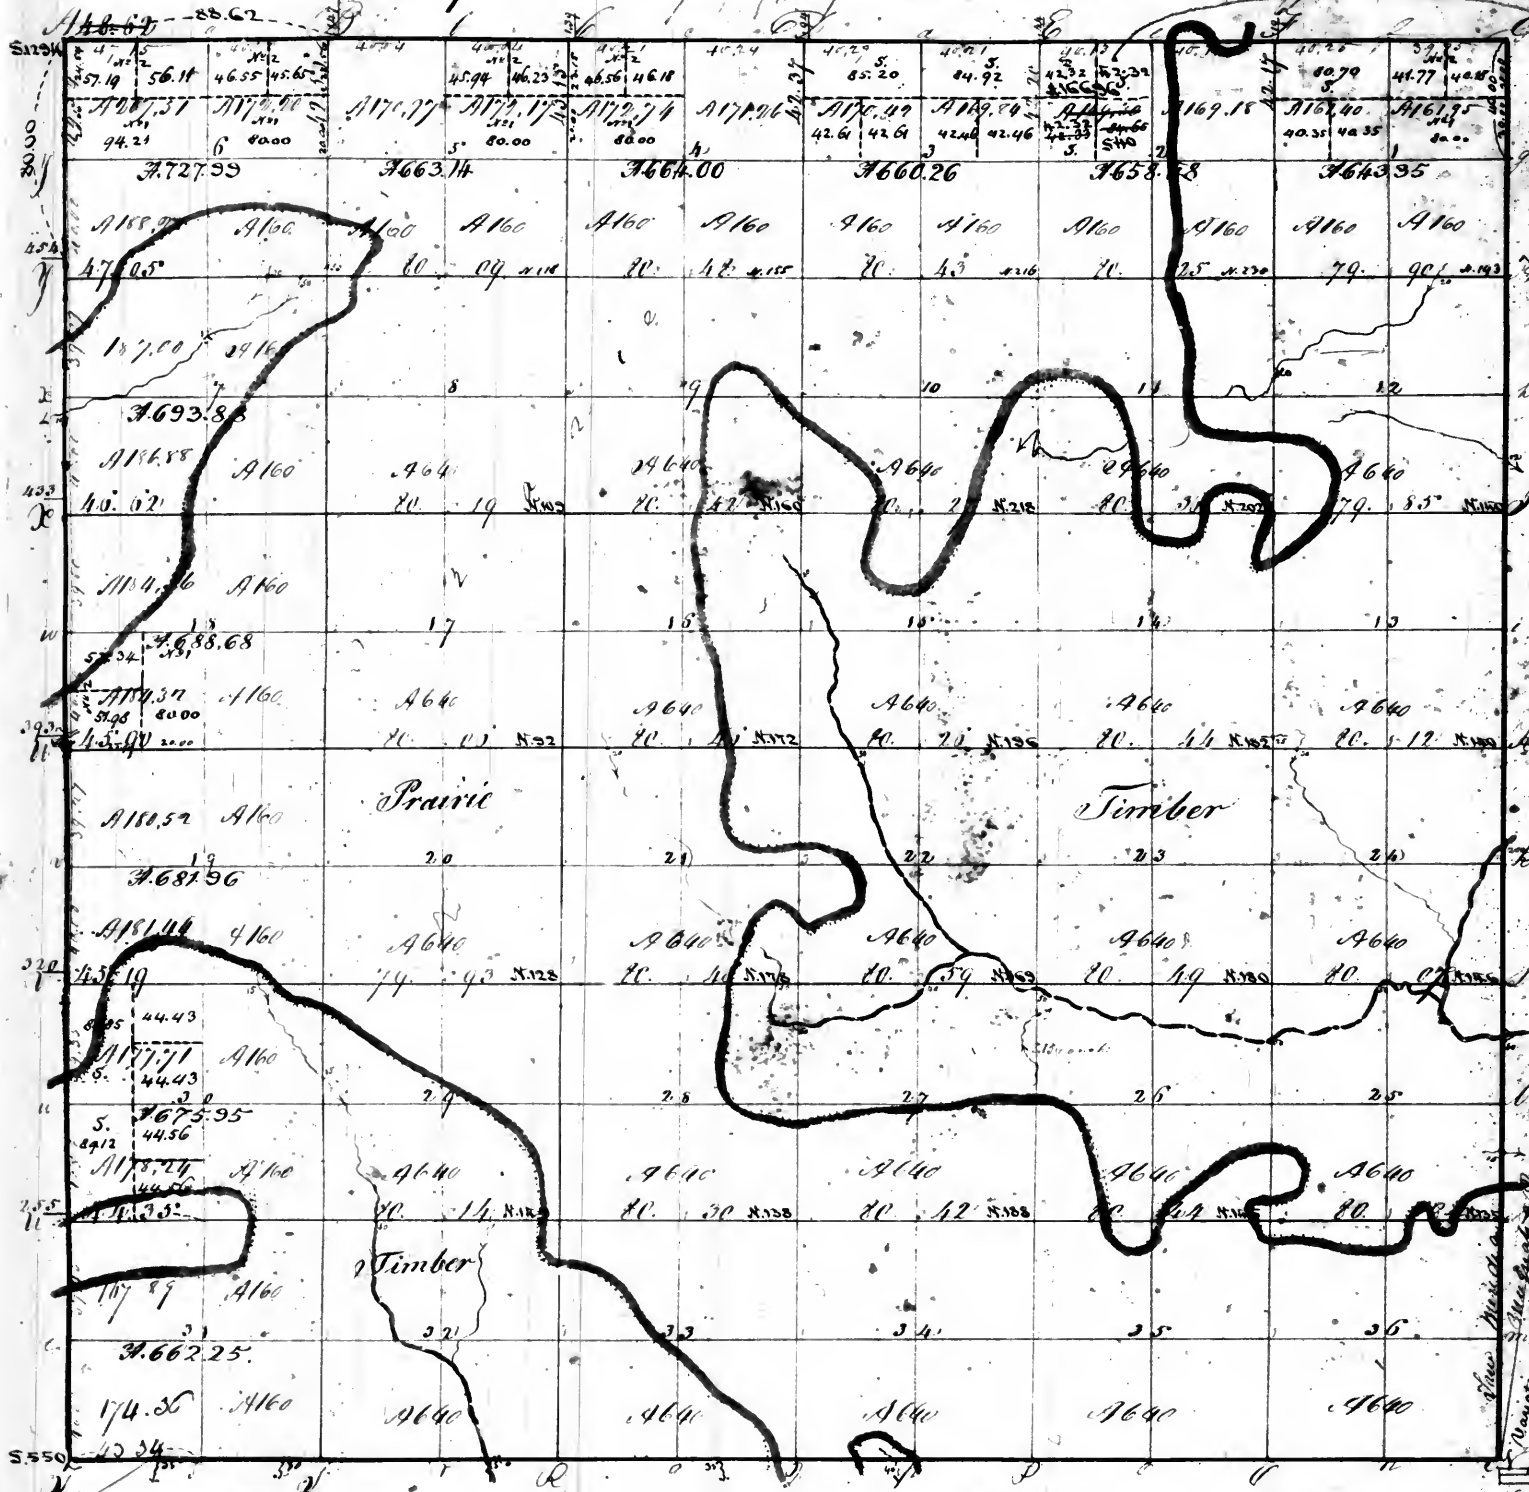

See letter from Register 6th June 1850

*Surveyor's office
Saint Louis July 11th 1850
The North East quarter of section 1-6,
the North West quarter of section 4, the
North half of section 6, the South
West quarter of section 8 subdivided
under the act of Congress of the 3^d of
April 1832 - the North West quarter
of section 14-2, the North half of section
3, the West half of section 30, and
divided so as to conform to previous
sales marked S. 1/2, and placed
to the Register and entered to the
Commissioners of the General
Land Office -*

106

Aggregate area = 23419.94 acres

Scale of 20 Ch. to an inch

Pursuant to a contract with, and instructions from William Recker, Surveyor of the lands of the United States in the Territories of Illinois and Missouri, bearing date the _____ day of _____ I have administered, laid out and surveyed the above described Township and do hereby certify, it had such marks and bounds, both natural and artificial, as are represented on this plat, and described in the field notes made thereof, and returned with this plat into the office of the Surveyor of the lands of the United States in the State of Illinois and Territories of Missouri and Arkansas.

Recorded

3 1/2

10

Town No 10 North of the Base line Range No one East of Third Principal Meridian



Surveyor's office
The North halves of sections 4, 5, 6,
subdivided under the act of the 5th
April 1832, and the North halves
of sections 17, 18, and the North West
quarter of section 3 subdivided so
as to conform to previous sales
1/4 marked S. 1/4 - placed at the
Surveyor's and entered to the Com-
missioner of the General Land
Office same day

Pursuant to a contract with and instructions from Hon. Robert T. Hunter, Surveyor of the Lands of the United States in the State of Illinois & Territories of Missouri & Arkansas, bearing date the seventeenth day of May in the year one thousand eight hundred & twenty, I have admeasured laid out & surveyed the above described Township & do hereby certify that it had such marks and bounds both natural and artificial as are represented on said plat and described in the field notes made thereof and returned with this plat into the office of the Surveyor of the Lands of the United States for the State of Illinois & Territories of Missouri and Arkansas.


Dated this 30 day of November 1820.

Thos. Sanger Hamilton
By Surveyor

Revised

374 #1

Township No. 11 North of the base line, Range No. 01W East of the 3rd principal Meridian.

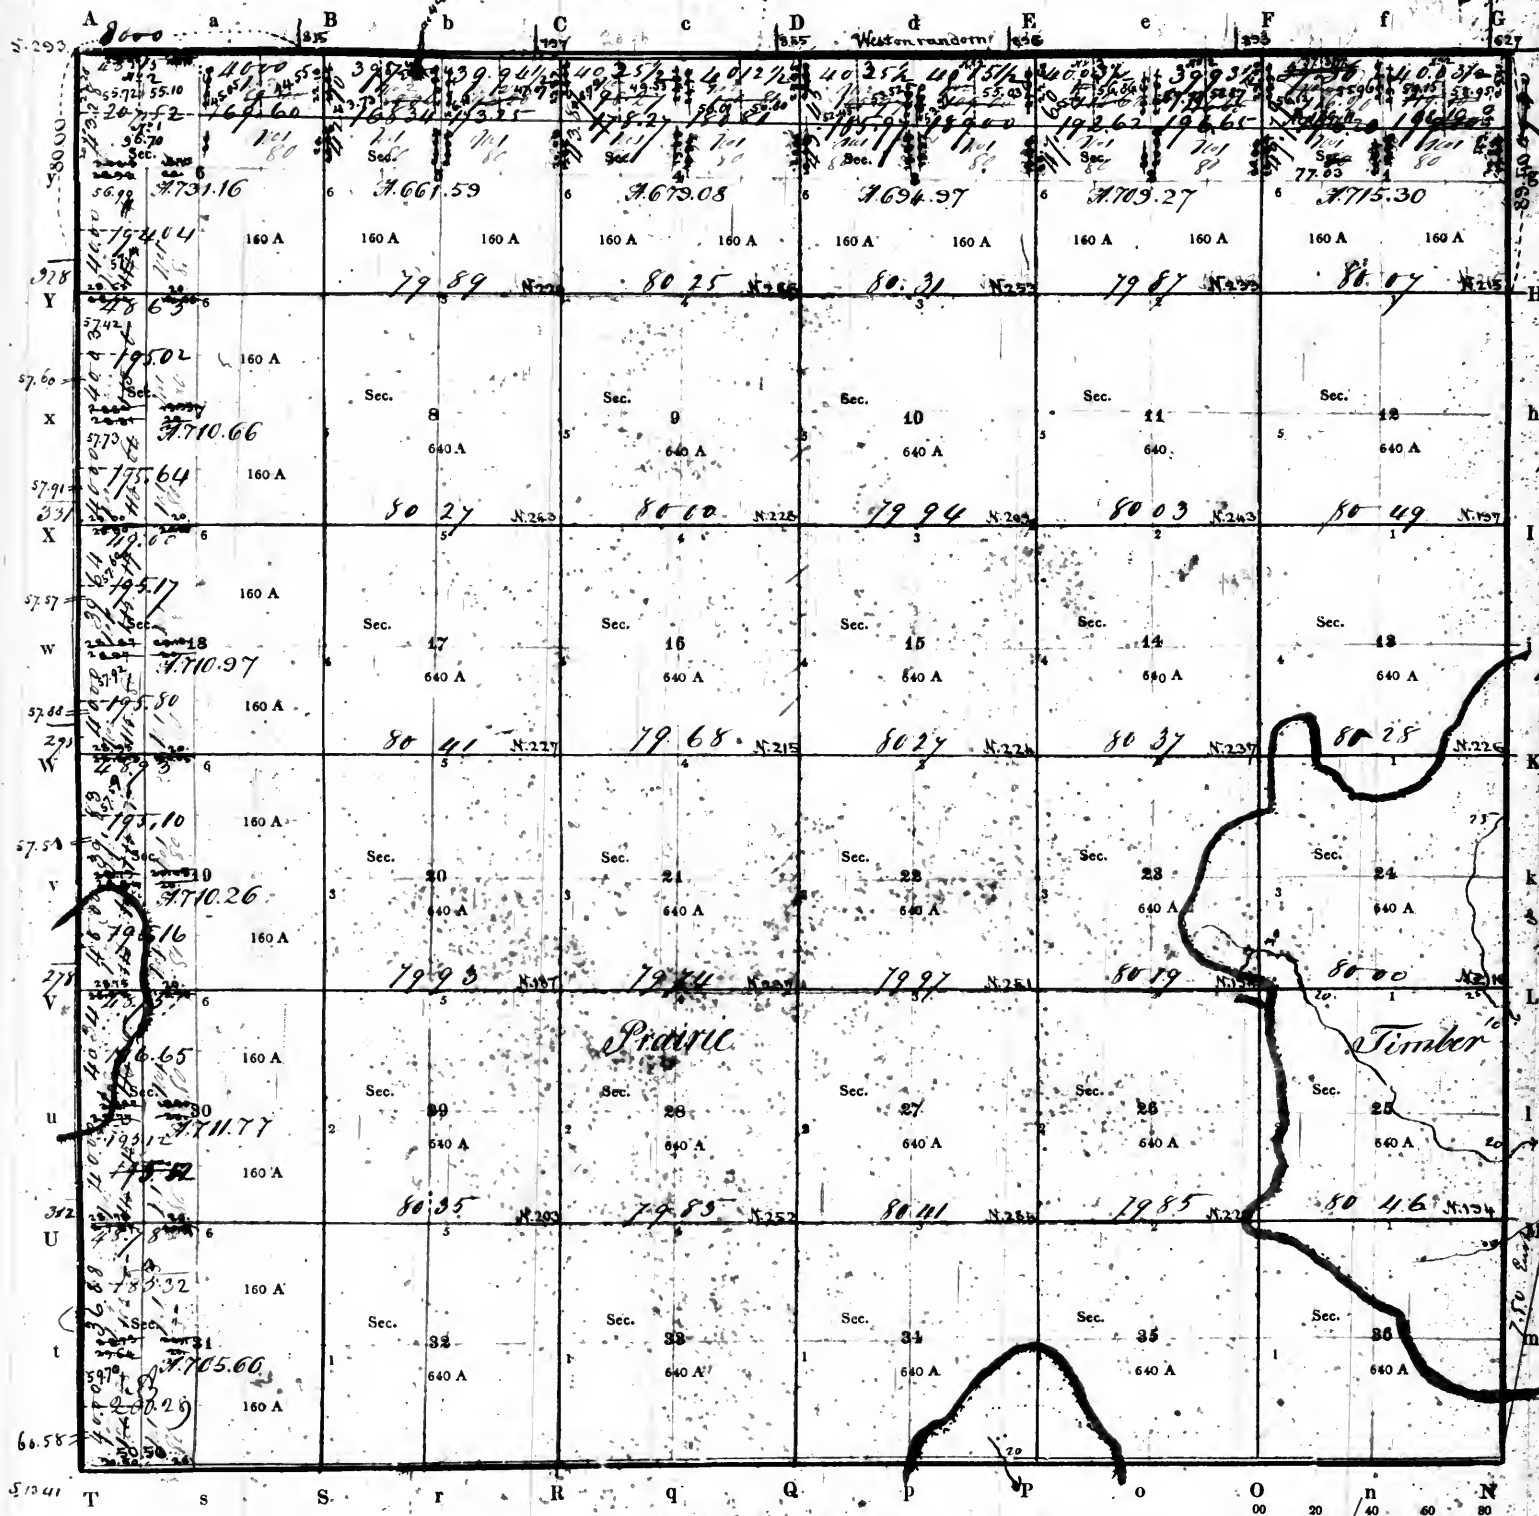

Office of the Surveyor General
for the State of Illinois
Saint Louis July 1857
The North halves of sec. 1, 2, 3, 4, 5,
the North half and the South west
quarter of section 6, and the west
halves of sec. 7, 18, 19, 30 & 31,
subdivided under the act of Congress
of the 5th of April 1832, and a
plot sent to the Register and
another to the Commissioner
of the General Land Office
on the same day

Surveyor's Office
St. Louis 10th August 1842.
Plot of the north half of sec.
1, 2, 3, 4, 5, of the N.E. 1/4 of the
N. of the West halves of sec. 6, 7,
18, 19, 30 & 31 sent this day to
the Commr of the Gen. L. O.

Aggregate area = 23740.63 acres

Scale of 40 Chains to an Inch

PURSUANT to a contract with, and instructions from WILLIAM RECTOR, Surveyor of the lands of the United States in the State of Missouri, and a Territory of Arkansas bearing date the Twentieth day of February 1821

I have admeasured, laid out and surveyed the above described Township; and do hereby certify, that it had such marks and bounds, both natural and artificial, as are represented on said plat, and described in the field notes made thereof, and returned with this plat into the Office of the Surveyor of the lands of the United States, for the State and Territory aforesaid

Certified this Thirtieth day of May A.D. 1824.


Jm S. Hamilton D. SURVEYOR

EXAMINED.

Recorded

375

Township No. 12 North of the base line, Range No. 11 East of the 3rd principal Meridian.

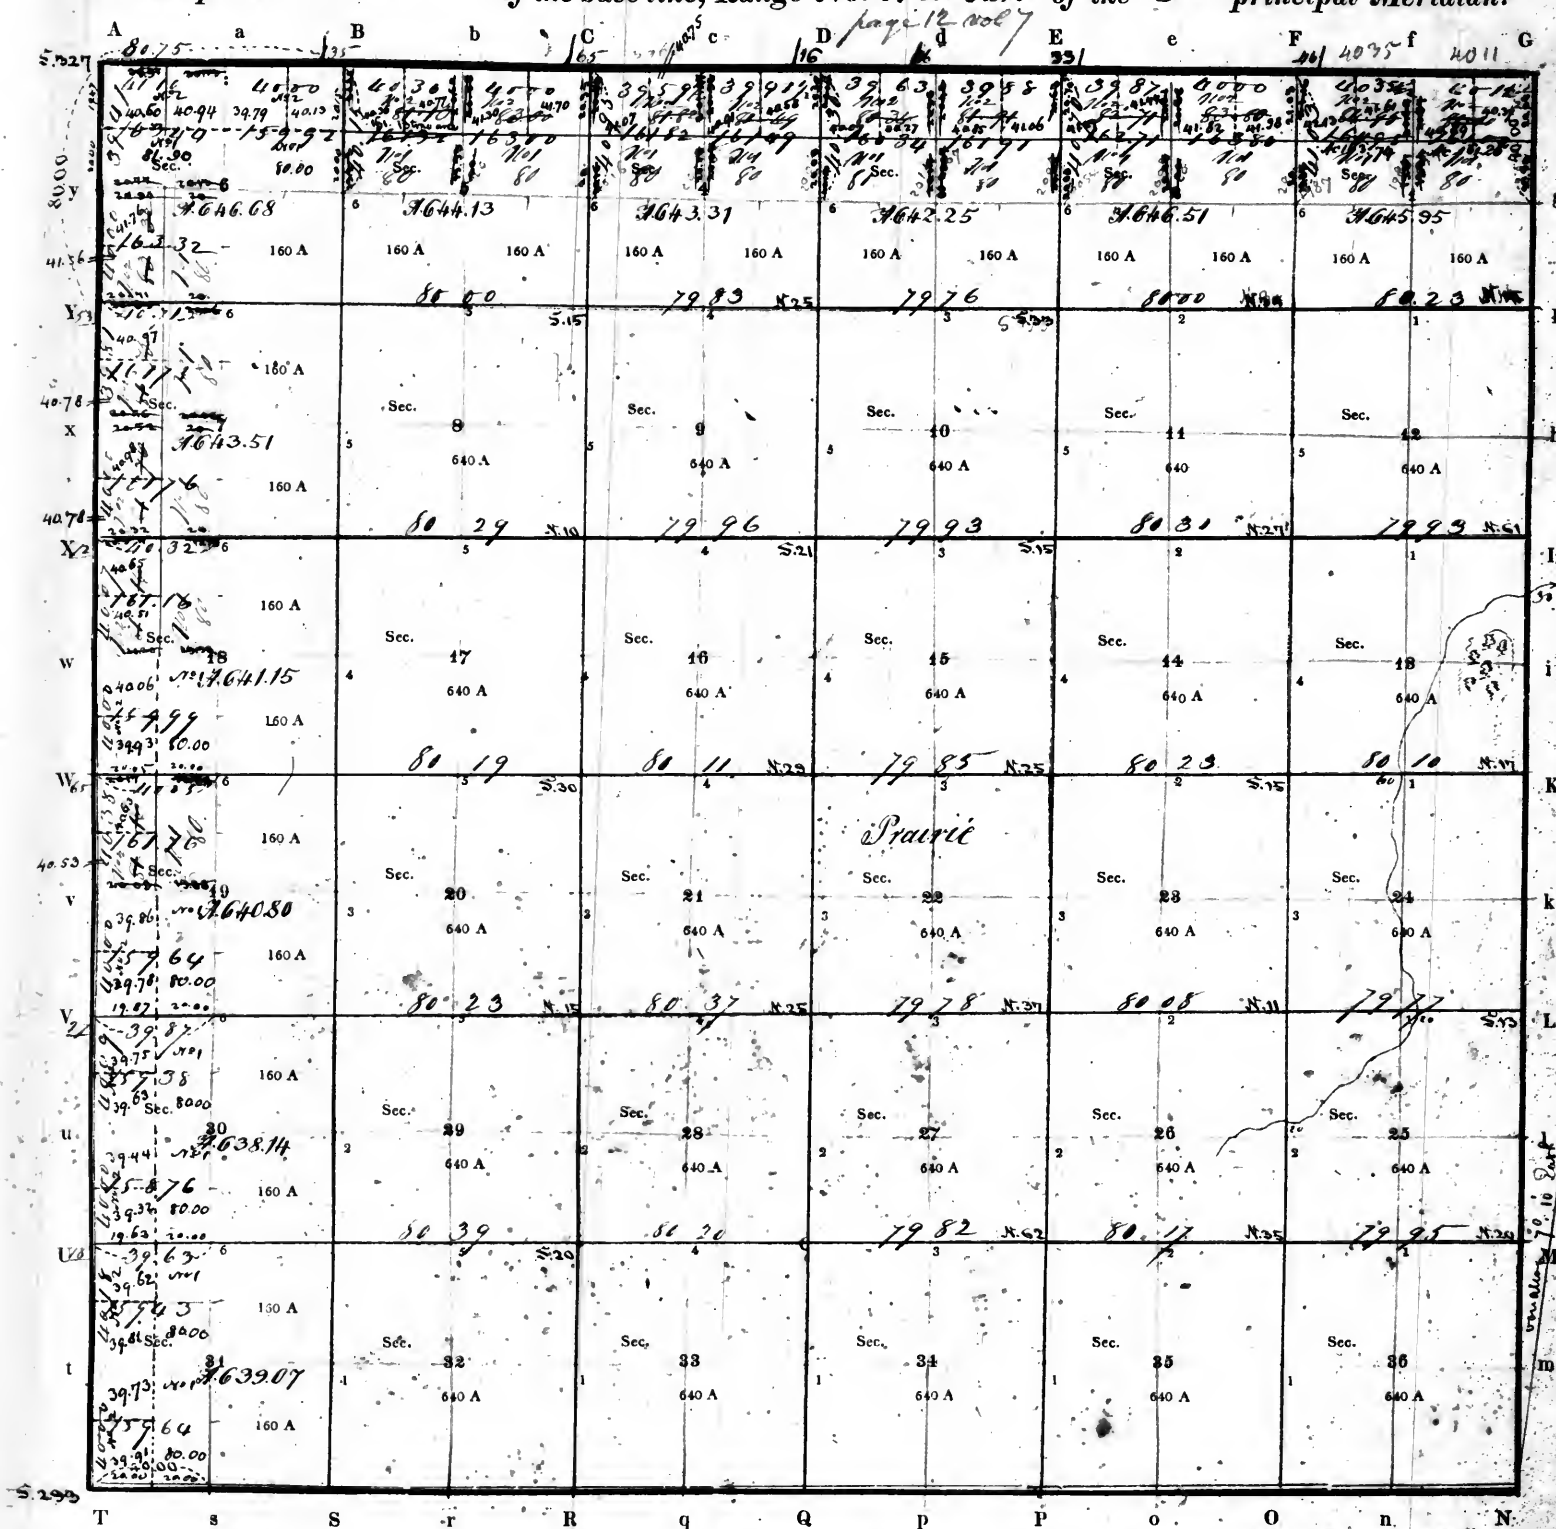

Aggregate area = 23071.50 acres

Scale of 40 Chains to an Inch.

PURSUANT to a contract with, and instructions from WILLIAM RECTOR, Surveyor of the lands of the United States in the State of Missouri, bearing date the 10th day of February 1821, I have admeasured, laid out and surveyed the above described Township; and do hereby certify, that if had such marks and bounds, both natural and artificial, as are represented on said plat, and described in the field notes made thereof, and returned with this plat into the Office of the Surveyor of the lands of the United States, for the State and Territory aforesaid.

Certified this 31st day of May 1821

EXAMINED.

Wm. A. Hamilton


D. SURVEYOR

Office of the Surveyor General for the State of Missouri and Missouri Territory, St. Louis, July 18th 1851. The North halves of sections 1, 2, 3, 4, 5, 6, and the West halves of sections 7, 8, and a plot sent to the Register and under to the Commissioner of the General Land Office, on the same day.

Surveyor's Office, St. Louis, 10th August 1842. Part of the North halves of Sects 1, 2, 3, 4, 5, 6, of the West halves of Sects 7, 8, 9, 10, 11, 12, 13, 14, 15, sent this day to the Commr of the Genl. L.

Revised

Township No. 13 North of the base line, Range No. One East of the 3^d principal Meridian. 376

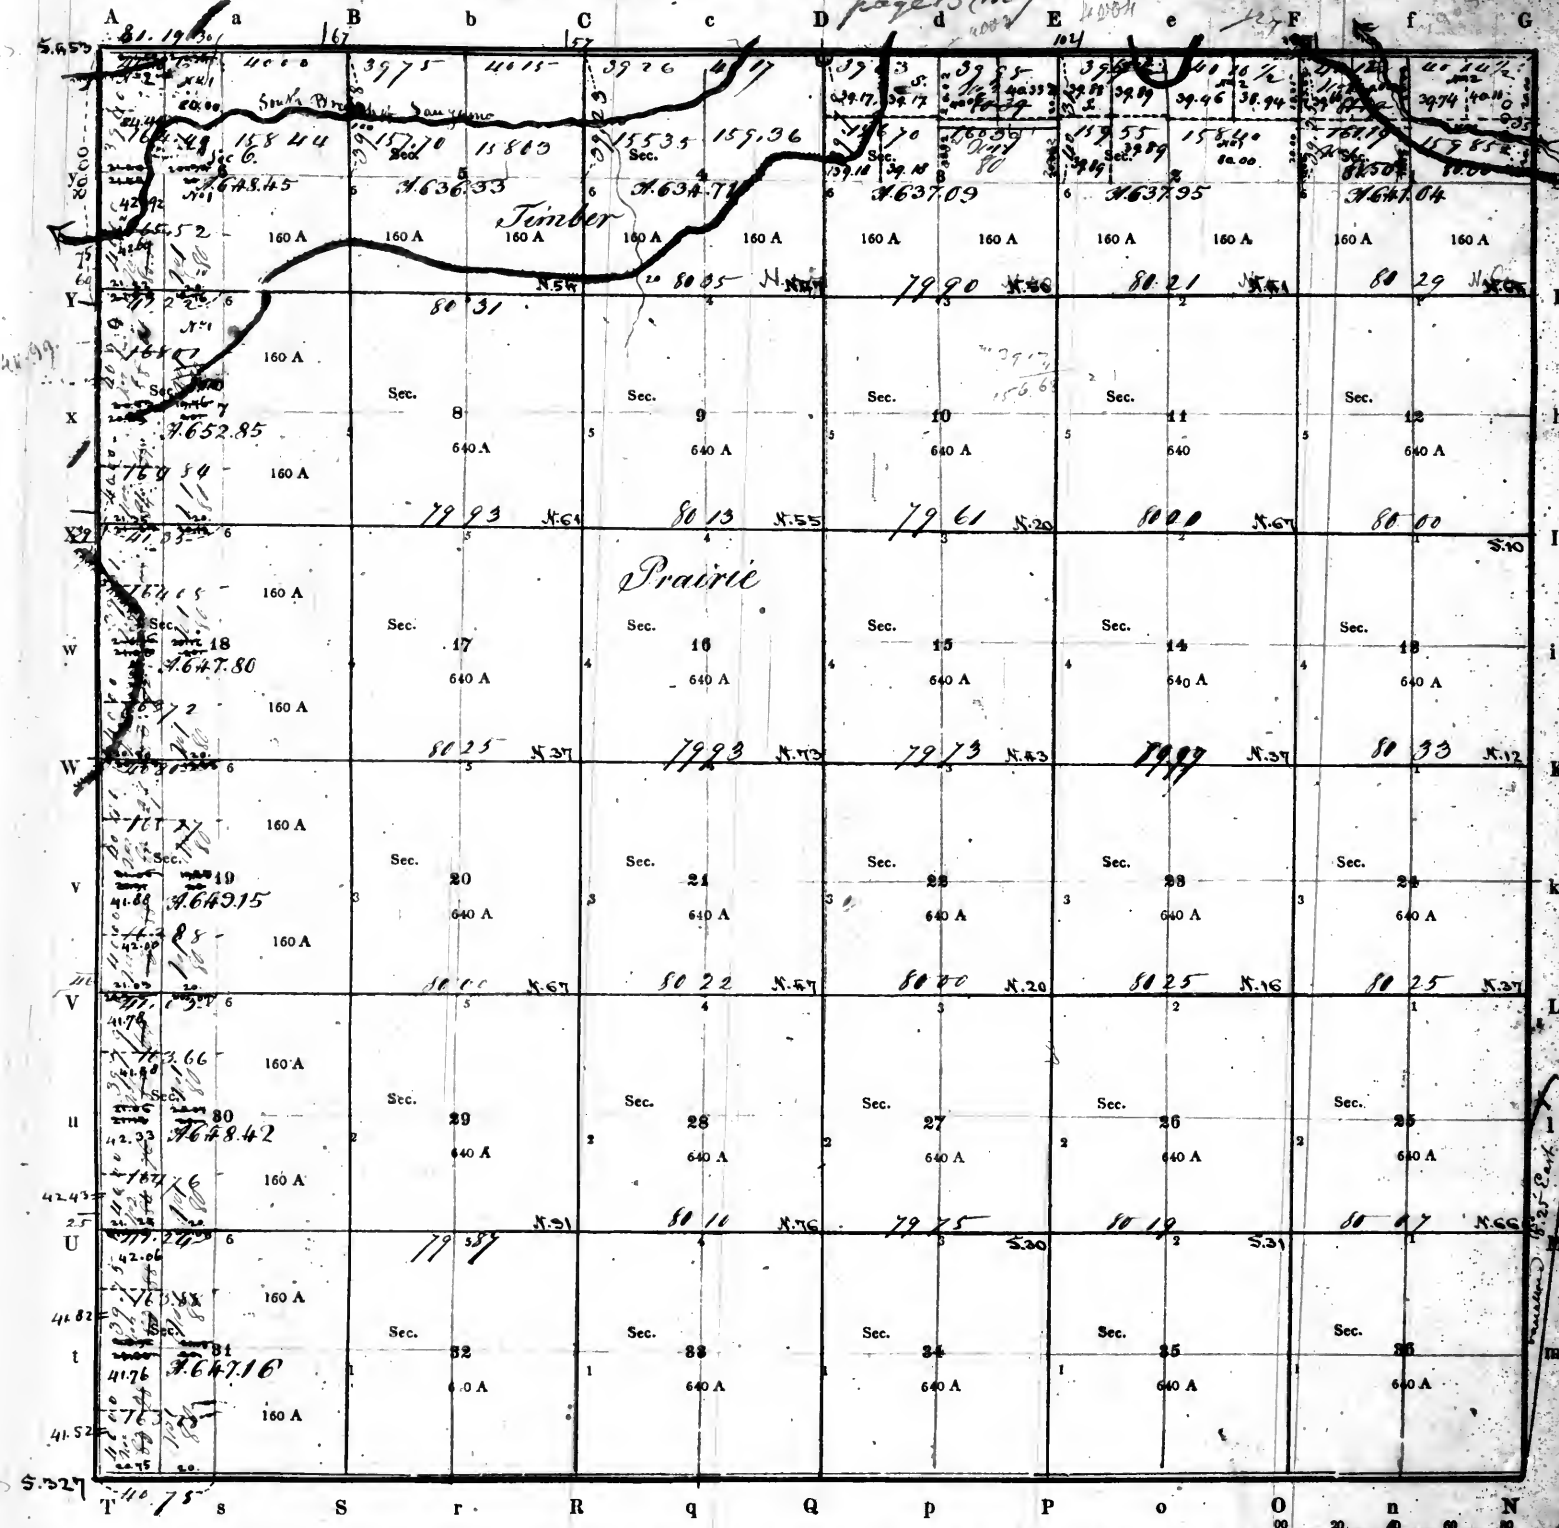

Aggregate area = 23080.95 acres

Scale of 40 Chains to an Inch.

PURSUANT to a contract with, and instructions from WILLIAM RECTOR, Surveyor of the lands of the United States in the State of Missouri & Territory of Arkansas bearing date the Twentieth day of February 1821

I have admeasured, laid out and surveyed the above described Township; and do hereby certify, that it had such marks and bounds, both natural and artificial, as are represented on said plat, and described in the field notes made thereof, and returned with this plat into the Office of the Surveyor of the lands of the United States, for the State and Territory aforesaid

Certified this Thirty first day of May. 1821


EXAMINED.

Wm. Hamilton D. SURVEYOR

Surveyor's Office
St. Louis 11th August 1842.
Plat of the N.W. 1/4 of Sec. 1, of the
N.E. 1/4 of Sec. 3, and of the West halves
of Sections 6, 7, 10, 13, 20, 31, sent
this day to the Commr of the Genl.
S. Office.
Surveyor's Office
St. Louis Sept. 15th 1849.
The N.W. 1/4 of quarter of
section 2, 1/2, 3, 4,

Township No. 14 North of the base line, Range No. 10 East of the 3rd principal Meridian.

377

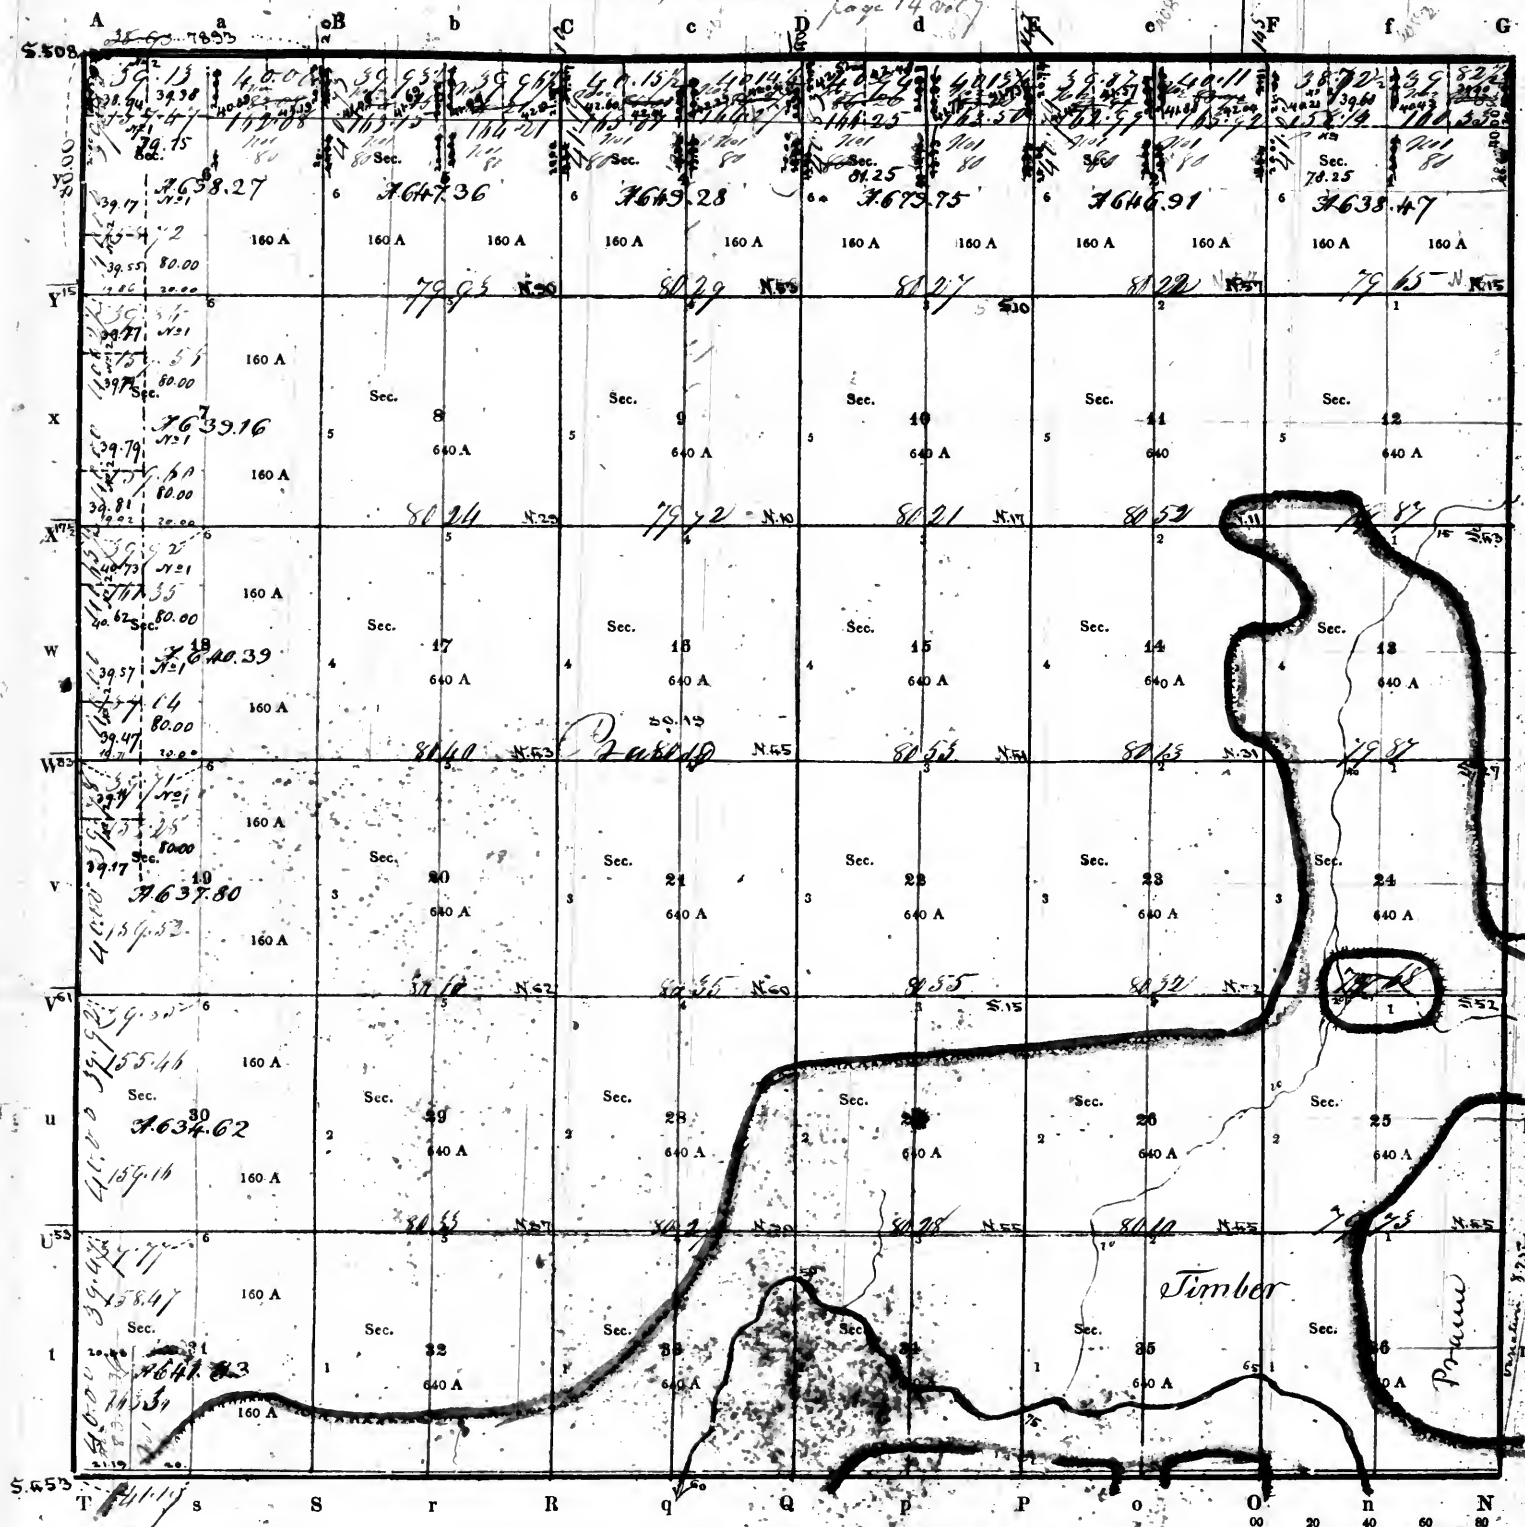

Surveyor's Office
St. Louis 10th August 1842.
Plat of the N.E. quarter of Sec. 14G
and of the North halves of Sections
2, 3, 4, 5, sent this day to the
Comptroller of the Genl. & O.

Surveyor's Office
St. Louis Sept. 15th 1849
The West halves of sections 6, 7, 8, 9,
and the North and quarter of
section 10, included under the
act of Congress of the 5th of
April 1832, and a plat of
the same sent to the Register
Land and another to the Comptroller
of the General Land Office
same day

Office of the Surveyor General
for the State of Illinois and Missouri
St. Louis Oct. 26th 1857
The North halves of sections 1, 2, 3, 4, 5,
and the North and quarter of section
6, included under the act of
Congress of the 5th of April 1832,
and a plat sent to the Register
and another to the Comptroller
of the General Land Office
on the same day

Aggregate area - 23,063.84 acres

Scale of 40 Chains to an Inch.

PURSUANT to a contract with, and instructions from WILLIAM RECTOR, Surveyor of the lands of the United States in the State of Illinois, bearing date the 10th day of February, 1842.

I have admeasured, laid out and surveyed the above described Township; and do hereby certify, that it had such marks and bounds, both natural and artificial, as are represented on said plat, and described in the field notes made thereof, and returned with this plat into the Office of the Surveyor of the lands of the United States, for the

Certified this 1st day of Jan 1842

EXAMINED.

D. SURVEYOR.

Recorded 378

Township No 12, North of the base line. Range No 1, East of the third principal meridian

Page 15, 1007



Aggregate area = 23152.13 acres

Scale of 40 chains to an inch

Surveyor's office
Saint Louis Sept. 15th 1849
The South West quarters of sections
6 & 30 the west half of section 7,
and the North West quarter of
section 31, included under the
act of Congress of the 5th April
1820, and a plat sent to the Com-
missioner of the General Land Office
Same day -
Office of the Surveyor General
for the State of Missouri, St. Louis
Same day
The North halves of sections 12, 3,
4, 5 & 6, included under the
act of Congress of the 5th April
1820, and a plat sent to the Com-
missioner of the General Land Office

Pursuant to a contract with, and instructions from William P. Foster, Surveyor of the lands of the United States of the States of Illinois & Missouri & Territory of Arkansas, bearing date the 5th day of March 1821, I have admeasured, laid out & surveyed the above described Township, & do hereby certify that it had such marks & bounds both natural & artificial, as are represented on said plat, and described in the field notes made thereby, and returned into the Office of the Surveyor of the lands of the United States, for the States of Illinois & Missouri & Territory of Arkansas.

Witness this 24th day of June 1822.


J. H. Anderson S. L.

Revised

379

16


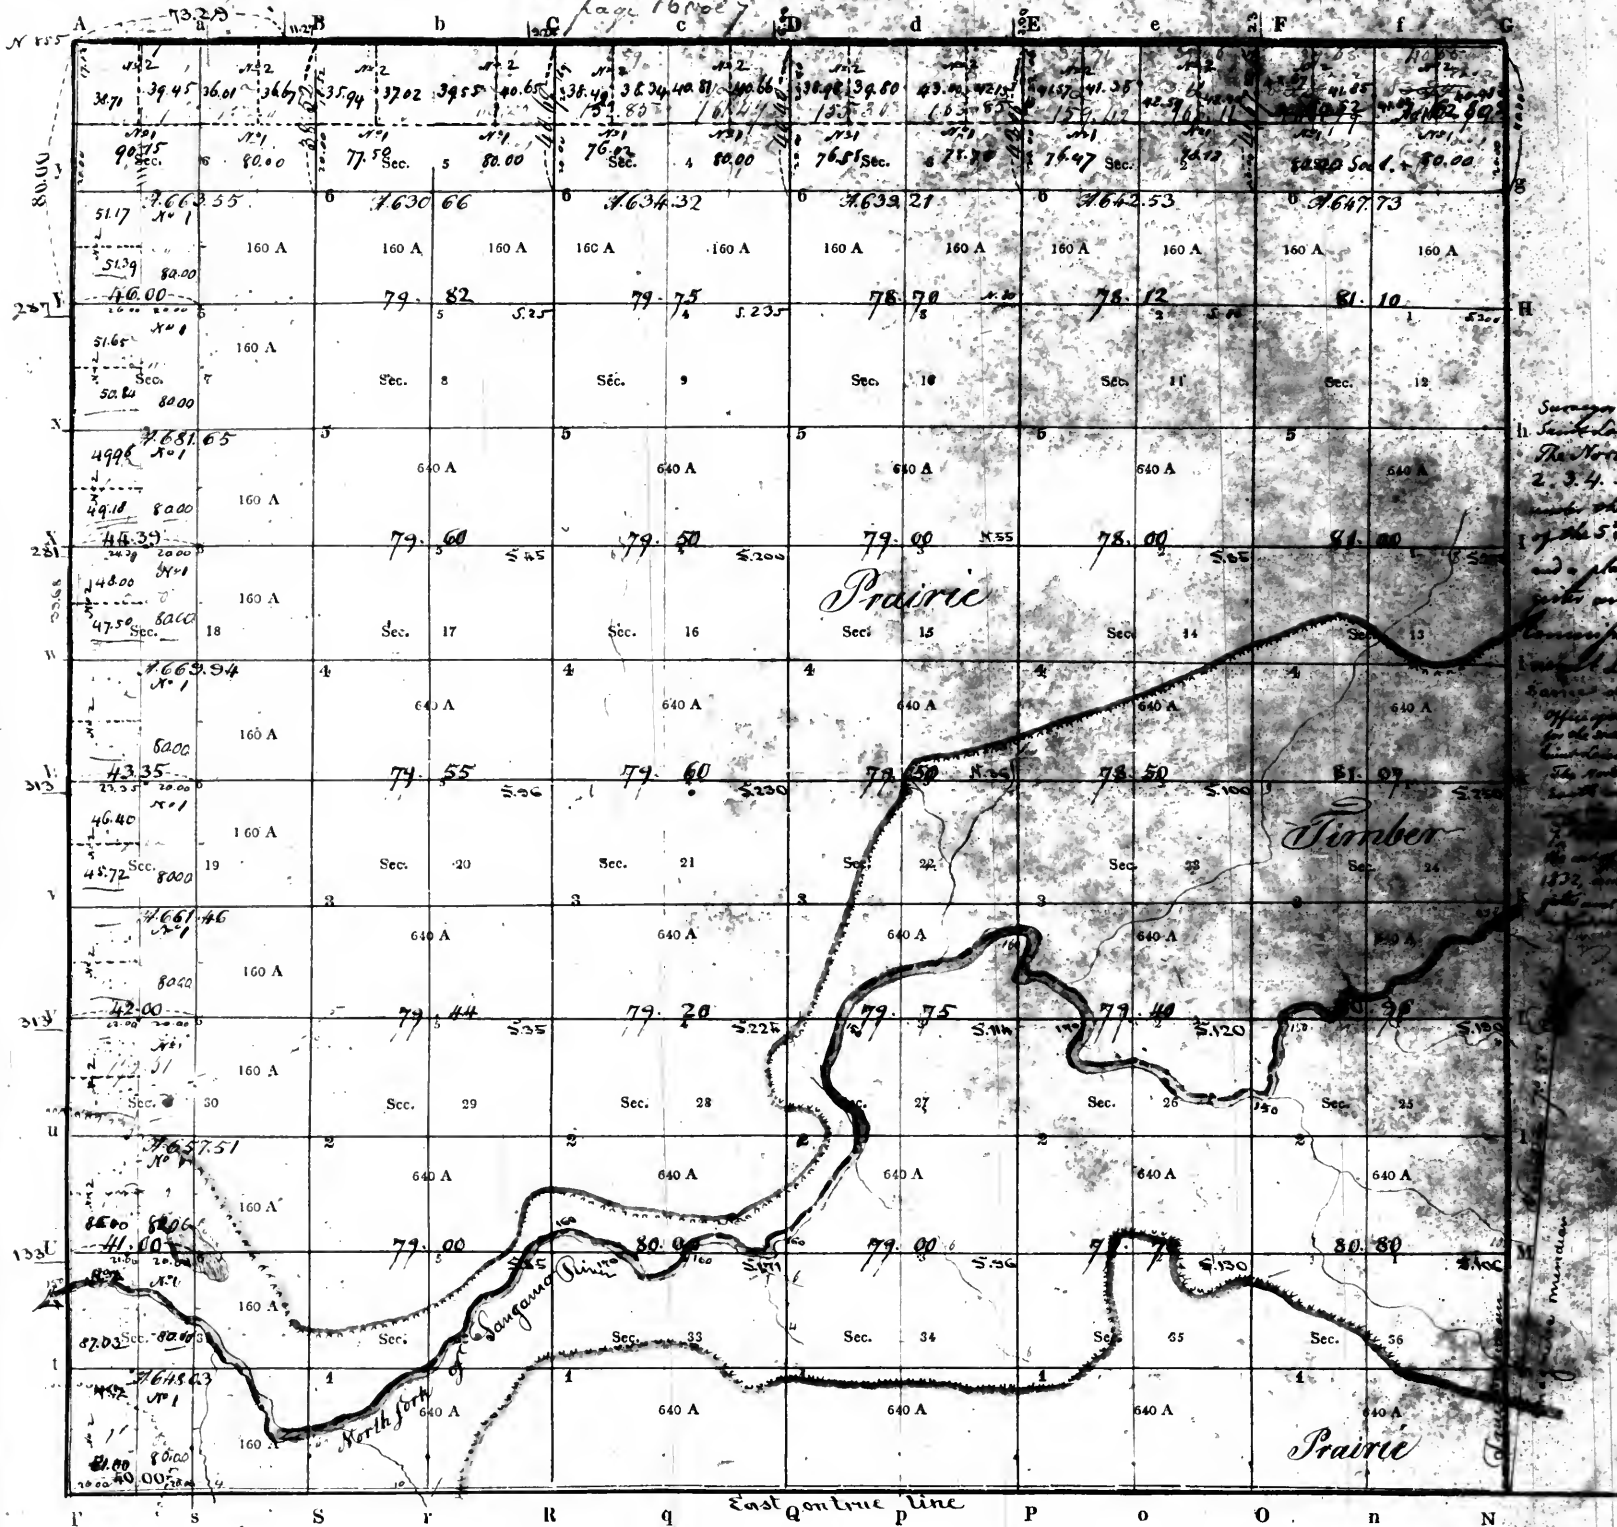

Surveyor's office
Sept. 15th 1832
The North fork of Sangamon
River, Sangamon Co. Illinois
was shown of Sangamon
of the 5th of April 1832
and a plat made to the
Commissioners of the
Land Office

PURSUANT to a contract with, and instructions from **William Rector**, Surveyor of the lands of the United States in the *State of Illinois*, bearing date the *fourteenth* day of *February* 1832, I have measured, laid out and surveyed the above described Township; and do hereby certify, that it had such marks and bounds, both natural and artificial, as are represented on said plat, and described in the field notes made thereof, and returned with this plat into the Office of the Surveyor of the Lands of the United States, in the *State of Illinois* *Missouri* and *Territory of Arkansas*.

Certified this *first* day of *March* 1833
EXAMINED.


Wm Rector
D. SURVEYOR.

Record

380

Township No. *17 North* of the base line, Range No. *1 East* of the *3rd* principal Meridian.

N. 866 32.33 A 45.73 B C page 17 of 27 D E F G

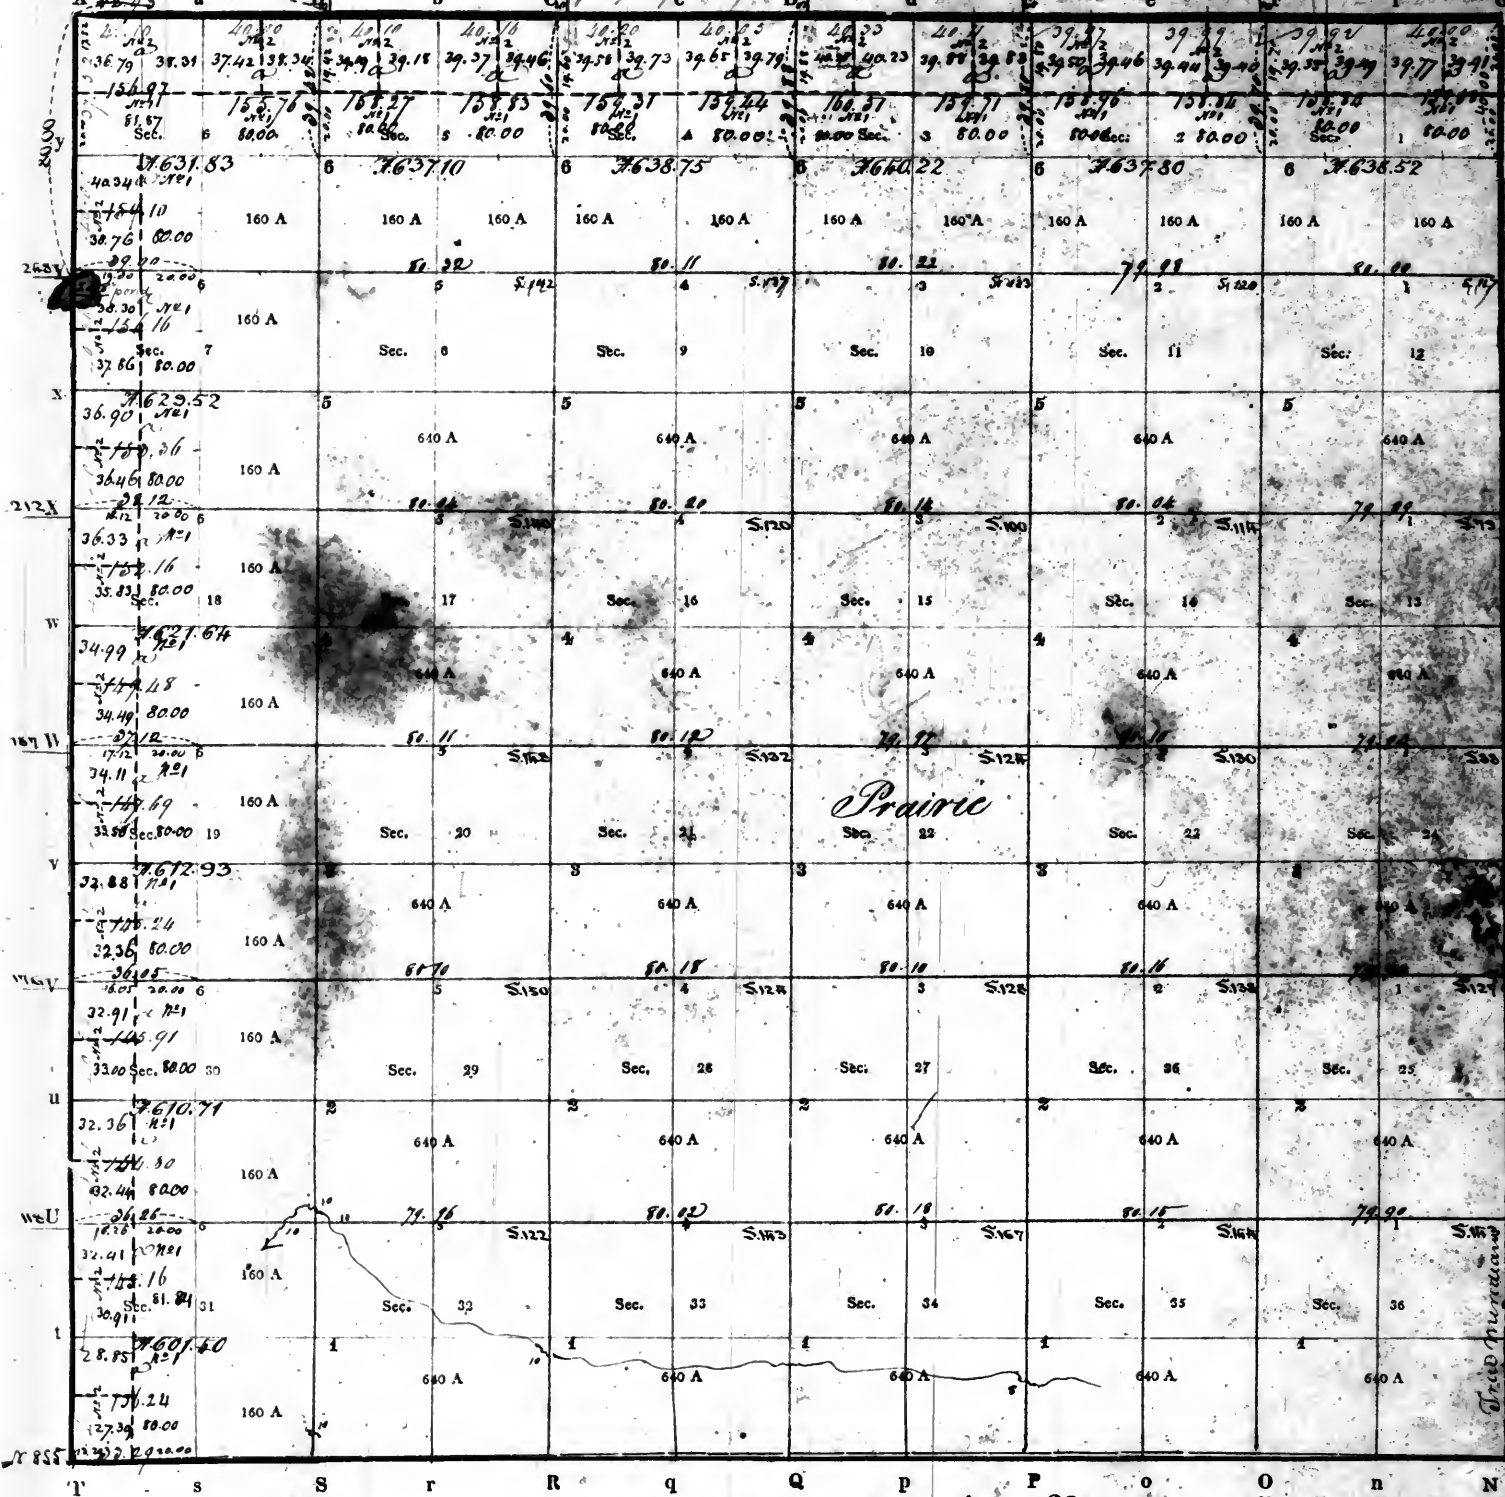


Surveyor's office

True Meridian
and
with

PURSUANT to a contract with, and instructions from William Rector, Surveyor of the lands of the United States in the *State of Illinois*
Missouri and Territory of Arkansas
 I have admeasured, laid out and surveyed the above described Township; and do hereby certify, that it had such marks and bounds, both natural and artificial,
 as are represented on said plat, and described in the field notes made thereof, and returned with this plat into the Office of the Surveyor of the Lands of the
 United States, in the *State of Illinois, Missouri and Territory of Arkansas*
 Certified this *1st* day of *March* 1893
 EXAMINED.
Wm Rector SURVEYOR.

Township No. *Eighteen North* of the base line, Range No. *One East* of the *Third* principal Meridian.

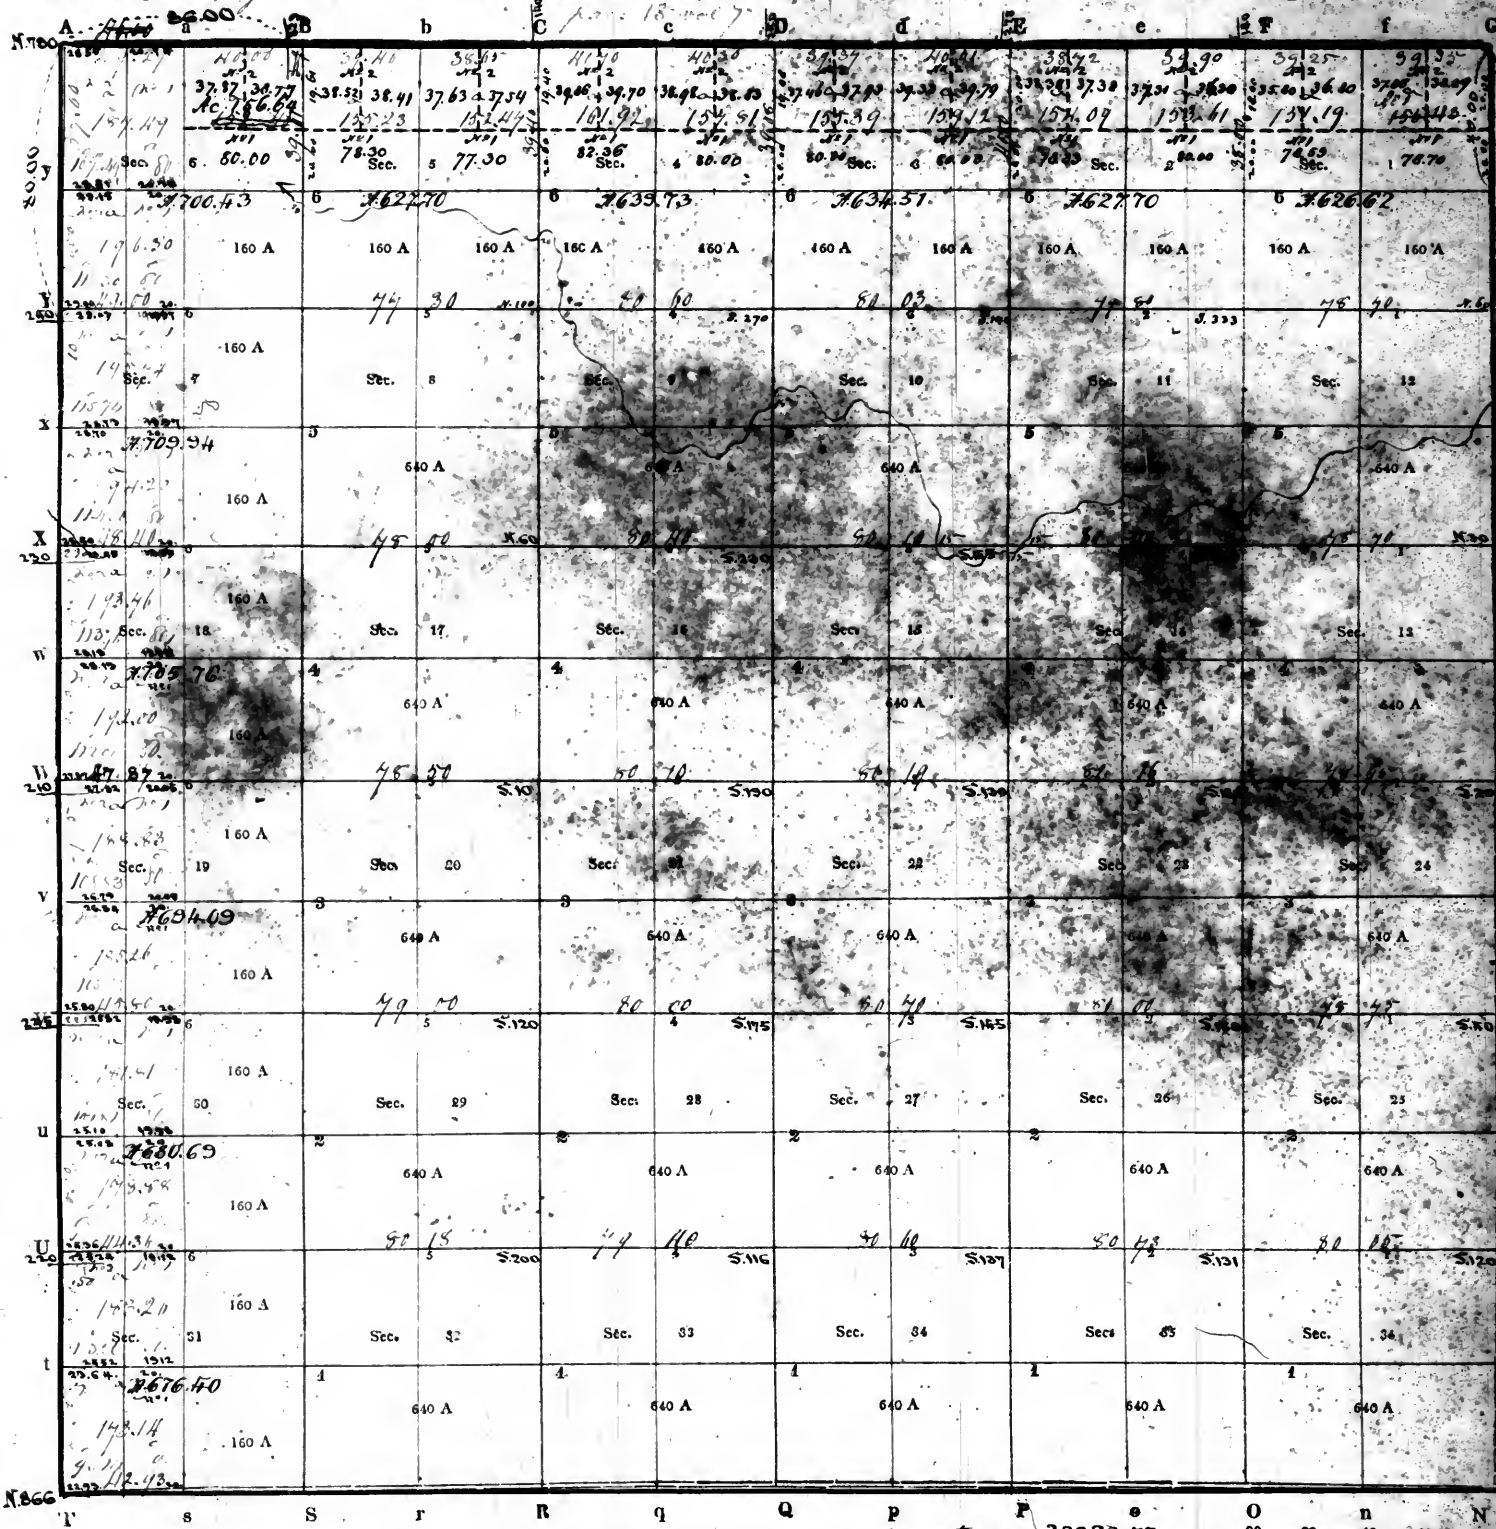

PURSUANT to a contract with, and instructions from William Rector, Surveyor of the lands of the United States in the *State of Illinois* bearing date the *nineteenth* day of *February* 1882 I have measured, laid out and surveyed the above described Township; and do hereby certify, that it had such marks and bounds, both natural and artificial, as are represented on said plat, and described in the field notes made thereof, and returned with this plat into the Office of the Surveyor of the Lands of the United States, in the *State of Illinois* *McParr and Territory of Arkansas*

Certified this *first* day of *March* 1882

EXAMINED.

W. Rector D. SURVEYOR.

15713


7957
7929

Revised

382

19

Township No. *19 North* of the base line, Range No. *1 East* of the *P* principal Meridian.

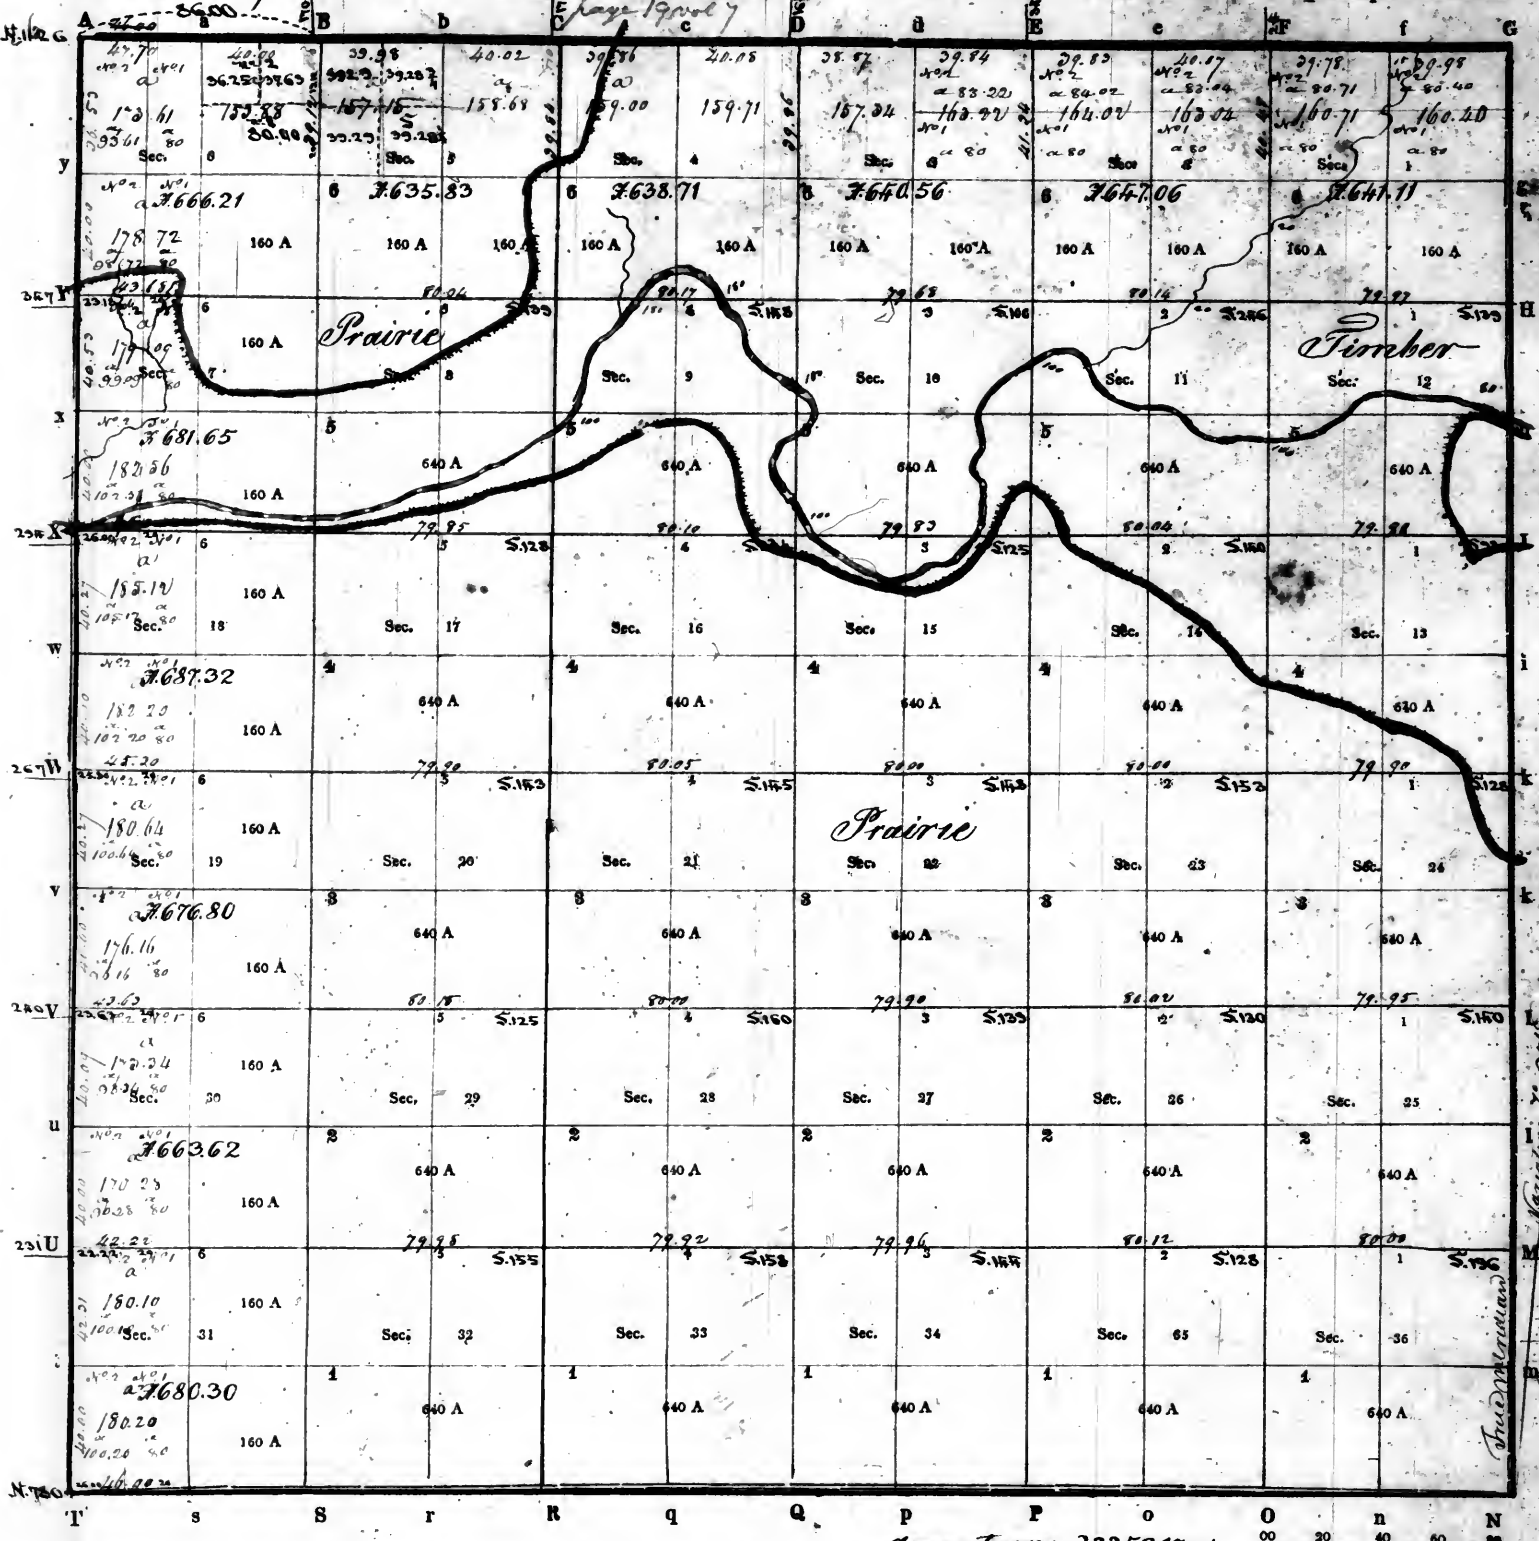


*Surveyor's Office
St. Louis 15 Sept 1886
Sent to the Register along
with the plat of Sec. 31 and 32 of the N.W.
Sec. 36 this day and another copy
of the plat of the said Sec. 31 and 32
the same day.*

PURSUANT to a contract with, and instructions from William Reeter, Surveyor of the lands of the United States in the *State of Illinois*
bearing date the *nineteenth* day of *February* 1882
I have admeasured, laid out and surveyed the above described Township; and do hereby certify, that it had such marks and bounds, both natural and artificial,
as are represented on said plat, and described in the field notes made thereof, and returned with this plat into the Office of the Surveyor of the Lands of the
United States, in the *State of Illinois* *Missouri and Territory of Arkansas*
Certified this *first* day of *March* 1882
EXAMINED.
Whorton Reeter D. SURVEYOR.

Recorded

383

Township No. 20 North of the base line, Range No. 1 East of the principal Meridian.

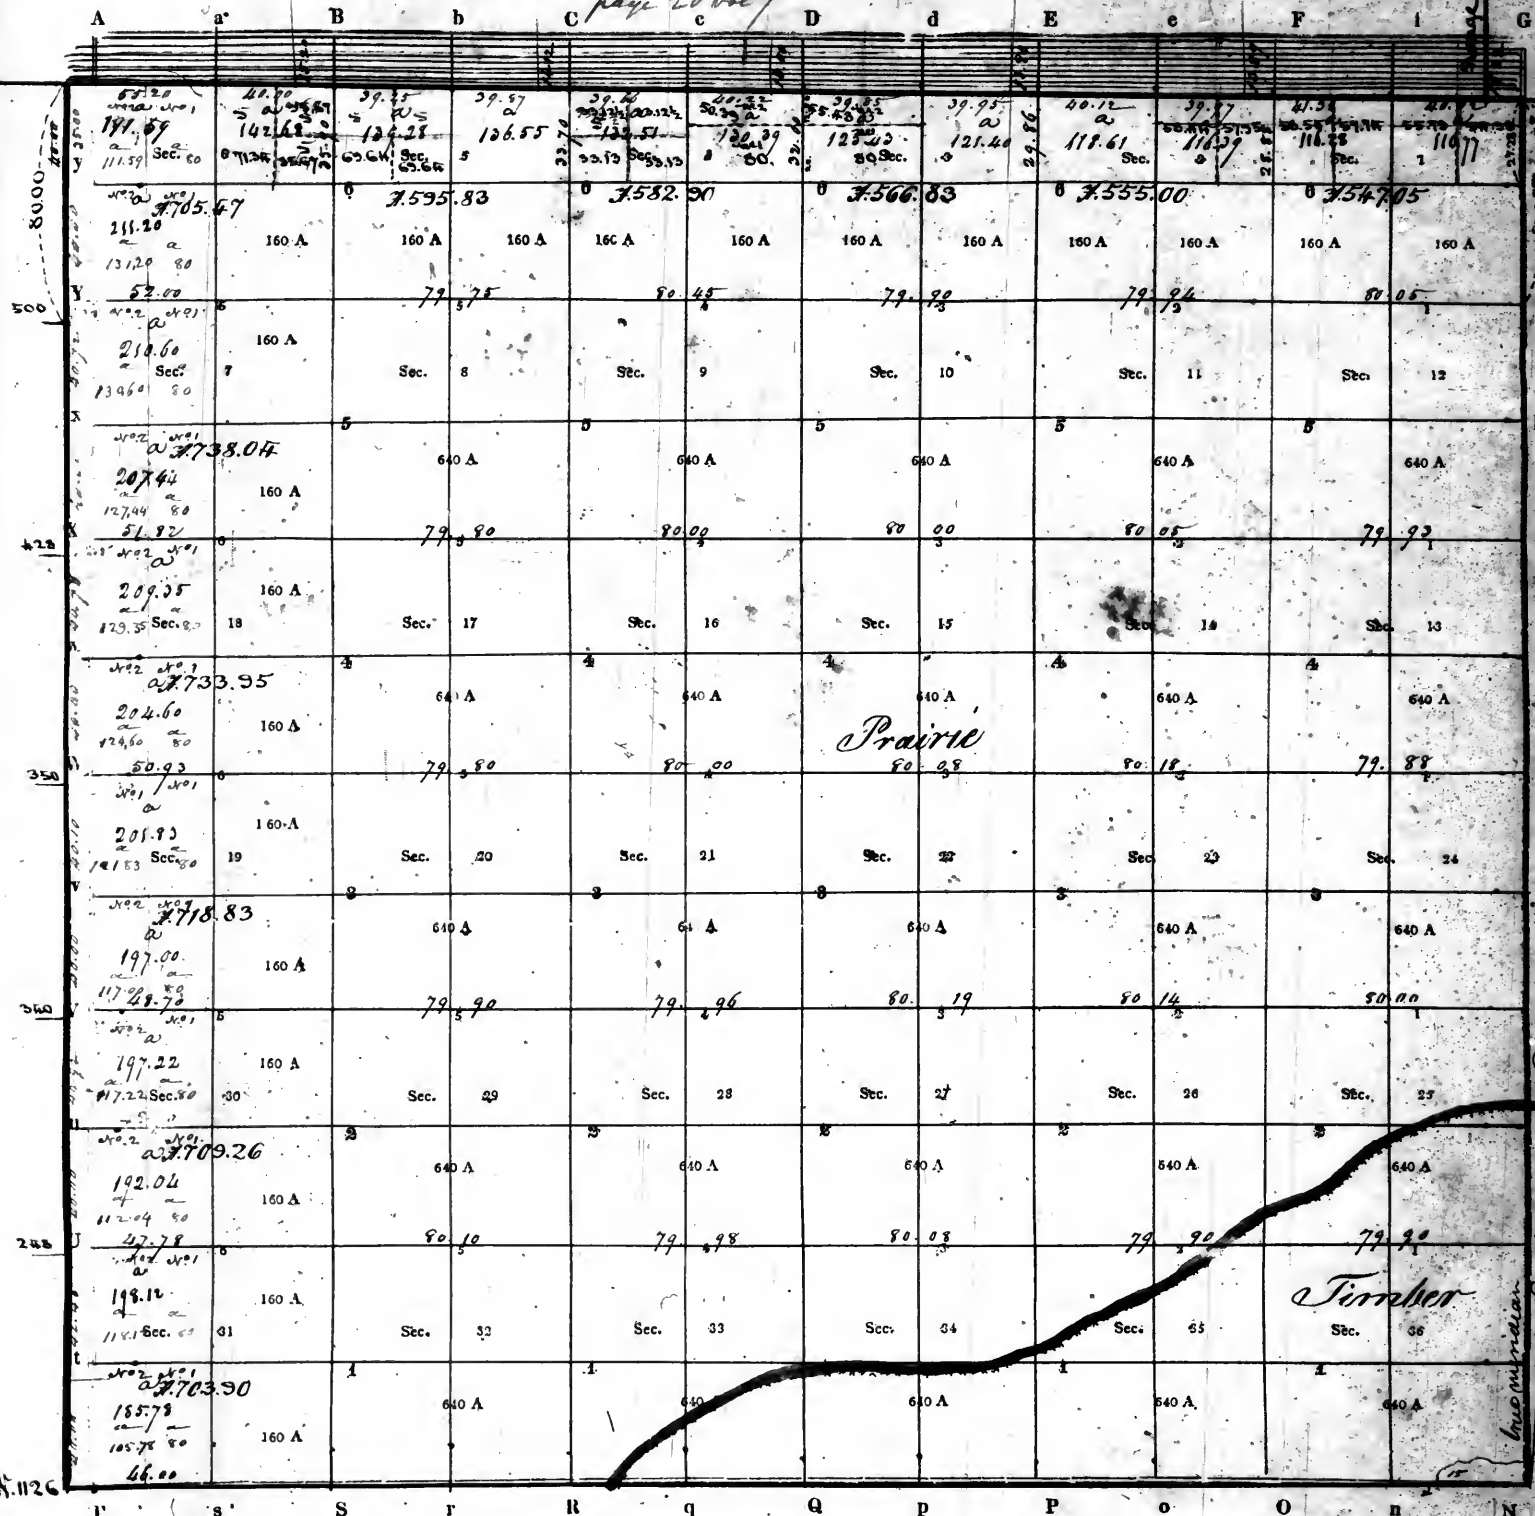

Aggregate area = 23157.06 ac

Scale of 40 Chains to an Inch.

PURSUANT to a contract with, and instructions from William Rector, Surveyor of the lands of the United States in the States of Illinois and Territory of Arkansas, bearing date the 11th day of February 1822, I have measured, laid out and surveyed the above described Township; and do hereby certify, that it had such marks and bounds, both natural and artificial, as are represented on said plat, and described in the field notes made thereon, and returned with this plat into the Office of the Surveyor of the Lands of the United States, in the States of Illinois and Territory of Arkansas.


Certified this 1st day of March 1823

EXAMINED.

Wm Rector D. SURVEYOR

Recorded

Township No. 21. north of the base line. Range No. 1 East of the 3^d Principal Meridian

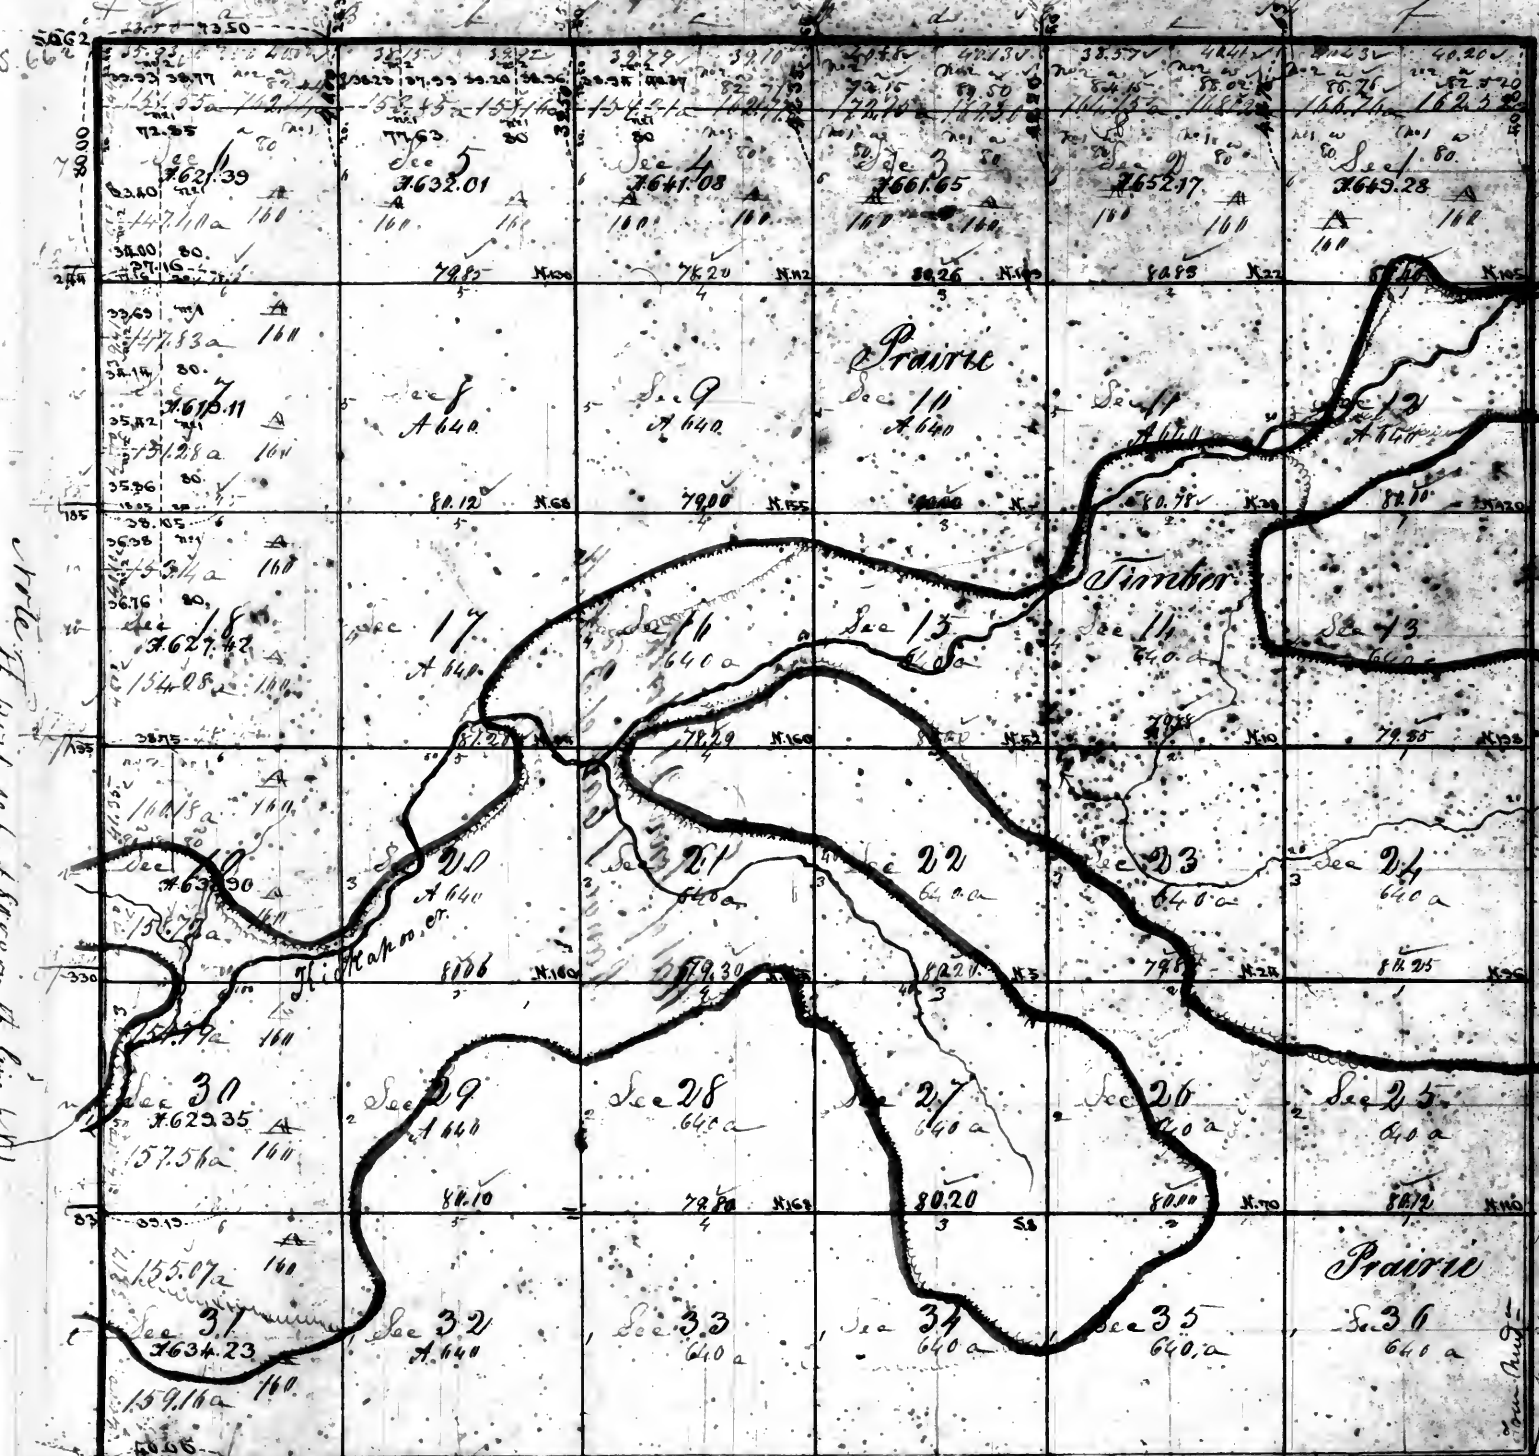

Surveyed by
J. H. Smith
Dec. 17, 1823
Subscribed the N.W. cor. of Sec. 24, the
N.W. cor. of Sec. 5 & the N.W. cor. of Sec. 24, 7
acres, a copy to the Register, and
another copy to the Comptroller of
the Genl. Land Office.

Aggregate area - 23006.55 ac.

Scale of 40 chains to an inch

Pursuant to a contract with and instructions from William C. C. Sumner of the lands of the United States for the State of Illinois & Territory of Wisconsin & Secretary of the Treasury, dated the 29th day of July 1823, I have examined and laid out and surveyed the above described Township, and do hereby certify that it has such marks & bounds both natural & artificial, as are represented on said plat and described in the field notes made thereof and returned into the Office of the Surveyor of the lands of the United States for the State of Illinois and Wisconsin and Territory of Wisconsin.


Certified this 23^d day of December 1823

John H. Smith, D. Surveyor

Examined
Wm. C. Rice
Sur. to -

Township No. 22 North of the base line. Range No. 1 East of the 3^d principal Meridian.

page 22 of 27

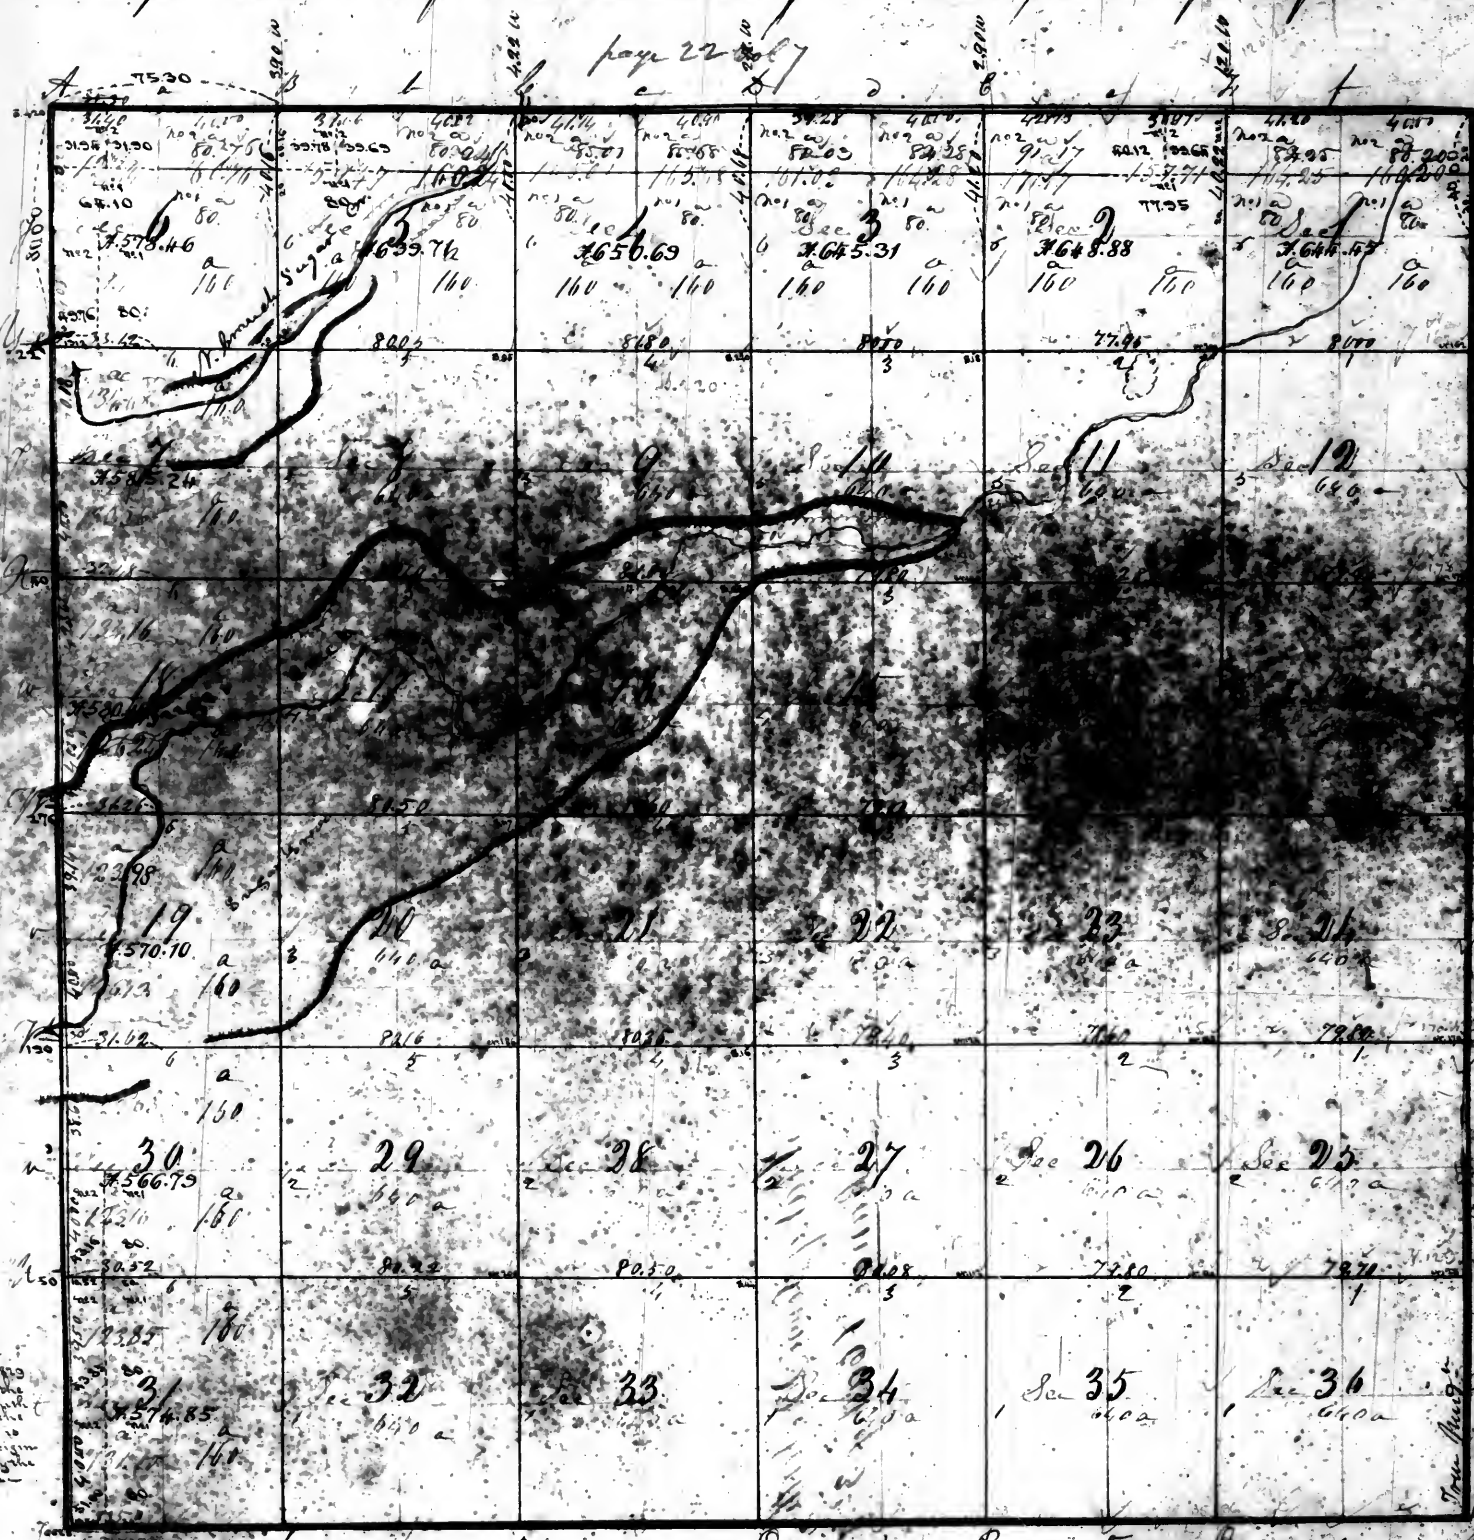

Surveyor's Office
St. Louis 17th Dec. 1826.
Subscribed the N.E. of Sec. 2, the
N.W. of Sec. 5, the S.W. of Sec. 30
in the West halves of Sects 6 & 31,
& sent a copy to the Register
and another copy to the Comptroller
of the Land Office.

Surveyors Office
St. Louis August 28 1823
On the line between the
Twp. 22 N. & 23 N. in the
R. 1 E. of the 3d M.
the distance 22 50 is
the point as origin
and is given by the
survey to this Office.

Aggregate area = 22684.88 acs

Scale of 40 chains to an inch


Pursuant to a contract with and instructions from William Root, Surveyor of the lands of the United States in the States of Illinois & Territories of Arkansas bearing date the 29th day of July 1823. I have accompanied said survey and surveyed the above described township, and do hereby certify that it has such marks & bounds as both natural and artificial as are represented on said plat and recorded in the field notes made thereby and returned with this plat into the office of the Surveyor of the lands of the United States in the States of Illinois & Territories of Arkansas.
Certified this 23^d day of December 1823.

Wm. Root
Surveyor

Surveyors Office
St. Louis 2^d Sept. 1829
The above plat, is (with the exception stated in the margin)
conformable to the field notes of the survey of Twp. 22 N. R. 1 E. of 3^d M.
on file in this Office.
Wm. Root
Surveyor

Township N^o 23 North of the base line, Range N^o 1 East of the 3^d Principal Meridian

Page 23

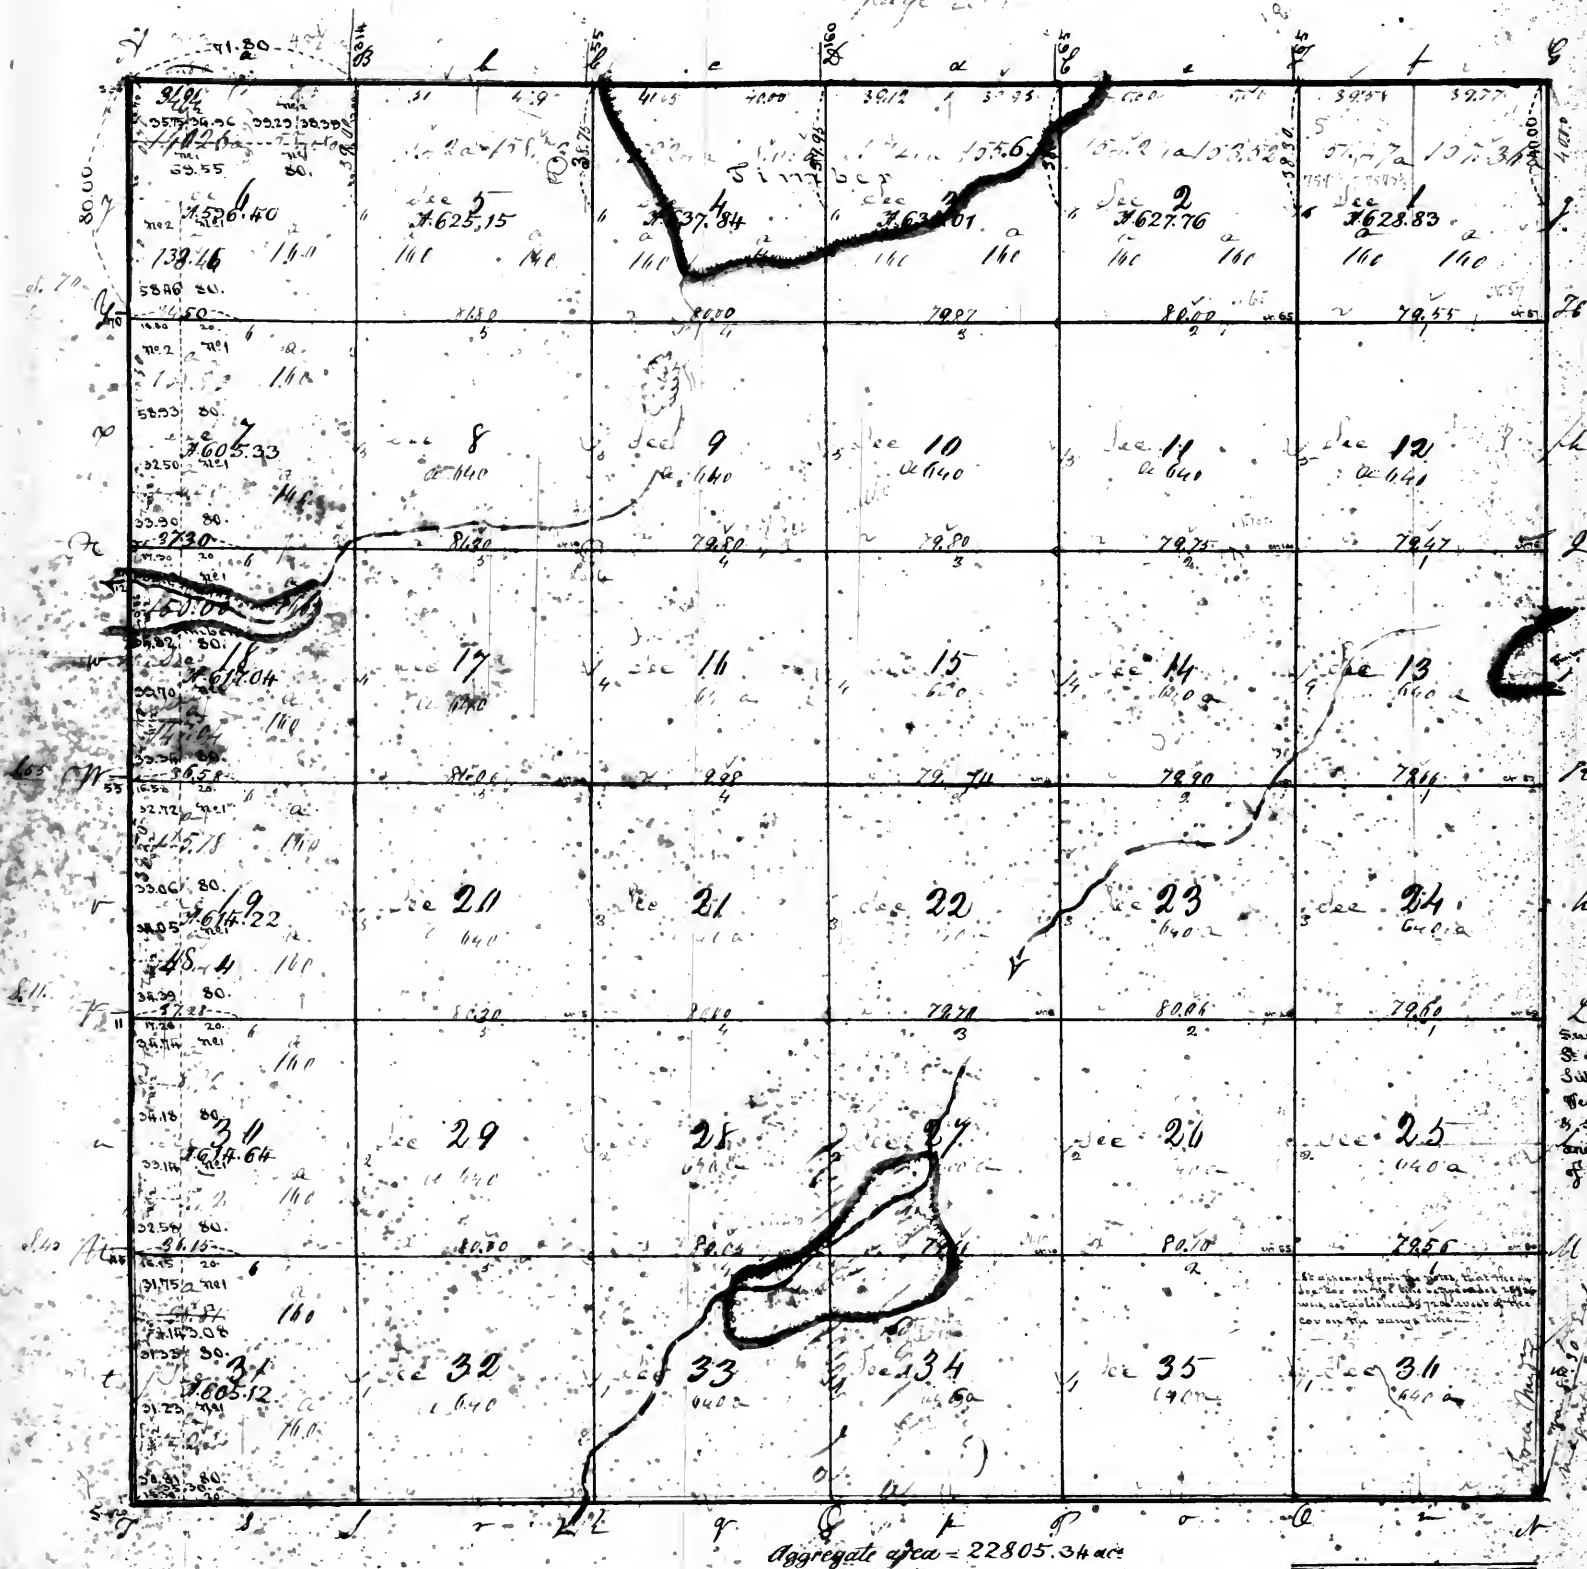

Pursuant to a contract with and instructions from William Brown Surveyor of the lands of the United States for the States of Illinois & Missouri & Territory of Arkansas, bearing date the 29th day of July 1823, I have administered and surveyed the above described township; and do hereby certify that it has such marks & bounds both natural & artificial, as are represented in said plat, and described in the field notes made thereof and returned into the Office of the Surveyor, of the lands of the United States for the States of Illinois and Missouri & Territory of Arkansas.

Certified this 1st day of December 1823.


Wm. H. Armstrong Surveyor

Surveyor's Office
St. Louis 24th Sept. 1829
The above plat of Twp. 23. N. R. 1. E. of 3^d P. Mer.
is conformable to the field notes of the Survey made upon this
office. — Wm. H. Reed
Sr. of Pub. Lands

Township No 24 North of the base line, Range No 1 East of the 3 principal Meridian

Record

25

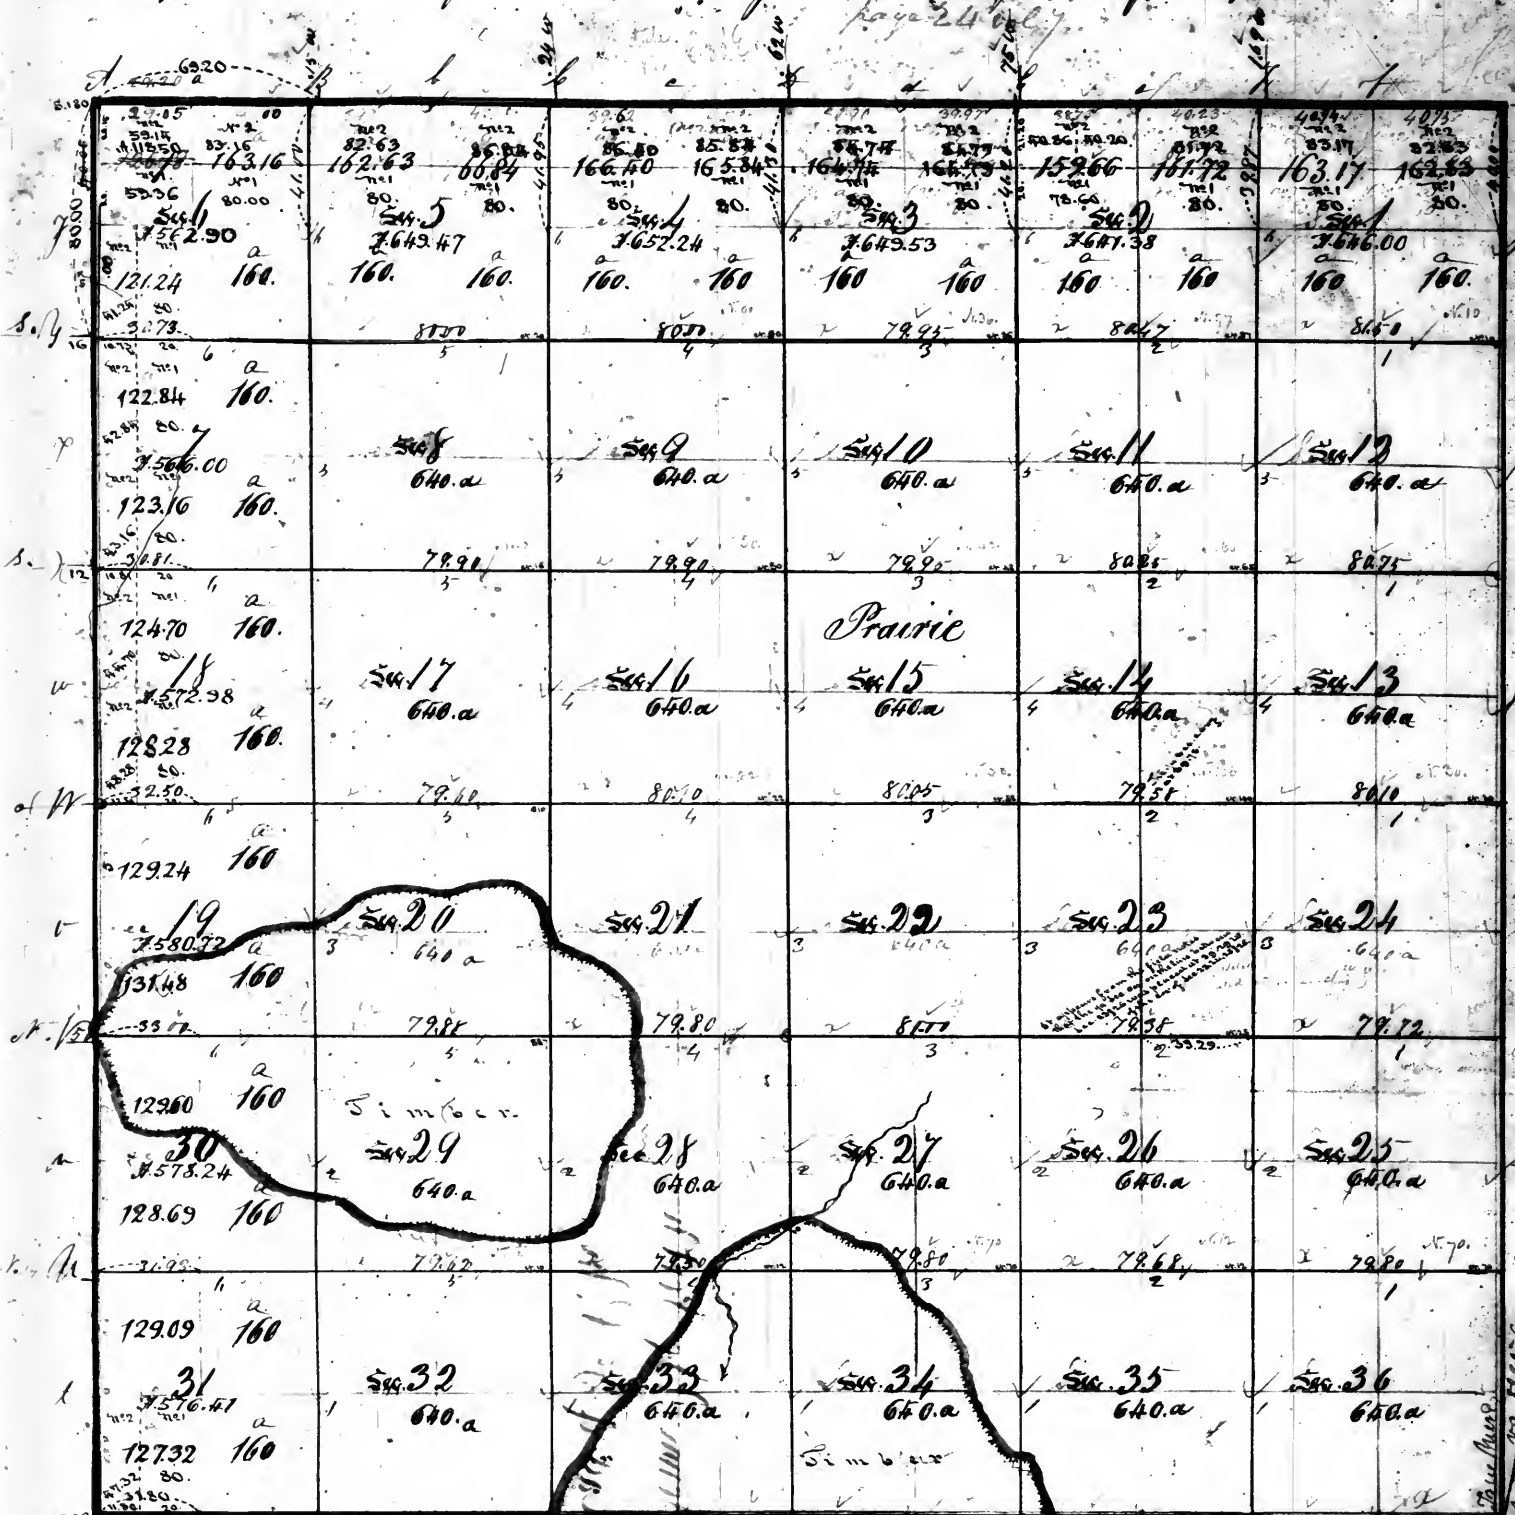

Surveyed by
J. L. Smith
Subscribed the N. W. 1/4 of Sec 2, the S. W. 1/4 of Sec 3, and the West halves of Sec 4 & 5, 1829.
I, the Surveyor, do hereby certify that a copy of this plat, and a true copy of the original of the General Land Office.

Aggregate area = 22675.87 ac


Scale of 40 chains to an inch

Pursuant to a contract with and instructions from William B. Rector Surveyor of the lands of the United States in the State of Illinois & Territory of Arkansas bearing date the 29th day of July 1829. I have examined said plat and surveyed the following described Township and do hereby certify that it has such marks and bounds both natural & artificial as are represented on said plat, & described in the field notes made thereon, and returned with this plat into the office of the Surveyor of the lands of the United States in the State of Illinois & Territory of Arkansas.

Certified this 33rd day of December 1829.
J. L. Smith
St. Louis 2nd September 1829
The above plat of Twp. 24. N. R. 1. E. of the 3rd Meridian is conformable to the field notes of the Survey for said Twp. on file in this Office. — Wm. B. Rector
Sr. & Plat. Ls.

Recorded

Township No 25 North of the base line, Range No 1 East of the 3^d Principle Meridian

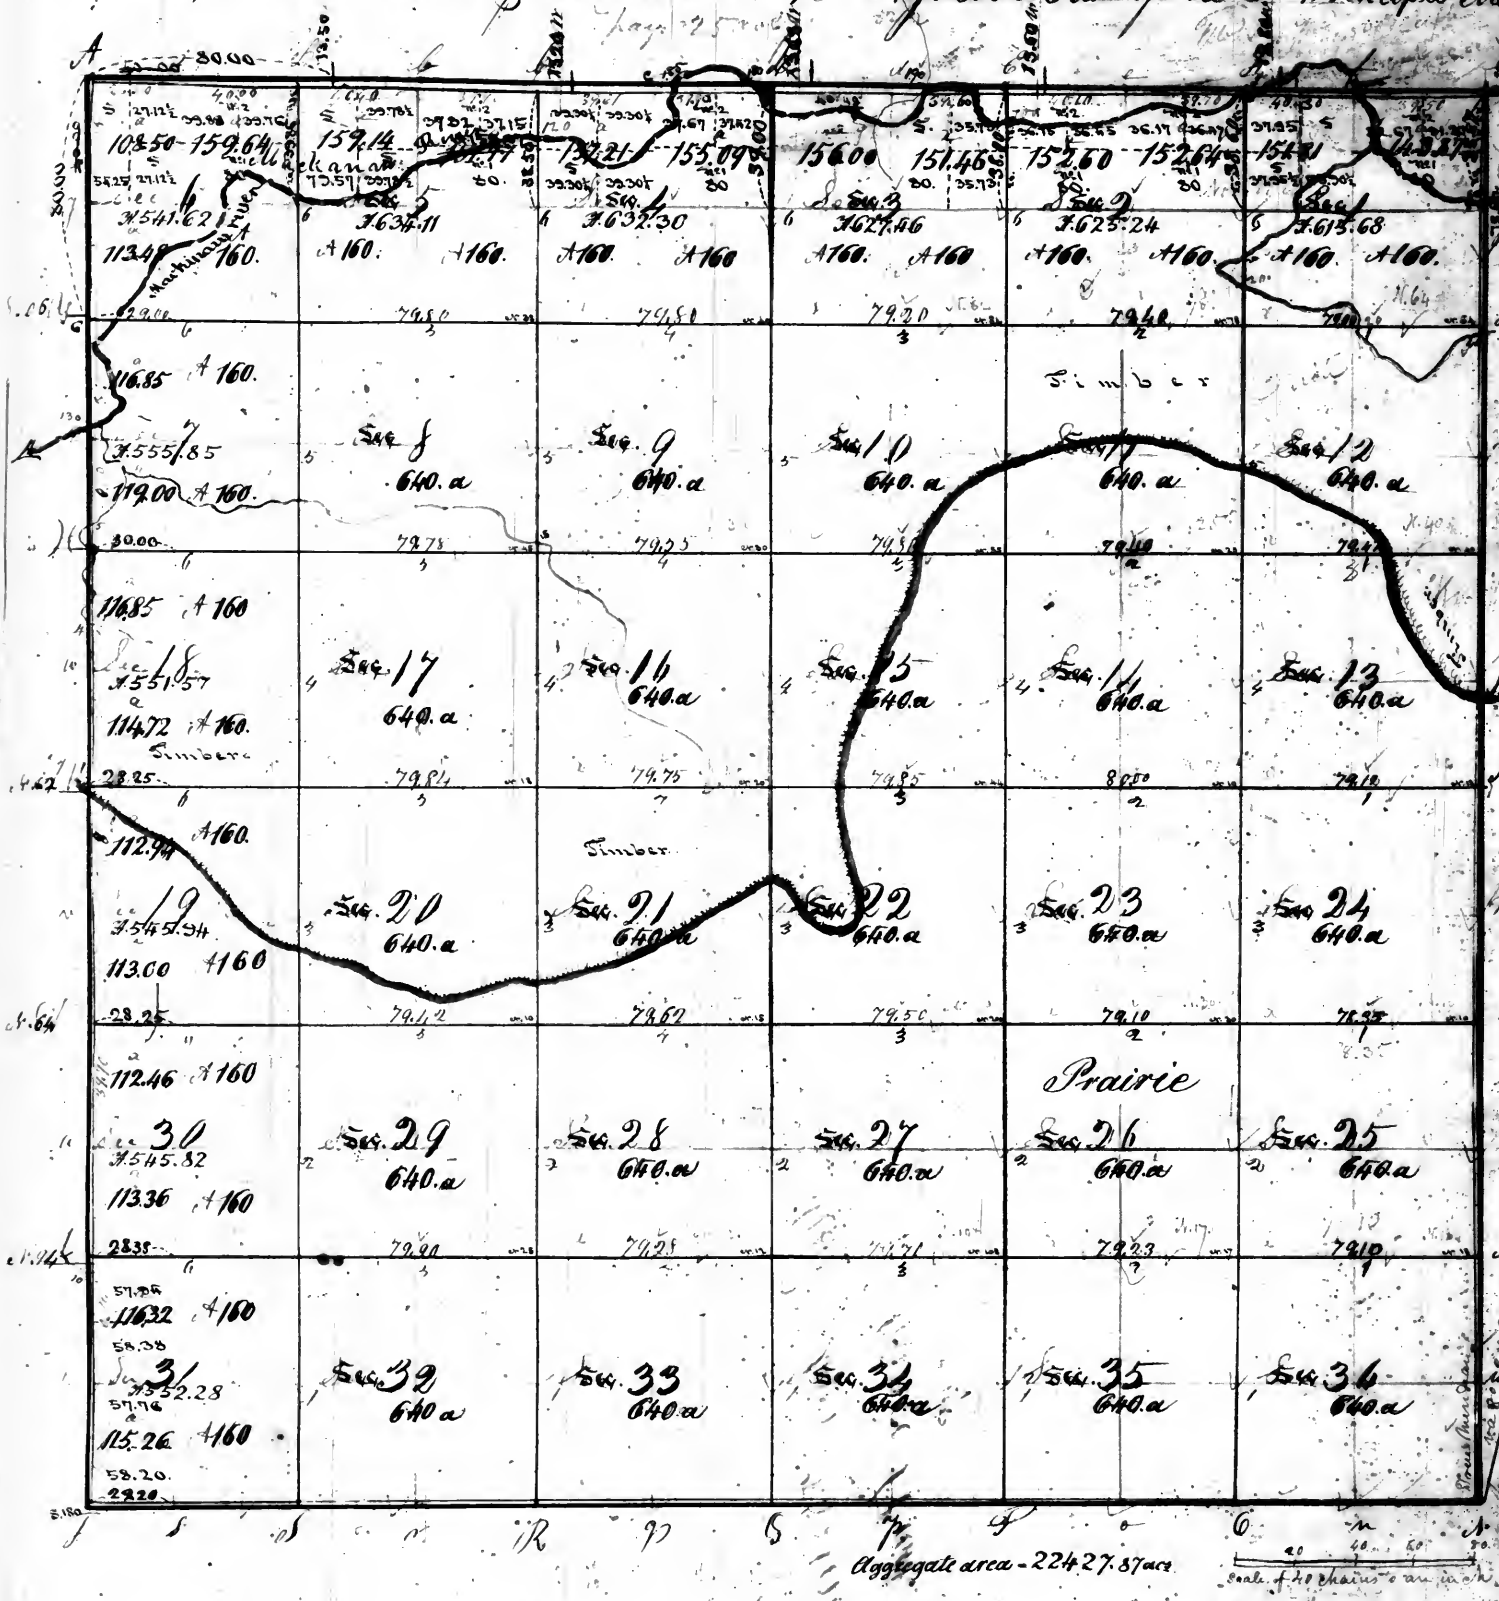


Surveyors Office
St Louis 17 December 1826.
Subdivided the N.E. q^{tr} of Sec 1, 2, 3 & 4
the North half of Sec 2 & the West
half of Sec 3, into the lot of Congress of
1822, and of the N.W. q^{tr} of Sec 1, 2,
3 & 4 and of the N.E. q^{tr} of Sec 3, into
lots so as to conform to previous sale
(marked S), and sent a copy to the
Register, and another copy to the
Commissioner of the General Land
Office.

Pursuant to a contract with and instructions from William Jackson Surveyor of the lands of the United States in the States of Illinois and Missouri and Territory of Arkansas, bearing date the 29th day of July - 1823 I have commenced laid out and surveyed the above described Township; And do hereby certify, that it had such marks & bounds, both natural and artificial as are represented on said Plat and described in the field notes made thereof, and returned into the Office of the Surveyor of the lands of the United States for the States of Illinois and Missouri and Territory of Arkansas.

Certified this 3^d day of December A.D. 1823.
Surveyors Office
St Louis 2^d September 1829 } The above plat of Twp 25 N. R. 1 E. of the 3^d P. Mer.
is conformable with the field notes of the Survey of the Twp on file in this
office. - Wm. M. Rice }
H. of Pub. Lands }

areas of W 1/2 Sec 6 is not agree
with the same on new plat in 186-26
better to duplicate

Township No. 31 N. of the base line Range No. 26 E. of the

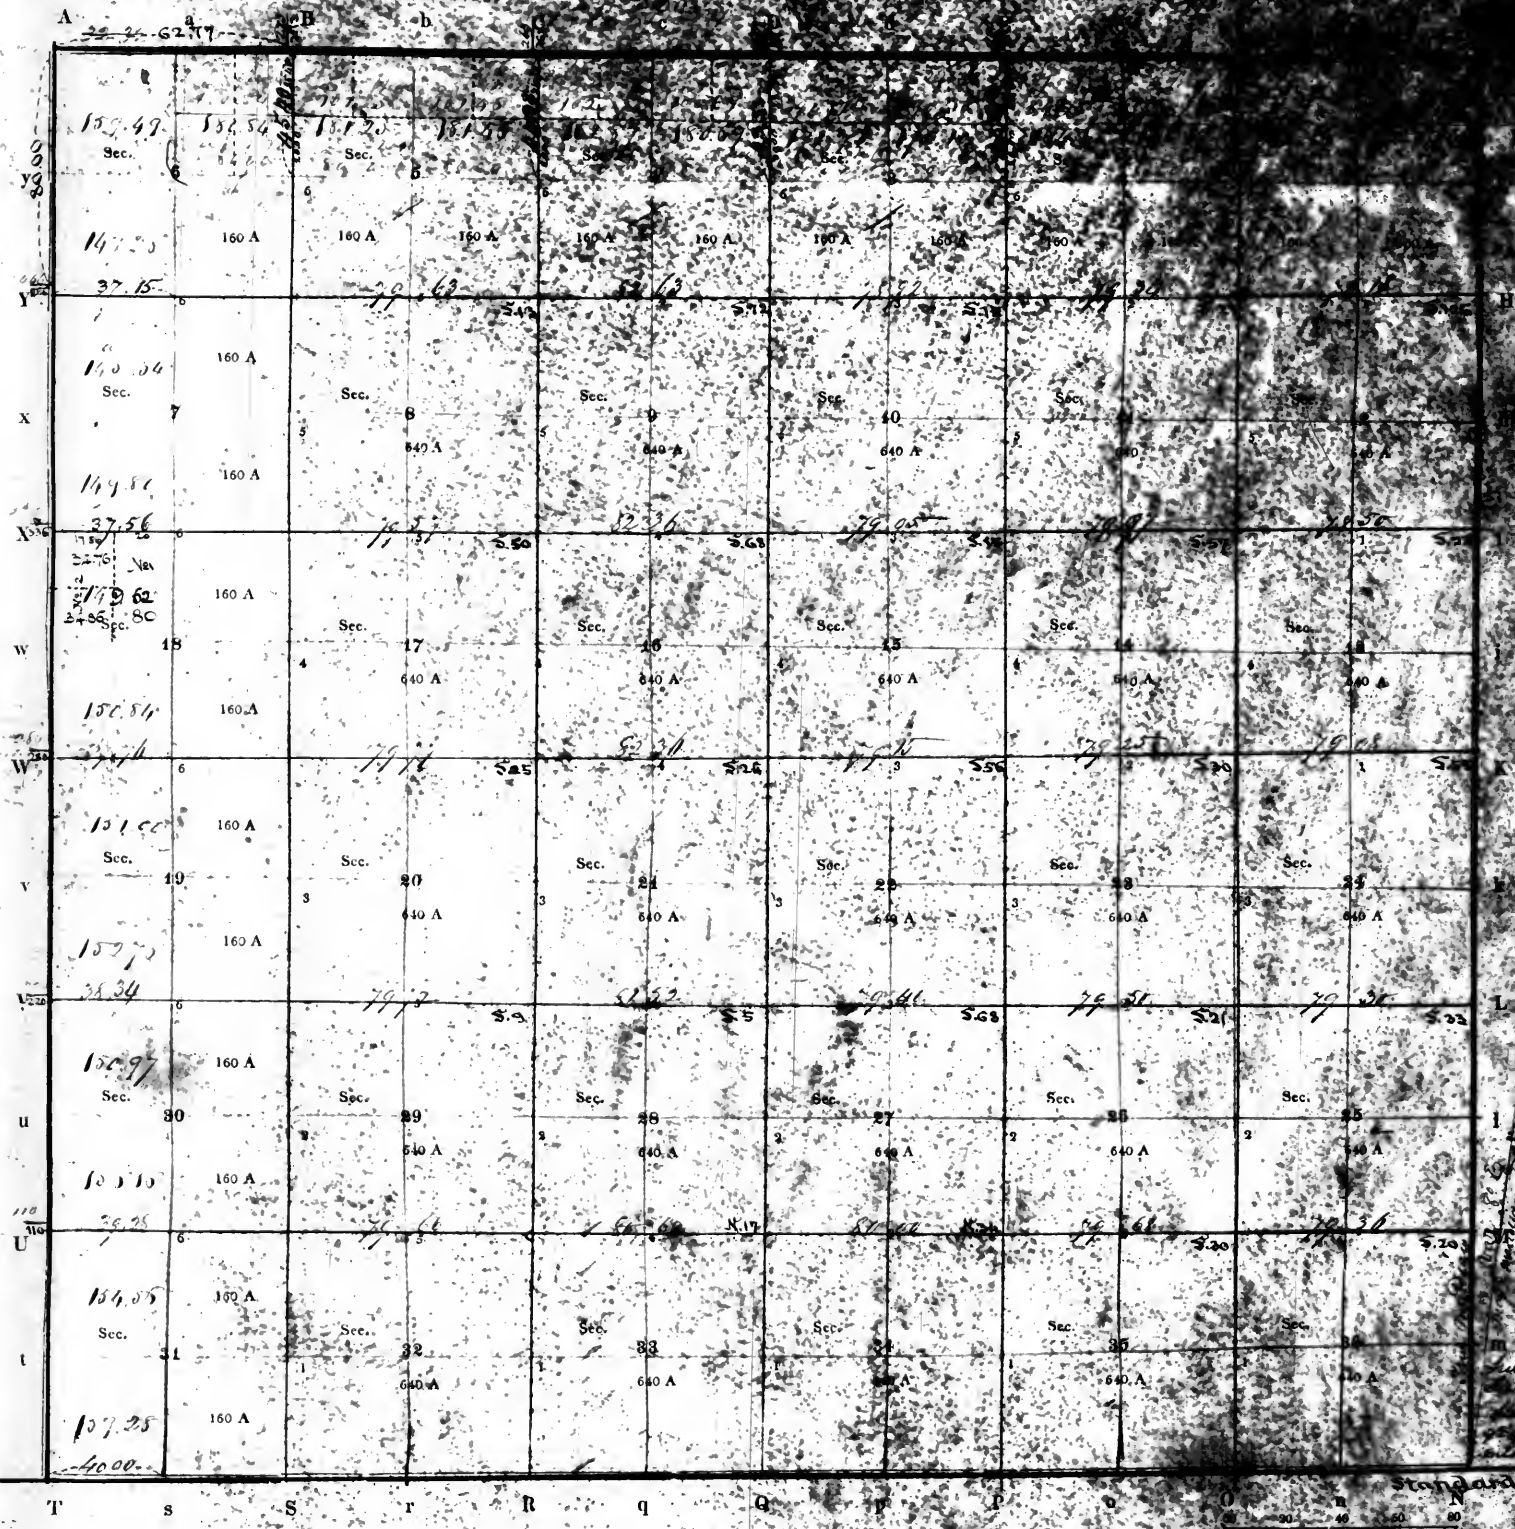


PURSUANT to a contract with, and instructions from WILLIAM RECTOR, Surveyor of the lands of the United States in the
State of Missouri, bearing date the Twentieth day of March 1862


I have admeasured, laid out and surveyed the above described Township; and do hereby certify, that it had such marks and honors, both natural
and artificial, as are represented on said plat, and described in the field notes made thereof, and returned with this plat into the Office of the Sur-
veyor of the lands of the United States, for the State of Missouri, and do hereby certify, that the same are correct and true.

Certified this day of

EXAMINED.

W. H. RECTOR

Township No. *32* *North* of the base line, Range No. *1* *East* of the *3rd* principal Meridian.

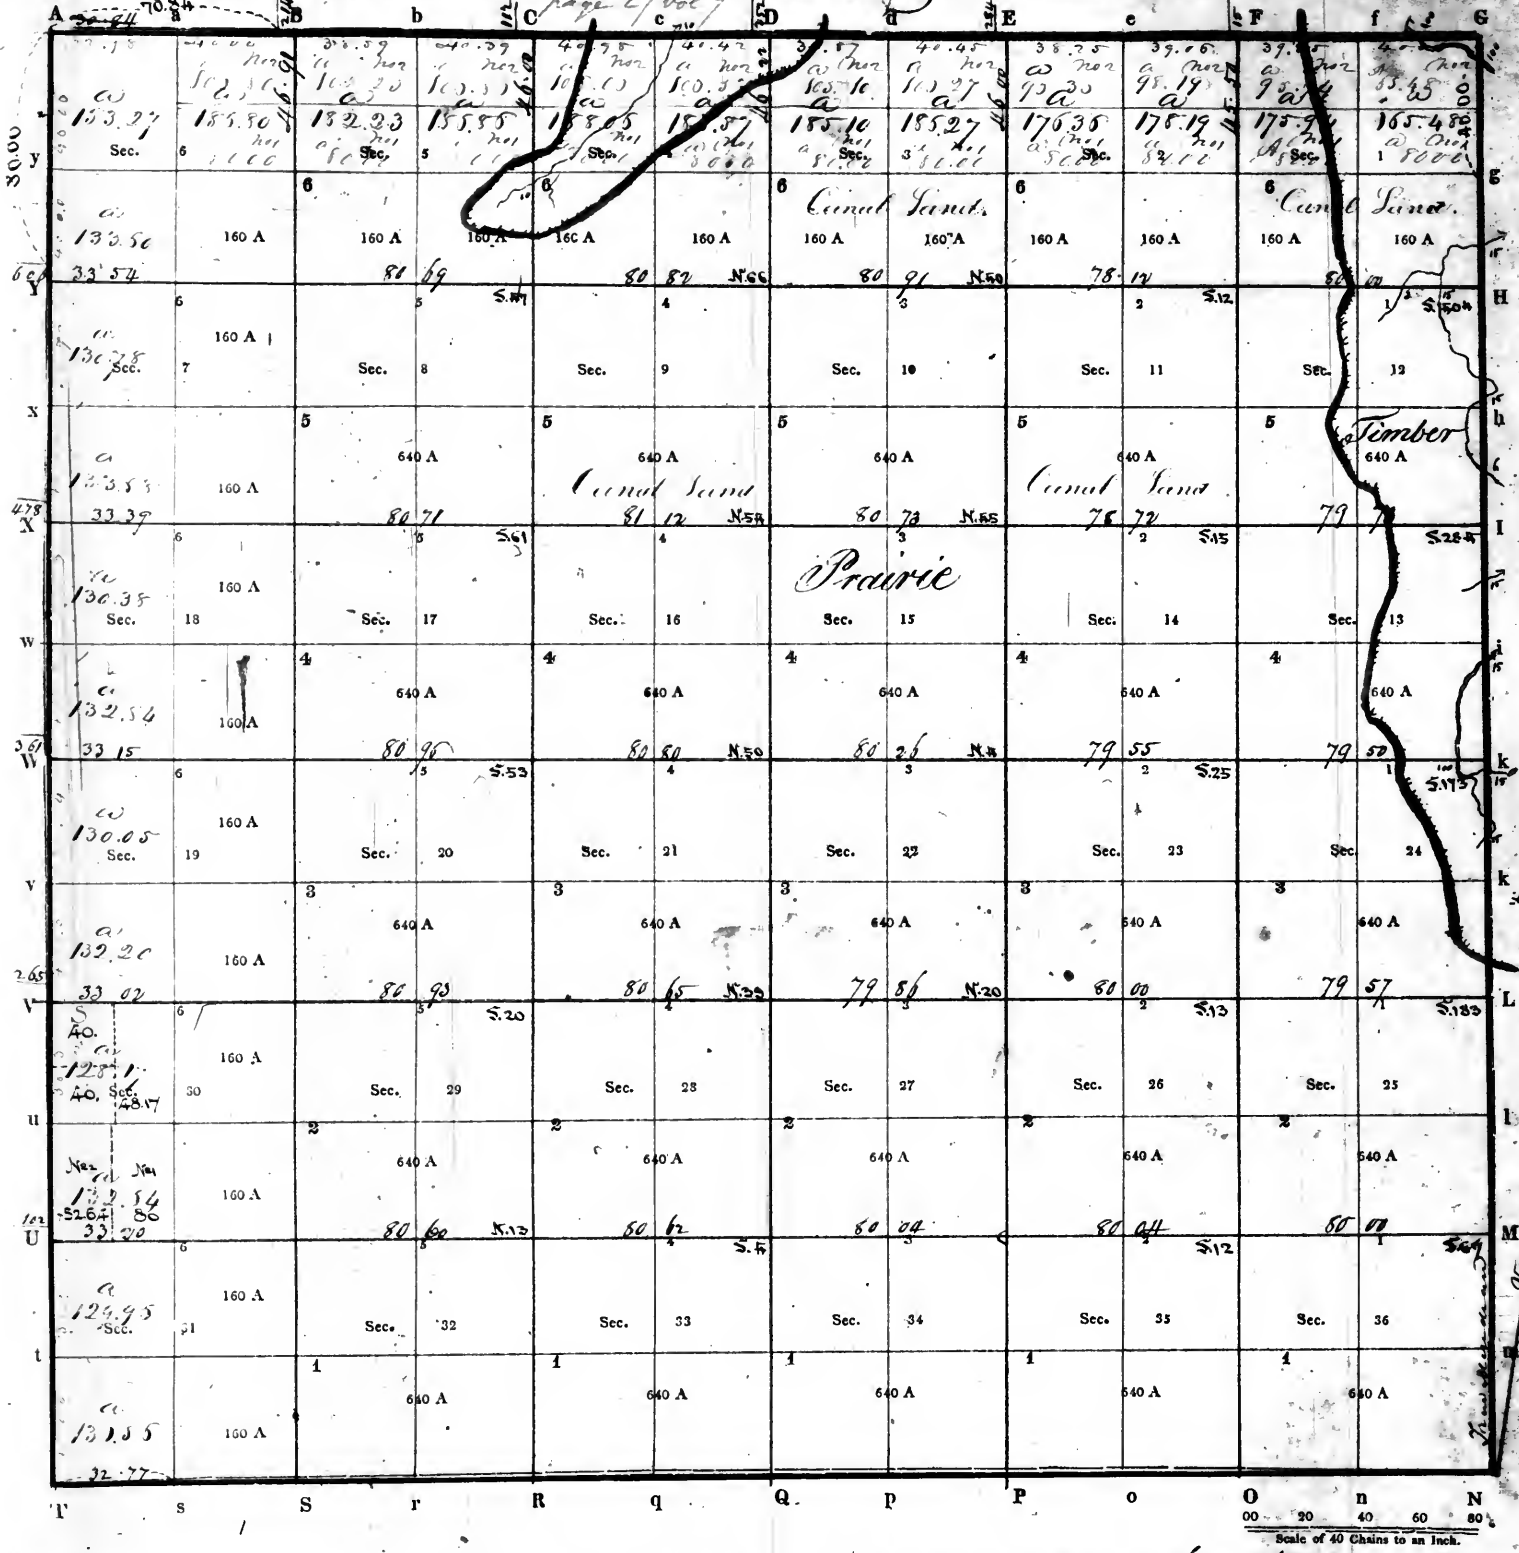





PURSUANT to a contract with, and instructions from William Rector, Surveyor of the lands of the United States in the *State of Illinois* *offspring* bearing date the *Twentieth* day of *March* 1831, I have admeasured, laid out and surveyed the above described Township; and do hereby certify, that it had such marks and bounds, both natural and artificial, as are represented on said plat, and described in the field notes made thereof, and returned with this plat into the Office of the Surveyor of the Lands of the United States, in the *State of Illinois* *offspring* and Territory of *Arkansas*—

Certified this _____ day of _____ 1832

EXAMINED.

D. SURVEYOR


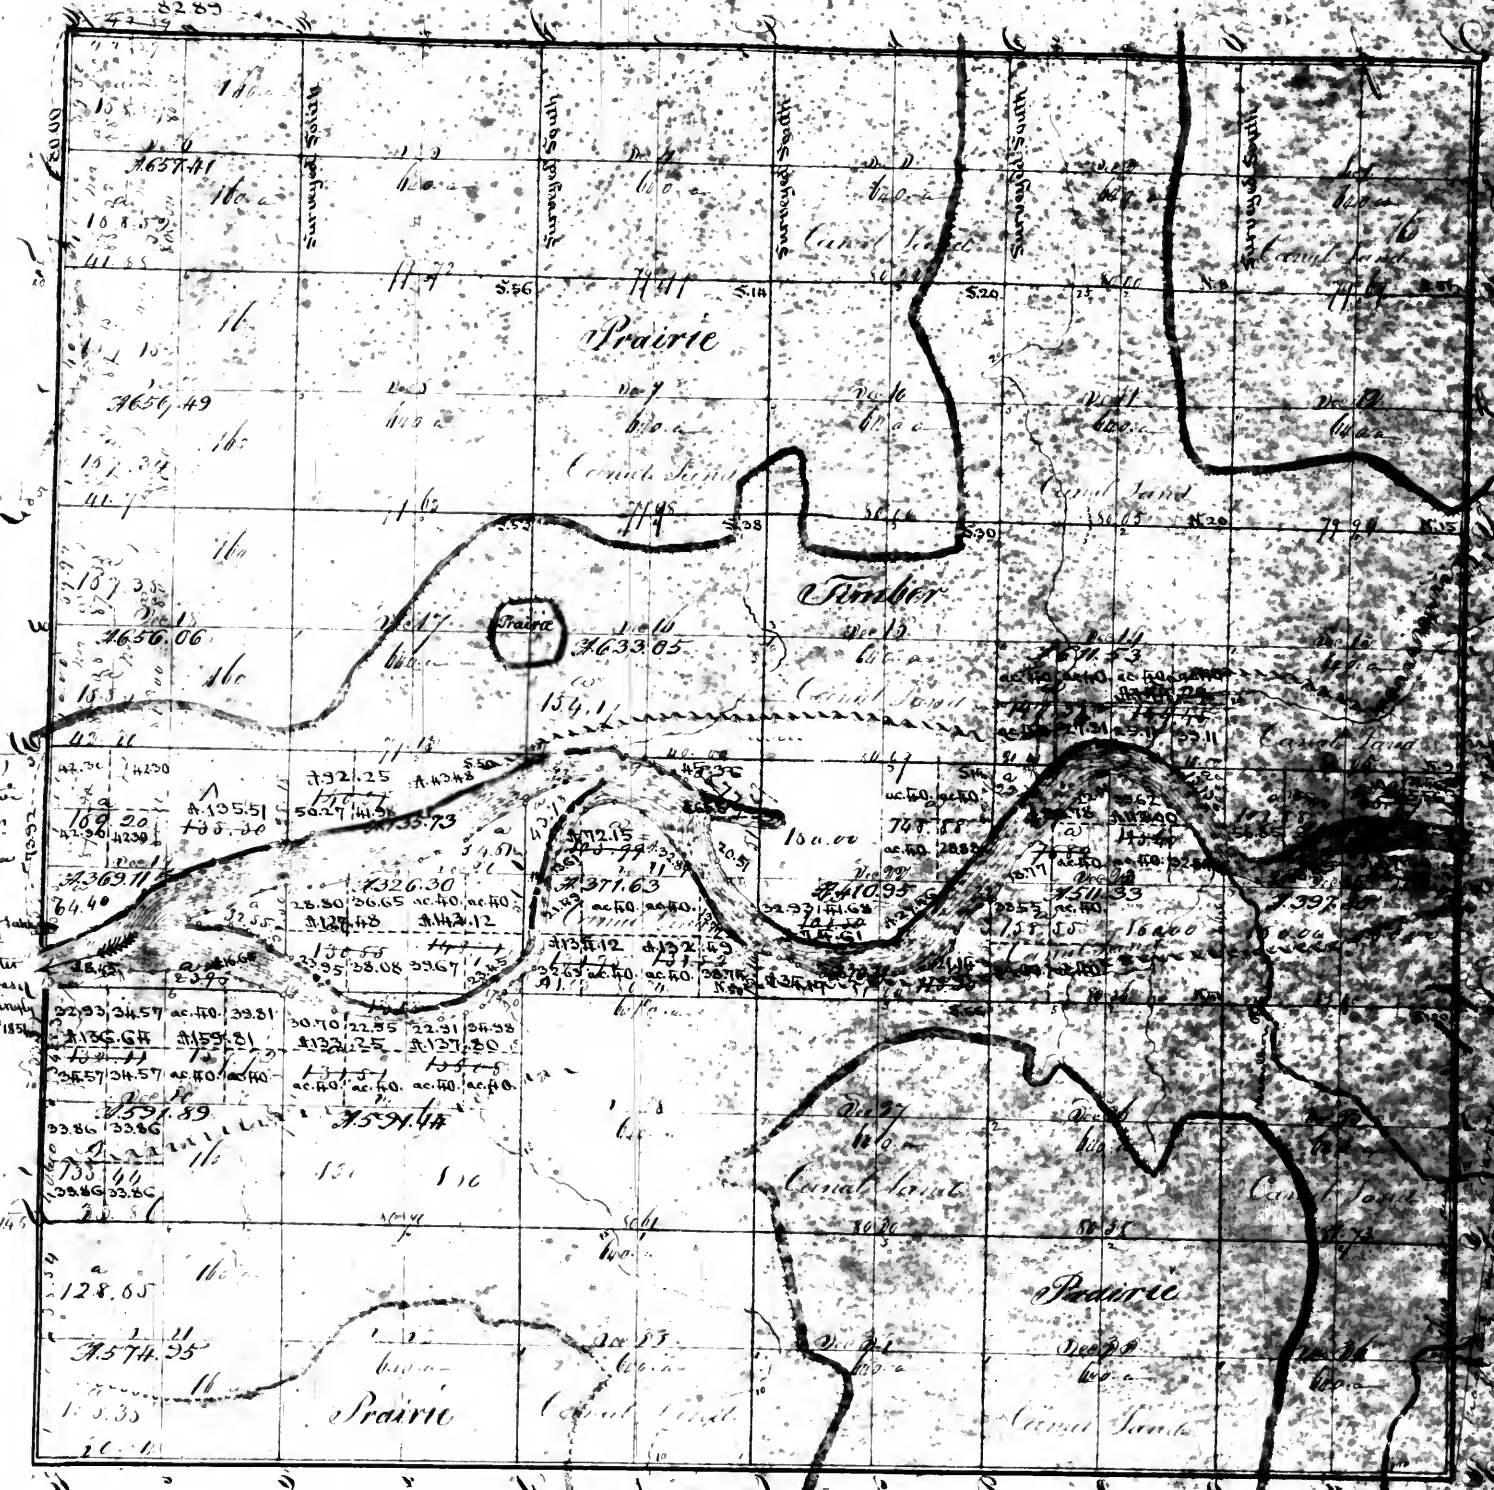

Aggregate area of public land - 22024.90 ac
Donated area of the river - 880.00 ac
Total - 22884.90 acres




by order of the Board of Commissioners
June 1872

D. H. H. H.

707

Township No. 34 North of the base line, Range No. 1 East of the 3rd principal Meridian.

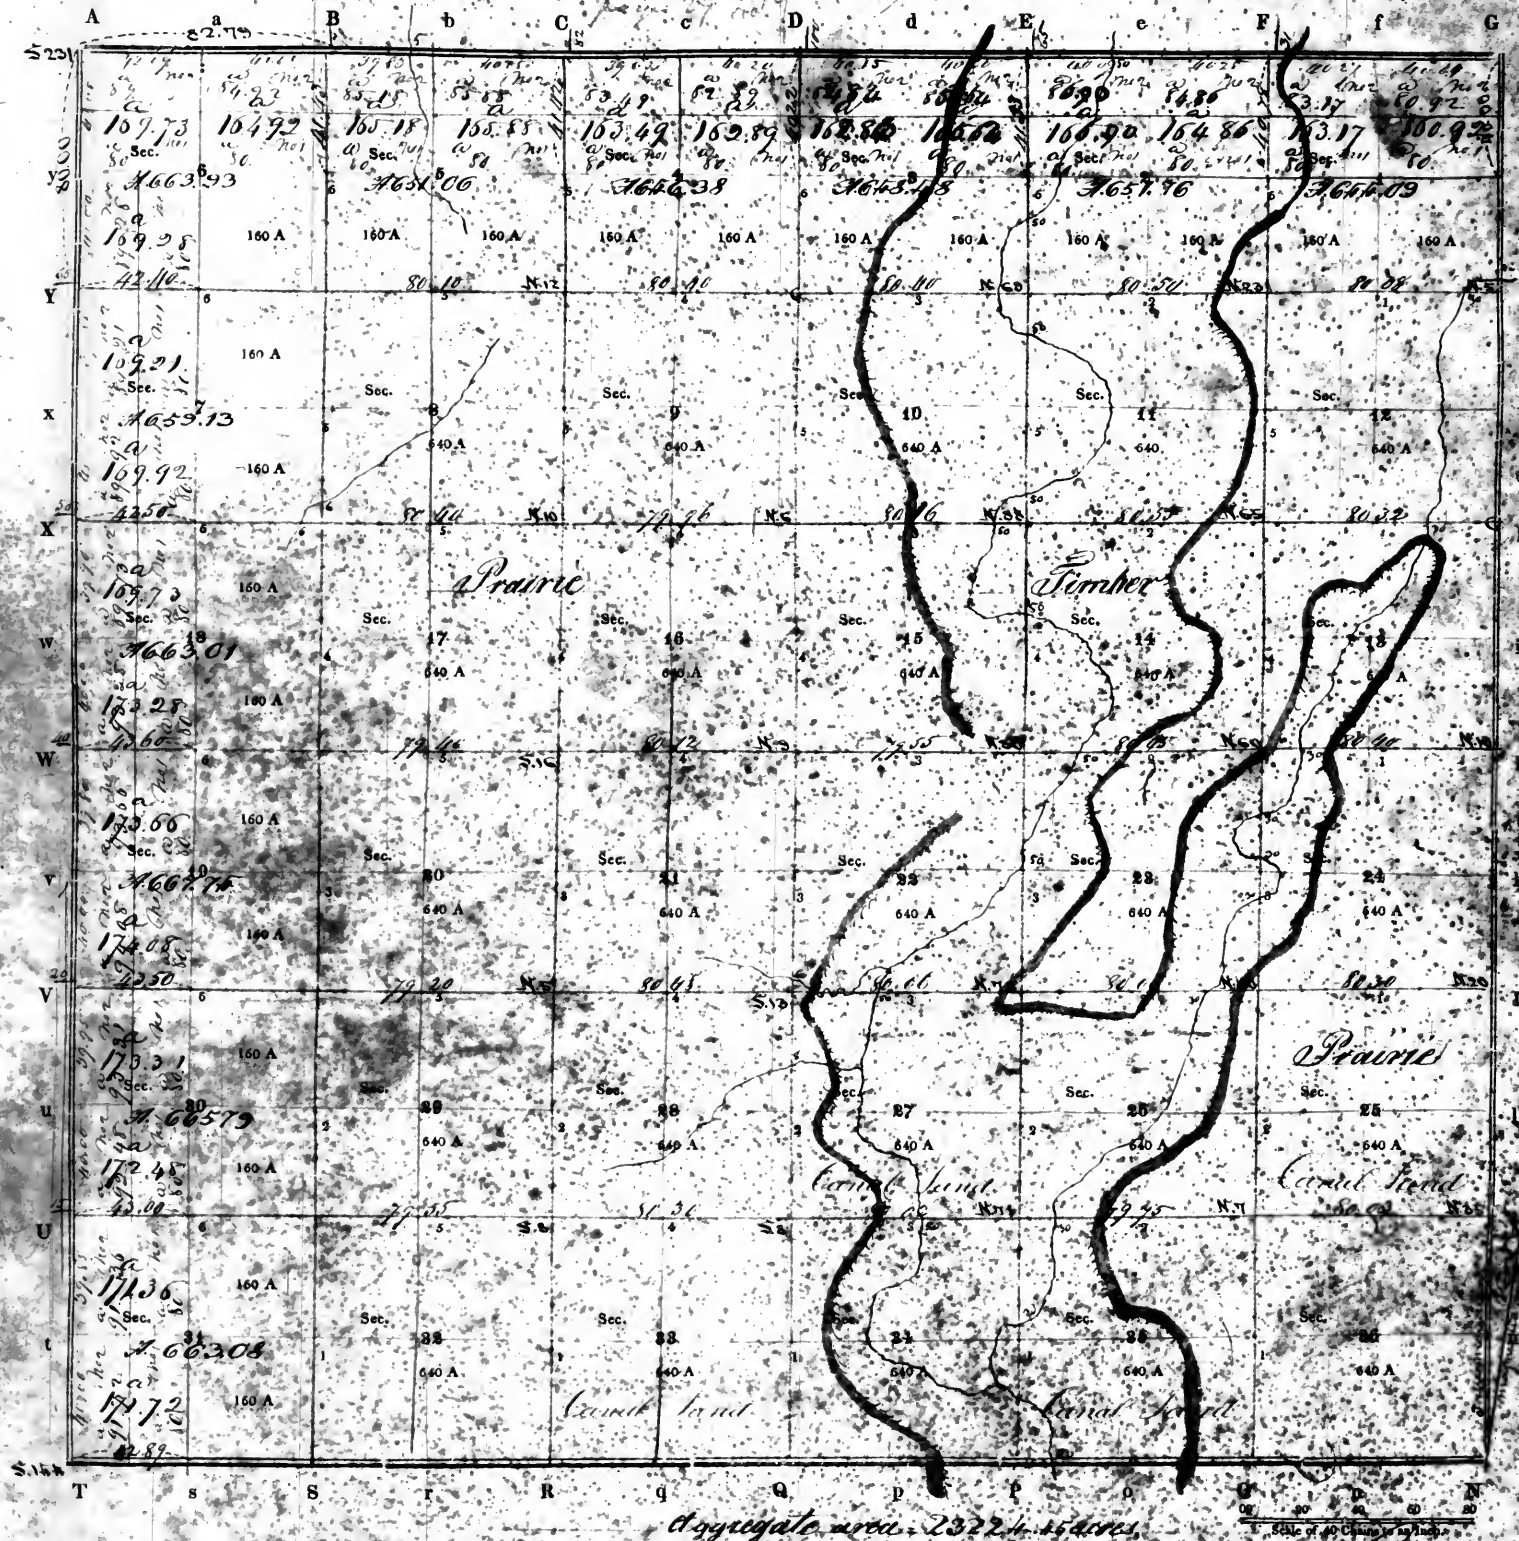

PURSUANT to a contract with, and instructions from WILLIAM REITOR, Surveyor of the lands of the United States in the State of Illinois, and the Surveyor of the lands of the United States in the State of Illinois, bearing date the 10th day of March, 1834, I have admeasured, laid out and surveyed the above described Township; and do hereby certify, that it had such marks and bounds, both natural and artificial, as are represented on said plat, and described in the field notes made thereof, and returned with this plat into the office of the Surveyor of the lands of the United States, for the State of Illinois, September 1st, 1834.

Certified this _____ day of _____

EXAMINED.


D. SURVEYOR.

Township No. *Thirty* north of the base line, Range No. *One East* of the *Third* principal Meridian.

A a b c d e f g

page 30 vol 7

Indian boundary line

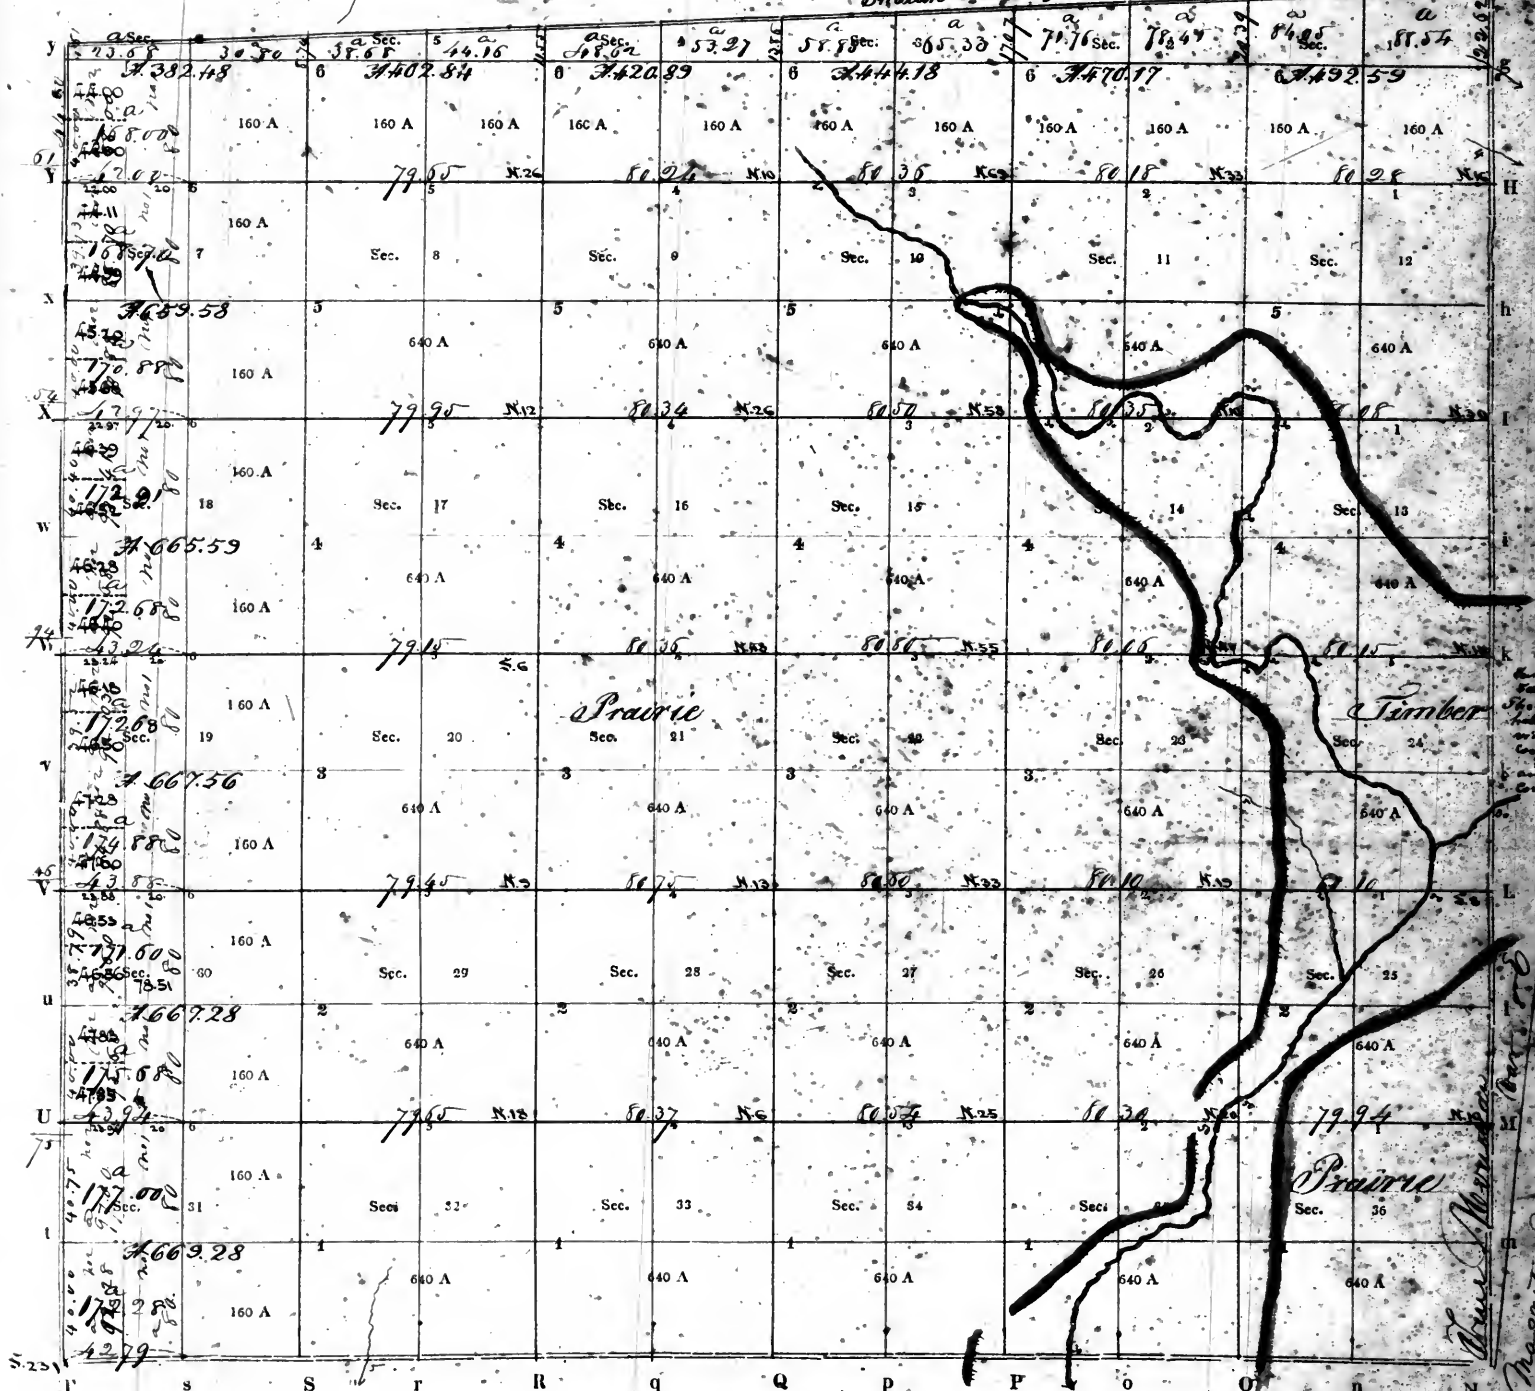

Aggregate area - 21942.44 acres

Scale of 40 Chains to an Inch.


PURSUANT to a contract with, and instructions from William Bector, Surveyor of the lands of the United States in the *States of Illinois and*
the Territory of Arkansas, bearing date the *fourth* day of *March* 1831
I have measured, laid out and surveyed the above described Township; and do hereby certify, that it had such marks and bounds, both natural and artificial,
as are represented on said plat, and described in the field notes made thereof, and returned with this plat into the Office of the Surveyor of the Lands of the
United States, in the *States of Illinois and the Territory of Arkansas*.

Certified this *11th* day of *March* 1831
EXAMINED.

D. SURVEYOR.

Township 1 North, Range 2 East of the 5th Principal Meridian

384

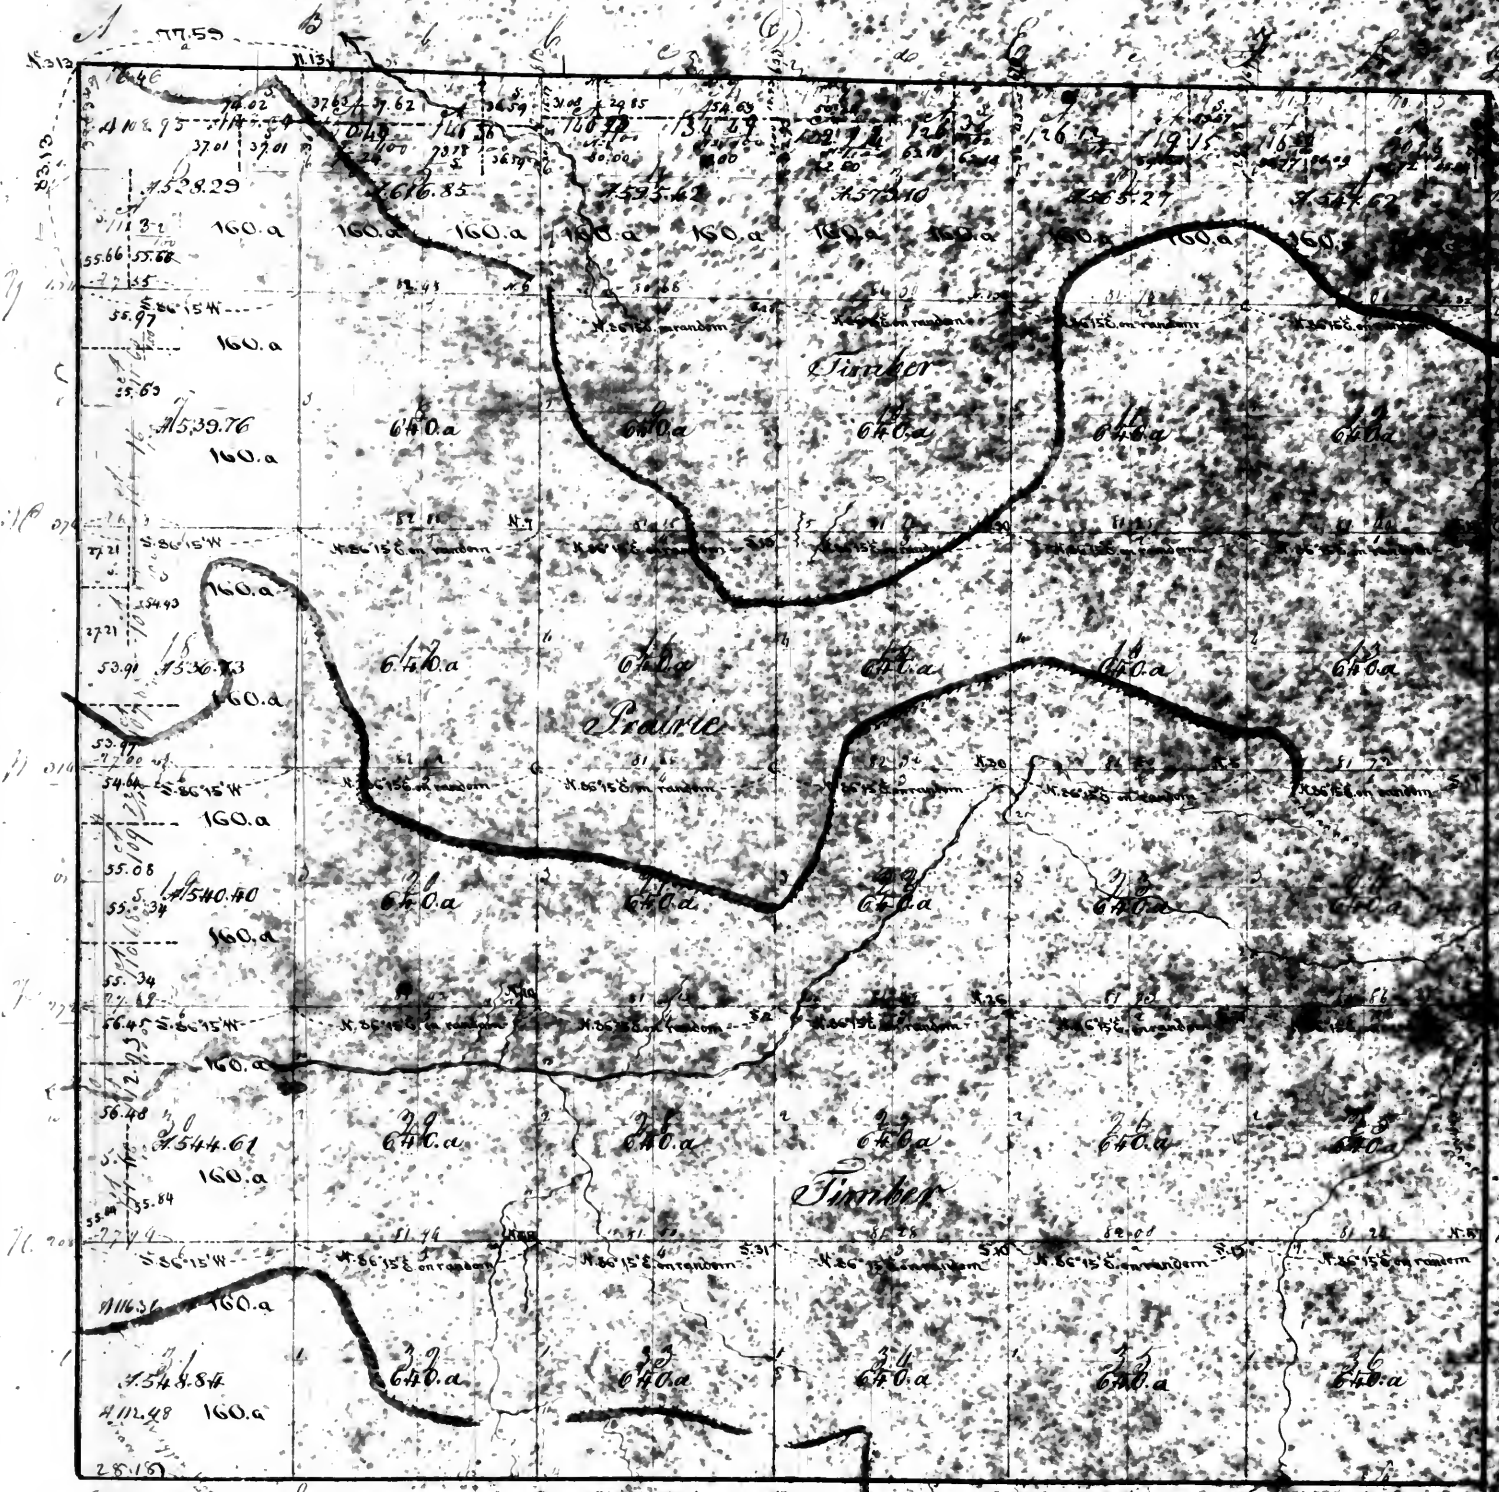




Recorded

Township 4. 2. south of the base line Range 1. 2. East of the 3. 2. Prime Meridian

385

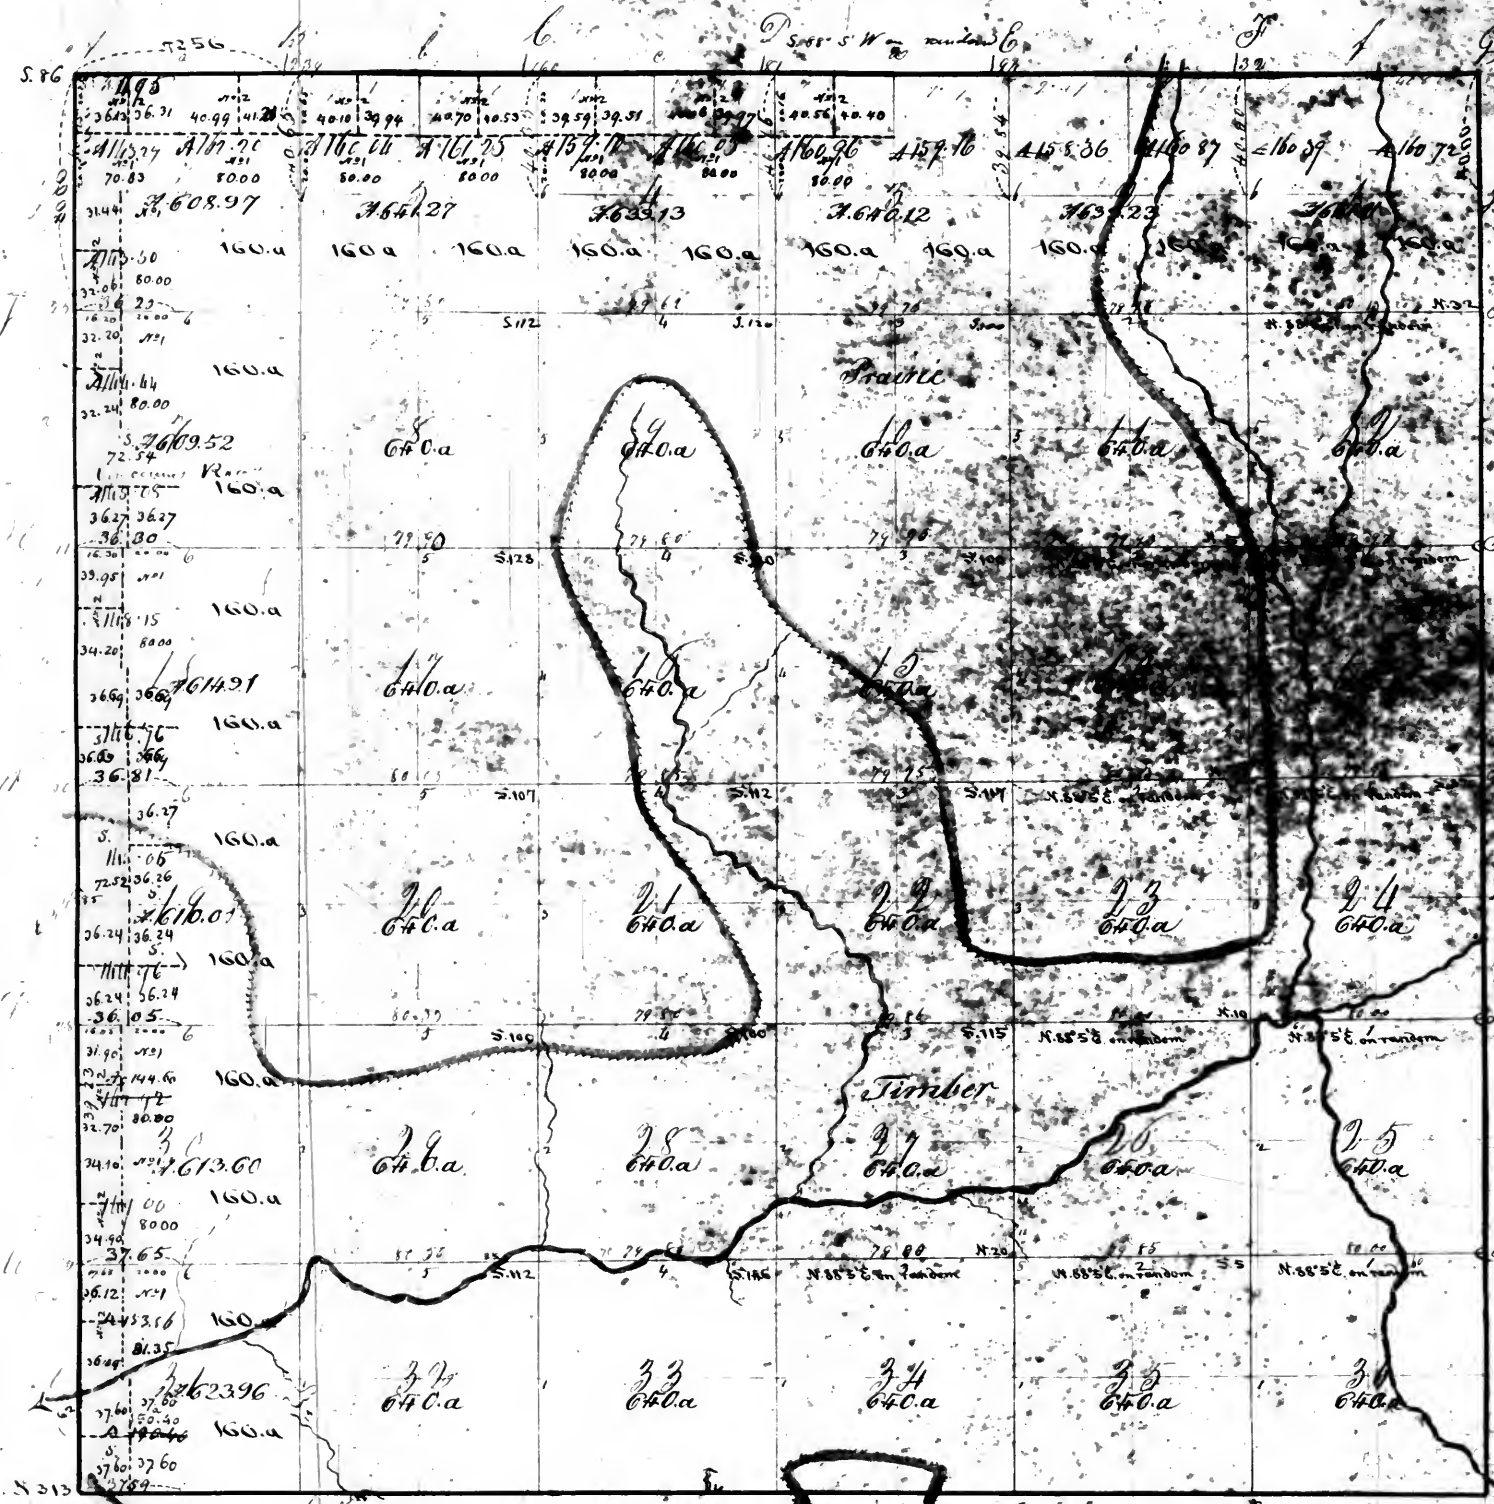

Surveyor's Office
St. Louis Sept. 15th 1849


Surveyor's Office
St. Louis Sept. 15th 1849
The N.W. q. of section 20 and N.E.
of sections 4, 5 & 6 & S.W. q. of Sec 6
subdivided under the act of
Congress of the 5th of April 1850
and one copy sent to the Register
and another to the Commissioner
of the General Land Office

Surveyor's Office
St. Louis July 11th 1850
The N.W. q. of sec 7, 18 & 31 of the
West half of section 30 in T. 4. N.
R. 2. E. of the 3rd P. M. subdivided
under the act of Congress of the
5th of April 1850 - by the S.W.
q. of sec 7, 18 & 31 and of the
West half of section 19 subdivided
so as to conform to previous sales
(marked S.) and a plat thereof
is on the 11th sent to the Register
and another sent to
the Commissioner of the G. L. Office

Aggregate area = 22881.33 acres

I am to be furnished with instructions from William B. Lewis Surveyor of the Lands of the
United States in the State of Illinois & Territory of Missouri bearing date the 22nd of
I have no objection, but I certify the above described Township & sections
certify that it has such marks & bounds both natural & artificial as are described on the plat
& annexed in field notes made thereof, and returns with this plat into the Office of the
Surveyor of the Lands of the United States for the State of Illinois & Territory of Missouri


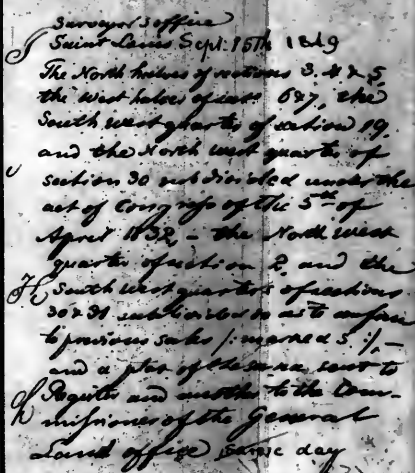

Pursuant to a Contract with, and Instructions from William P. Weston Surveyor of the
Lands of the United States in the Territories of Illinois & Missouri bearing date the
day of _____ I have administered, laid out & surveyed the above described Township, & do
hereby Certify that it has such marks & bounds both Natural & artificial as are refer-
enced on this plat, & described in the Field notes made thereof & returned with this
plat into the Office of the Surveyor of the Lands of the United States for
the Territories of Illinois & Missouri.

Surveyed 21st May 1893

Proctress D

Aggregate area = 22690.36 acres

Scale 1/40000

True Meridian
Variation 50'


Road

34

Township No. 4 North of the Base line of Range No. 2 East of the 3rd P.M.

Page 361

387

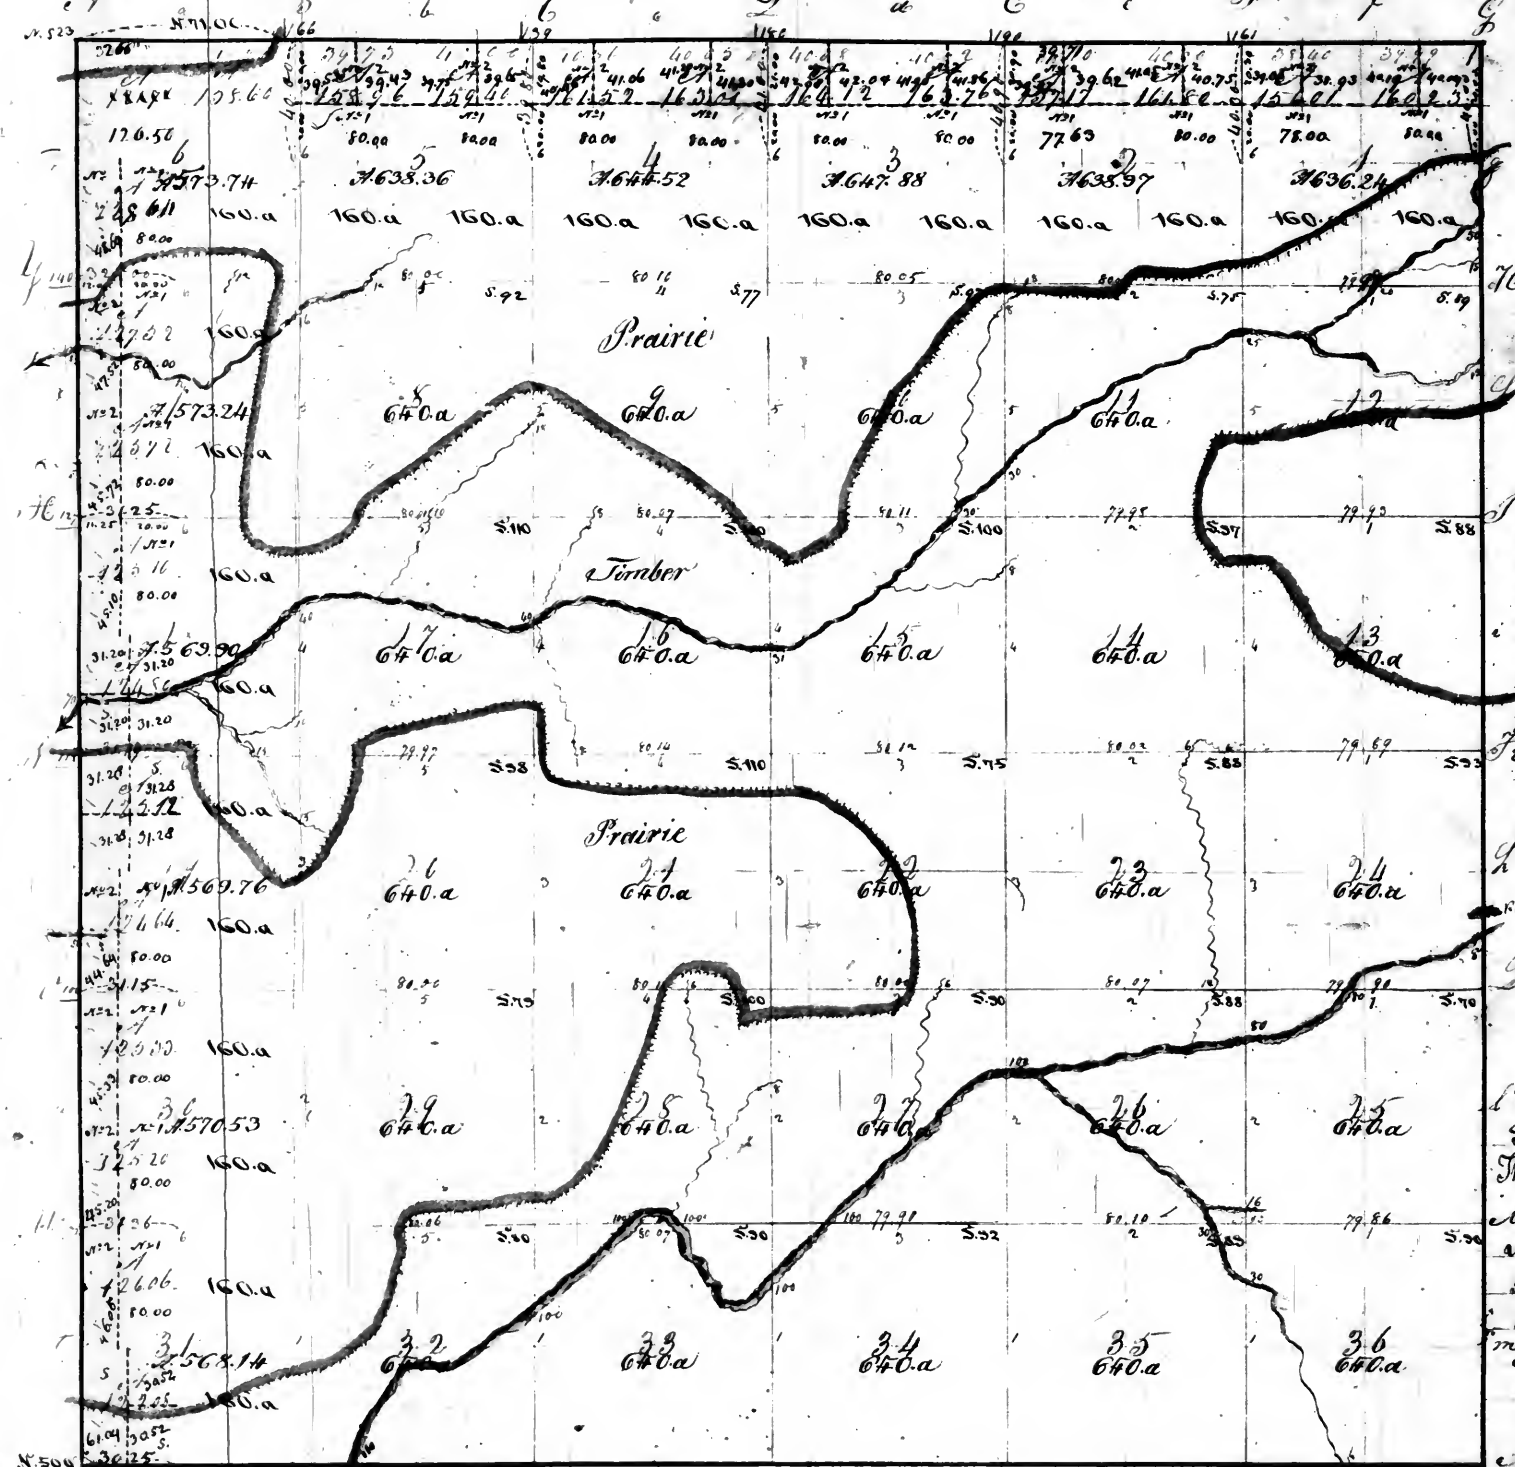

Surveyor's Office
St. Louis Sept. 15th 1849
The North halves of sections 1, 2, 3, 4 & 5, the South west quarter of section 6, the West halves of sections 7 & 8, and the North west quarter of section 9, all of the 5th of April 1832, and the South west quarter of section 10, and the North west quarter of section 11, and the North west quarter of section 12, all of the 5th of April 1832, and a plot of the same sent to the Register and another to the Commissioner of the General Land Office same day.

Surveyor's Office
St. Louis Sept. 15th 1849
The North halves of Sec. 1, 2, 3 & 5, and the S.W. q. of Sec. 6 Subdivided under the act of Congress of the 5th of April 1832, and a plot of the same sent to the Register and another to the Commissioner of the General Land Office.

Surveyor's Office
St. Louis Dec. 11th 1850
The West halves of sections 7 & 8 of the 1st M. of Sec. 19 in T. 4 N. R. 2 E. of the 3rd P.M. subdivided under the act of Congress of the 5th of April 1832, of the S.W. q. of Sec. 19 subdivided as to conform to previous sales (made Dec. 11th 1850) and a plot of the same sent to the Register and another to the Commissioner of the General Land Office.

Aggregate area = 22631.28 acres


Remnant to a contract with instructions from William B. Polk Surveyor of the Lands of the United States in the State of Illinois & Territory of Missouri bearing date the day of
I have measured laid out & surveyed the above described Township & do certify that it has such marks & bounds both natural & artificial, as are represented on the plat & described in the field notes made thereof, & returned with this plat into the Office of the Surveyor of the Lands of the United States for the State of Illinois & Territory of Missouri.

Certified 21st May 1849

The Surveyor

Recorded

Township 5 N 10 E East of the 3^d Principal Meridian
page 35

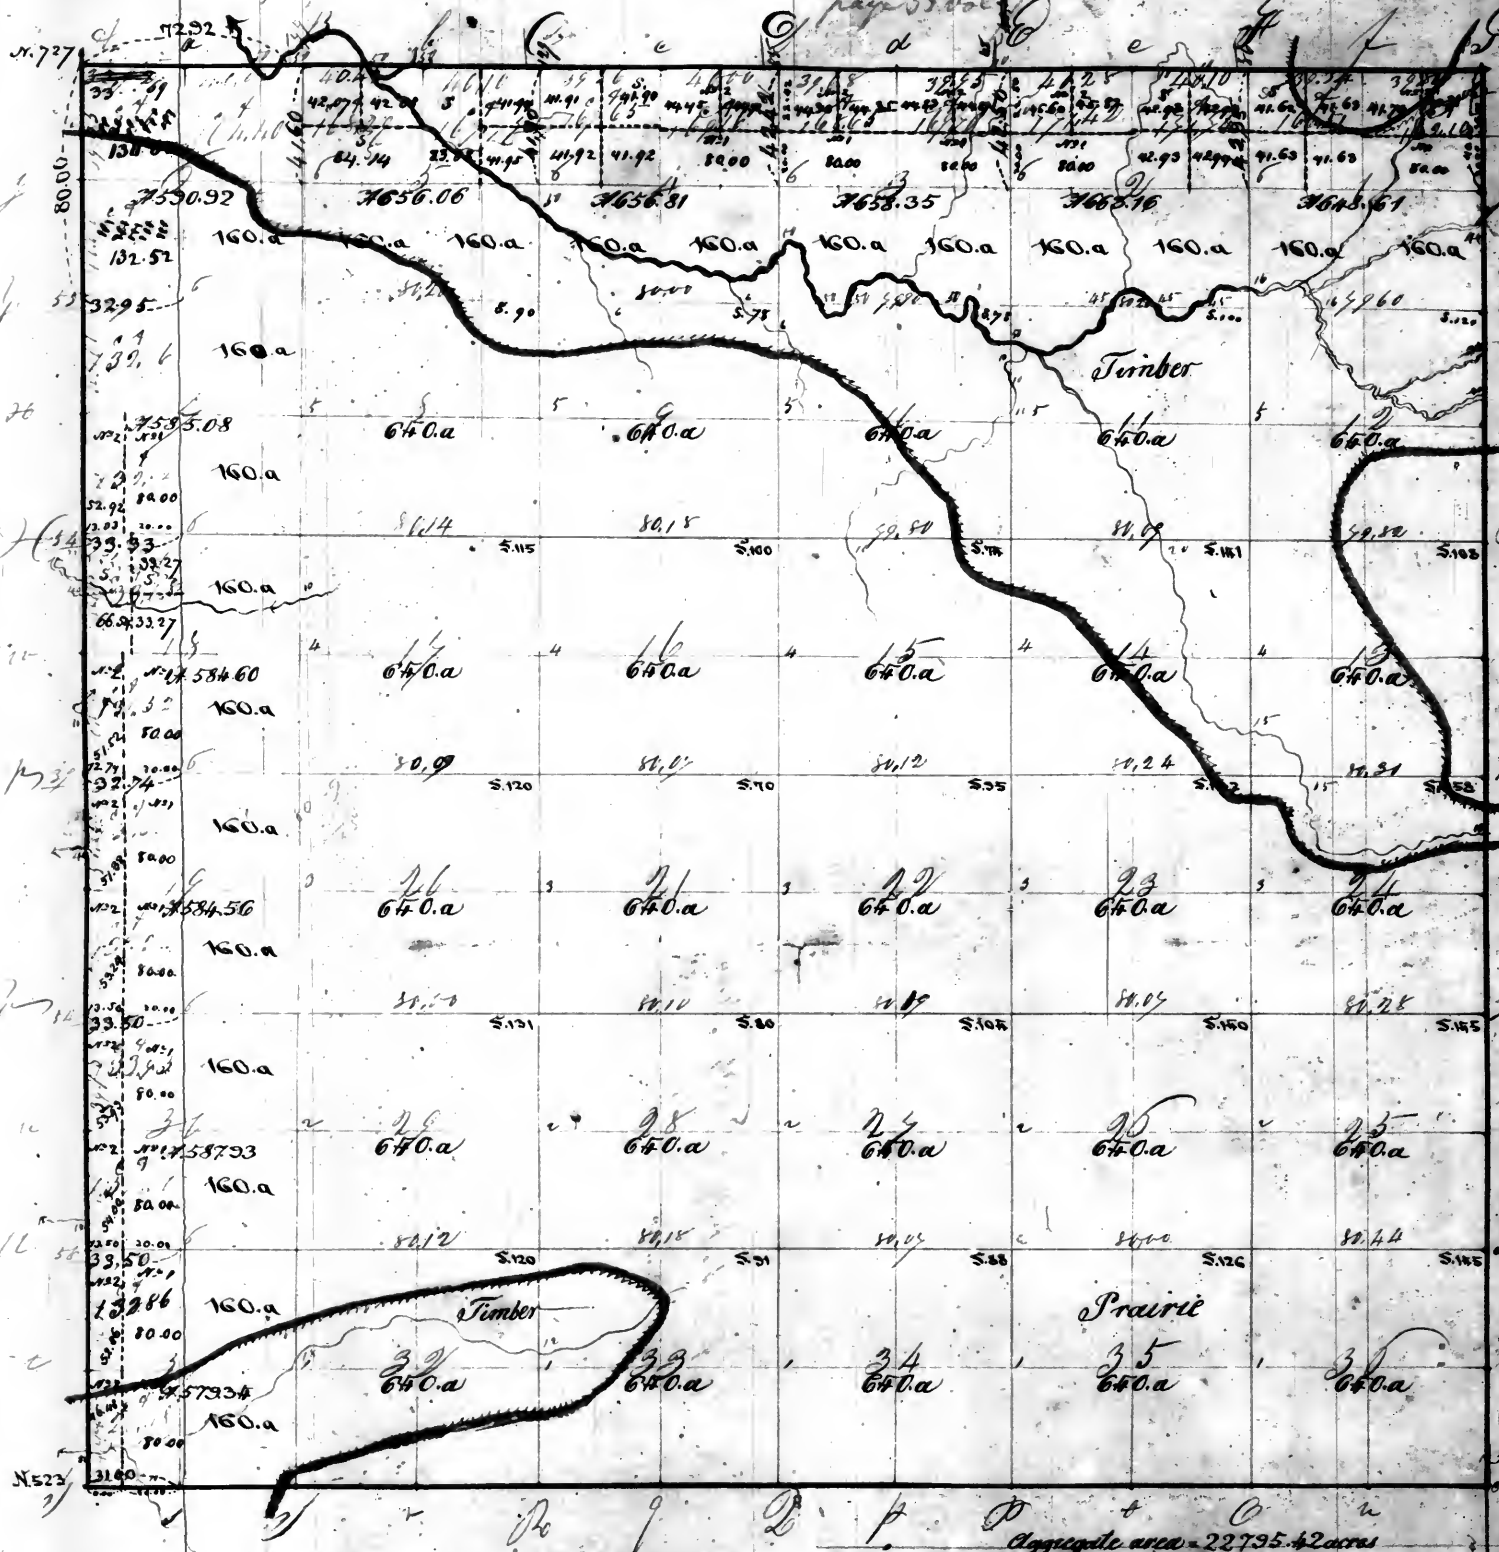

Of Surveyor's office
Saint Louis Sept. 15th 1849
The North East quarter of section
10-4, the North West quarter of
section 2, the North East quarter of
section 3, the North West quarter of section 7, and
the West halves of sections
10, 20 & 30, situated under the
act of Congress of the 5th of April
1812 - the North East quarter of
section 1, the North West quarter of
section 2, and the
South East quarter of section 3, situated
under the act of Congress of the 5th of April
1812 - and a plot of
the same sent to the Register
and another to the Commissioner
for the General Land Office
same day -

Aggregate area - 22795.42 acres

Assent is a contract with & distribution from the Surveyor of the Lands of the United
States in the State of Illinois & Territory of Missouri bearing date the day of
I have administered land out & surveyed the above described Township & do
Certify that it had such marks & bounds both natural & artificial as are represented
on the plat & described in the field notes made thereof & returned with this plat
into the Office of the Surveyor of the Lands of the United States for the State of
Illinois & Territory of Missouri


Certified 21st May 1849

Thea Mathews D.S.

Rounded

Township N. 6. North of the Base line of Range N. 2 East of the 3rd Prin^t Merⁿ

389.

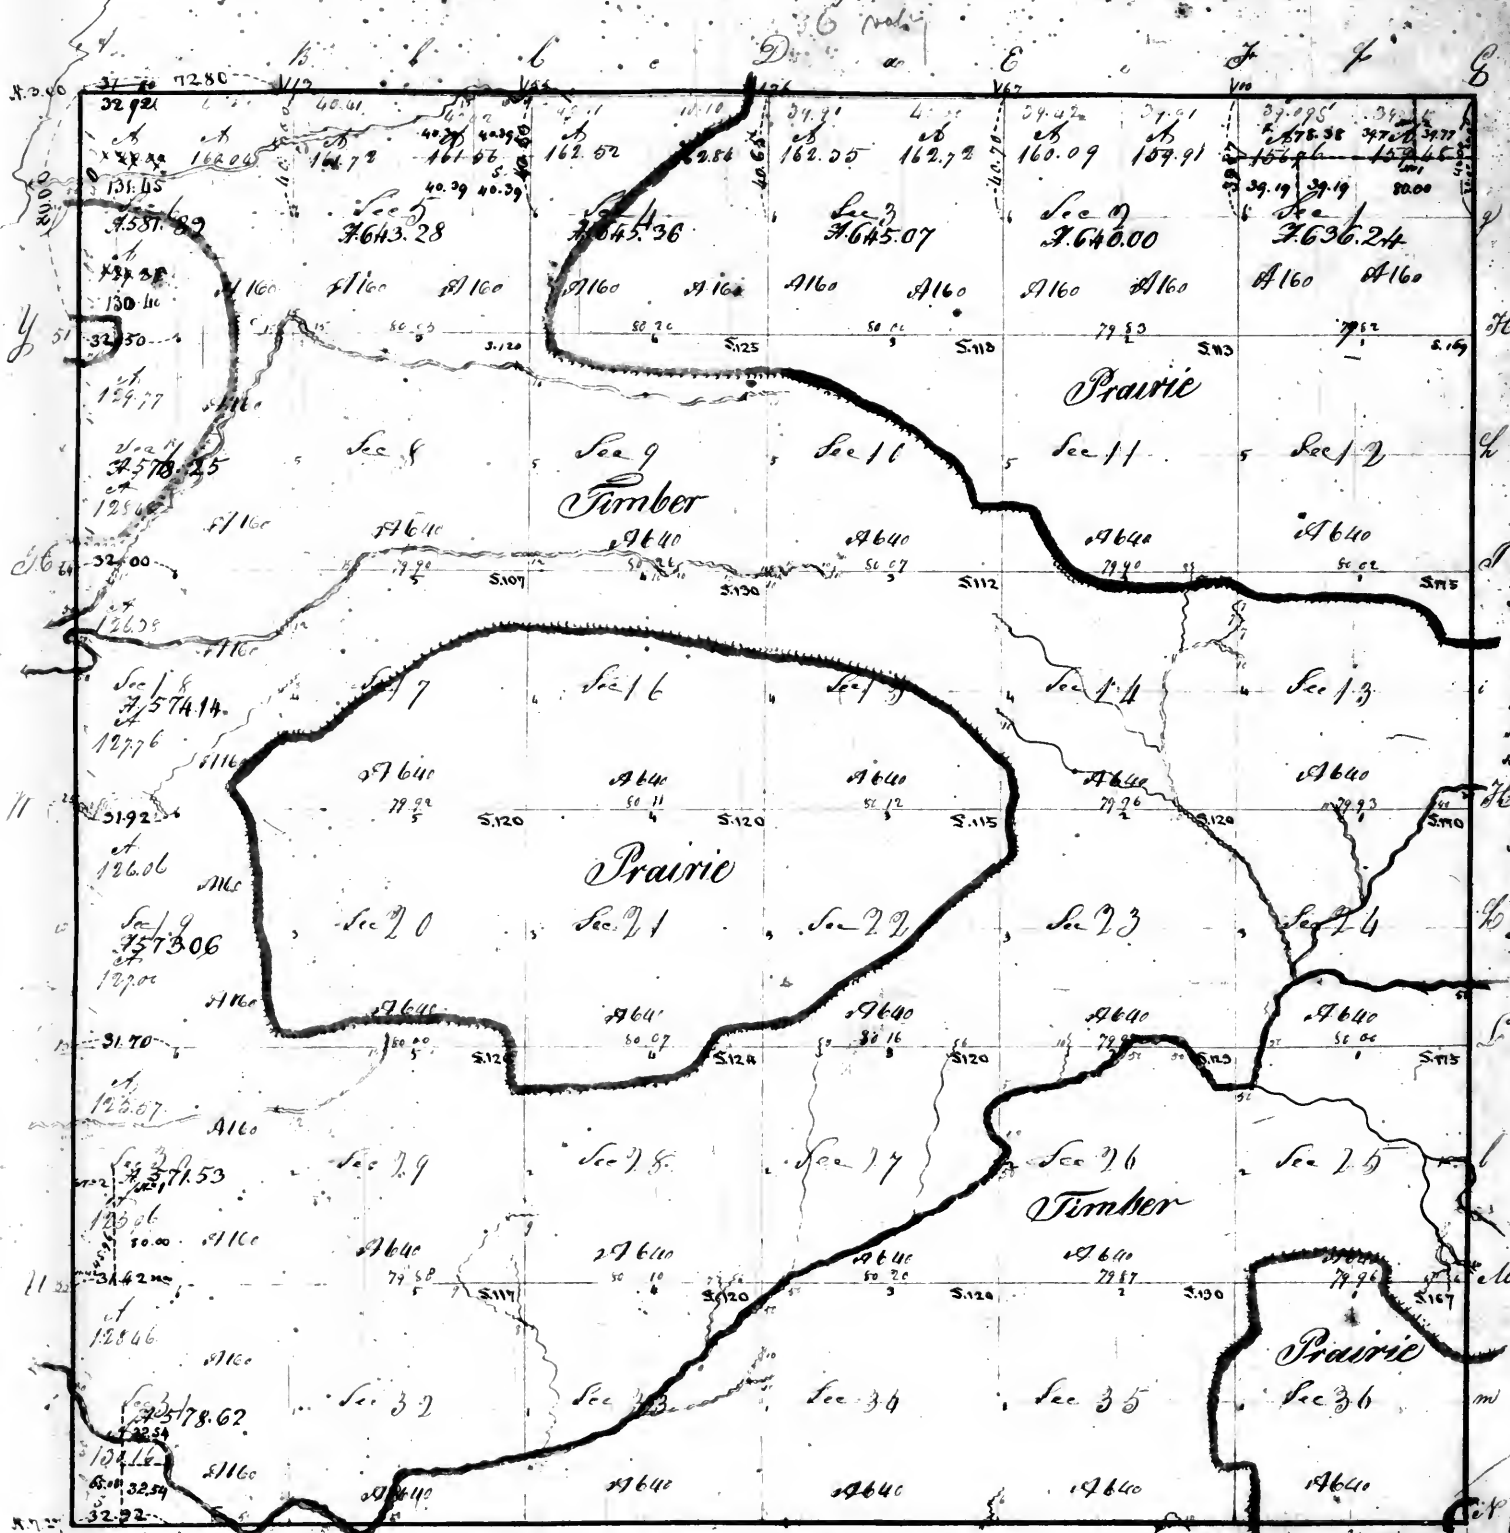

Surveyor's office
The North East quarter of section 1, and the South West quarter of section 30, within the limits of the act of Congress of the 5th of April 1832 - the North West quarter of section 1, the North East quarter of section 3, and the South West quarter of section 31, situated in as to conform to previous sales made by the Agents and recorded by the Commissioner of the General Land Office.

Aggregate area = 22667.44 acres

I am and to a contract with the Surveyor from William Reator Surveyor of the lands of the United States in the State of Illinois Territory of Wisconsin bearing date the 1st day of May 1850. I have examined, laid out & surveyed the above described lands and as the same are situated that it had such marks & bounds both natural and artificial as are represented on the plat and as shown in the field notes made thereof and returned with the plat into the Office of the Surveyor of the lands of the United States for the State of Illinois and Territory of Wisconsin.

Certified 21st May 1851


Wm. Mathers J.S.

Scale 60 Ch. 1" = 60 Ch. 1" = 60 Ch.

Rebernd

Township 47 North Range 2 East of the 3rd Principal Meridian

27
390

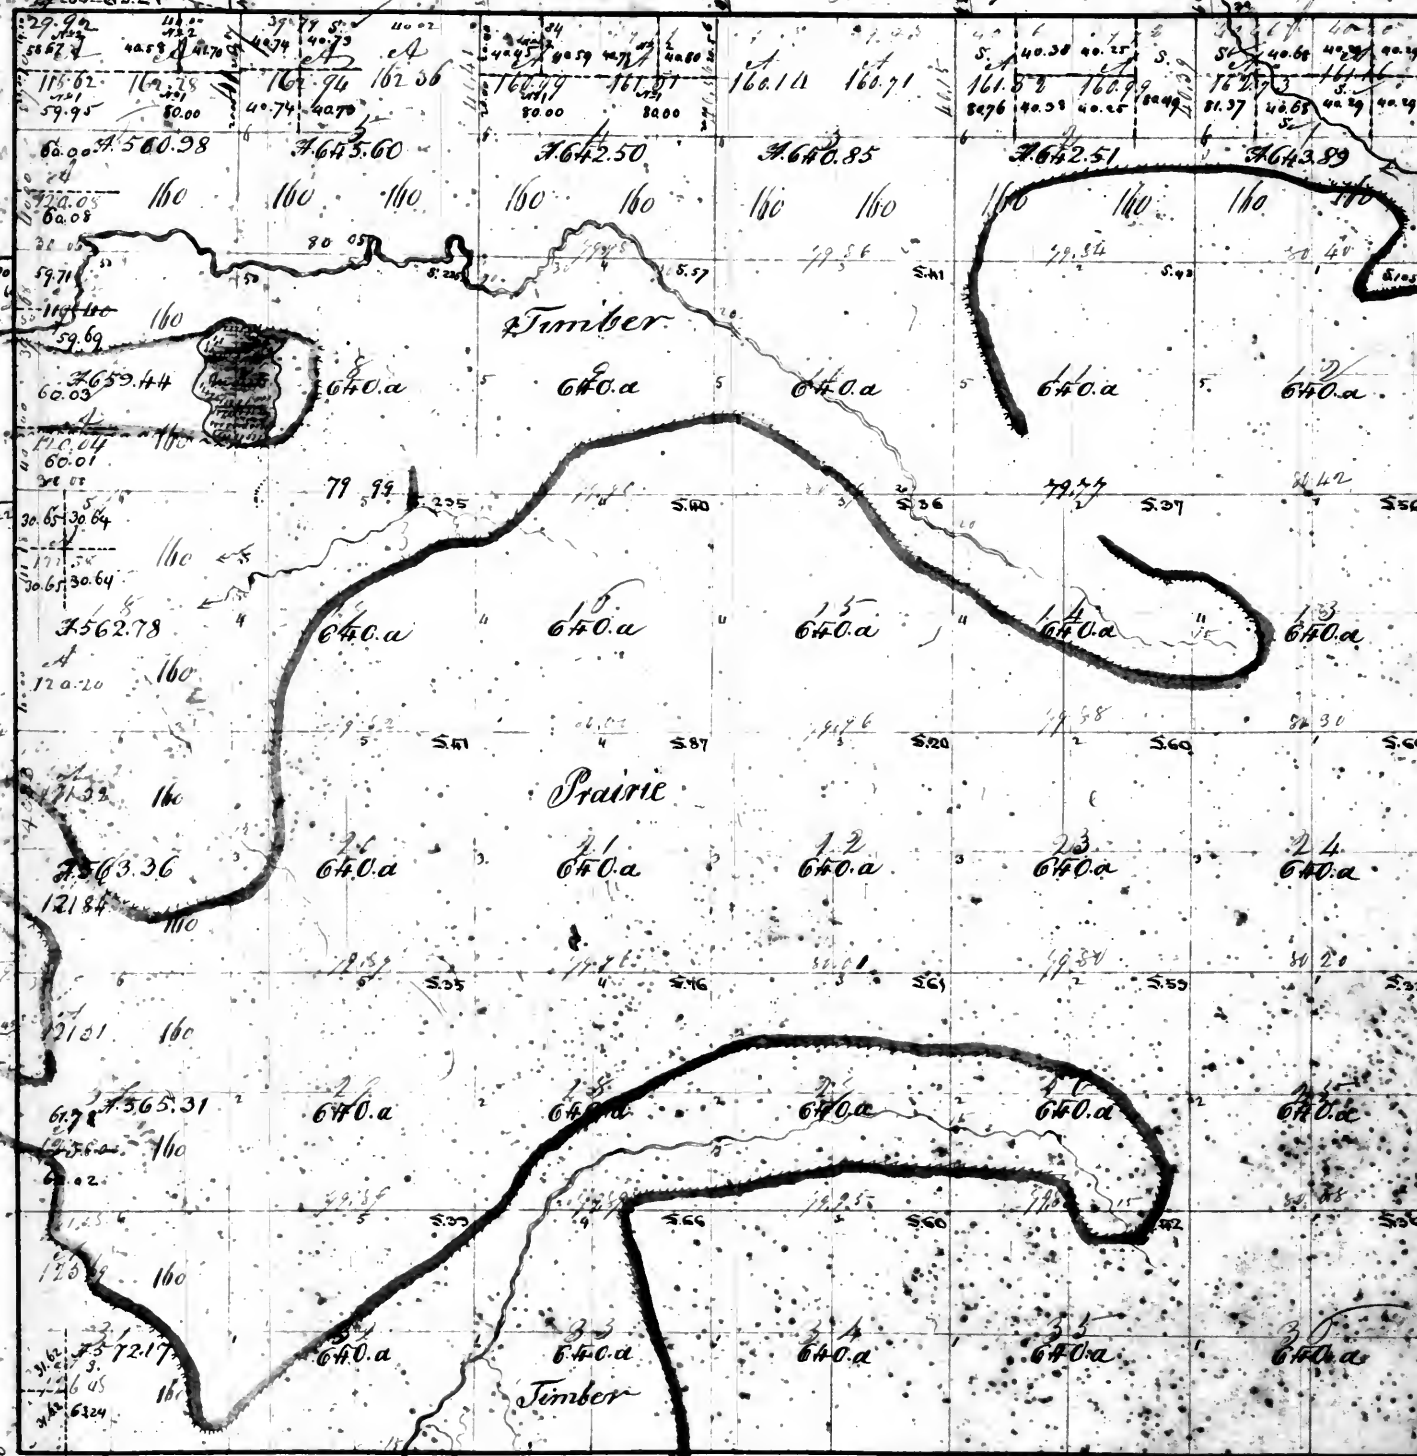


No North house operations 4 & 6
the South east quarters of sections
6 & 34, and the west half of section
7 subdivided under the act of Congress
of the 5th of April 1822 - the North
houses of lots 1 & 2, the North west
quarters of lots 1 & 8, and the
South west quarters of lots 11 & 18, and the
North west 1/4 of 10 as to contain to
grants, said sales & conveyances, in
a plat of the same sent to the
Register and another to the Com-
missioner of the General Land
Office same day.

Surveyors Office.
The Deeds of Section 7 p. S. M.
of the 31. Richard under
the act of Congress of the 5th
of April 1820. The N. W. q. of Sec.
18. of the S. M. of Section 31
Richard was so to conform
to previous sales (marked S.)
and a plat sent to the Register
and another to the Commissioner
of the General Land Office

Swingors office
St. Louis July 11th 1850
The north half of section 4
The north half and S.W. q. of
Sec. 6 in T. 7. N. R. 2 E. of
The S.W. q. of Sec. 10 and
The act of Congress of the 5th
of April 1832 and also of
The north half of Sec. 17 and
The S.W. q. of Sec. 5 sub
divided so as to conform
to the sales made
under the act to the Receiver
and also to the Com^r of the

Re: Y. L. P. aggregate area 2253.33 acres
Pursuant to a contract with & instructions from William W. Taylor Surveyor of the Land of the State of Illinois & Territory of Mississippi bearing date the day of
I have accompanied, laid out & surveyed the above described Townships and do hereby certify
that it had such marks & bounds both natural & artificial as are represented on the plat
& as recorded in the field notes made therefore & returned with the plat into the Office of the
Surveyor of the Land of the United States for the State of Illinois & Territory of Mississippi

390

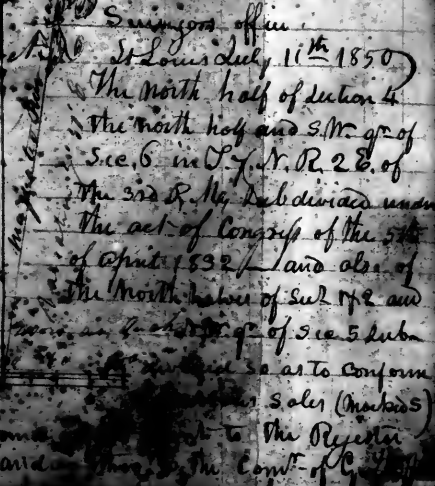

Aggregate area - 2250.33 acres
Perrin's file is in contact with, & instructions from William Director Surveyor of the Land of the State of Illinois & Territory of Mississippi bearing date the 24th of
I have accompanied land out & surveyed the above described Townships and as per copy certified
that it had such marks & bounds both natural & artificial as are represented on the plat
& described in the field notes made thereof & returned with the plat into the Office of the
Surveyor of the Lands of the United States for the State of Illinois & Territory of Mississippi

391. 38

Township N^o 8 South of the Base line Range N^o 2 East of the 3rd principal Meridian



Surveyor's office
Saint Louis Sept 15th 1849
The North halves of sections 22, 23, 24, 1000.


Aggregate area = 22525.30 acres.

Pursuant to a Contract with, and instructions from William Rector, Surveyor of the lands of the United States in the Territory of Illinois and Missouri, bearing date the day of I have admeasured, laid out and Surveyed the above described Township and do hereby certify, that it had such marks and bounds both natural and artificial, as are represented on said plat, and described in the field notes made thereof, and returned with this plat into the office of the Surveyor of the lands of the United States, for the State of Illinois and Territory of Missouri and Arkansas.

Receivable

392. 27

Source ship. 19. South of the base line of Range. 1. East of the 3rd principal meridian.

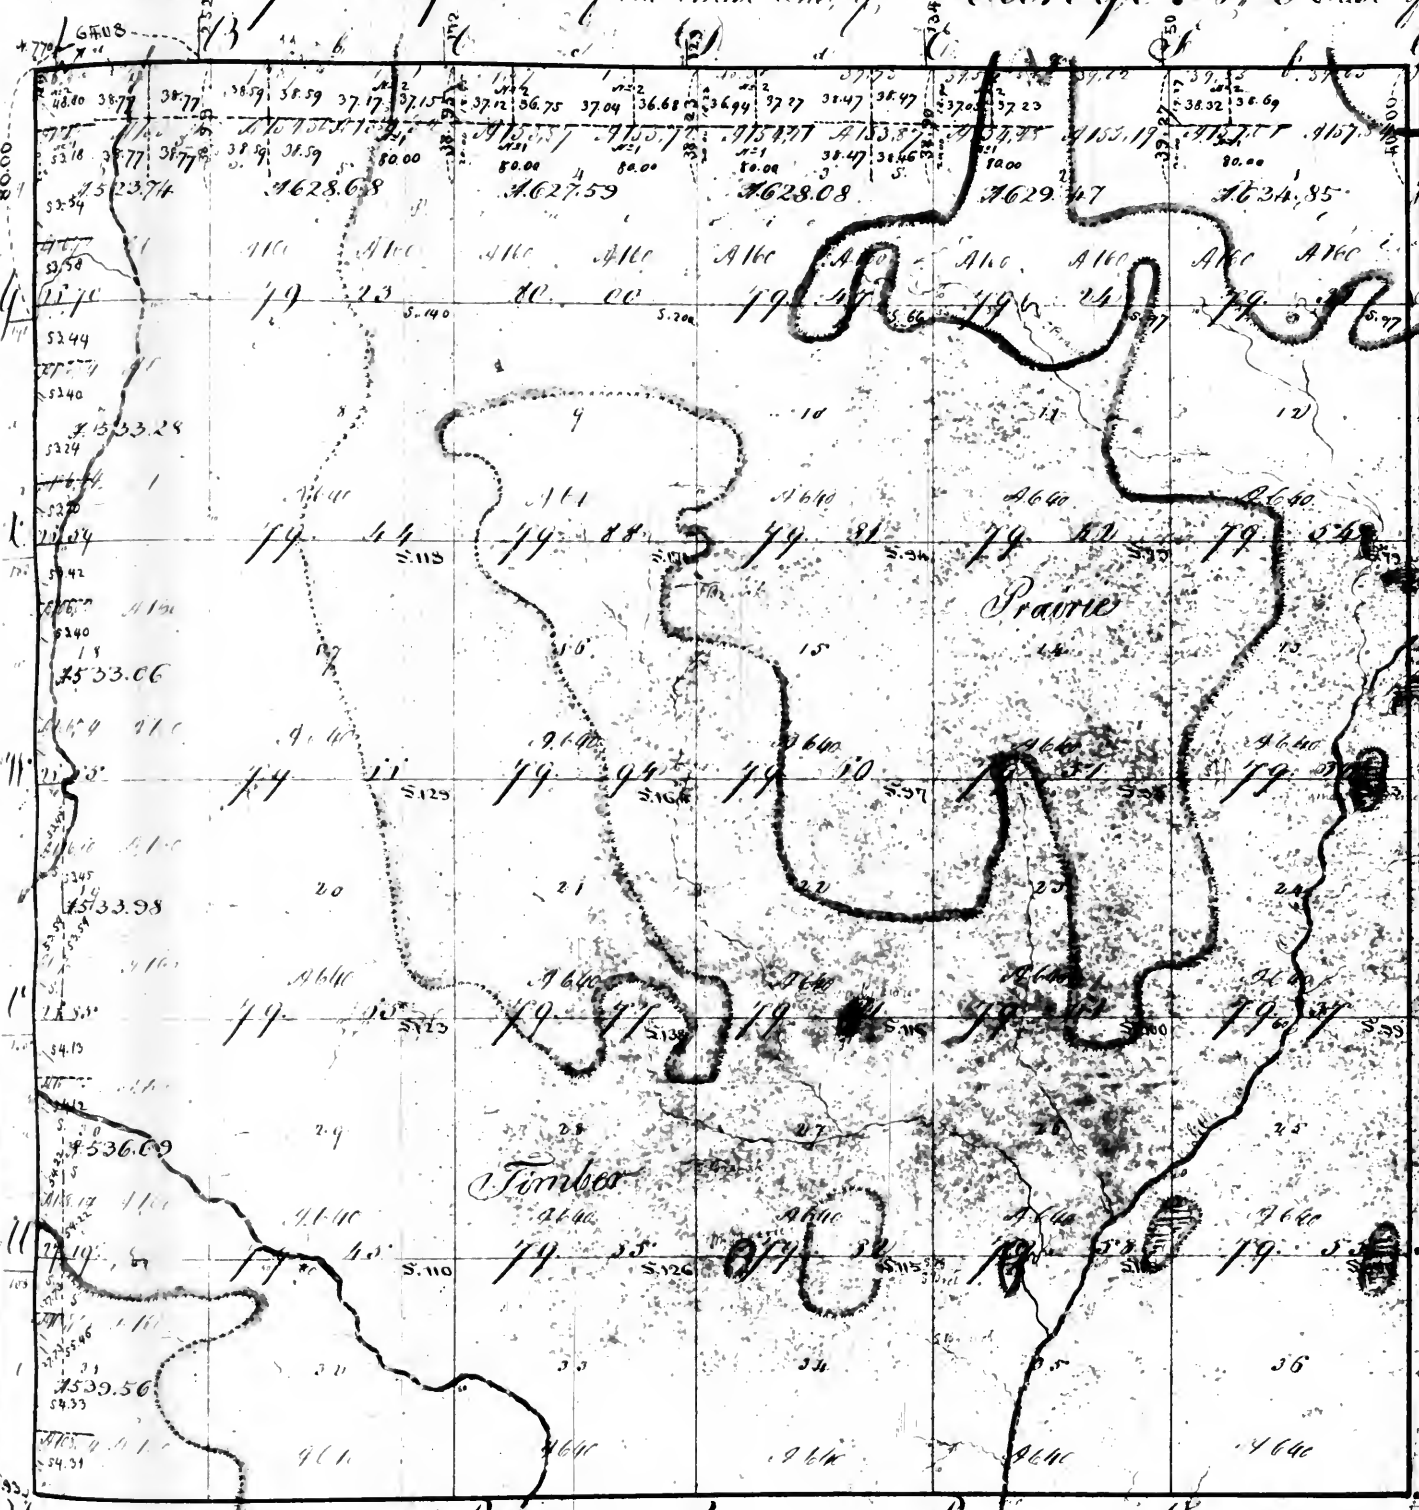

Surveyor's office
The north west quarter of section 12, 32 & 18,
the North half of section 4, the North East
quarter of section 5, the West halves of
sections 6 & 7, and the South West quarter
of section 31, included under the act of
Congress of the 5th of April 1832. —
the North East quarter of sections 32 & 6,
the North west quarter of sections 5 & 31,
and the West halves of sections 19 & 30,
subdivided in accordance to previous
sales, marked S. / — and plat of same
sent to the Register, and another to the
Commissioner of the General Land Office,
same day.

H. Surveyors Office.
 St. Louis 15th Sept. 1849.
 The N. W. gr. of sections 1. 2. & 3. The North
 half of Section 4. The West half of Section
 5. and the N. E. gr. of Section 5 Subdivided
 under the act of Congress of the 5th of
 April 1832. The N. E. gr. of Sections 276
 & and N. W. gr. of Section 5. Subdivided so
 as to conform to previous
 sales (marked 5.) and a
 plat sent to The Register
 and another to The
 Commissioner of the
 General Land Office

Surveyors Office
St Louis July 11th 1850
The west half of Section 7, of the
N.W. q. of Sec 18 and of the S.W.
q. of Sec 21 & 22, q. N. R. 2 E. of the
3rd p. M. subdivided under
The act of Congress of the 5th of
April 1832 - and also of the
west halves of Sec 19 & 30 also
of the N.W. q. of Sec 21, subdivided
so as to conform to previous sale
marked S. 1) and a plat sent
to the Register and another
to the Commissioner of the
Public Land Office.

Aggregate area = 22348.98 acres

Pursuant to a Contract with, and instructions from William Reeder, Surveyor of the lands of the United States in the Territories of Illinois and Missouri bearing date the _____ day of _____

I have measured, laid out and surveyed the above described Township, and do hereby certify, that it had such marks and bounds, both natural and artificial, as are represented on said plat, and described in the field notes made thereof, and returned with this plat into the Office of the Surveyor of the lands of the United States for the State of Illinois and Territories of Missouri and Arkansas.

7

Two




Summary of
 of Louis. July 11th 1857
 The North half of SW 1/4
 T. 10 N. R. 2 E. 3rd P. M.,
 subdivided under the act
 of Congress of the 5th of
 April 1832 and also of the
 North half of SW 2 of the
 N. 10th of Section 4 of the
 T. E. 1st of Section 5 and
 of the T. E. 1st of Section
 5 subdivided 2nd as to con-
 form to previous sales
 (United S.) and a plat
 sent to the Register and an-
 other to the Commissioner
 of the Genl. Land office

Aggregate area = 22298.62 acres
 Pursuant to a Contract with and instruction from the Surveyor of the Lands of the United States in the State of Illinois & Territories of Missouri and Arkansas bearing date the thirteenth day of May in the year one thousand eight hundred & twenty, I have measured and surveyed the above described Townships and do hereby certify that it had such marks & bounds both natural and artificial as are represented on said plat and described in the field notes made thereof and return with this Plat to the Office of the Surveyor of the Lands of the United States for the State of Illinois & Territories of Missouri and Arkansas Certified this 30 day of November 1820—
 Wm. Sayler Hamilton

Ben. Snyler Hamilton
G. Sawyer

Recorded 34
Township No. 11 North of the base line, Range No. 20 East of the principal Meridian. 394

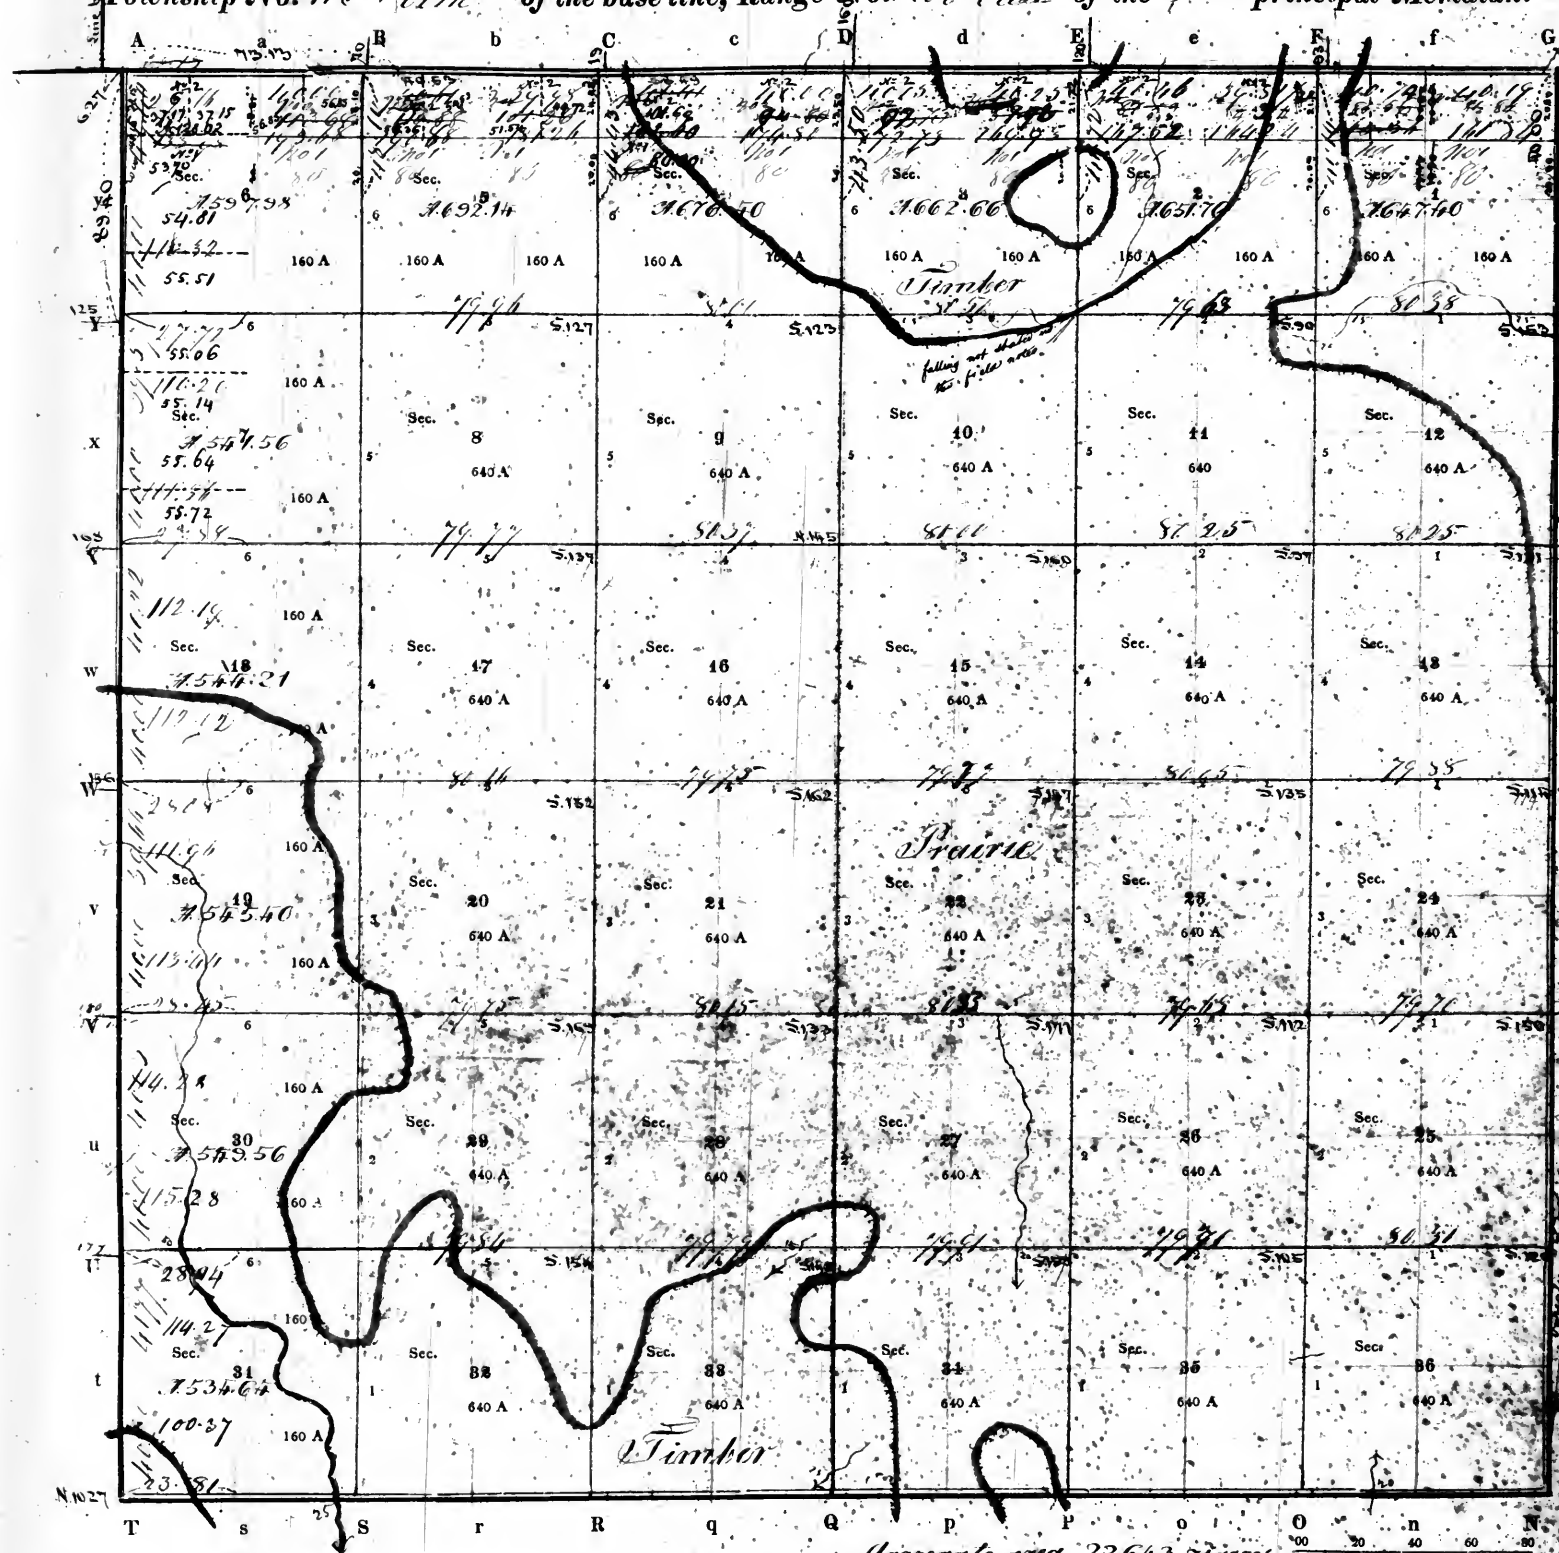

Surveyor's Office
St. Louis 9th August 1849
Plat of the North halves of sects.
1, 2, 3, 4, 5, and of the N.E. q.
of Sect. 6 sent this day to the Com-
missioner of the Gen'l. L.O.

Surveyor's Office
St. Louis 15th Sept. 1849
The West halves of sections 6, 9,
Register and another to the
Commissioner of the Gen'l.
Land Office.

Surveyor's Office
St. Louis 26th Oct. 1850
The North halves of sections
1, 2, 3, 4, 5, and of the N.E. q.
of Sect. 6, and a plat sent to the
Register and another to the
Commissioner of the Gen'l.
Land Office.

Aggregate area = 22643.77 acres

PURSUANT to a contract with, and instructions from WILLIAM RECTOR, Surveyor of the lands of the United States in the State of
Missouri Territory of Arkansas bearing date the 10th day of February 1848
I have admeasured, laid out and surveyed the above described Township; and do hereby certify, that it had such marks and bounds, both natural
and artificial, as are represented on said plat, and described in the field notes made thereof, and returned with this plat into the Office of the Sur-
veyor of the lands of the United States, for the State and Territory aforesaid.
Certified this 1st day of May, 1851.

EXAMINED.


W. Hamilton, SURVEYOR

Recorded

52

Township No 12 North of the Base Line Range No 2 East of the 3 Principal Meridians.

395

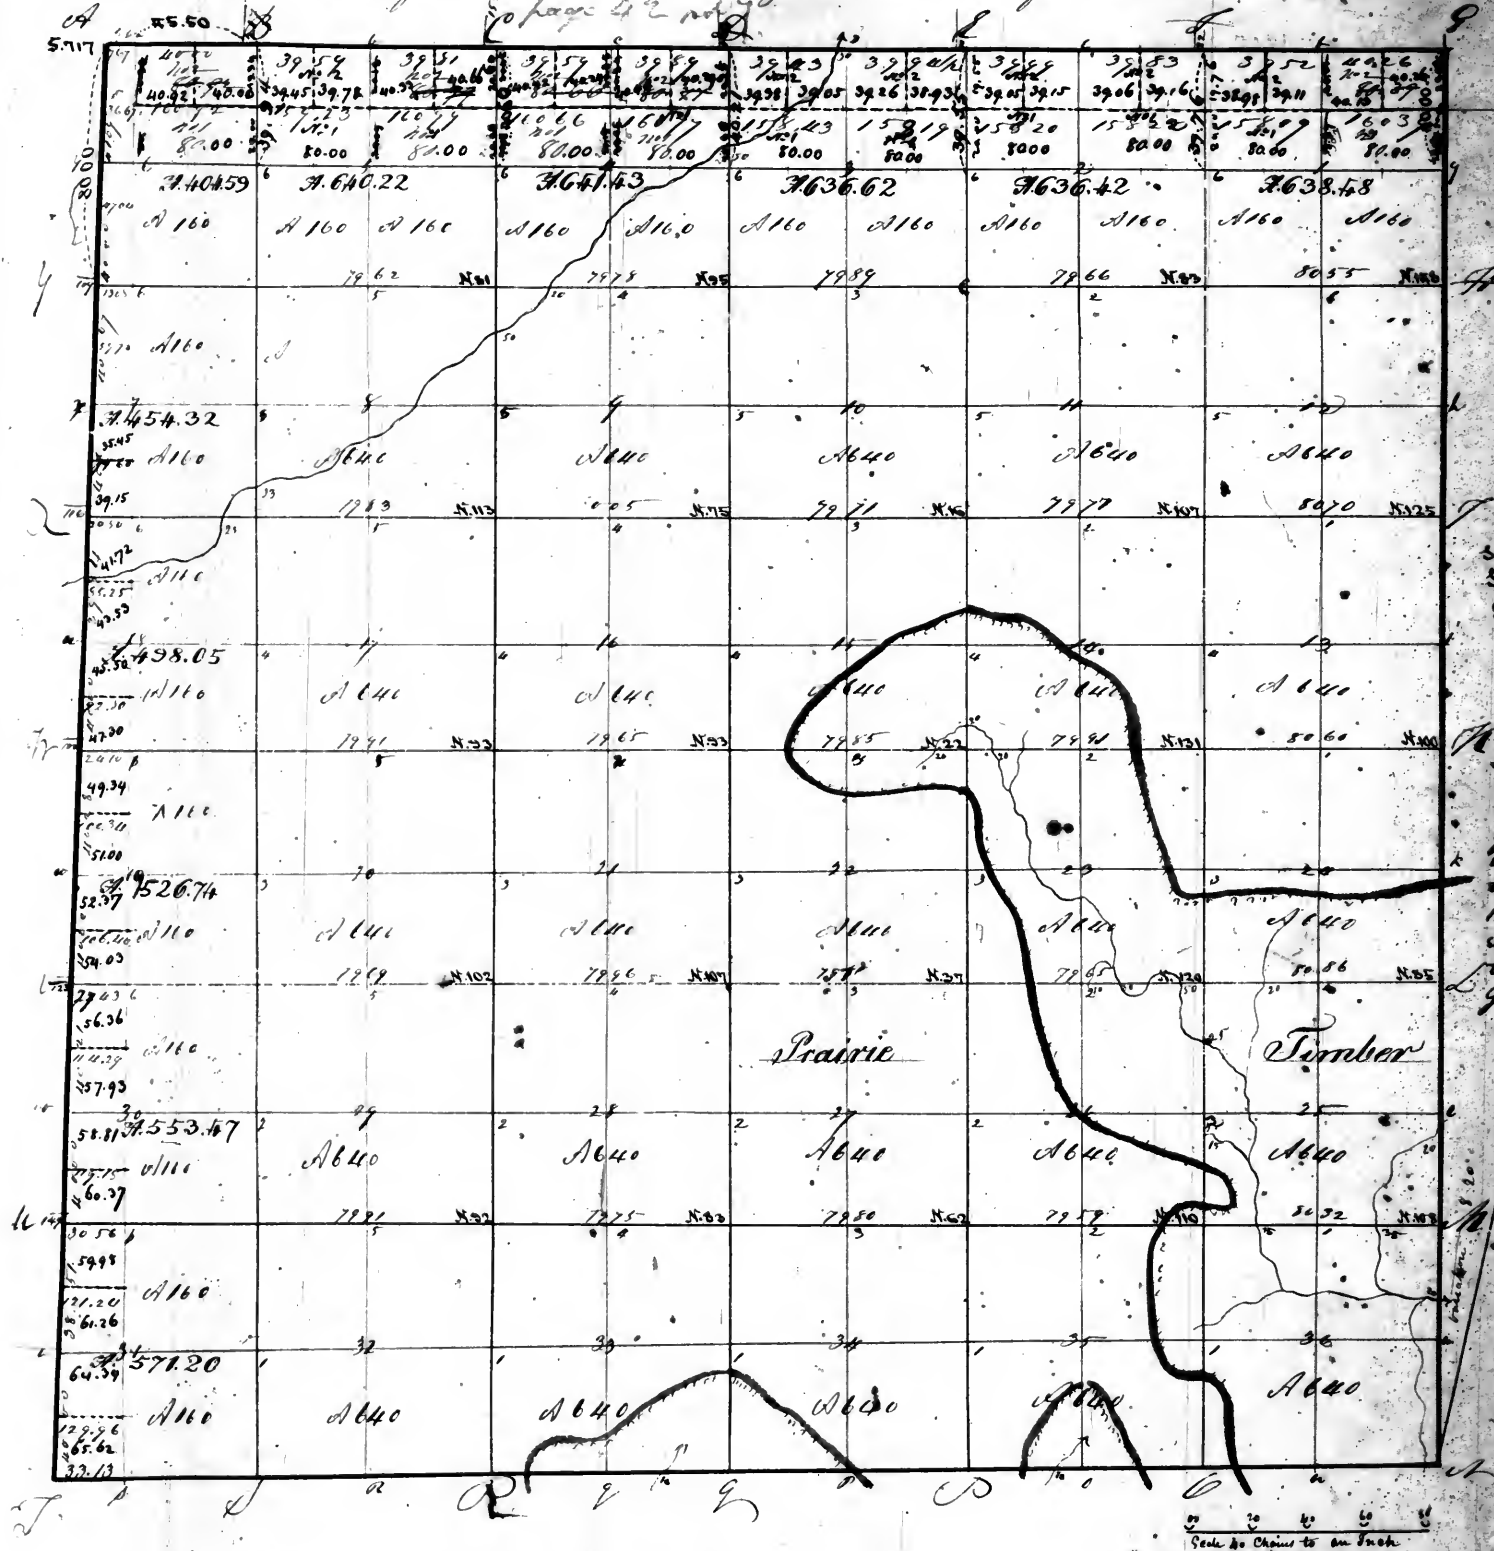

Surveyor's Office
St Louis, Mo. April 2nd.
Part of the NE 1/4 of Sec. 11, 12, 13, 1000.

Surveyor's Office
St Louis, Mo. Sept. 15th 1849
The North halves of sections 1, 2, 1000.


Pursuant to a Contract with and Instructions from William Dotter, Surveyor of the lands of the United States in the State of Missouri and Territory of Arkansas bearing date the Twentieth day of February 1821, I have administered the Survey and laid out the above described Township and do hereby certify that it had such markers and bounds both natural and artificial as are represented on said plat and described in the field notes made thereof and returned with the plat into the Office of Surveyor General of the United States for the State and Territory aforesaid.
Certified this first day of April 1821

Wm Hamilton
Surveyor

Revised

396

Township N^o 13 North of the Base line, Range N^o 26 East of the 3^d Principal Meridian

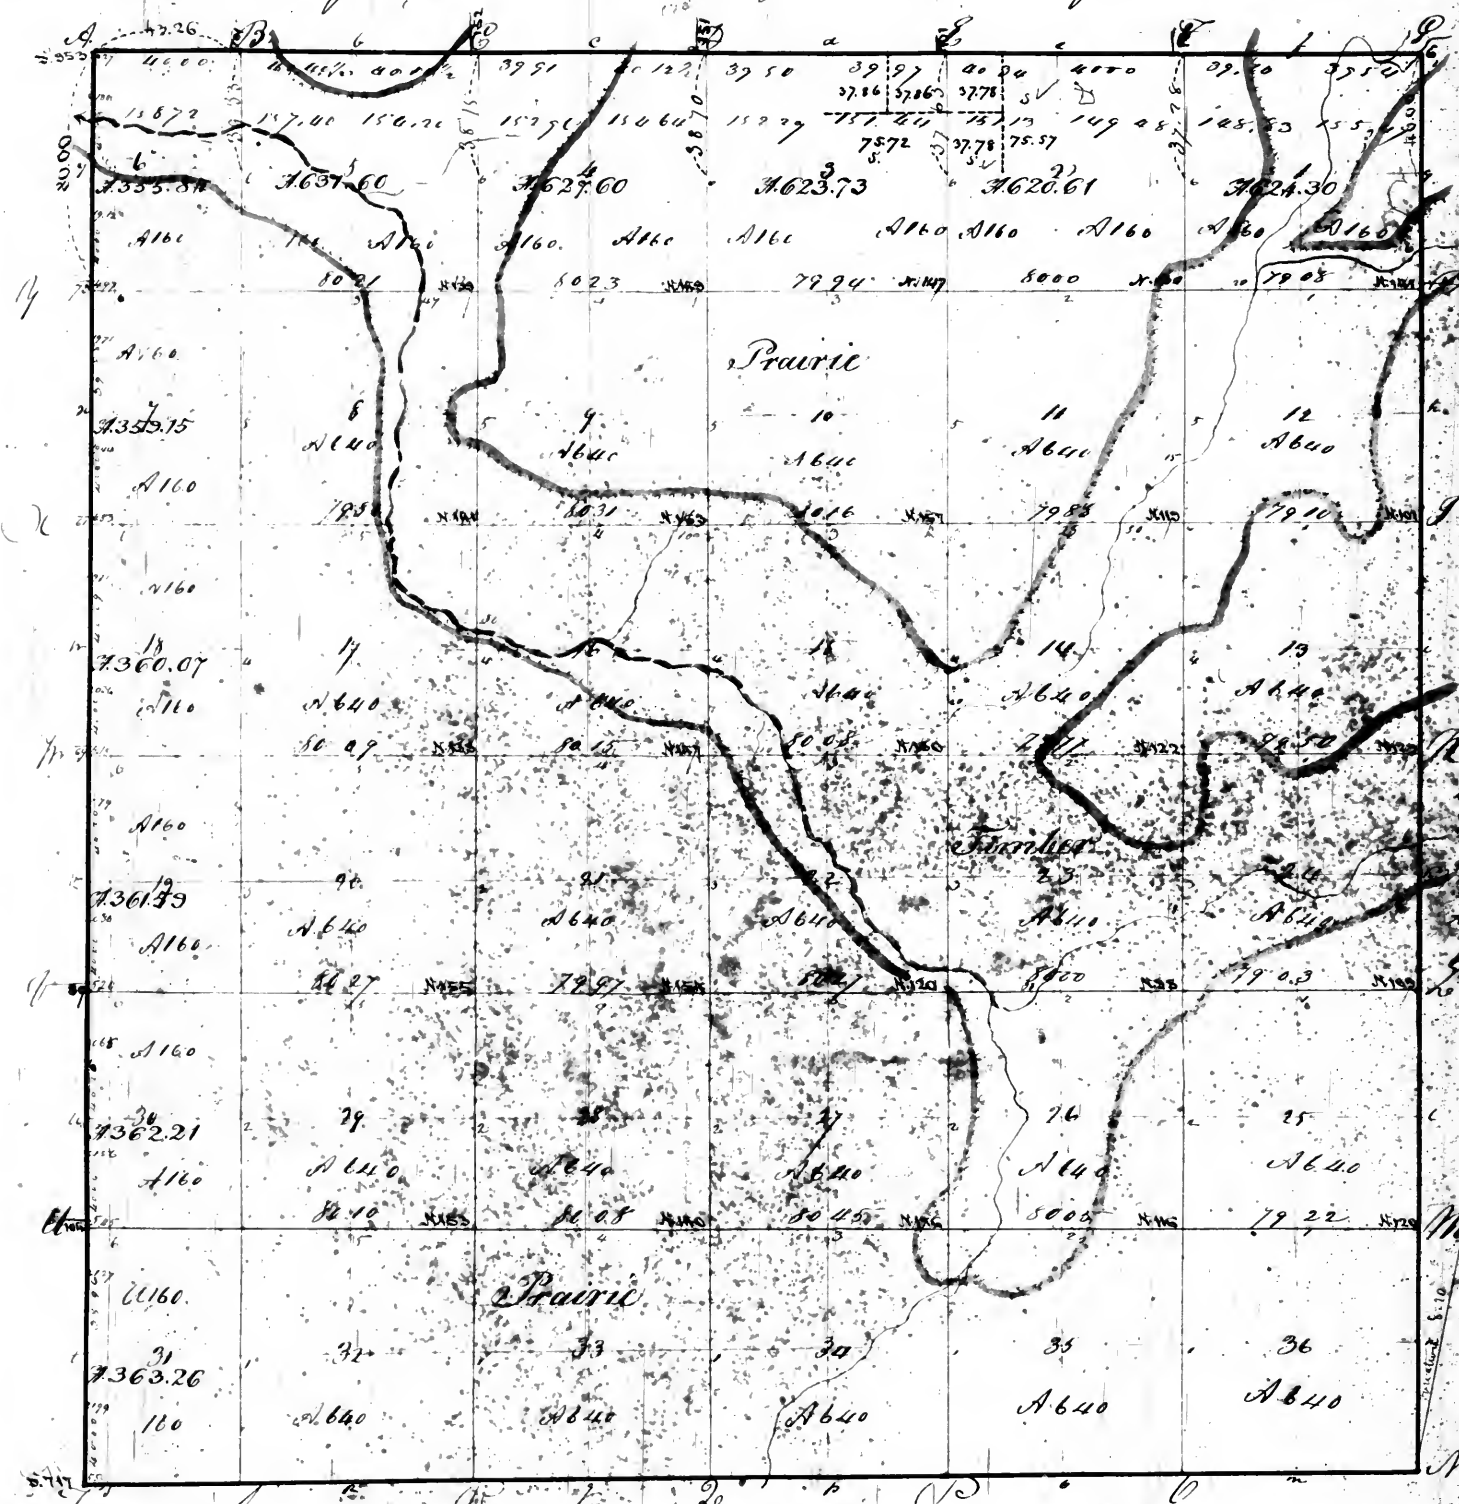

Surgeon Roffie
 St Louis Daily 11th 1850
 The Northwest quarter of section
 2, and the North East quarter
 of section 3, included so as to
 transfer to precious Saks.
 from which a plat was
 to the Register and another
 to the Commissioner of the
 General Land Office.

Aggregate area = 21289.96 acres

Scale 40 Chains to an Inch

(Pursuant to a contract and instructions from William Walter Murray of the lands of the United States in the State of Illinois, Wisconsin & Territory of Arkansas bearing date the twentieth day of February - 1891 before authorized land out and surveyor the above described township; and do hereby certify, that it had such marks and boundaries both natural and artificial as are represented on said plat and describe in the field notes thereof and returned with this plat one in office of the Surveyor of the Lands of the United States for the aforesaid State & Territory





Recorded

397

Township No. 14 North of the Base line Range 1-2 East of the 3^d Principal Meridian

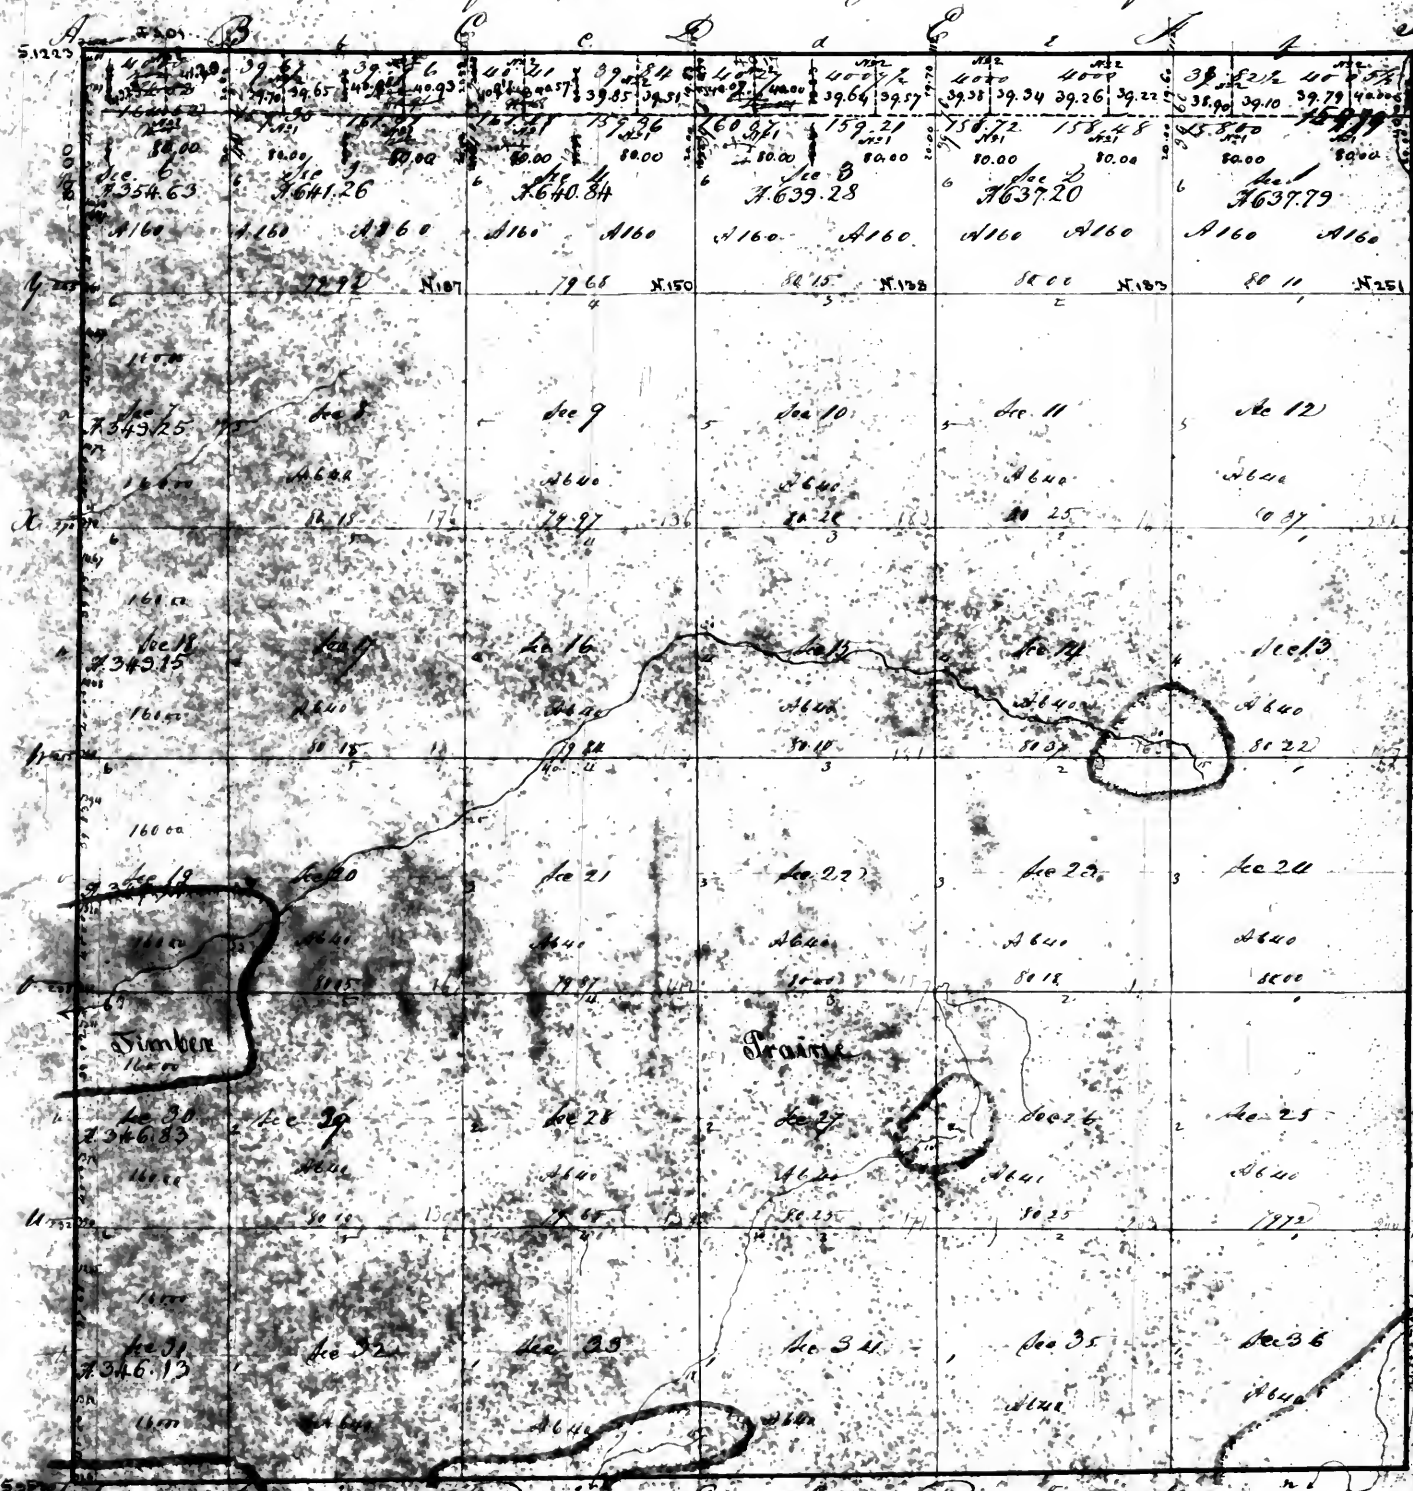

Surveyor's Office
St Louis 10th August 1842.
Plat of the N.W. q. of sec. 5 & 6 of
Twp. 14 N. of R. 2 E. of M. 3, sent this
day to the Commr of the Genl. L. O.
R. S. Surveyor's Office
Smithfield Sept. 16th 1849
The North halves of sections
1, 2, 3, 4, 5, and the North East
quarter of section 6, subdivided
under the act of Congress of the
5th of April 1820, and a plat
sent to the Register and attested
by the Commr. of the
General Land Office:
Same day.

Pursuant to a contract and instructions given William H. Wells surveyor of the lands of the United States in
and returned with this plat into the office of the Surveyor of the Land of the United States for the State of Illinois
Certified this 1st day of June 1842.


Examined

Wm. J. Hamilton, S. Surveyor

Township No 15, north of the base line Range No 2, East of the third Principal Meridian.

Page No 7

Township

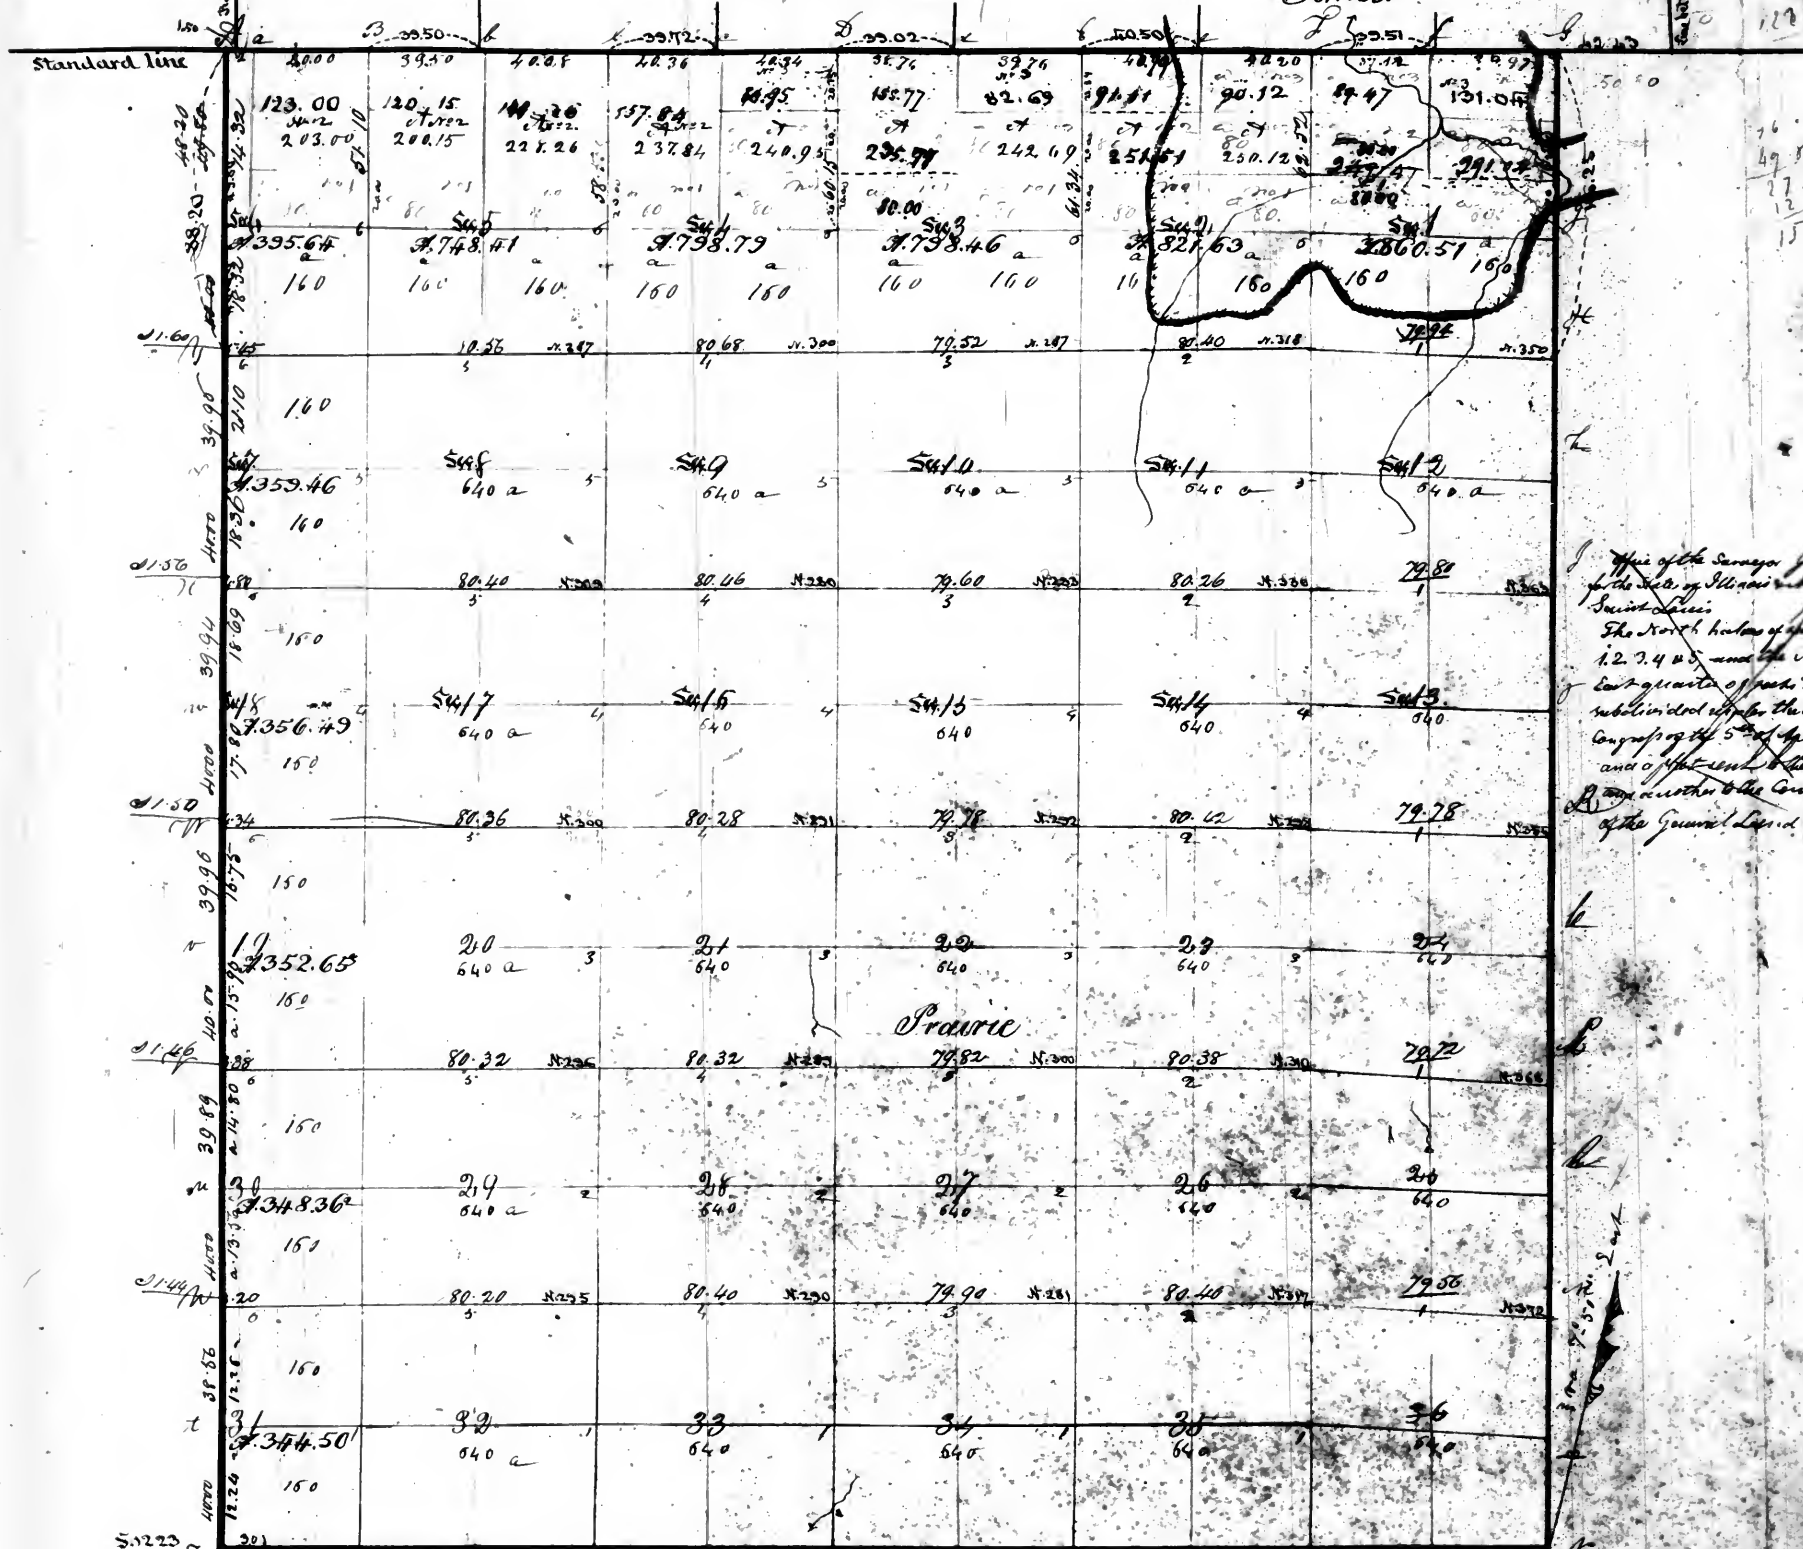

Office of the Surveyor General
for the State of Illinois
Surveyed
The North halves of sections
1, 2, 3, 4, 5, and 6
of the General Land Office

Aggregate area = 22184.90 acres Scale of 100 chains to an inch

I have been directed by a contract with, & instructions from William B. Rector, Surveyor of the lands of the United States, for the State of Illinois & Missouri
& Territory of Arkansas, bearing date the 5th day of March 1821, to have & do hereby laid out and surveyed the above described township, & hereby
Certify, that it had such marks & bounds both natural & artificial, as are represented on said plat, and deposited in the field notes made
thereof, and returned with this plat into the Office of the Surveyor of the lands of the United States, for the State of Illinois & Missouri
& Territory of Arkansas.

Certified this 2nd day of June 1822.

J. B. Anderson


Recorded

56

399

page 46 vol 7

Township No. 16 North of the base line, Range No. 2 East of the 3^d principal Meridian.

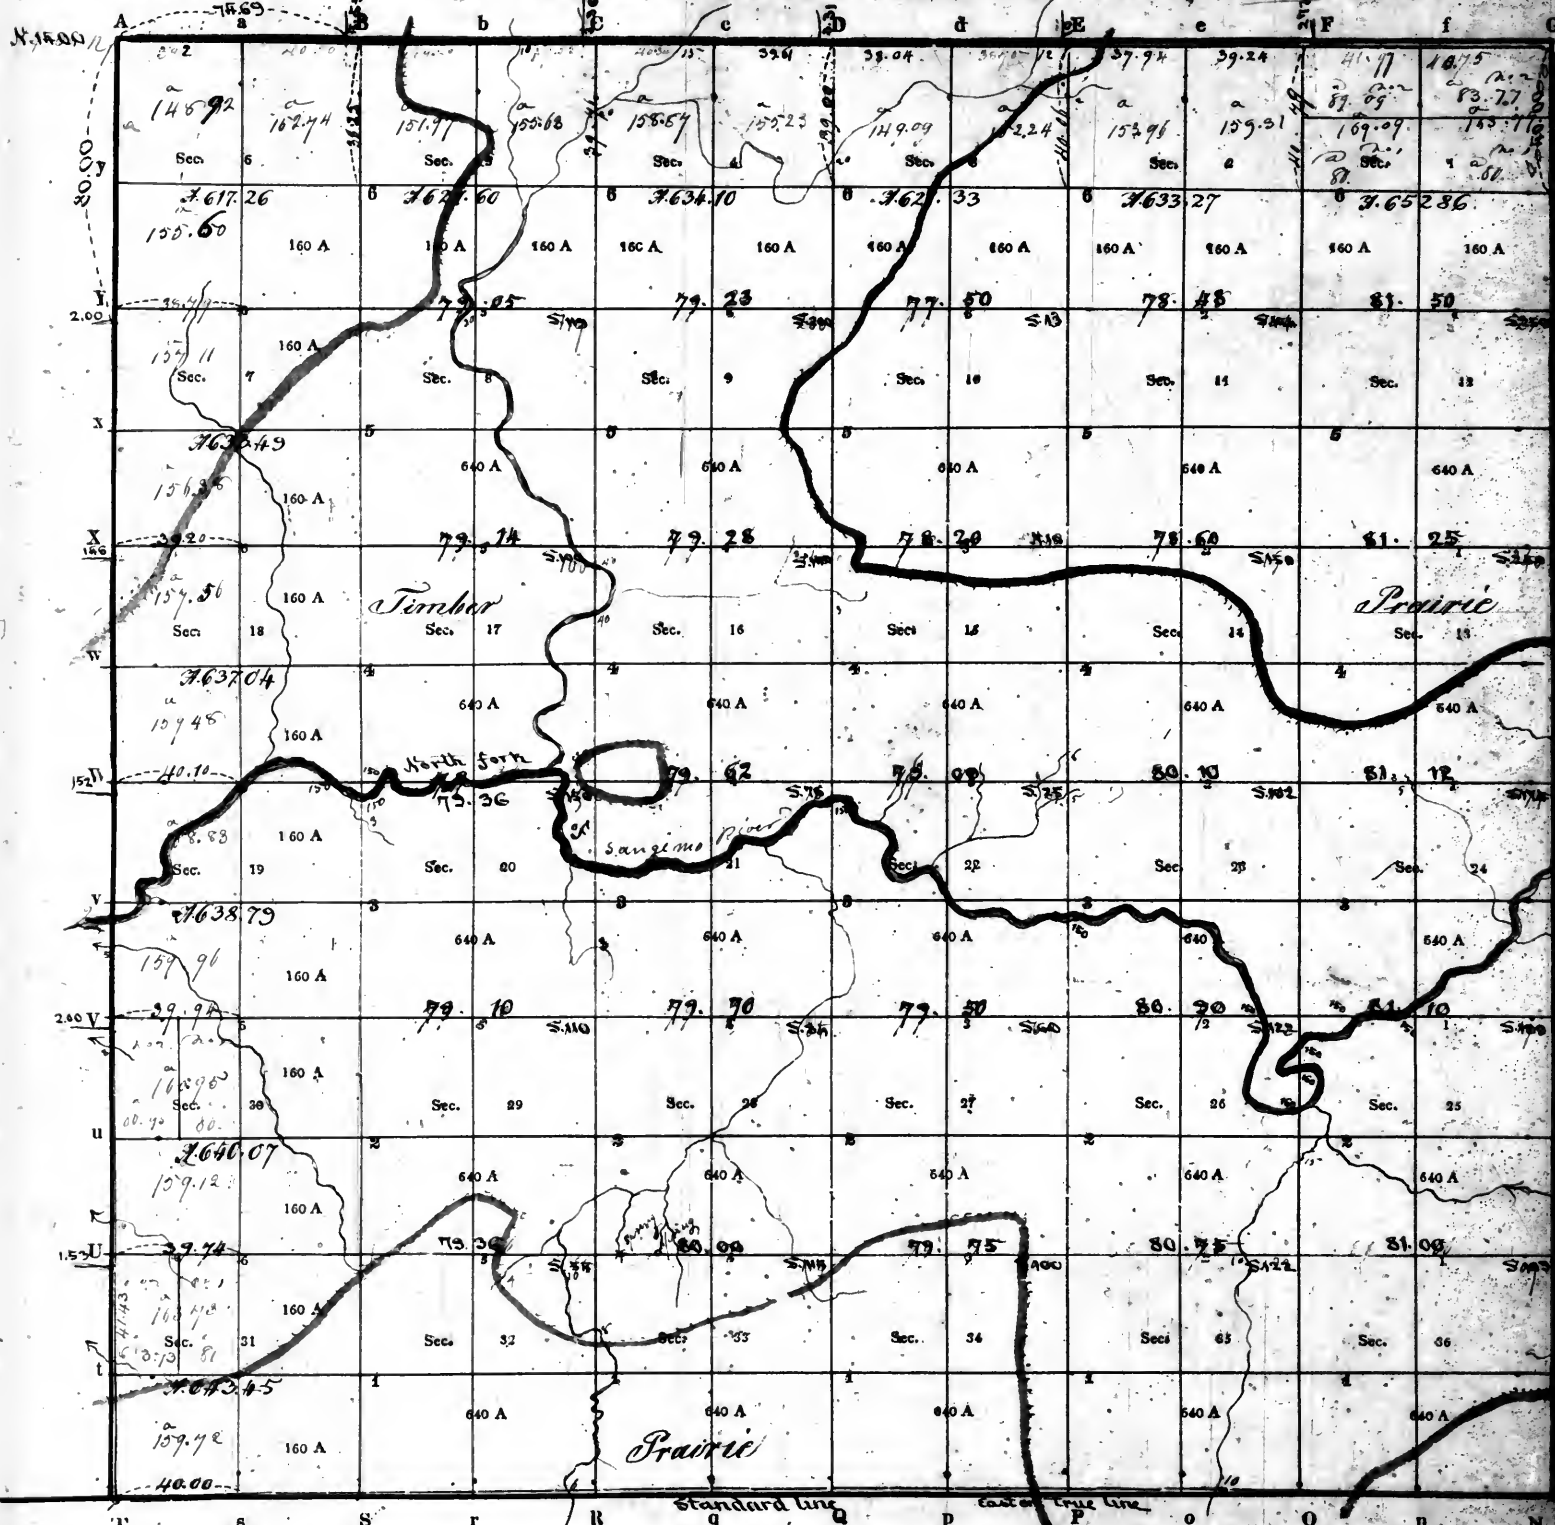

Aggregate area - 22979.26 acres

Scale of 40 Chains to an inch.

PURSUANT to a contract with, and instructions from William Reector, Surveyor of the lands of the United States in the State of Illinois, Missouri and Territory of Arkansas, bearing date the 1st day of February 1882, I have measured, laid out and surveyed the above described Township; and do hereby certify, that it had such marks and bounds, both natural and artificial, as are represented on said plat, and described in the field notes made thereof, and returned with this plat into the Office of the Surveyor of the Lands of the United States, in the State of Illinois, Missouri and Territory of Arkansas.

Certified this 1st day of March 1883

EXAMINED *Wm. Reector*


Wm. Reector
S. SURVEYOR

Recorded

page 48 vol 7

Township No. 18 North of the base line, Range No. 3 East of the principal Meridian.

Surveyor's office
St. Louis July 13 1843
The NW 1/4 sec 5, NW 1/4 sec 6, NW 1/4 sec 7, NW 1/4 sec 18, 19, 30 & 31 the 6th April 1843
the SW 1/4 of sec 6, NW 1/4 of sec 7, subdivided according to sale completed of all and this day to the Register and another to the General Land office on the same day

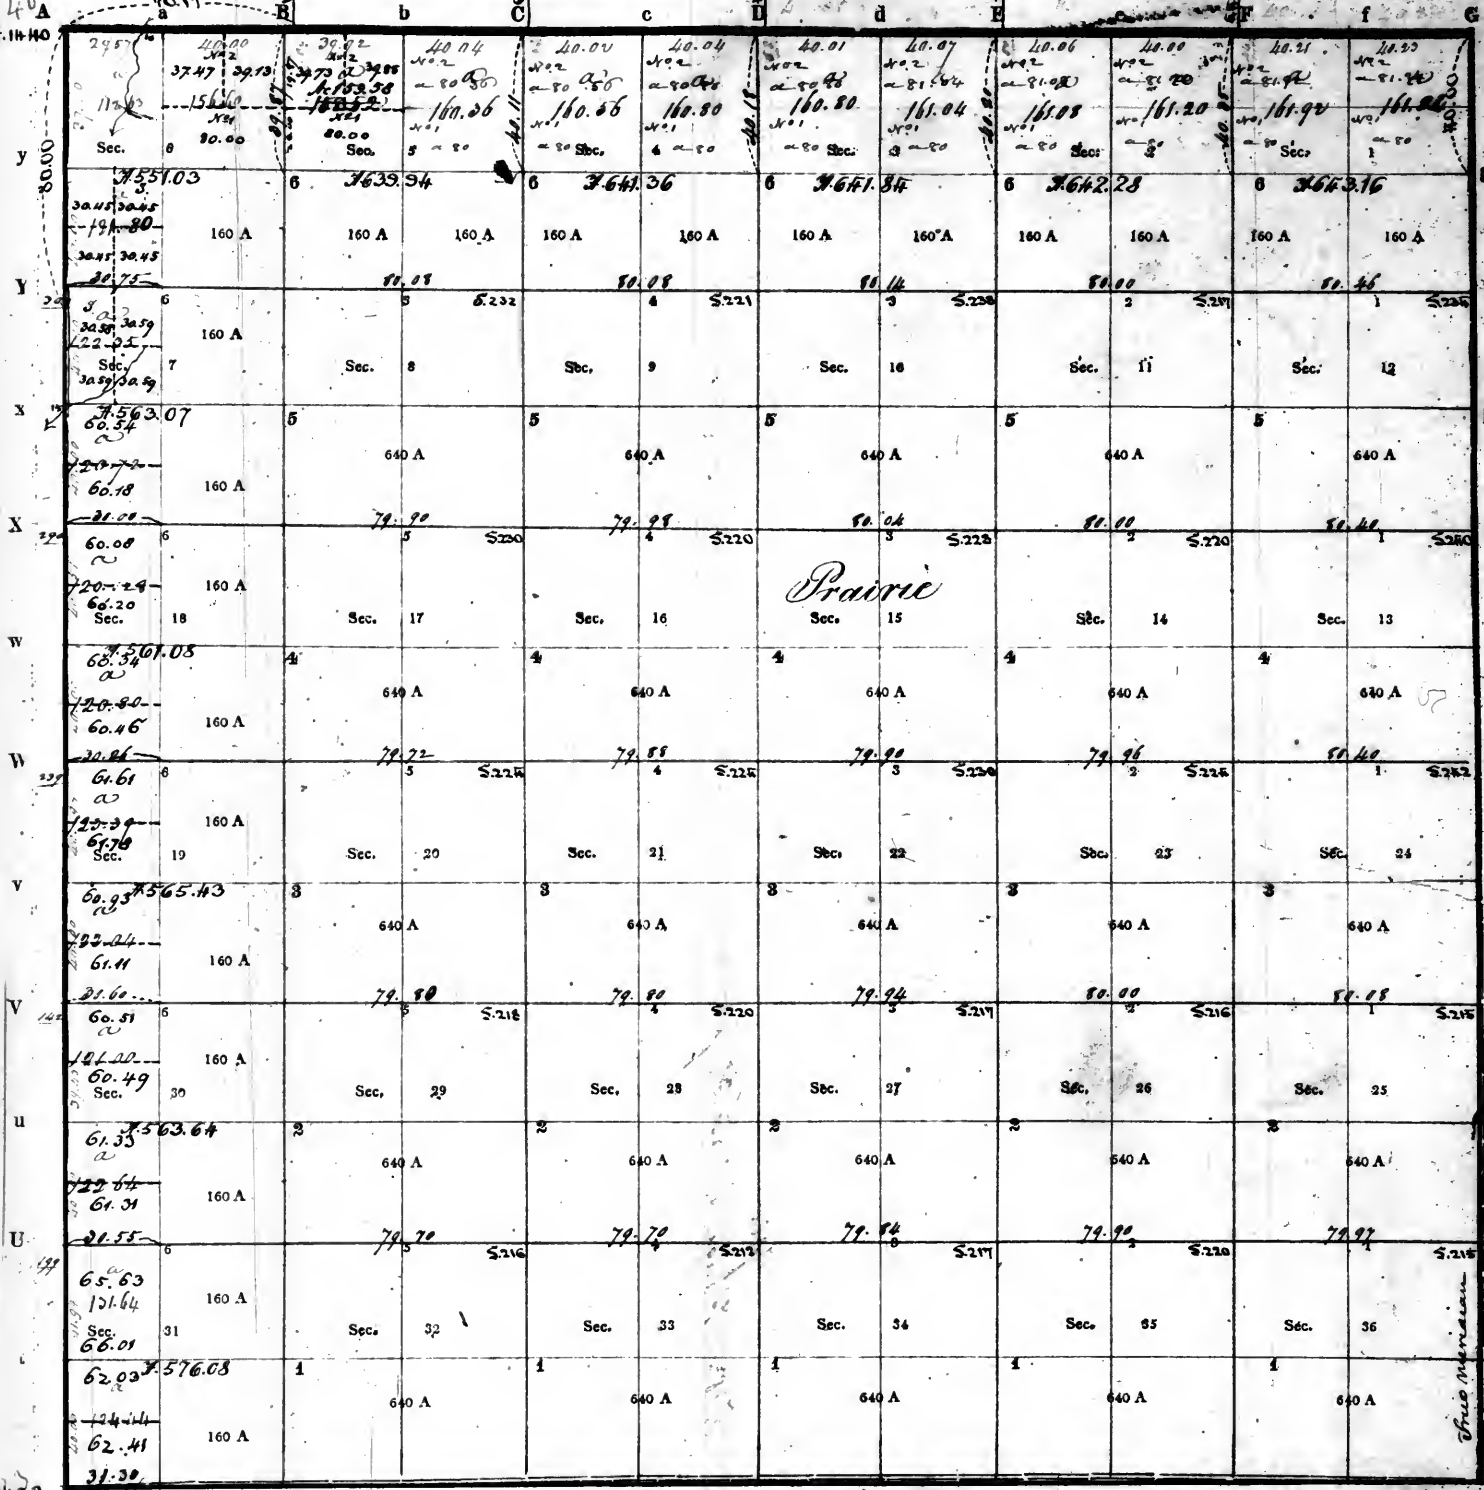

Aggregate area = 22588.91 ac


Scale of 40 Chains to an Inch.

PURSUANT to a contract with, and instructions from William Rector, Surveyor of the lands of the United States in the State of Illinois
Mipauri and Territory of Arkansas
I have admeasured, laid out and surveyed the above described Township; and do hereby certify, that it had such marks and bounds, both natural and artificial, as are represented on said plat, and described in the field notes made thereof, and returned with this plat into the Office of the Surveyor of the Lands of the United States, in the State of Illinois Mipauri and Territory of Arkansas -
Certified this 1st day of March 1843
Wm Rector D. SURVEYOR.
EXAMINED.

Recorded

page 50 vol 7

Township No. 20 North of the base line, Range No. Two East of the First principal Meridian.

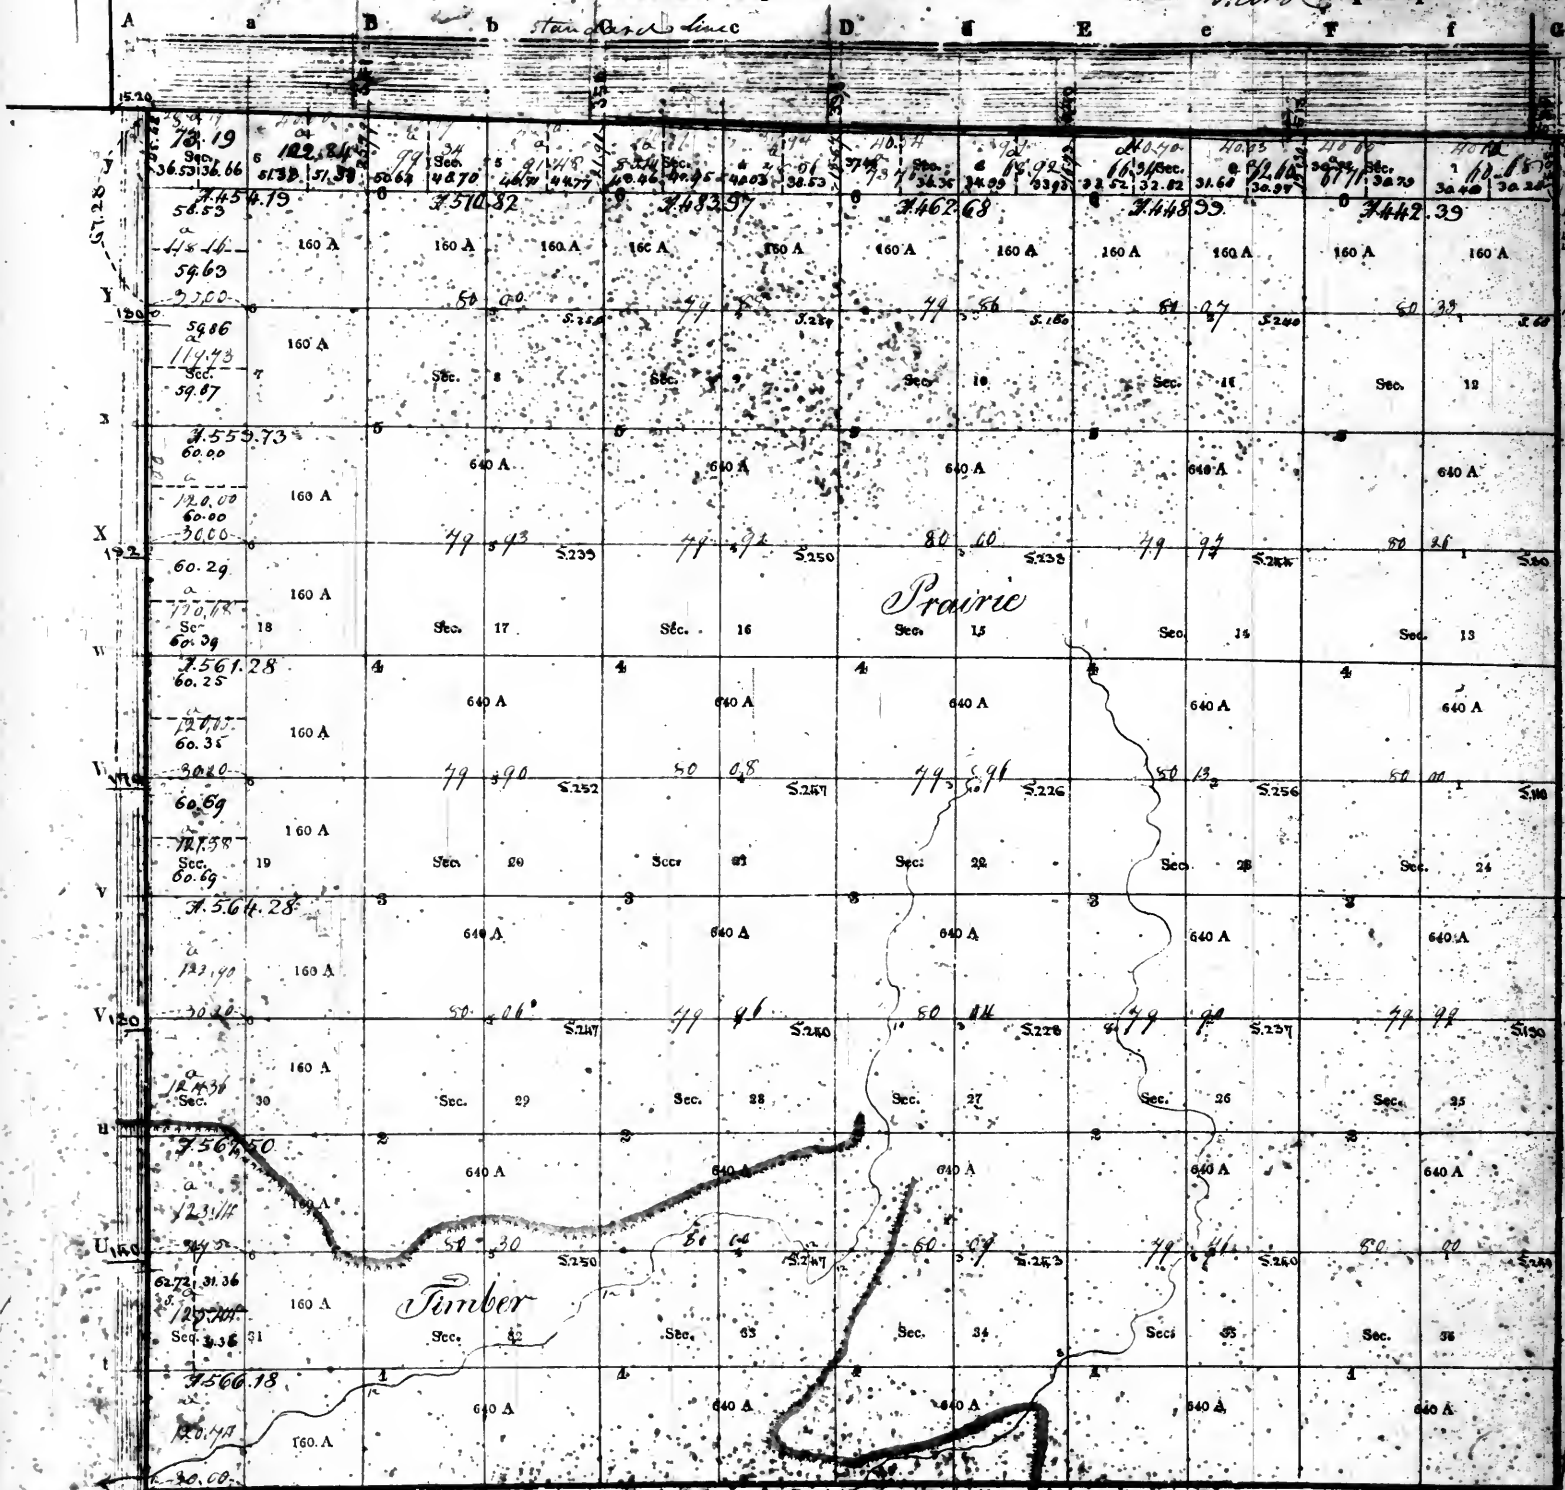

Surveyor's office
Saint Louis June 15th 1849.
The North West quarter of section 1, 2, 3, 4, 5 & 6 - the South West quarter of section 6, the East halves of sections 7, 8, 9, and the North West quarter of section 19 subdivided into the one of Congress of the 5th of April 1832, and the North West quarter of section 31 subdivided to suit and form to appear as sold: more 5, and a plan sent to the Register and another to the Comptroller of the General Land office

PURSUANT to a contract with, and instructions from William H. Wells, Surveyor of the Lands of the United States in the State of Illinois, I have measured, laid out and surveyed the above described land, and do hereby certify that it had such marks and bounds, both natural and artificial, as are represented on said plat and described in the field notes made by me and returned with this plat into the Office of the Surveyor of the Lands of the United States in the State of Illinois, Illinois, and Surveyor of the Lands of the State of Illinois.

Certified this 1st day of March 1850.


EXAMINED.

Surveyor

Record

Township No. 21 North of the base line, Range No. 2 East of the 3rd Principal Meridian

Note: The whole of the distance between the section corners in R. 2 E. is not stated in H.P. notes.

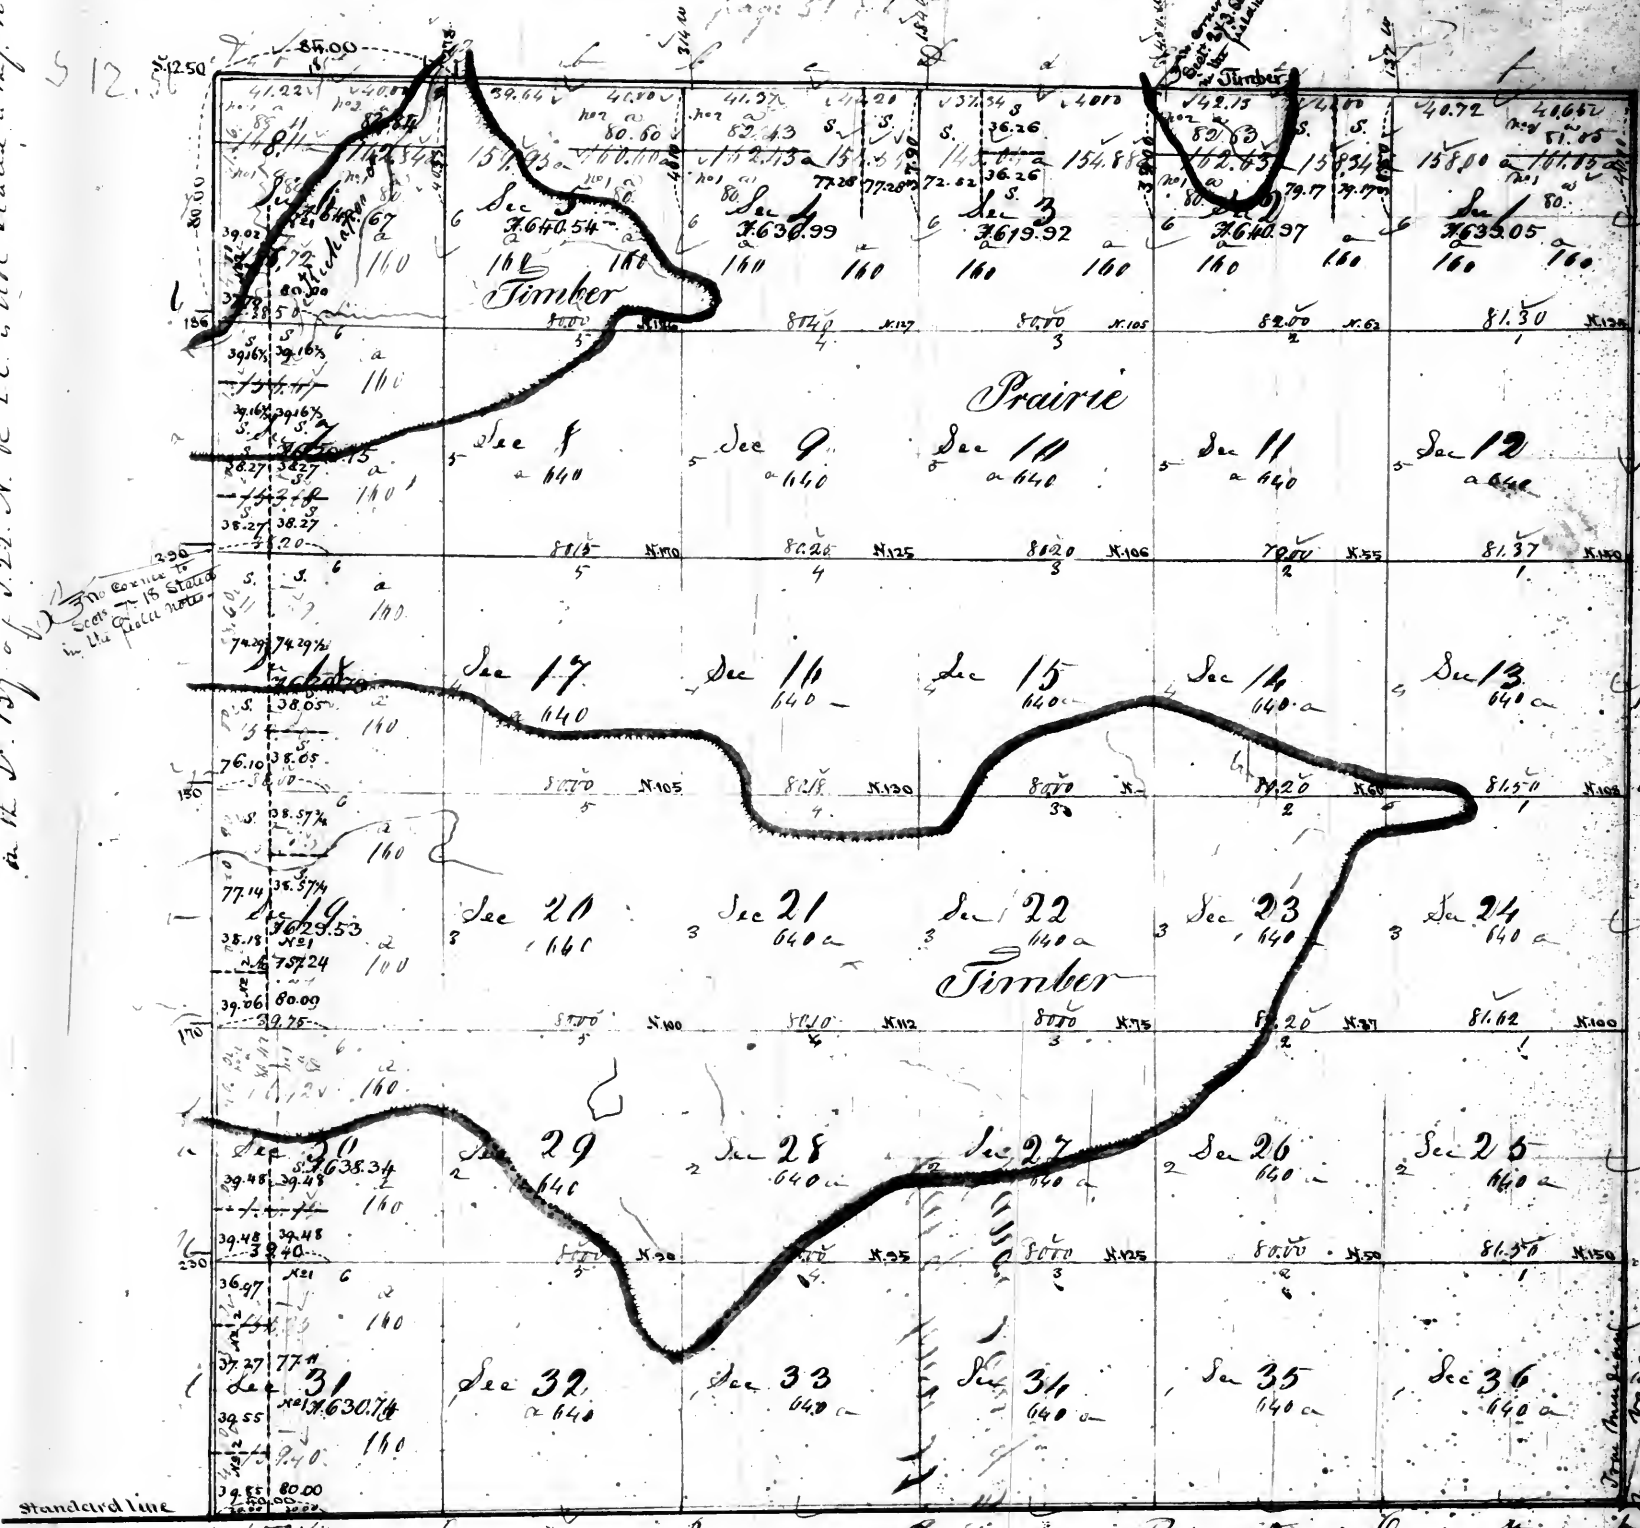

Surveyor's Office
Gained June 13 1848
Substantiated under the act of
Congress of the 5th April 1832.
Shows of said 640 a. and 1/2
of said 36.26 a. - substantiated to
be to conform to sales: the
H.P. of said 200 a. Survey of
June 30 1848, of said 30,
and any of said subdivisions
entirely to the Surveyor
of the G. Land Office on the
same day -

Aggregate area = 22974.30 a. c.
Scale of 40 chains to an inch


Pursuant to a contract with and instructions from William H. Rector, Surveyor of the Lands of the United States in the State of Illinois & Territory of Arkansas, bearing date the 29th day of July 1823. I have measured laid out & surveyed the above described Township; and do hereby certify that it has such marks & bounds both natural & artificial as are represented on said plot and described in the field notes made thereof & returned with this plot into the Office of the Surveyor of the Lands of the United States for the State of Illinois & Territory of Arkansas -
Certifying this 23rd day of December 1823

Wm. H. Rector
Surveyor

Examine
Wm. H. Rector
Surveyor

Recorded

Township No 22 North of the base line, Range No 2 East of the 3^d Principal Meridian
page 52

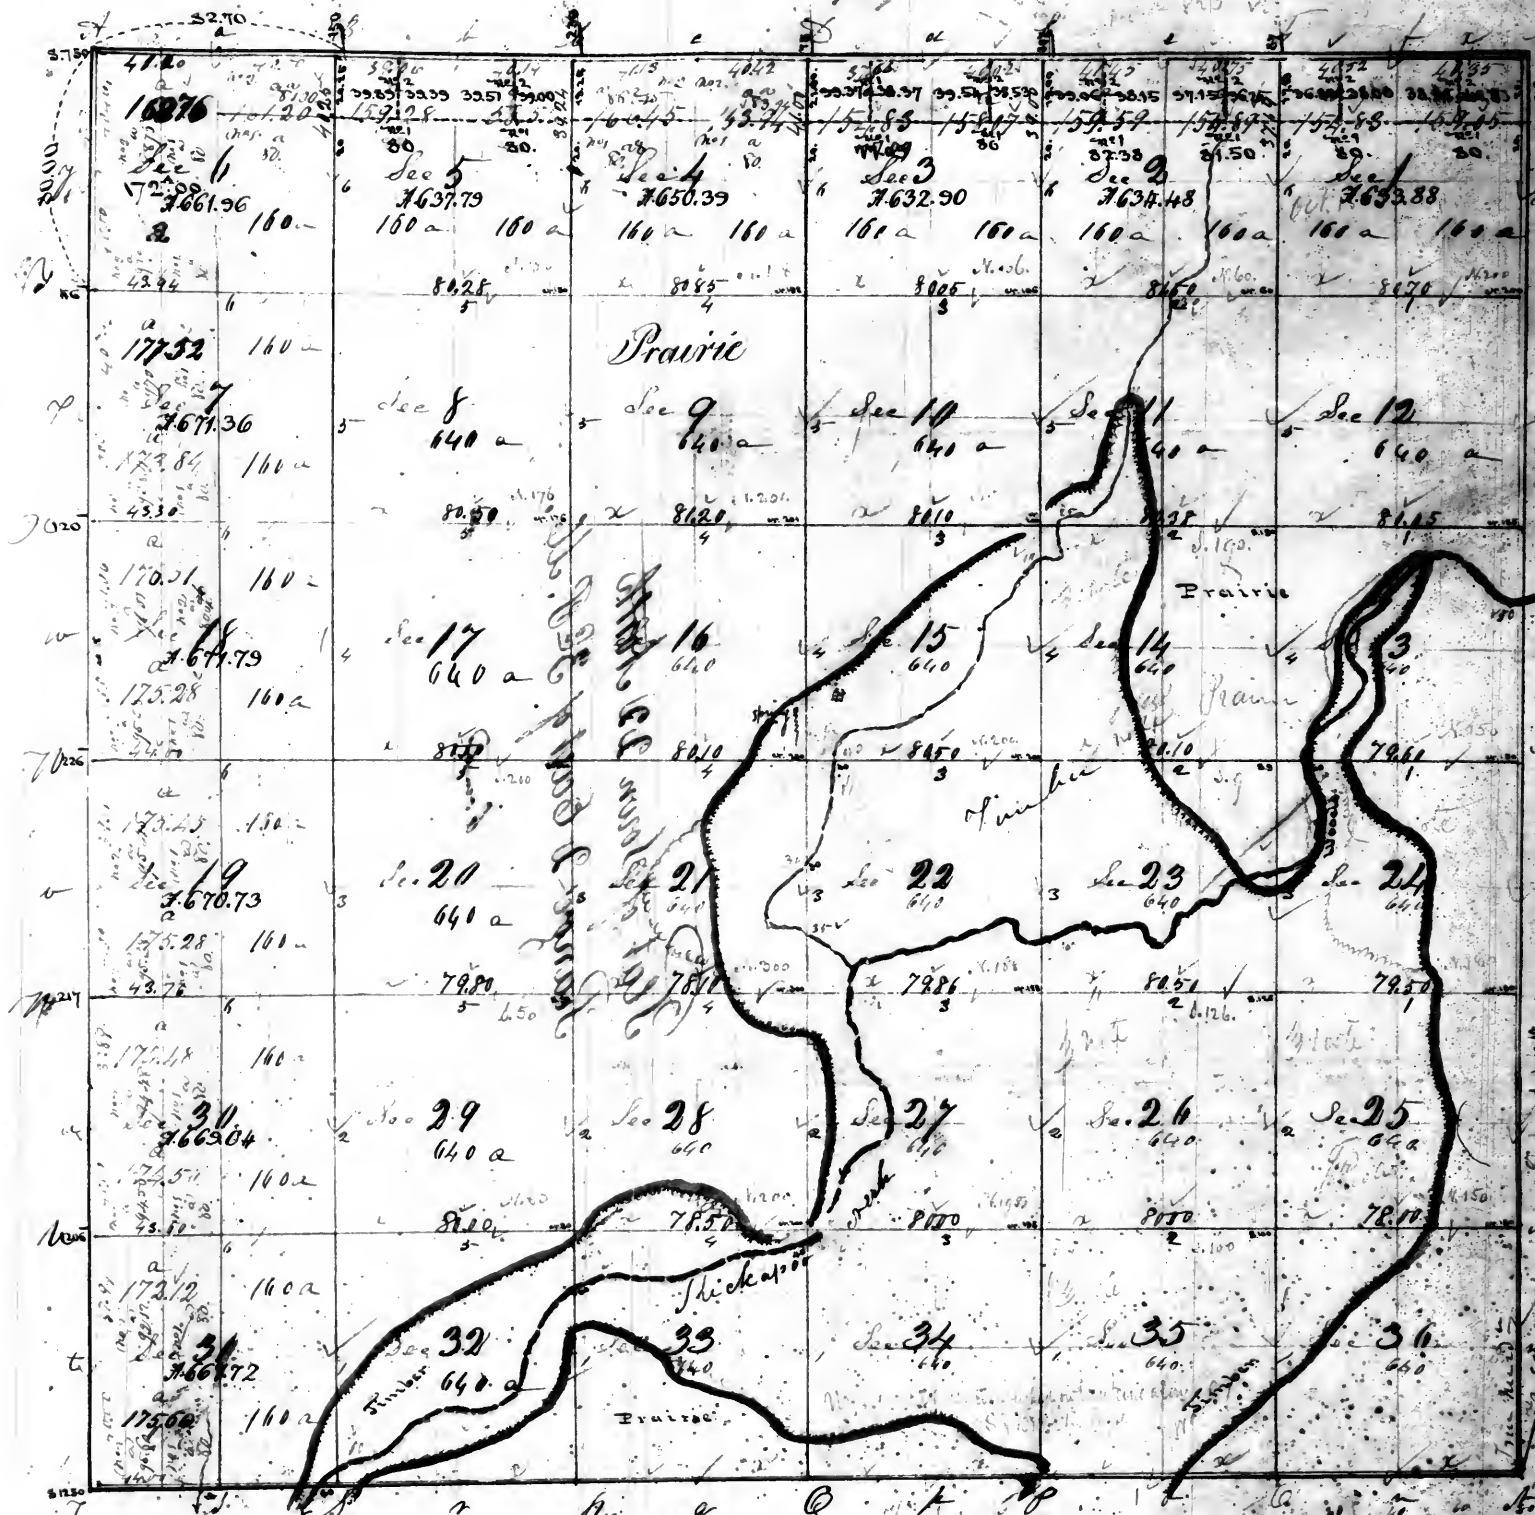


Surveyor's Office
St. Louis Sept 15 - 1846
Sent this day a copy of plat of
the North halves of Sec 12, 23,
& 34 to the Register - and
another copy to the Commission
of the Genl Land Office on the
same day.

Whereas to a contract with and instructions from William B. Rector, Surveyor of the Lands of the United States in the
State of Illinois and Missouri & Territory of Arkansas, bearing date the 29th day of July 1823, I have accordingly taken
out & surveyed the above described Township; and hereby certify that it has such marks and bounds, both natural & artificial
as are represented on said plat, and described in the field notes made thereof & returned into the Office of the Surveyor of the
Lands of the United States for the States of Illinois & Missouri & Territory of Arkansas.
Certified this 3^d day of December 1823.

Surveyor's Office
St. Louis 2^d September 1829 } The above plat of Twp 22 N. R. 2 E. of 3^d M.
is in conformity with the field notes of the Survey just filed in this Office -
Wm. B. Rector }
Sr. of past Secs }

Township No 24 North of the base line, Range No 2 East of the 3^d Principal Meridian.

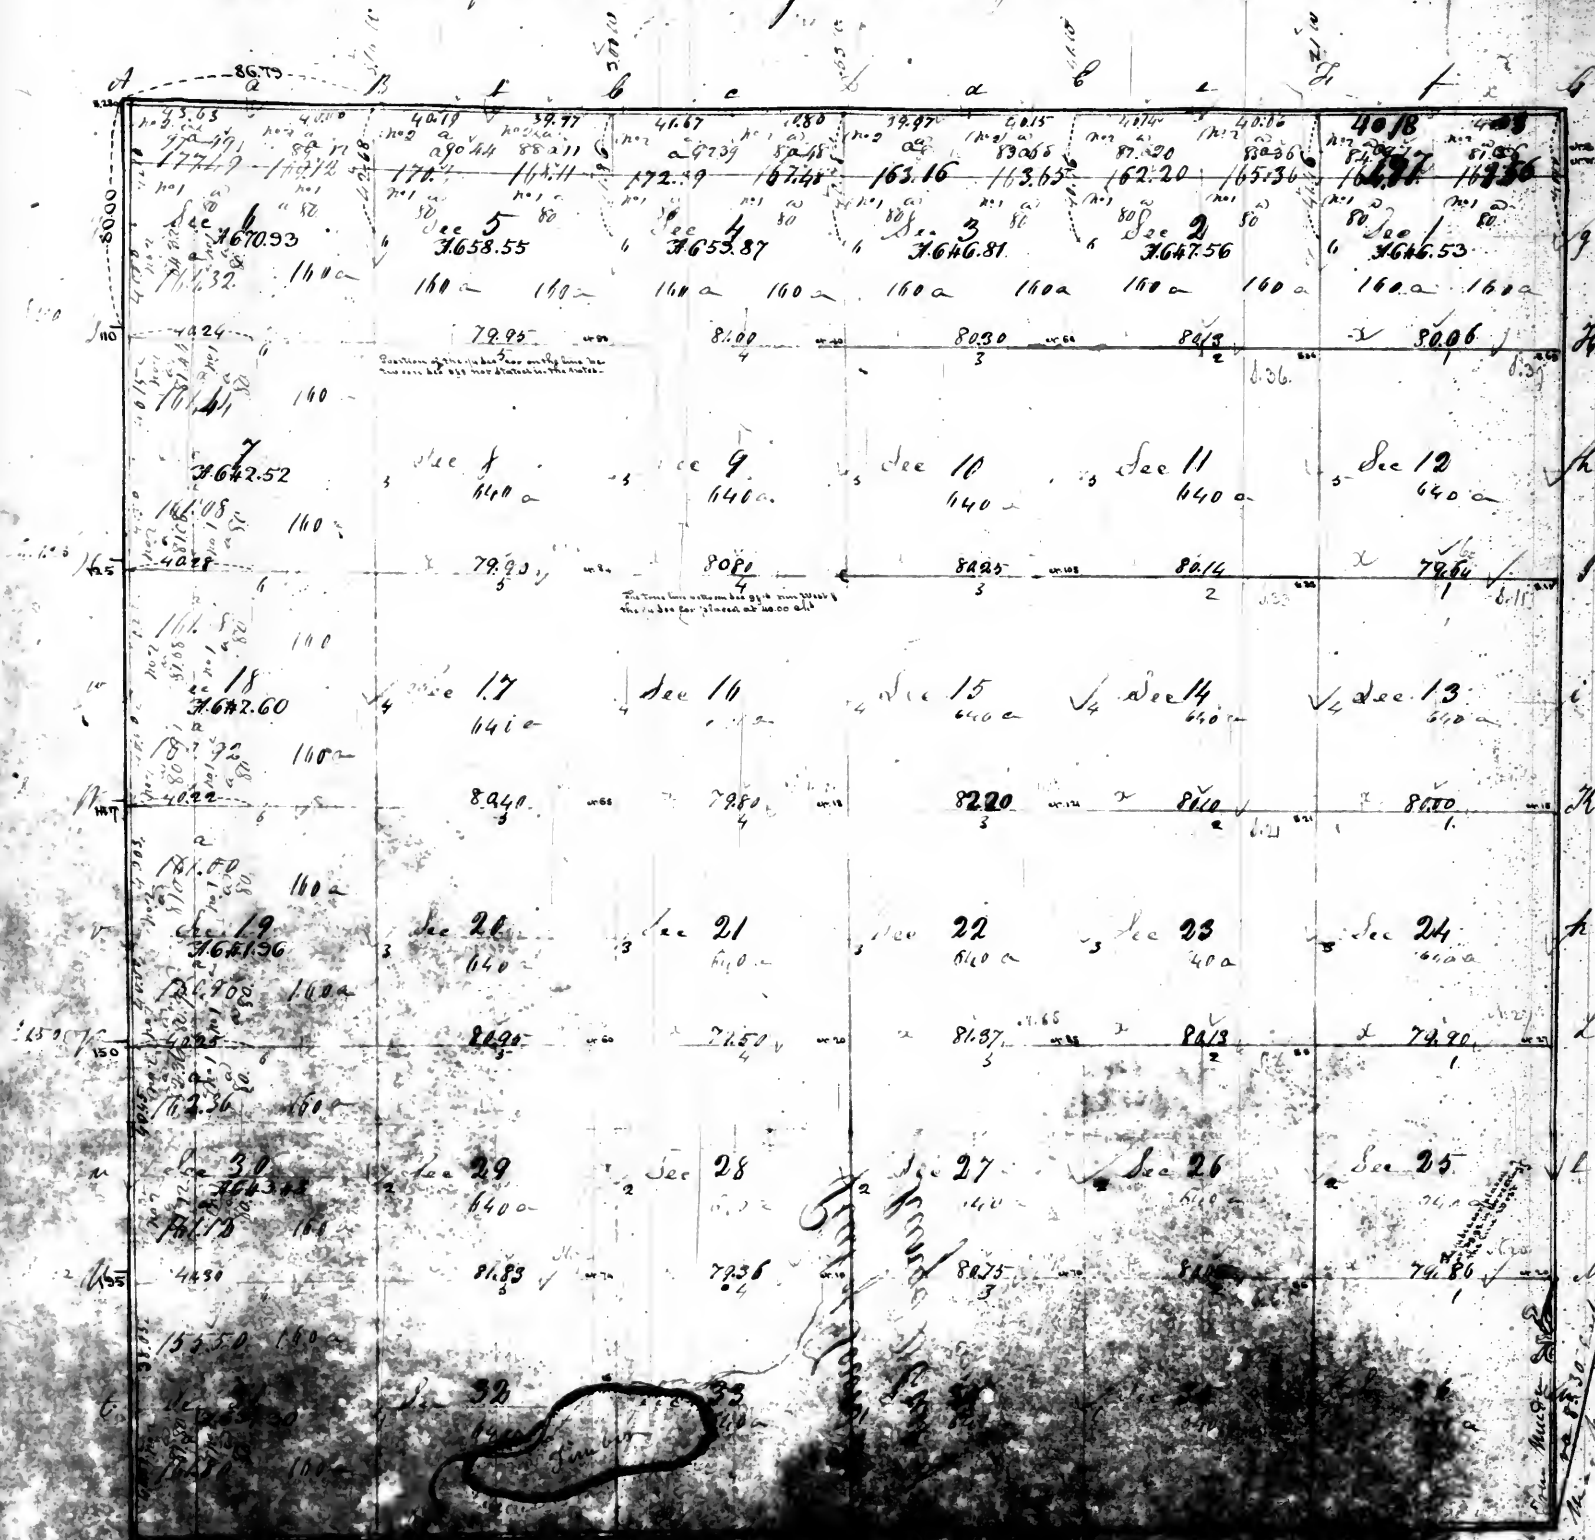





Township No 25 North of the base line, Range No. 2 East of the 3^d Principal Meridian.

Ruudelf

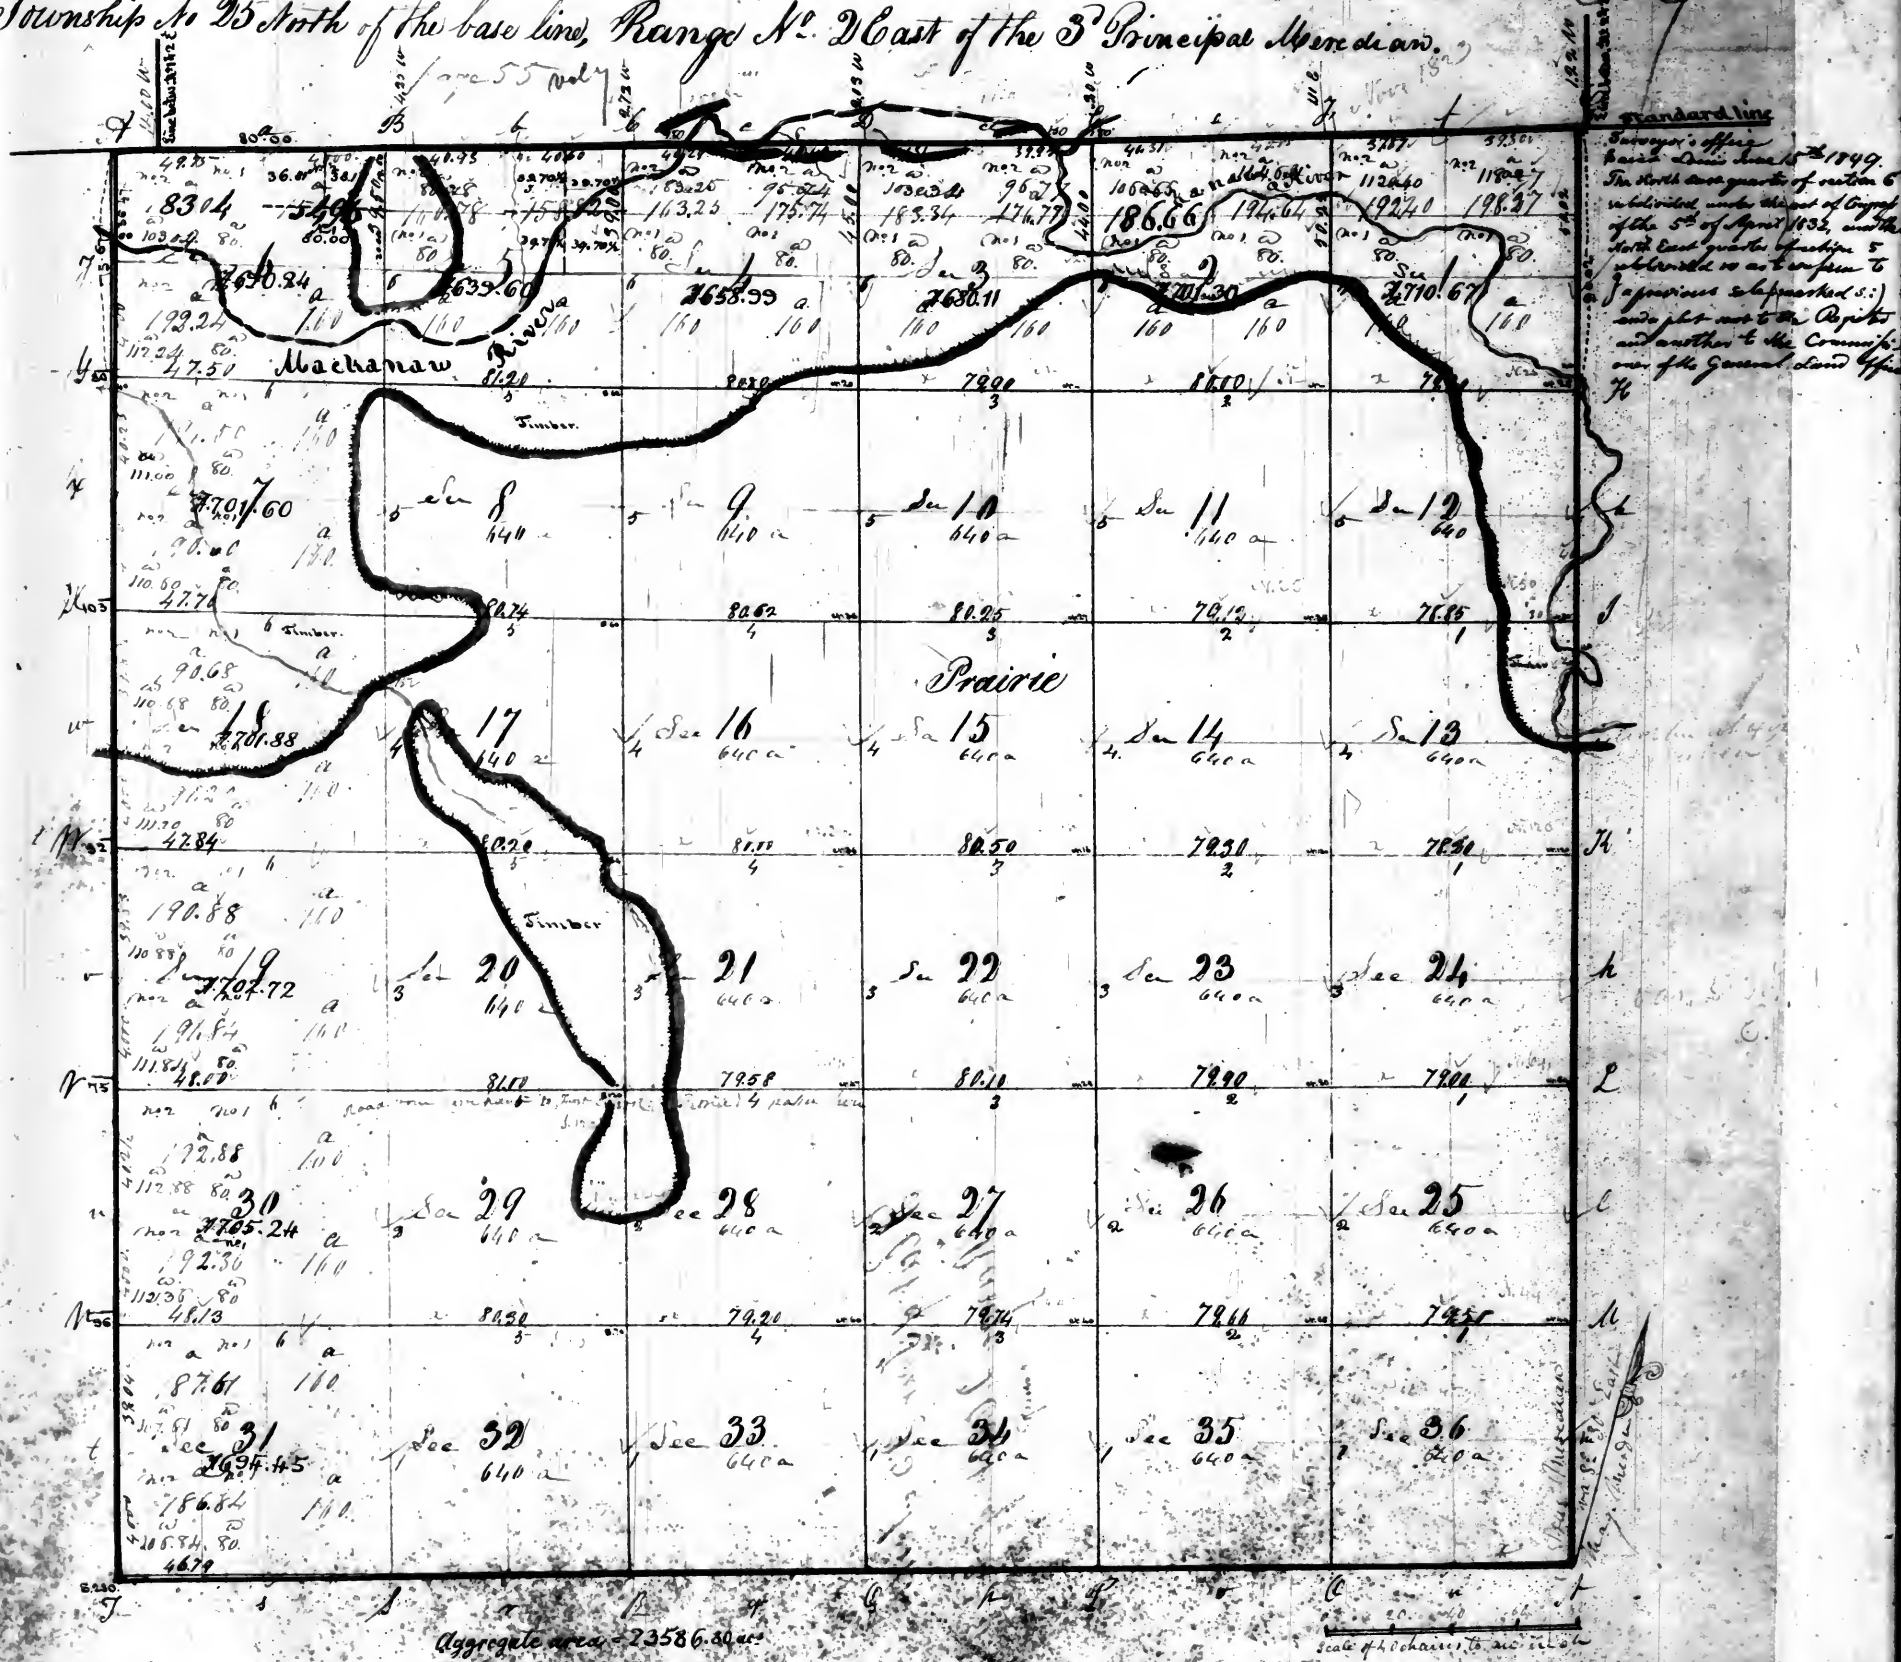

Pursuant to instructions from and a contract with the said Surveyor of the lands of the United States in the
 States of Illinois & Missouri and Territory of Arkansas bearing date the 23rd day of July 1822 I have administered and
 as a Surveyor the above described Township and do hereby certify that it has a clear made & made to be natural & official
 as are upon the same plat and described in the full return made thereof and returned with this plat into the Office of the
 Surveyor of the lands of the United States for the States of Illinois & Missouri and Territory of Arkansas.
 Certified this 23rd day of December 1823.



Survey on Affair }
St. Louis 24 September 1829 } The above plat is conformable to the field notes of the survey of Sep. 18
25. N. R. 2 E. of 3^d Mer. on file in the office.
W. M. Rice

Ph. Hamtramck & Harry Co.

Wm. A. Reed
Sr. & J. B. Reed

Township No. 31 North of the base line, Range No. 2 East of the 3 principal Meridian.

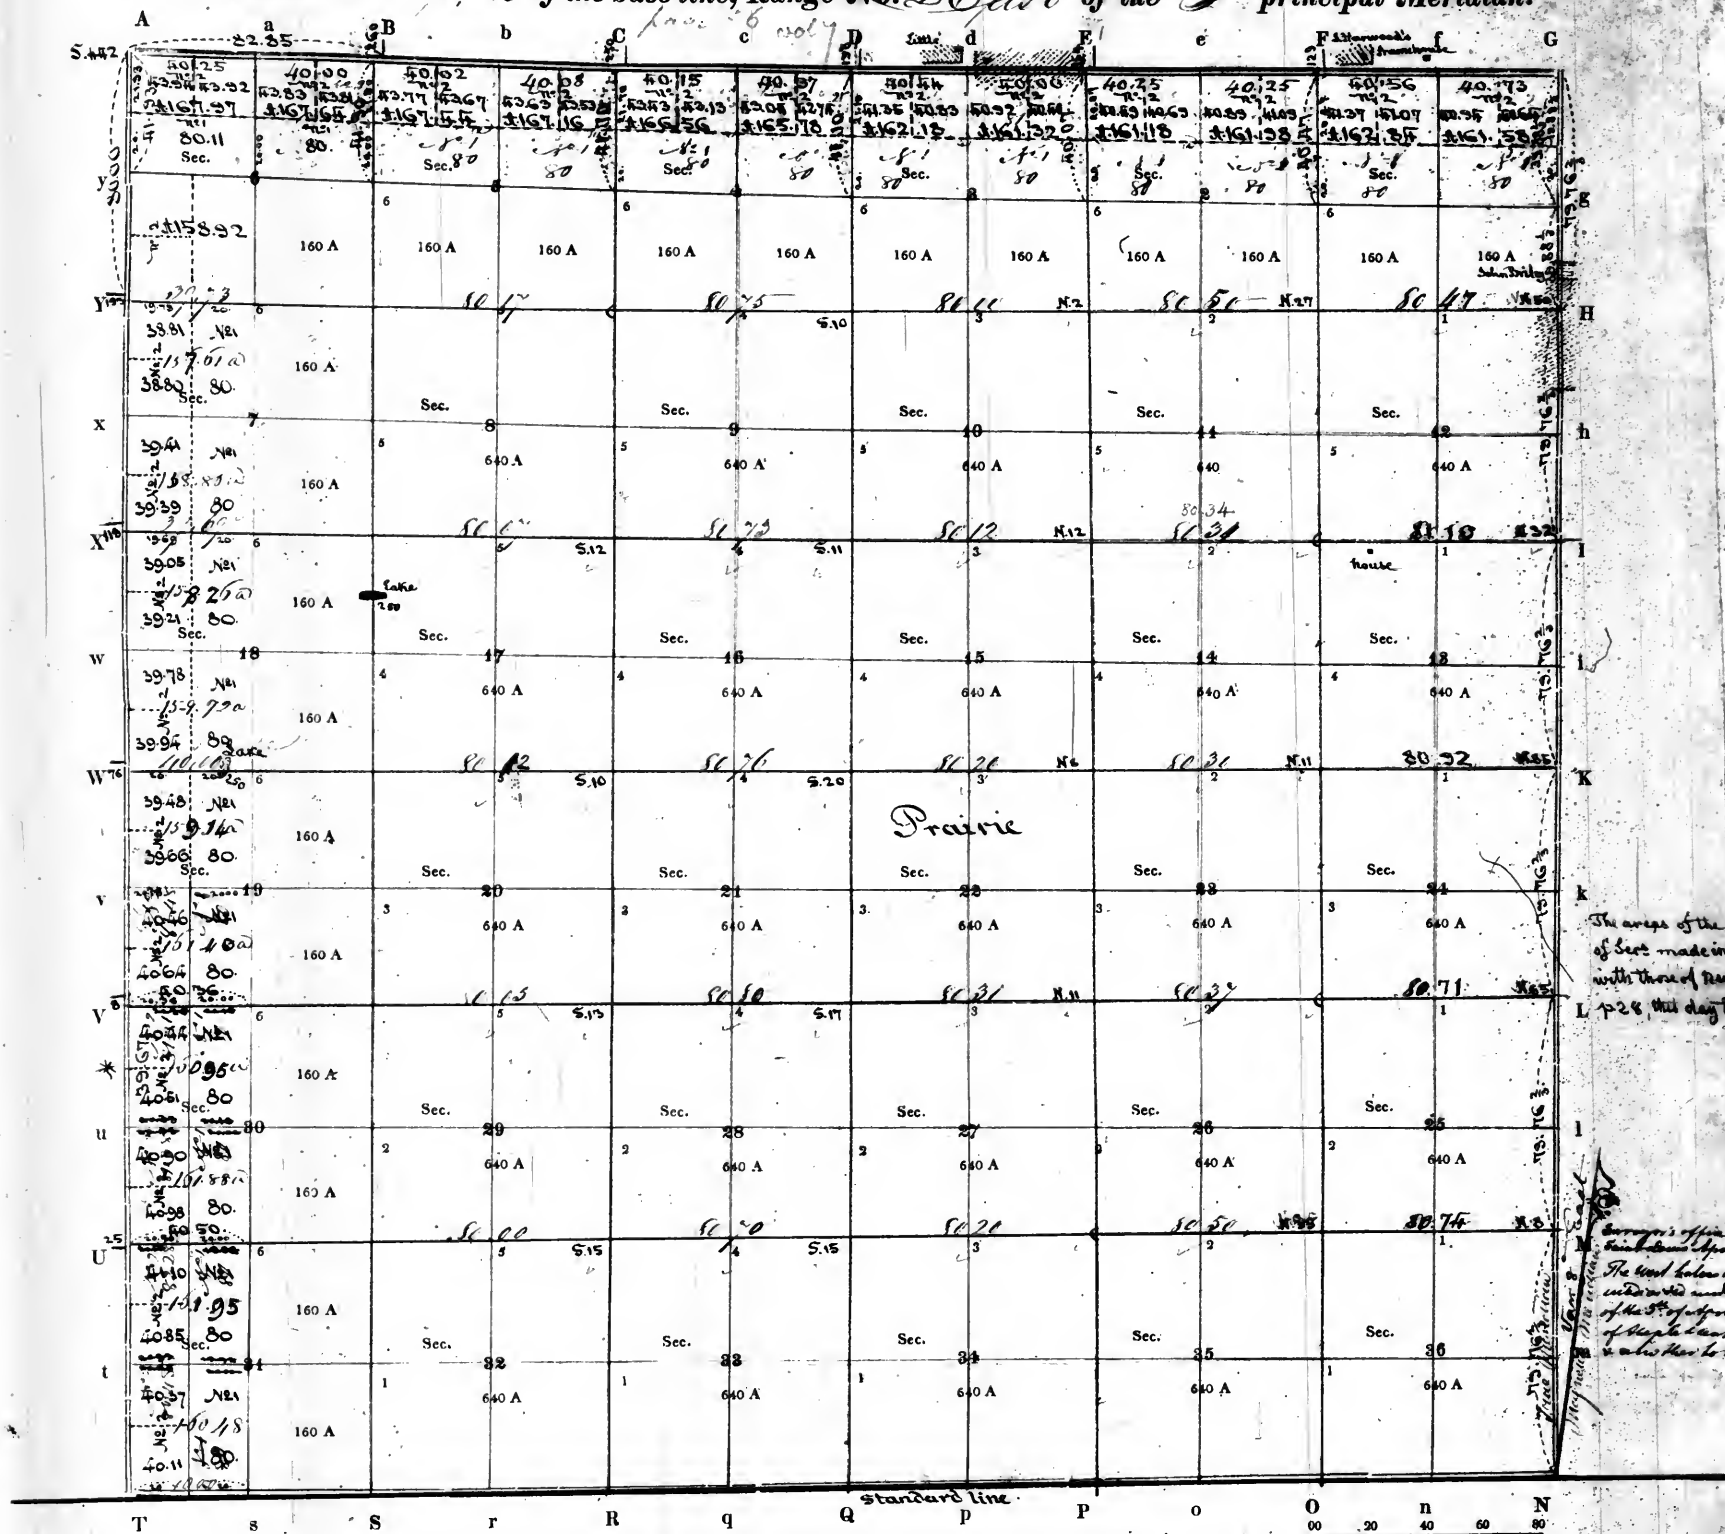

The areas of the northern tier of Secs made in conformity with those of Res. plat in Vol. 25 L p 28 this day the 4th Oct. 1851

Surveyor's Office
St. Louis 1st April 1846
The land below of Secs 1, 2, 1000

PURSUANT to a contract with, and instructions from WILLIAM RECTOR, Surveyor of the lands of the United States in the State of Missouri, bearing date the twentieth day of March 1821

we have admeasured, laid out and surveyed the above described Township; and do hereby certify, that it had such marks and bounds, both natural and artificial, as are represented on said plat, and described in the field notes made thereof, and returned with this plat into the Office of the Surveyor of the lands of the United States, for the State of Missouri.

Certified this day of

D. SURVEYOR.


EXAMINED.

Surveyor's Office. Saint Louis 9th of December. 1841.

The above plat of township 31 North of the base line range 2 East of the 3rd principal meridian is mostly conformable to the field notes of the survey thereof on file in this office which have been examined & approved, except sections 1, 12, 13, 24, 25 & 36, and the north halves of sections 2 & 6, which are omitted because no notes are found of the East boundary of this township, and the South boundary of township 32 R. 2. The South boundary of the West boundary was surveyed in May 1821 by Richard P. Holladay, and the subdivision line was surveyed by S. S. McCallum, all under the contract of Stephen Rector & Thomas Rector of the 20th March 1821.

Surveyor of the public land for the District of Missouri

Township No. *32 North* of the base line, Range No. *2 East* of the *3rd* principal Meridian.

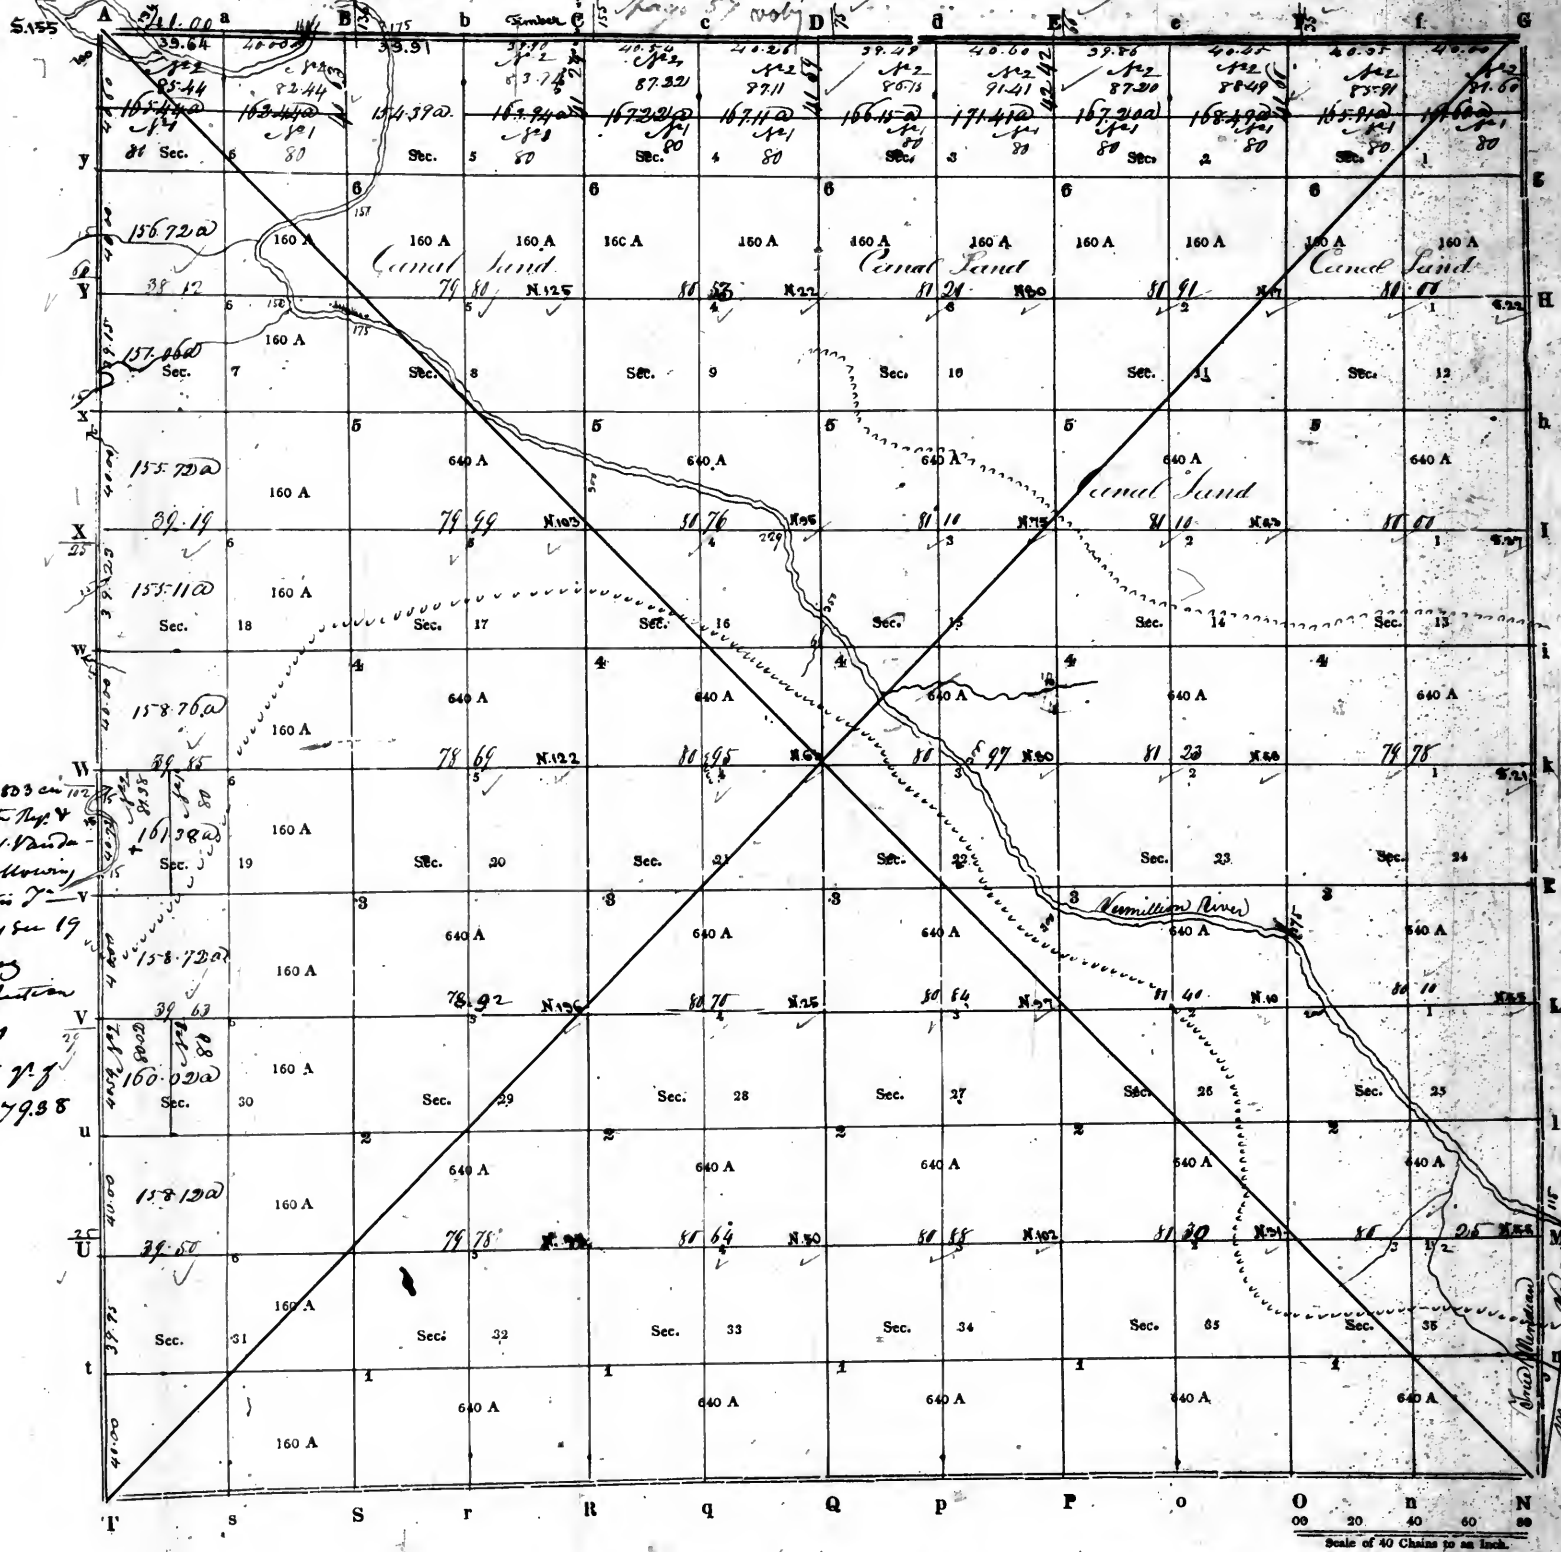

22 Jan 1853
 Report to the Reg. &
 Division of Land
 in the following
 areas of this T.
 161.38 ac
 5 E of Section
 8. 160 ac
 E 1/2 of SW 1/4
 Sect. 18 = 79.38
 ac

PURSUANT to a contract with, and instructions from William Reector, Surveyor of the lands of the United States in the State of Illinois Missouri and Territory of Arkansas bearing date the *twentieth* day of *March* 1851 we have admeasured, laid out and surveyed the above described Township; and do hereby certify, that it had such marks and bounds, both natural and artificial, as are represented on said plat, and described in the field notes made thereof, and returned with this plat into the Office of the Surveyor of the Lands of the United States, in the State of Illinois Missouri and Territory of Arkansas—

Certified this _____ day of _____ 1851

D. SURVEYOR.

EXAMINED.
 Surveyors Office.
 Saint Louis 9th of December 1851.

The above plat of township 32 North of the base line, range 2 East of the 3rd principal Meridian, is mostly conformable to the field notes of the survey thereof on file in this Office which have been examined and approved—except sections 31, 32, 33, 34, 35 & 36, which are omitted, because no notes of the South boundary of the township are found on file. The West boundary 6 miles was surveyed in May 1851, by S. P. McCallum. The North boundary 6 miles and 1 chain, — the East boundary 6 miles — and the subdivision lines were surveyed by George Thomas, in July 1851, all under the contract of Stephen Reector by Thomas Reector of the 20th March 1851.


Surveyor of the public lands
 for the District of Mo.

Surveyors Office, St. Louis 30th of January 1857

This plat of township 32 North, Range 2 East of the 3rd principal Meridian is this day cancelled. — See for the correct plat of said Township the plat approved by the Surveyor General on the 25th of June 1854 and 16th of October 1854, as filed on page 35 of Volume XXX of Illinois plat.

A. R. C. C. C.

Township N. 33 North of the base line Range N. 2 East of the 3rd Principal Meridian
page 58

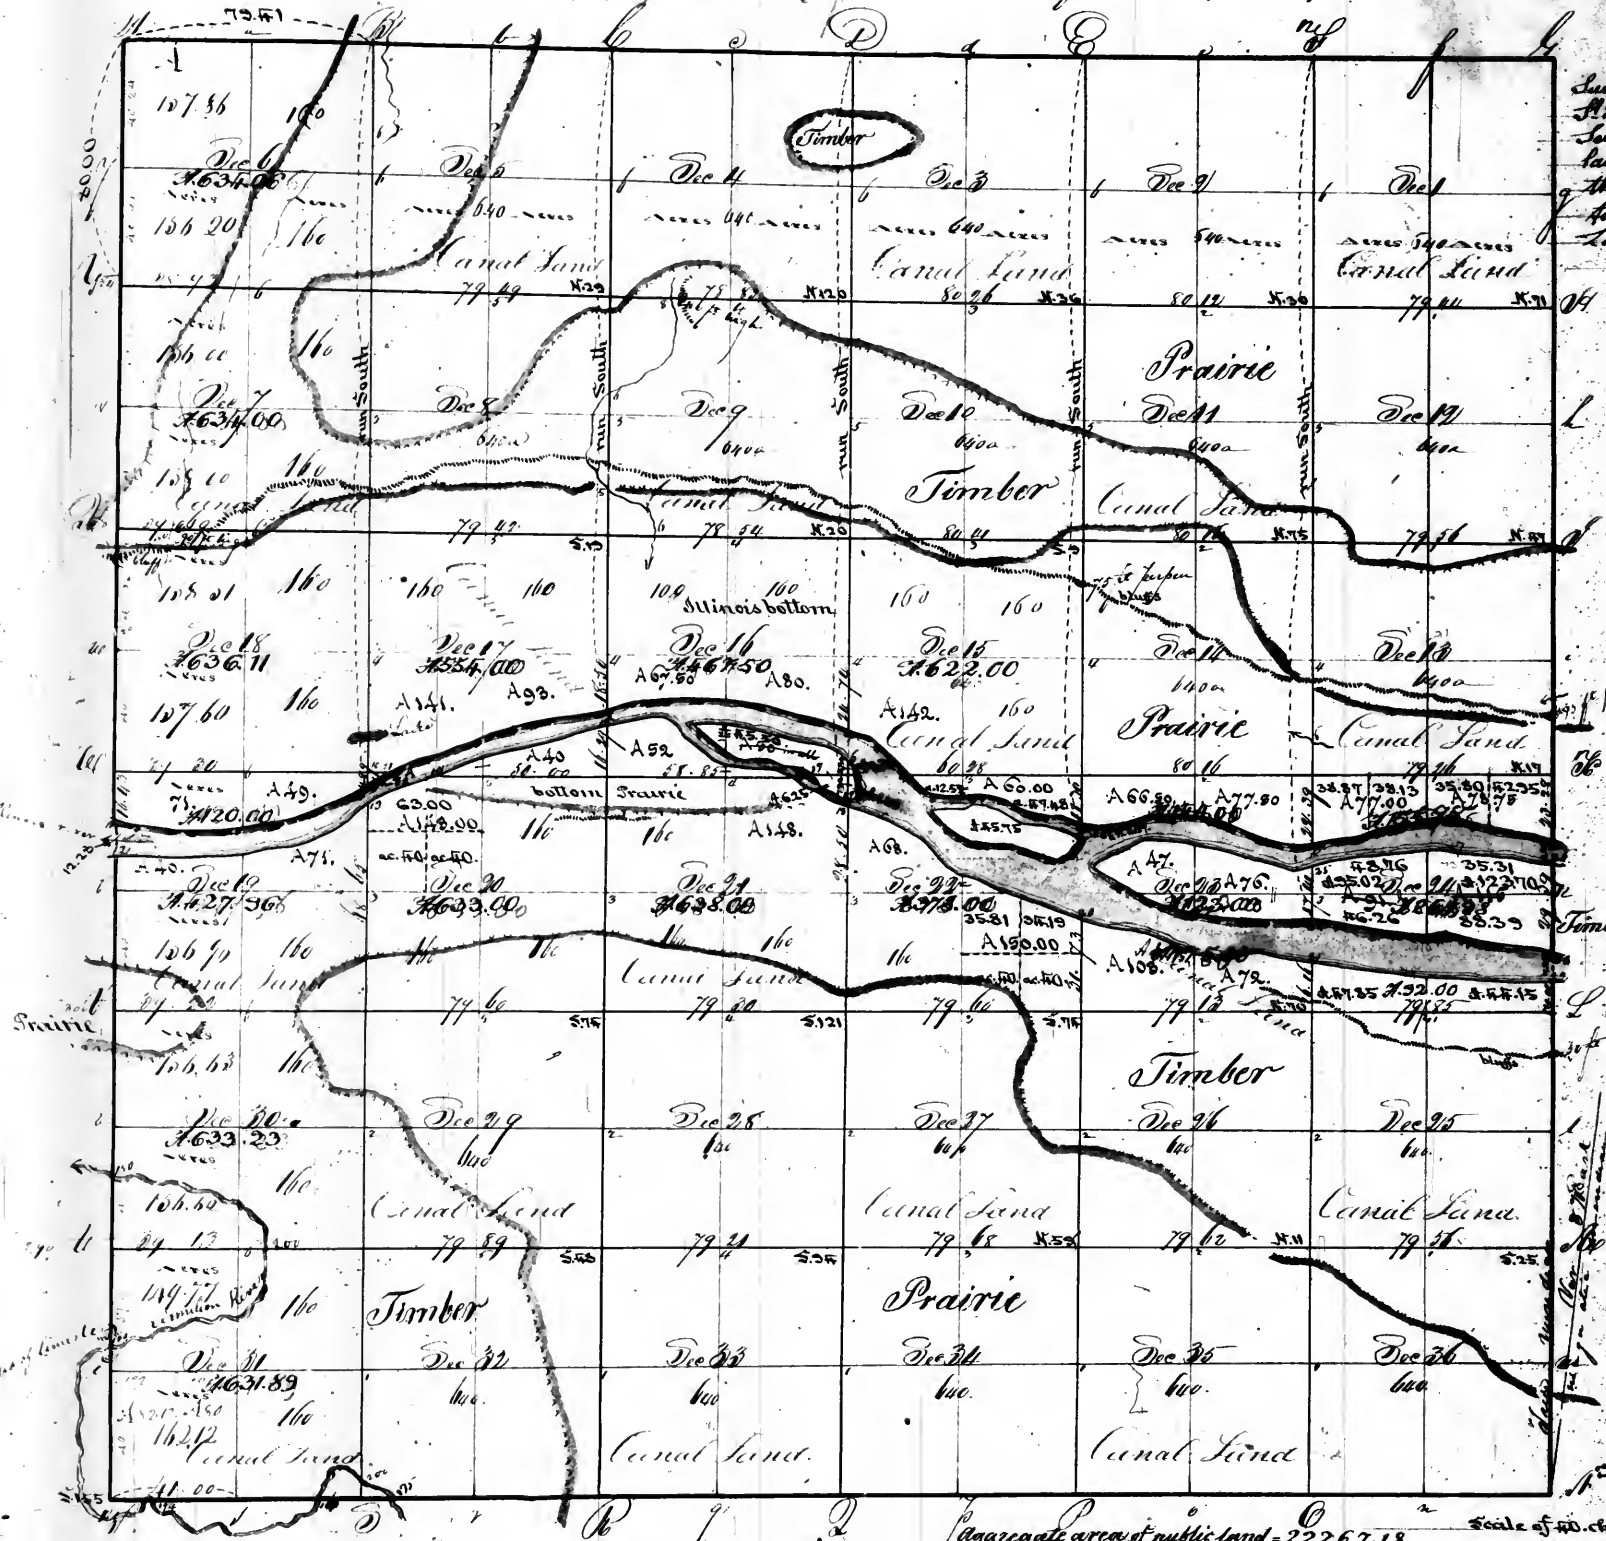


Surveyor's Office
St. Louis
Sent this day a copy of plat of So.
land in the 15. 16. 21 & 22 to
the Register, and another copy
to the Commr of the general
Land Office.


Aggregate area of public land = 22267.18
estimated area of the river = 706.00
Total = 22973.18 acres

Pursuant to a contract with and instructions from William Pector Surveyor of the lands of the United States in the States of Illinois and Territory of Arkansas bearing date the 10th day of March 1822 - We have delineated laid out and surveyed the above described Township and do hereby certify that it had such marks and bounds both natural and artificial as are represented on said plat and described in the field notes made thereof and returned with this plat into the office of the Surveyor of the lands of the United States in the States of Wisconsin & Illinois and Territory of Arkansas Certified this first day of Nov. 1822
Examined
Wm Pector
D. Surveyor


Township No. 34 North of the base line, Range No. 10 East of the principal Meridian.

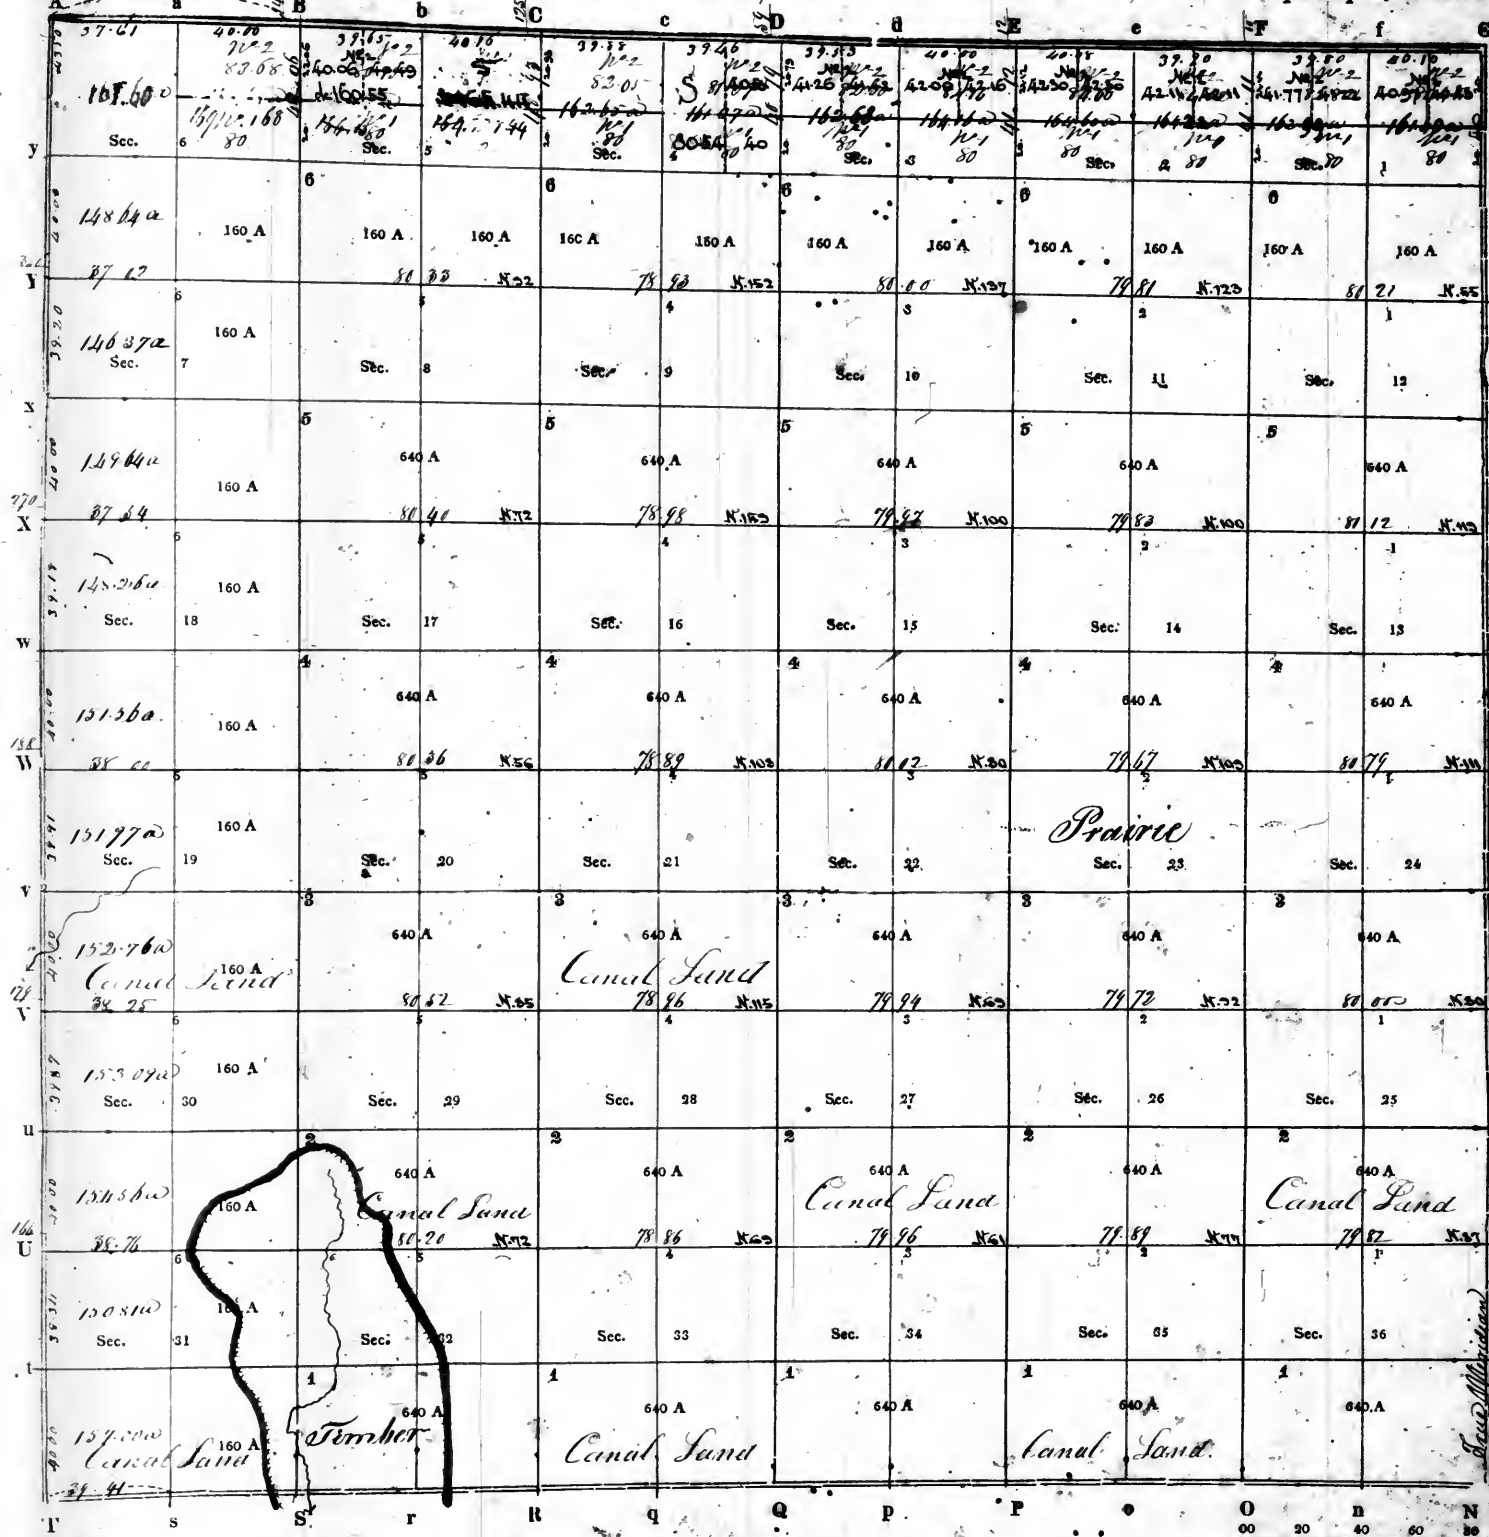

PURSUANT to a contract with, and instructions from William Rector, Surveyor of the lands of the United States in the State of Illinois, bearing date the 10th day of March 1881, we have admeasured, laid out and surveyed the above described Township; and do hereby certify, that it had such marks and bounds, both natural and artificial, as are represented on said plat, and described in the field notes made thereof, and returned with this plat into the Office of the Surveyor of the Lands of the United States, in the State of Illinois.

Certified this day of 1881 EXAMINED.

D. SURVEYOR.

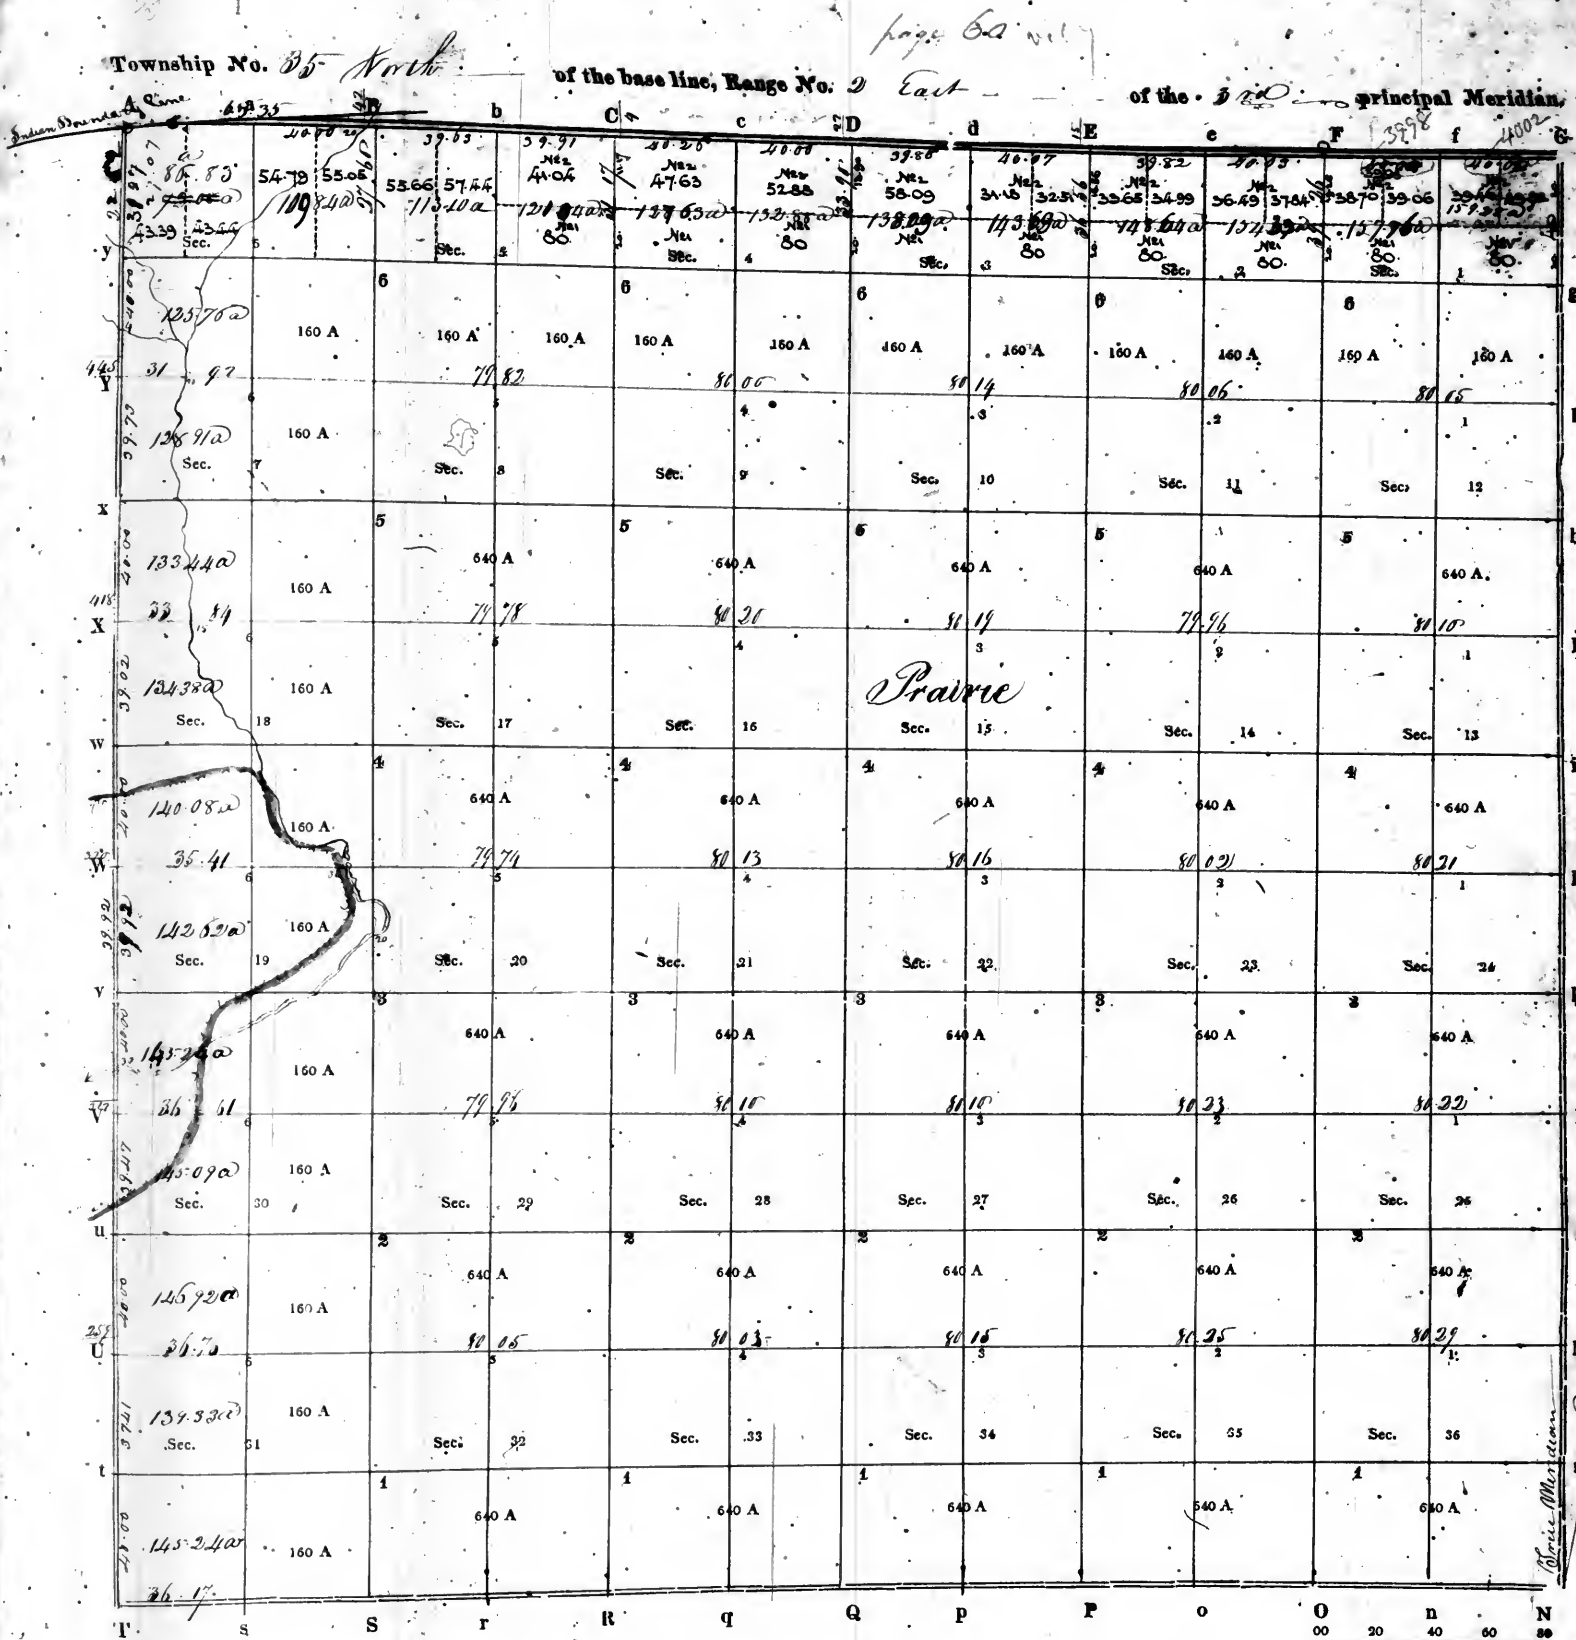

PURSUANT to a contract with, and instructions from William Rector, Surveyor of the lands of the United States in the State of Illinois, Missour and Territory of Arkansas, bearing date the twentieth day of March 1821, we have admeasured, laid out and surveyed the above described Township; and do hereby certify, that it had such marks and bounds, both natural and artificial, as are represented on said plat, and described in the field notes made thereof, and returned with this plat into the Office of the Surveyor of the Lands of the United States, in the State of Illinois, Missouri and Territory of Arkansas.

Certified this fourth day of November 1822.


EXAMINED.

D. SURVEYOR.

Surveyor's Office
 St. Louis, Mo. April 2^d 1846
 Sent to the Register
 a copy of the plat of Sects 1, 2, 3, 4, 5,
 & 6, laid out to the Commission

Robert Mendenhall

Tract Township N. 36 North of the Base line Range N. 2 East of 3rd Principal Meridian

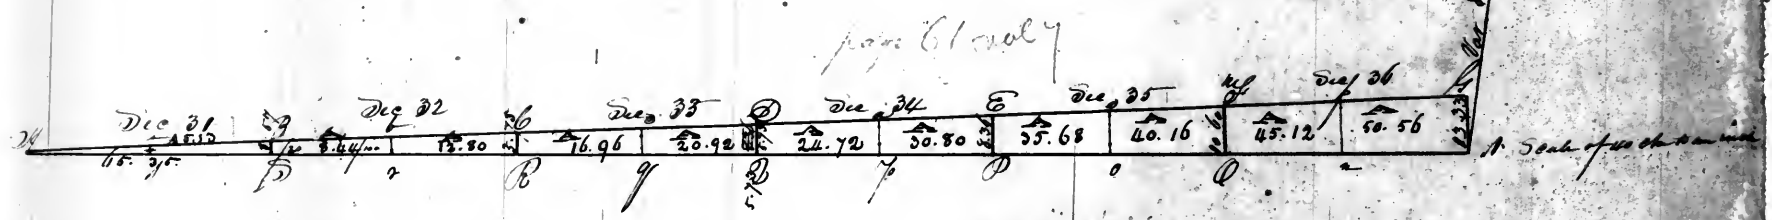

In pursuance to a contract with and instructions from William Rector surveyor of the lands of the United States in the States of Missouri and Illinois and Territory of Arkansas bearing date the twenty-first day of March 1822 We have admeasured laid out and surveyed the above described Tract Township and do hereby Certify that it had such marks and bounds both natural and artificial as are represented on said plat and described in the field notes made thereon and returned with this plat into the office of the Surveyor of the lands of the United States in the States of Missouri and Illinois and Territory of Arkansas
Witness our hand this first day of Nov 1822

Examined

The C. Rector D. Surveyor
Stephen Rector

VOL. 10


Township 1. N. North of the Base line Range 1. E. East of the 3^d principal Meridian

Note There are no field notes of the South bounds of this Township on file in this office

Surveyor's office
St. Louis Mo. July 11th 1853
The S.W. 1/4 of Sec. 7 and
the S.W. 1/4 of Sec. 18 of Twp. 1. N. R. 1. E. of the 3^d principal Meridian
were on the 10th day of April 1851
of the 1st M. of S. of the
31 Sections as to the
Note previous sales (made
and a plat sent to the
and another to the Comm.
of General Land Office

Surveyor's office
St. Louis Mo.
The North halves of sections
the South West quarter
sections 6, 7, and the
West quarter of section 11
were under the act of
April 1851
the North halves of sections
3, 5, 6, the North west
1/4 of section 7, and
South West quarter of
11, 30, 31 subdivided
conform to previous
marked 5, and
sent to the Reg. and
another to the
Comm. of the General
Office

Surveyor's office
St. Louis Mo. Sept 15th
The North halves of
1, 2 and the S.W. 1/4 of
6 subdivided under the
act of Congress of
April 1852. The
North halves of Sec.
3, 5, 6 subdivided so
conform to previous
marked 5, and a
plat sent to the Reg. and
to the Commission or
General Land Office.

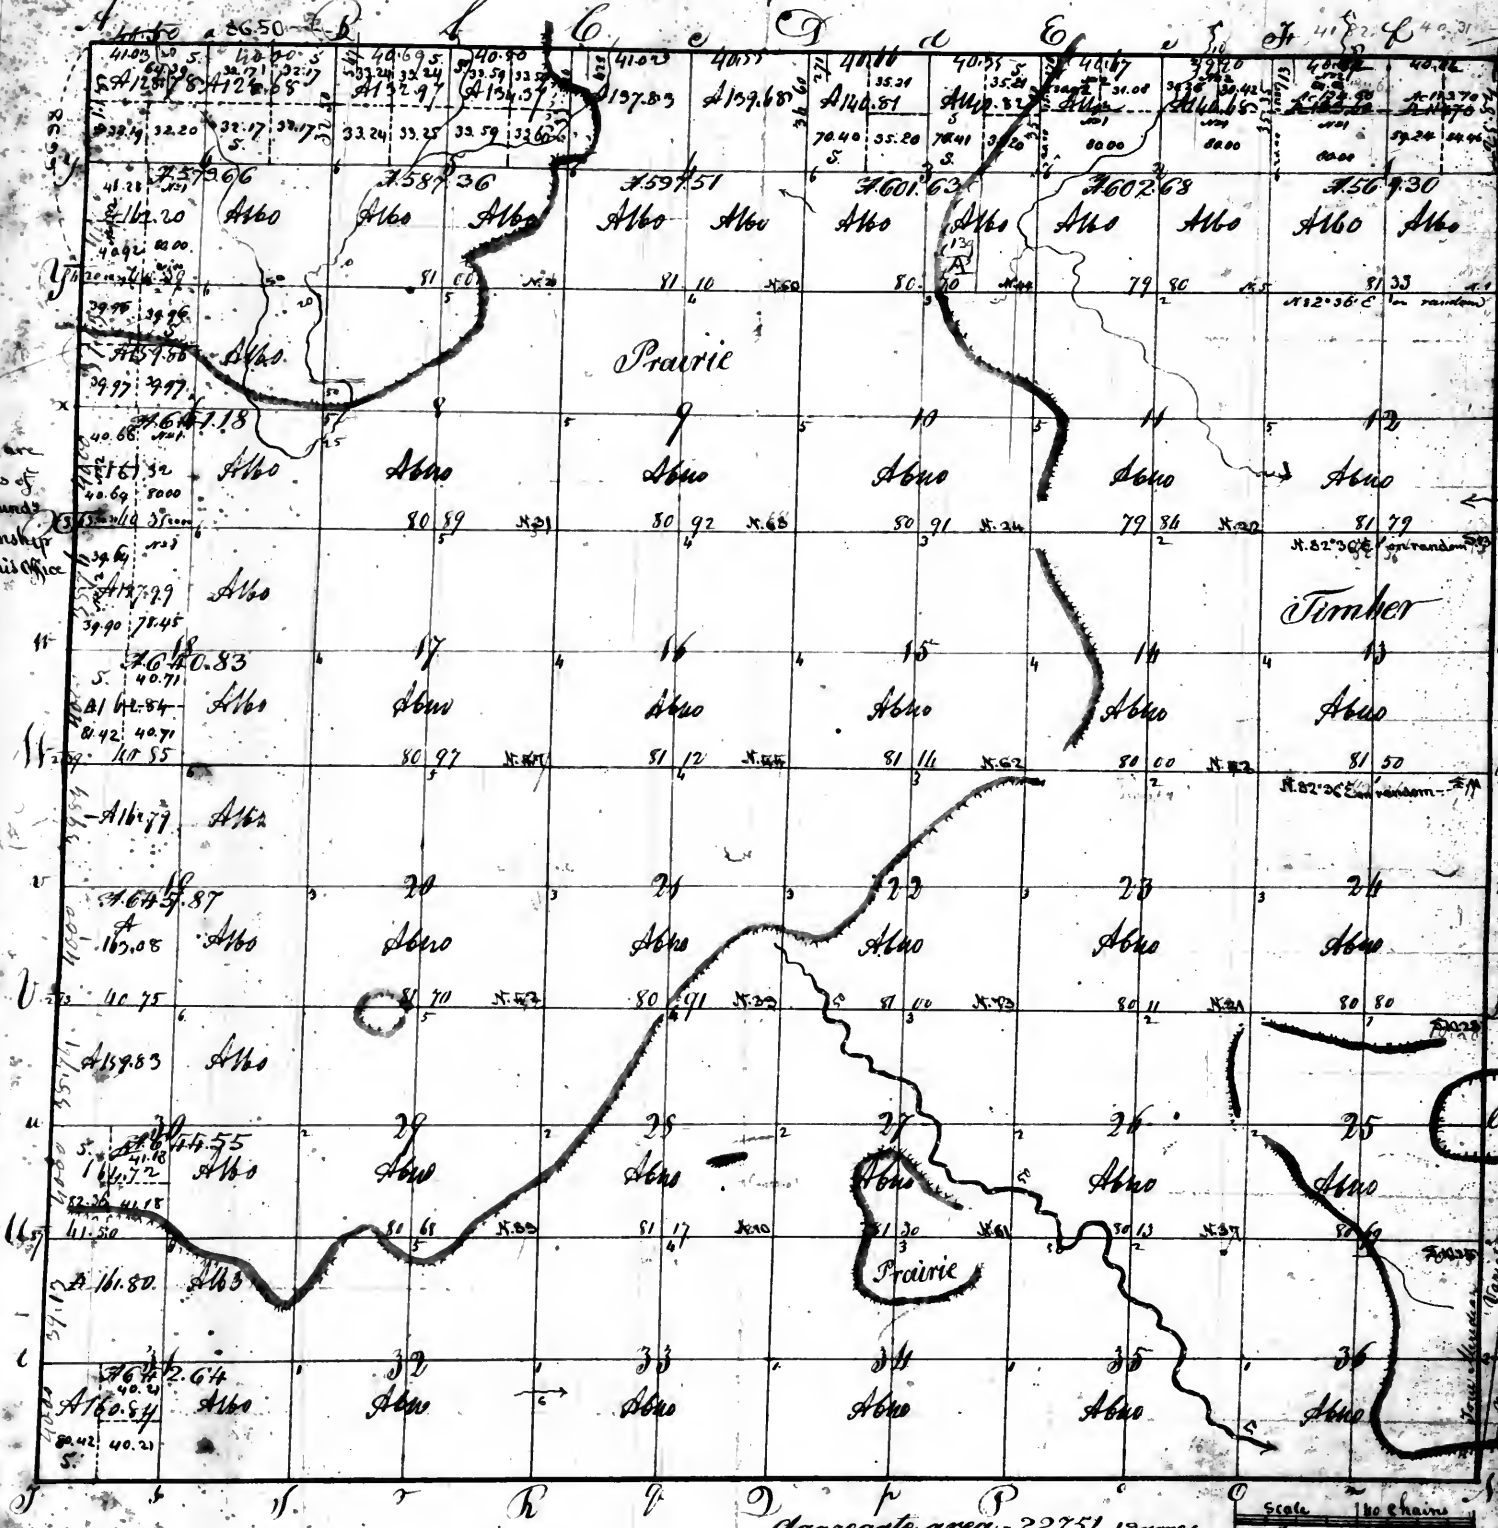

Aggregate area = 22751.13 acres

Scale 1 inch = 3600 feet

Pursuant to a contract with and instructions from William Reiter Surveyor of the Lands of the United States in the Territories of Illinois and Missouri bearing date the 19th day of Oct. 1851 I have examined, laid out and surveyed the above described Township of land and do hereby certify that it had such marks and bounds both natural and artificial as are here set out on said plat and described in the Field notes made thereof and returned with this plat into the office of the Surveyor of the Lands in the United States for the Territories of Illinois and Missouri

Certified this 19th day of April 1853


Wm. Reiter

Reconquered

Township N 2 North of the Base line in Range R 3 East of the 3rd principal meridian

405

4024 page 2 vol 8

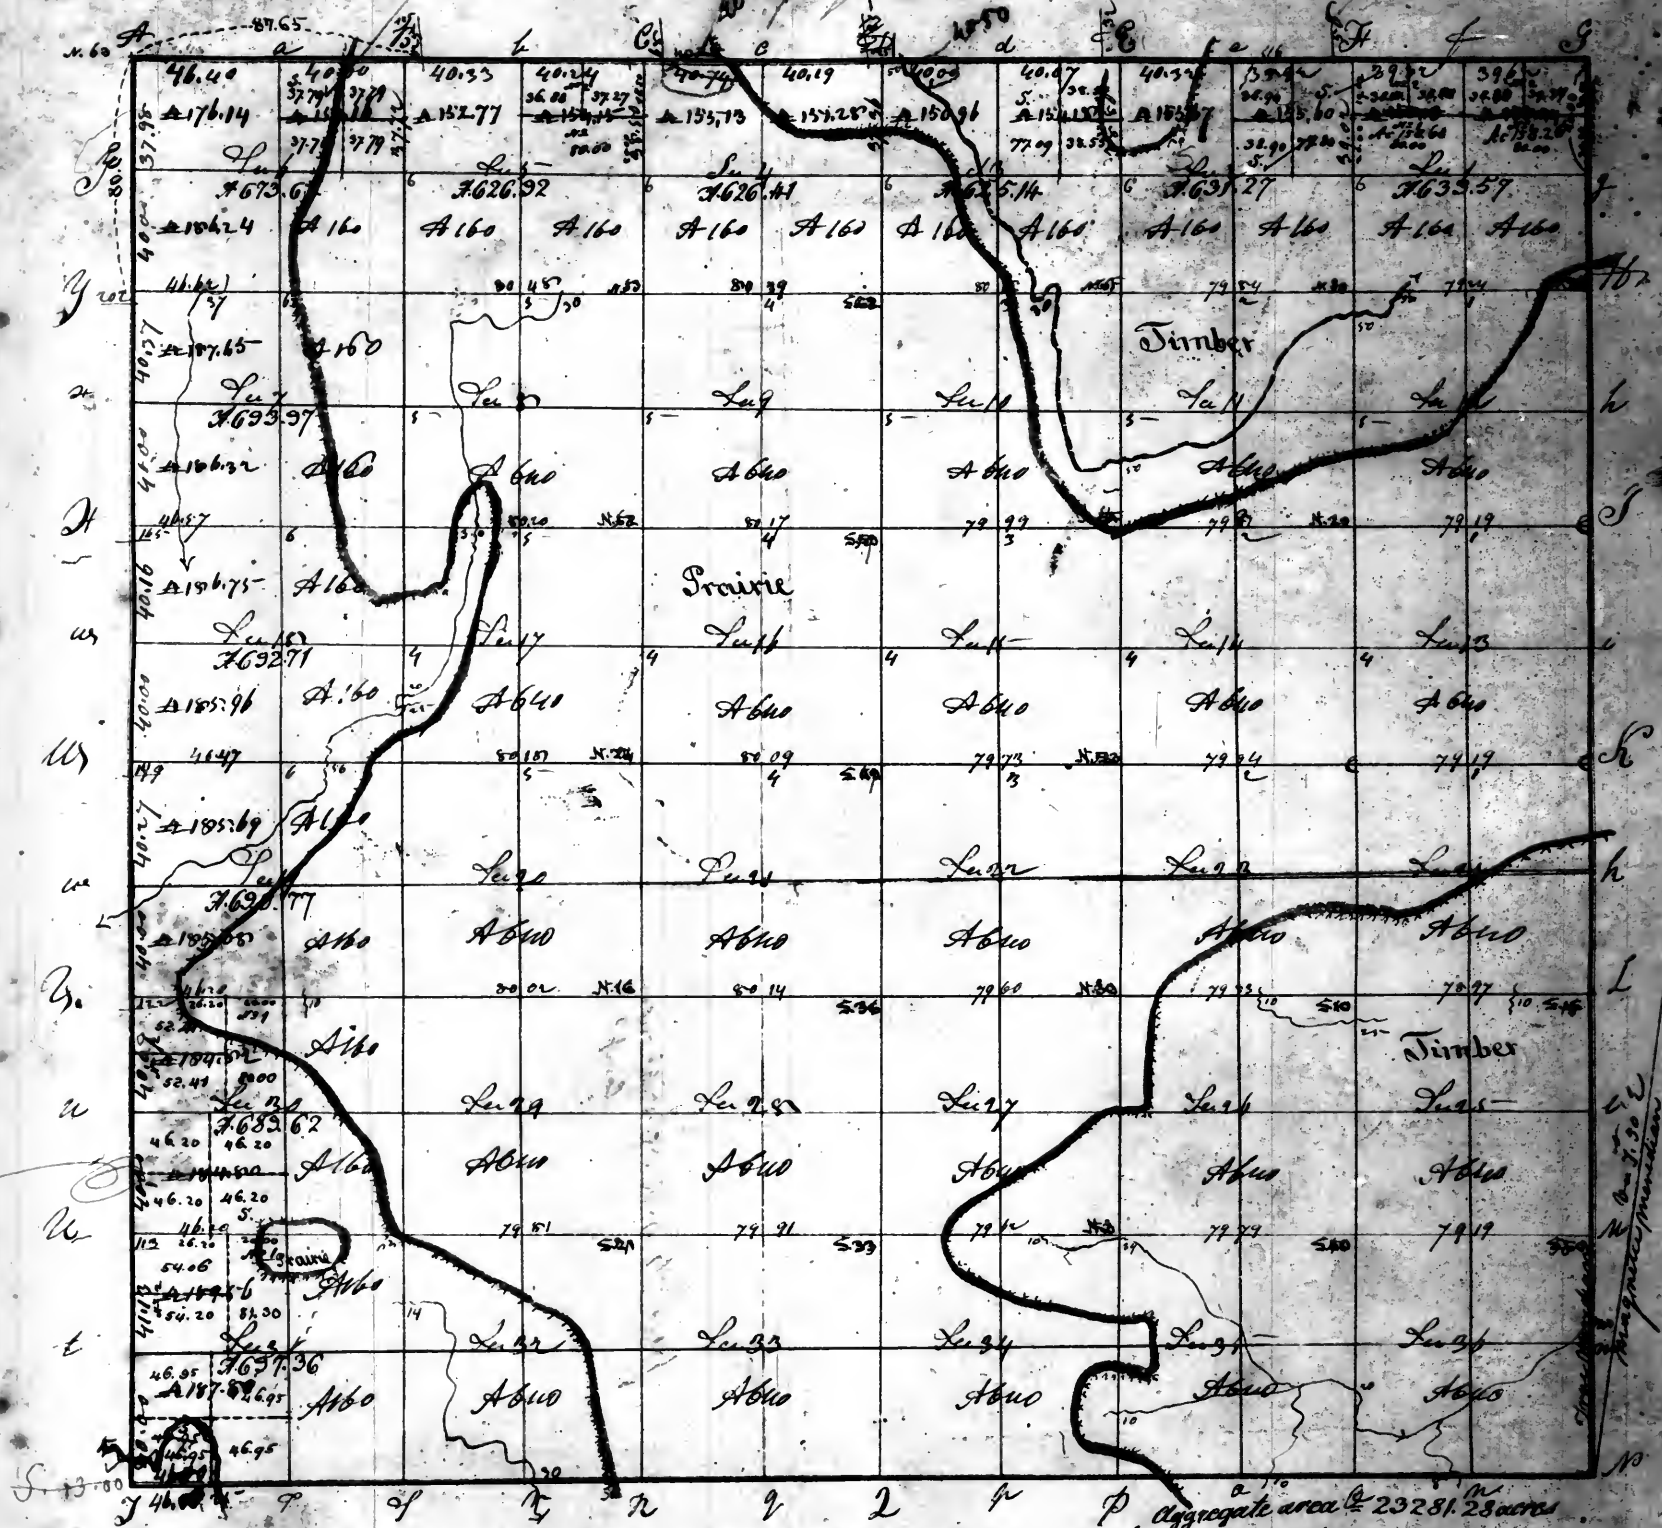

Aggregate area $\frac{1}{2}$ 23281.28 acres

Pursuant to a contract with and instructions from William Weston Surveyor of the Lands of the United States in the Territories of Illinois and Missouri bearing date the 29 day of Oct. AD 1818 I have admeasured laid out and Surveyed the above Township of Land and do hereby certify that it had such marks and bounds both natural and artificial as are represented on said plat and dencribed in the field notes made thereof and returned with this plat into the office of the Surveyor of the lands of the United States in the Territories of Illinois and Missouri

Certified this 19th day of April 1879


Swenson Office St Louis July 11th 1857
The St. M. quarter of sections 30 & 31 in T. 2 N. R. 2 E.
of the 3rd S. M. subdivided under the act of Congress
of the 5th of April 1832 and also of the S. M. part
of said sections subdivided so as to conform to
various spcs. (marked S.) and a plat sent
to the Registry and another to the Commissioner
of the Land and Office.

Surveyor's Office

The North half of section 1, the North East quarter of section 5,
the North East quarter of section 22 and subdivided into
The North East quarter of sections 2, 3, 4, 6, and the
South west quarter of sections 22 and 23 subdivided so as to
uniform & provide sales from 1st St. and a plat sent to the
Register and another to the Commissioners of the General Land
Office

3

406

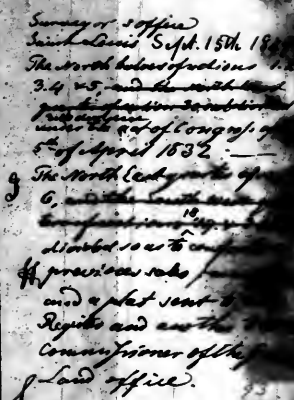

J. Swanyour office
 St. Louis, Mo. 1890
 The N. M. of the 30th
 L. 3, N. R. 3, E. of the S.
 Principal Meridian
 Subdivided under the act
 of Congress of the 5th of
 April 1852 - and the
 15th Sept. 1862 Subdivided
 so as to conform to the
 sales (Mackay) and
 the present and
 sent to the Register
 another to the Comptroller
 of the General Land

Magnetic Meridian. Vase

pursuant to a contract with and instructions from William Weston Surveyor of the lands of the United States in the Territory of Illinois and Missouri Bearing date the 29th day of Oct^r 1868 I have admeasured laid out and surveyed the above described Township of land and do hereby certify that it had such Marks and bounds both natural and artificial as are represented on said plat and described in the Field note made thereof and returned with this Plat into the office of the Survey of the lands of the United States in the Territories of Illinois and Missouri

certified this 19th day of April 1869


certified this 19th day of April 1889

Whorton Ketchum

Rustad

Township No. 41 N. of the Base line in Range No. 3 E. of the 3^d Principal meridian

407.

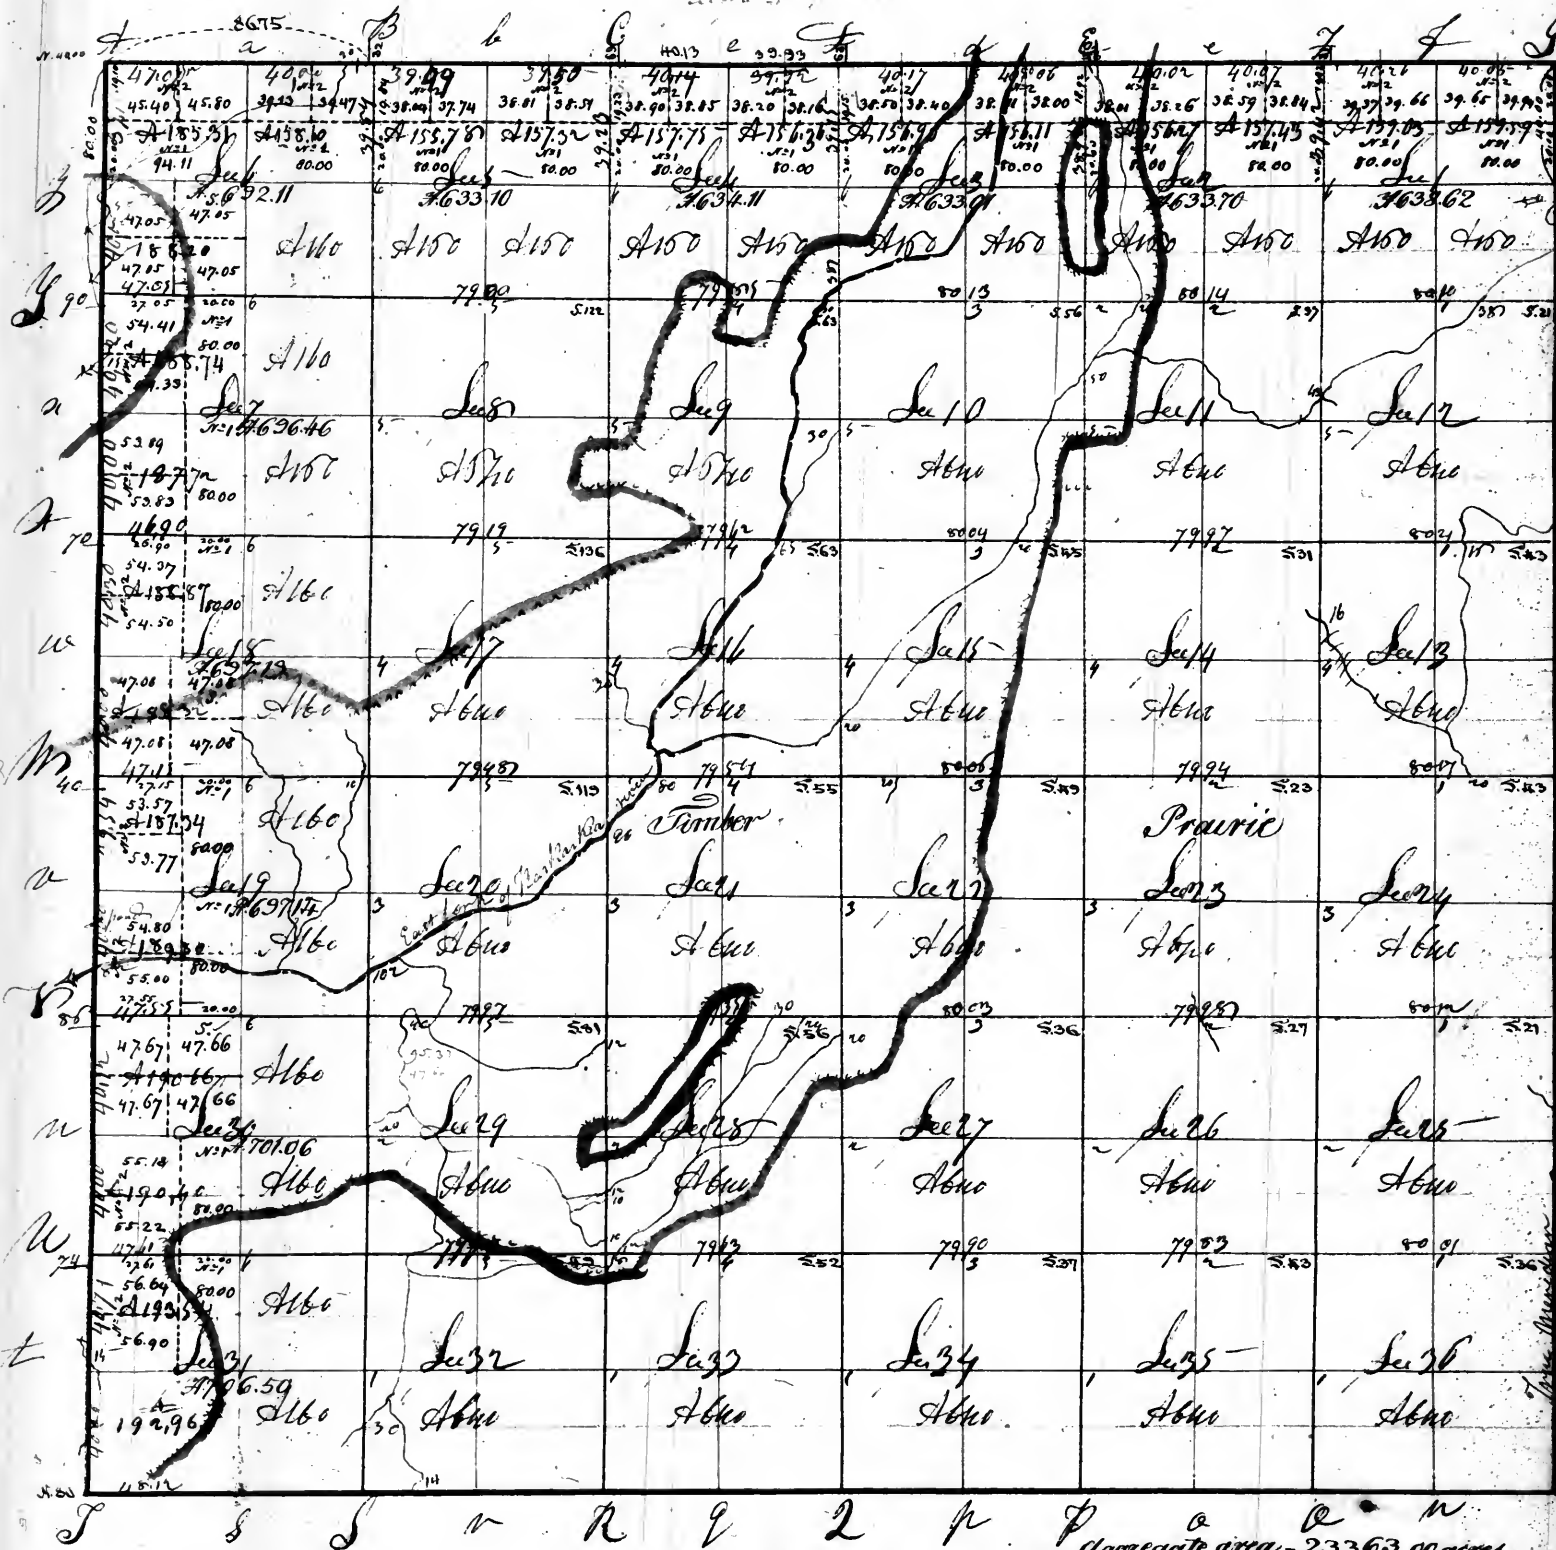

Surveyor's Office
Saint Louis Sept. 15th 1849
The North halves of sections 1, 2, 3, 4, 5 & 6, - the West halves of sections 7 & 10, - the North west quarter of sections 18 & 31, and the South west quarter of each, are subdivided under the act of Congress of the 5th of March 1832, - the balance of each quarter of each of the North west quarter section 30 subdivided conform to previous application of 3 ft. - and a plan of the same sent to the Agents and clerks to the Commissioners of the General office.

Note From the field notes, the South bound of T. 41 N. 3 E. of the 3^d P. M. appears to have been run West on a line and the falling is 40.00 ch. North of the Township corner. In comparing the subdivision of T. 41 N. 3 E. and the falling of the South bound of T. 41 N. 3 E. of the 3^d P. M. it is found that the falling of the South of T. 41 N. 3 E. is 40.00 ch. stated as 40.00 ch. North is used in constructing this map.

Pursuant to a contract with and instructions from William Weston Surveyor of the Lands of the United States in the Territories of Illinois and Missouri bearing date the 29th day of Oct. A.D. 1848, I have all measured laid out and surveyed the above Township of land and do hereby certify that it had such marks and bounds both natural and artificial as are represented on said plat and described in the field notes made thereof and returned with this plat into the office of the Surveyor of the Lands of the United States in the Territories of Illinois and Missouri.

certified this 19th day of April 1849
William Weston

Recorded

Township N. 3 North of the Base line & Range N. 3 East of the Principal Meridian



Surveyor's office
St. Louis, Mo., July 11th 1850
The North East quarter of section 1 & 3, - the North West quarter of section 2 & 7, - the South West quarter of section 6 & 19, - and the West halves of sections 18, 30 & 31, were sold under the act of Congress the 5th of April 1832. - The North West quarter of section 1 & 3, 6 & 19, - the North East quarter of section 2, - the North halves of sections 4 & 5, and the South West quarter of section 7, submitted to the court and ordered to be sold under the act of Congress the 5th of April 1832, and a copy of the plat of the North halves of sections 1 & 3, 4 & 5, and West half of section 6, sent one copy to the court and another to the clerk on the 16th Sept. 1849. Note from the field notes, the South bound of this Township appears to have been run at random, and the falling is 1000 ft. North of the Township corner. In comparing the subdivision of this Township and the fallings of the South bound of section 35 of the 3rd of June - no doubt the fall of the South bound of this Township is seriously stated as 1000 ft. North, perhaps it is 1000 ft. North, which is in constructing this Township.


Warrant to a contract with and instructions from William Rees, Surveyor of the lands of the United States in the Territory of Illinois and Missouri bearing date the 29th day of October 1848, to wit: That, having examined said plat and survey, the above Township of land and do hereby certify that it had such Mark and bounds both Natural and Artificial as are represented on said plat and returned with the plat into the office of the Surveyor of the lands of the United States in the Territory of Illinois and Missouri.

Wm. Rees

Recorded

Township N. 7 north of the Base line in Range 12 3 East of the 3rd Principal Meridian 410.

page 7 vol 8

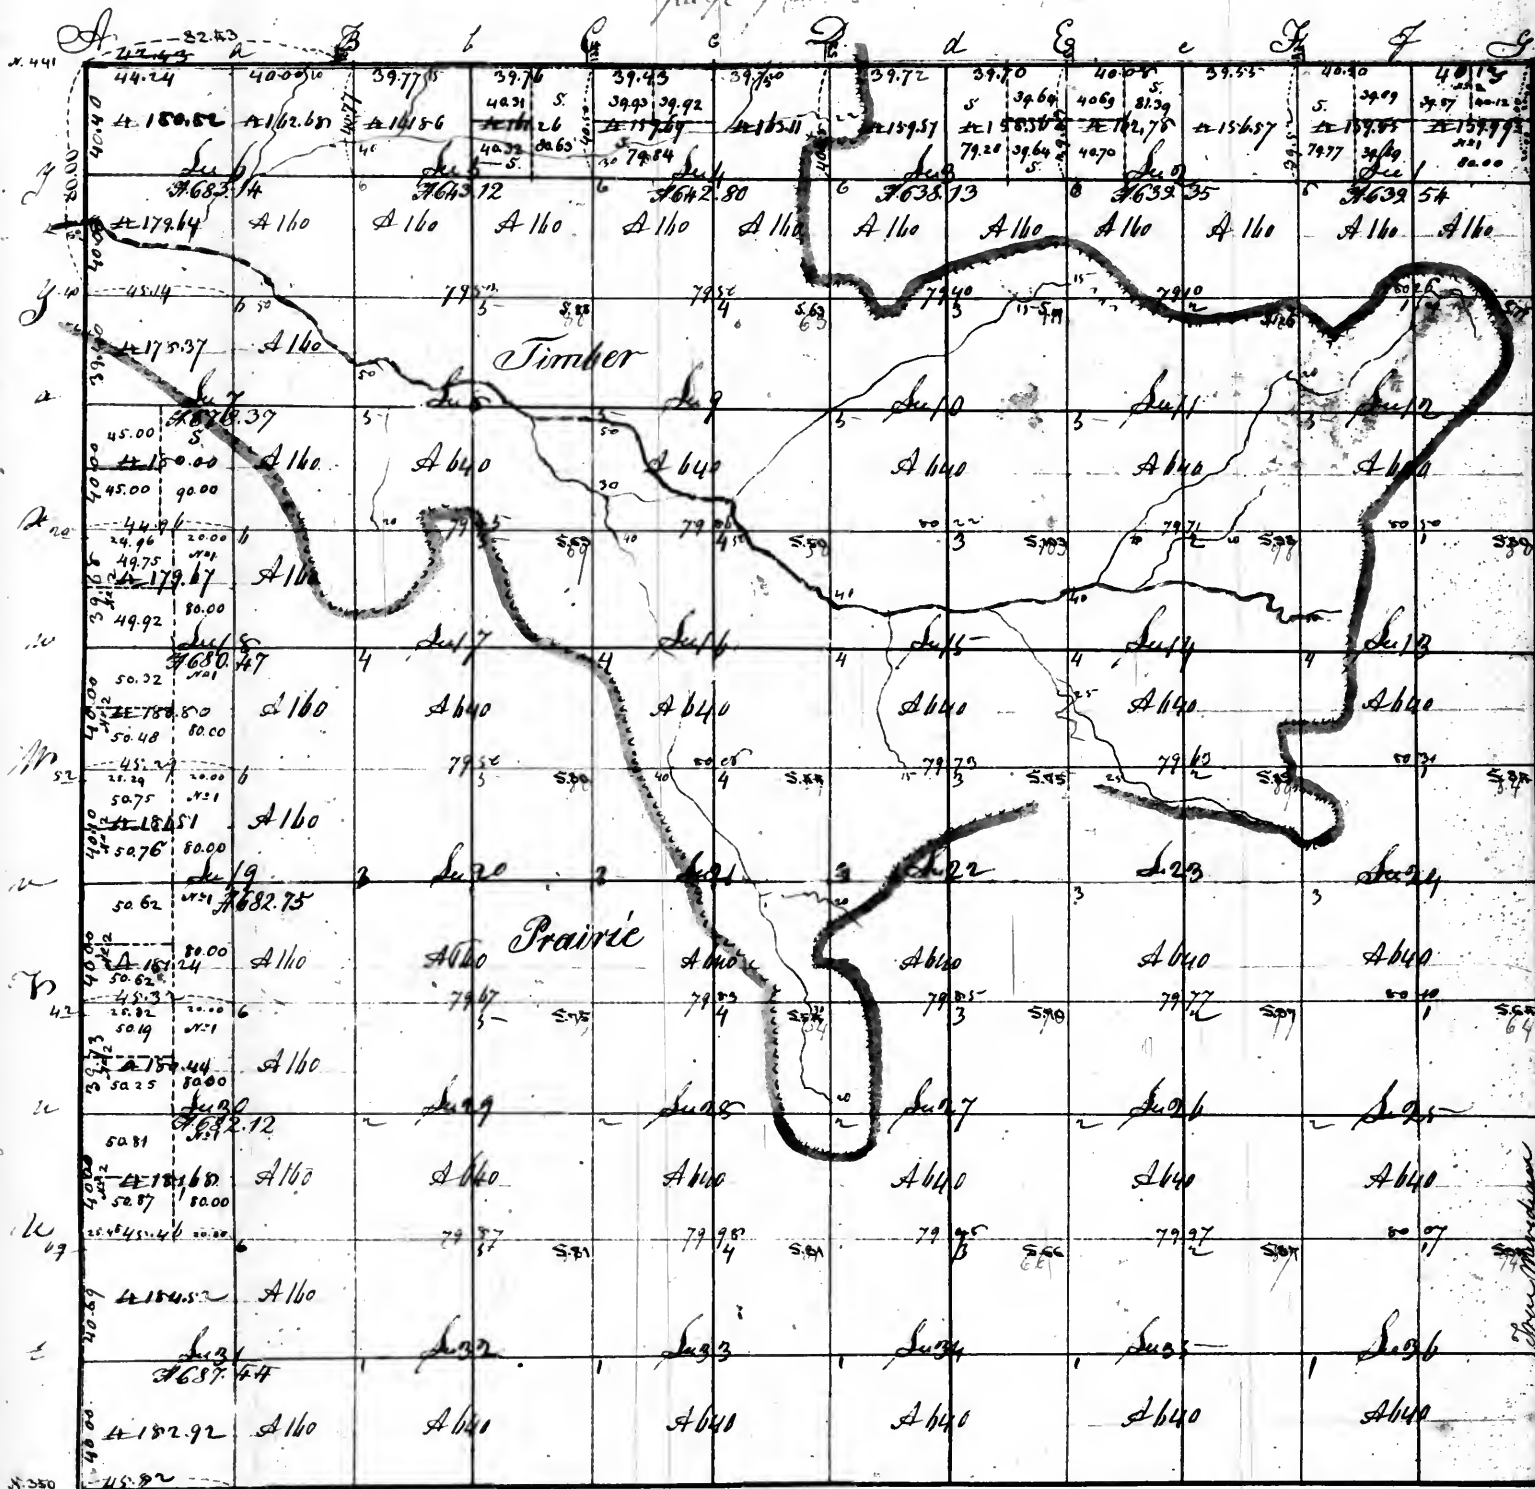

Surveyor's office
St. Louis, Mo. 15th 1849
The North East quarter of
section 1, and the east halves
of sections 18, 19 & 20, subsection
under the act of Congress of the
5th of April 1852.
The North West quarter
of sections 18, 19, 20, the North
East quarter of sections 3 & 5
and the South West quarter
of section 7, subdivided as to
improved to previous
and a plot sent to
with and another to
Commissioner of the General
Land Office

50.00
397.6

3rd Principal Meridian


Pursuant to a contract with and Instructions from William Reitor Surveyor of the lands of the United States in the Territories of Illinois and Missouri bearing date the day of 22nd 1848 I have administered laid out and surveyed the above Township of land and do hereby certify that I had such marks and bounds both natural and artificial as are represented on said plat and described in the field notes made thereon and returned with this plat into the office of the Surveyor of the lands of the United States in the Territories of Illinois and Missouri

certified this 20th day of April 1849
William Reitor DS

Records

411.

Township No 8 North of the Base line Range No Three East of Third Principal Meridian

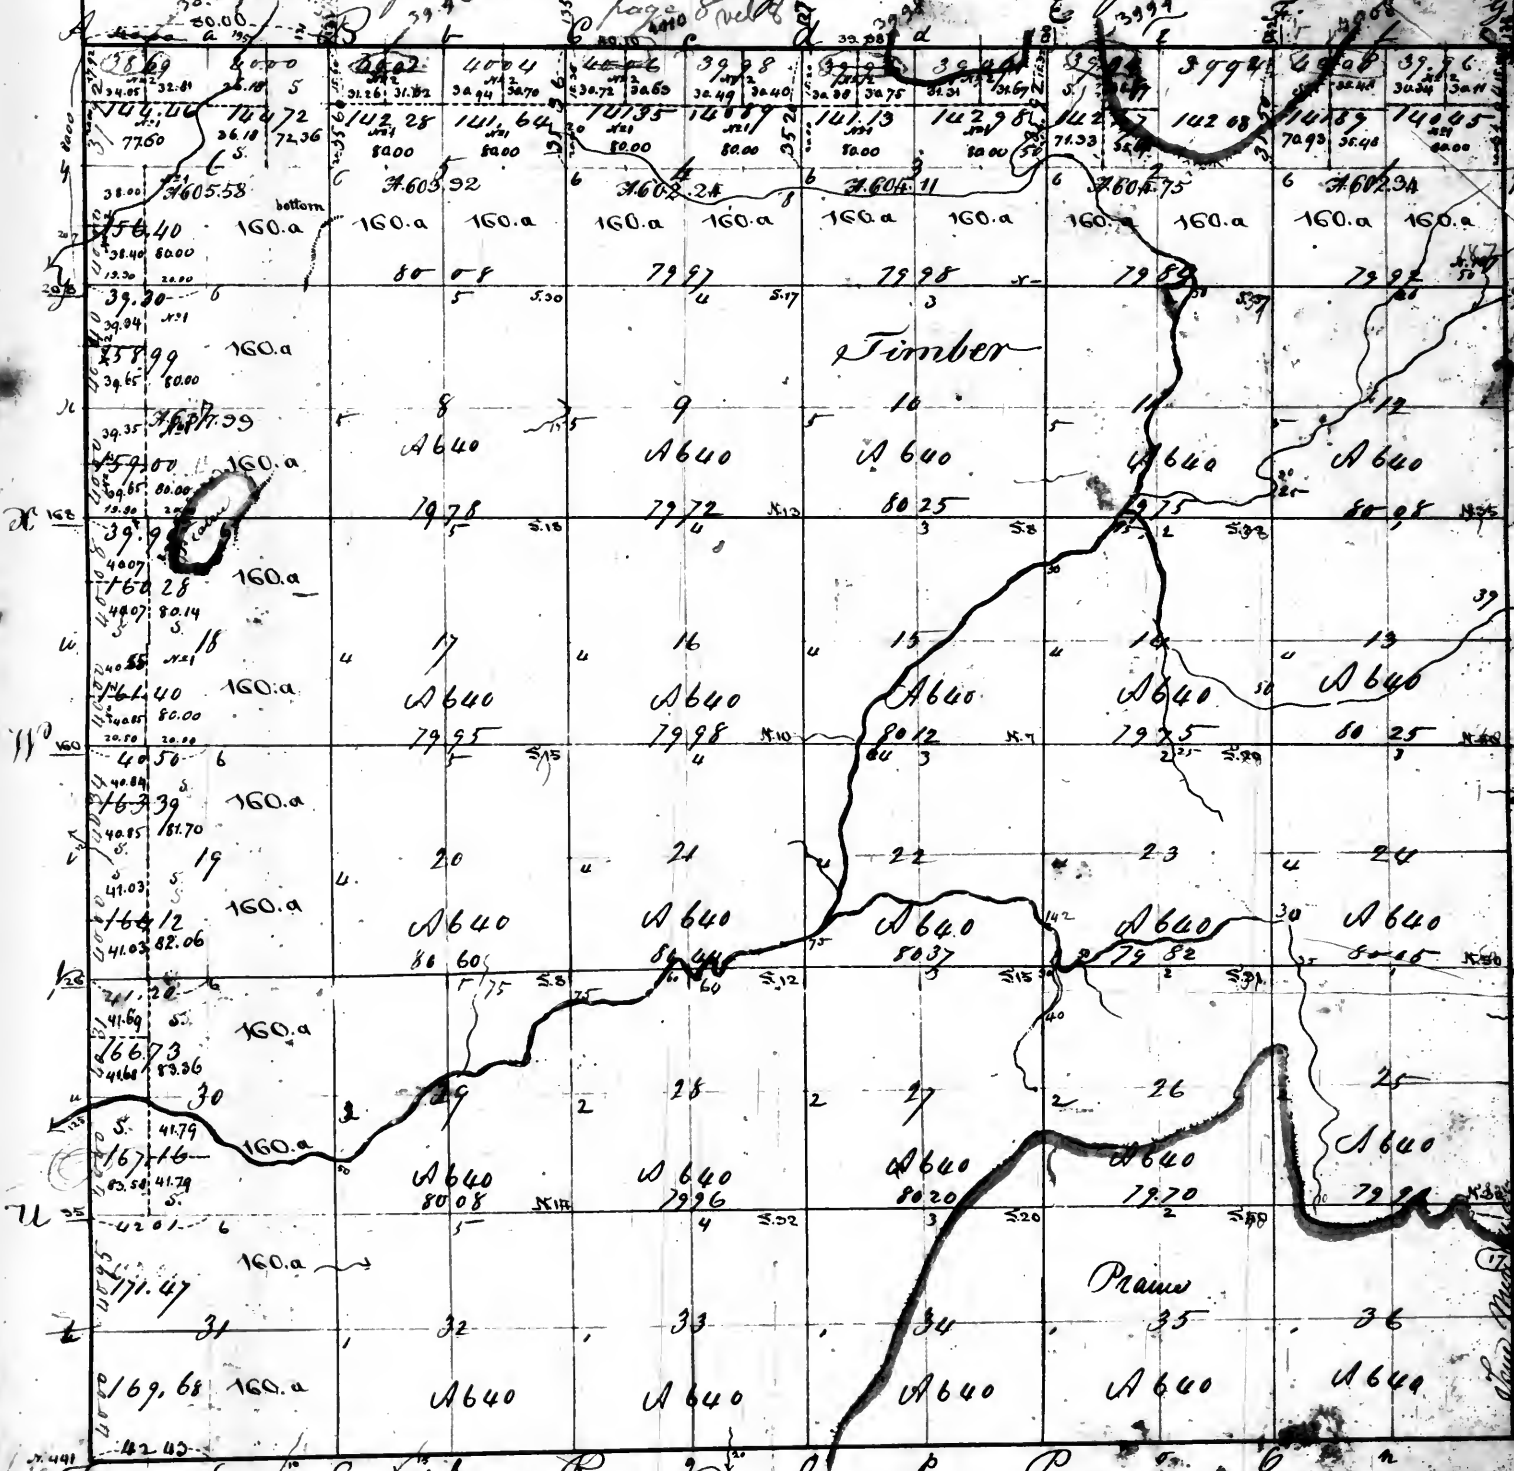

Surveyor's Office
of the State of Missouri
The north quarter of the
the north halves of sections 2, 3,
the west halves of sections 4, 5,
and the south west quarter
of section 18, subdivided
in accordance with the
act of Congress of the
April 1832, - the
quarters of sections
the North East quarter
R. 6, and the west halves
19 & 20 subdivided, so as
form to previous notes
and a plat was to be
made and another to the
of the General Land

Aggregate area = 22865.16 acres

Pursuant to a Contract with and instructions from the Surveyor of the Lands of the United States in the State of
Missouri & Territories of Missouri & Arkansas bearing date seventeenth day of May in the year one thousand eight hundred
& twenty I have examined said map & surveyed the above described Township & do hereby certify that it had such map
& boundary both natural & artificial as are represented on said plat and described in the field notes made there
and returned with this plat into the office of the Surveyor of the Lands of the United States for the State of Missouri & the
Territories of Missouri & Arkansas.

Wm. Lewis Hamilton


By Surveyor

Calculated this 2nd day of December 1820

Recorded

412.

Township Nine North of the Base line Range Three East of the Third Principal Meridian

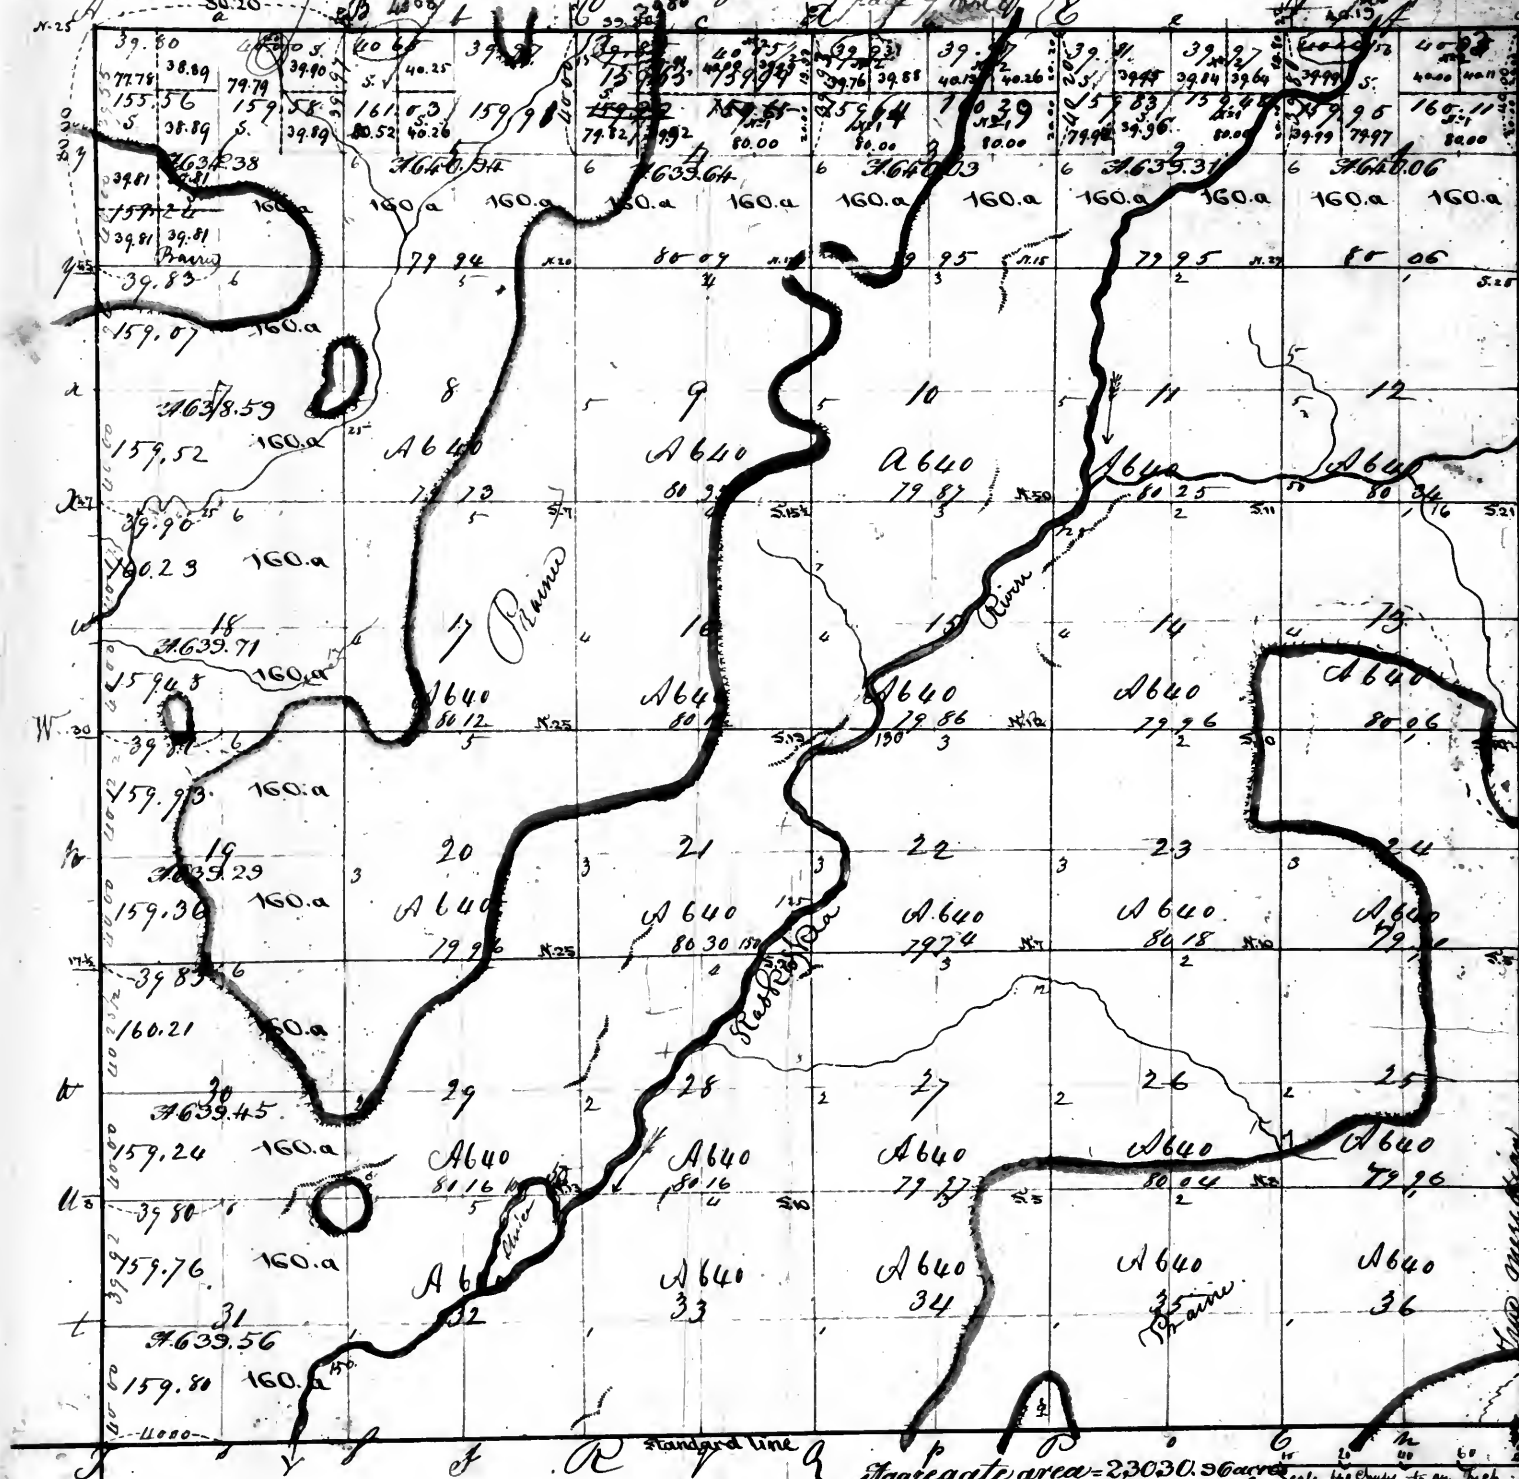

Surveyor's Office
St. Louis, Mo. July 11th 1850

Aggregate area - 23030.56 acres

Pursuant to a Contract with and instruction from the Surveyor of the Lands of the United States in the State of Missouri and Territories of Missouri & Arkansas bearing date the seventeenth day of May in the Year One Thousand Eight Hundred & Sixty. I have admeasured laid out and surveyed the above described Township; I do hereby certify that it had such marks and bounds, both natural and artificial as are represented on said plat and described in the field notes thereof, and returned with this plat into the office of the Surveyor of the Lands of the United States for the State of Missouri & Territories of Missouri & Arkansas.


Before this 2nd day of December 1850

Wm. Peyton Hamilton

By Surveyor

Recorded 413

Township No Ten North of the Base Line Range No Three East of Third Principal Meridian

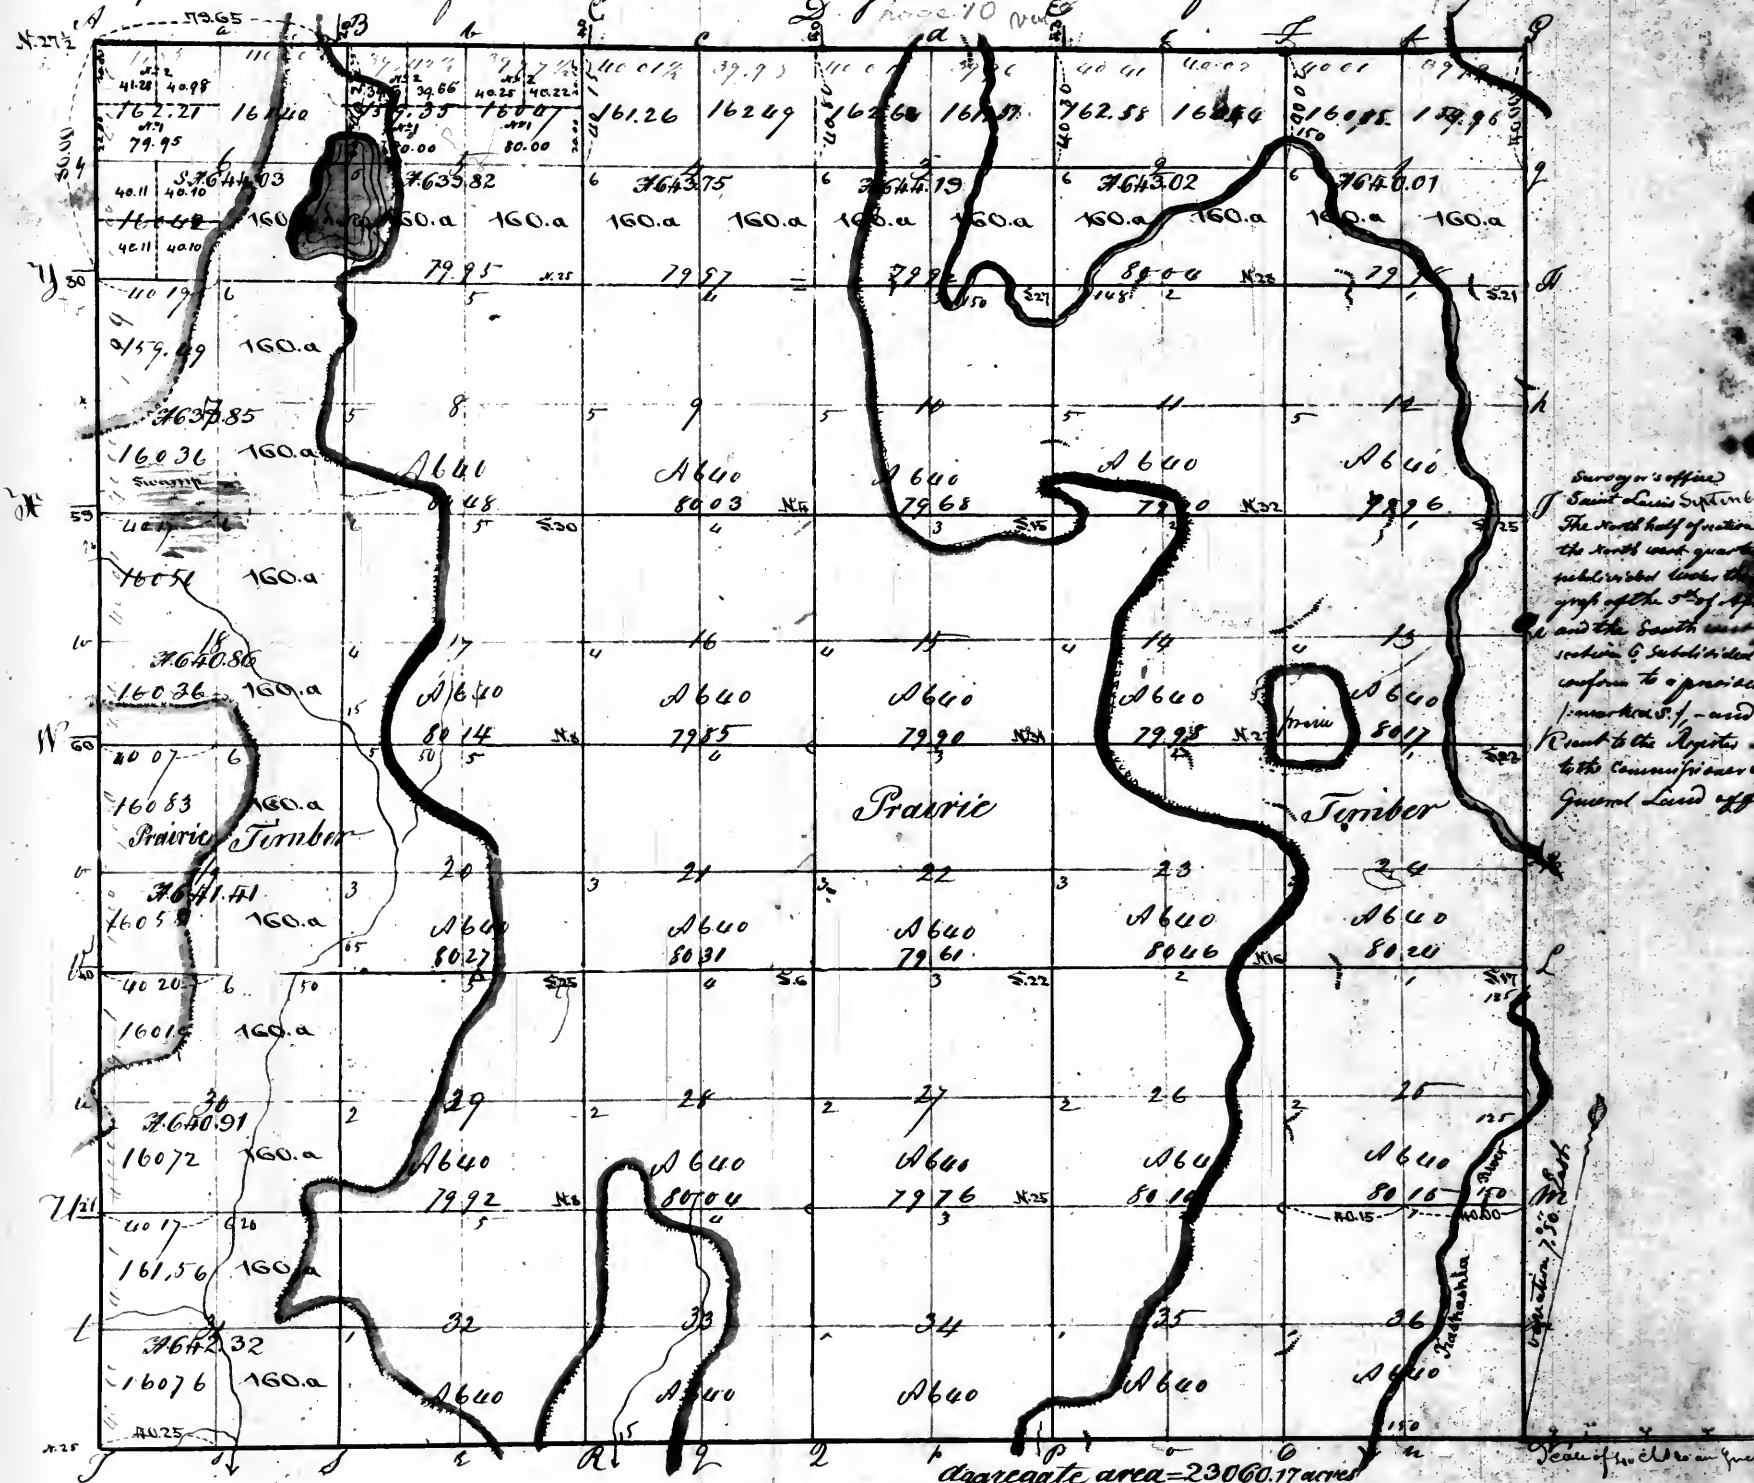


Surveyor's Office
Saint Louis, September 15th 1857
The north half of section 5 and
the north west quarter of section 6
subdivided under the survey
of the 5th of April 1857.
and the south west quarter
section 6 subdivided same
conform to a previous
marked S. 1. and again
sent to the Agents
to the Commissioners of the
General Land Office

Aggregate area = 23060.17 acres

Pursuant to a Contract with and instruction from Mr. Peter Surveyor of the Lands of the United States in the State of Illinois & Territories of Missouri & Arkansas bearing date the seventeenth day of May in the year one thousand eight hundred & twenty. I have had measured laid out & surveyed the above described Township & do hereby certify that it had such marks & bounds both natural and artificial as are represented on said plat and described in field notes made there of and returned with this plat into the office of the Surveyor of the Lands of the United States for the State of Illinois & Territories of Missouri & Arkansas. Certified this 2nd day of December. Mr. Sayer Hamilton
By Surveyor

Recorded 414

Township No. 11 North of the base line, Range No. 3 East of the 3^d principal Meridian.

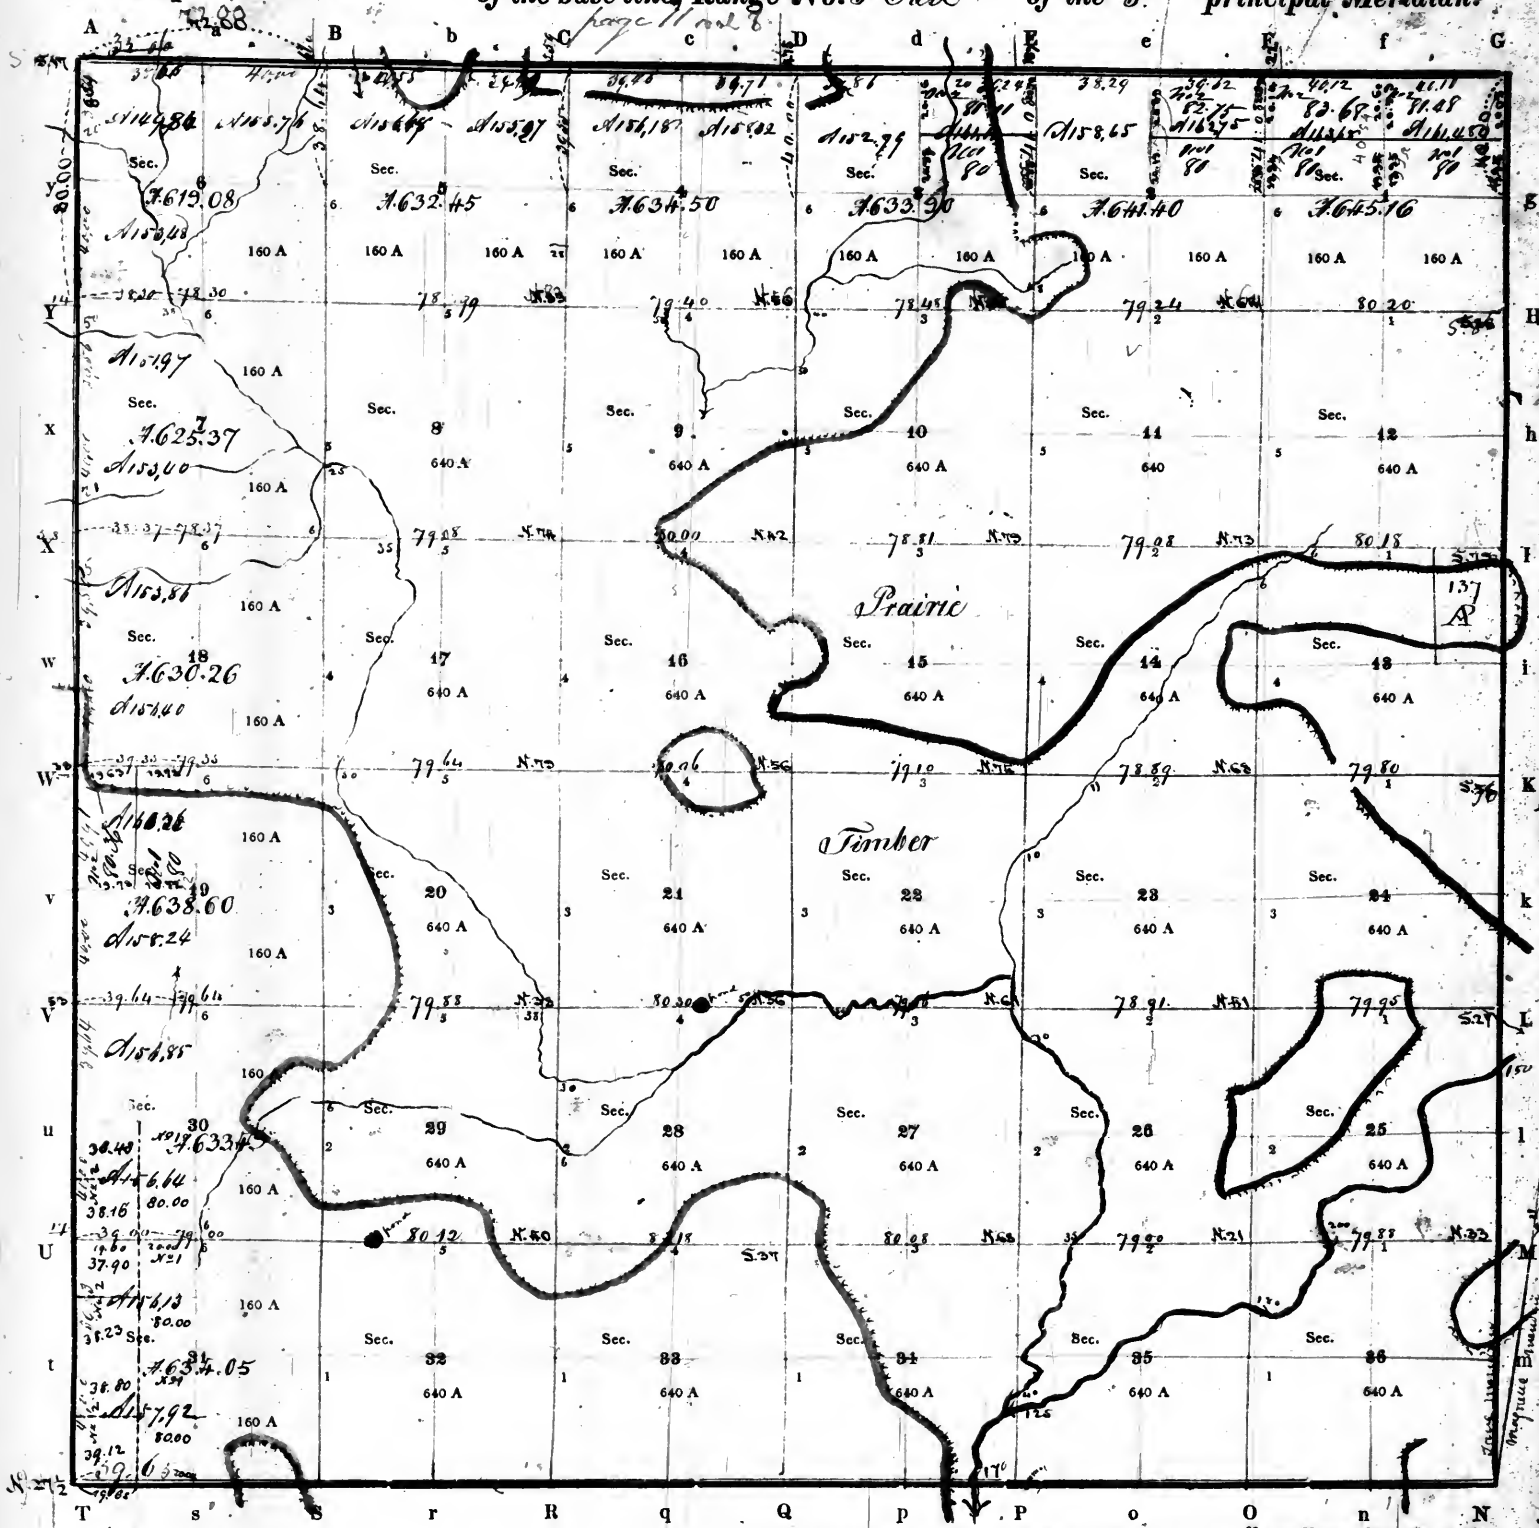

Aggregate area = 22968.26 acres

PURSUANT to a contract with, and instructions from WILLIAM RECTOR, Surveyor of the lands of the United States in the State of Illinois
 Missouri & Territory of Arkansas bearing date the 3rd day of March 1824

I have admeasured, laid out and surveyed the above described Township; and do hereby certify, that it had such marks and bounds, both natural and artificial, as are represented on said plat, and described in the field notes made thereof, and returned with this plat into the Office of the Surveyor of the lands of the United States, for the State of Illinois & Missouri & Territory of Arkansas


Certified this 15th day of Sept 1824

EXAMINED.

Wm. Rector
 D. SURVEYOR.

Surveyor's Office
 St. Louis 10th August 1824
 Plat of the North half
 of the NE quarter of Sec
 4 of the N.W. quarter of
 sent this day to the Commis
 S.O.
 Surveyor's Office
 St. Louis 15th 1824
 The South West quarter of
 30 and the West half of
 subdivided under the survey
 of the 6th of April 1824 and
 a plat sent to the Register
 under to the Commission
 General Land Office

Township No. 12 North of the base line, Range No. 3 East of the 2^d principal Meridian. 415.

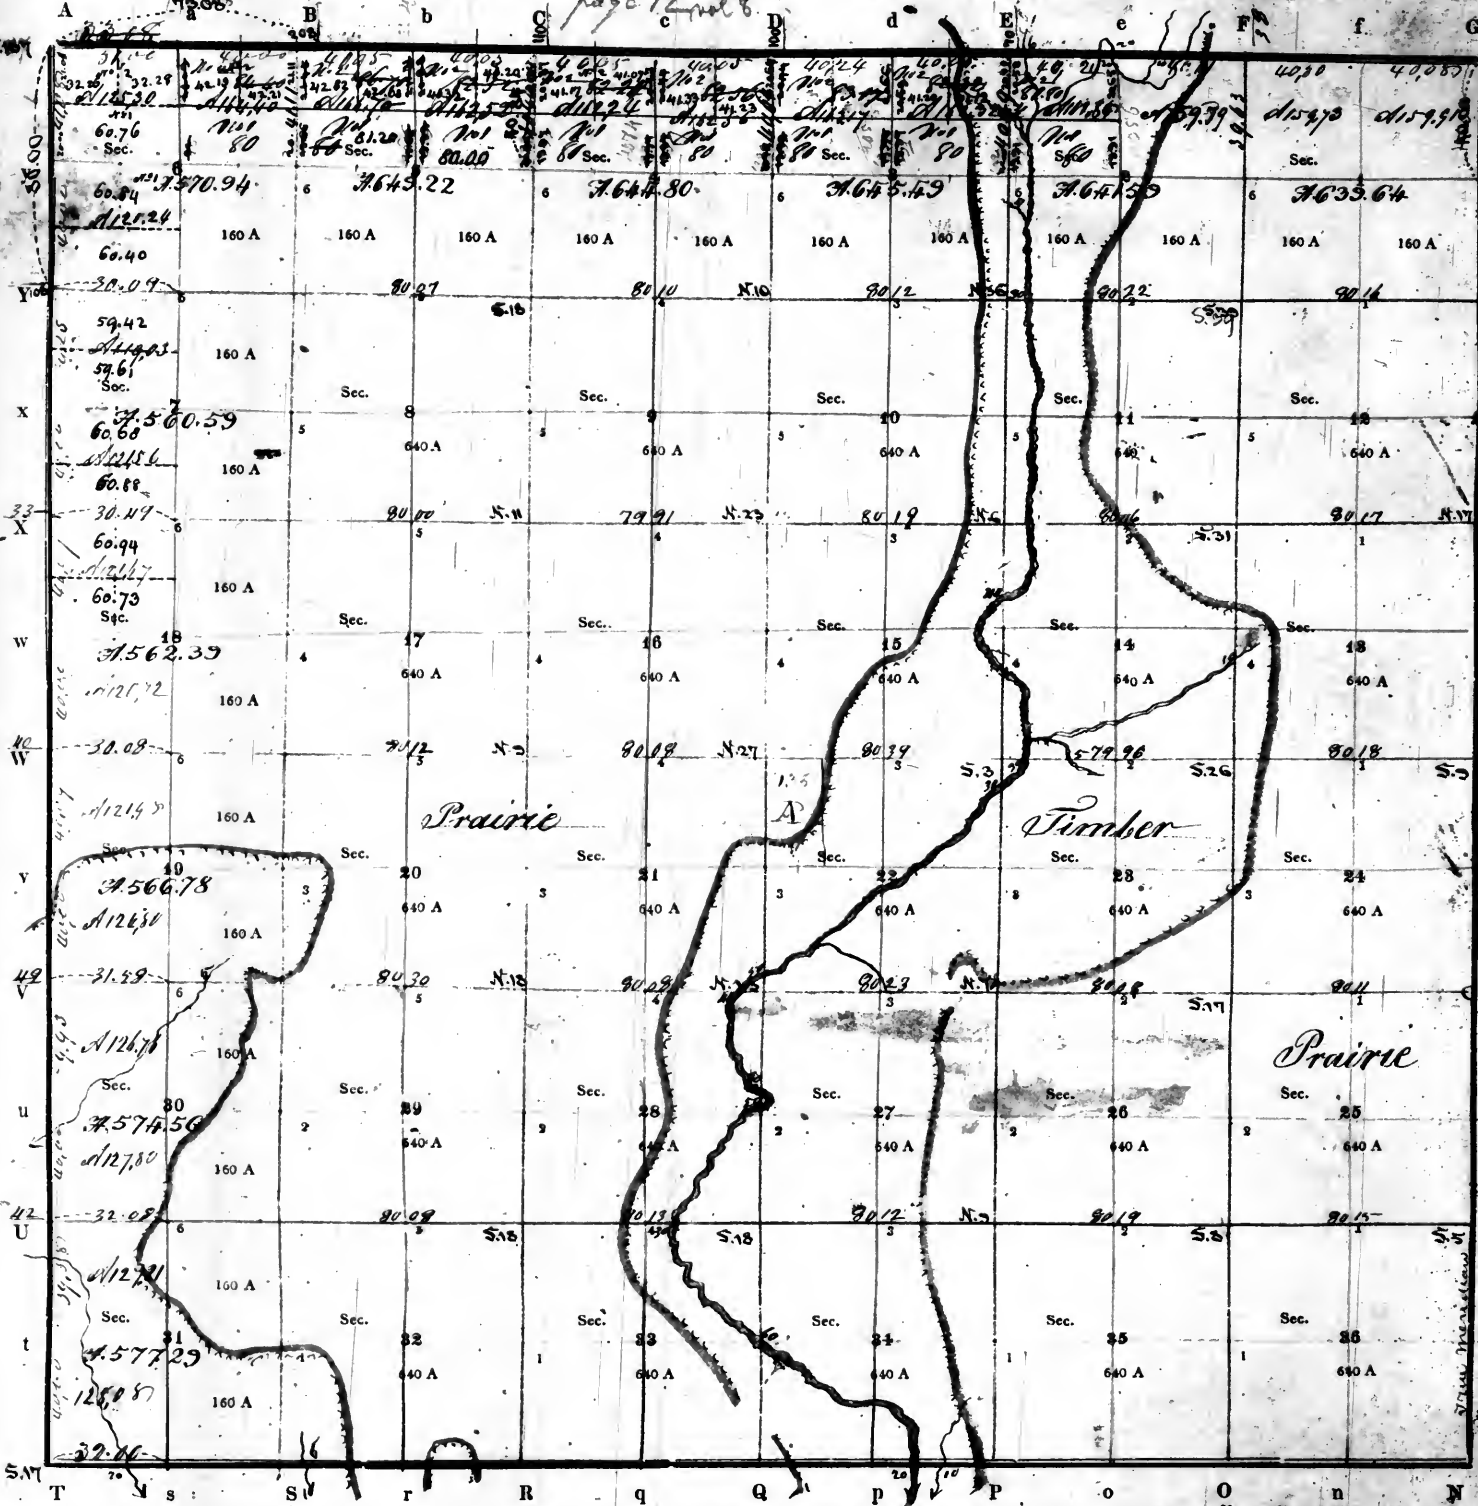

Aggregate area - 22633.29 acres

PURSUANT to a contract with, and instructions from WILLIAM RECTOR, Surveyor of the lands of the United States in the States of Missouri and Illinois & Territory of Arkansas bearing date the 3^d day of March 1821.

I have admeasured, laid out and surveyed the above described Township; and do hereby certify, that it had such marks and bounds, both natural and artificial, as are represented on said plat, and described in the field notes made thereof, and returned with this plat into the Office of the Surveyor of the lands of the United States, for the States of Missouri and Illinois & Territory of Arkansas

Certified this 13th day of September 1821.

EXAMINED.


W. RECTOR, SURVEYOR.

Surveyor's Office
St. Louis 10th August 1821
Plat of the N.W. q. of Sec. 1 of
North halves of Secs 2, 3, 4 & 5
the N.E. q. of Sec. 6, and
to the Corner of the land
Surveyor's office
Saint Louis Sept. 15th 1821
The west halves of sections
and the North East quarter
section 18, subdivided into
lots of 40 acres each, the 5th
April 1822, and a plat
to the Register and
the Commissioner of the
General Land Office
Office of the Surveyor
General of Illinois
Saint Louis July 19th 1821
The North halves of sections
and the North East quarter
of section 6, subdivided into
lots of 40 acres each, the 5th
April 1822, and a plat
to the Register and
the Commissioner of the
General Land Office

Recorded

456

Township No. 13 North of the base line, Range No. 3 East of the principal Meridian.

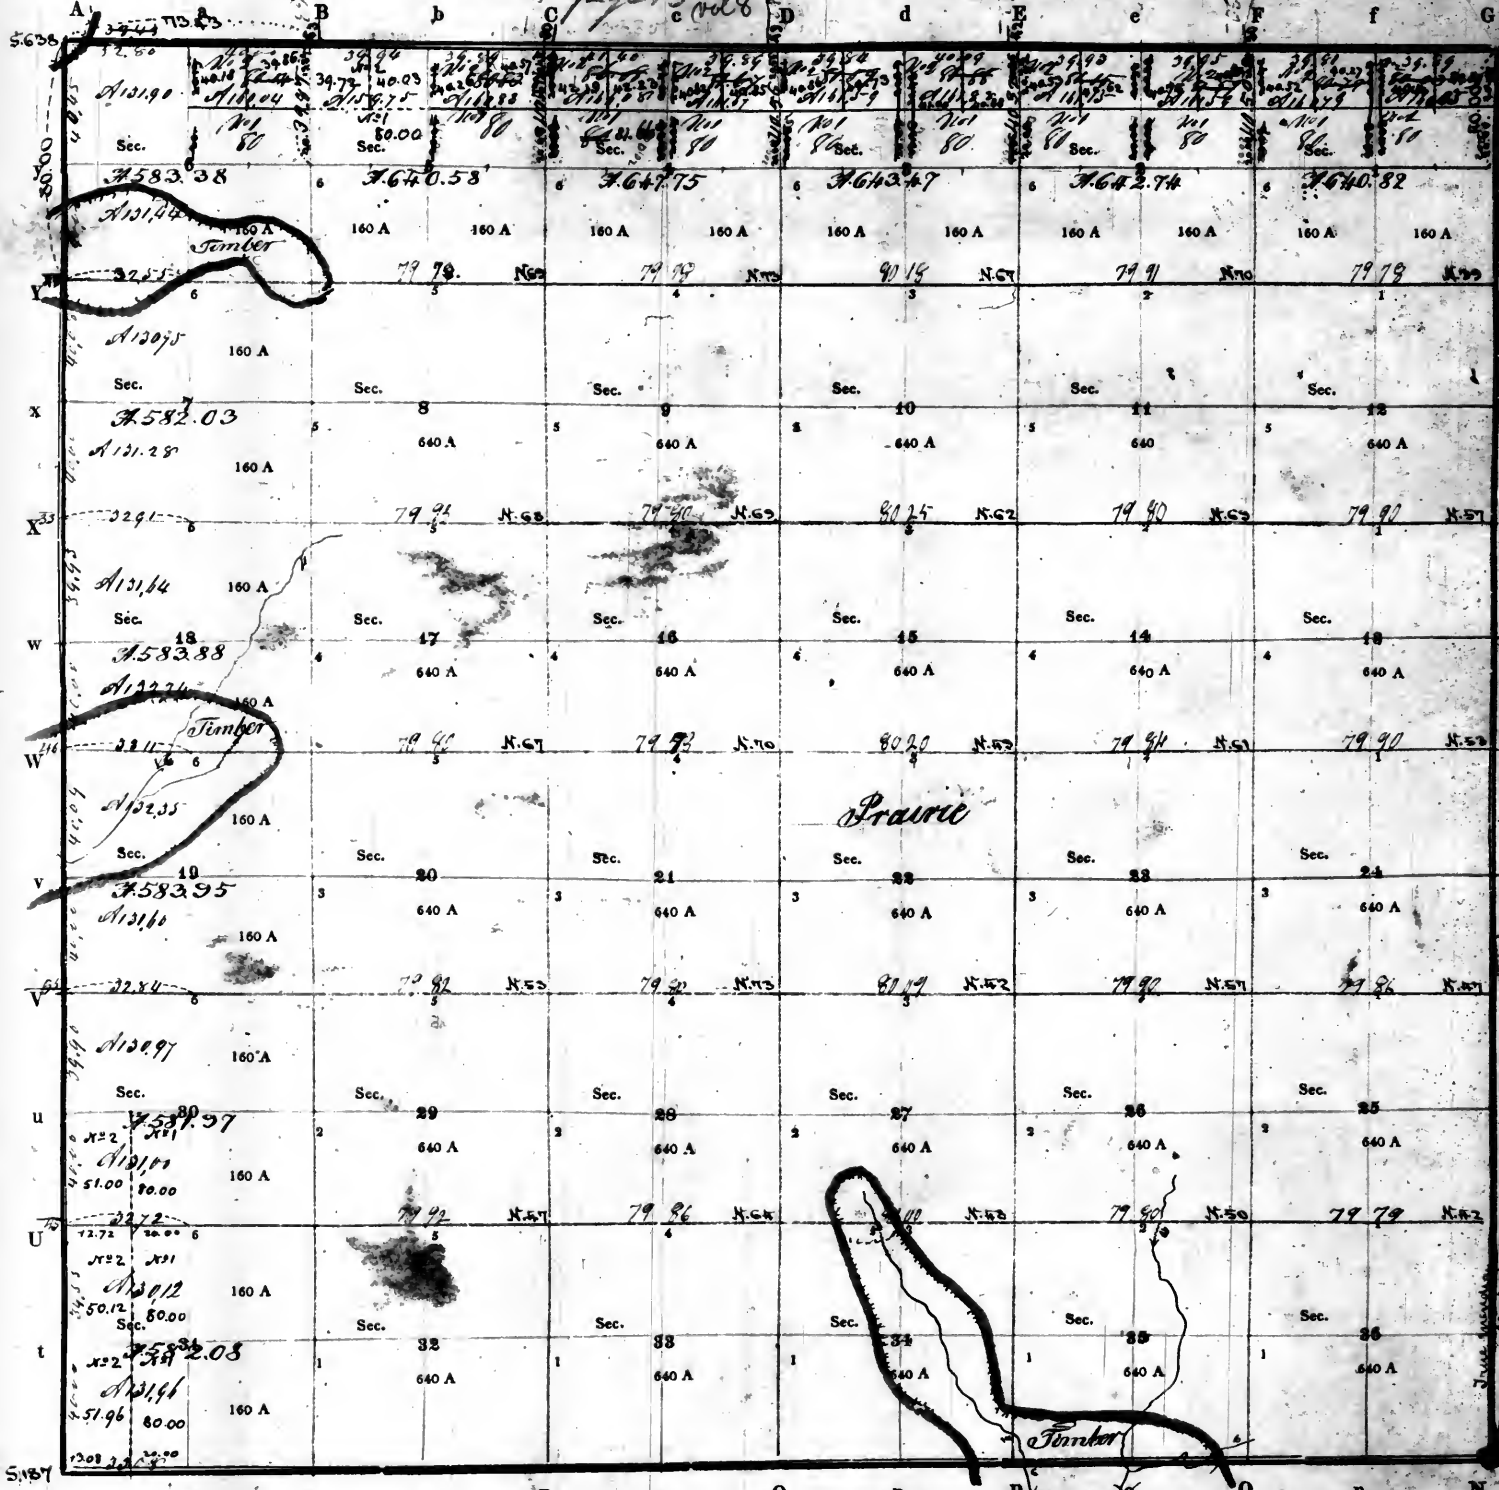

Surveyor's Office
St. Louis 10th August 1821
k Plot of the North halves
1, 2, 3, 4, 5, and 6 of the N.E.
of Secs 5 & 6, next the
Commissioner of the General
L Surveyor's Office
Surveyed under 15th Sec.
The South half of Sec. 15
30 in the 11th Range
substantially under
a copy of the 5th Sec.
and a plat sent to the
and another to the Com.
of the General Land
Office of the Surveyor
for the State of Illinois
Saint Louis, July 18th
The North halves of sections
3, 4, 5, and 6, next the
to of section 6, subdivided
the out of a copy of the
of April 1832, and a
sent to the Register and
to the Commissioner of the
and Land Office.

Aggregate area - 22712.65 acres

Scale of 40 Chains to an Inch.

PURSUANT to a contract with, and instructions from WILLIAM RECTOR, Surveyor of the lands of the United States in the States of Illinois and Missouri and Territory of Arkansas bearing date the 3rd day of March 1821.

I have admeasured, laid out and surveyed the above described Township; and do hereby certify, that it had such marks and bounds, both natural and artificial, as are represented on said plat, and described in the field notes made thereof, and returned with this plat into the Office of the Surveyor of the lands of the United States, for the States of Illinois and Missouri & Territory of Arkansas

Certified this 10th day of Sept 1821


C. R. C. SURVEYOR

EXAMINED.

Records

417

Township No. 14 North of the base line, Range No. 3 East of the 3^d principal Meridian.

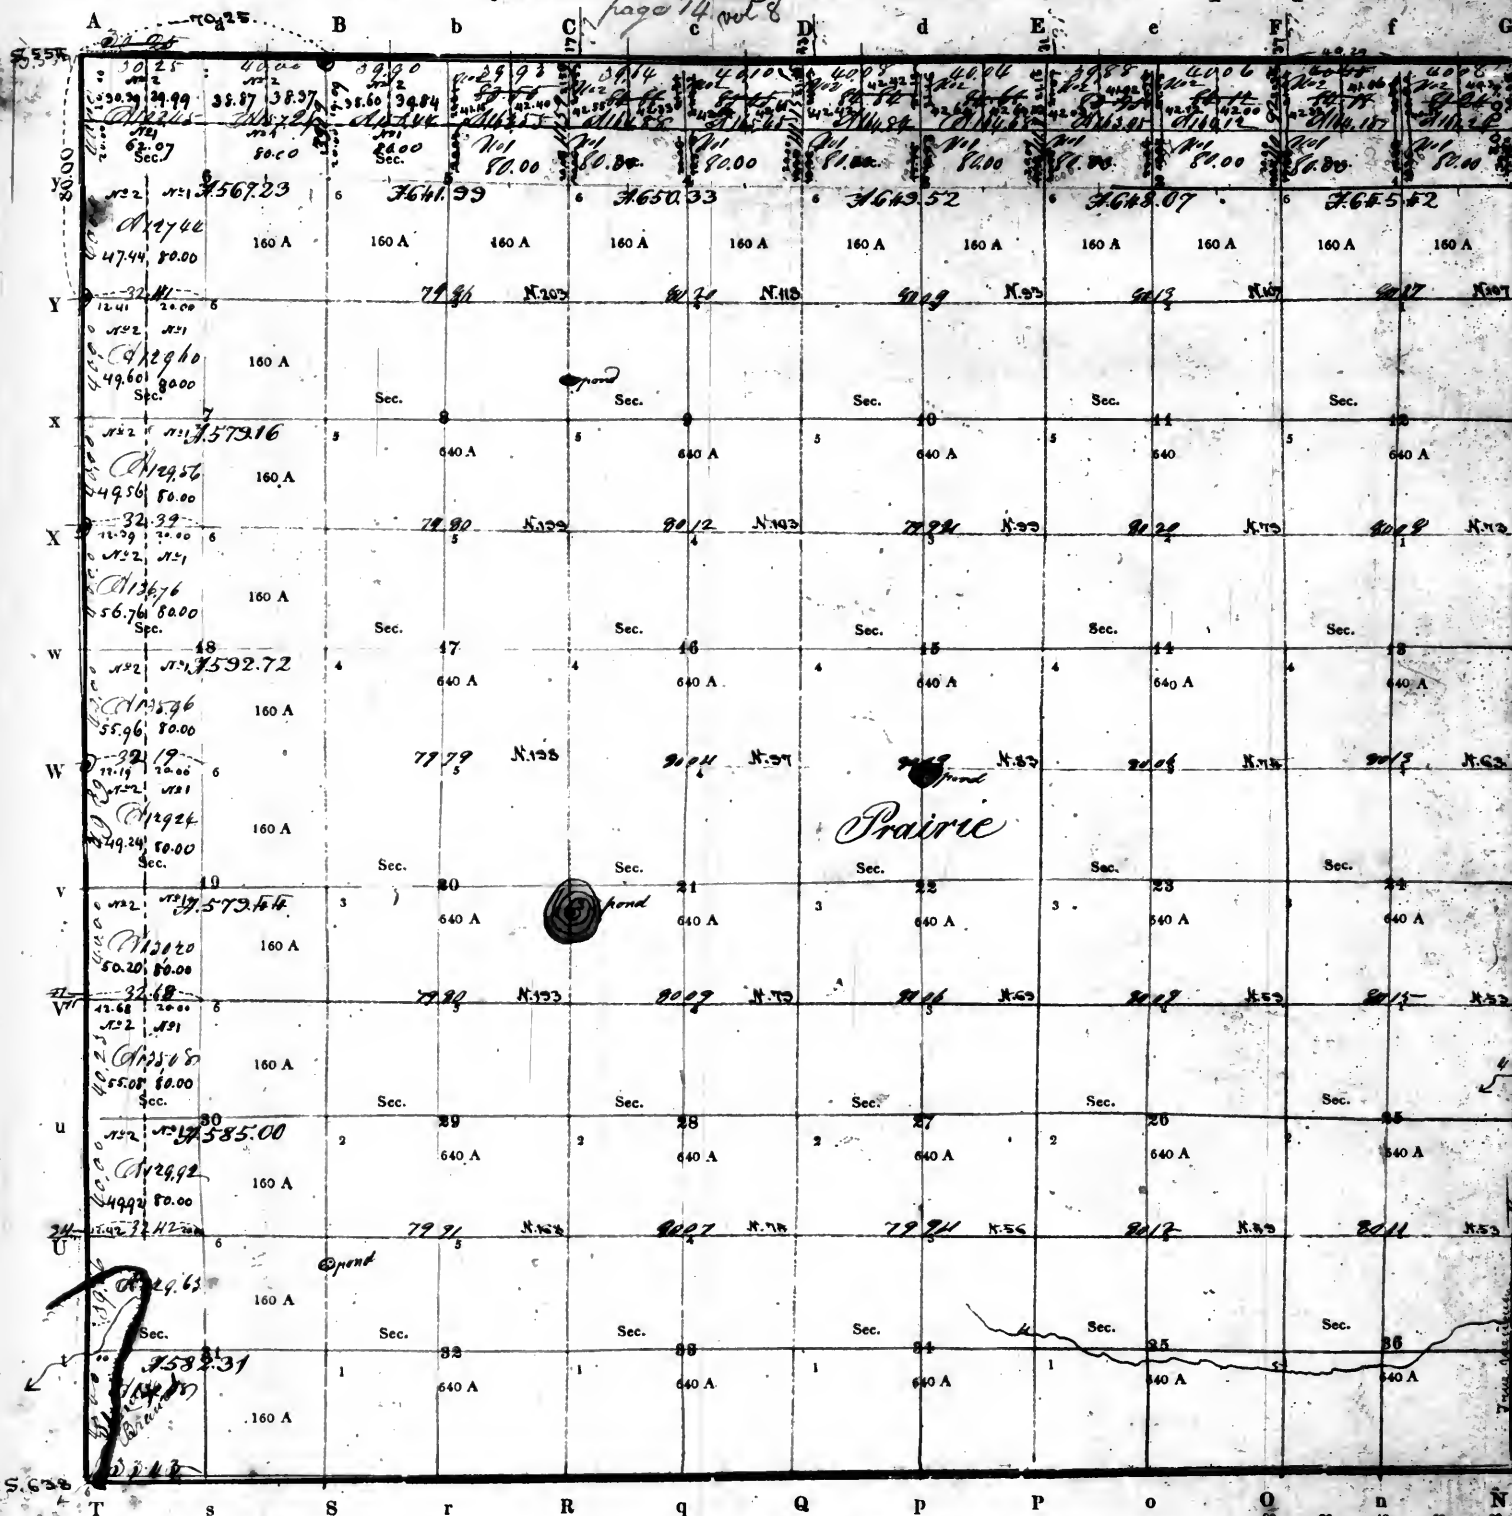

Surveyor's Office
St. Louis, Mo.
Plat of the North half
of Sec. 5, east half of the
of the Q. & O.
Surveyor's Office
St. Louis, Mo.
Sept. 15th
The North half of
3 4 5 6, the South
half of section 6, and
half of section 7, as
subdivided under the
act of April 1835
as amended by the
act of the General Assembly

Aggregate area = 22721.09 acres

Scale of 40 Chains to an Inch.

PURSUANT to a contract with, and instructions from WILLIAM RECTOR, Surveyor of the lands of the United States in the States of Missouri and Illinois & Territory of Arkansas bearing date the 3^d day of March 1821.


I have admeasured, laid out and surveyed the above described Township; and do hereby certify, that it had such marks and bounds, both natural and artificial, as are represented on said plat, and described in the field notes made thereof, and returned with this plat into the Office of the Surveyor of the lands of the United States, for the States of Missouri and Illinois and Territory of Arkansas

Certified this 14th day of September 1821.

Green

D. SURVEYOR


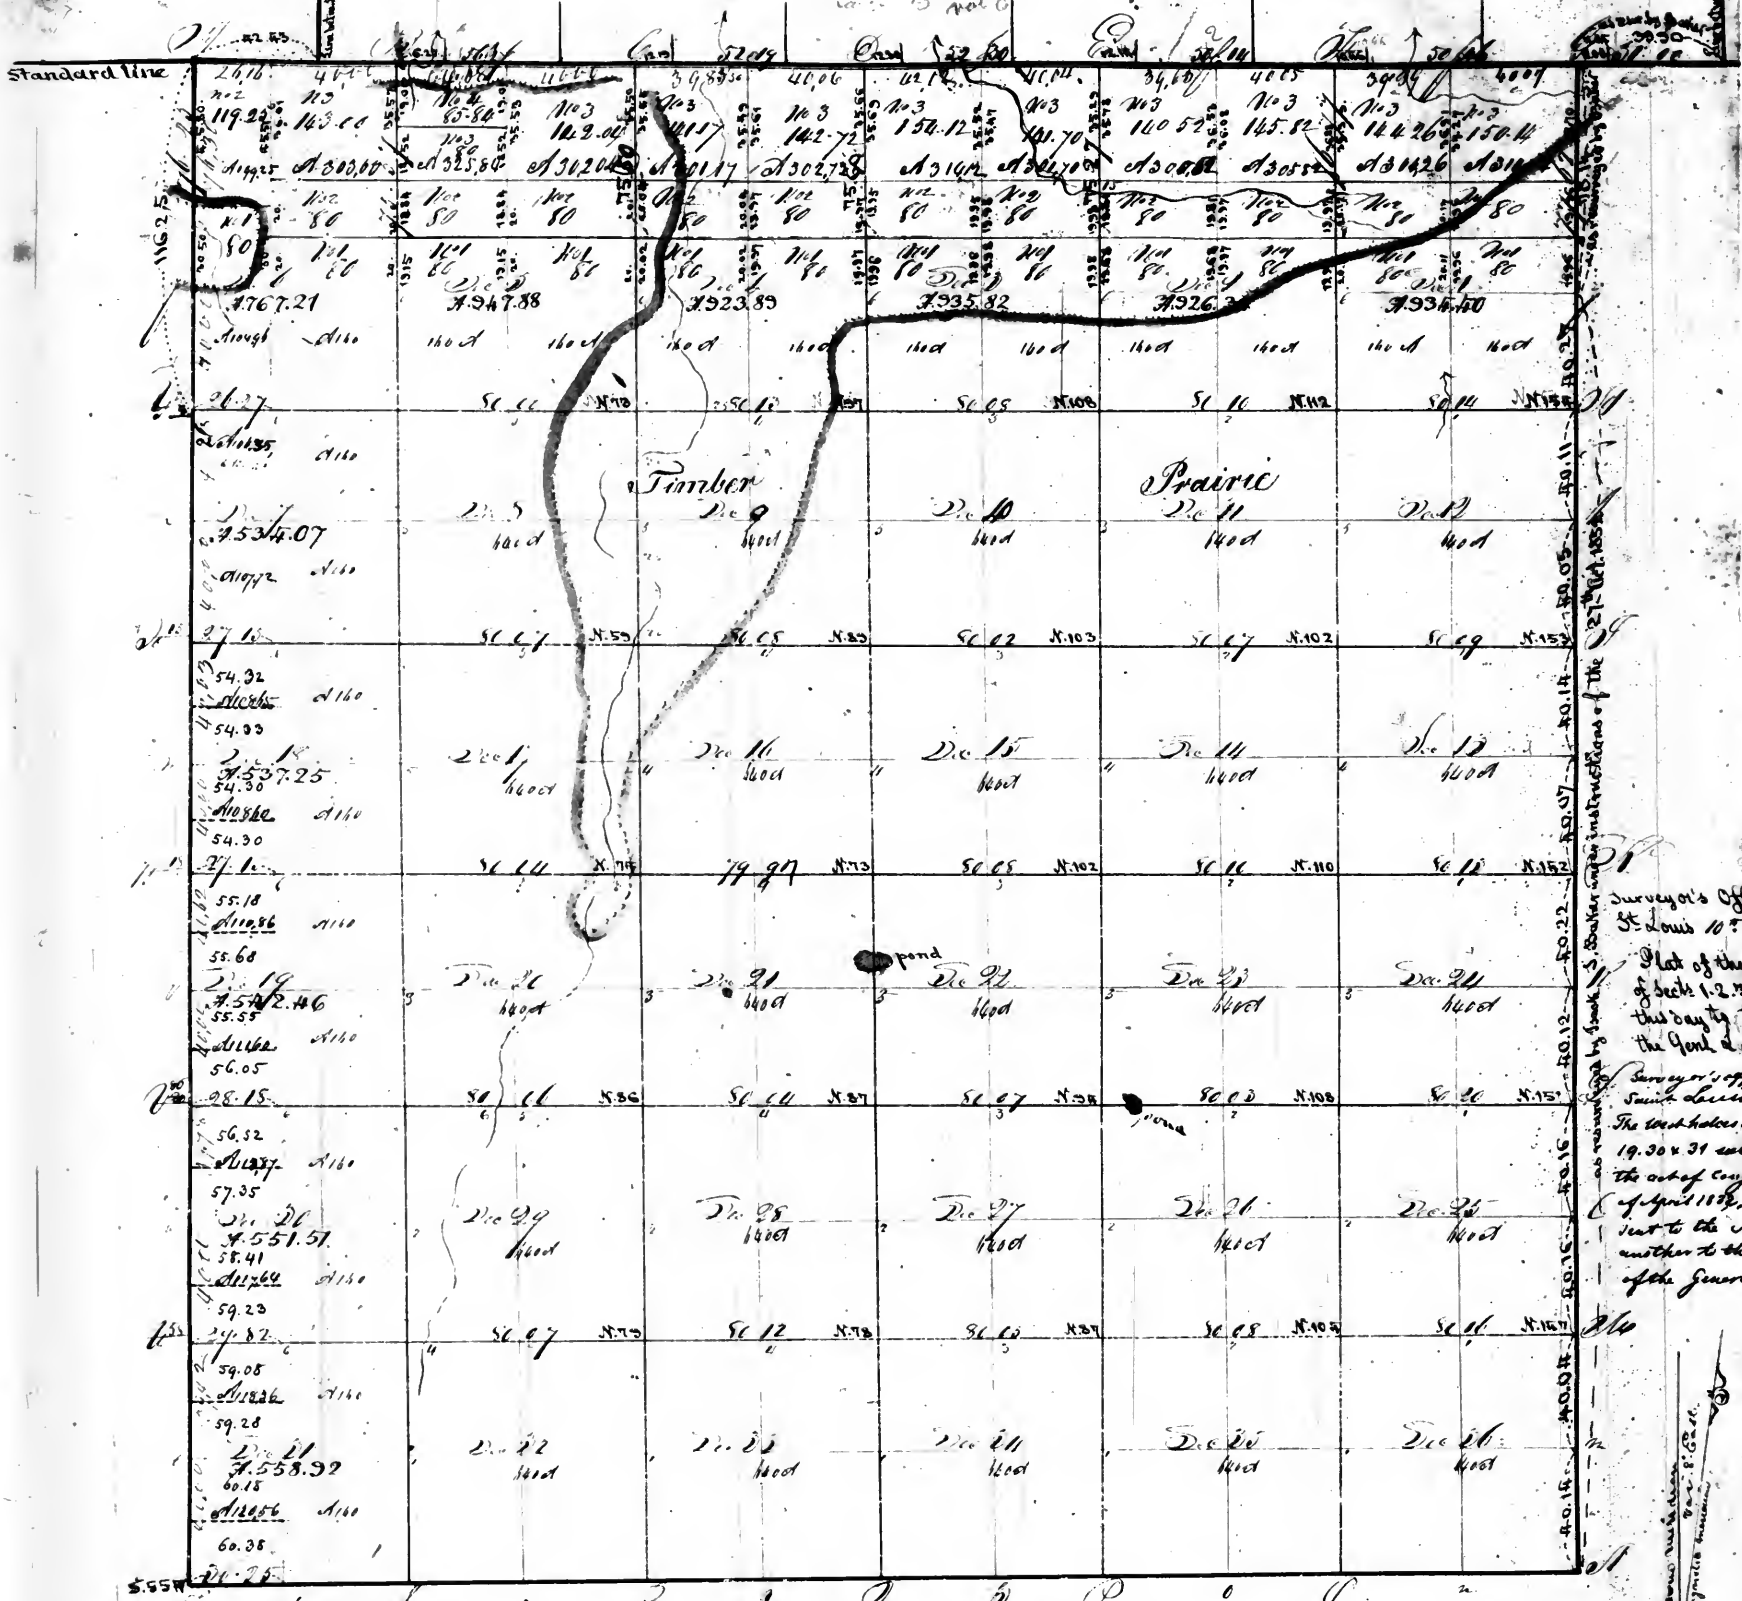

Aggregate area - 24159.75 acres

Surgeant, to a contract with his instructions from William Reder Surveyor of the lands of the United States in the State of Missouri and Territory of Arkansas bearing date the 3rd day of March 1821

I have accordingly laid out and surveyed the above described Township and do hereby certify that it has such marks and bounds both natural and artificial as are represented on said plat and described in the field notes made thereof and returned with this plat into the Office of the Surveyor of the Lands of the United States for the State of Missouri and Territory of Arkansas


Certified this 13 day of September 1821

St. Louis 10th August 1842

9270
170
8100
842
78

Recorded 419

Township No. 16 North of the base line, Range No. 3 East of the principal Meridian.

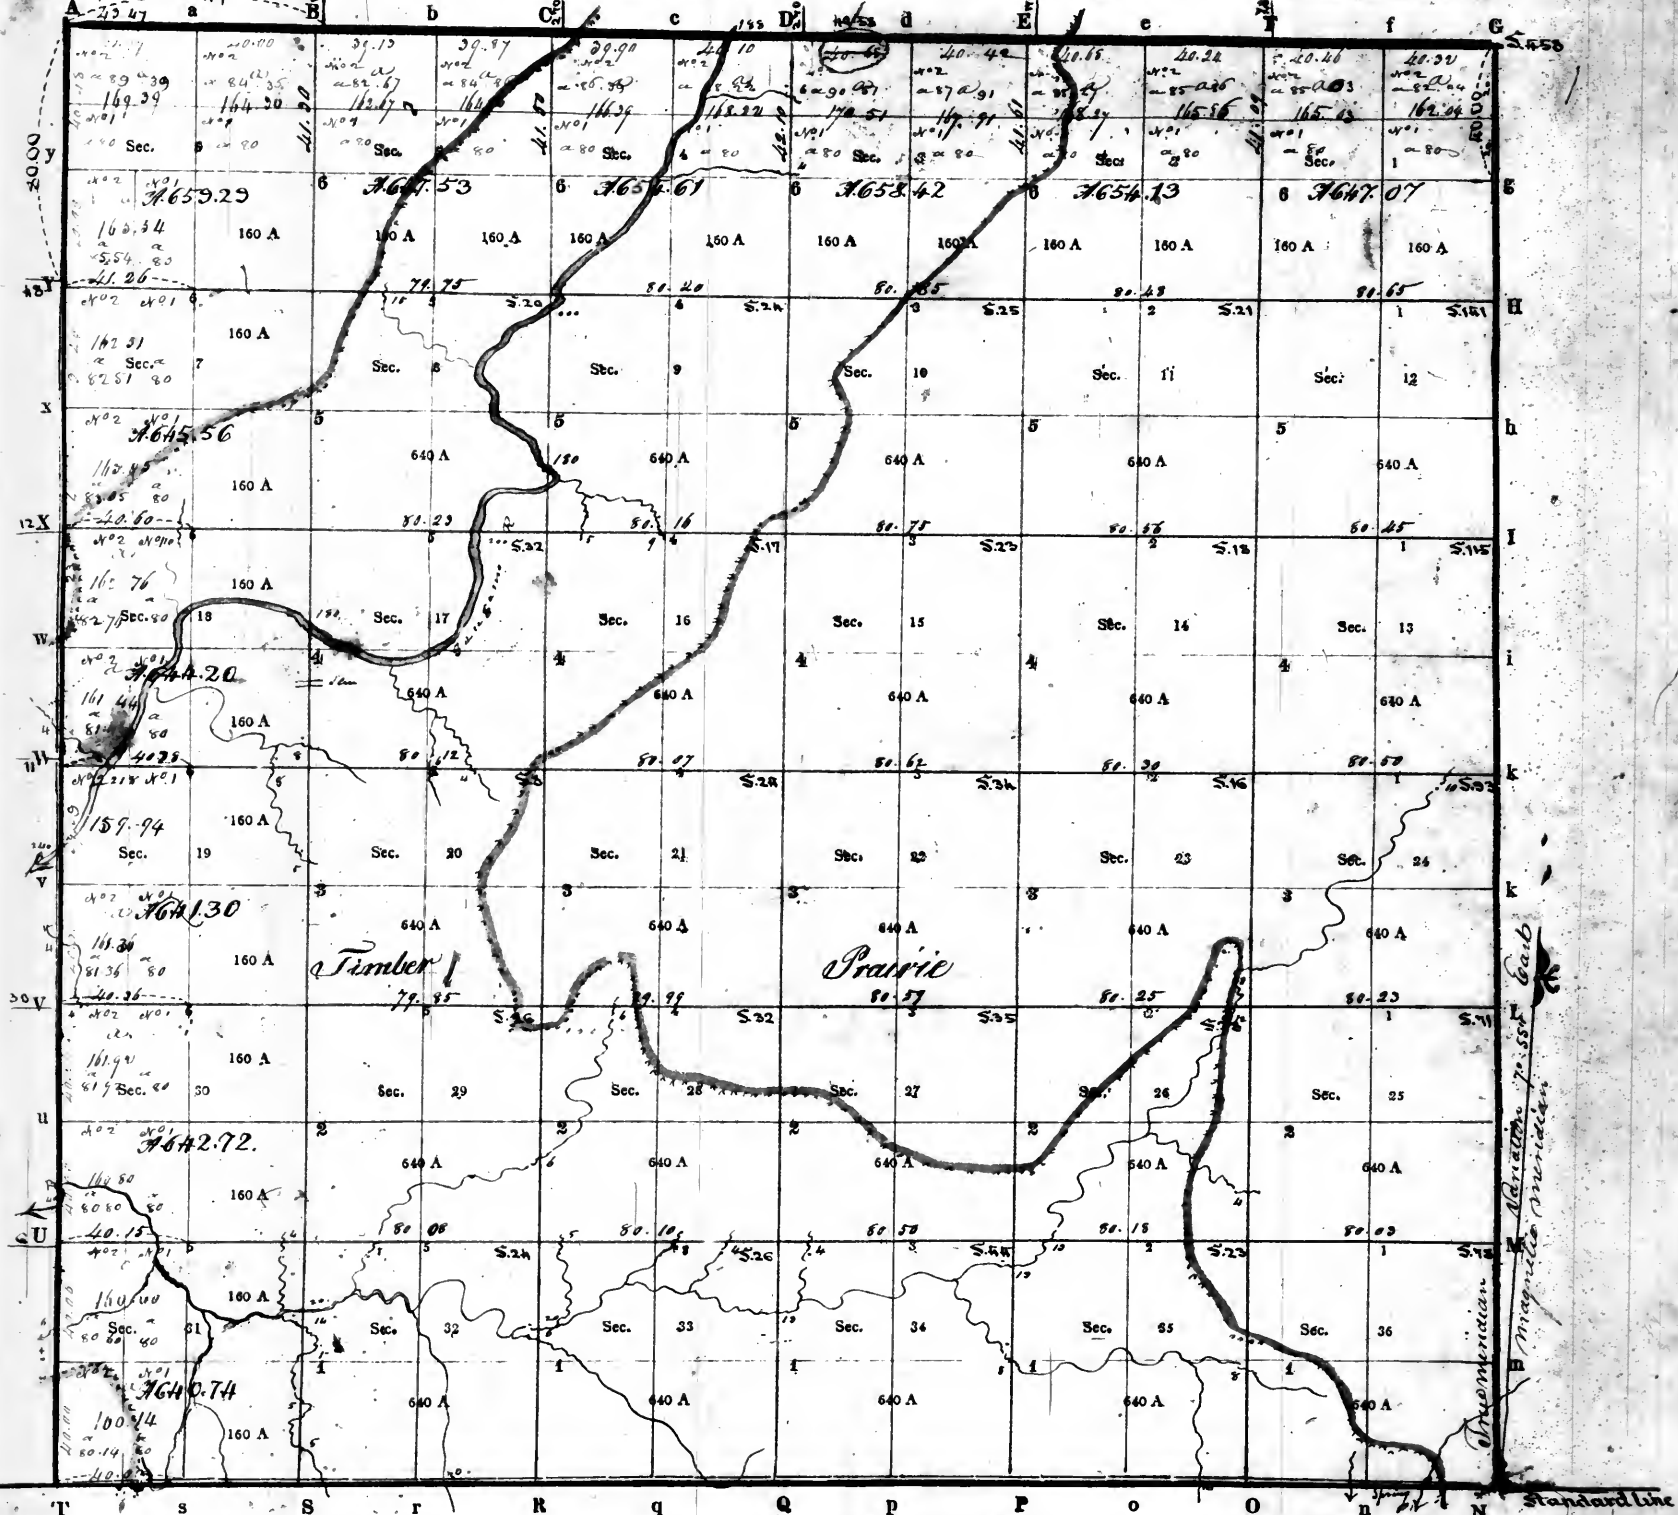

Aggregate area: 23135.57 acres

PURSUANT to a contract with, and instructions from William Rector, Surveyor of the lands of the United States in the State of Illinois, bearing date the thirtieth day of February 1822, I have admeasured, laid out and surveyed the above described Township; and do hereby certify, that it had such marks and bounds, both natural and artificial, as are represented on said plat, and described in the field notes made thereof, and returned with this plat into the Office of the Surveyor of the Lands of the United States, in the State of Illinois, Michigan Territory of Arkansas.

Certified this fourth day of March 1823

Wm Rector
D. SURVEYOR.


EXAMINED.

Records

420.


Township No. 14 North of the base line, Range No. 8 East of the Third principal Meridian.

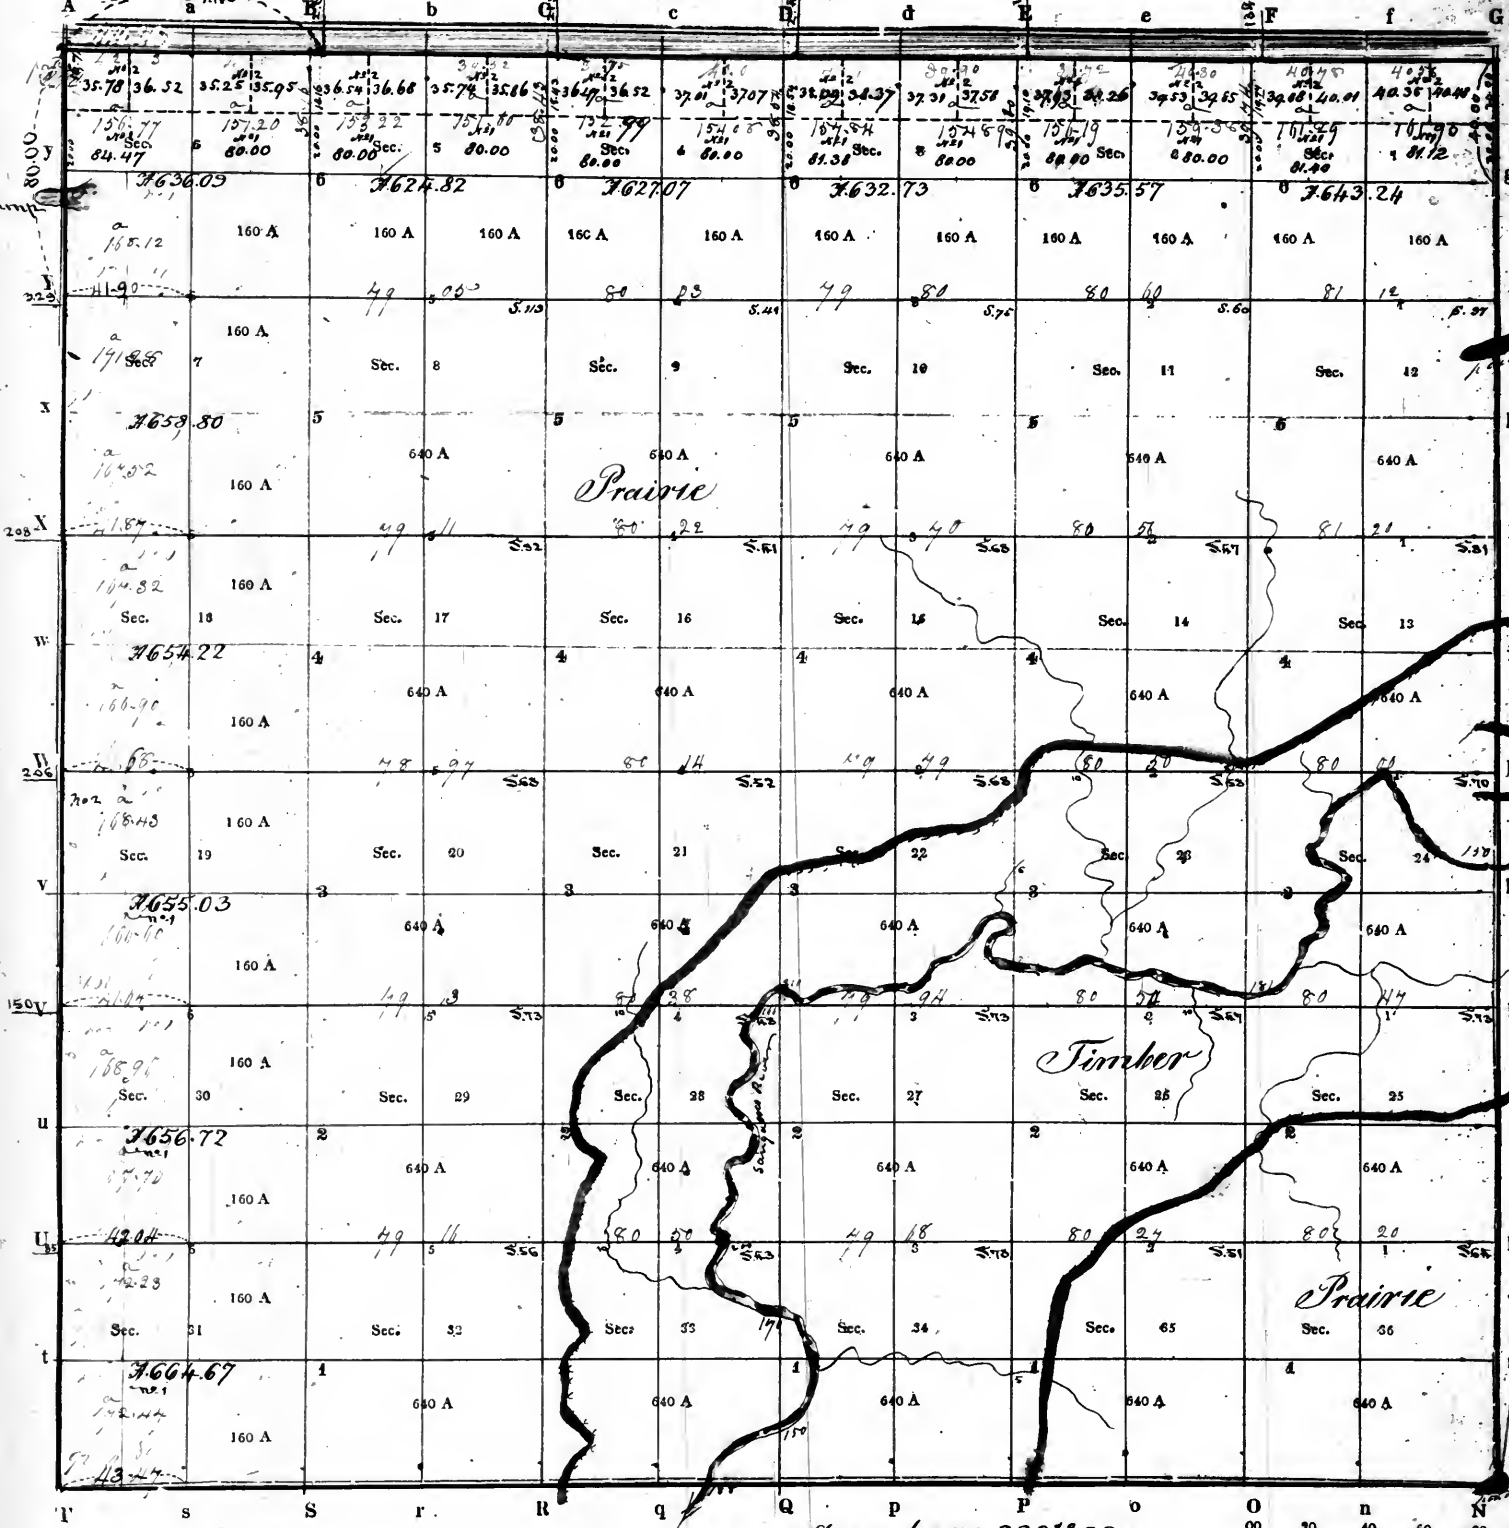

Surveyor's office
St. Louis, Mo. June 1st 1882
The North halves of sections 1, 2, 3, 4, 5 & 6 subdivided
and a plat sent to the Register
and another to the Commissioner
of the General Land Office

Aggregate area - 23088.96 ac

Scale of 40 Chains to an inch.

PURSUANT to a contract with, and instructions from William Rector, Surveyor of the lands of the United States in the State of Illinois bearing date the nineteenth day of February 1882 I have measured, laid out and surveyed the above described Township; and do hereby certify, that it had such marks and bounds, both natural and artificial, as are represented on said plat, and described in the field notes made thereof, and returned with this plat into the Office of the Surveyor of the Lands of the United States, in the State of Illinois, Missouri and Territory of Arkansas.


Certified this first day of March 1883

EXAMINED.

W. Rector SURVEYOR.

Revised

421.

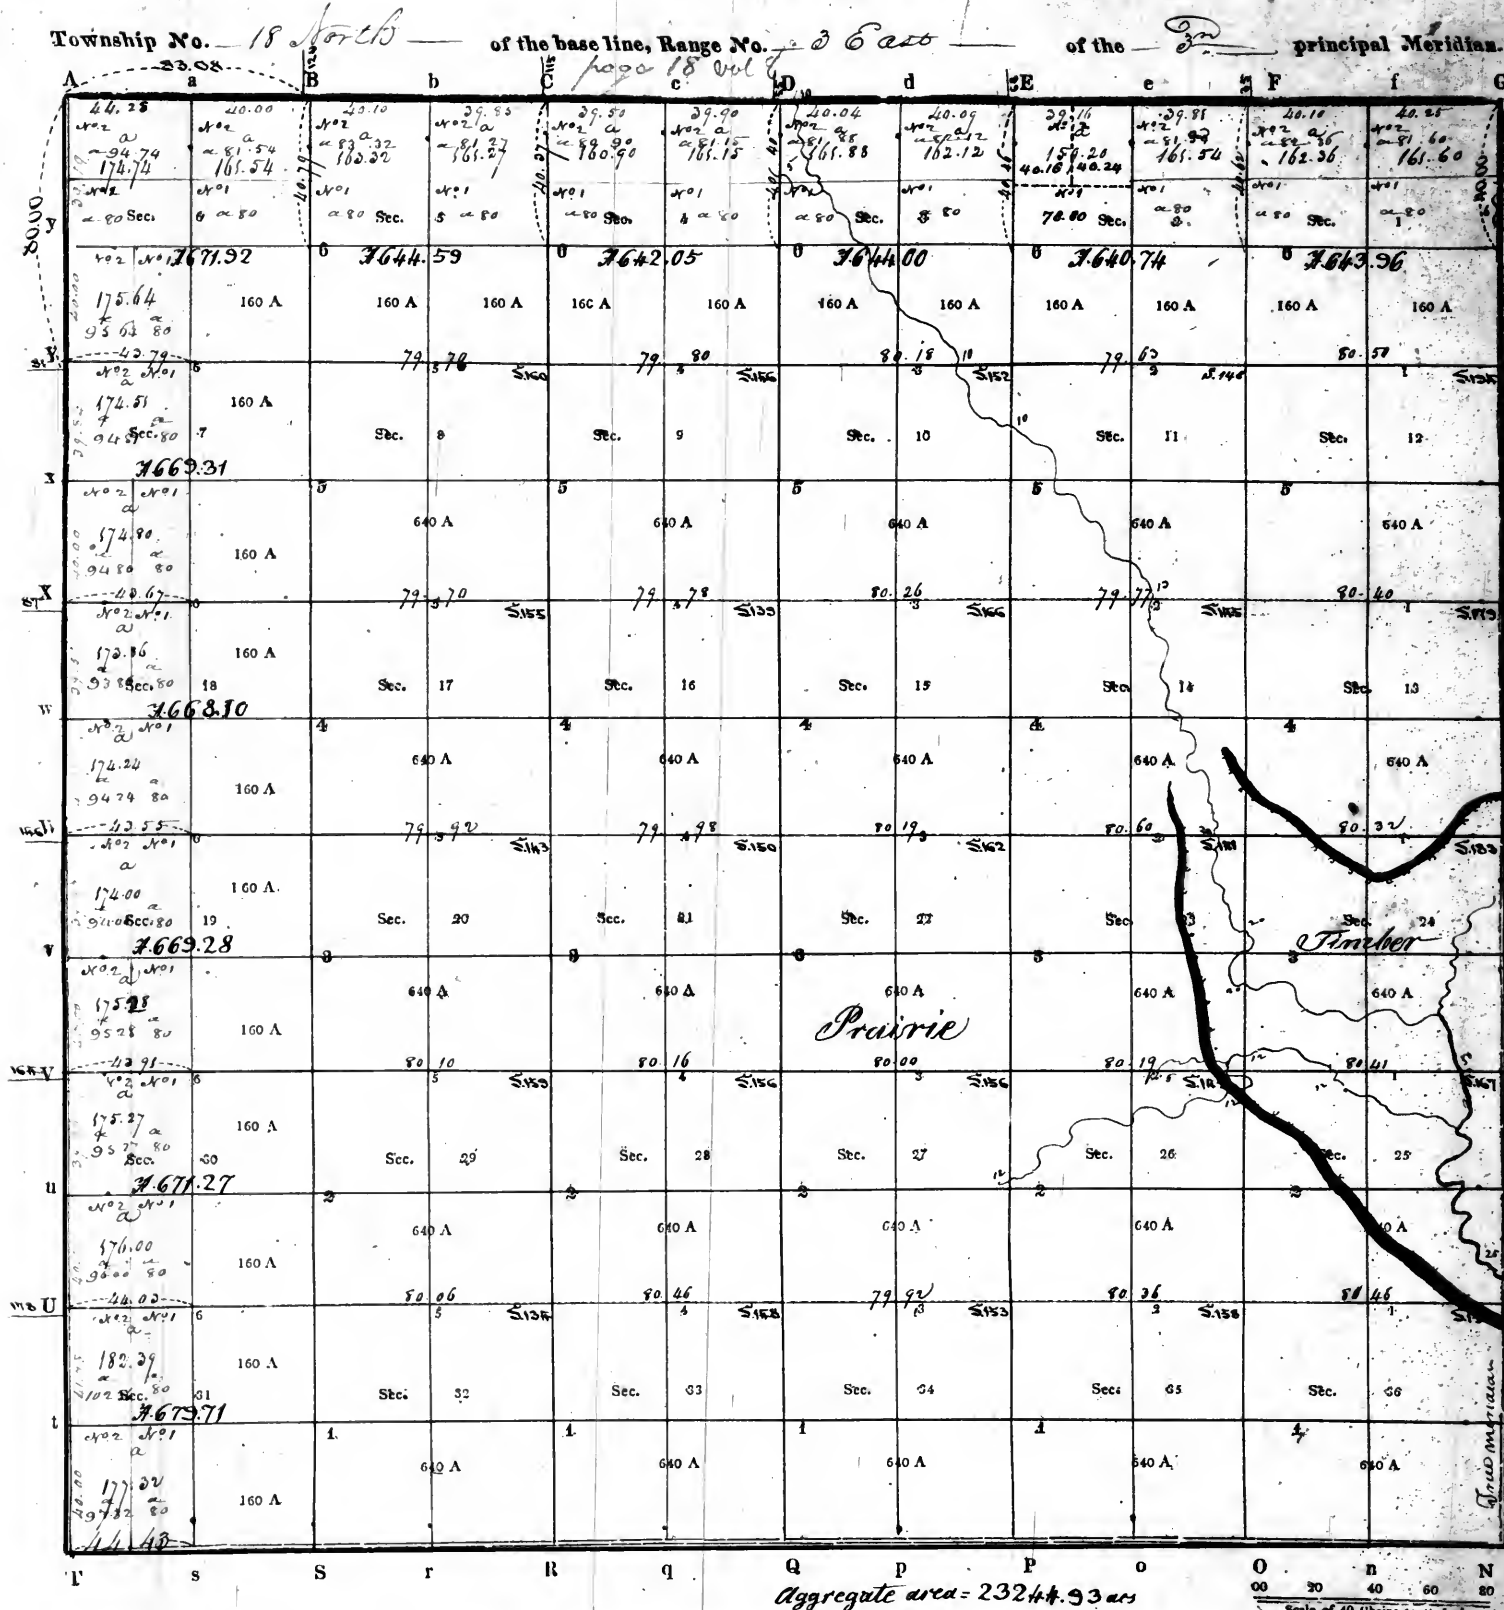

PURSUANT to a contract with, and instructions from William Rector, Surveyor of the lands of the United States in the State of Illinois, bearing date the Nineteenth day of February, 1882, I have measured, laid out and surveyed the above described Township; and do hereby certify, that it had such marks and bounds, both natural and artificial, as are represented on said plat, and described in the field notes made thereof, and returned with this plat into the Office of the Surveyor of the Lands of the United States, in the State of Illinois, Missouri and Territory of Arkansas.

Certified this first day of March, 1883


Wm Rector D. SURVEYOR

EXAMINED.

Recorded

422.

Township No. 19 North of the base line, Range No. 3 East of the principal Meridian.

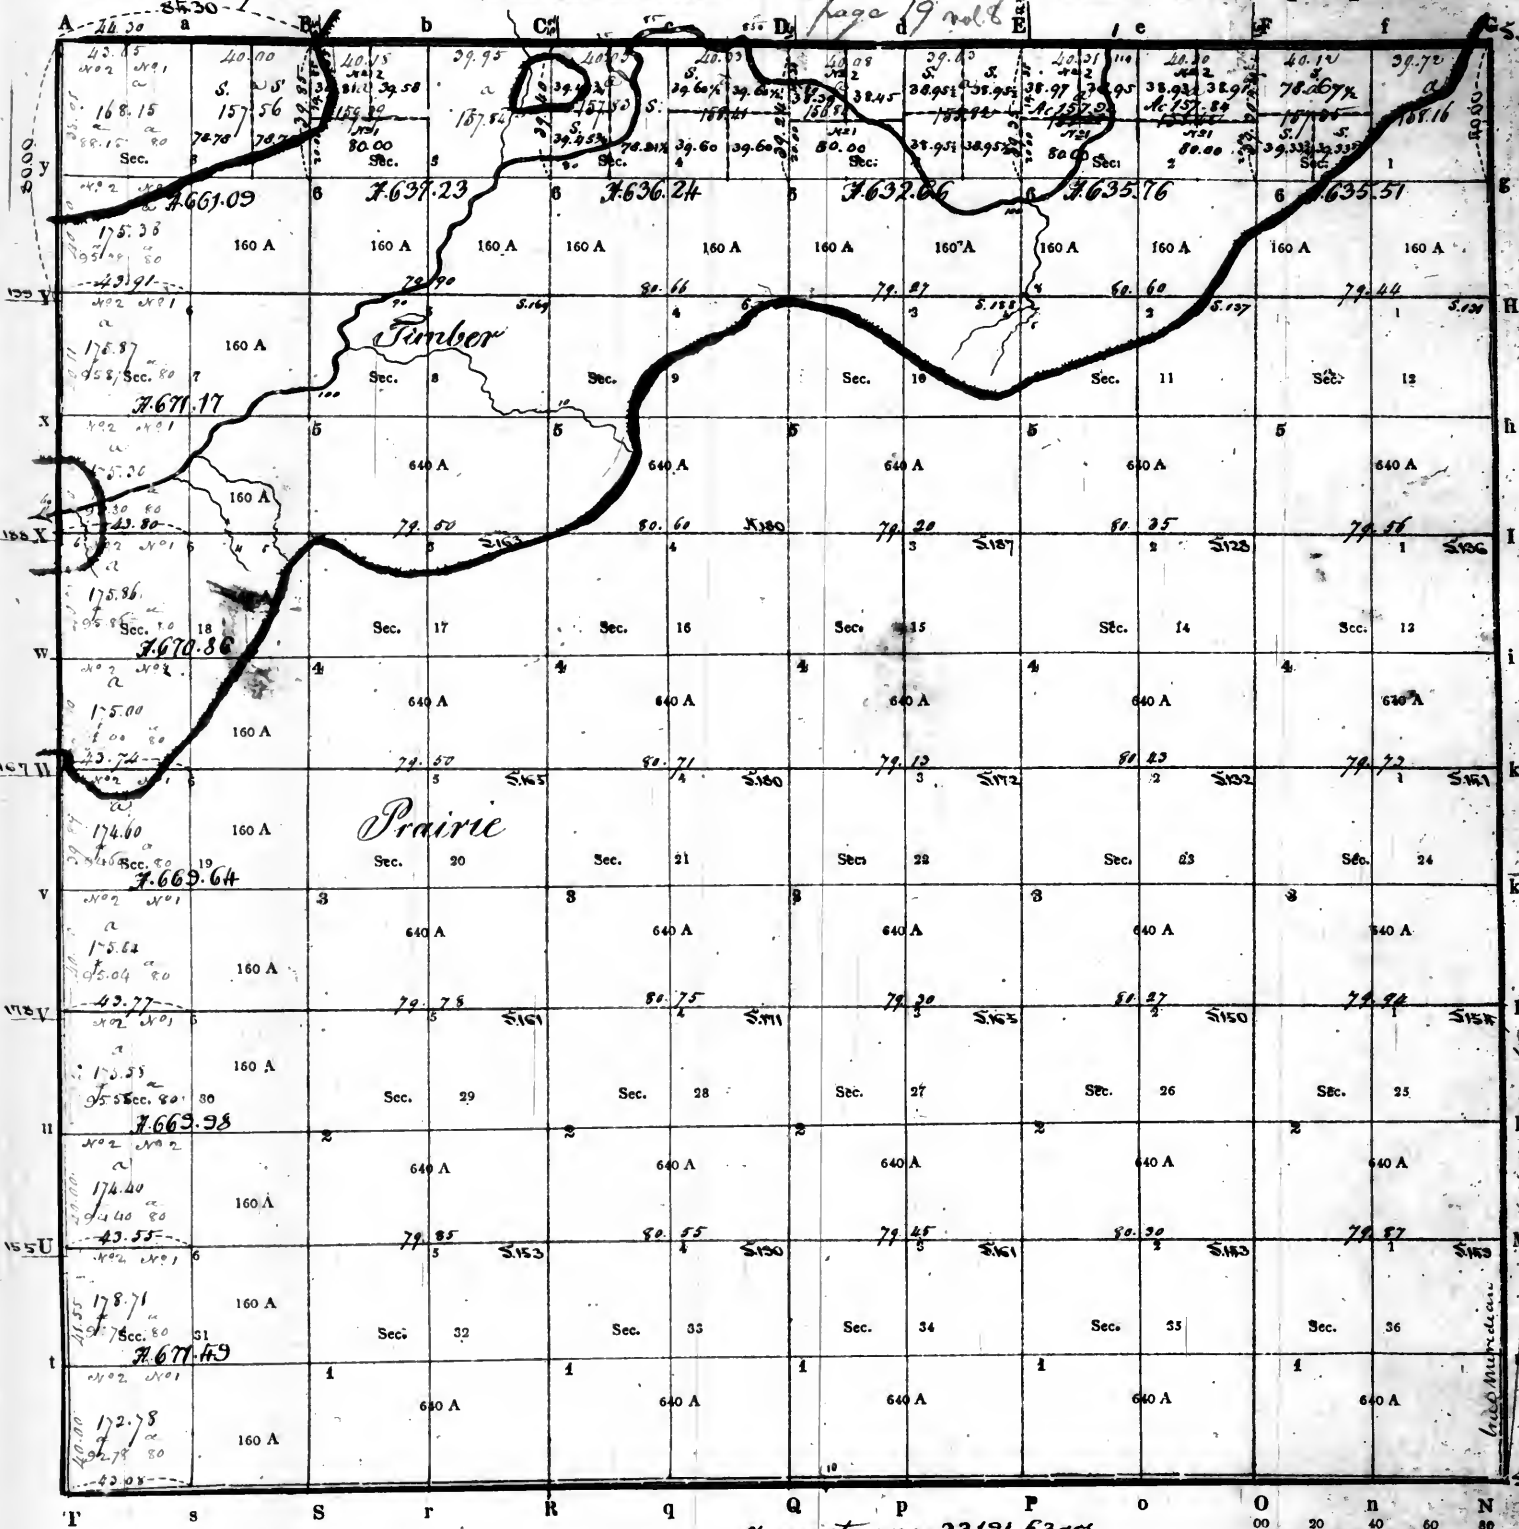

Surveyor's office,
Saint Louis, July 13 1882.
Subscribed under the act of Congress
of the 5th of April 1820, North
of section 2, NW 1/4 of sec 20
subdivided so as to conform to
to the Division of the
General Land Office on the
same day

Magazine Meridian 77° 55' 30" East


5500 30

PURSUANT to a contract with, and instructions from William Reector, Surveyor of the lands of the United States in the State of Illinois
I have measured, laid out and surveyed the above described Township; and do hereby certify, that it had such marks and bounds, both natural and artificial,
as are represented on said plat, and described in the field notes, made thereof, and returned with this plat into the Office of the Surveyor of the Lands of the
United States, in the State of Illinois (Missouri and Territory of Arkansas)
Certified this 1st day of May 1882
EXAMINED.
Wm. Reector
D. SURVEYOR.

Reunited

423.

Township No. *Twenty North* of the base line, Range No. *Three East* of the *Third* principal Meridian.

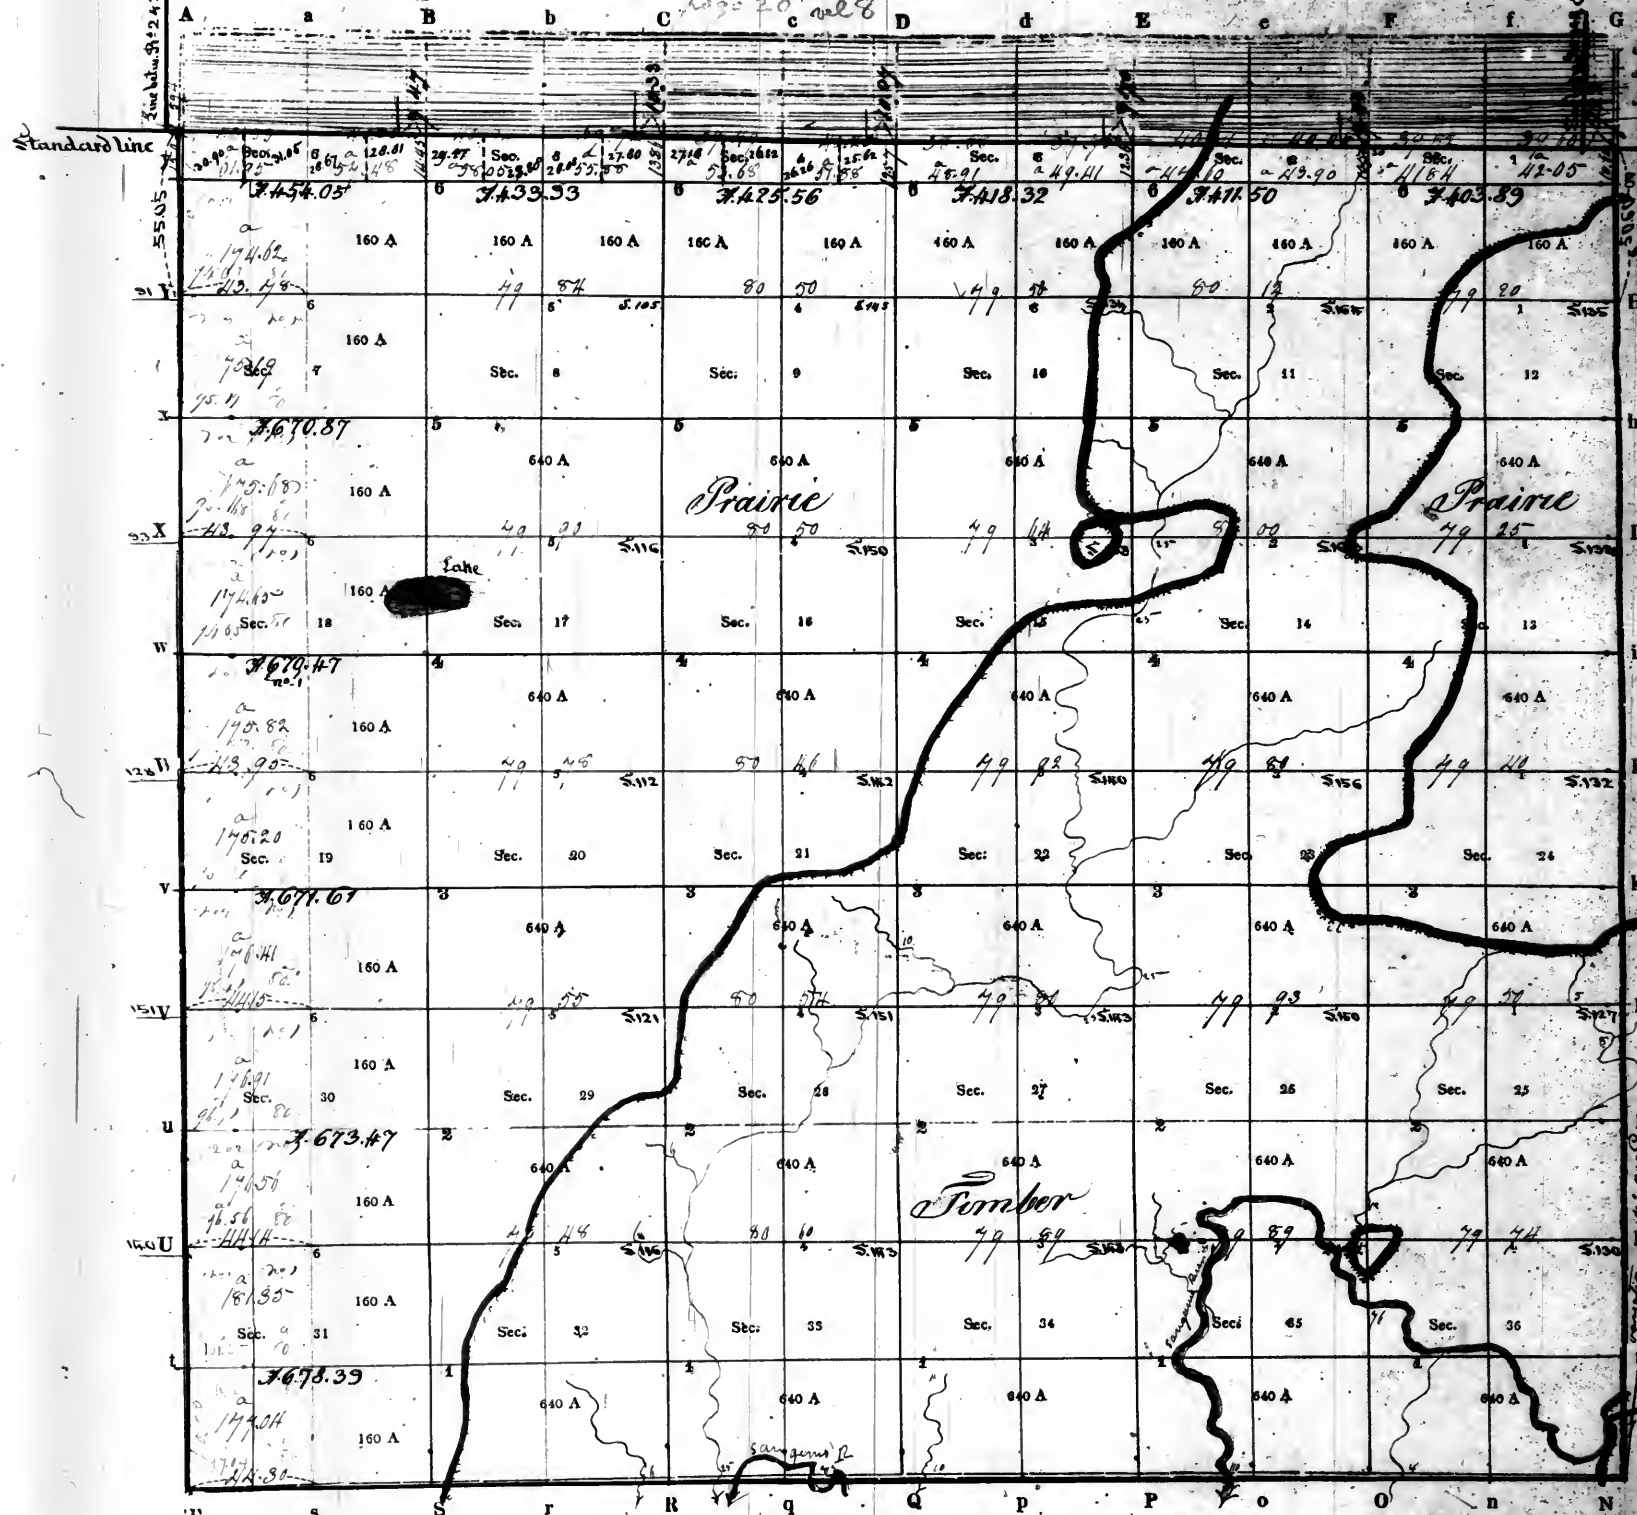

Aggregate area = 21942.06 acres

PURSUANT to a contract with, and instructions from William Rector, Surveyor of the lands of the United States in the State of Illinois, bearing date the *fourteenth* day of *January* 1882, I have measured, laid out and surveyed the above described Township; and do hereby certify, that it had such marks and bounds, both natural and artificial, as are represented on said plat, and described in the field notes made thereof, and returned with this plat into the Office of the Surveyor of the Lands of the United States, in the State of Illinois.


Certified this *fourth* day of *March* 1883

EXAMINED.

Wm Rector SURVEYOR.

Reviewed

Township 21 North of the Base line Range 3 East of the 3rd principal Meridian

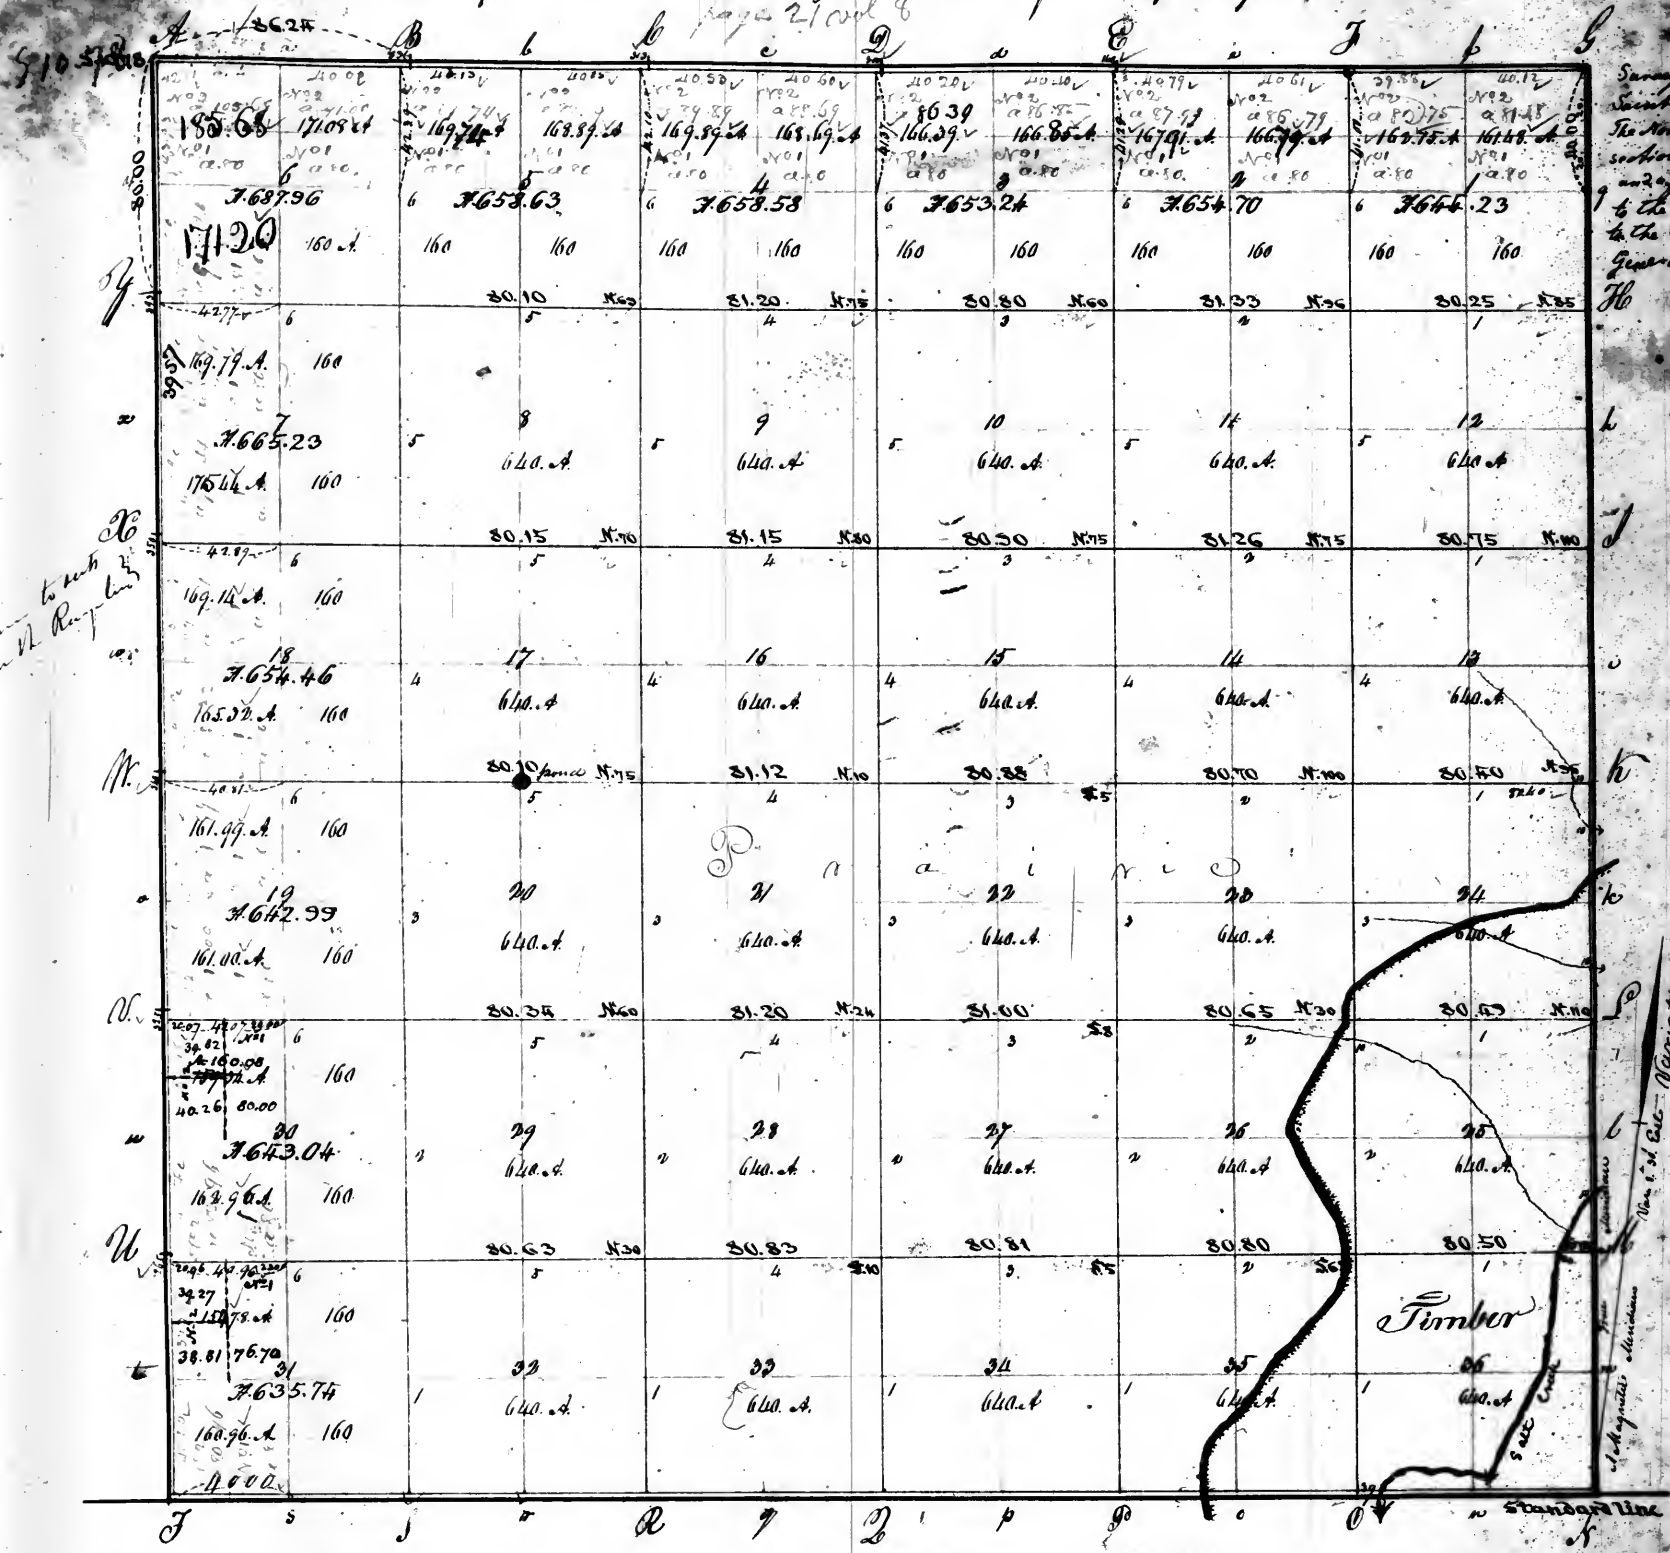

Aggregate area = 23198.80 ac.

Pursuant to a contract with and instructions from William Reiter, Surveyor of the lands of the United States in the States of Illinois & Missouri and Territory of Arkansas, bearing date the Eleventh day of June, one thousand eight hundred and Twenty Three, I have examined laid out and surveyed the above described Township, and its sub-division marks and bounds; both Natural and artificial, as are described on said plat, and described in the field notes made thereof, and returned with this plat into the office of the Surveyor of the lands of the United States in the States of Illinois & Missouri and Territory of Arkansas—

Certified this fifth day of April 1834:


Examiners
Wm. R.
Surveyor of lands

Beal Greenup, Deft. Surveyor

Recorded

Township N. 22 North of the Base line Range N. 3 East of the 2nd principal Meridian

page 22 vol 8

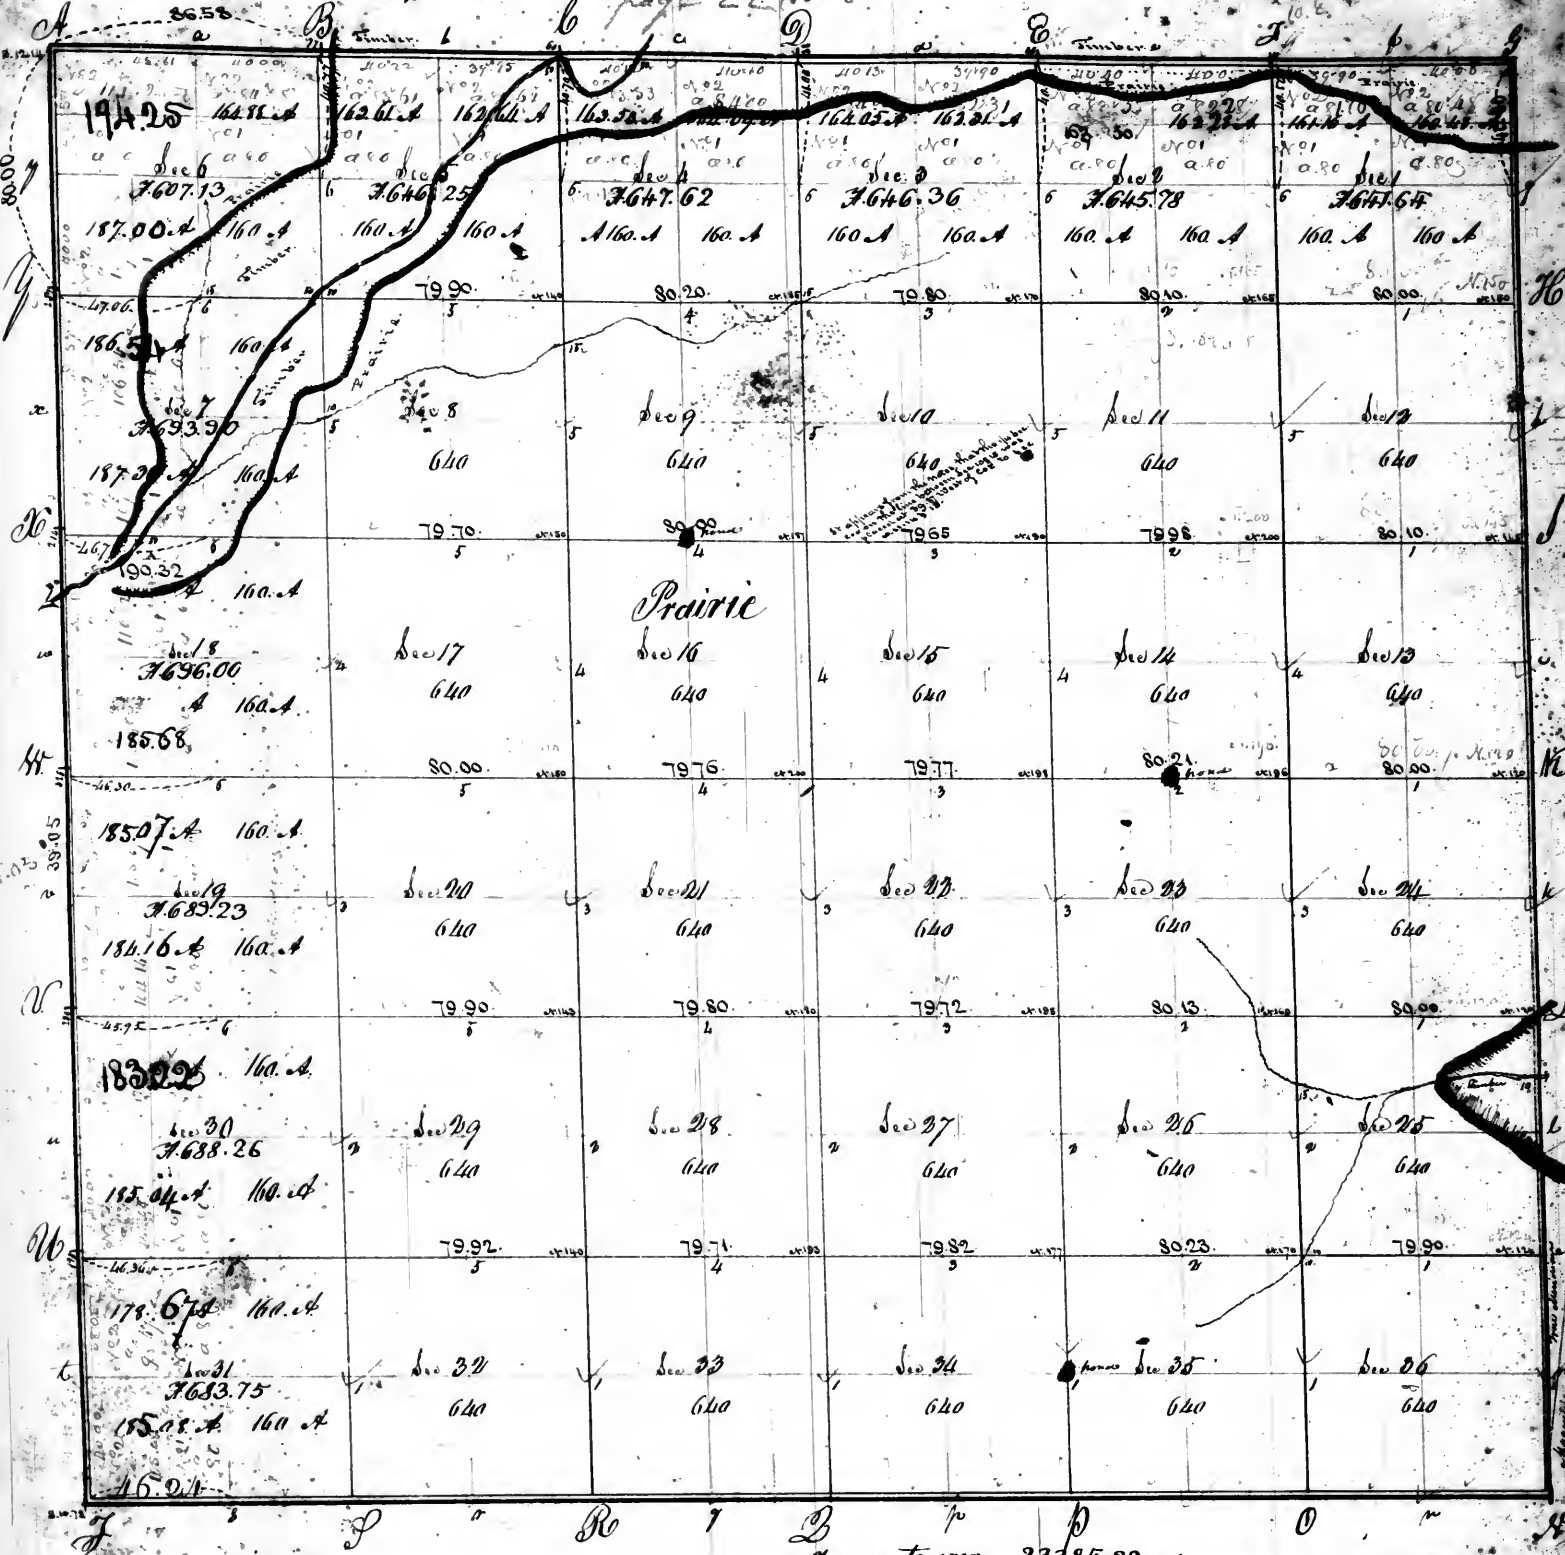

Aggregate area - 23384.32 acs

Pursuant to a contract with and instructions from William Potter, Surveyor of the lands of the United States in the States of Illinois & Missouri and Territory of Arkansas, bearing date the Eleventh day of June 1833 I have examined, laid out and surveyed the above described Township, and do hereby certify that it has such Marks and boundaries both Natural and artificial as are represented on said plat, and as described in the field notes made thereby, and returned with this plat into the office of the Surveyor of the lands of the United States, for the States of Illinois & Missouri and Territory of Arkansas —
Certified this fifth day of April 1834 —

Brace Grunup - Deft. Surveyor


Surveyors Office
St. Louis 3rd April 1834

The above plat of Twp. 22 N. Range 3 E. of the 2nd Meridian is conformable to the notes of the Survey of said Township on file in the office of the Surveyor of the Lands of the United States for the States of Illinois & Missouri and Territory of Arkansas.

Revised

Township N. 23 North of the Base line, Range N. 3 East of the 3rd Principal Meridian

page 23 vol 8

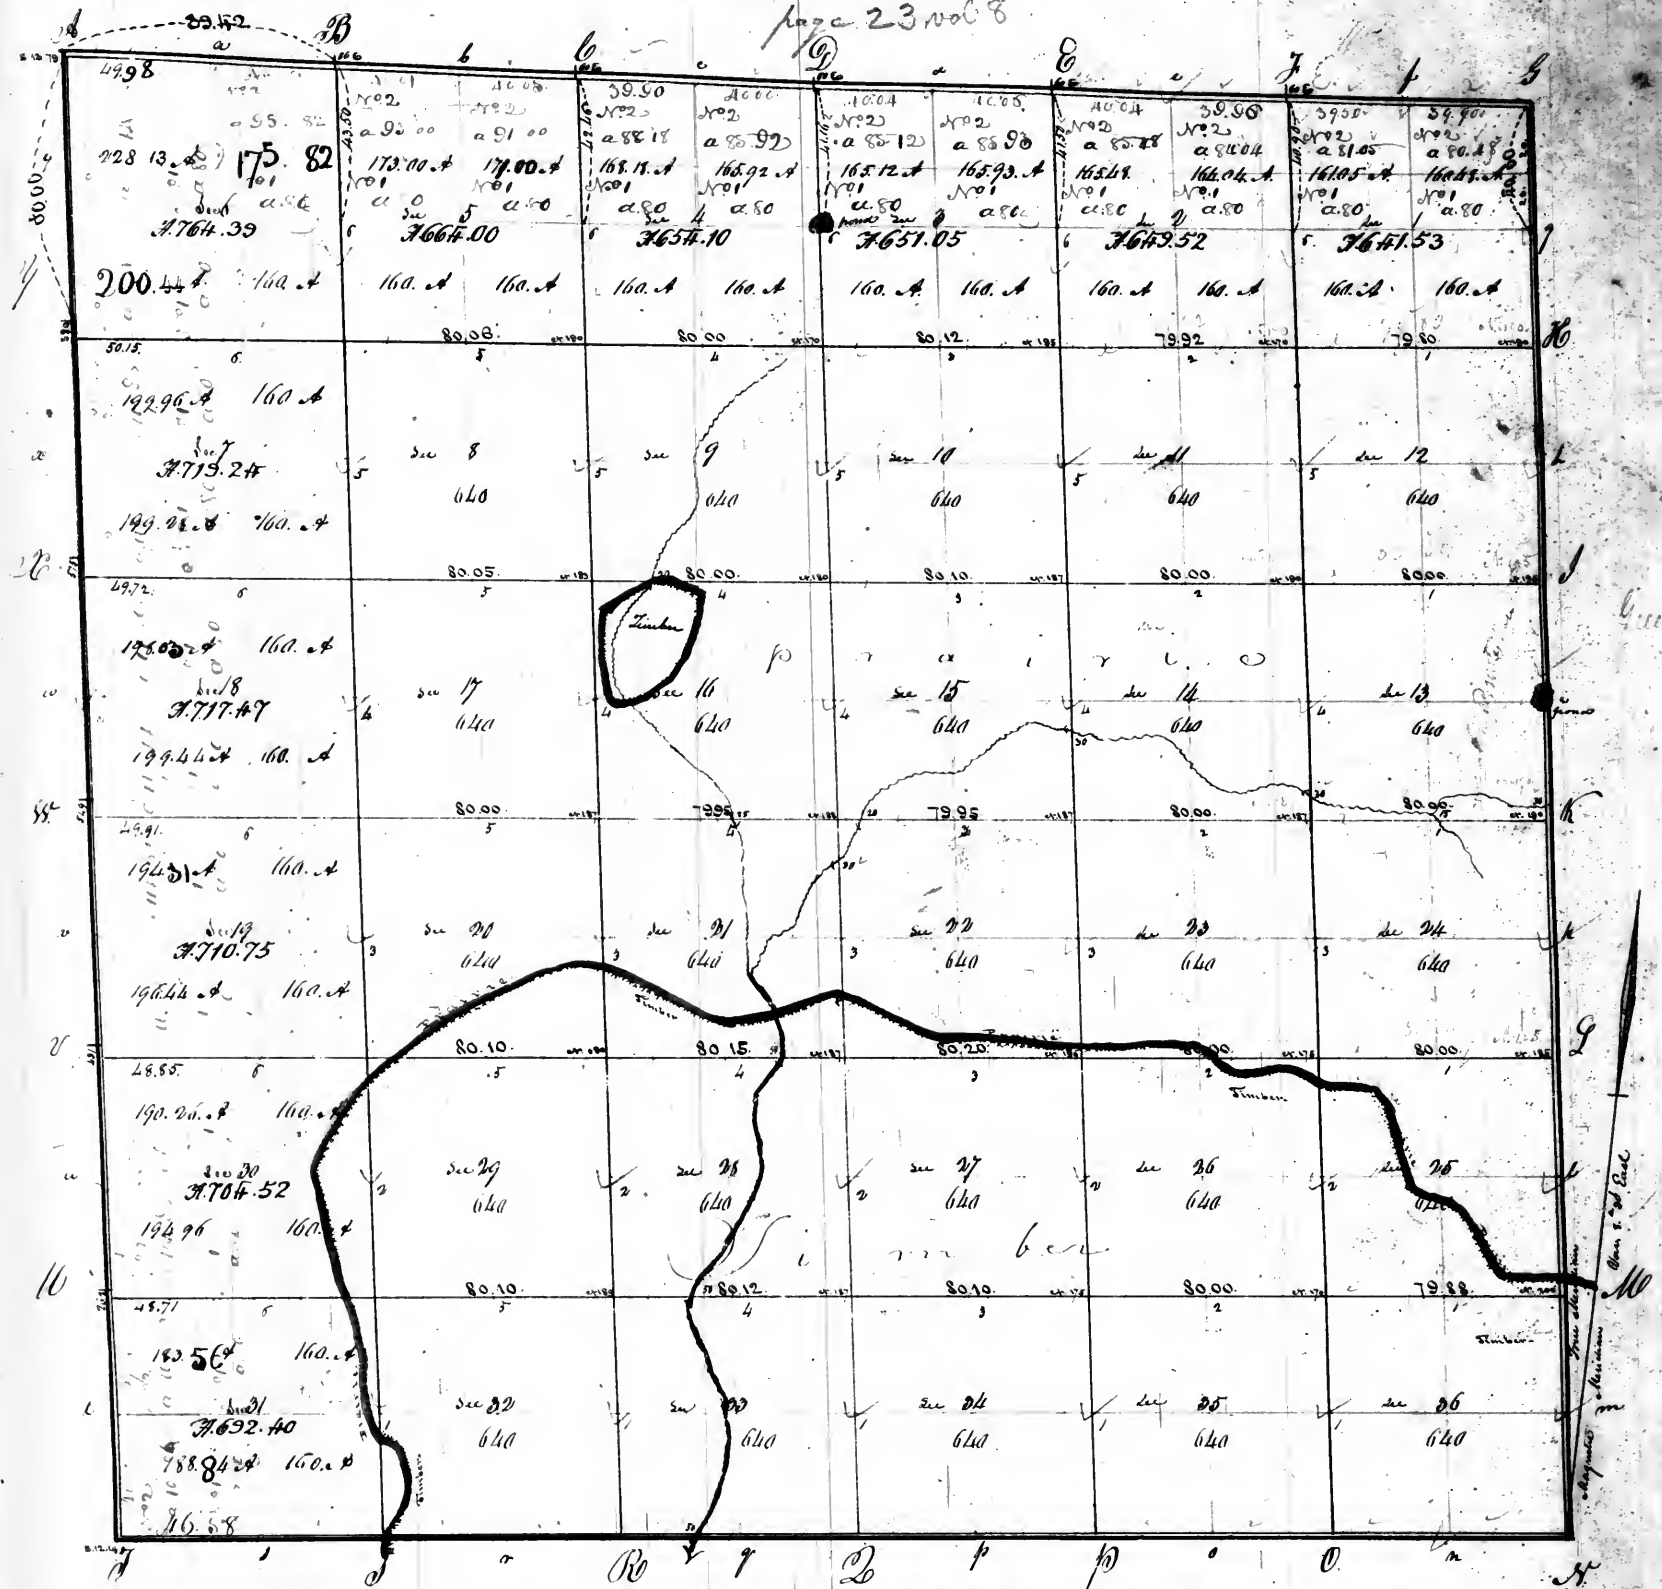

Aggregate area: 23568.37 ac

Scale of 100 Chains to an Inch

Pursuant to a contract with and instructions from William Victor Surveyor of the lands of the United States in the State of Illinois and Missouri & Territory of Arkansas, bearing date the 11th day of June 1832 I have administered said act and bearings the above described Township, and do hereby Certify, that it has been made, and bounds both Natural and artificial as are represented on said plat, and described in the field notes made thereon, and returned with this plat into the office of the Surveyor of the lands of the United States, for the State of Illinois and Missouri and Territory of Arkansas.

Certified this 5th day of April 1834—

Beas group Det Surveyor


Surveyors Office
St Louis 3rd September 1829 } The above plat of Twp. 23. N. R. 3
of the 3rd P. Meridian is conformable to the field notes of the
of said Township, on file in this Office.

Wm. R. R.

Recorded

Township N^o 24 North of the Base line, Range N^o 3 East of the 1st Principal Meridian

page 24 vol 8

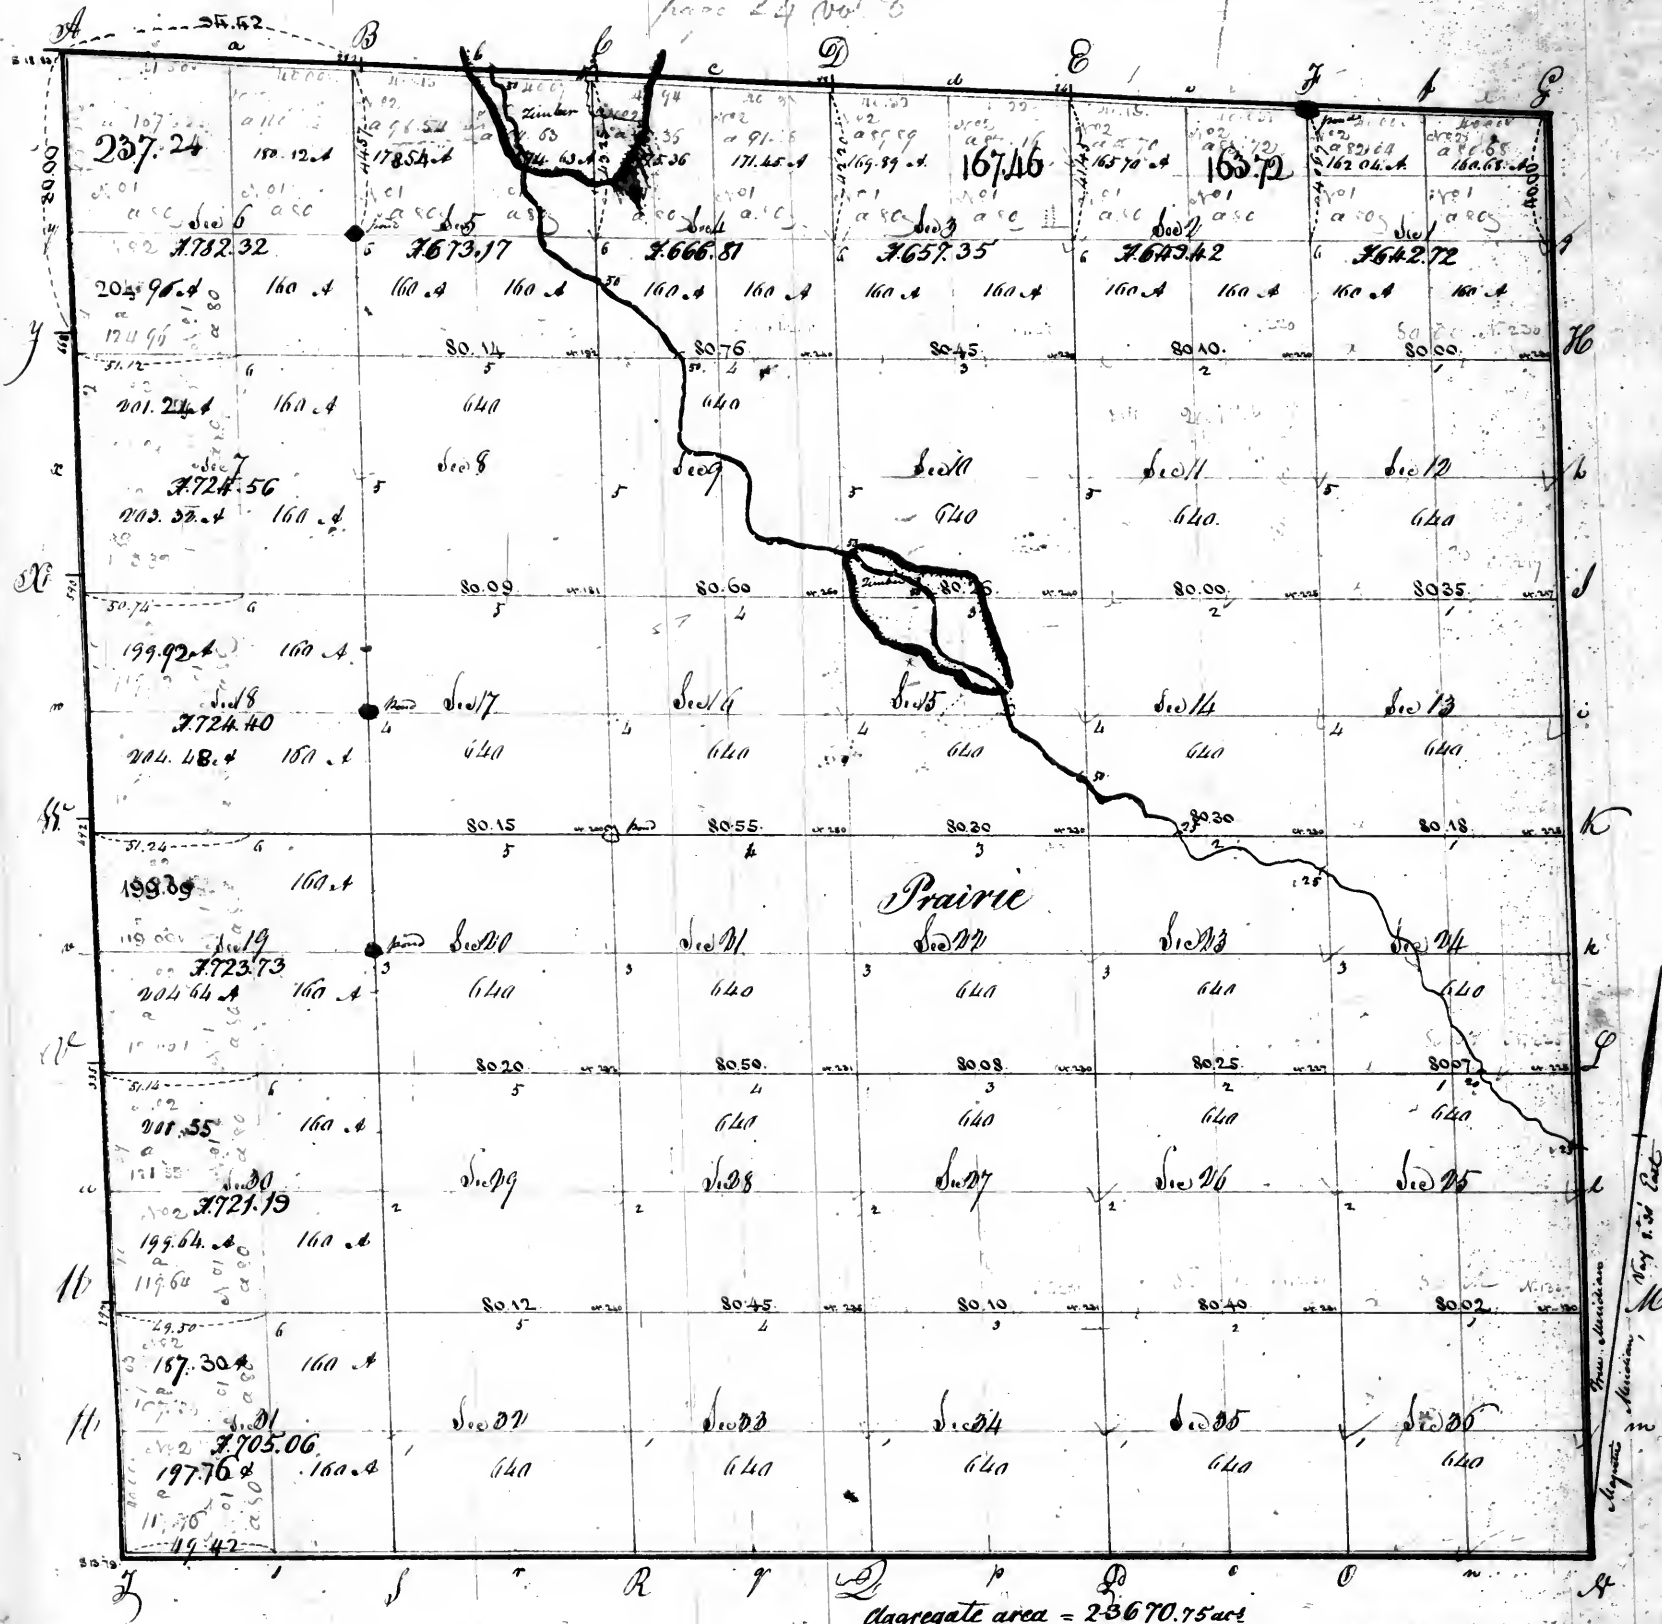

Pursuant to a contract with, and instructions from William Butler, Surveyor of the lands of the United States, in the State of Missouri & Territory of Arkansas, bearing date the Eleventh day of June one thousand eight hundred and twenty three I have examined laid out and surveyed, the above described Township, and do hereby certify that it has such marks and bounds, both natural and artificial as are represented on said plat, and described in the field notes made thereof, and returned with this plat into the office of the Surveyor of the lands of the United States, in the State of Missouri & Territory of Arkansas.

Certified this Sixth day of April 1824

Surveyors Office
St Louis 2nd Sept. 1829

Done & sworn to
Deft Surveyor

The above plat of Twp 24. N. R. 3. E. of 8th Mer. is conformable to the field notes of the survey of said Twp. on file in this Office.

Wm. M. Butler
S. of P. M. S.


Alton del



Bear Creek Sept. Swamps

1172. Roe
Scrip. pub. Lib.

715

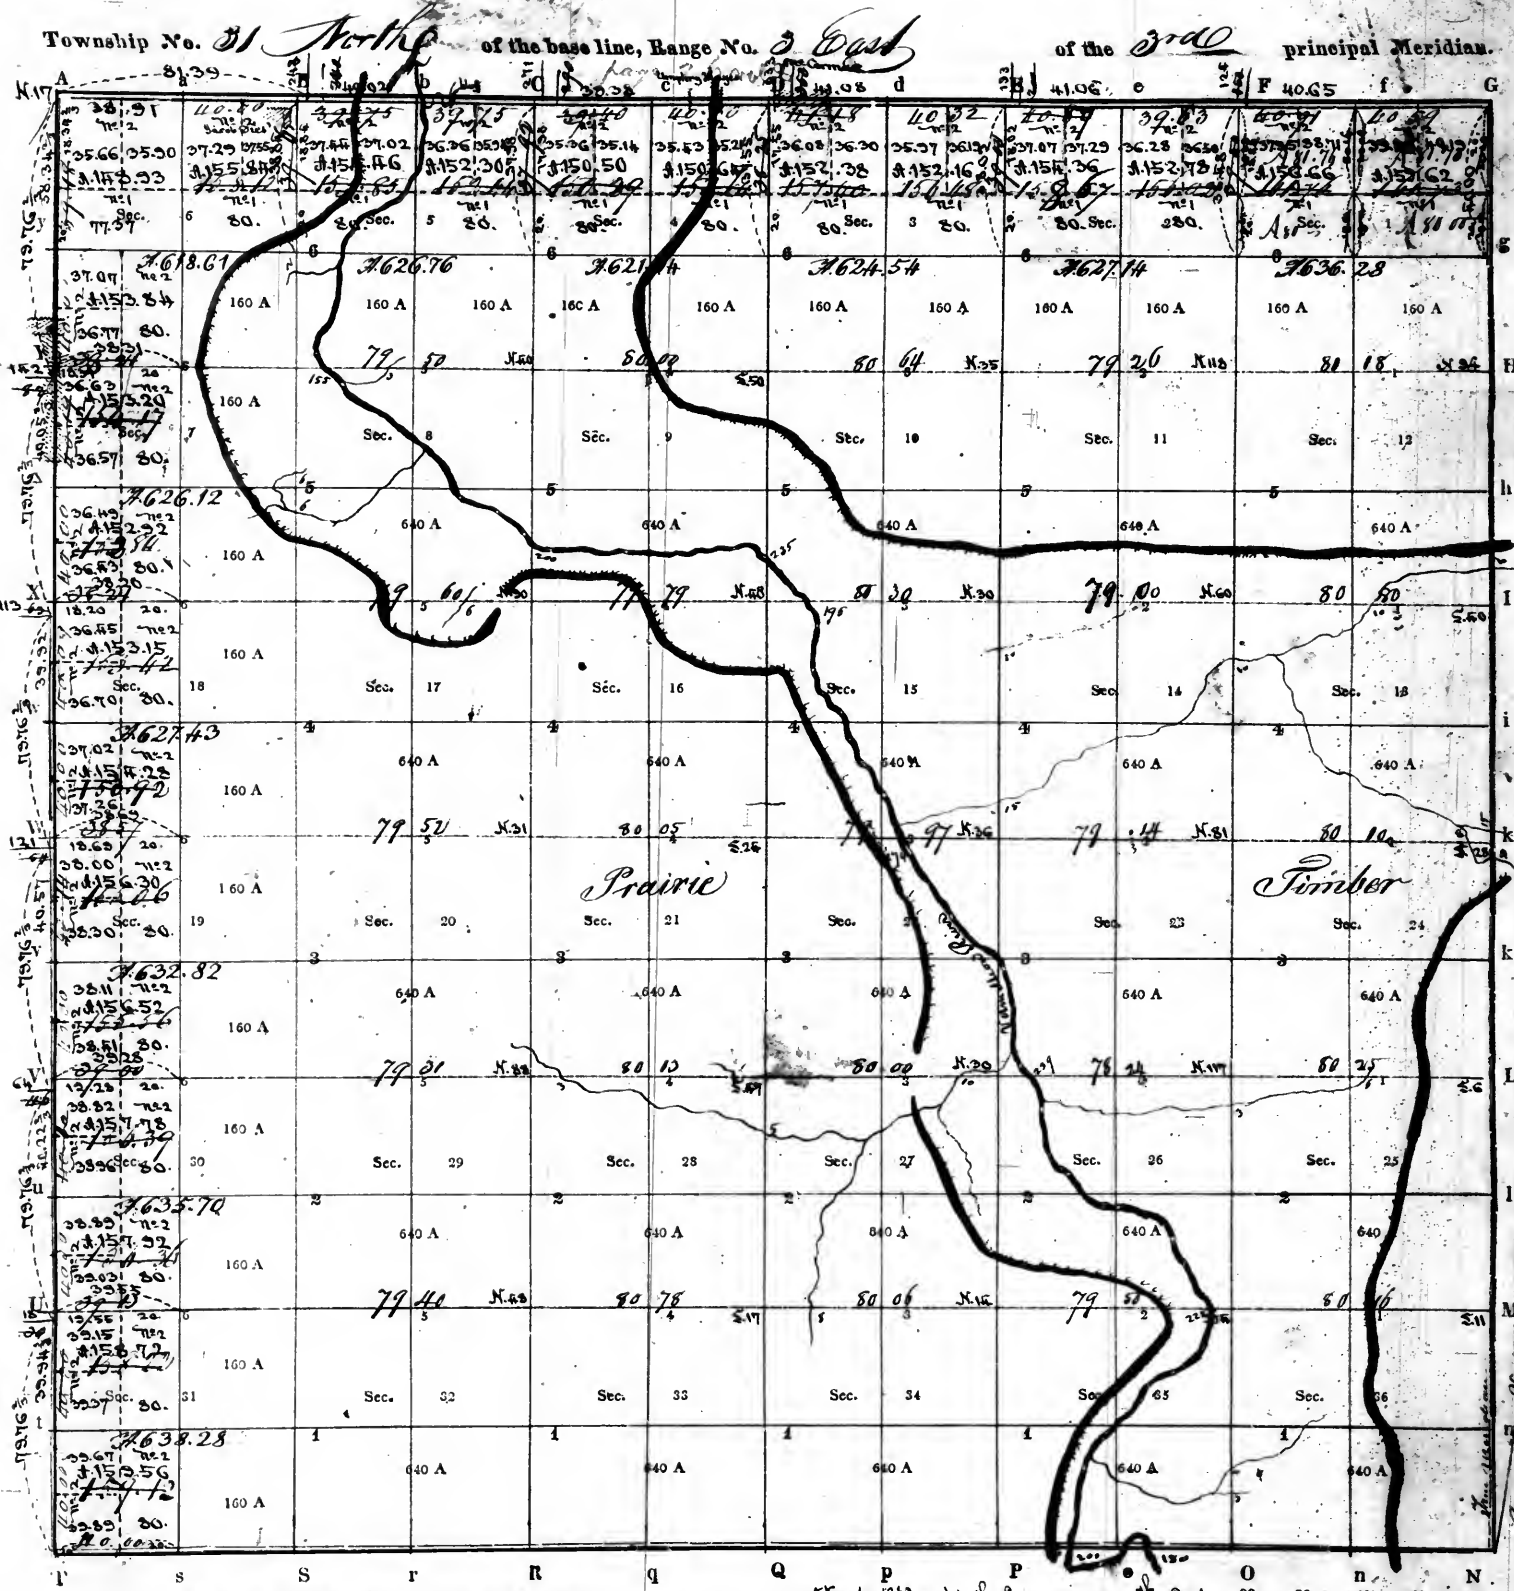

PURSUANT to a contract with, and instructions from William Rector, Surveyor of the lands of the United States in the State of Illinois, Missouri and Territory of Arkansas, I have measured, laid out and surveyed the above described Township; and do hereby certify, that it had such marks and bounds, both natural and artificial, as are represented on said plat, and described in the field notes made thereof, and returned with this plat into the Office of the Surveyor of the Lands of the United States, in the State of Illinois, Missouri and Territory of Arkansas.


Certified this _____ day of _____ 1882

EXAMINED.

D. SURVEYOR.

716

Township No. 27 North of the base line, Range No. 10 East of the 5th principal Meridian.

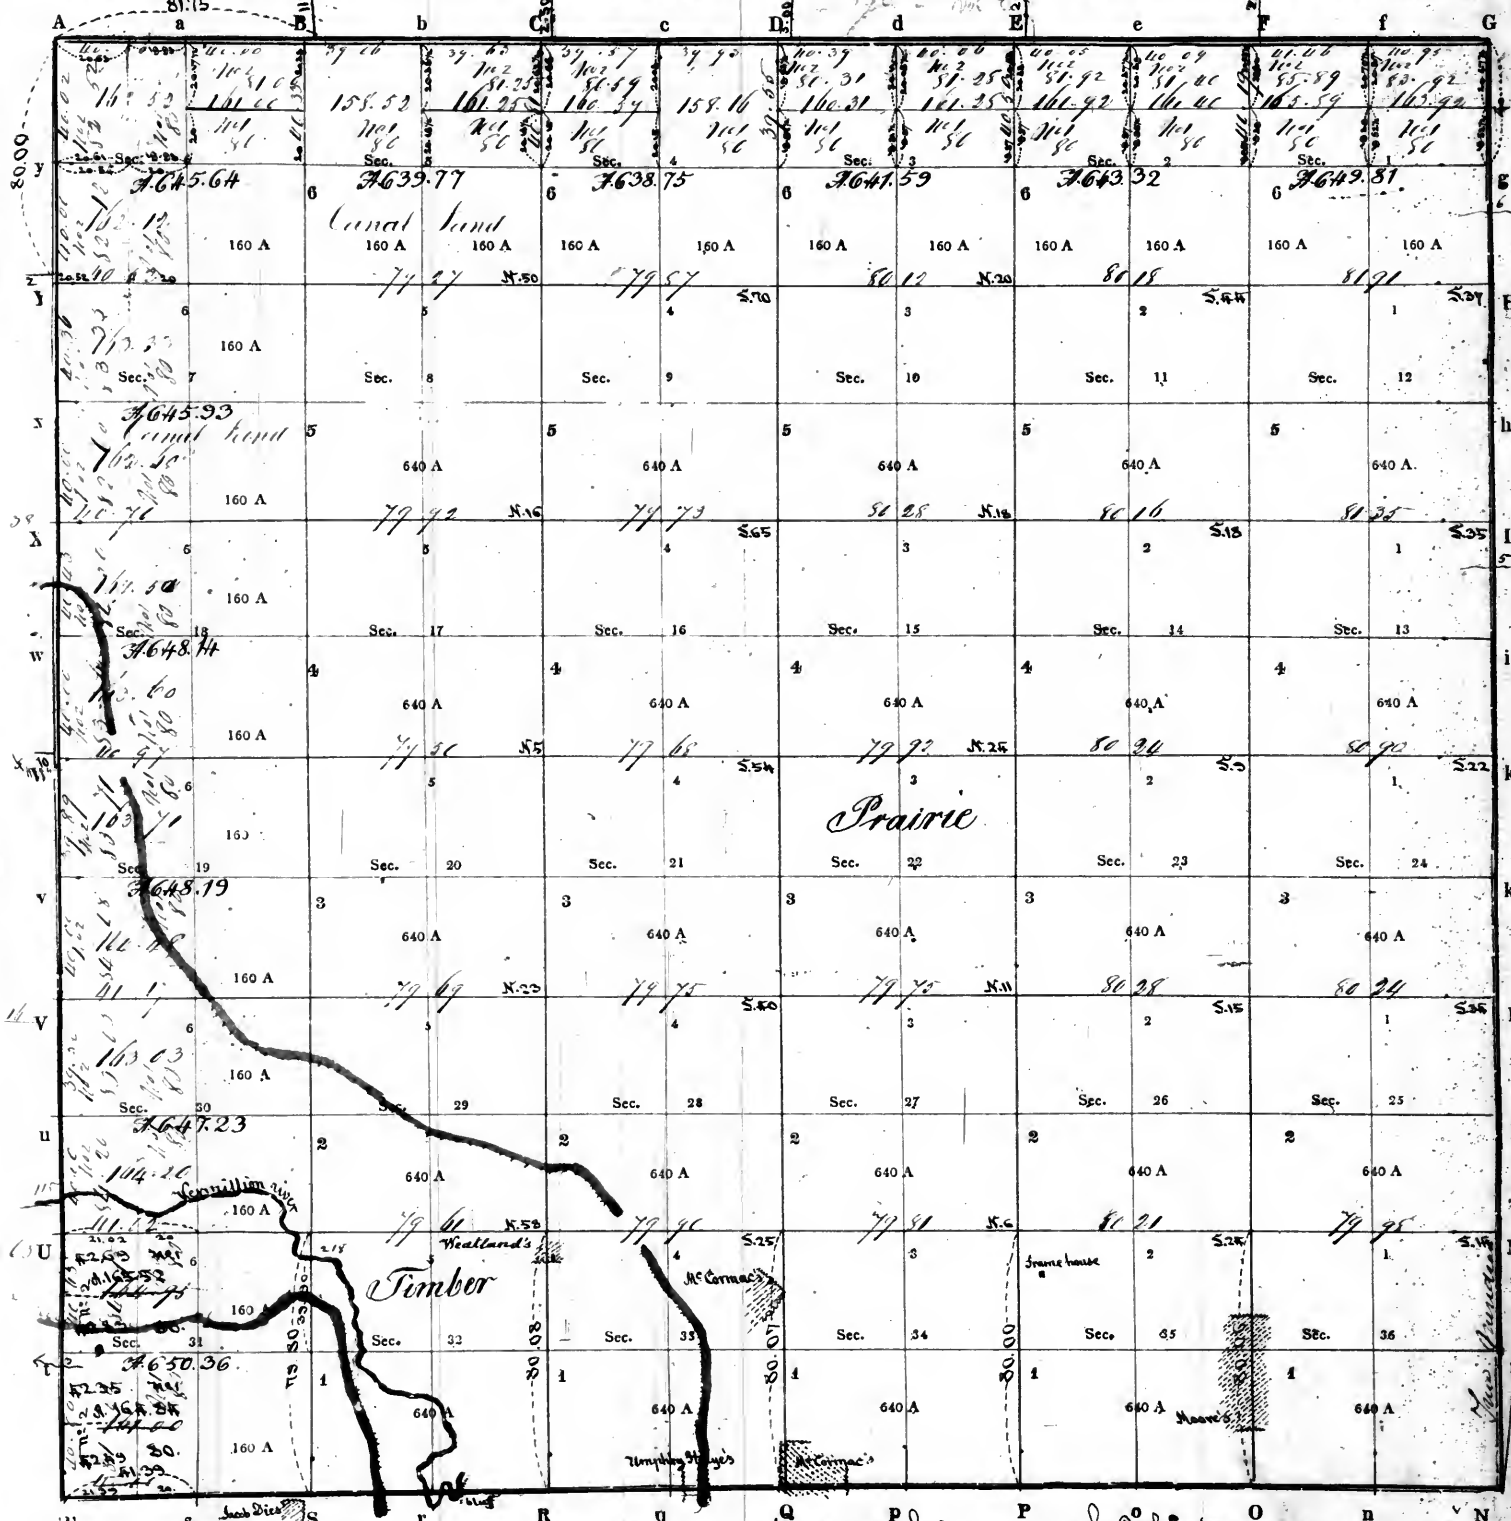


Aggregate area = 23038.73 acres

PURSUANT to a contract with, and instructions from William Rector, Surveyor of the lands of the United States in the State of Illinois, I have admeasured, laid out and surveyed the above described Township; and do hereby certify, that it had such marks and bounds, both natural and artificial, as are represented on said plat, and described in the field notes made thereof, and returned with this plat into the Office of the Surveyor of the Lands of the United States, in the State of Illinois.

Certified this day of 1882
EXAMINED.

D. SURVEYOR.

Township 1° 30' North of the Base Line Range 10 East of 3rd Principal Meridian
 page 28 vol 8

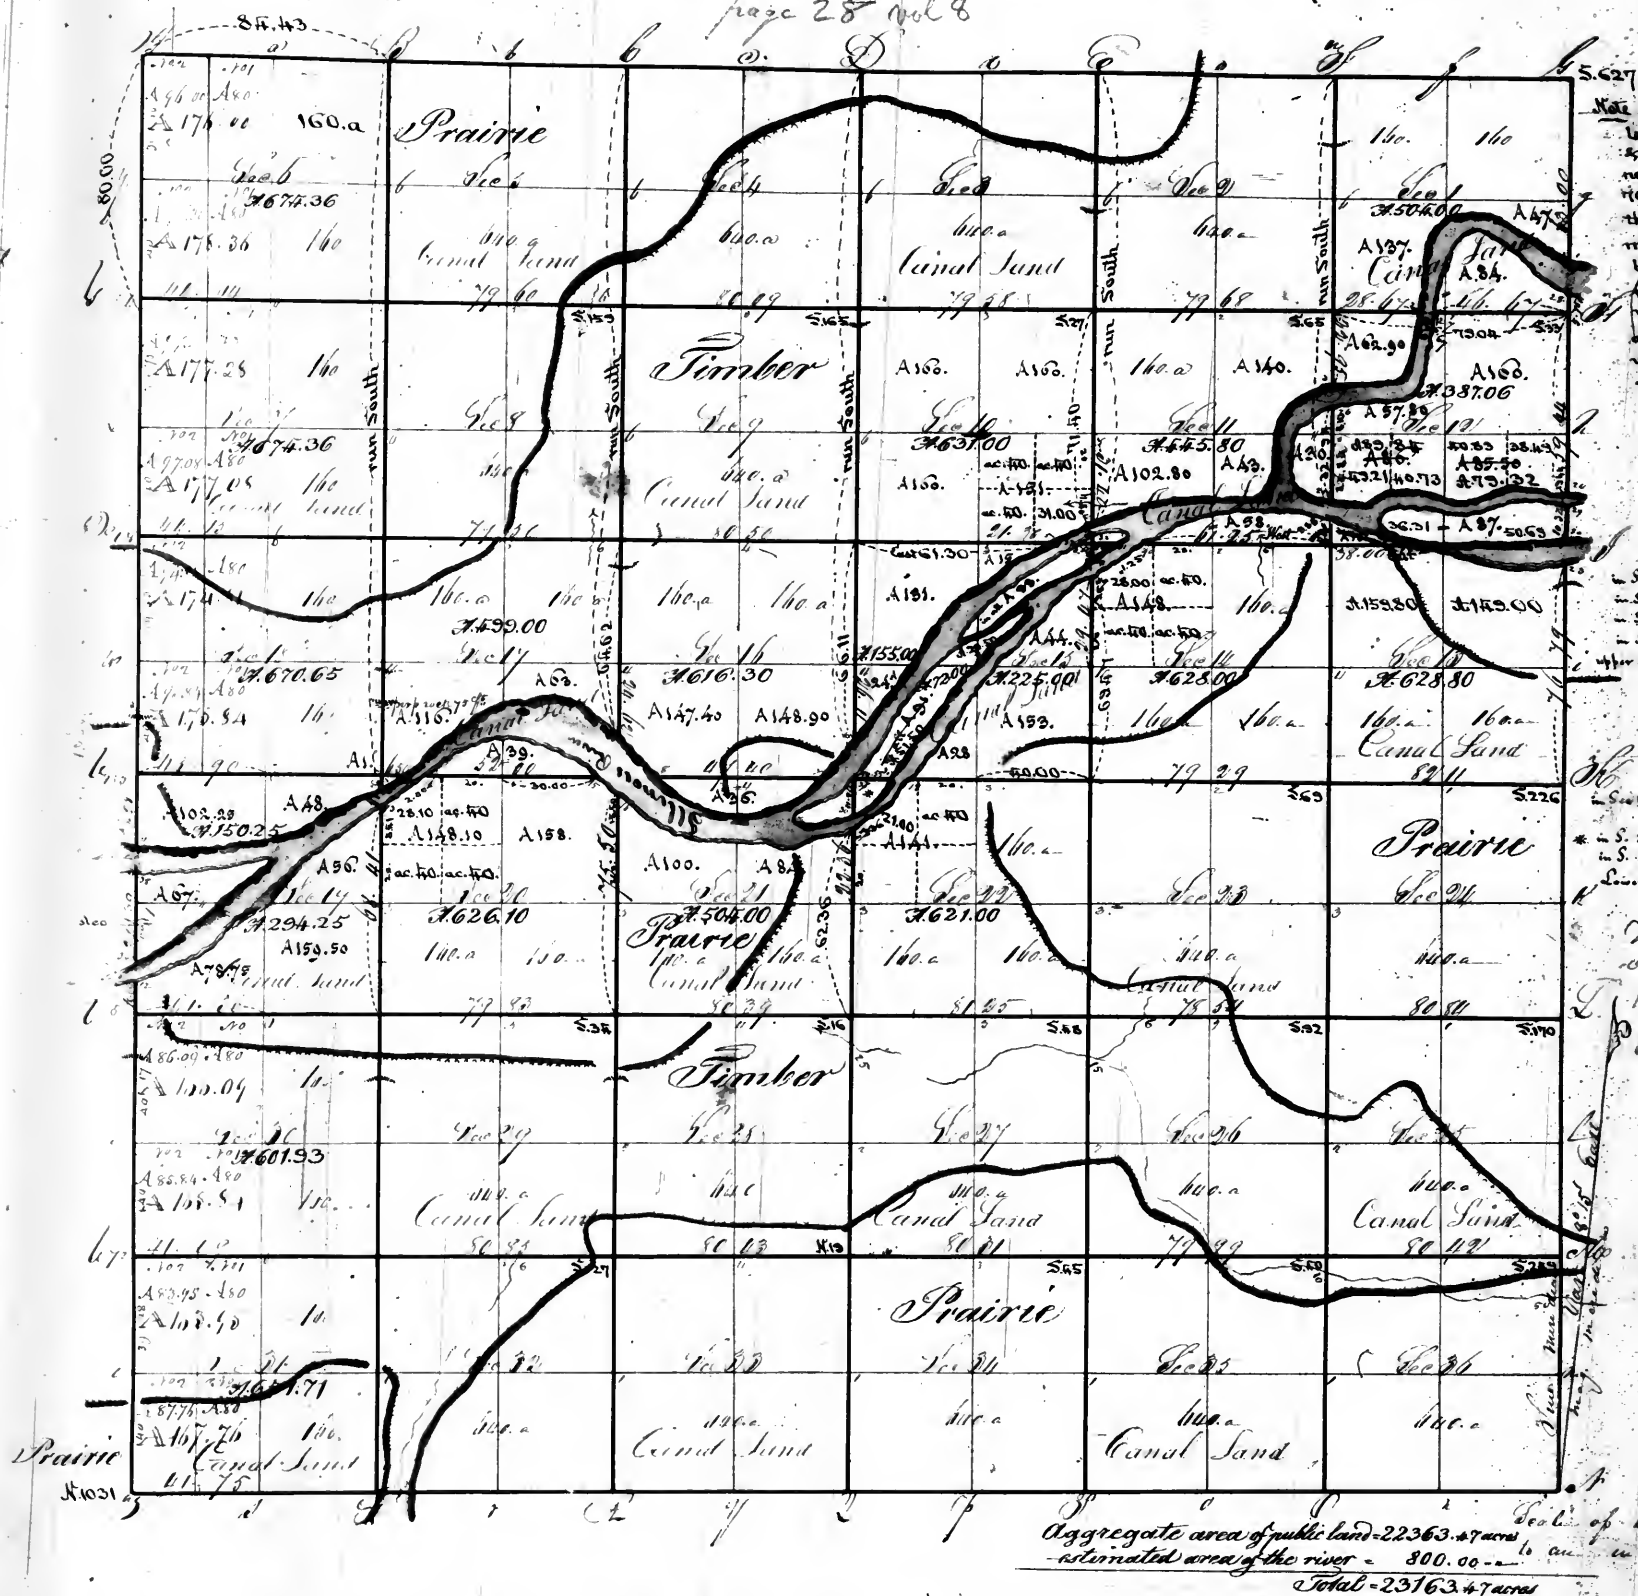

Note - In the field notes appears the length of the line between Sects 22 in running West from corner to Sect 15. 22 x 23 as 76.64 chains. In taking out the latitude & departure of the meander courses of the left bank of Illinois river in Sect 22 (see Vol 241, page 302) the windings are 17.22 ch. which added to 76.64 gives the whole length as 93.86 which is evidently

S. 11 ... 2.50
 S. 10 ... 7.75
 S. 14 ... 7.75
 S. 15 ... 28.00
 upper 51.25 = 33.00
 S. 19 N. 6. 20.50
 S. 10 ... 7.75
 S. 22 ... 6.75
 S. 21 ... 12.50
 lower 51.25 = 33.00


Town of ...
 on the S.E. ...
 11 on both ...
 of the river



The C. Rector Deputy Surveyor
 of the State

718.


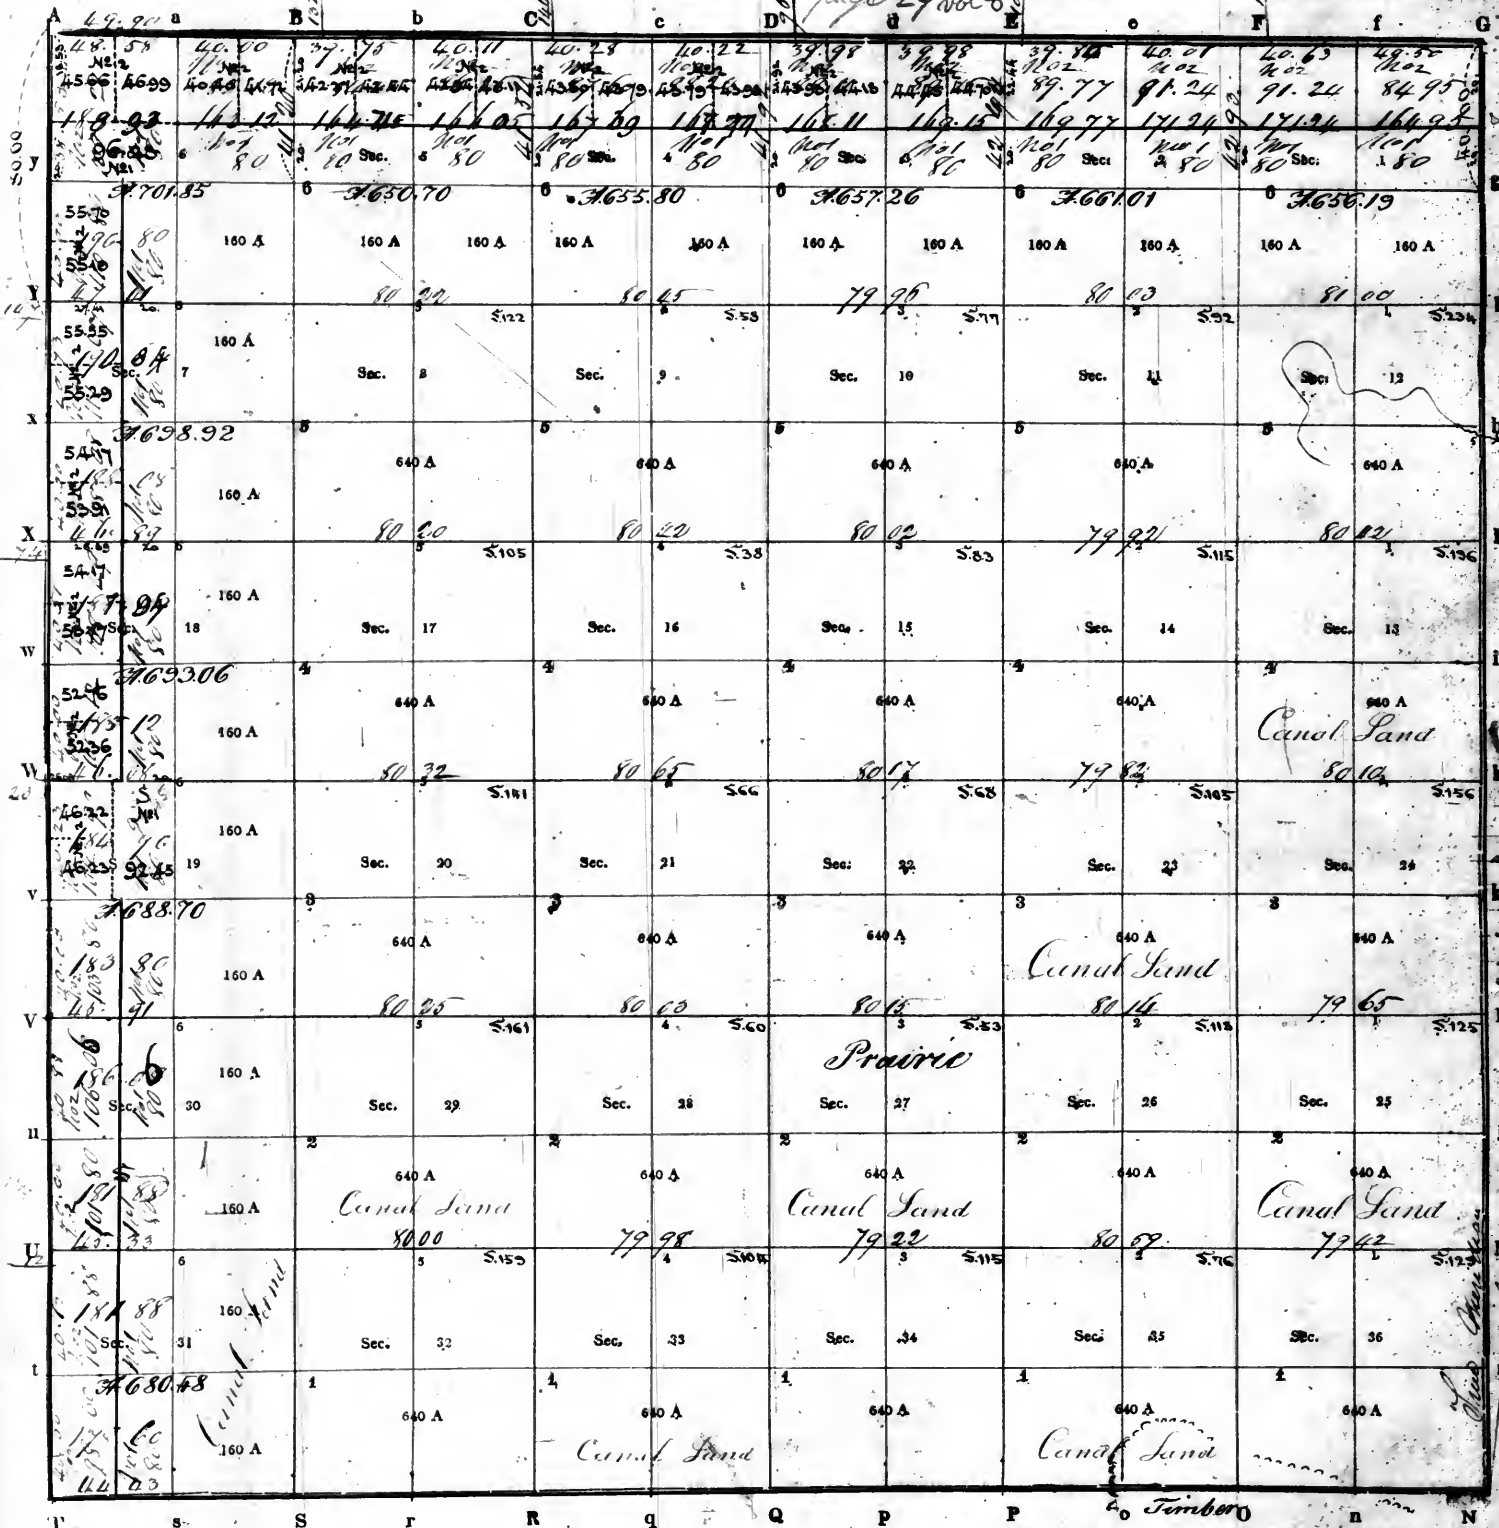

Aggregate area = 22743.97 ac except Sec. 30

PURSUANT to a contract with, and instructions from William Rector, Surveyor of the lands of the United States in the State of Illinois and Territory of Arkansas, bearing date the twentieth day of March 1841, we have admeasured, laid out and surveyed the above described Township; and do hereby certify, that it had such marks and bounds, both natural and artificial, as are represented on said plat, and described in the field notes made thereof, and returned with this plat into the Office of the Surveyor of the Lands of the United States, in the State of Illinois and Territory of Arkansas.

Certified this 10th day of November 1842


EXAMINED.

D. SURVEYOR.

719

Surveyors Office
St. Louis April 15th 1846.
Sent to the Register a copy of this plat & a slip
of the NW 1/4 of Sec 5, & NW 1/4 Sec 7, 18, 30 & 31 sub 2 under
the Act of Congress of the 5th April 1832, & the NW 1/4 of Sec 6
sub 2 to be conveyed to a private sale and another to the Govt.

Township No. 35 North of the base line, Range No. 3 East of the 3rd Principal Meridian.

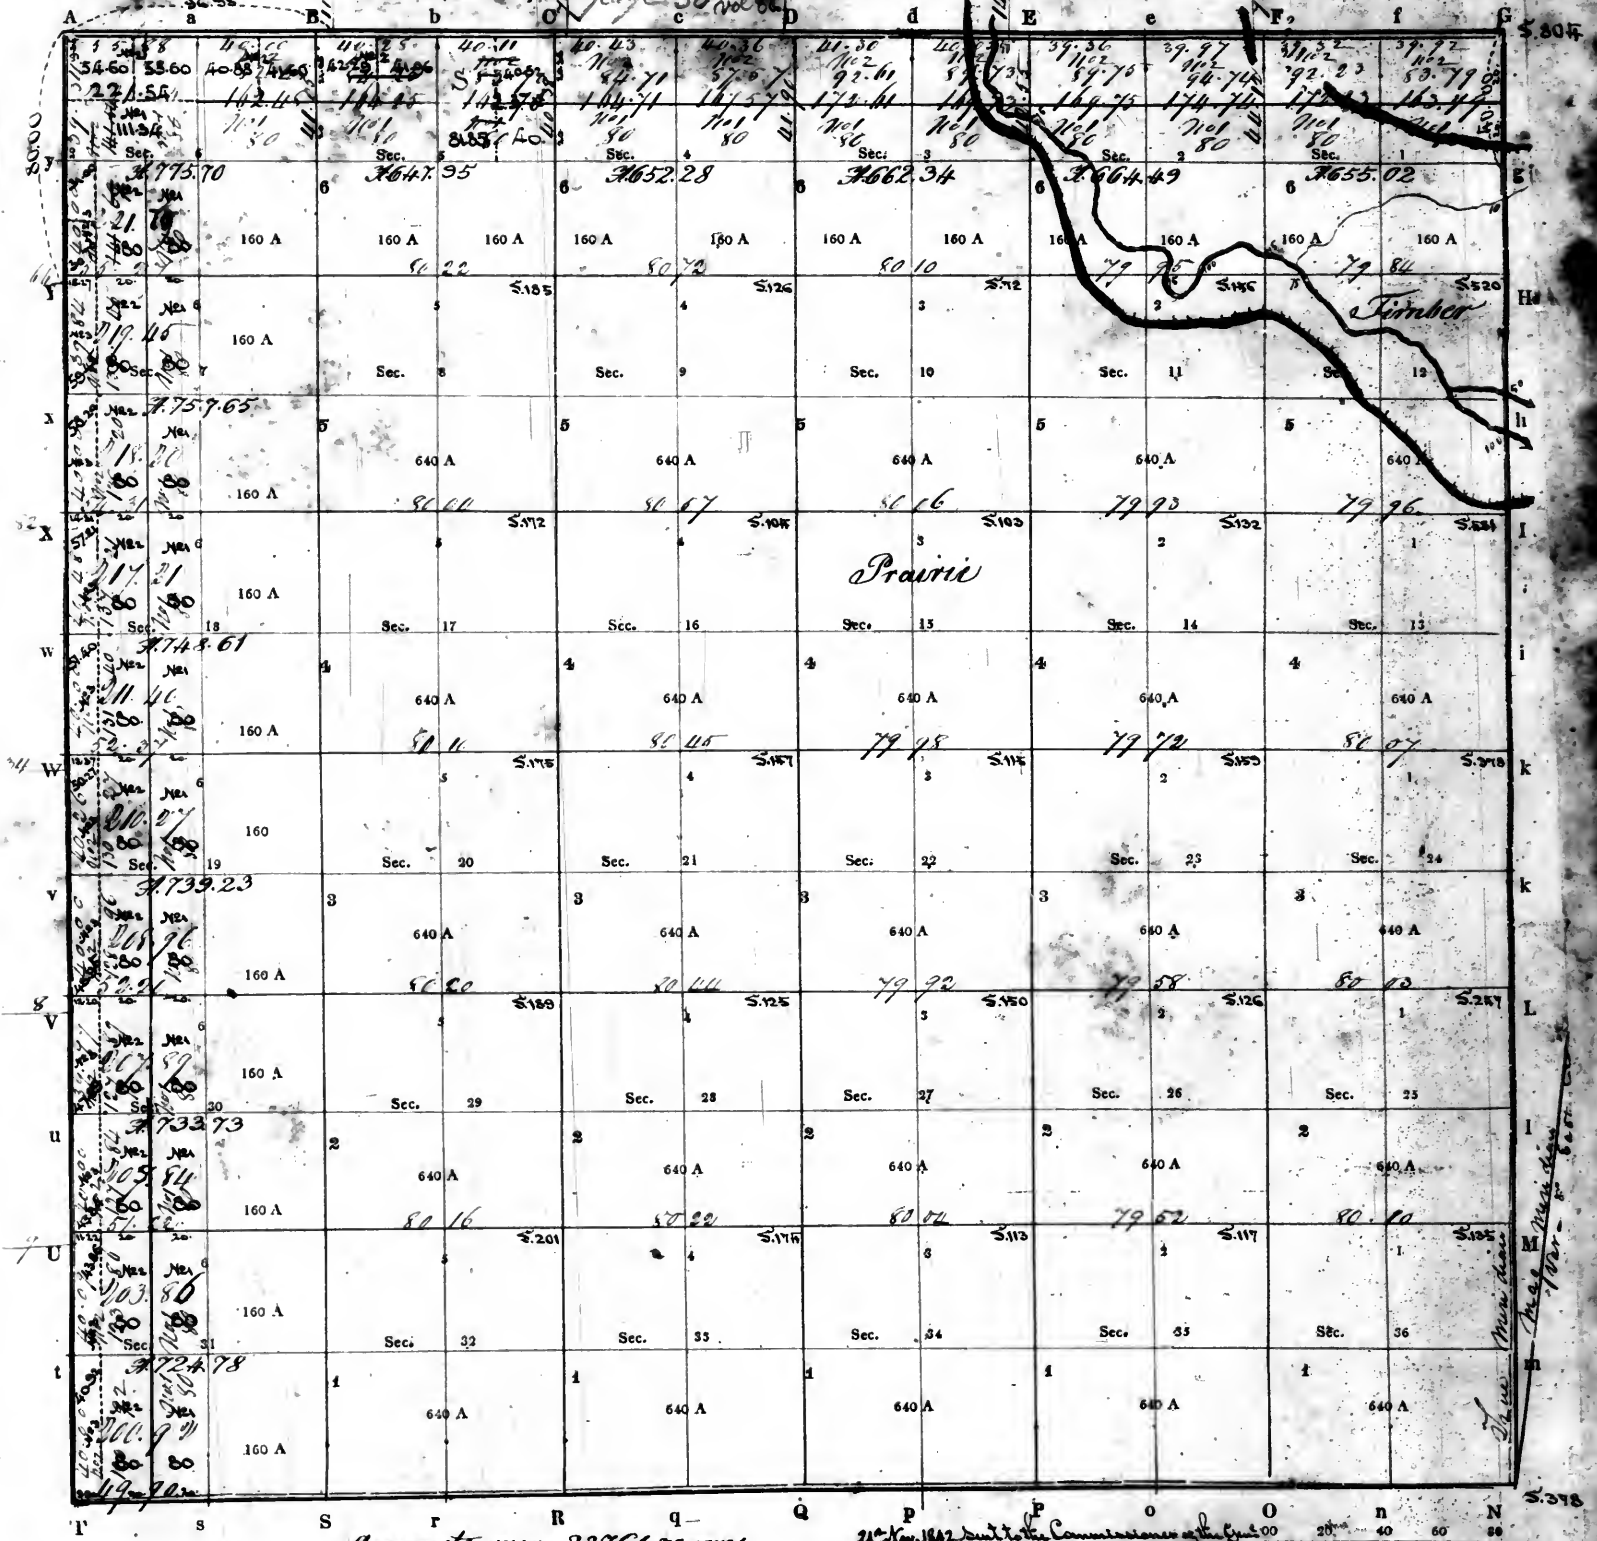

Aggregate area = 23761.78 acres


21st Nov. 1842, sent to the Commissioner of the Land Office a plat of the NW 1/4 of Sec 5, & NW 1/4 Sec 7, 18, 30 & 31 sub 2 under the Act of Congress of the 5th April 1832, & the NW 1/4 of Sec 6 sub 2 to be conveyed to a private sale and another to the Govt.

PURSUANT to a contract with, and instructions from William Rector, Surveyor of the lands of the United States in the State of Missouri and Territory of Arkansas, bearing date the twentieth day of March 1842, we have admeasured, laid out and surveyed the above described Township; and do hereby certify, that it had such marks and bounds, both natural and artificial, as are represented on said plat, and described in the field notes made thereof, and returned with this plat into the Office of the Surveyor of the Lands of the United States, in the State of Illinois and Missouri and Territory of Arkansas.

Certified this day of 1842
EXAMINED.
B. SURVEYOR.

720

Tract Township N. 26 North of the Base line Range N. 3 East of 3rd Principal Meridian

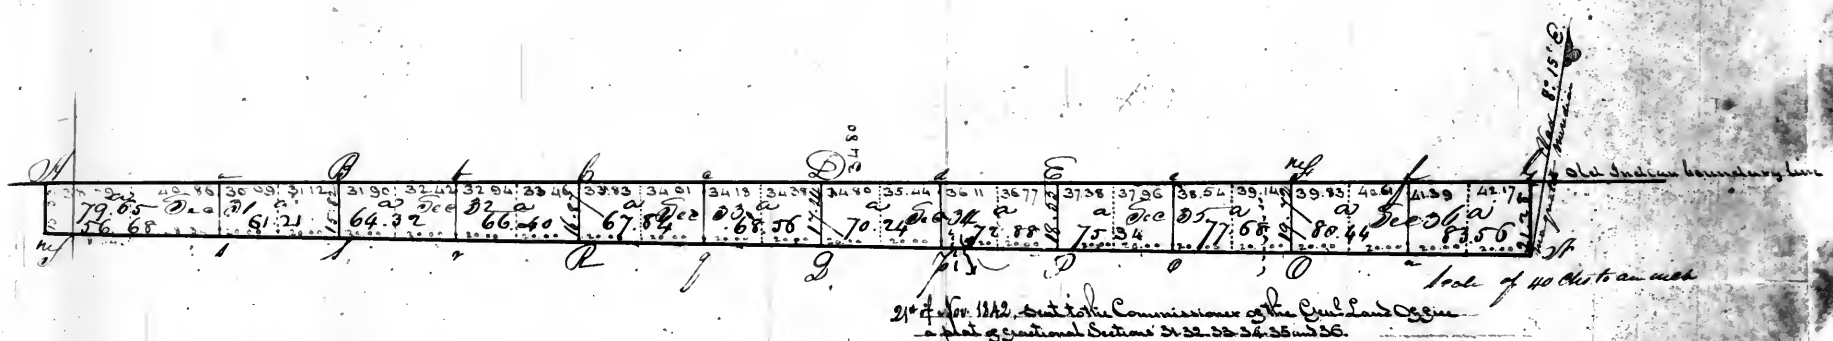







Reference to the field notes of the Survey of this township:
 S. boundary in book 140. date September 1821
 E. boundary in book 138. date May 1821
 N. boundary and subdivision, in subdivision book 720. date October 1821

~~61~~
424

Page 32/col 8

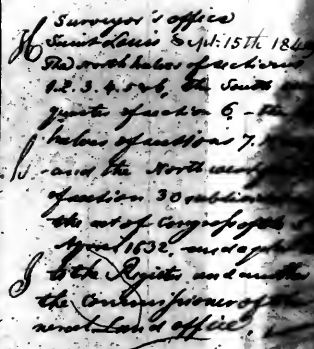

Aggregate area = 22708.13 acres


Surveyed Dec 1848 & Jan. 1849

To John Duggel - Dr
For Elias Barcroft Dr

Recorded

425


Township No. 2 North of the Base line, Range No. 4 East of the 3rd Principal Meridian.
 page 33 of 8

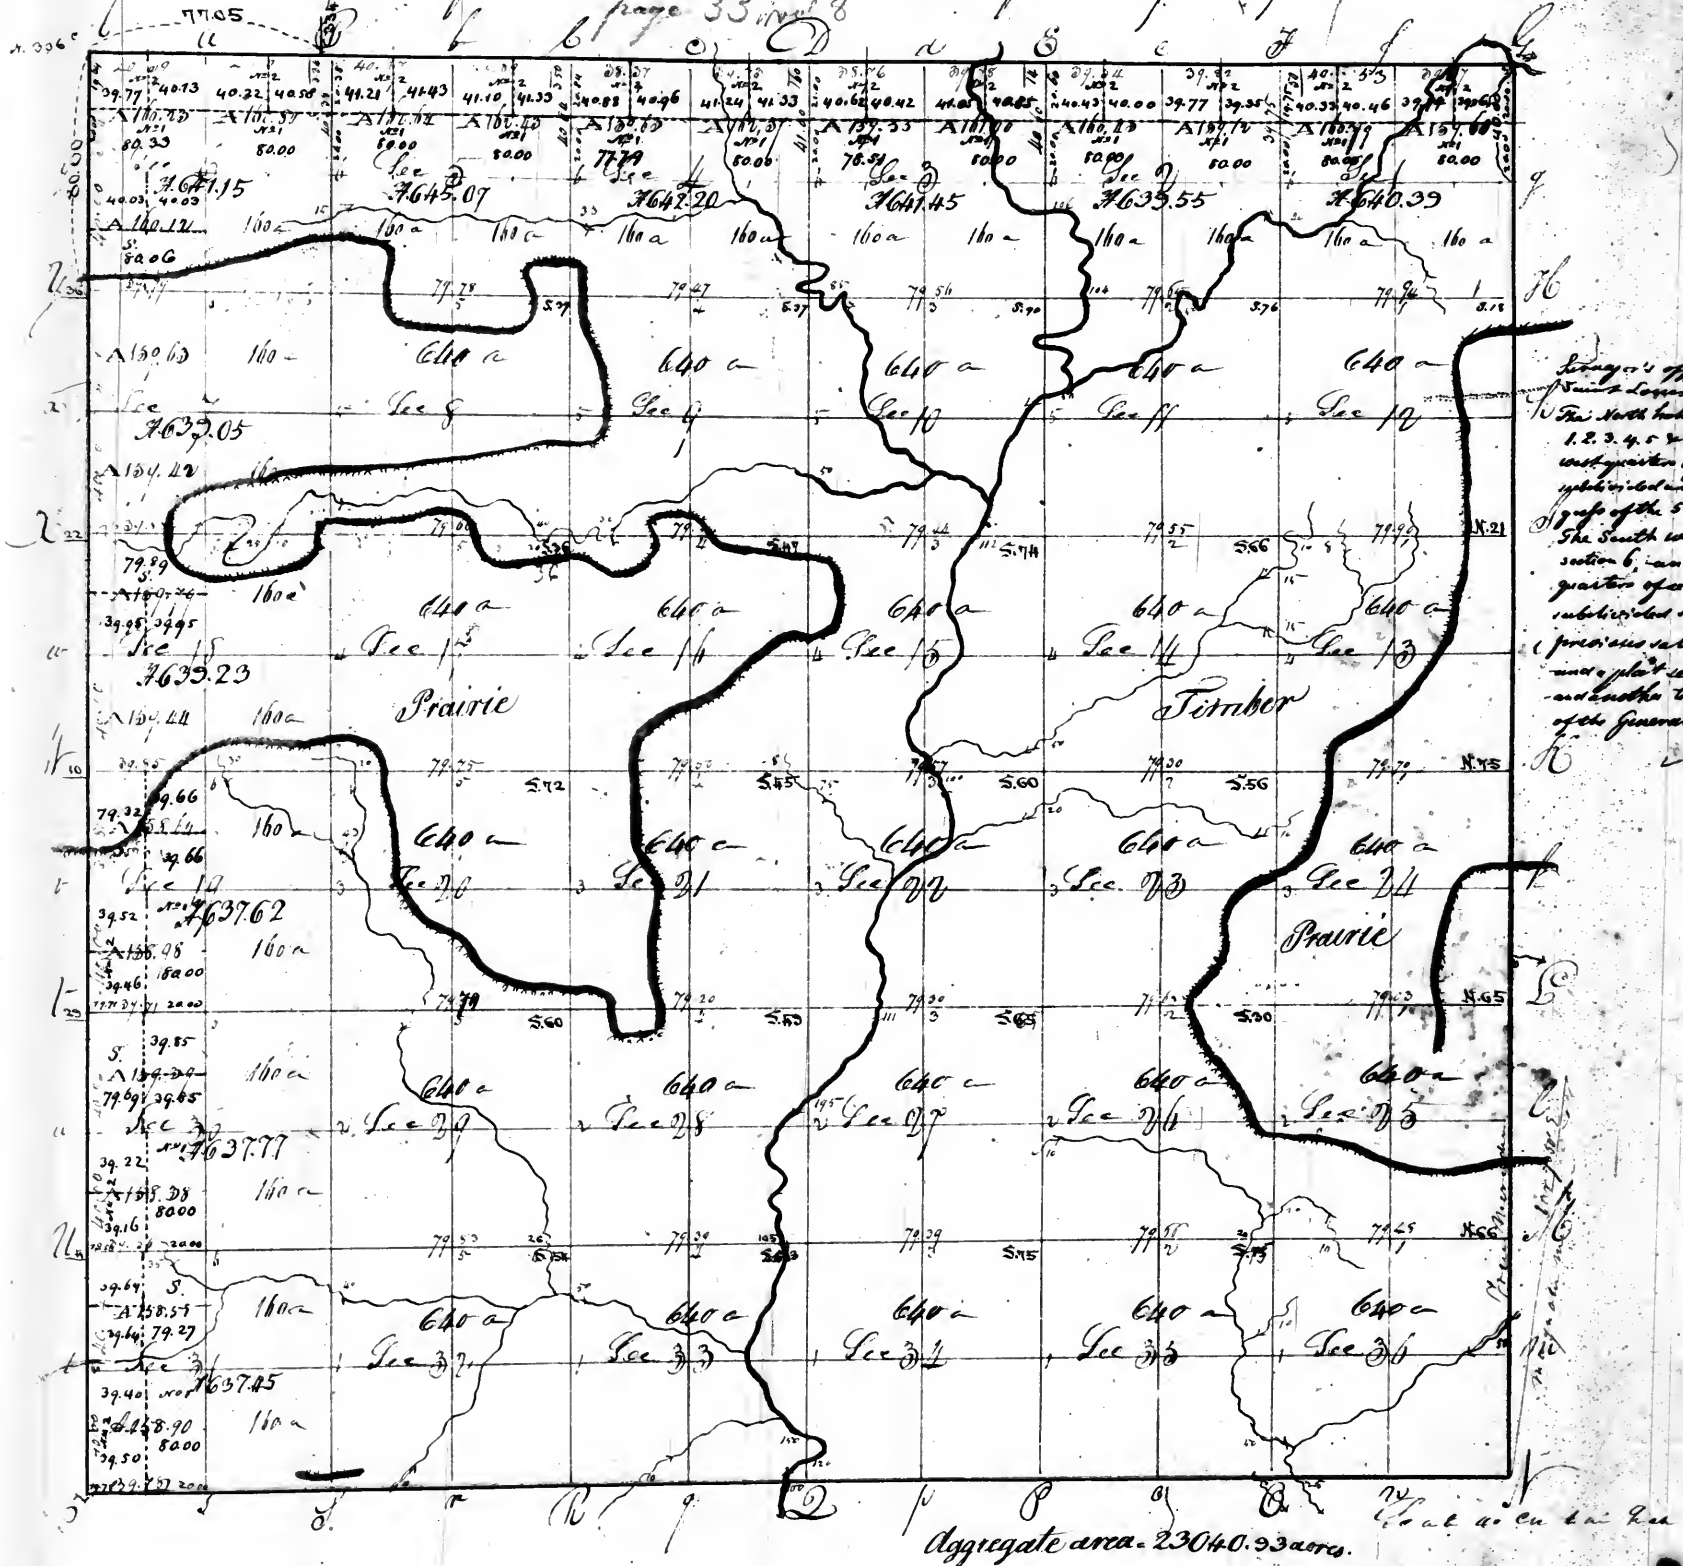

Surveyor's office
 This North half of section 1, 2, 3, 4, 5 & 6, and the South
 (previous sales of sections 3,
 and 4, plat sent to the Surveyor
 and another to the Commissioner
 of the General Land Office)

Recorded 426

Township No. 3 North of the Base line, Range No. 4 East of the 3rd Principal Meridian

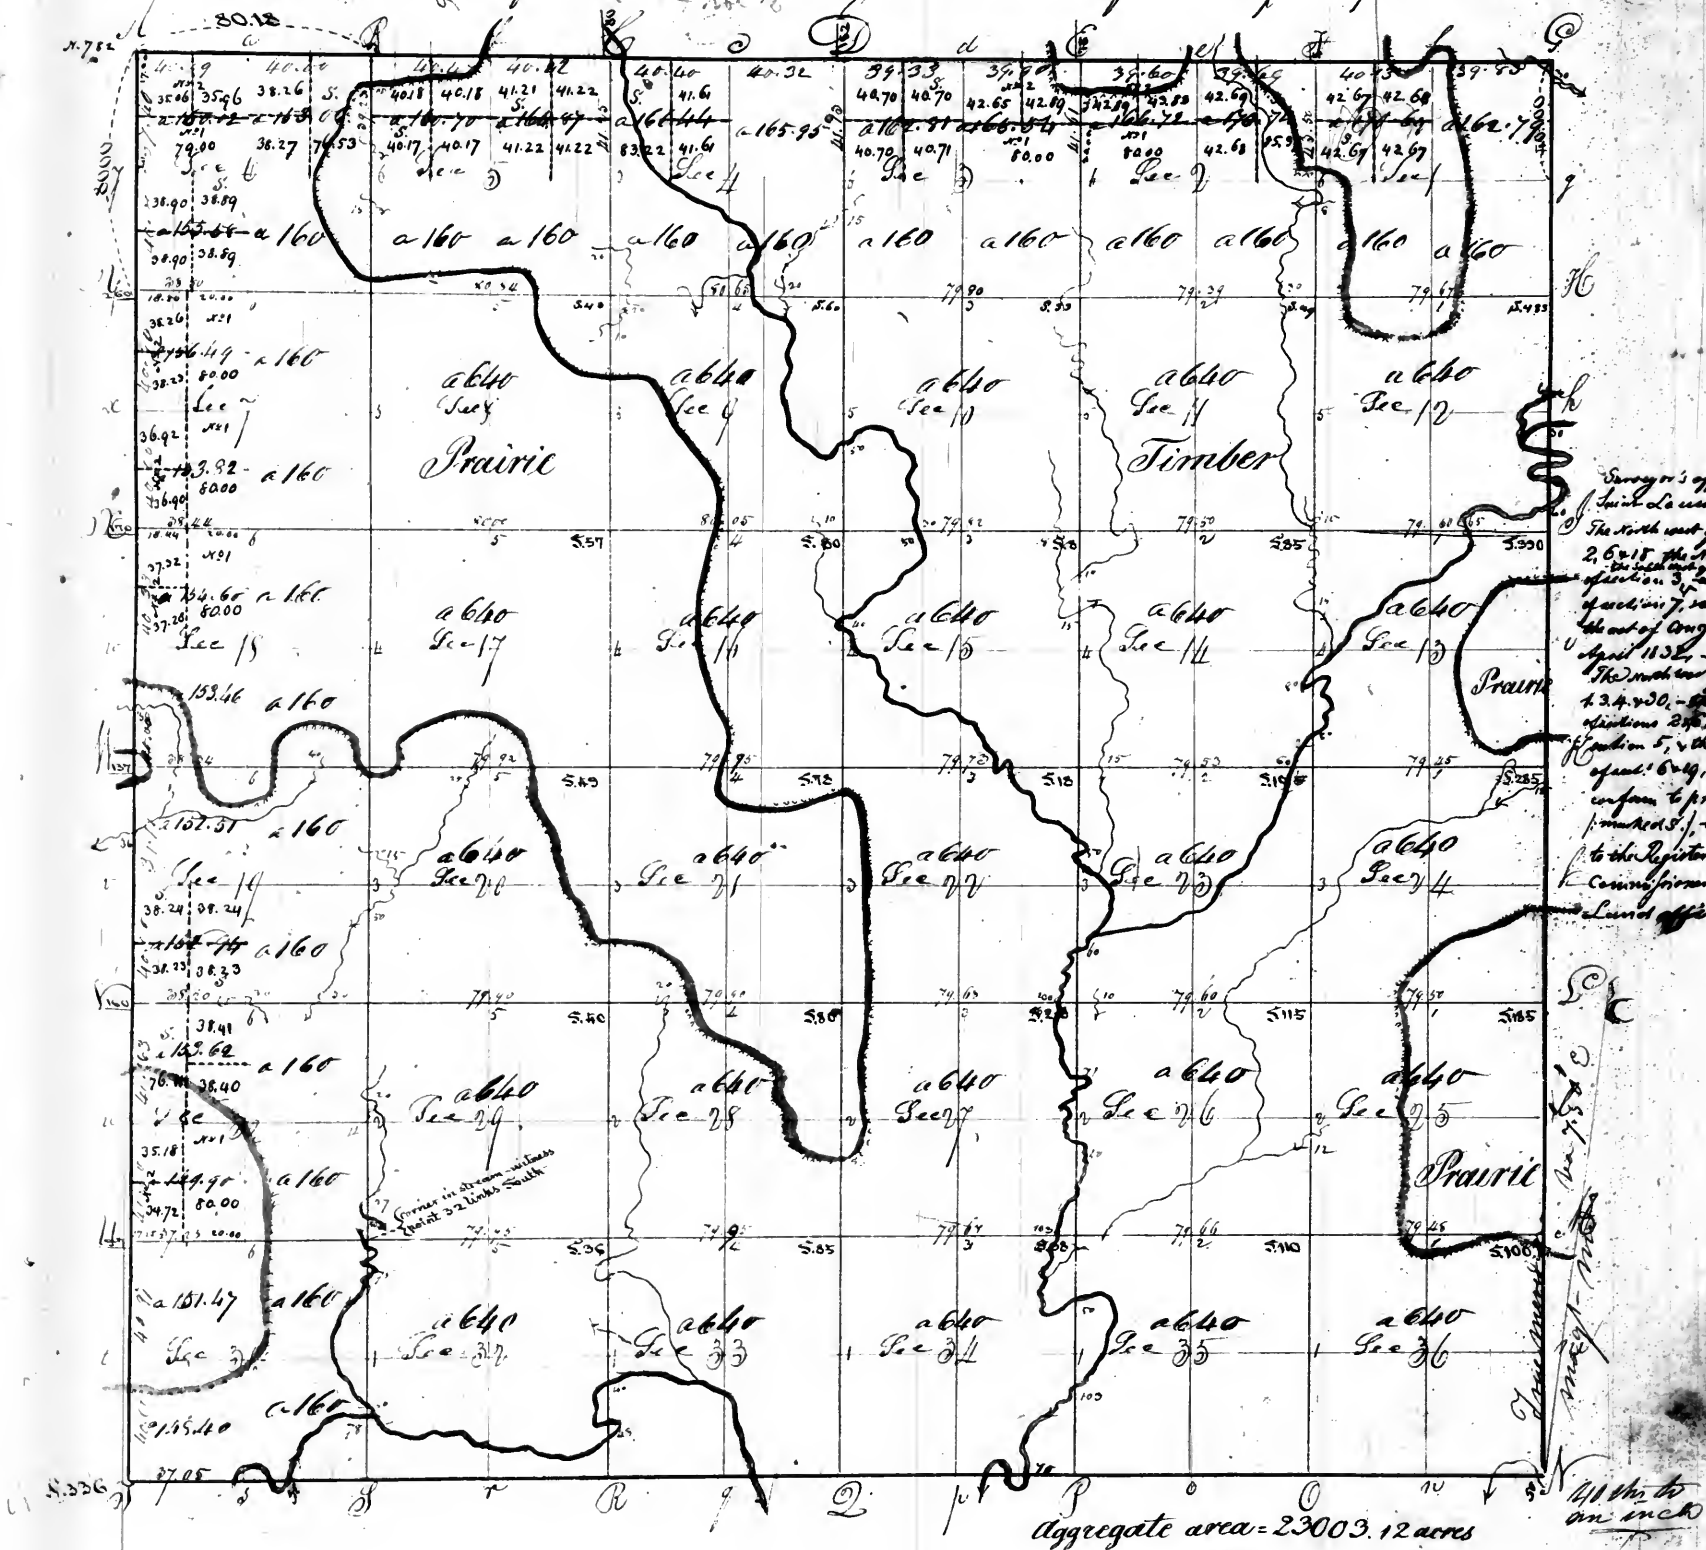


Surveyor's office
Saint Louis, Mo. July 11th 1881
The North and quarter of section
2, 6, 18, the North East
quarter of section 3, and the North
quarter of section 7, subdivided under
the act of Congress of the 5th of
April 1832.
to the Register and under the
Commission of the General
Land Office.

Recorded 427

Furnishings No. 2 North of the Base line, Range No. 4 East of the 3rd Principal Meridian
Page 35

Page 35

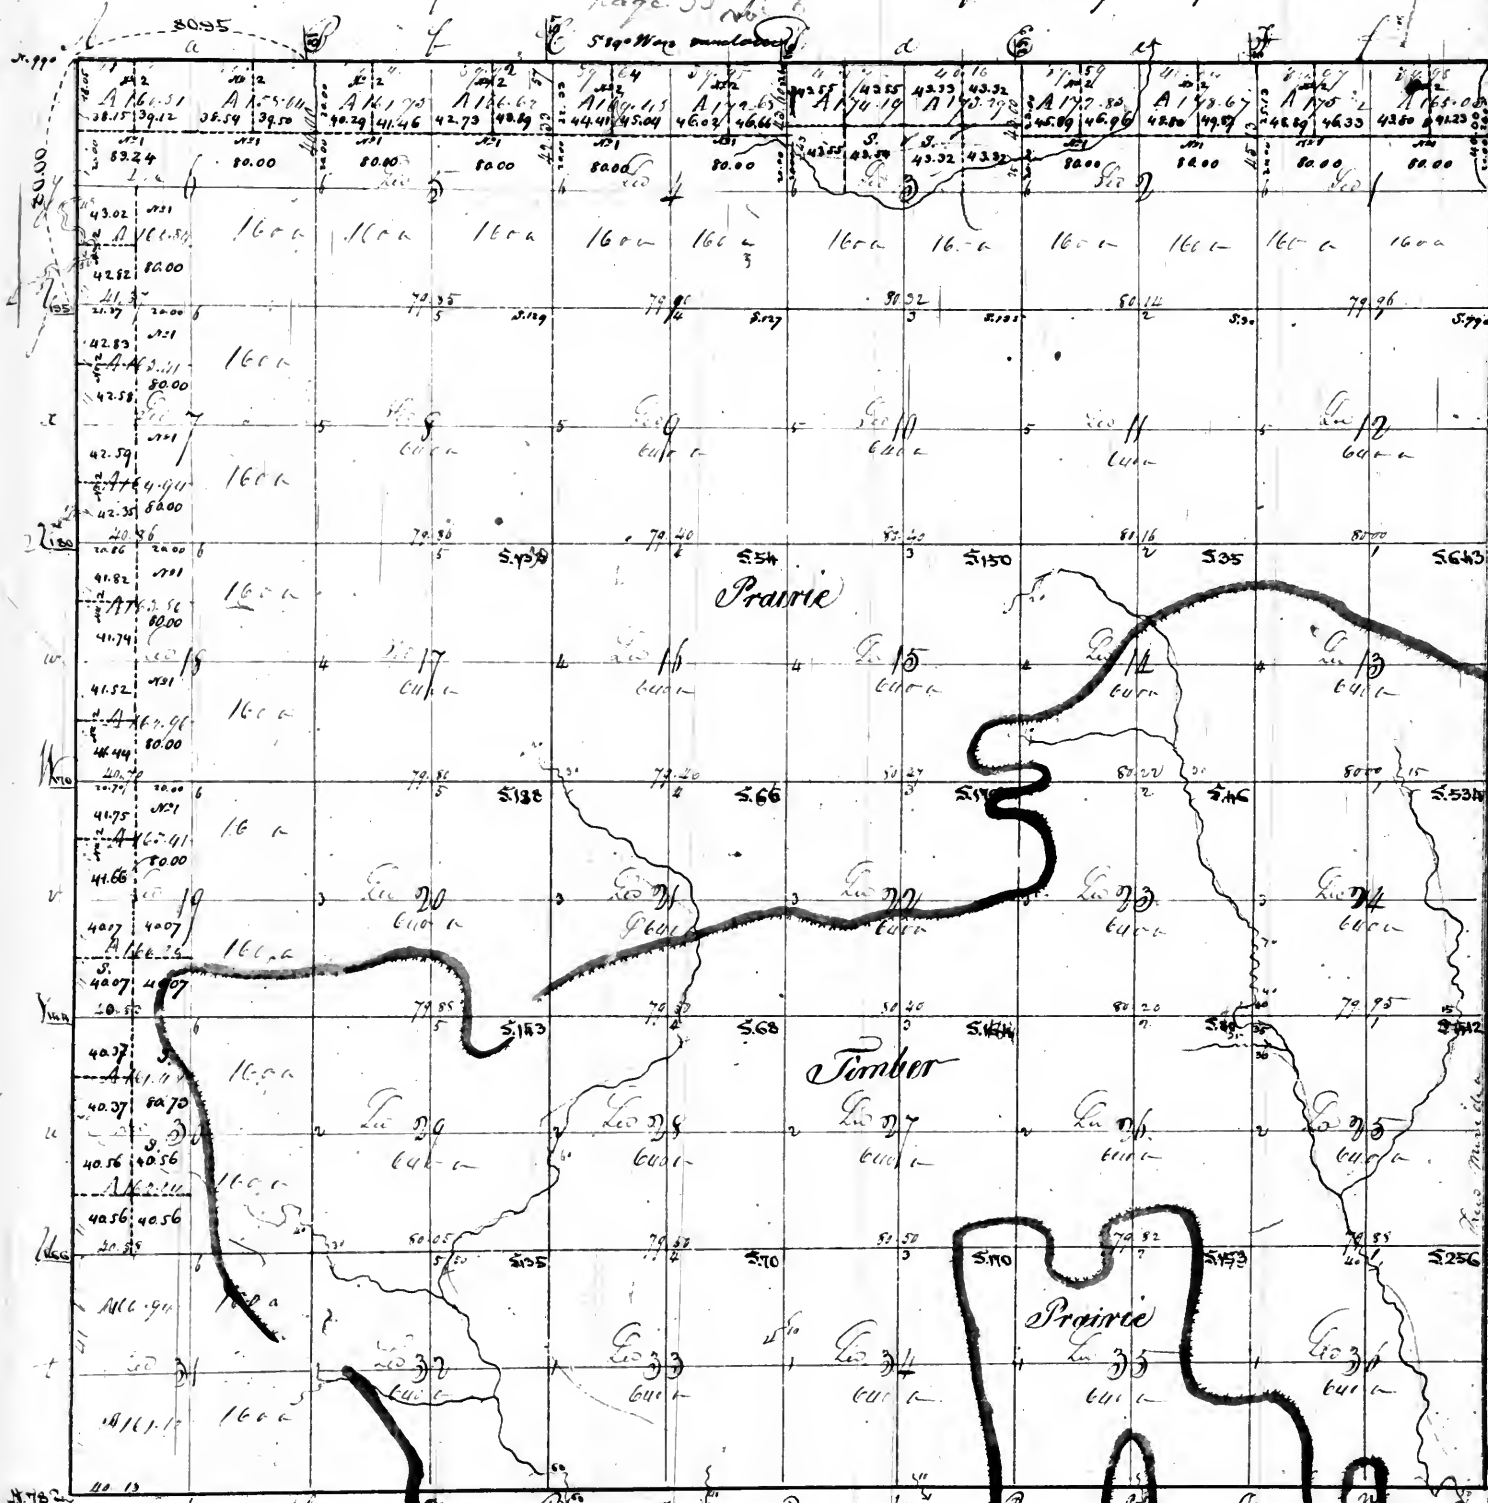

HC Surveyor's office
The North halves of sections
4, 5, 6, the South west quarter
of section 8, West halves of
sections 9, 8, and the
west quarter of section 19,
situated on about the west side
of the 5th of April 1834
The North half of section 7,
the South west quarter of
section 19, and the West
quarter of section 30, situated
to conform to government
records of S. 1, and a plat
to the Register and under
the Commission of the
General Surveyor of the

Aggregate area = 23,86.47 acres

428





Summary of his office
James L. Davis's Sept. 16th 1849.
The north halves of sections 22, 23, 24,
the south west quarter of section 25,
and the west halves of sections 26
• 19, 20 & 31 subdivisions under the act
of Congress of the 5th of April 1832,
and a plot made by the Register
another to the Commissioner of
General Land Office.

Aggregate area = 23014.39 acres ^{140 Chrs to an Inch}

Page 37

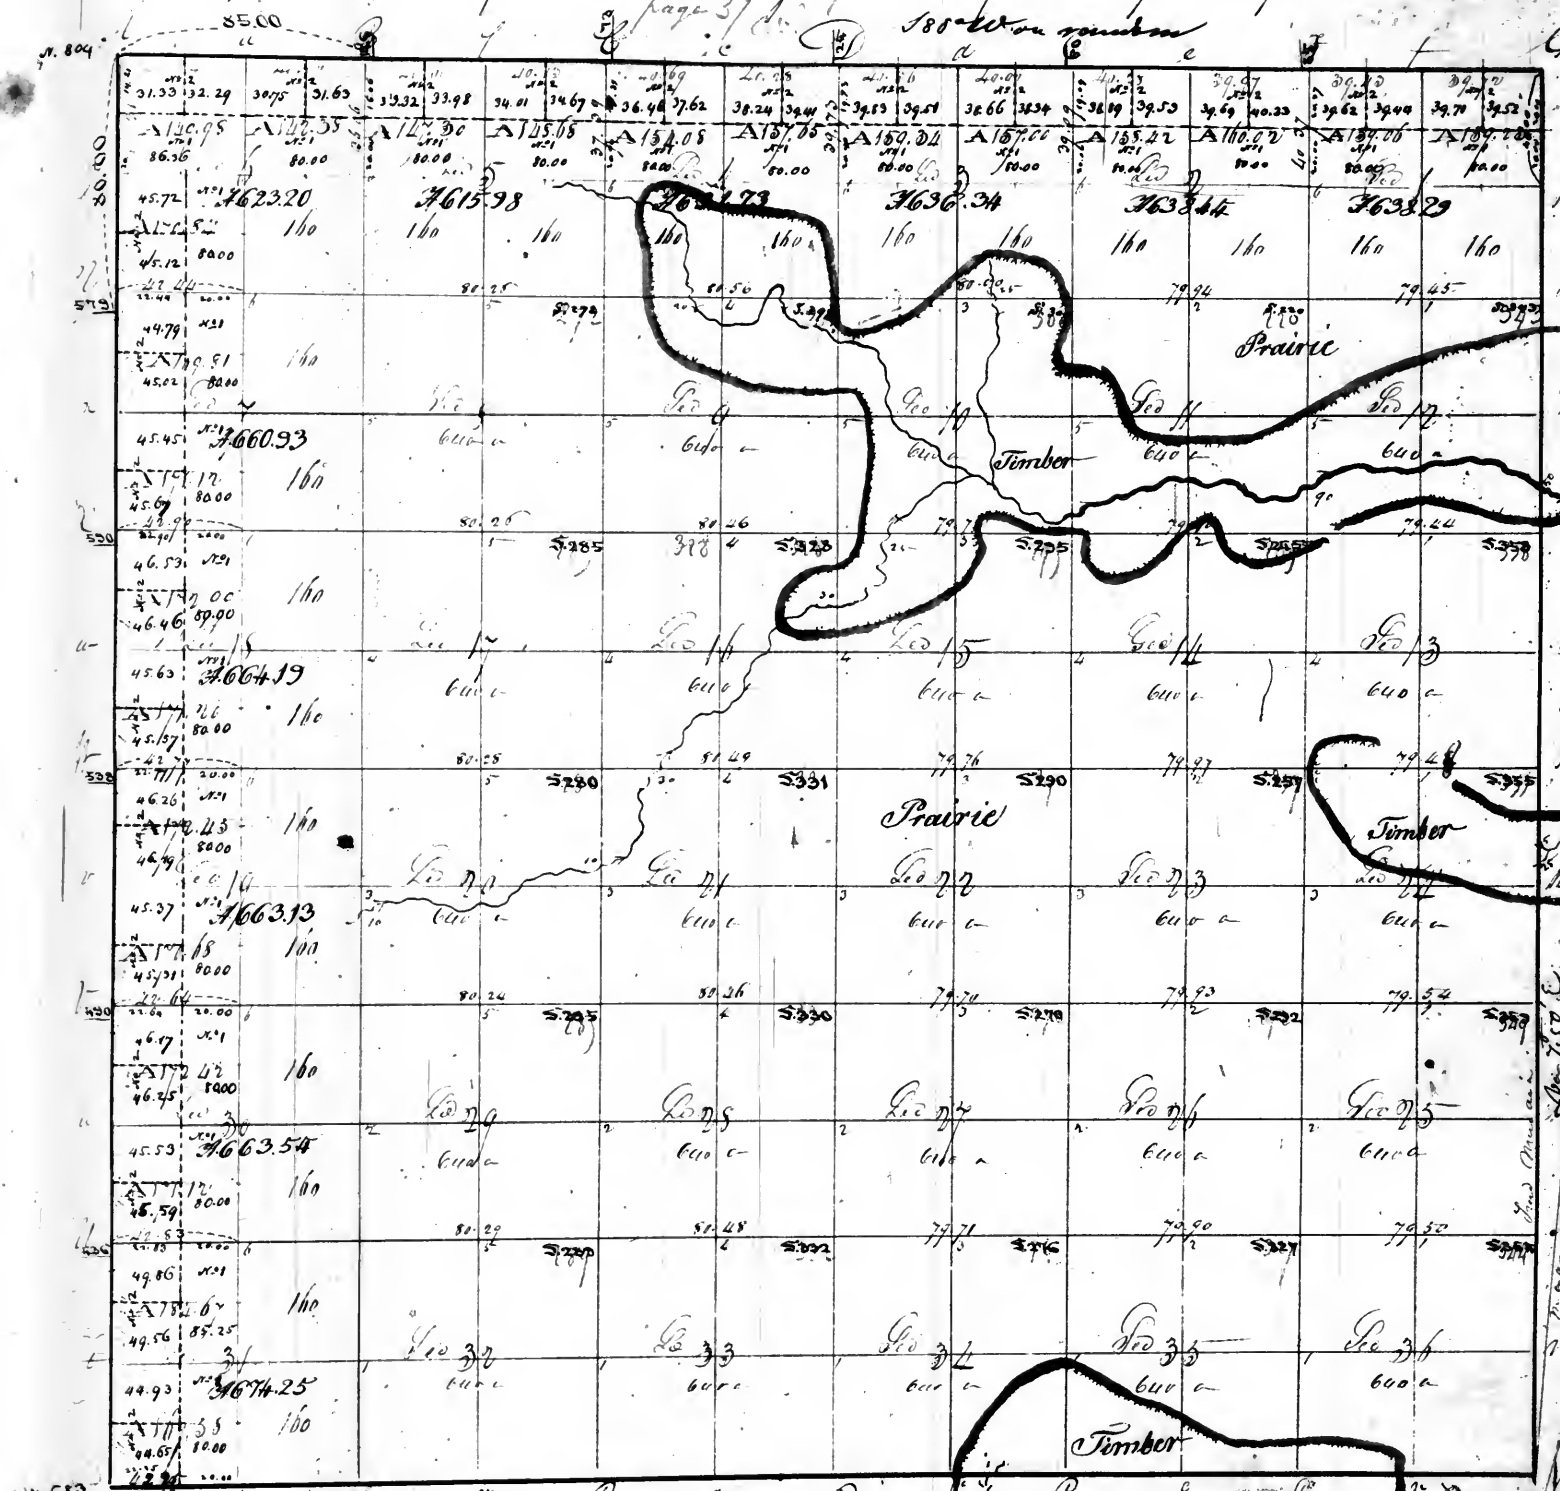


Barrow's office
Saint Louis Sept. 15th 1849
The North halves of sections 1, 2,
3, 4, 5 & 6, the South half
of section 6, and the East half
of sections 7, 15, 16, 30 & 31, and
the West corner of the west of
the 5th of R 5 E,
and a plat sent to the
Govt another to the
Govt of the General
office

Scale of 1 in. = 100 ft. to an inch
Aggregate area = 23110.02 acres

Record 430

Traverse N. 7° 30' E. to the base line, Range N. 4 East of the 3rd Principal Meridian.

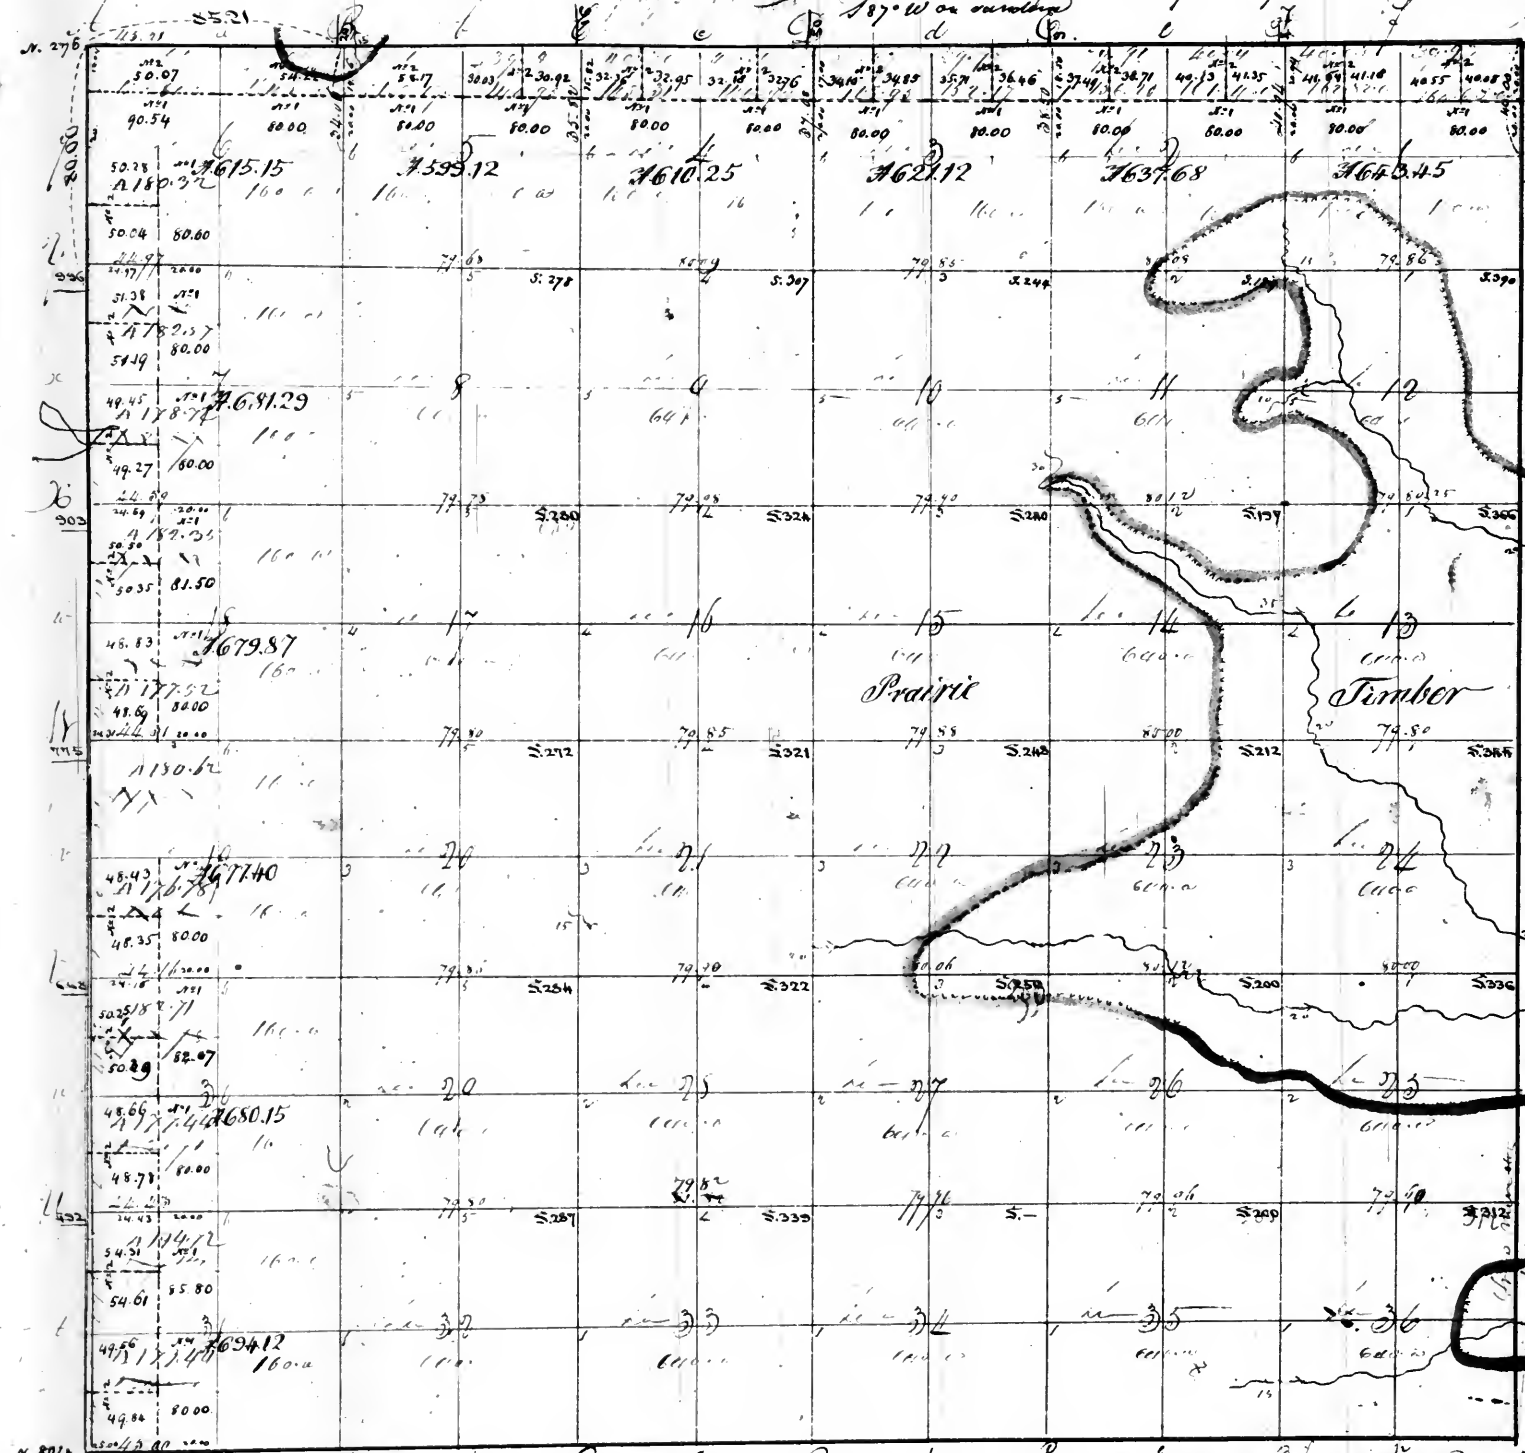


Surveyor's office
St. Louis Sept 15th 1849
The North halves of sections 1, 2, 3,
4, 5 & 6, the South West quarter of
section 6, and the East halves of
sections 7, 8, 20 & 31, and the
West quarter of section 19, under
the Act of Congress
5th April 1832, and
sent to the Register and
to the Commissioner of the
General Land office

Aggregate area - 23139.60 acres
Surveyed by John Daggell
March 1849

to the B. of C. in the

431.

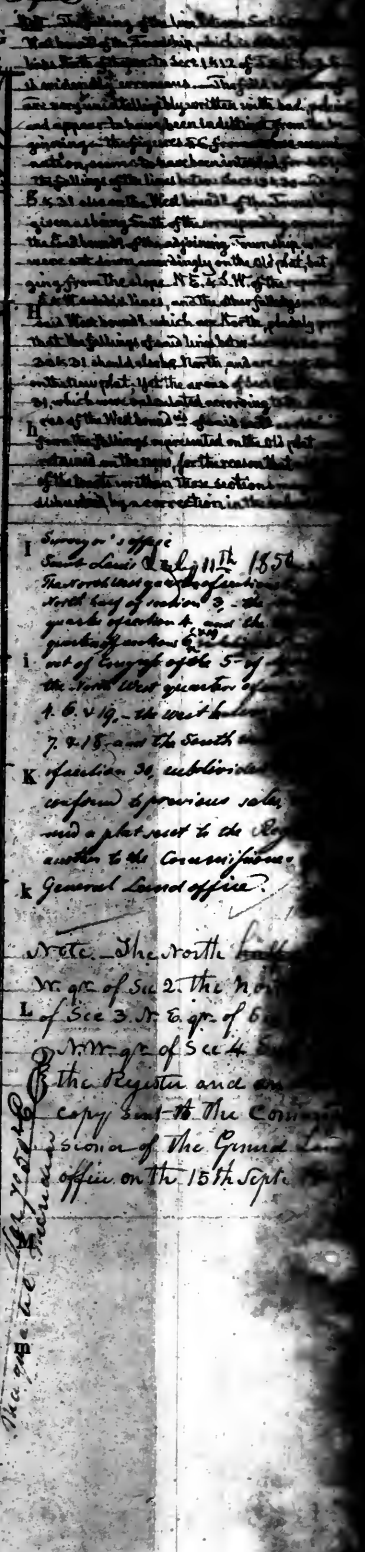


Surveyed by Benjamin Fort
D. SURVEYOR
June 1890

Recorded

64
432

Township No. 9 North of the base line, Range No. 4 East of the 3rd principal Meridian.

page 40 rd 8

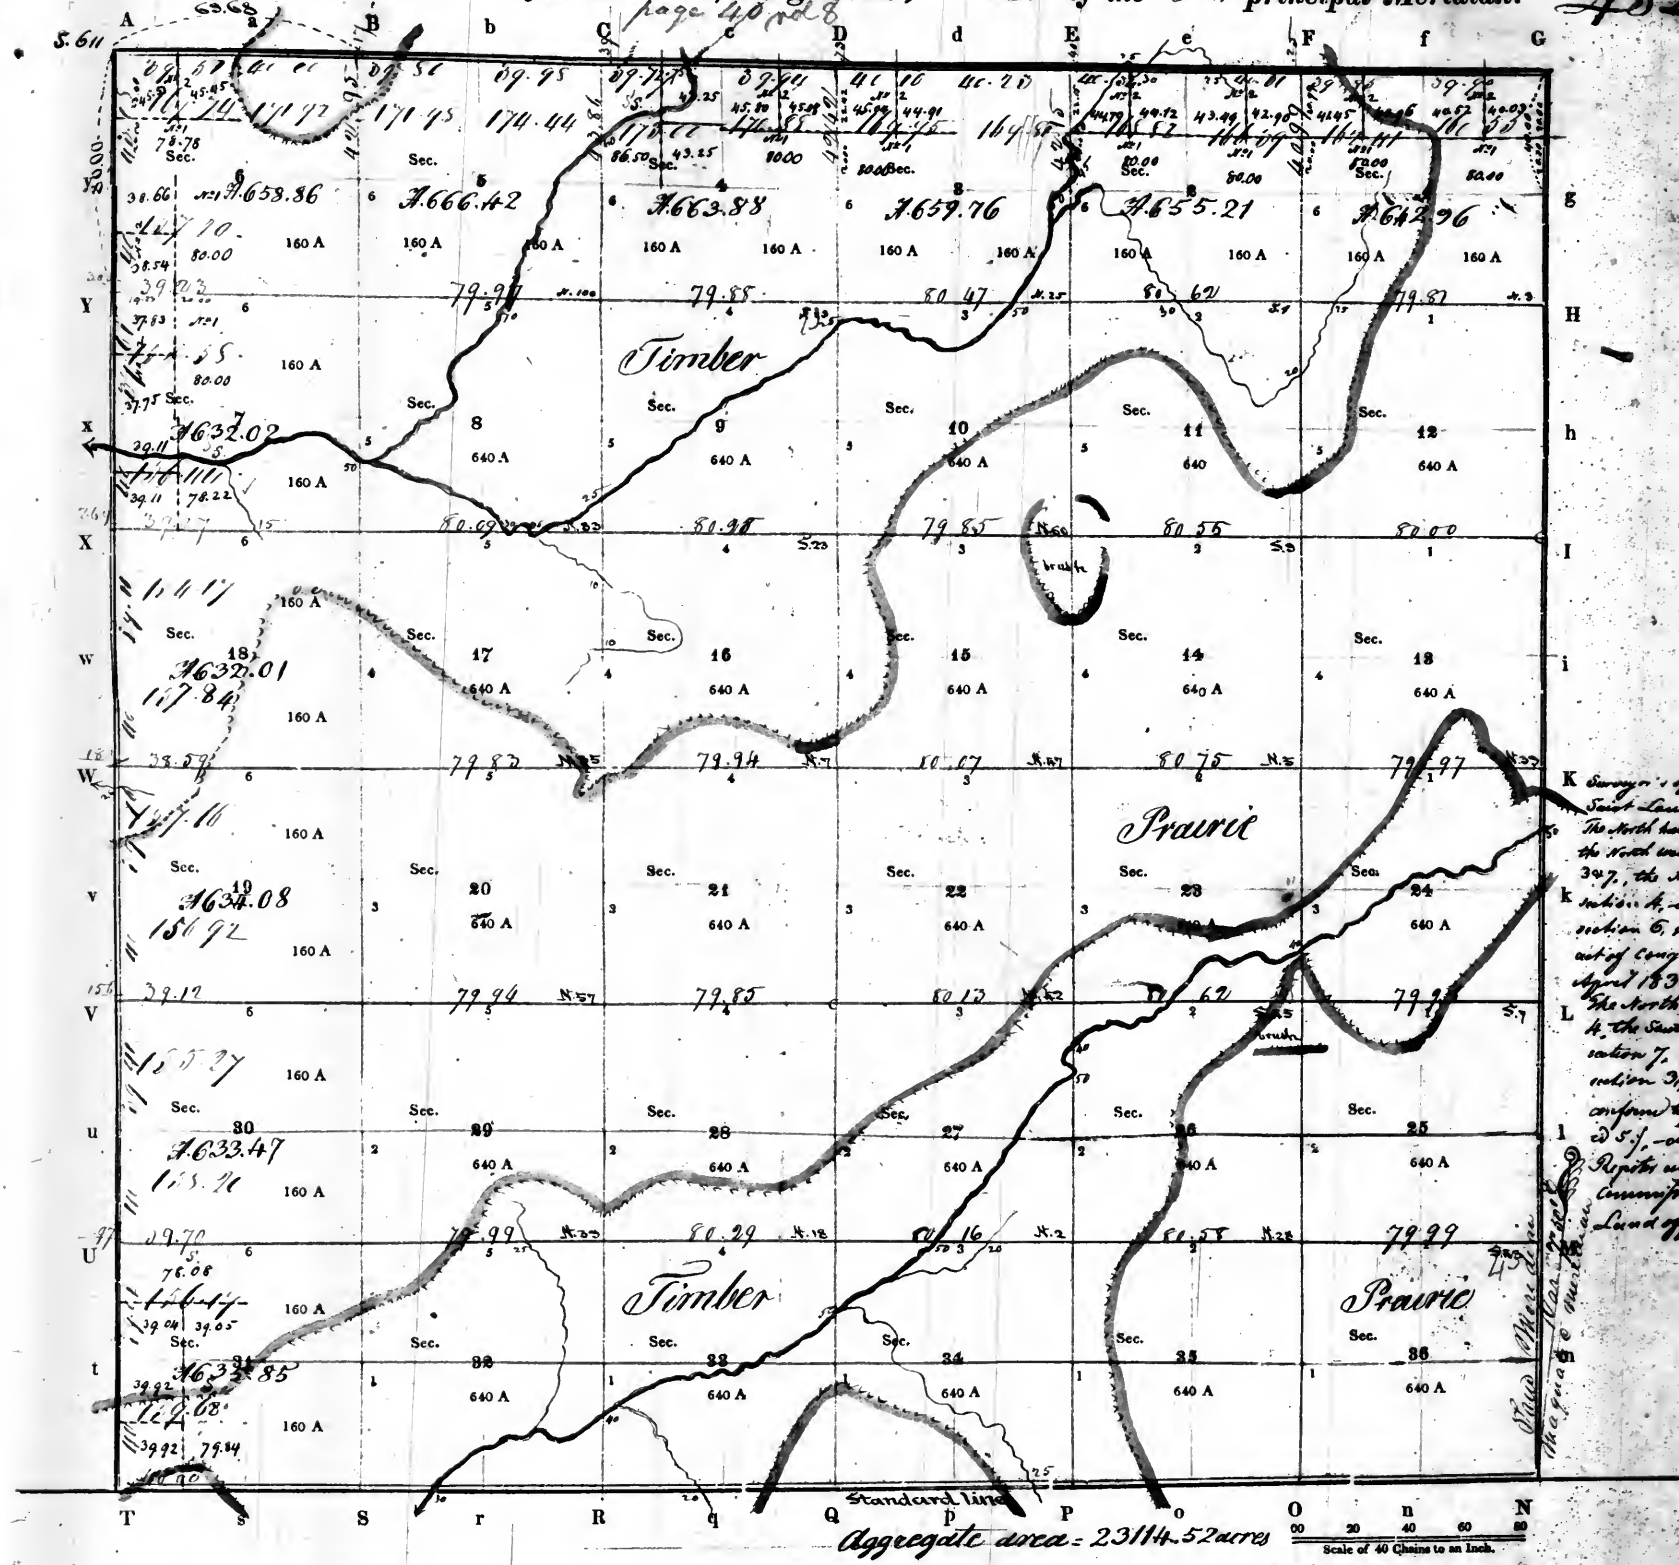

K Surveyor's office
Saint Louis Sept 15th
The North halves of sections
the North east quarter of
347, the North East quarter
section 4, and the West half
section 6, subdivided under
act of Congress of the 5th
Sept 1832.
The North west quarter of
4, the South west quarter
section 7, and the West
section 31, subdivided
conform to previous
S.S. and a plat
Repairs and another
Commissioner of the
Land Office.

PURSUANT to a contract with, and instructions from WILLIAM RECTOR, Surveyor of the lands of the United States in the State of Illinois and Territories of Missouri & Arkansas bearing date the 18th day of May, 1820

I have admeasured, laid out and surveyed the above described Township; and do hereby certify, that it had such marks and bounds, both natural and artificial, as are represented on said plat, and described in the field notes made thereof, and returned with this plat into the Office of the Surveyor of the lands of the United States, for the State of Illinois & Territories of Missouri & Arkansas


Certified this 10th day of October 1820

EXAMINED.

James Connor D. SURVEYOR
Stephen Rector Dy.
Jan 1820.

Recorded
of the 3rd principal Meridian.
E e 2nd f G

433.

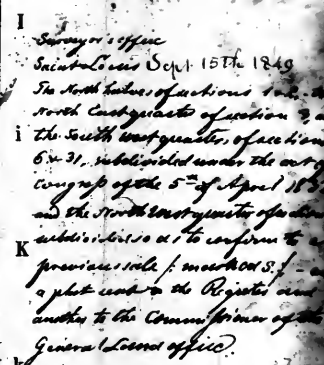

I have admeasured, laid out and surveyed the above described Township, and do hereby certify, that it had such marks and bounds, both natural and artificial, as are represented on said plat, and described in the field notes made thereof, and returned with this plat into the Office of the Surveyor of the lands of the United States, for the State of Illinois. *I hereby certify under oath*

EXAMINED.

James C. Munroe D. SURVEYOR
for
Stephen C. Cator D.S.
June & July 1820.

Records

Township No. 11 North of the base line, Range No. 4 East of the 3rd principal Meridian.

434



Surveyor's Office
St. Louis 10th August 1821
Plot of the North halves of
1345, and of the NE
1/4 6 and the day to the
of the Genl. L. S.

aggregate area = 22913.59 acres

Scale of 40 Chains to an Inch.

PURSUANT to a contract with, and instructions from WILLIAM RECTOR, Surveyor of the lands of the United States in the States of Illinois and Missouri and Arkansas bearing date the third day of March 1821


I have admeasured, laid out and surveyed the above described Township; and do hereby certify, that it had such marks and bounds, both natural and artificial, as are represented on said plat, and described in the field notes made thereof, and returned with this plat into the Office of the Surveyor of the lands of the United States, for the State of Illinois and Missouri and Territory of Arkansas

Certified this 14th day of September 1821

Green
D. SURVEYOR

EXAMINED.

Township No. 12 North of the base line, Range No. 4 East of the 3rd principal Meridian.

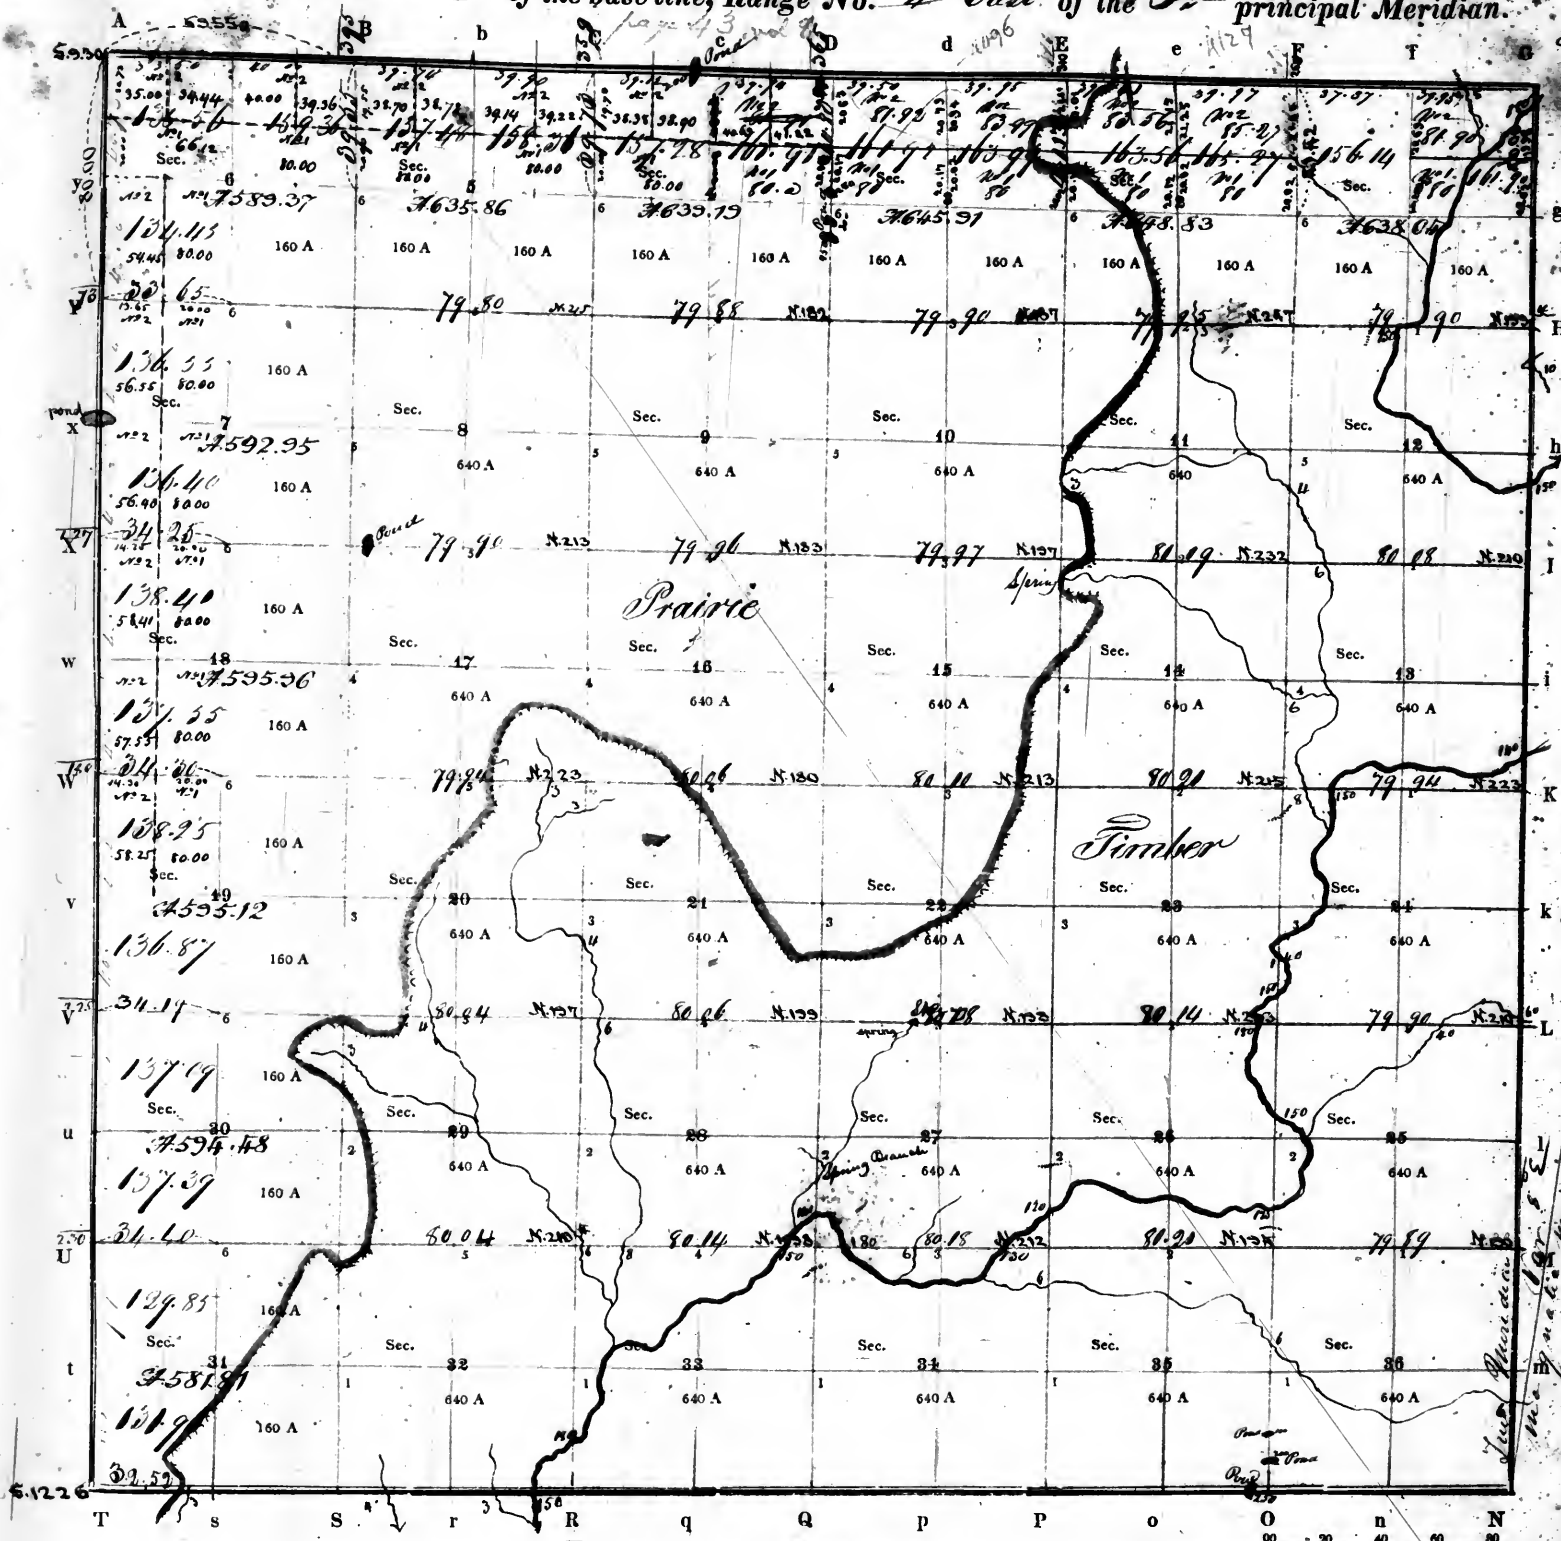

Surveyor's Office
St. Louis 10th Sept
Plat of the N.E. apt of sec
and of the North halves
2 & 3 sent this day to
of the Genl & O.

Surveyor's office
St. Louis Sept. 15th
The north halves, of sec
4 & 5 & 6, the South
the of sec 6, the
halves of sections 7, 8
and the north half
of section 19, and
within the act of
of the 5th of
and a plat was
and another to the
surveys of the
closed off.


Scale of 40 Chains to an inch.

PURSUANT to a contract with, and instructions from WILLIAM RECTOR, Surveyor of the lands of the United States in the States of Illinois and Territory of Arkansas - bearing date the third day of March 1821

I have admeasured, laid out and surveyed the above described Township; and do hereby certify, that it had such marks and bounds, both natural and artificial, as are represented on said plat, and described in the field notes made thereof, and returned with this plat into the Office of the Surveyor of the lands of the United States, for the States of Illinois and Territory of Arkansas

Certified this 14th day of September 1821


EXAMINED.

J. H. Rector D. SURVEYOR

Records

Township No. 13 North of the base line, Range No. 4 East of the 3rd principal Meridian.

456

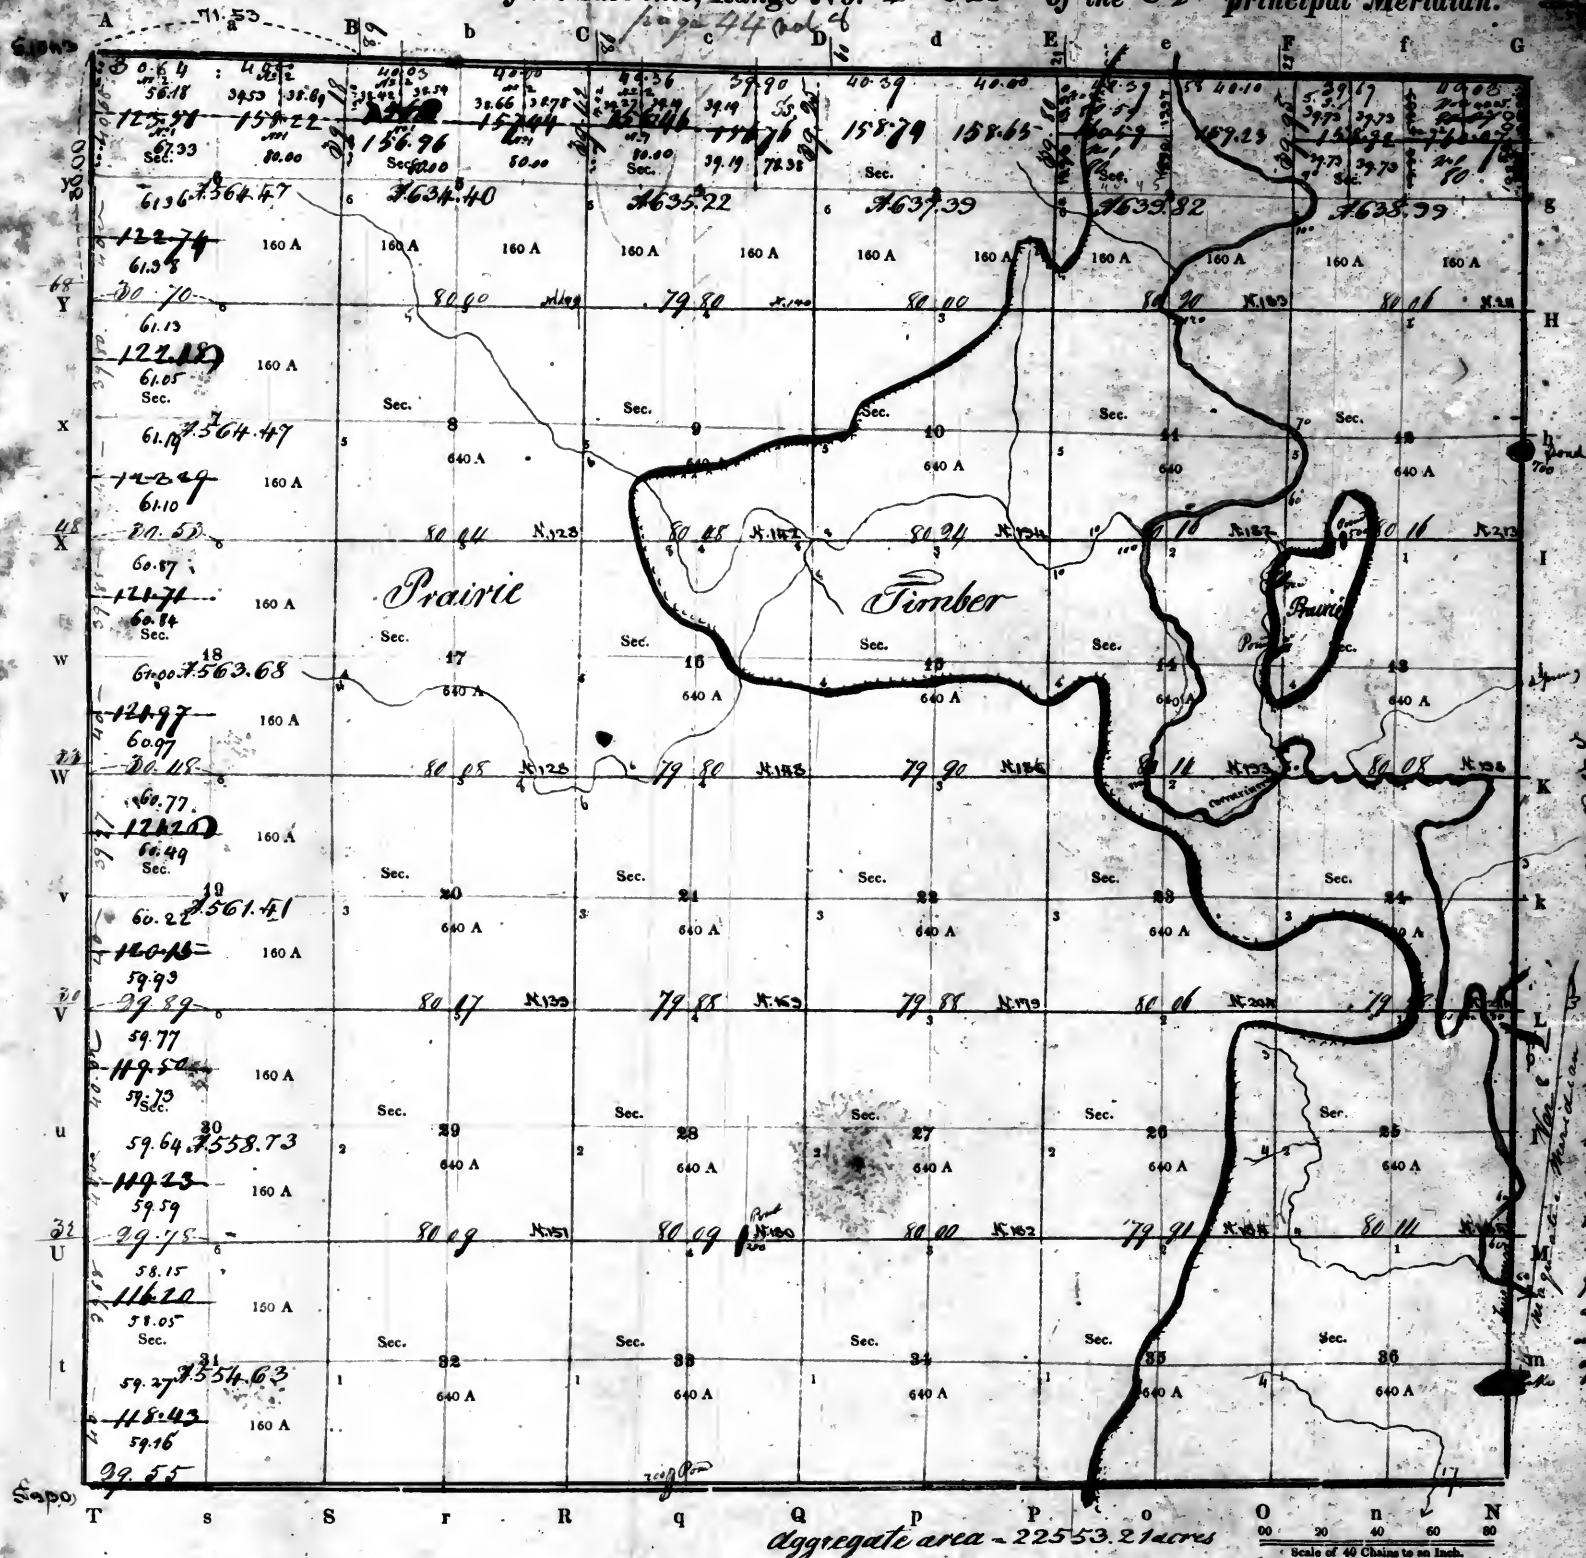

Surveyor's Office
Plat of the N.E. 1/4 of Sec.
of the 13. N. of R. 4. E. of
T. 13. N. of Sec. 36.
day to the Comm. of the
L.O.
Surveyor's Office
The North East quarter
of section 14, the
quarter of section 15, and the
half of section 16, and the
West half of section 17,
6, 7, 18, 19, 30 & 31 under
the act of Congress
5th of Jan'y 1832, - the
survey of addition 6, and
the North East quarter of
4, section 14, is as shown
from the previous plat, and
is a plat sent to the Register
and another to the Comm.
of the General Land Office.





EXAMINED.

Estee D. SURVEYOR.

Township No. 14 North of the base line, Range No. 4 East of the 2nd principal Meridian.

Recorded 437

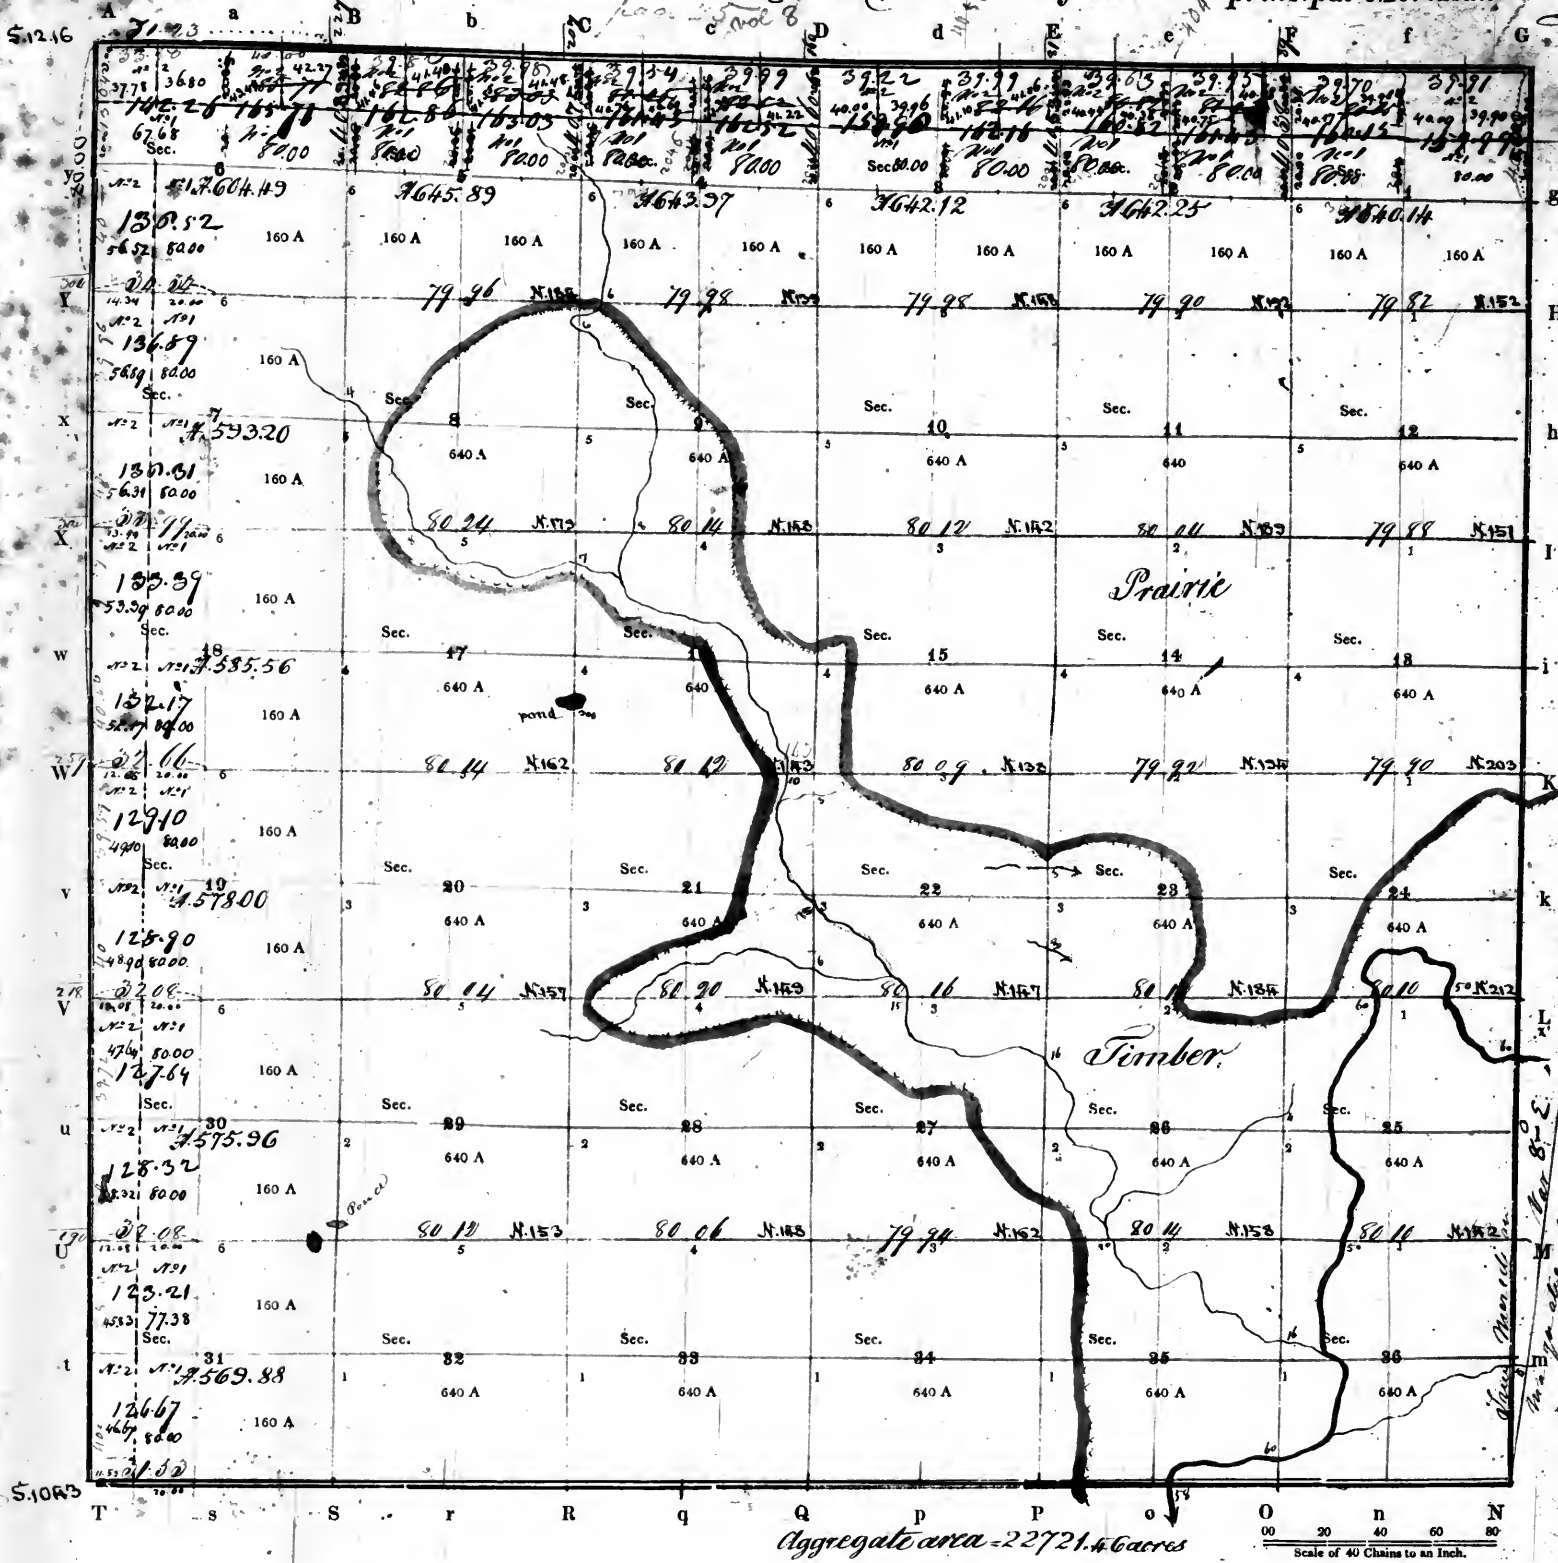

Surveyor's Office
St. Louis 17 August 1821
Plot of the N.W. quarter
of the N.E. quarter
and of the North halves
of sections 1, 2, 1000.

PURSUANT to a contract with, and instructions from WILLIAM RECTOR, Surveyor of the lands of the United States in the State of Missouri as a Surveyor and Chief of Arkansas - bearing date the 13th day of March 1821

I have admeasured, laid out and surveyed the above described Township; and do hereby certify, that it had such marks and bounds, both natural and artificial, as are represented on said plat, and described in the field notes made thereof, and returned with this plat into the Office of the Surveyor of the lands of the United States, for the State of Missouri as a Surveyor and Chief of Arkansas

Certified this 14th day of September 1821

Cokeer D. SURVEYOR.

EXAMINED.


[illegible]


Pursuant to a Contract with and instructions from William Bector Surveyor of the lands of the United States in the States of Missouri and Illinois and Territory of Arkansas bearing date the third day of March 1821 I have measured laid out and surveyed the above described Township and do hereby certify that it had such marks and bounds both natural and artificial as are represented on said plat and described in the field notes made thereof and returned with this plat into the Office of the Surveyor of the lands of the United States for the States of Missouri and Illinois and Territory of Arkansas

Certified this 14th day of September 1821

Chas. L. Smith

Recorded

Township No. 16 North of the base line, Range No. 4 East of the Third principal Meridian.

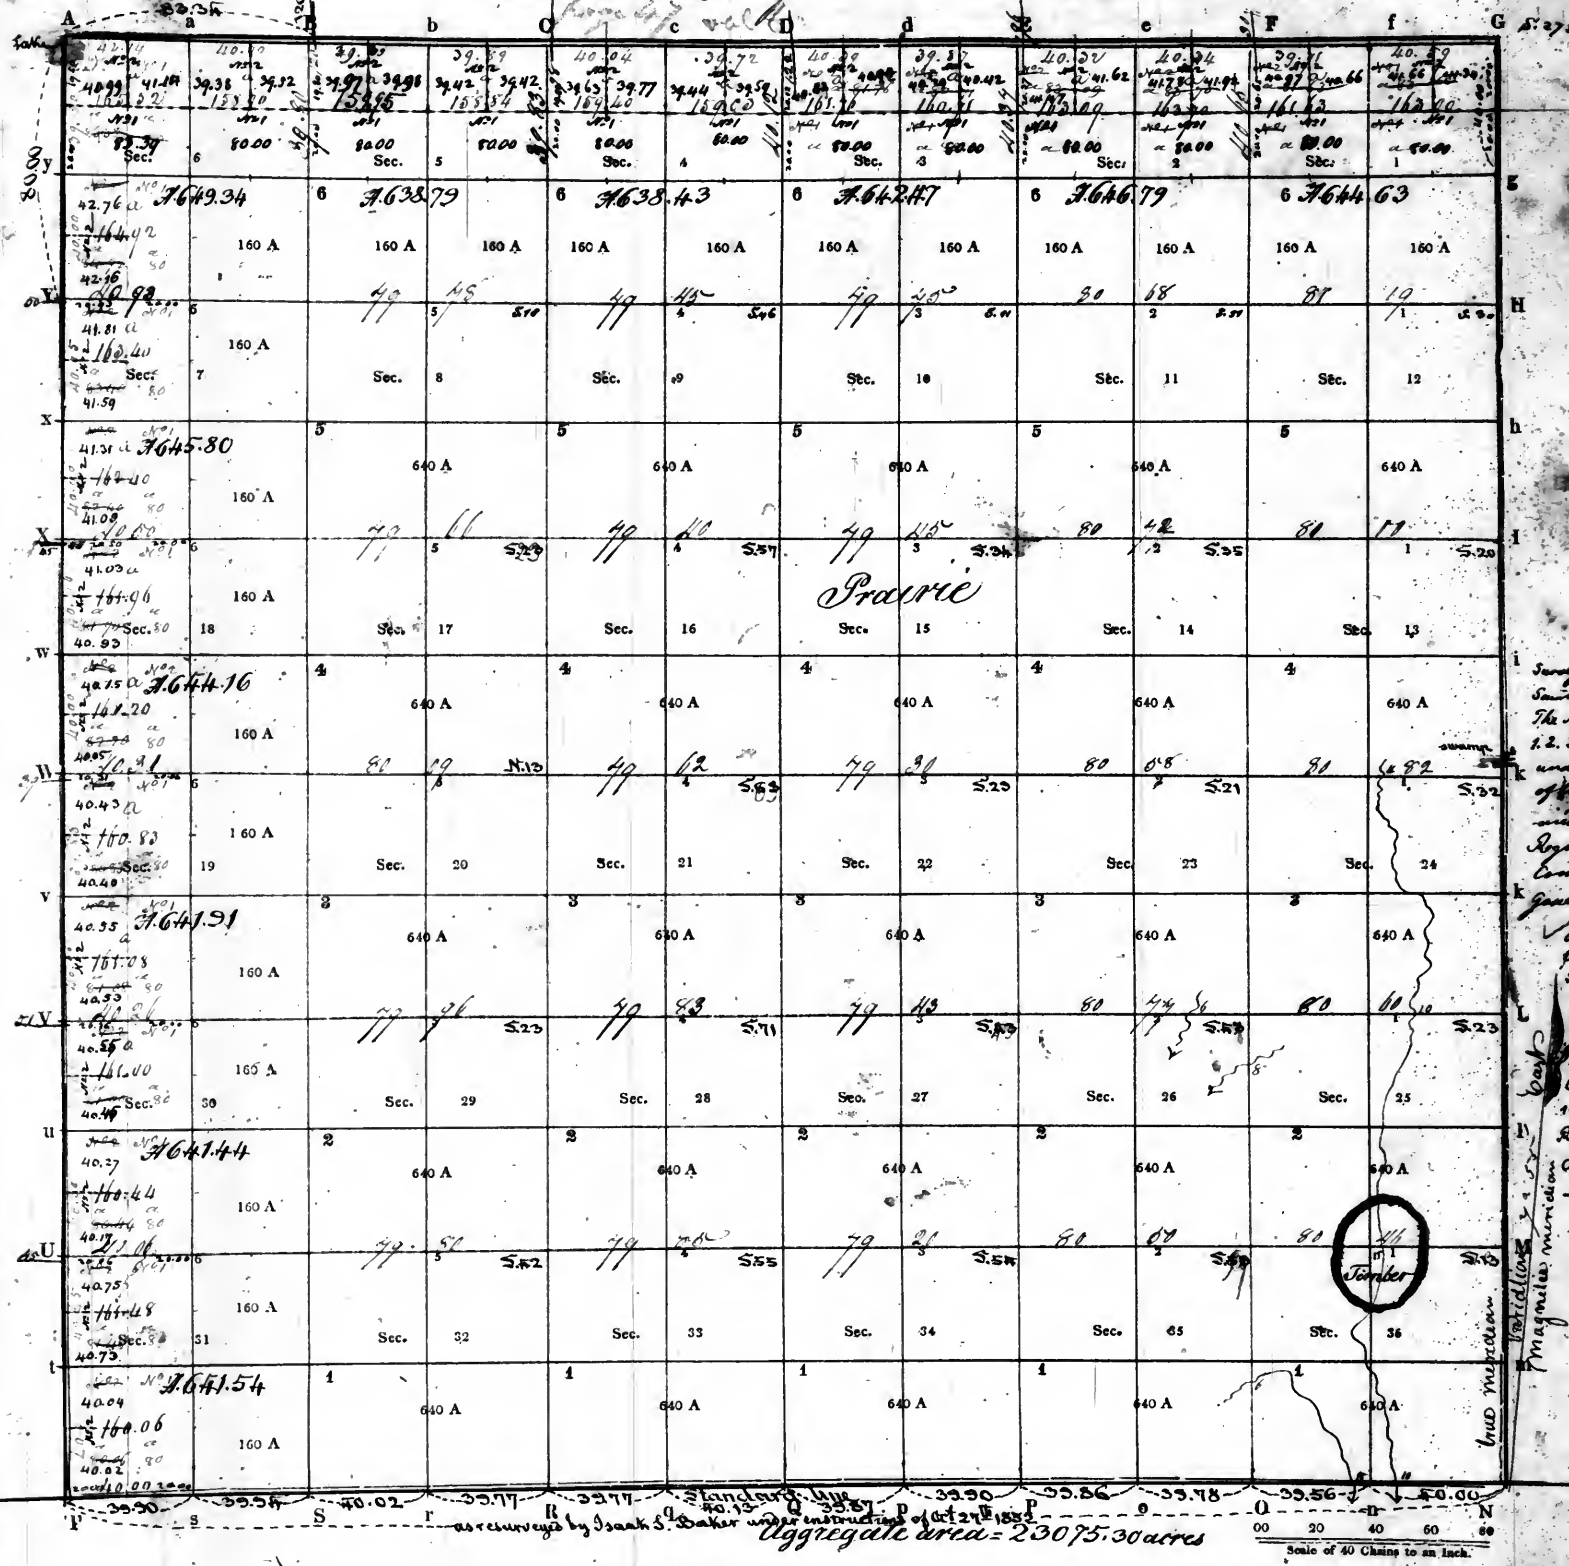


Surveyor's Office
Saint Louis, Mo.
The North West
under a grant of land
of the 5th of April 1820
and a plat of land
Register and another
Commissioner of the
General Land Office
Office of the Surveyor
for the State of Illinois
Saint Louis, Mo.
The South West
under a grant of land
of the 5th of April 1820
and a plat of land
Register and another
Commissioner of the
General Land Office

PURSUANT to a contract with, and instructions from William Rector, Surveyor of the lands of the United States in the State of Illinois
bearing date the _____ day of _____ 1822
I have admeasured, laid out and surveyed the above described Township; and do hereby certify, that it had such marks and bounds, both natural and artificial,
as are represented on said plat, and described in the field notes made thereof, and returned with this plat into the Office of the Surveyor of the Lands of the
United States, in the State of Illinois
Certified this _____ day of _____ 1822
EXAMINED.
B. SURVEYOR.

Revised

440.

Township No. *Twenty North* of the base line, Range No. *four east* of the *Third* principal Meridian.

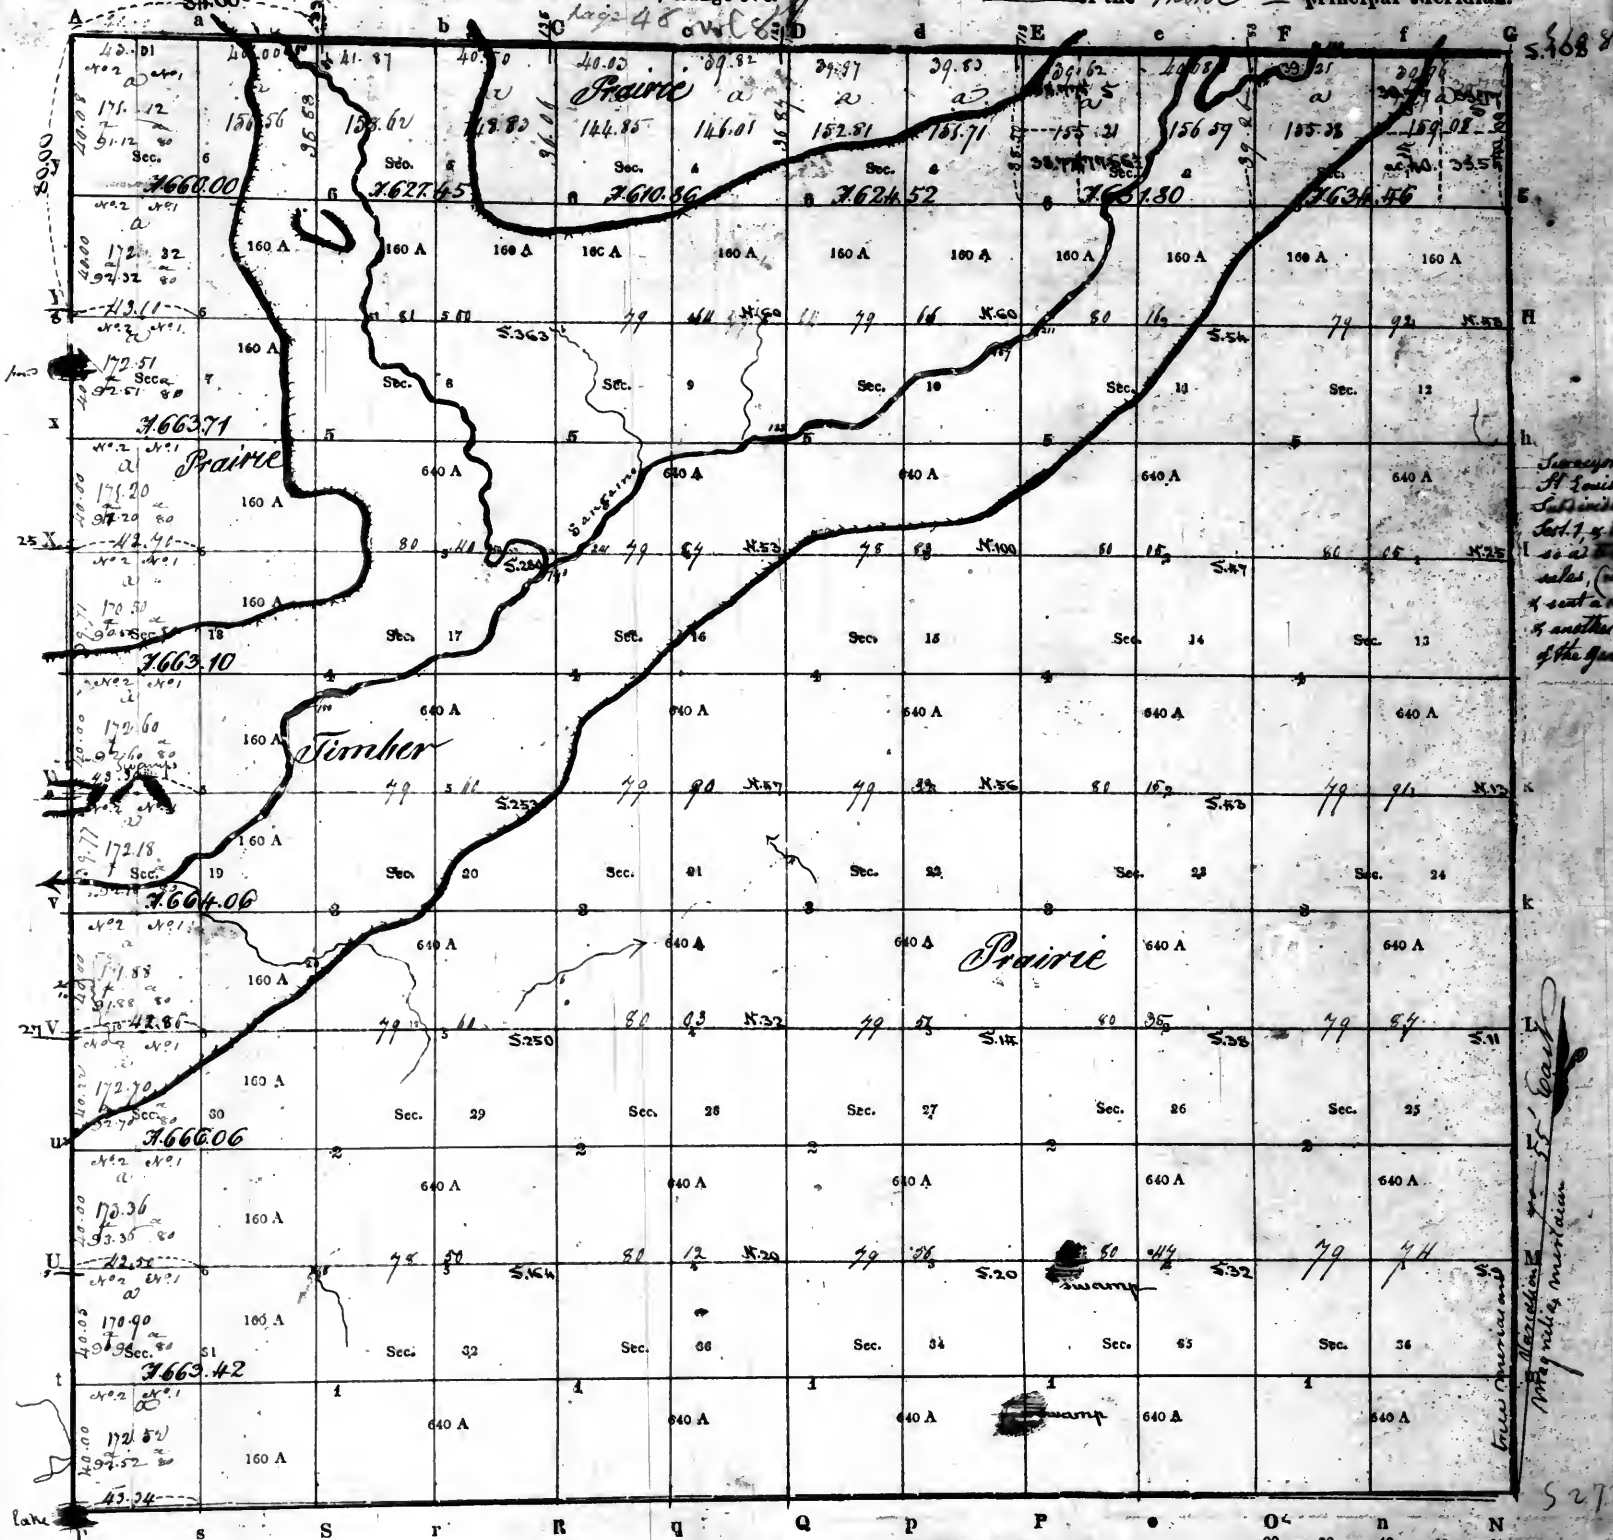

*Surveyor's Office
St. Louis, Mo.
Subscribed and
Sworn to, and
certified, that
the same is a
true and correct
copy of the
original of the
General Survey*

Notary Public for St. Louis, Mo.

Aggregate area = 23102.44 ac.


Scale of 40 Chains to an inch.

PURSUANT to a contract with, and instructions from William Rector, Surveyor of the lands of the United States in the *State of Illinois*
Missouri and Territory of Arkansas
I have measured, laid out and surveyed the above described Township; and do hereby certify, that it had such marks and bounds, both natural and artificial,
as are represented on said plat, and described in the field notes made thereof, and returned with this plat into the Office of the Surveyor of the Lands of the
United States, in the *State of Illinois Missouri and Territory of Arkansas*
Certified this *first* day of *March* 1823
EXAMINED.
W. H. Rector
D. SURVEYOR.

Recorded

441

Township No. 18 North of the base line, Range No. 4 East of the 3rd principal Meridian.

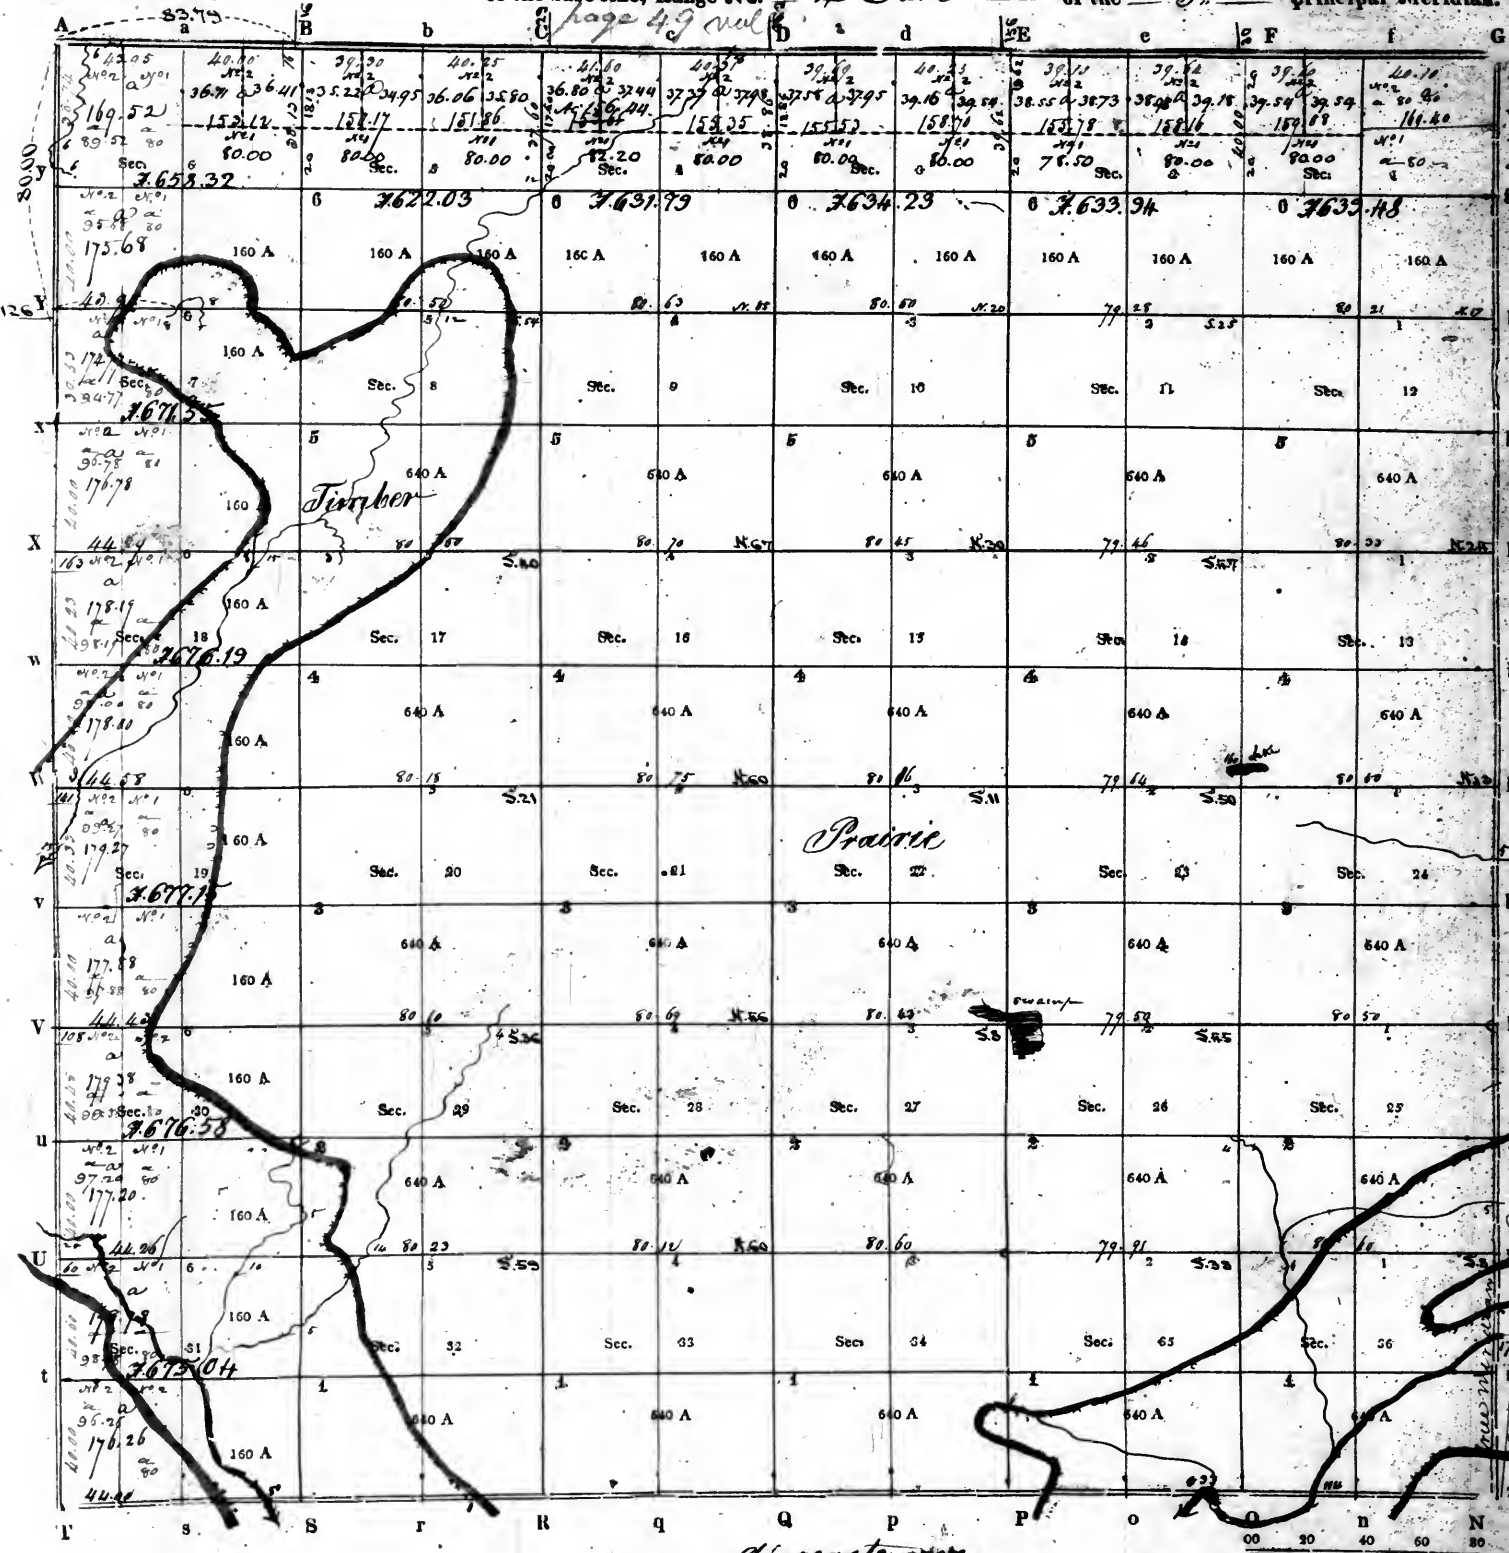


Surveyors of the
State of Illinois
of the
April 1832; the
of said 23rd
the 18th of
and of the
was and to the
H. Rector to the
one of the Surveyors
said office on the
same day

PURSUANT to a contract with, and instructions from William Rector, Surveyor of the lands of the United States in the State of Illinois
bearing date the nineteenth day of February 1832
I have measured, laid out and surveyed the above described Township; and do hereby certify, that it had such marks and bounds, both natural and artificial,
as are represented on said plat, and described in the field notes made thereof, and returned with this plat into the Office of the Surveyor of the Lands of the
United States, in the State of Illinois
Certified this first day of March 1833
EXAMINED.
Whorton Rector D. SURVEYOR

Roundup

442

Township No. *19 North* of the base line, Range No. *4 East* of the *3rd* principal Meridian.

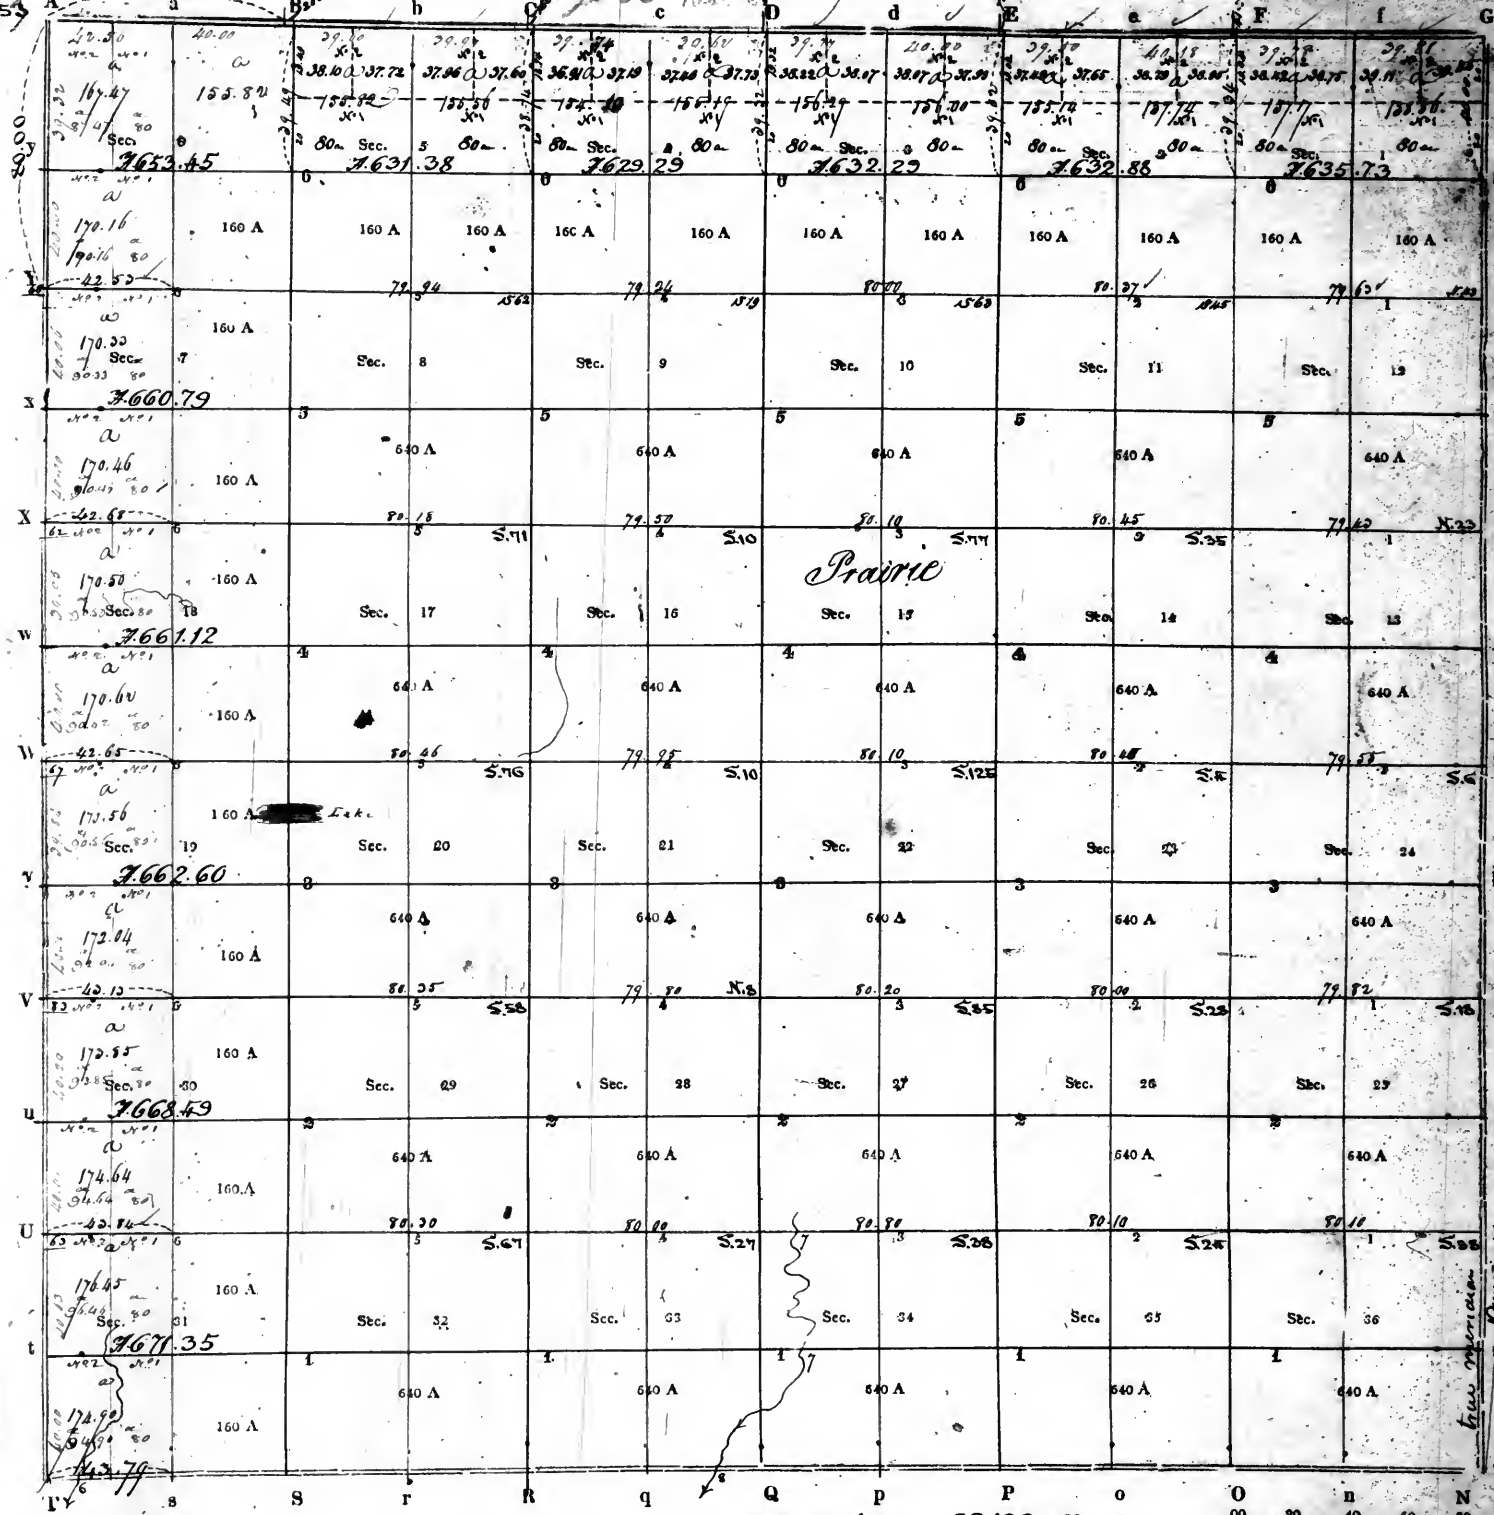

Part of section 1, 2, 1000.

Aggregate area = 23139.37 ac


Scale of 40 Chains to an inch.

PURSUANT to a contract with, and instructions from William Reector, Surveyor of the lands of the United States in the *State of Illinois* bearing date the *nineteenth* day of *February* 1882
I have measured, laid out and surveyed the above described Township; and do hereby certify, that it had such marks and bounds, both natural and artificial, as are represented on said plat, and described in the field notes made thereof, and returned with this plat into the Office of the Surveyor of the Lands of the United States, in the *State of Illinois Michigan and Territory of Arkansas*
Certified this *first* day of *March* 1883
EXAMINED.
Wm Reector
D. SURVEYOR.

Revised

443

Township No. - 20 North of the base line, Range No. - 4 East of the - 3rd - principal Meridian.

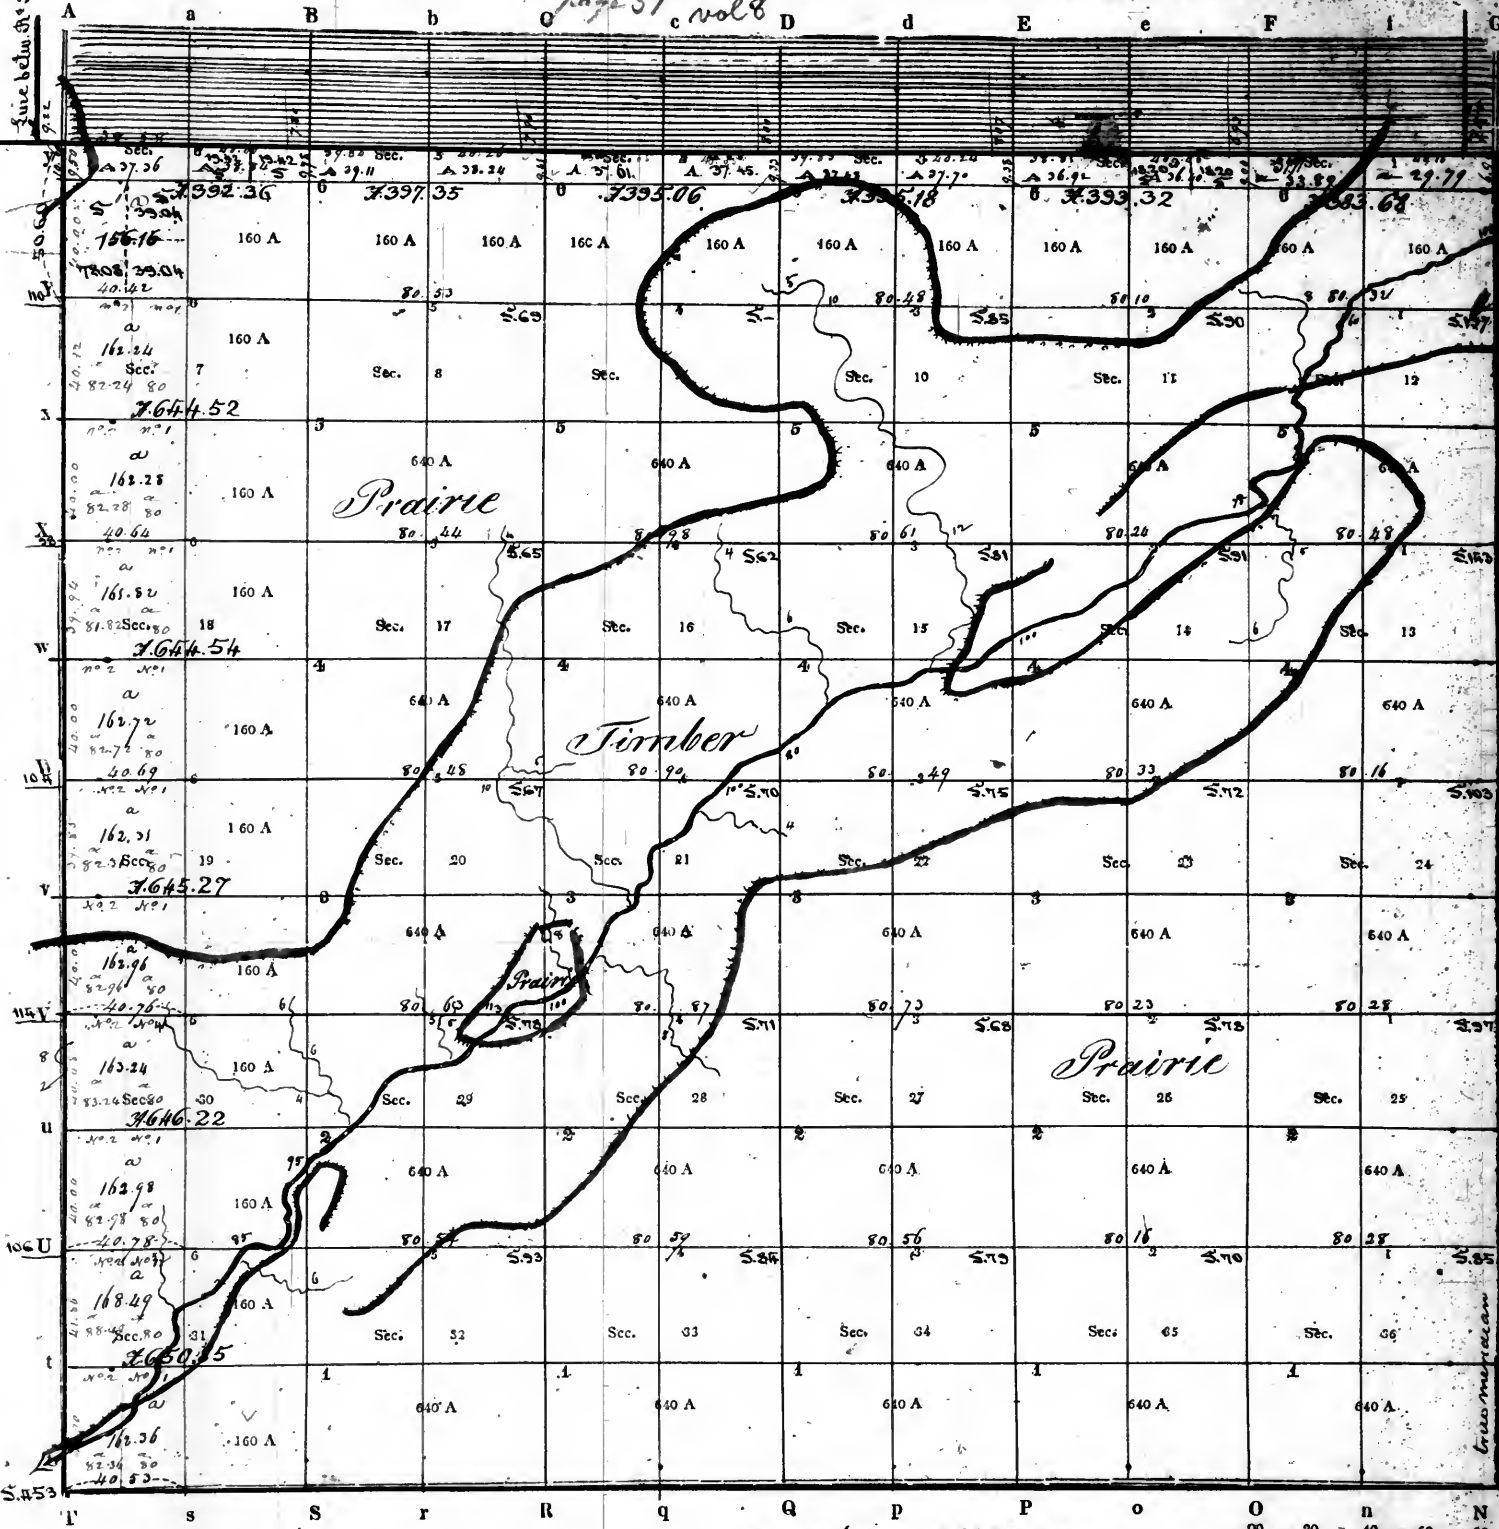

Standard line
Surveyor's Office
St. Louis, Mo. 1882


Aggregate area - 2757827 acres


Scale of 40 Chains to an Inch.

PURSUANT to a contract with, and instructions from William Reector, Surveyor of the lands of the United States in the State of Illinois
Missouri and Territory of Arkansas, bearing date the nineteenth day of February 1882
I have measured, laid out and surveyed the above described Township; and do hereby certify, that it had such marks and bounds, both natural and artificial,
as are represented on said plat, and described in the field notes made thereof, and returned with this plat into the Office of the Surveyor of the Lands of the
United States, in the State of Illinois, Missouri and Territory of Arkansas.
Certified this first day of March 1883
Wm Reector D. SURVEYOR.
EXAMINED.

John Barcroft D. Surgery

Recorded

Township No. 22 North of the base line, Range No. 4 East of the 3rd Principal Meridian

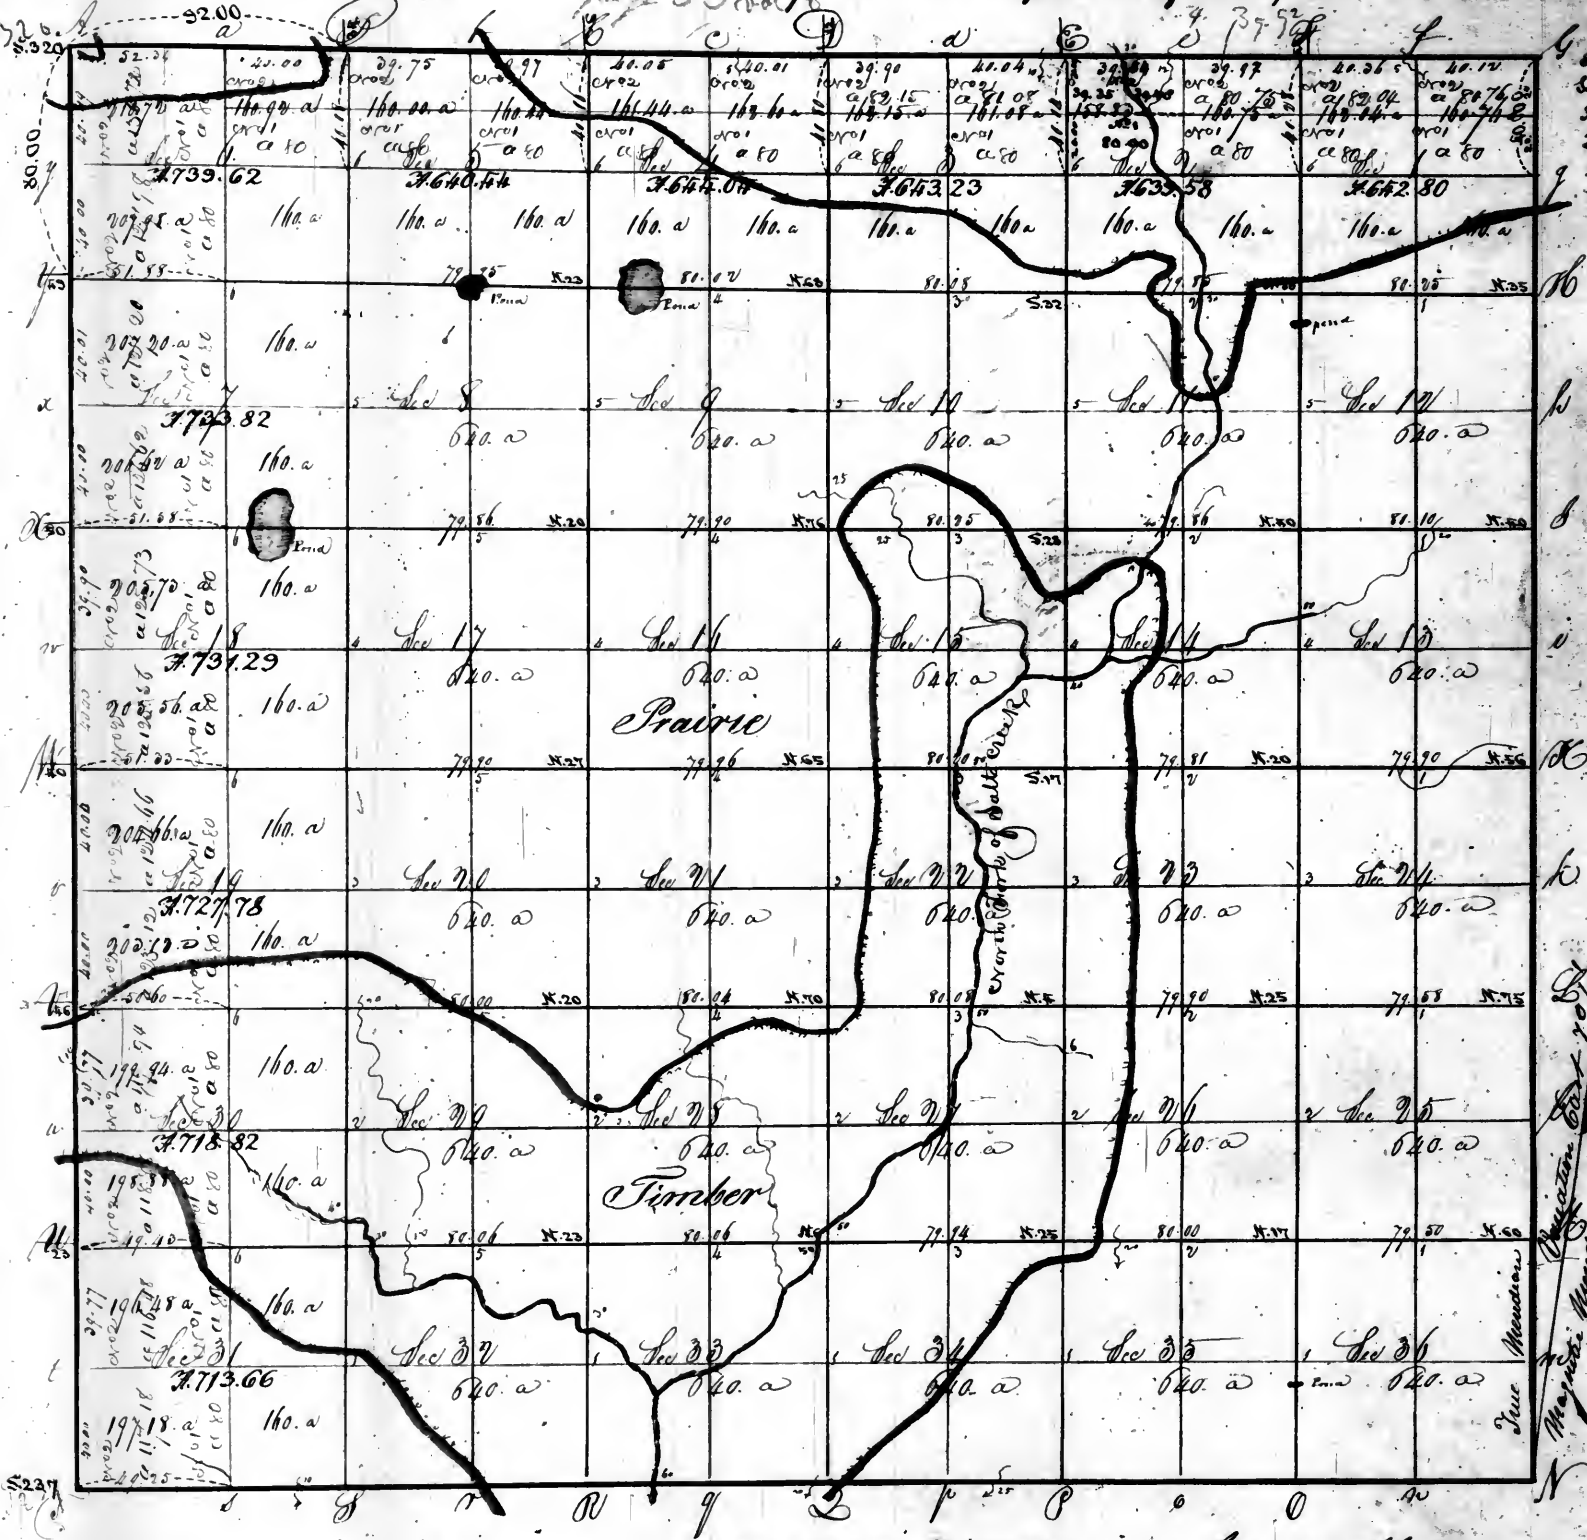

Surveyor's Office
Saint-Louis, Mo. 5th 1849
The North and quarter of section
2 subdivided and sold
sent to the Register and
to the Commissioner

Original East 1040
Major's Meridian

Pursuant to a contract with an Instructions from William B. Lewis Surveyor of the lands of the United States in the State of Illinois, Missouri and Territory of Arkansas, bearing date, the first day of December 1820. I have accompanied, laid out and surveyed the above described Township; and do hereby certify, that it has such marks and bearings, both natural and artificial were represented on said described in the field notes made thereof, and returned with this plat into the office of the Surveyor of the lands of the United States of Illinois and Missouri and Territory of Arkansas.


Certified this 23rd day of June 1844.

John Barcroft D. Surveyor

Recorded

Township N. 23 North of the base line, Range N. 4 East of the 3rd Principal Meridian

page 54 and 8

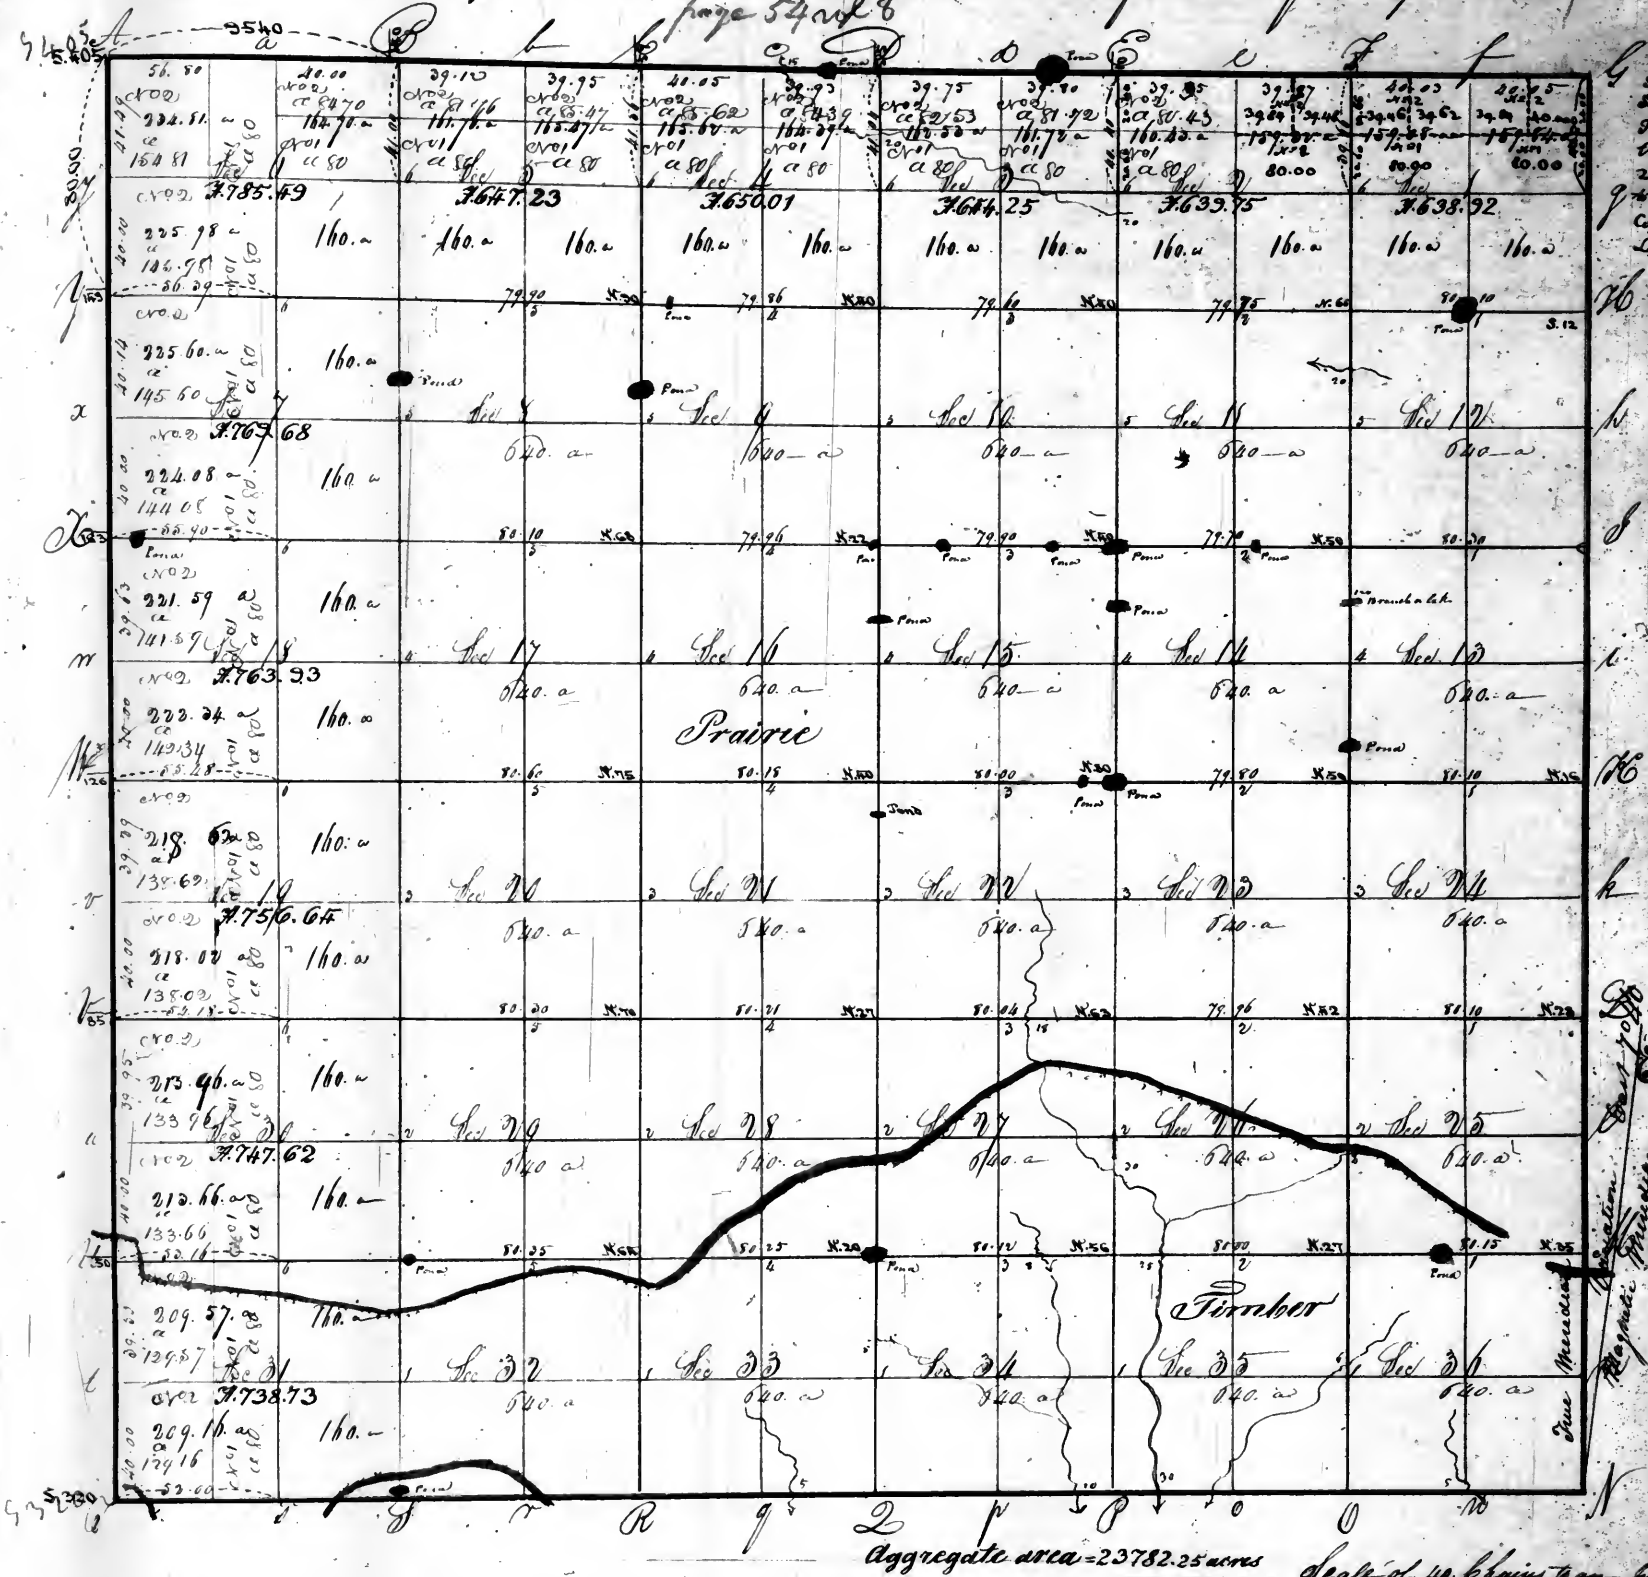

Surveyor's Office
Saint Louis June 15th 1824
The North half of section
the North East quarter of
2 sections, and 2 sections
of the Range 4 East of the
3rd Principal Meridian
Land Office


Pursuant to a contract with, and instructions from William P. Croft Surveyor of the Lands of the United States in the State of
Missouri and Territory of Arkansas bearing date the first day of December 1823 I have admeasured laid out and
surveyed the above described Township; and do hereby certify that it has such marks and bounds, both natural and artificial
as are represented on said plat, and described in the field notes made thereof, and returned with this plat into the office of
the Surveyor of the Lands of the United States in the State of Missouri and Territory of Arkansas

Certified this 23rd day of June 1824

John. Barcroft D. Surveyor

Revised

Township N. 24 North of the base line, Range N. 4 East of the 3rd Principal Meridian

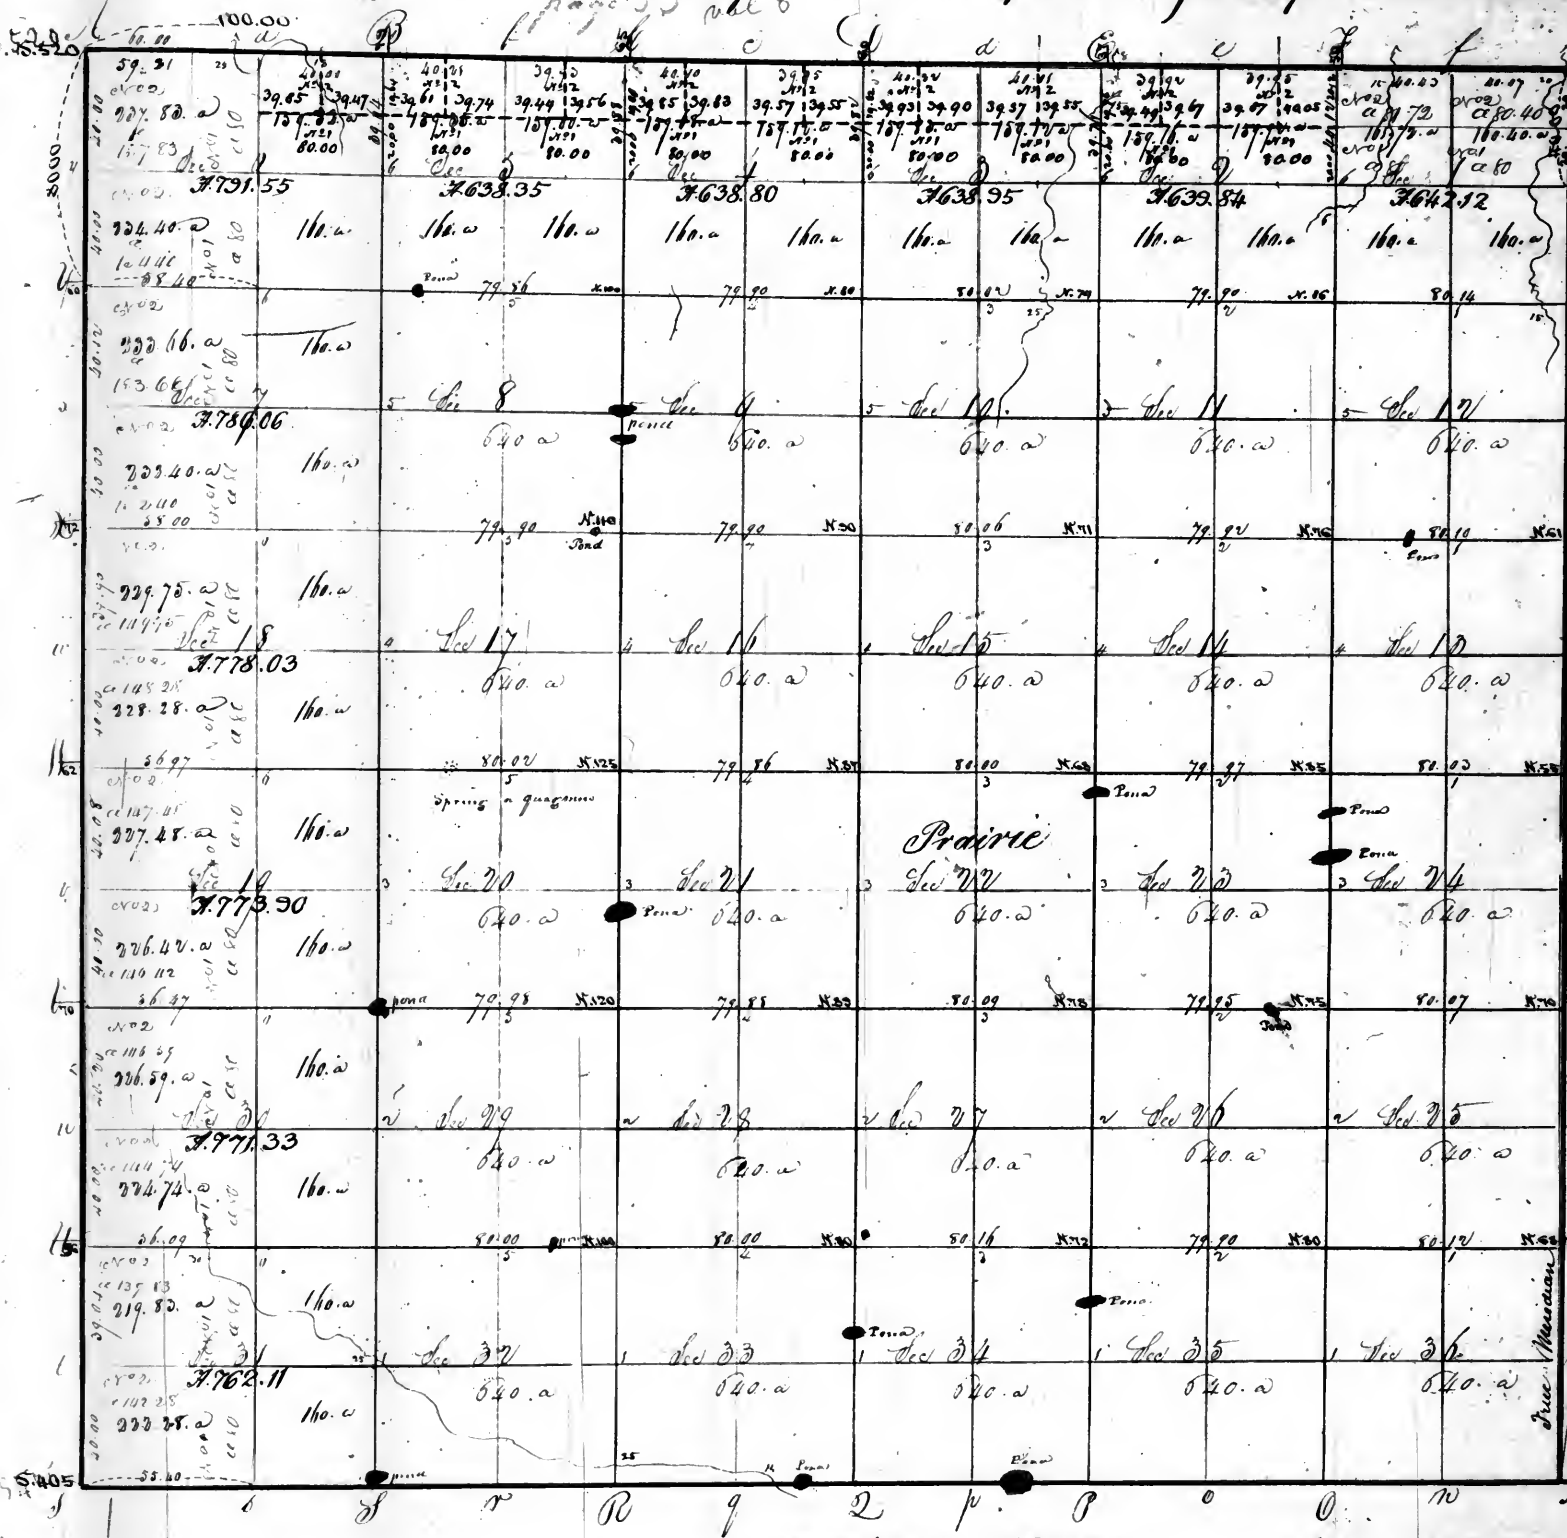

Surveyor's office
June 15th 1894
The north lines of sections
2, 3, 4, 5 and the North East
quarter of section 6, containing
9 and a half acres, to the
and another to the Commission
of the General Land Office

June 15th 1894

Aggregate area = 23861.04 ac

Scale of 40 chains to an inch


Pursuant to a Subpoena with, and Instructions from, William H. Rector, Surveyor of the lands of the United States in the State of Illinois and Missouri and Territory of Arkansas, bearing date the first day of December 1893, I have examined, laid out and surveyed the above described Township; and do hereby certify that it has such marks and bounds both natural and artificial as are represented on said plat and described in the field notes made thereof, and returned with this plat into the Office of the Surveyor of the lands of the United States in the State of Illinois and Missouri and Territory of Arkansas.

Certified this 23rd day of June 1894

John Barcroft D. Surveyor

721

Township No. 31 North of the base line, Range No. 4 East of the 3 principal Meridian.

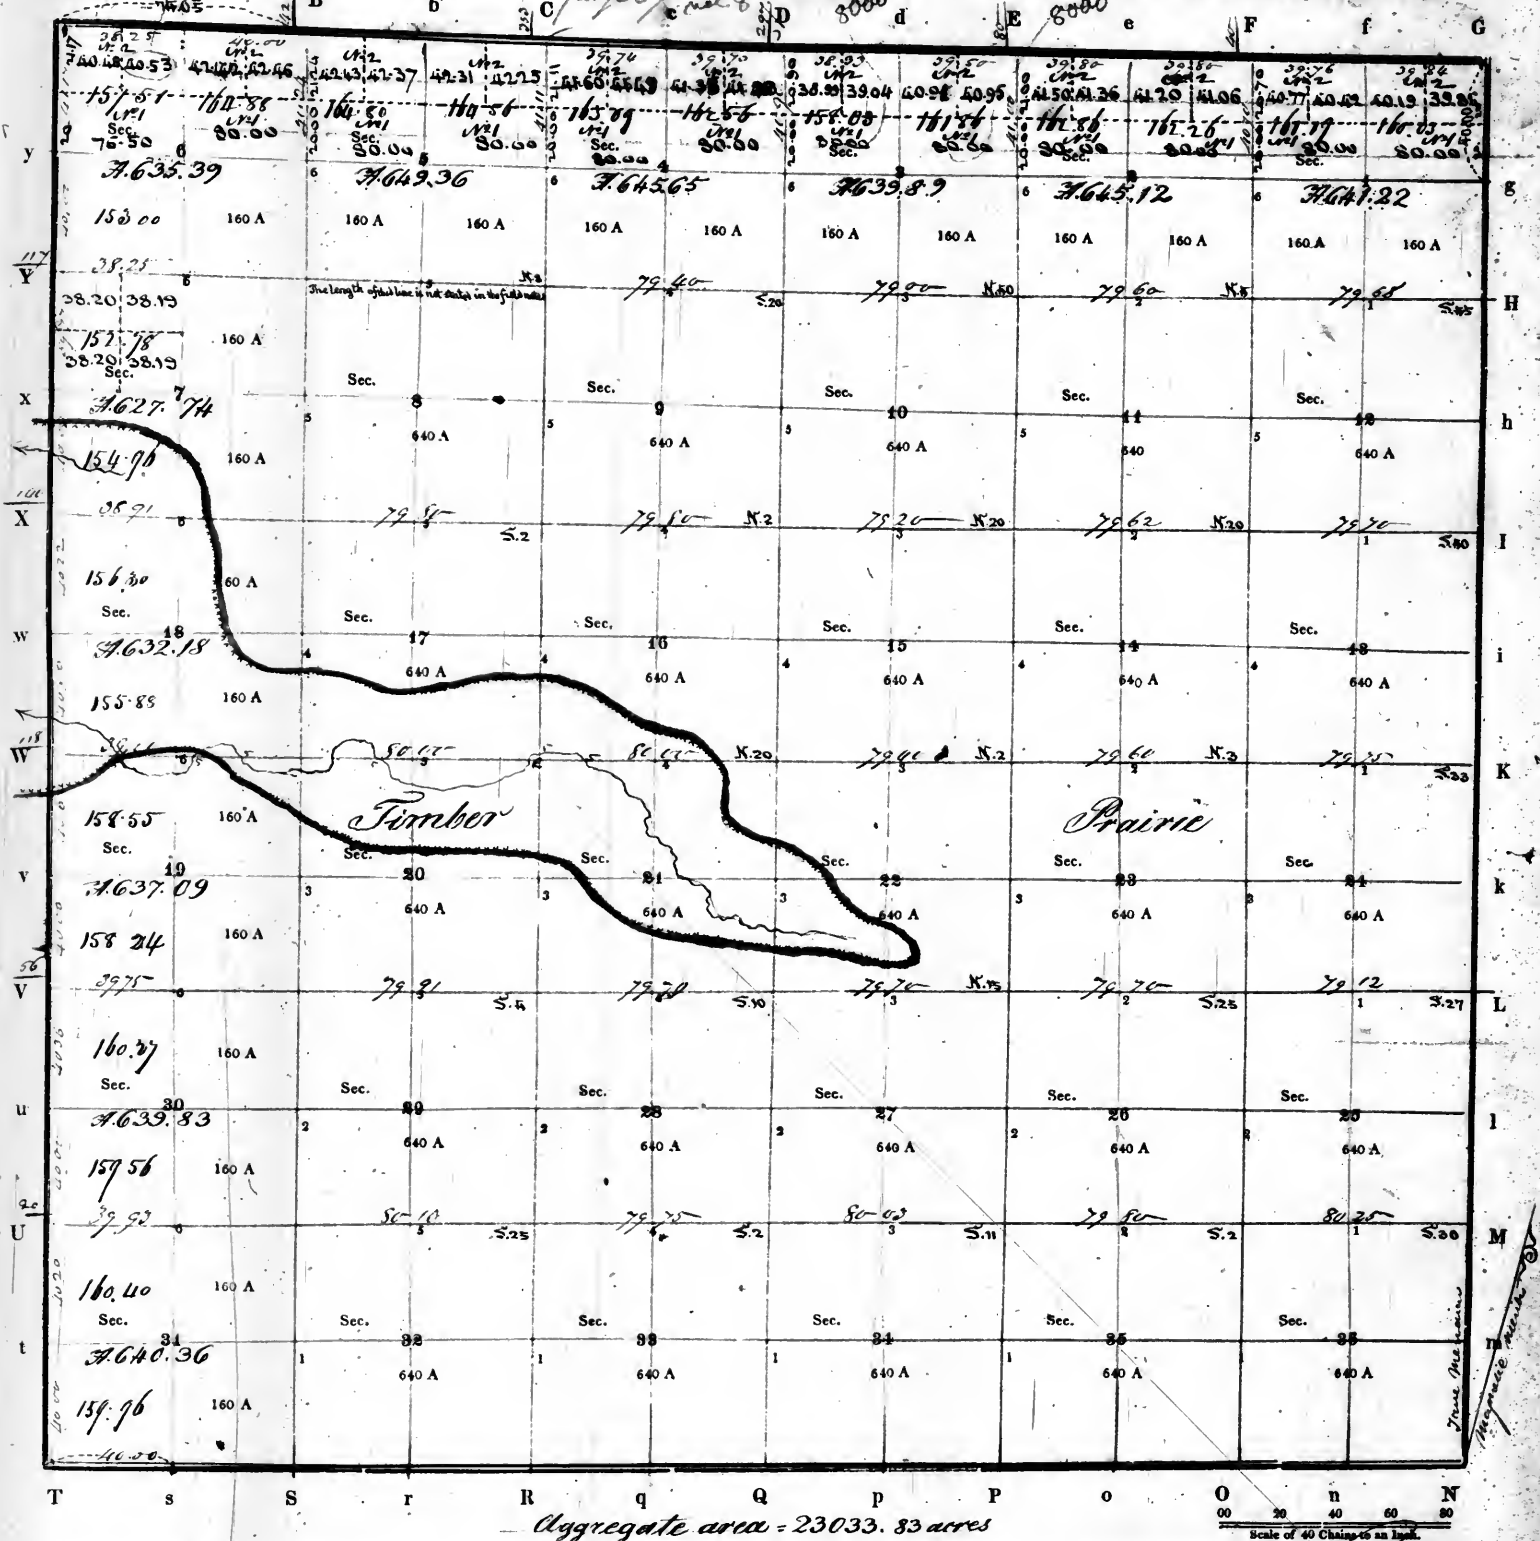

PURSUANT to a contract with, and instructions from WILLIAM RECTOR, Surveyor of the lands of the United States in the State of Missouri & Territory of Arkansas bearing date the 20th day of March 1861

I have admeasured, laid out and surveyed the above described Township; and do hereby certify, that it had such marks and bounds, both natural and artificial, as are represented on said plat, and described in the field notes made thereof, and returned with this plat into the Office of the Surveyor of the lands of the United States, for the State of Missouri & Territory of Arkansas

Certified this day of


Surveyor's Office
Saint Louis 12th November 1864

D. SURVEYOR.

EXAMINED.

Subdivided under the Act of 1832, viz. the 1st of Dec. 1, 2, 3, 4, 5 & 6; and sent to my copies of the plat thereof, one to the Commissioner, and another to the Register on the 24th of August 1865.

Township No. 32 North of the base line, Range No. 4 East of the 3rd principal Meridian.

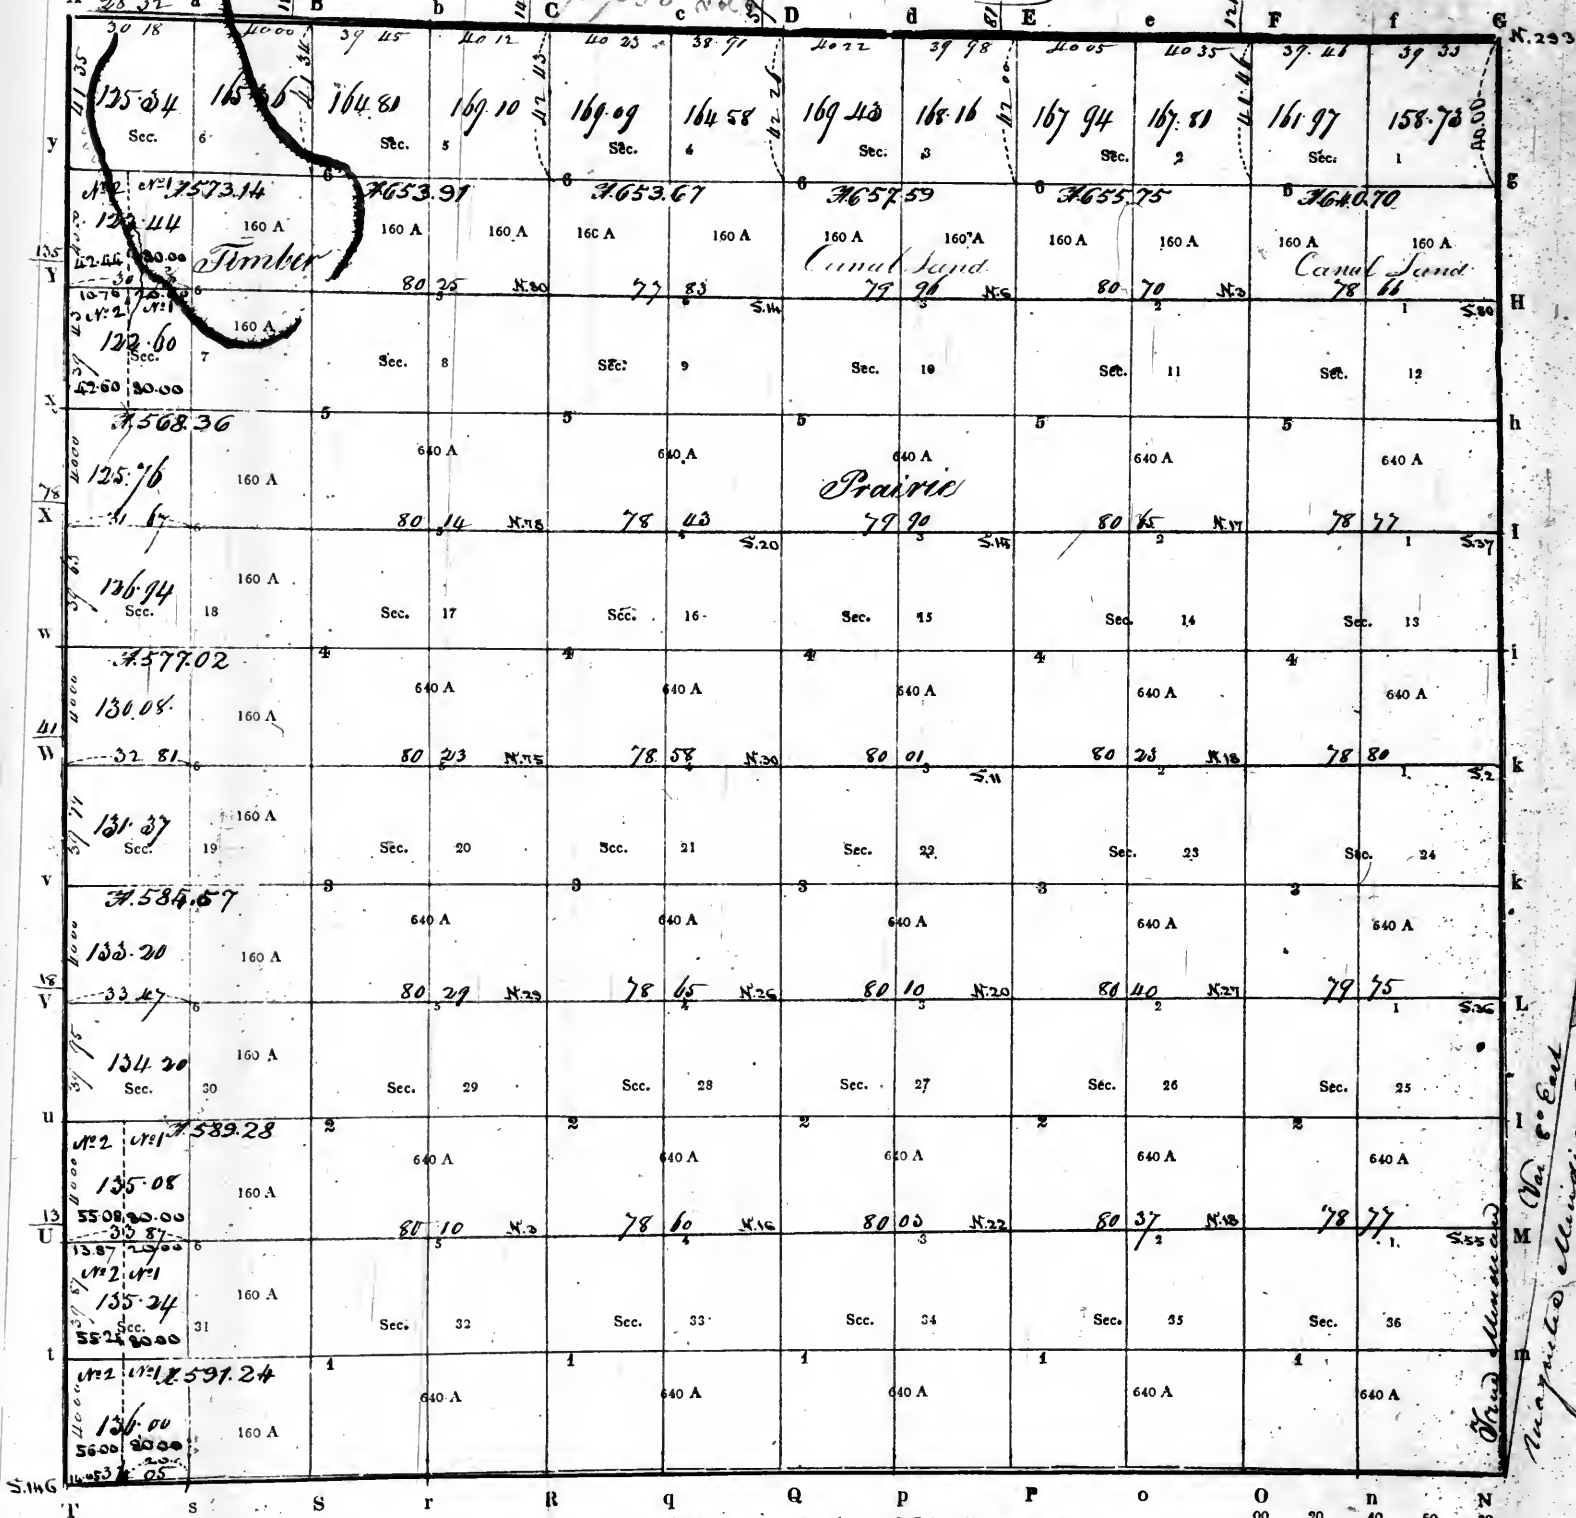

Aggregate area = 22745.23 acres

PURSUANT to a contract with, and instructions from William Rector, Surveyor of the lands of the United States in the State of Illinois and Territory of Arkansas, bearing date the 10th day of March 1881, I have admeasured, laid out and surveyed the above described Township; and do hereby certify, that it had such marks and bounds, both natural and artificial, as are represented on said plat, and described in the field notes made thereof, and returned with this plat into the Office of the Surveyor of the Lands of the United States, in the State of Illinois and Territory of Arkansas.

Certified this day of 1881
EXAMINED.

D. SURVEYOR.


Surveyor's Office

St. Louis 12th March 1881

Subdivided under the Act of 1832, viz. the Act of Dec 6 & 30, the Act of Dec 7, and the Act of Dec 31, and have today a copy of the plat thereof, on to the State & another to the Commissioner, on the 17th of August 1881.

Township N^o 33 North of the Base line Range N^o 4 East of the 3^d Meridian 123.

page 59 vol 8

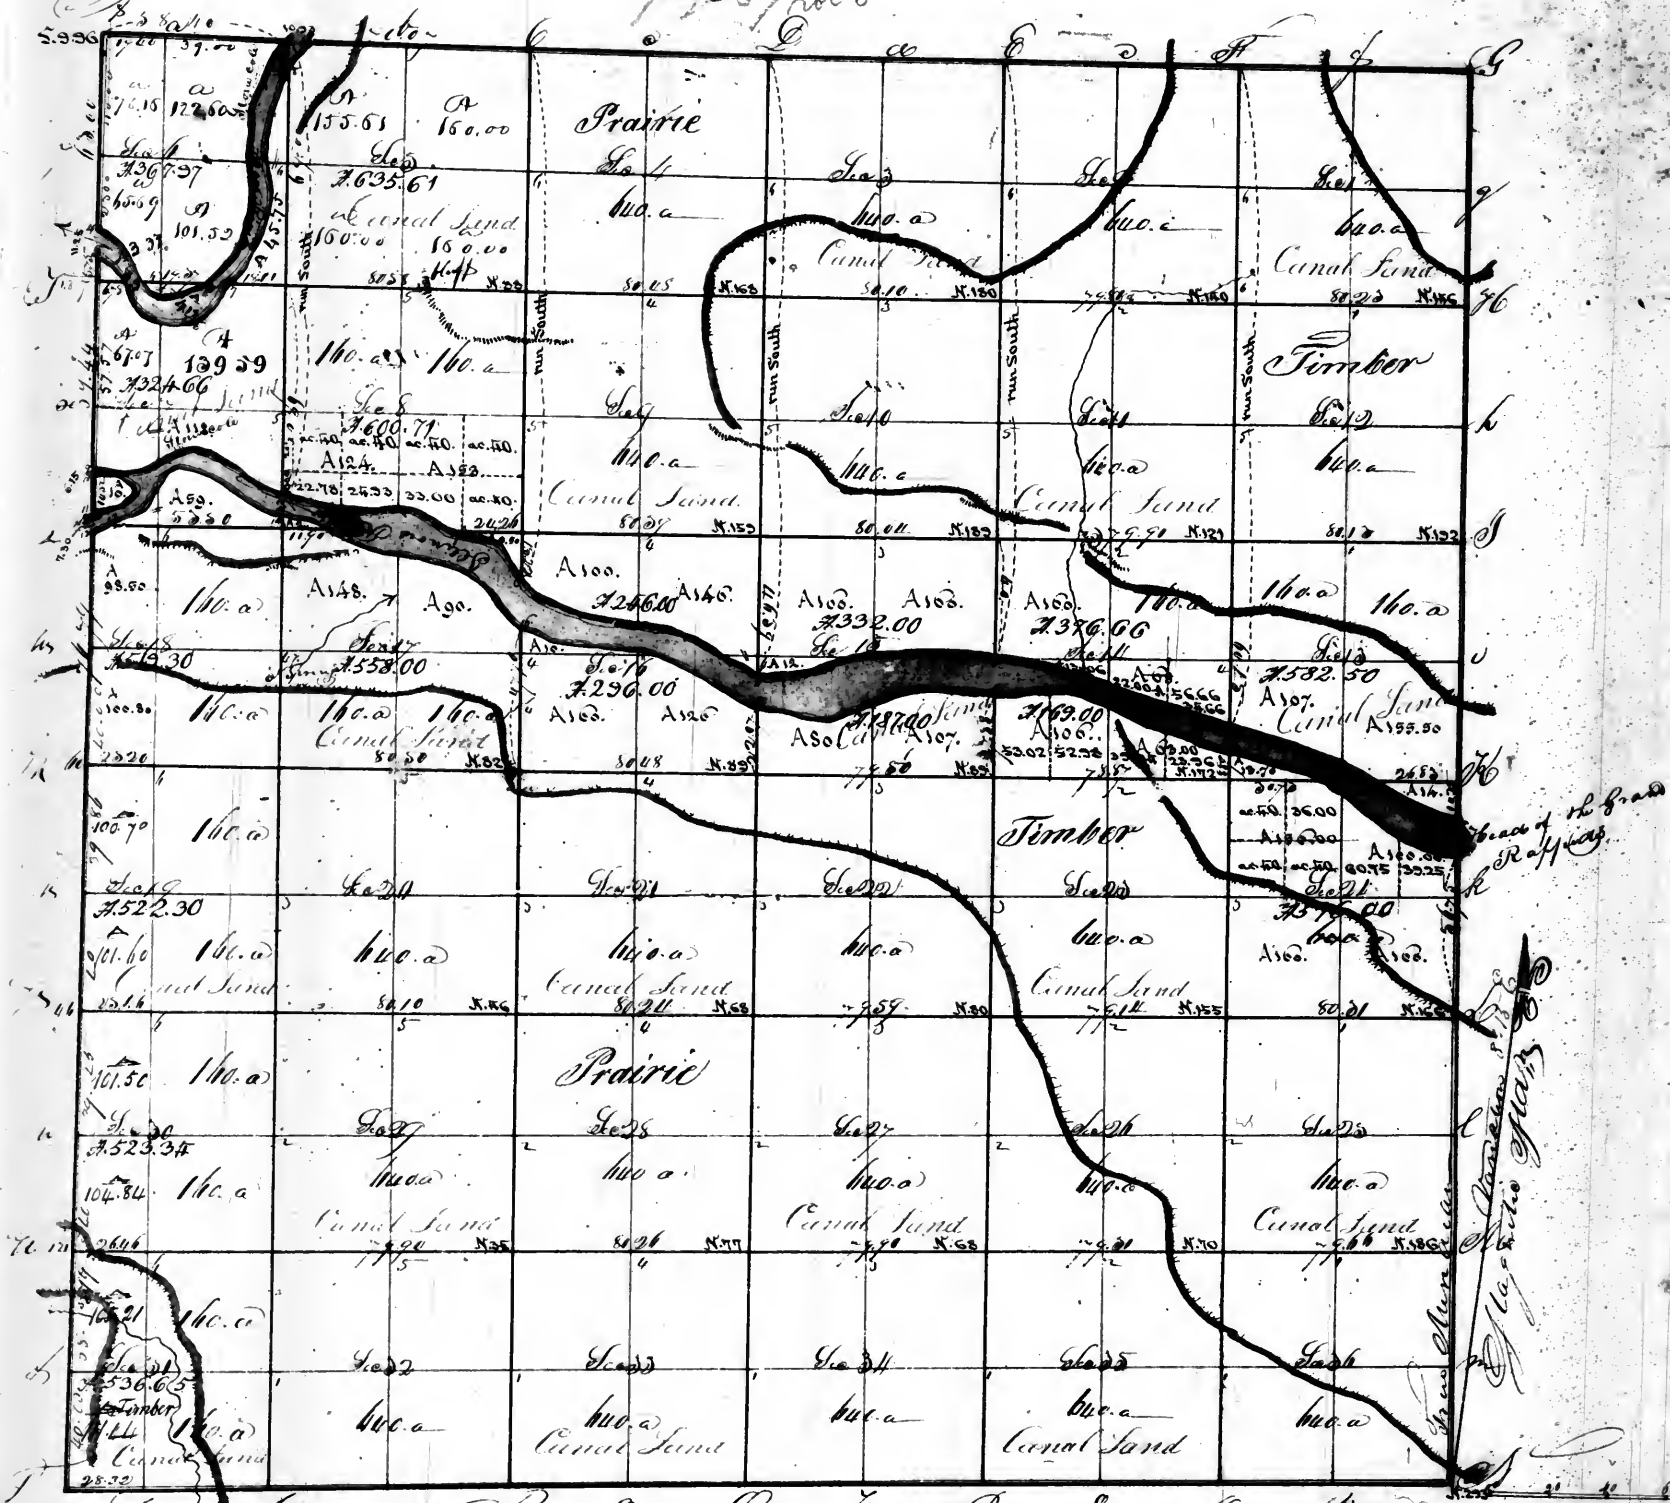


Aggregate area of public land - 21601.02 ac
 Estimated area of the river = 700.00 -
 Total = 22301.02 ac
 See down by a scale of 40 chs
 to an Inch

Pursuant to a contract with an instructions from William Reister Surveyor of the Lands of the United States in the States of Illinois & Missouri & Territory of Arkansas bearing date the 31st day of March 1821 We have a commission laid out and surveyed the above described Township N° 33 North of the Base line Range N° 4 East of the 3rd Meridian and by being that it had such marks and bounds both natural and artificial as an representation on said plat and annexed in the field notes made thereof and returned with this plat into the office of the Surveyor of the Lands of the United States in the States of Illinois & Missouri & Territory of Arkansas bearing the first date 1822

Examined
 The C. Reister &
 Stephen Reister &c

Township N° 34 North of the Base and Range N° 4 East 3d Principal Meridian

page 60 vol 6

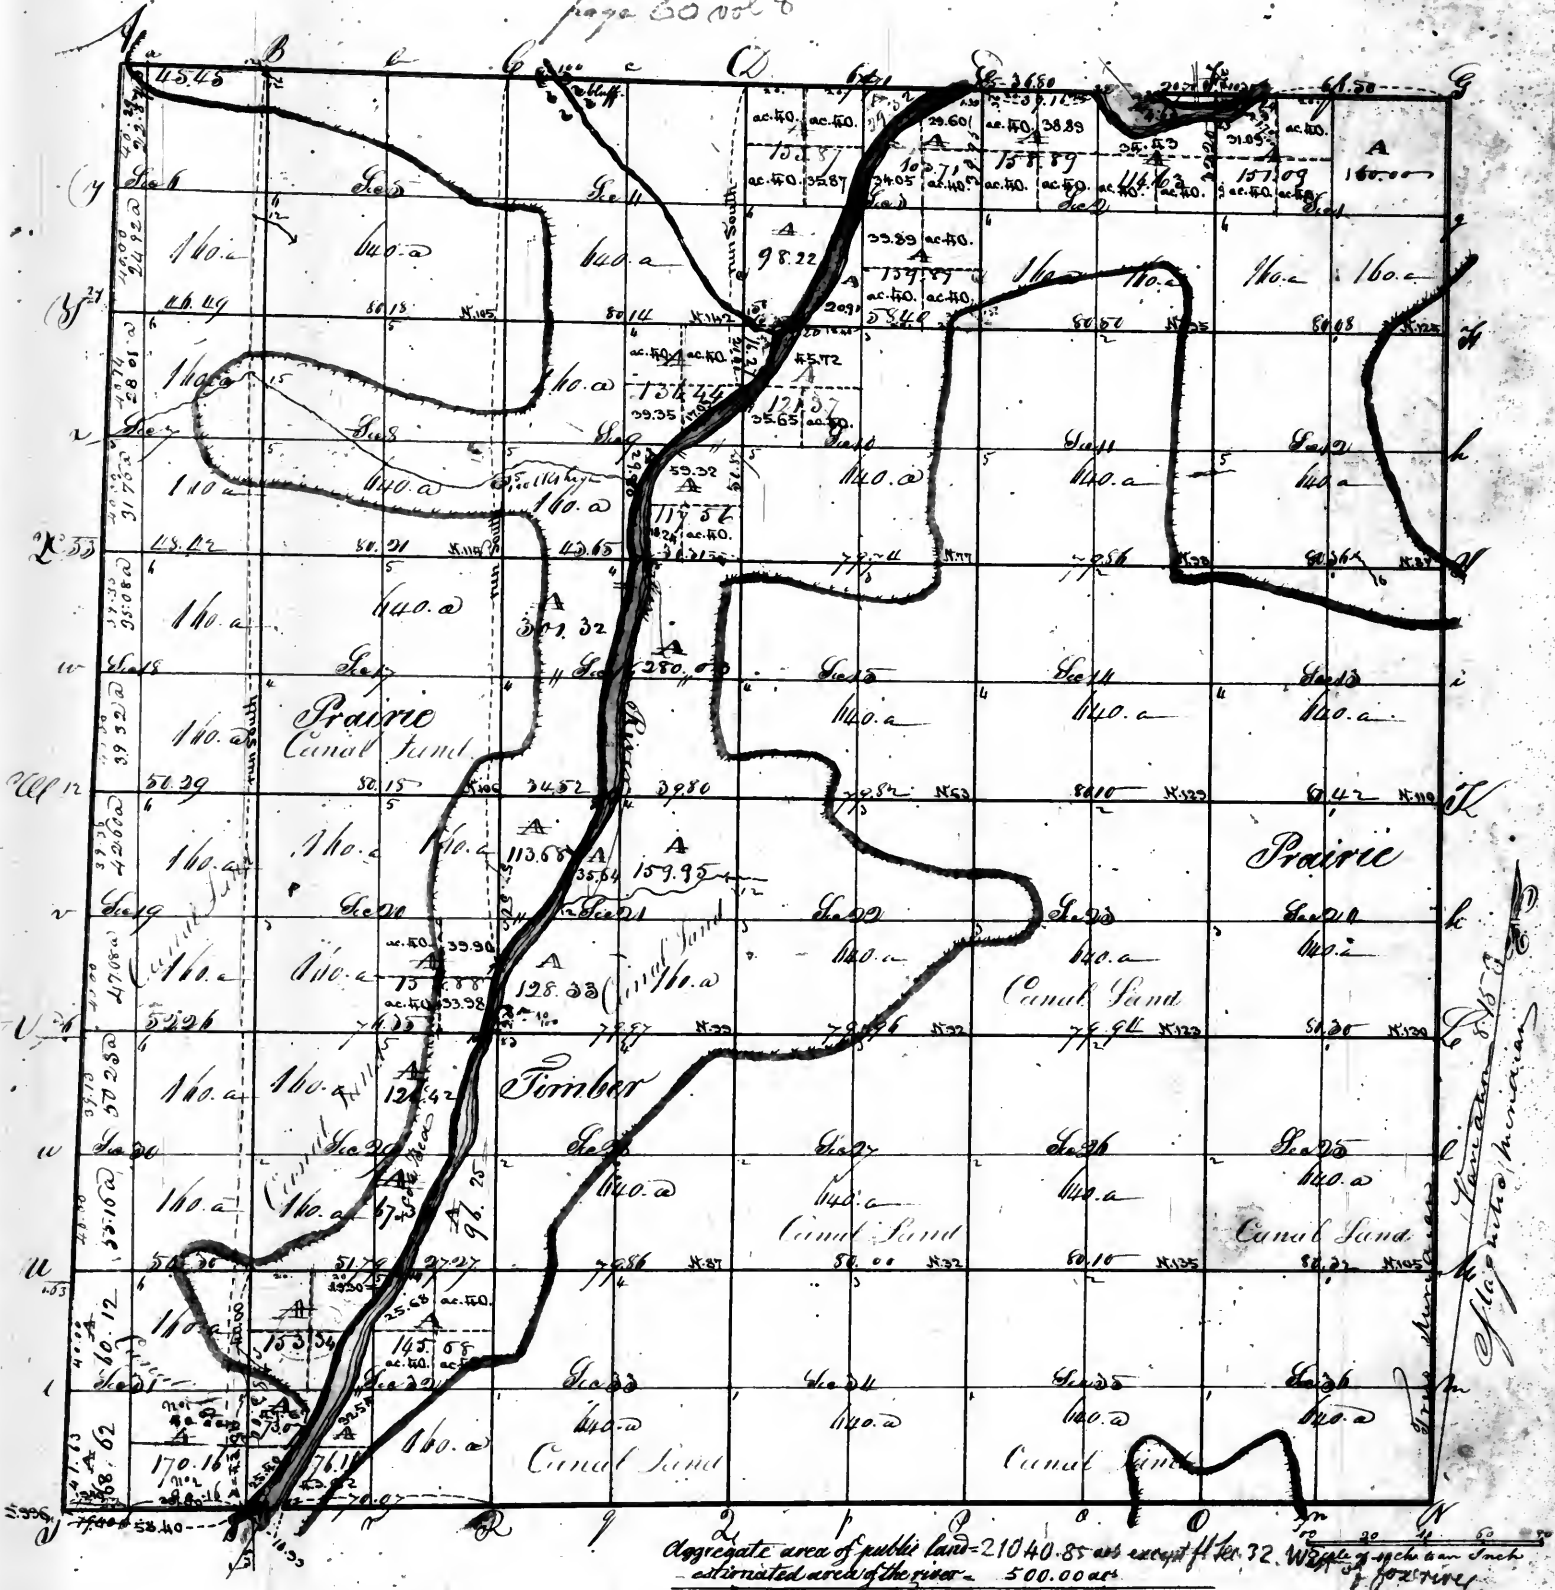


Pursuant to a contract with the instructions from William Reitor Surveyor of the lands of the United States in the States of Illinois & Jefferson & Territory of Arkansas bearing date the 20th day of March 1891, We have examined the said map and Survey and the above described township and hereby certify that it has such marks and bounds both natural and artificial as are represented on said map and described in the field notes made thereof and returned with the plat into the office of the Survey of the Lands of the United States in the States of Illinois & Jefferson & Territory of Arkansas verified this first day of April 1892

Examined

*Wm C Reitor Sr
Stephen Reitor*

Township No. 25 North of the Base Line Range No. 12 East of the 2nd Principal Meridian

Page 61 vol 4.

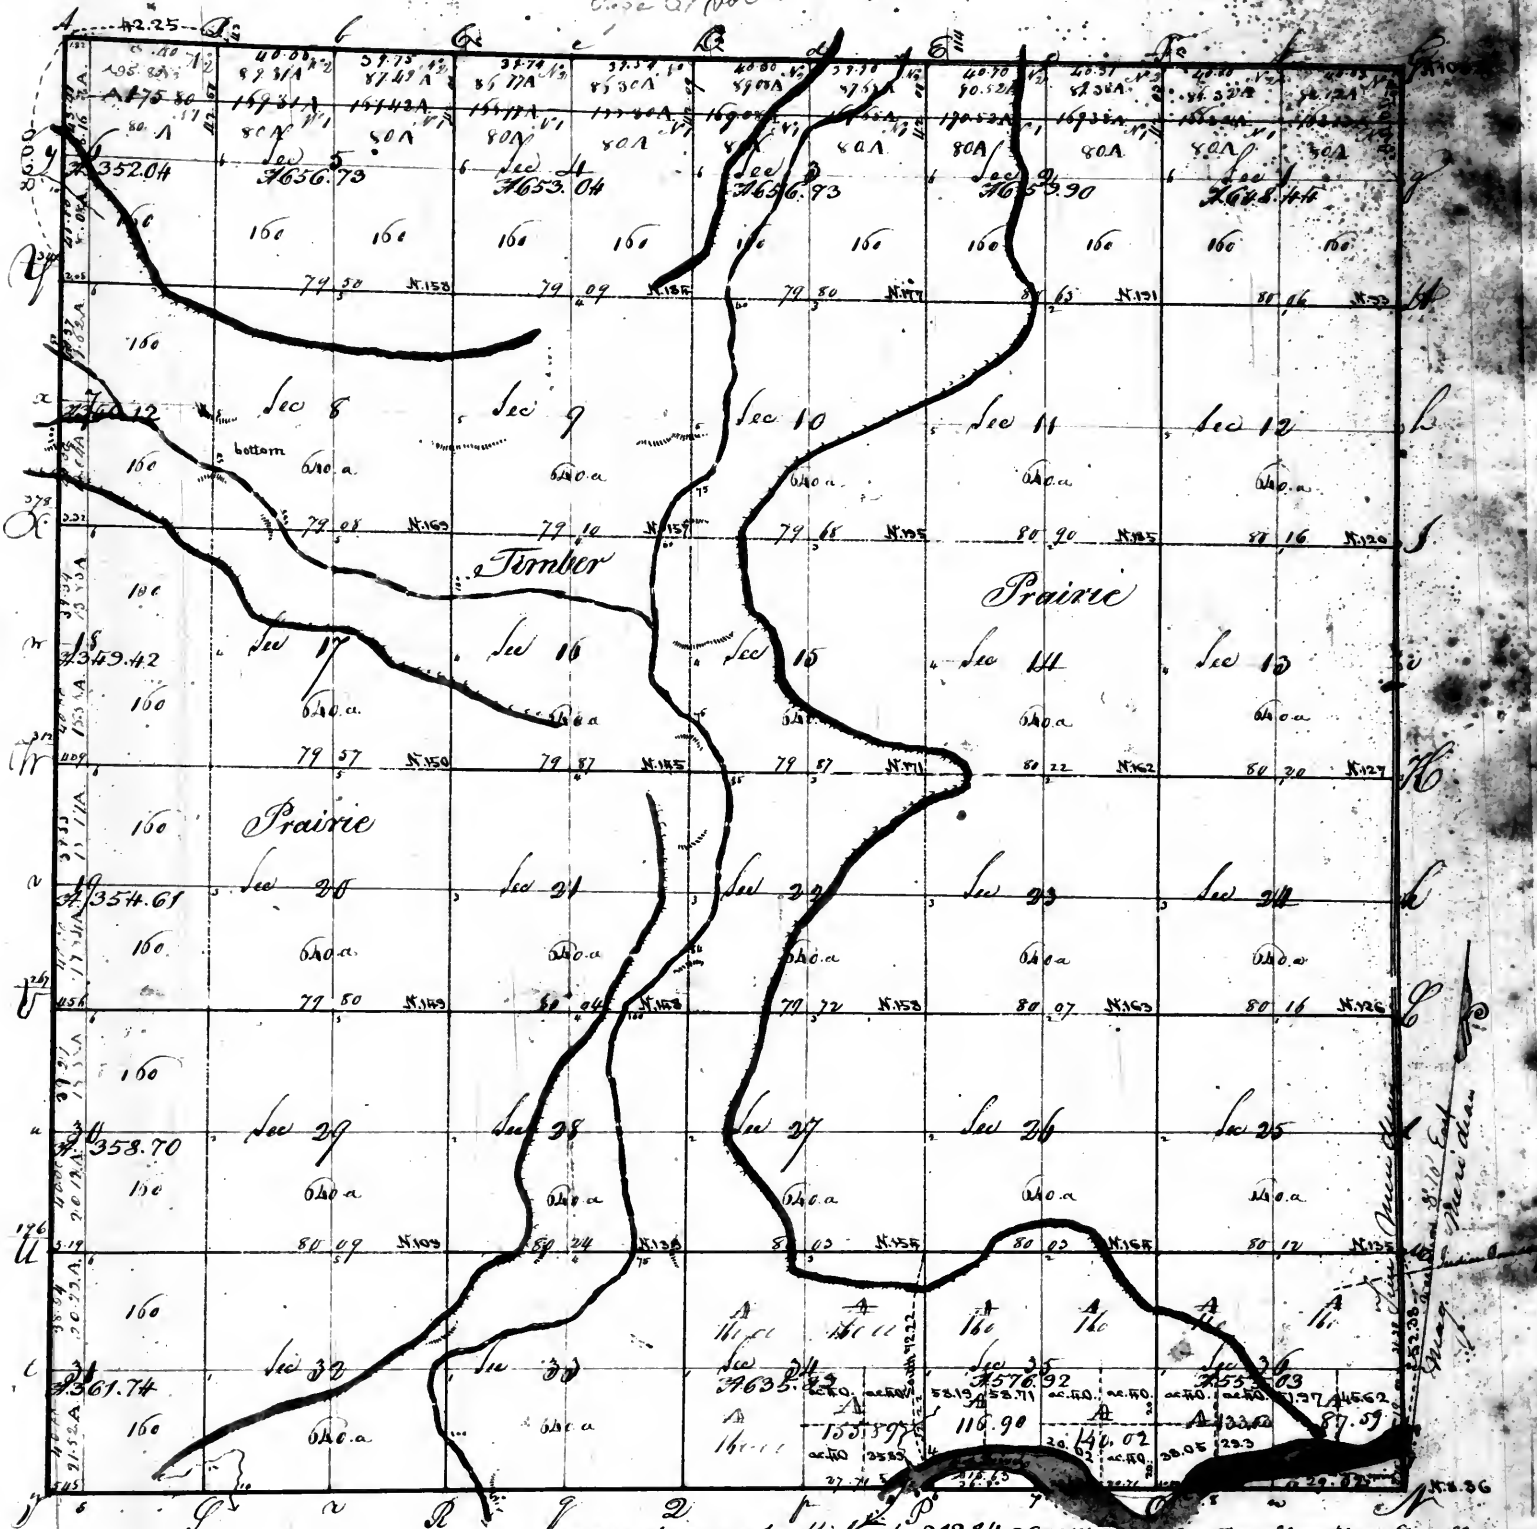

Aggregate area of public land = 21284.26 acres

estimated area of the river = 110.00

Total = 21394.26 acres





Examined

Wm. C. Reitor, U.S. Surveyor

John Factor

726

Ref. This township is a strip of the base line range of 1st E. of 3rd Principal Meridian

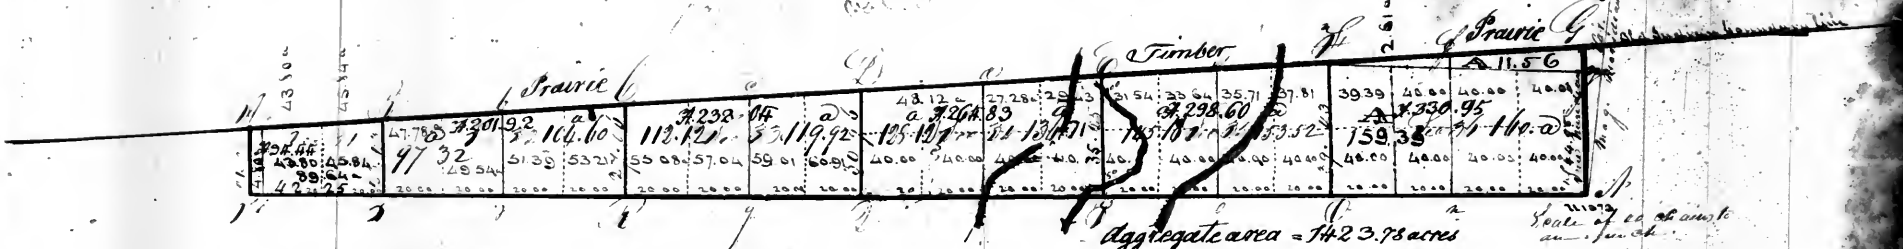


Reference to the field notes of the survey of this township
 S. boundary in book 740 - date September 1821
 E. boundary in book of subdivision 720 date October 1821
 N. boundary
 W. boundary in book 138 date May 1821
 Subdivision in book 720 date October 1821

Aggregate area = 1423.73 acres

Thos C. Pictor
 Stephen Pictor

VOL. 11

Recon
 Township N. 1 North Range N. 5 East of the 3rd principal Meridian

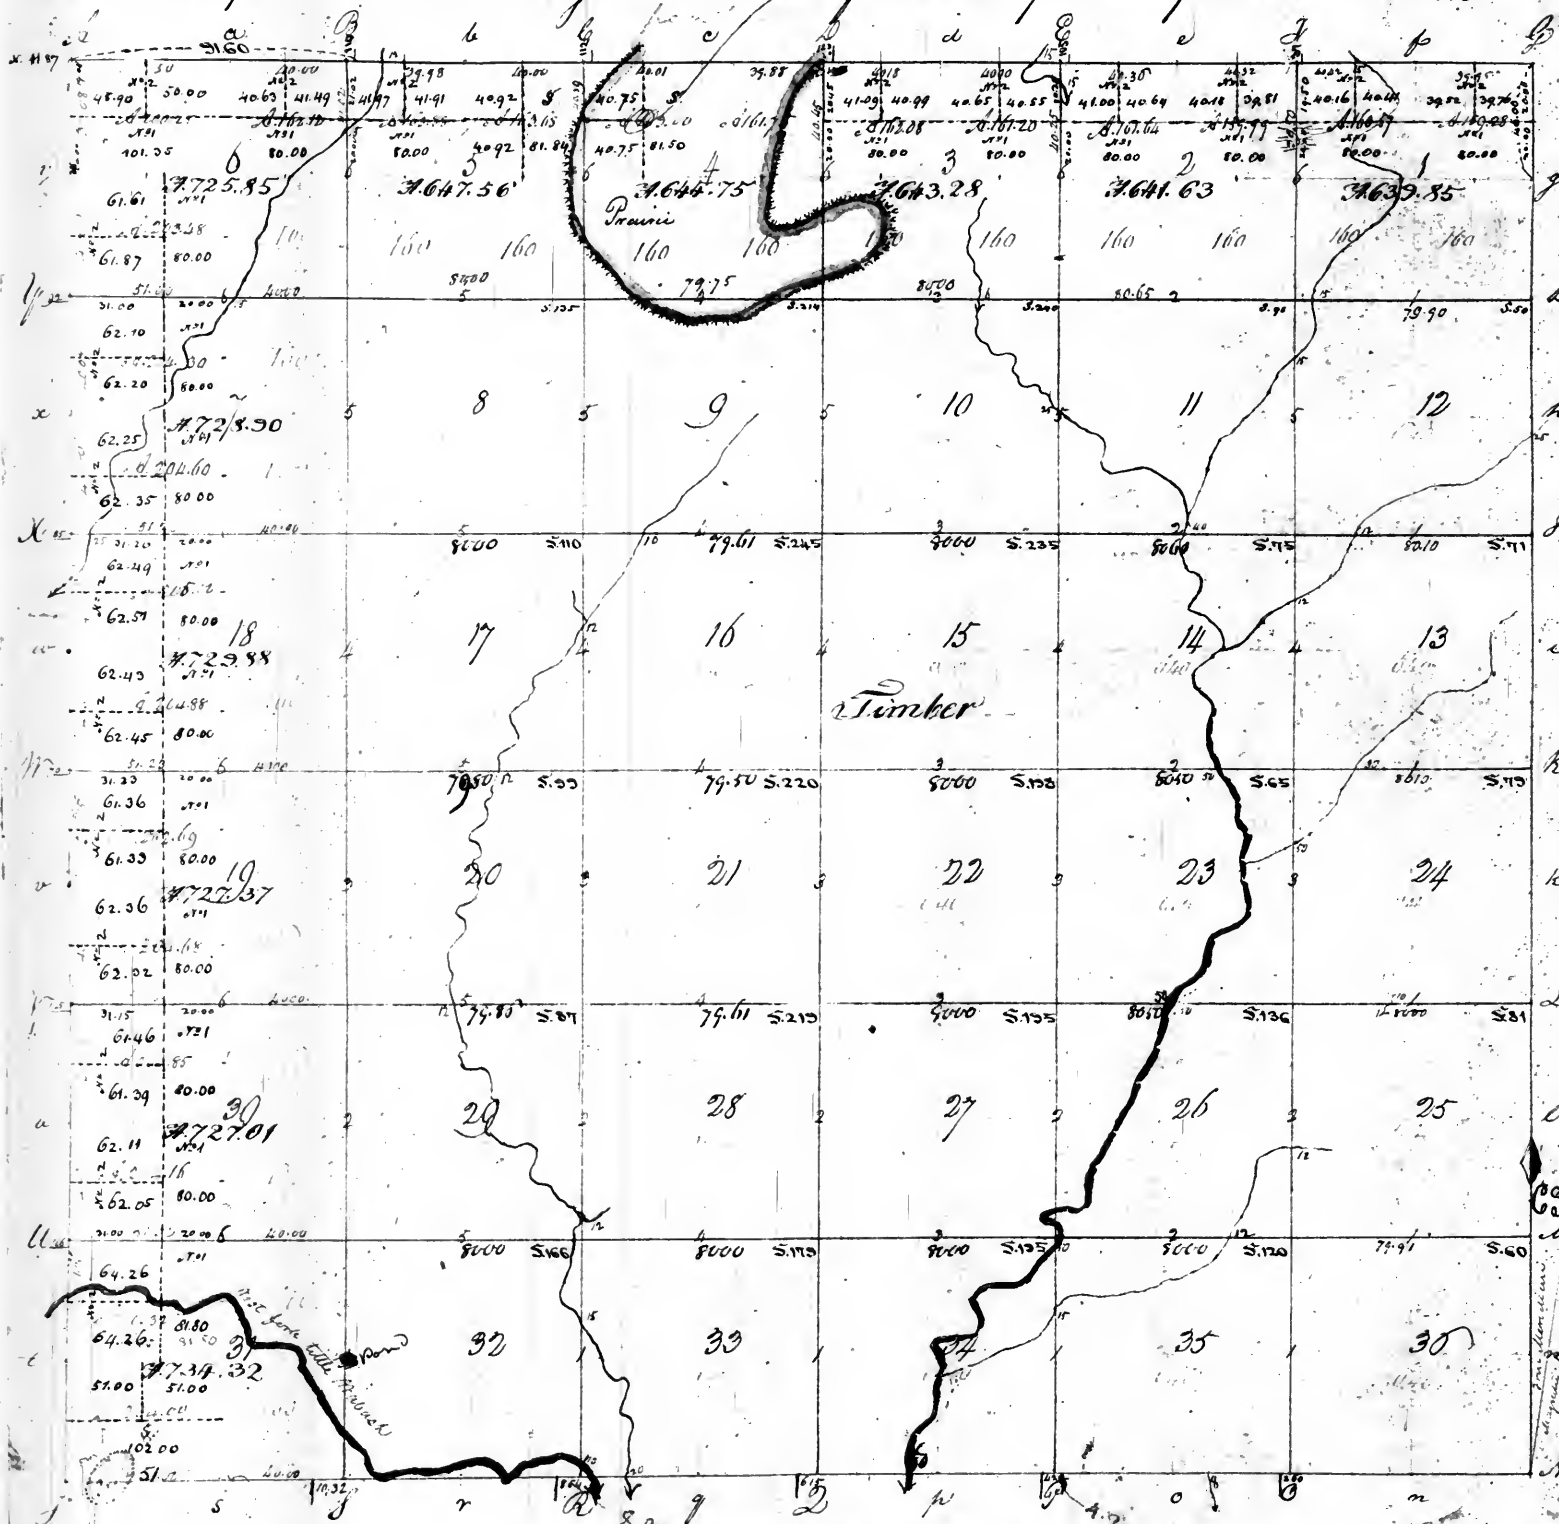

II

Office of the Surveyor General
 for Illinois & Missouri.
 Saint Louis Mo., 11/13/50
 The North halves of sections 1, 2, 3 & 6
 the North West quarter of sections
 5 & 31, the South West quarter of
 section 6, and the West halves of
 sections 7, 18, 19 & 30 subdivided
 under the act of Congress of the
 5th of April 1832.
 The North West quarter of section 4,
 the North East quarter of section 5,
 and the South West quarter of section
 31 subdivided so as to conform to
 previous sales marked S. 1, and
 a plat sent to the Register and
 another to the Commissioner of the
 General Land Office.

Done)
 The West halves or plat of
 the West halves of sections
 7, 18, 19, 20 & 31 sent to the
 Register and Commissioner
 of the General Land Office
 the 15th of Sept. 1849


Aggregate area = 23590.40 acres

Pursuant to a contract with and instructions from William Reeder, Surveyor of the Lands of the United States in the Territory of Illinois and Missouri bearing date the twenty sixth day of October 1818- I have administered and surveyed the above described Township, and do hereby certify, that it had such marshy and bounchy both natural and artificial as are represented on the plat and described in the field notes made thereof, and returned with this plat into the Office of the Surveyor of the lands of the United States for the Territory of Illinois and Missouri.

and drawn by a scale of 40 Chains to the inch

Wm. Greenup S.S.

Record 445.
Township N. 2. North Range. 1.5 East of the 3rd principal Meridian
Page 2 of 9

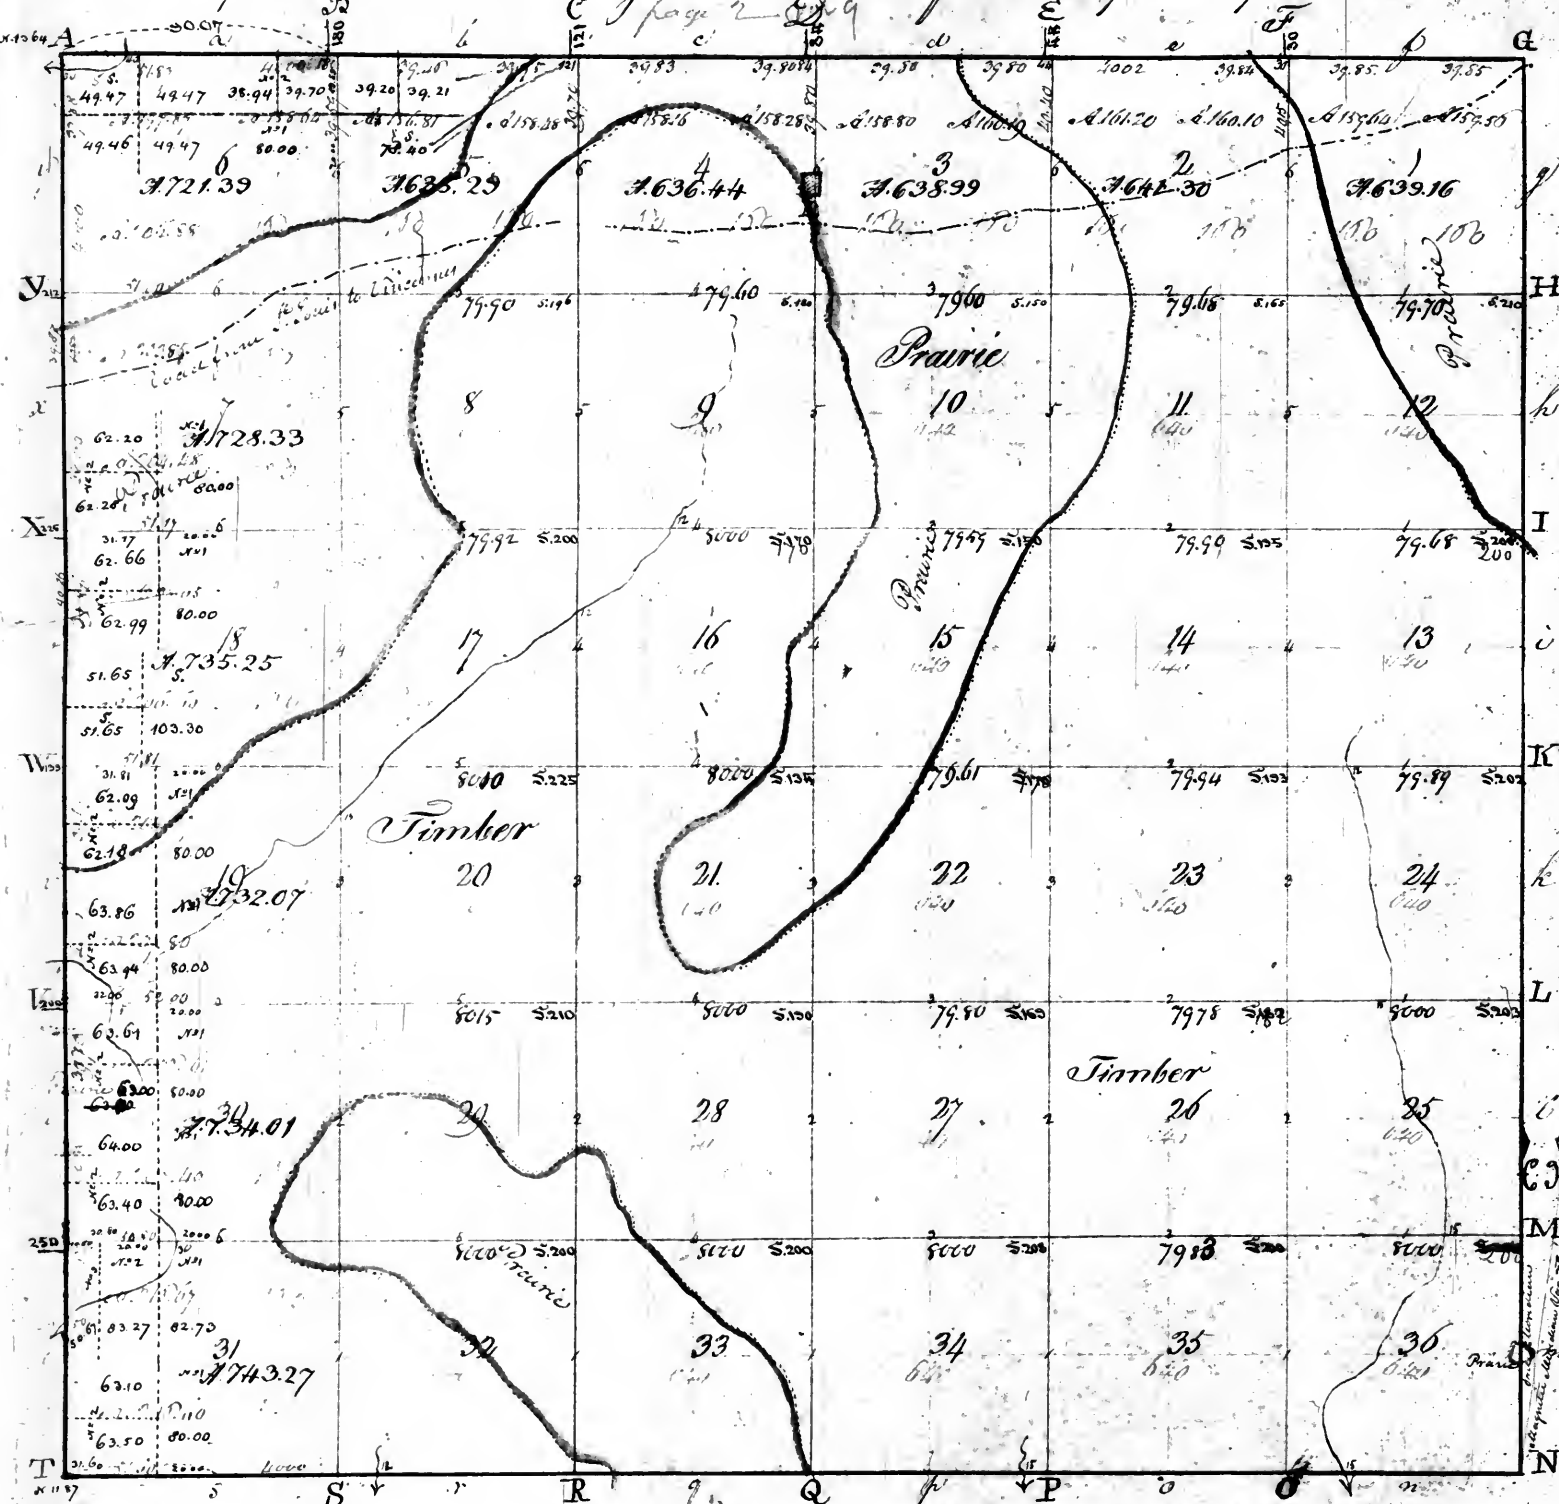

Office of the Surveyor General
 for Illinois & Missouri
 Saint Louis, Mo. July 11th 1850.
 The North East quarter of section 6,
 the South East quarter of section 7,
 the North West quarter of section 18,
 and the West halves of sections 19, 30 & 31,
 which are shown on the act of Congress of
 the 5th of April 1832. —
 the North East quarter of sections
 5 & 6, and the South East quarter
 of section 18, which are shown on the
 form to previous sales (marked S),
 and are sent to the Register and
 under to the Commissioners of the
 General Land Office.


Aggregate area - 23585.50 acres

Pursuant to a contract with and instructions from William Reeder Surveyor of the lands of the United States in Illinois and Missouri Territory bearing date the twenty sixth day of October 1818 I have admeasured laid out and surveyed the above described Township, and do hereby certify that it has such marks and bounds both natural and artificial as are represented on the plat and described in the field notes made thereby and returned with this plat into the Office of the Surveyor of the lands of the United States for the Territory of Illinois and Missouri

Laid down by a scale of 100 Chains to the inch

Wm. C. Greenup D.S.

Township N. 3 North Range N. 5 East of the 3rd principal Meridian

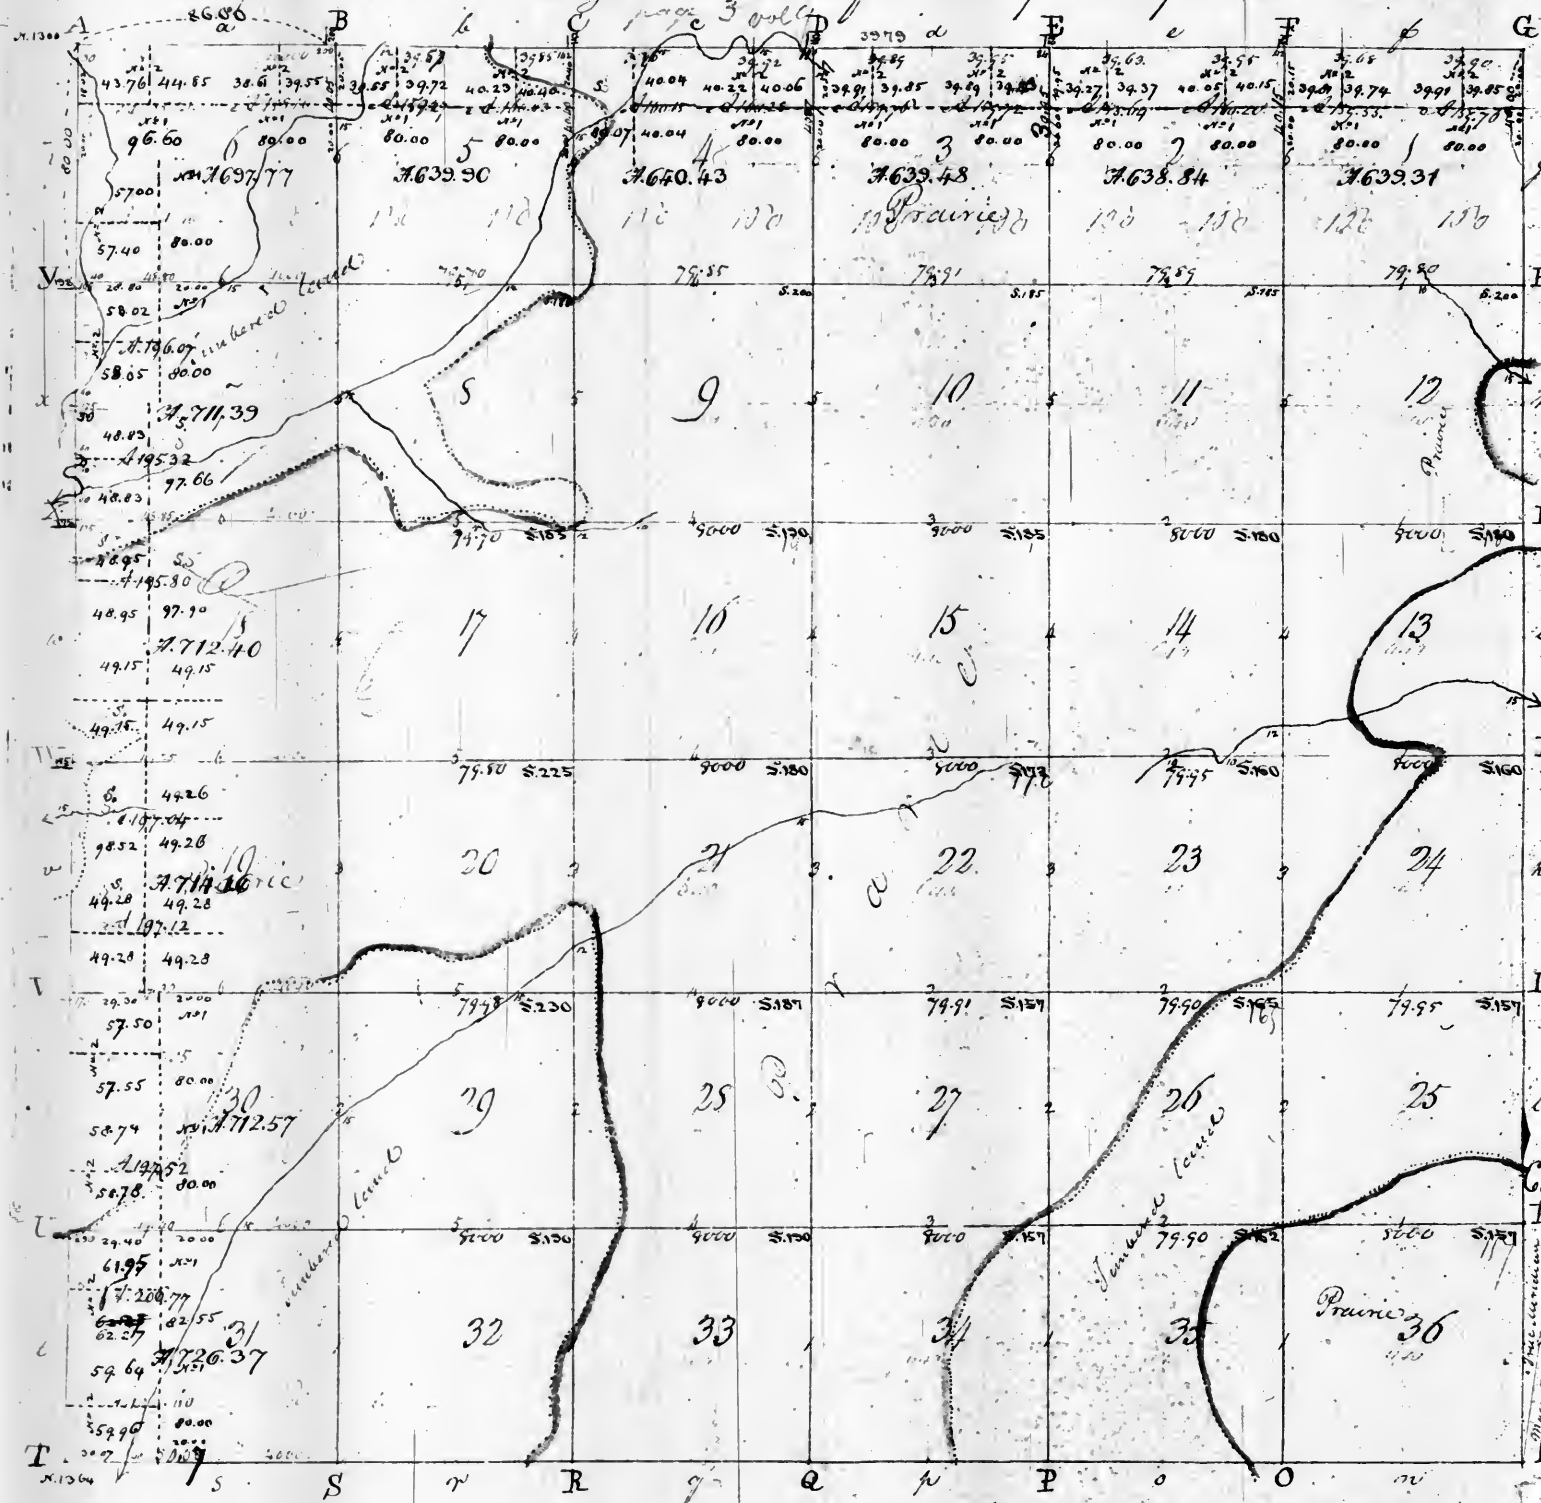

Office of the Surveyor General
Saint Louis, Mo. 11th 1850
The North halves of sections 1, 2, 3, 5 & 6,
the North East quarter of section 4,
the South west quarter of section 6, the
North West quarter of section 7, and
the West halves of sections 8, 30 & 31,
situated under the act of Congress
of the 5th of April 1832, —
the North West quarter of section 4,
the South West quarter of section 7,
and the West halves of sections
18 & 19, not being sold so as to con-
form to previous sales (marked S),
and a plat sent to the Register and
another to the Commissioner of the
General Land Office.

A plat of the North halves of
Sections 1, 2, 3, 4, 5 & 6 & S. M.
of Section 5 sent to the Reg-
ister and a copy sent to the
Commissioner of the General
Land Office on the 16th Sept.
1849.

Aggregate area = 23472.62 acres


Pursuant to a contract with and instructions from William Bector, Surveyor of the lands of the United States, in the Territories of Illinois and Missouri bearing date the twenty sixth day of October 1818 I have examined laid out and surveyed the above described Township, and do hereby certify that it has such marks and boundary both natural and artificial as are represented on the plat and described in the field notes made thereof, and returned with this Plat into the Office of the Surveyor of the lands of the United States for the Territories of Illinois and Missouri

Ends down by a scale of 40 chains to the inch

Mrs. Greenup & S.

Recorded 47

Township N. 4 North of Range N. 5 East of the 3rd Principal Meridian

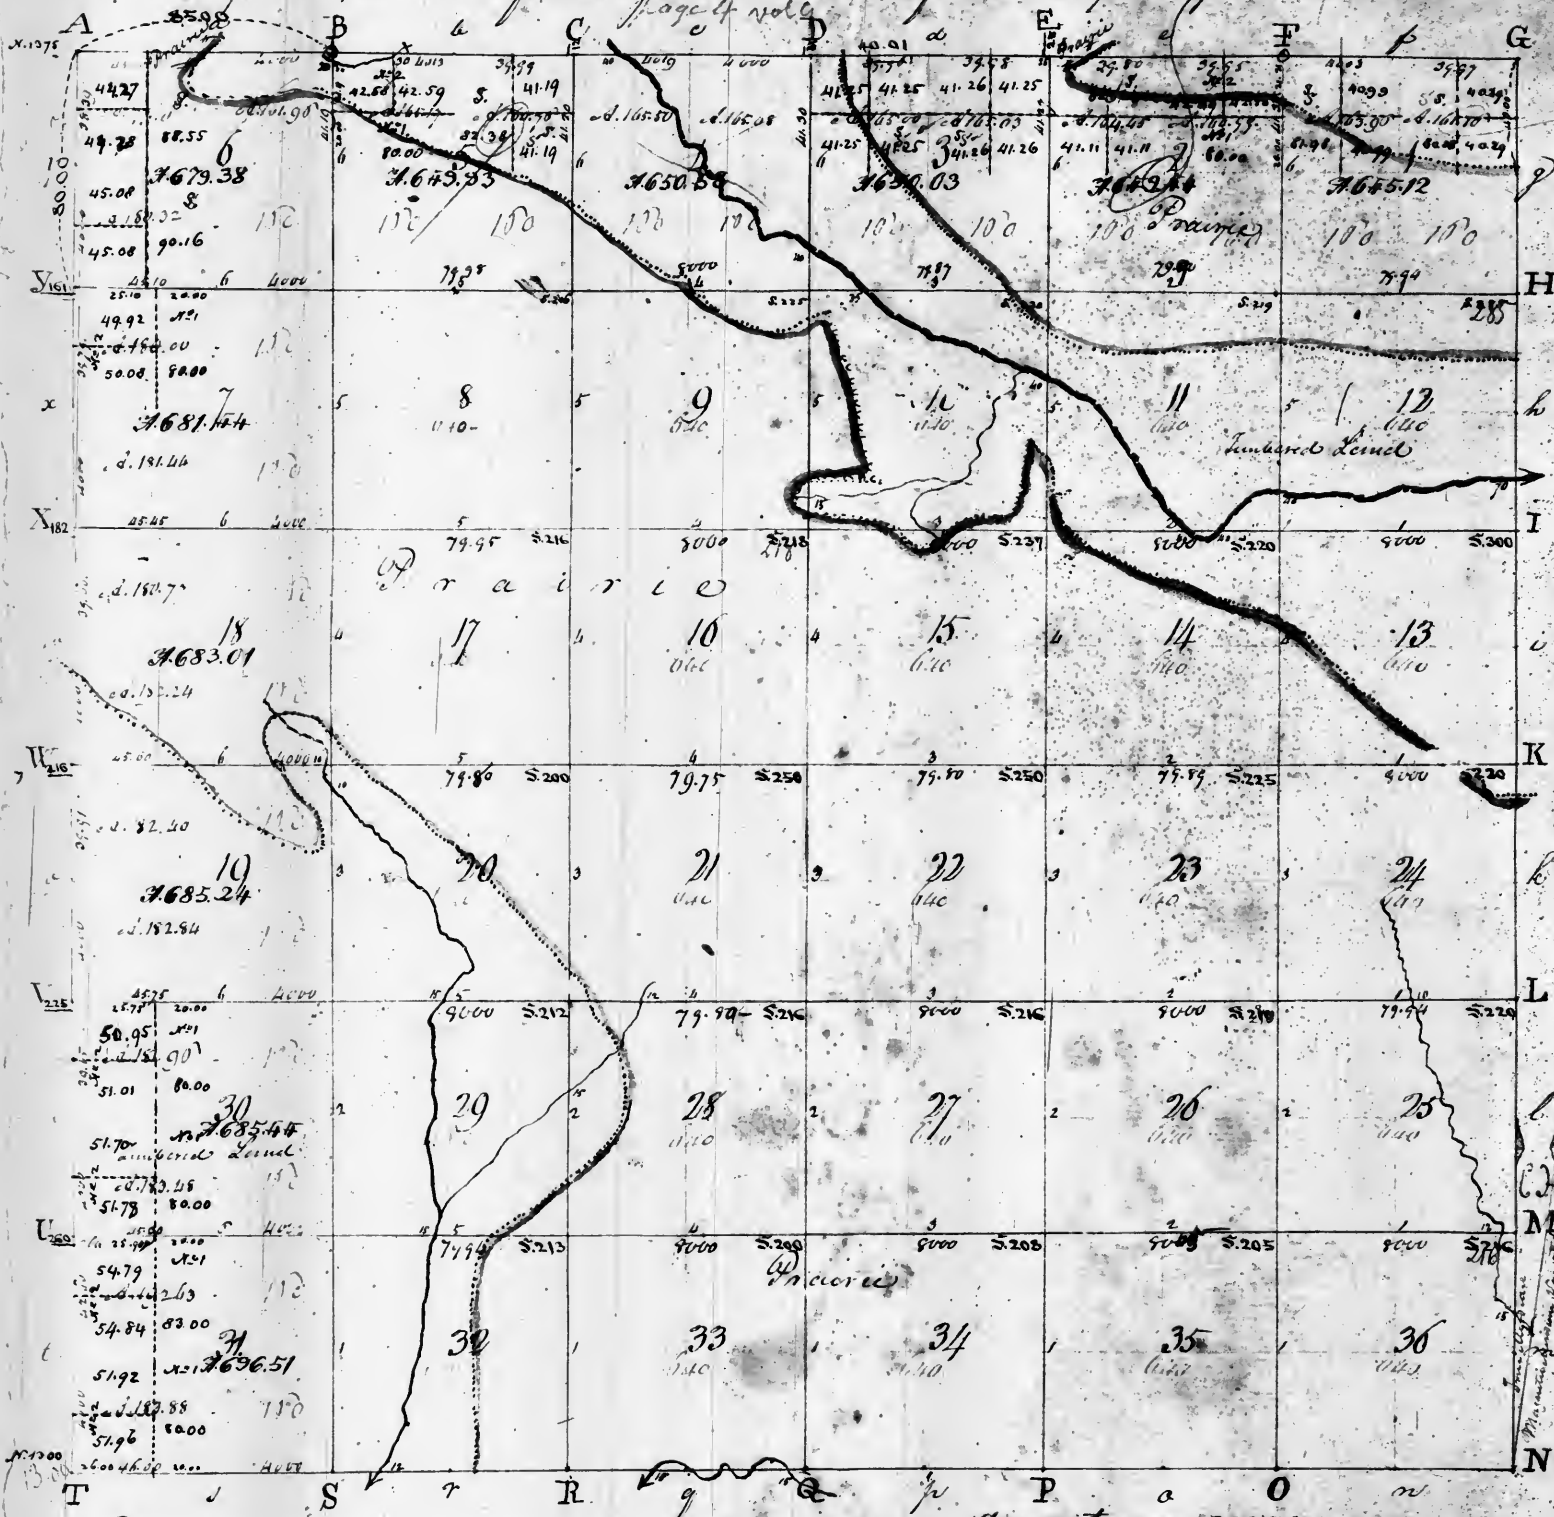

Office of the Surveyor General
for Illinois and Missouri
St. Louis July 11th 1850.
The North East quarter of section 2,
the North West quarter of section 2,
and the West halves of sections 30 & 31,
subdivided under the act of Congress
of the 5th of September 1832,
the North halves of sections 1 & 2,
the North West quarter of section 2,
the North East quarter of section 5,
and the West half of section 6, subdivi-
ded, so the township to previous
sales (marked S.), and a plan
sent to the Register and another
to the Commissioner of the Gen-
eral Land Office.


Aggregate area = 23356.12 acres

Pursuant to a contract with and instructions from William Reister Surveyor of the lands of the United States in the Territory of Illinois and Missouri, bearing date the 20th day of October 1848 I have ad-
mired and laid out and and surveyed the above described Township, and do hereby certify that it has
been marked and bounded both natural and artificial as are represented on the plat and described in
the field notes made thereof and returned with this plat to the Office of the Surveyor of the lands of
the United States for the Territory of Illinois and Missouri.

Laid down by a scale of 40 Chains to the inch

M. C. Greenup S. S.

Township 1° V North Range 1° V East of the III Principal Meridian 448

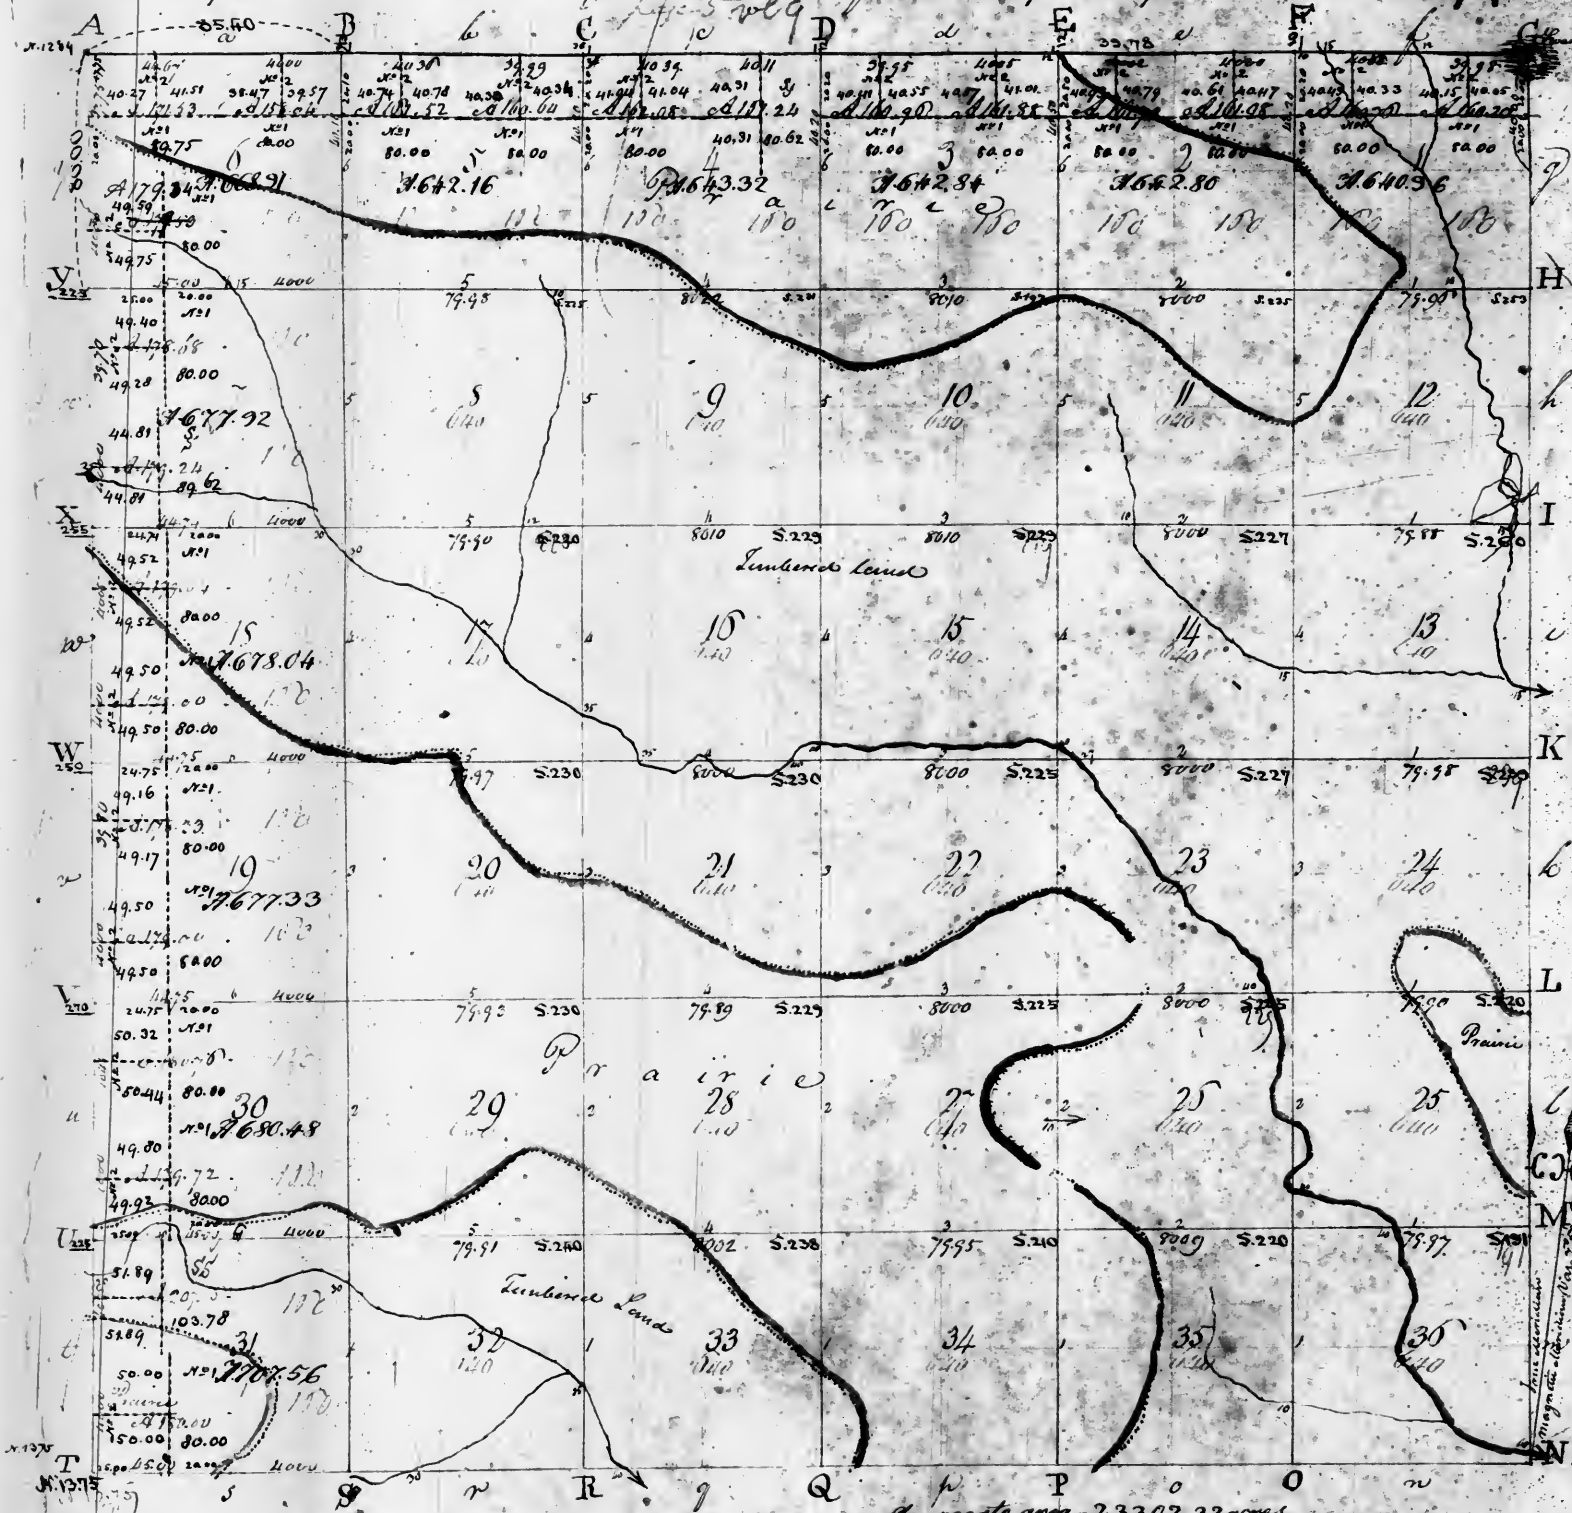

Office of the Surveyor General
for Illinois & Missouri
June 1st 1850
subdivided under the act of Congress of the 5th of April 1832, the North East quarter of section 1, the South West quarter of section 7, and the North East quarter of section 31, subdivided so as to conform to previous sales marked S. 1, and a plat sent to the Register and another to the Commissioner of the General Land Office.
A plat of the west halves of sections 7, 12, 19, 30 & 31, sent to the Register and another to the Commissioner of the General Land Office on the 15th Sept. 1849.

Pursuant to a contract with and instructions from William B. Rector Surveyor of the lands of the United States in the Territories of Illinois and a lipouri bearing date the twenty sixth day of October 1818 I have measured, laid out and surveyed the above described Township, and do hereby certify that it had sunk marks and firmly both natural and artificial as are represented on the plat and described in the field notes made thereby and returned with this plat into the Office of the Surveyor of the Lands of the United States for the Territories of Illinois and a lipouri.

and drawn by a scale of 40 Chains to the inch


Wm. C. Greenup D. S.

Recorded

6

449

Township N. VI North Range N. V East of the III principal Meridian

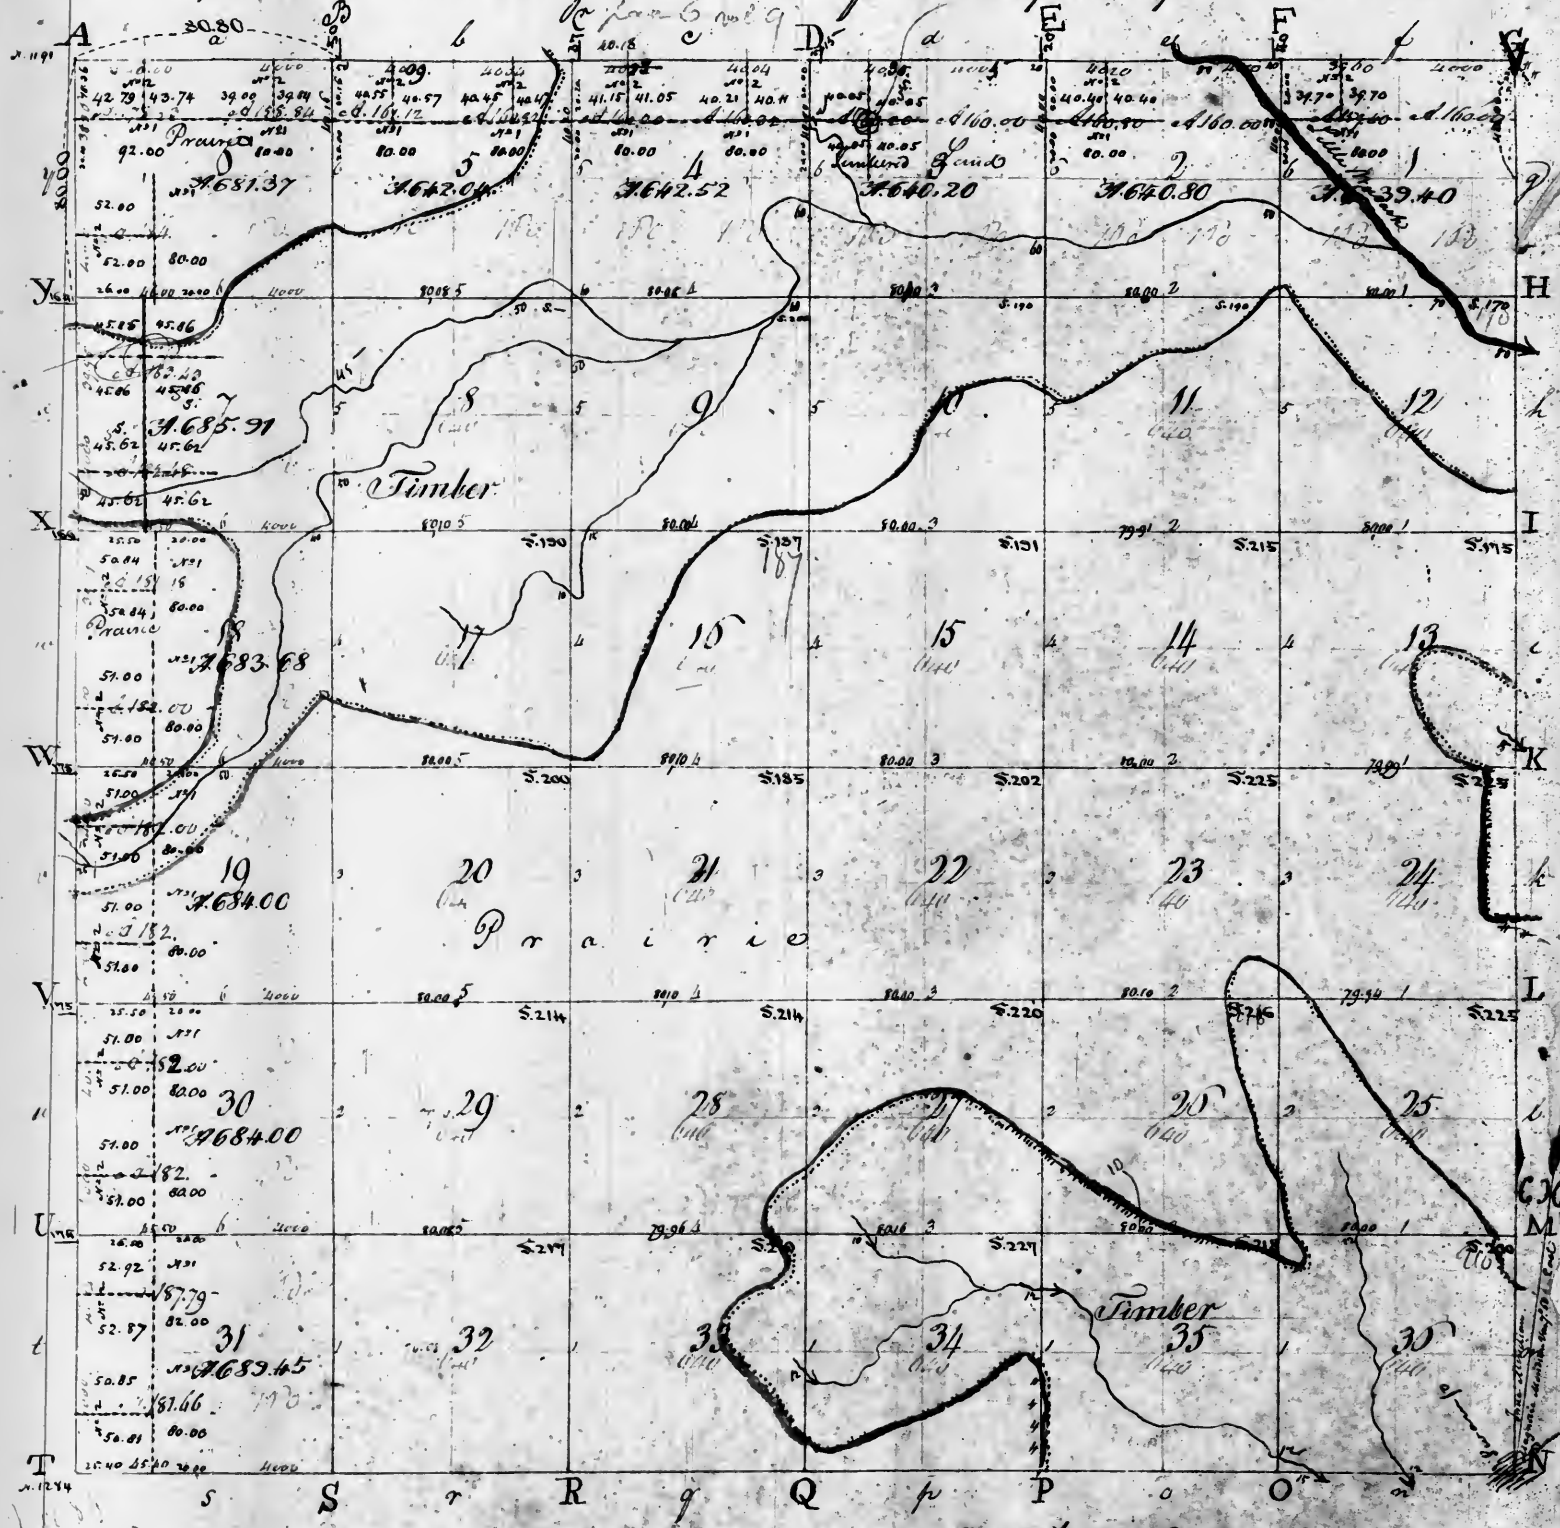

Office of the Surveyor General
for Illinois & Missouri
Saint Louis July 11th 1850
The North West quarter of section 1 & 2
the North halves of sections 4, 5 & 6
the South West quarter of section 9
and the West halves of sections
18, 19, 30 & 31, subdivided under
the act of Congress of the 5th of
April 1850,
the North West quarter of section
3, and the West half of section 7,
subdivided so as to conform to
previous sales for armed S. J.
and a plat sent to the Register
and another to the Commissioner
of the General Land office.

Aggregate area - 23313.37 acres

Pursuant to a Contract with and instructions from William Austin Burrows of the land of the United States in the Territory of Missouri bearing date the 20th day of October 1848. I have accordingly laid out and surveyed the above described Township, and do hereby Certify that it has such marks and bounds, both natural and artificial as are represented on the plat and described in the field notes made thereby, and returned with this plat into the office of the Surveyor of the land of the United States for the Territory of Illinois and Missouri.


Laid down by a scale of 40 chains to the inch

W. C. Spencer S.S.

Reconnoitred

17

Township N. VII North Range N. V East of the III principal Meridian 450.

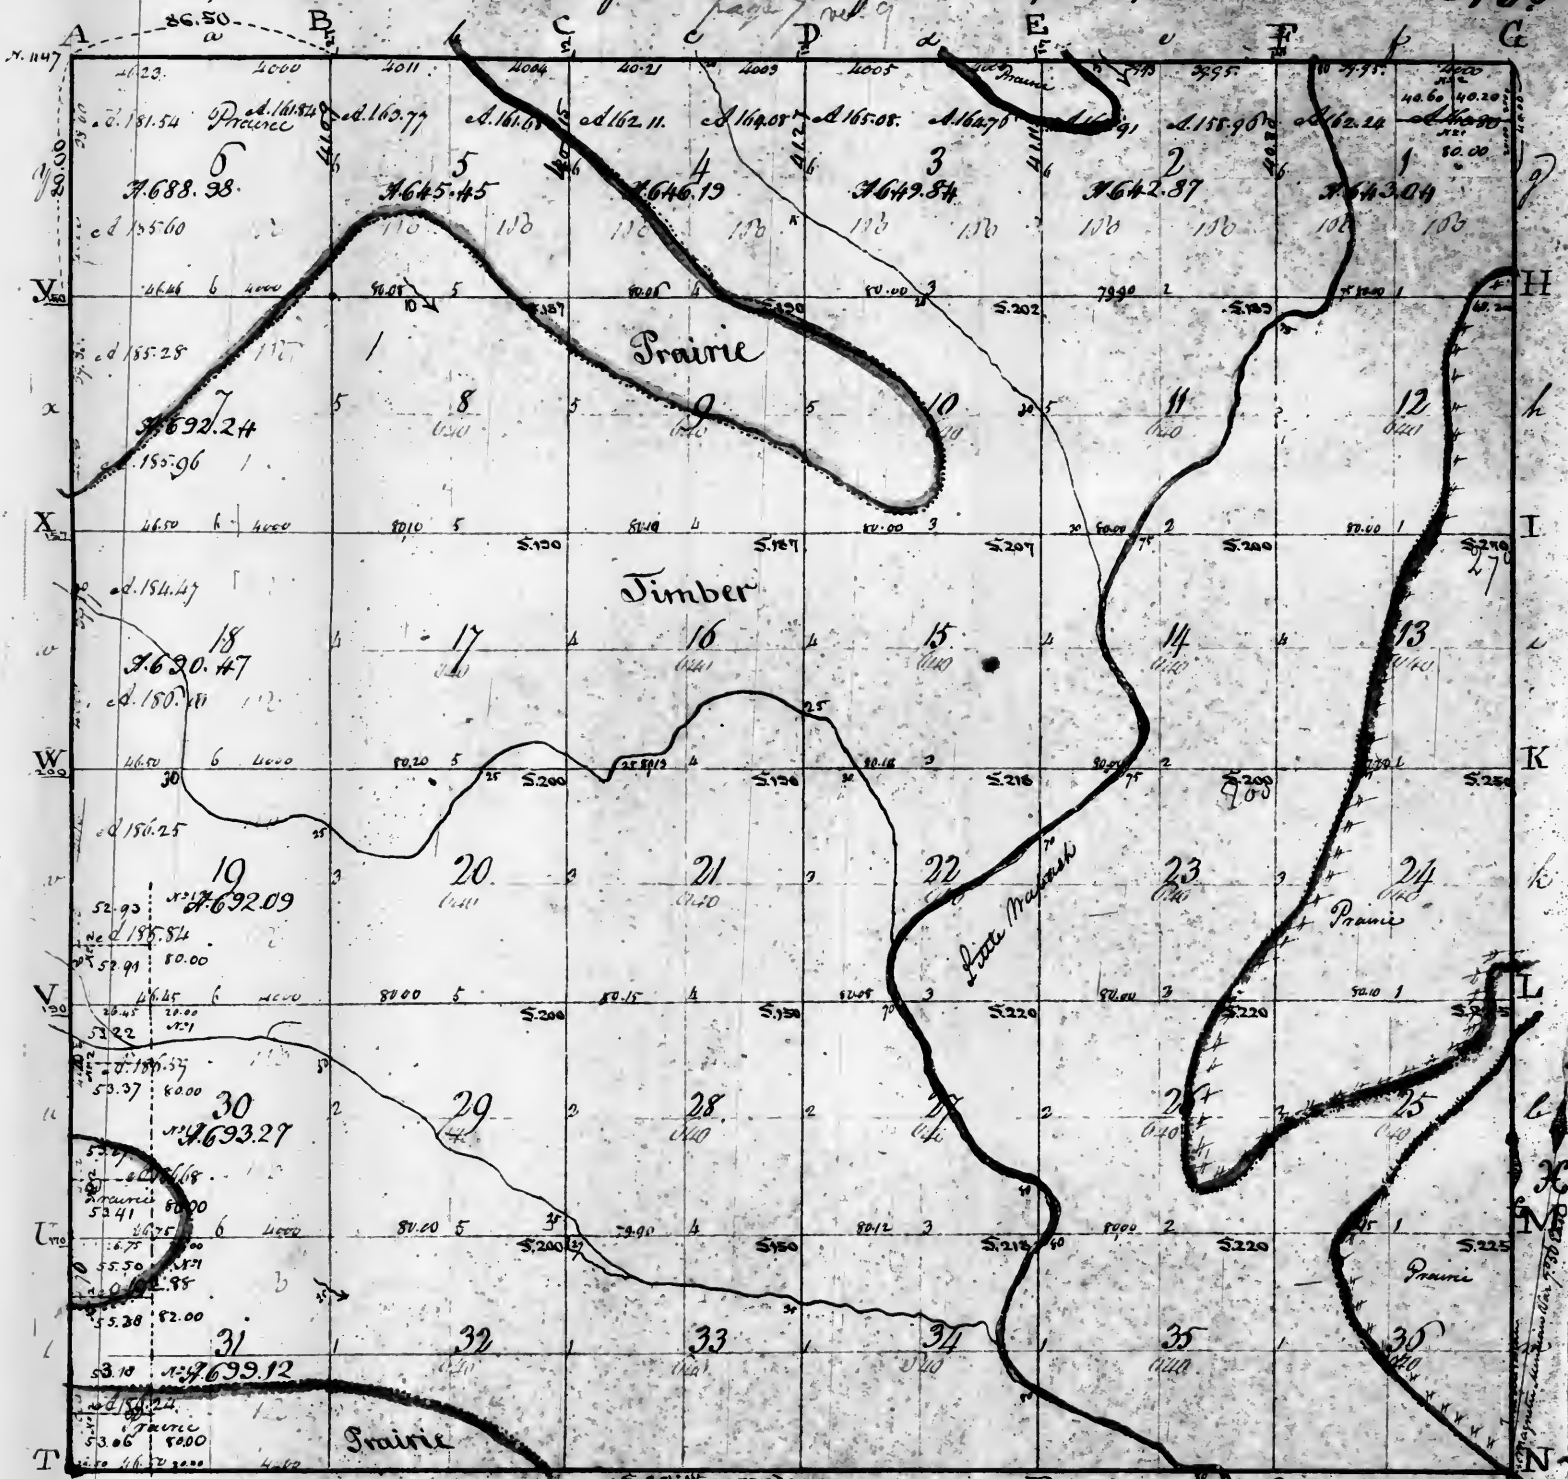

Office of the Surveyor General
in Illinois & Wisconsin
Saint Louis Sept 15th 1849.
The North East quarter of section 1,
the South East quarter of section 19,
and the West halves of sections 30 & 31,
are included under the act of Congress
of the 5th of April 1832, and a
plat is to be the Register and sent
to the Commissioner of the General
Land office.

Aggregate area = 23383.56 acres

I pursuant to a contract with and instructions from William Reeder Surveyor of the lands of the United States,
in the Territory of Illinois and Wisconsin bearing date the 20th day of October 1818; I have as aforesaid have
and now Surveyed the above described Township, and do hereby certify that it has been marked and
bound both natural and artificial as are represented on the plat and described in the field notes made
thereof; and returns with this plat into the Office of the Surveyor of the lands of the United States for the
Territories of Illinois and Wisconsin.


M. C. Greenup D.S.

Said down by a scale of 40 chains to the inch

451

Page 8 vol 1

Office of the Surveyor General
for Illinois & Missouri
Saint Louis Sept 15th 1849
The South west quarter of section 6
and the most halves of sections 7, 19, 20 & 31, subdivided under the act
of Congress of the 5th of Sept 1832,
the West half of section 18 subdivided
to conform to pre-
vious sales marked S. J. and
returned to the Register, by
order of the Commissioner of
the General Land office.

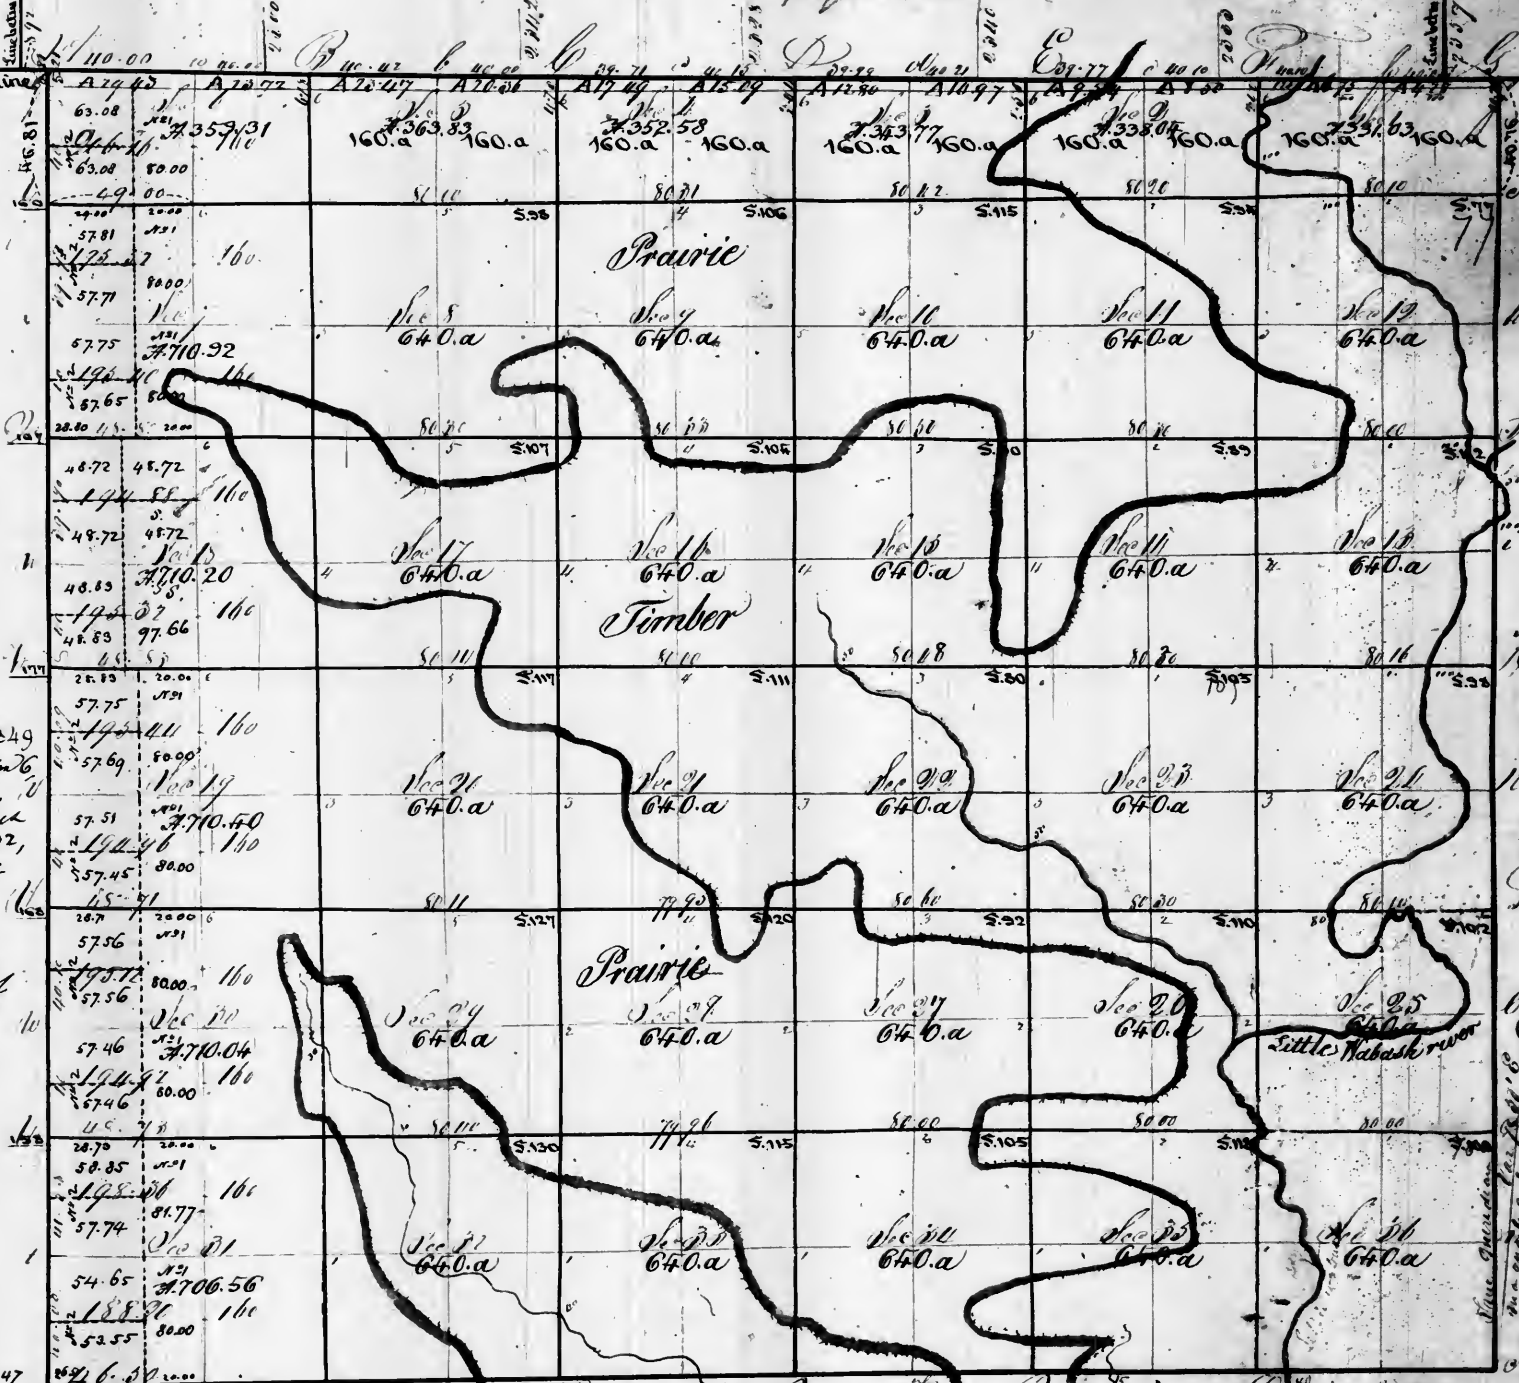

1147

Aggregate area = 21636.03 acres


Pursuant to a contract with, and instruction from William H. Bates Surveyor of the Lands of the United States in the State of Illinois and Territories of Mississippi and Arkansas bearing date the day of I have delineated laid out and surveyed the above fractional Township; and do hereby certify that it hath such marks and bounds, both natural and artificial as are represented on said plat, and described in the field notes made thereof, and returned into this office in the office of the Surveyor of the Lands of the United States for the State of Illinois and Territories of Mississippi and Arkansas.

Recorded

9

452

Township No. 9 North of the base line, Range No. 5 East of the 3rd principal Meridian.

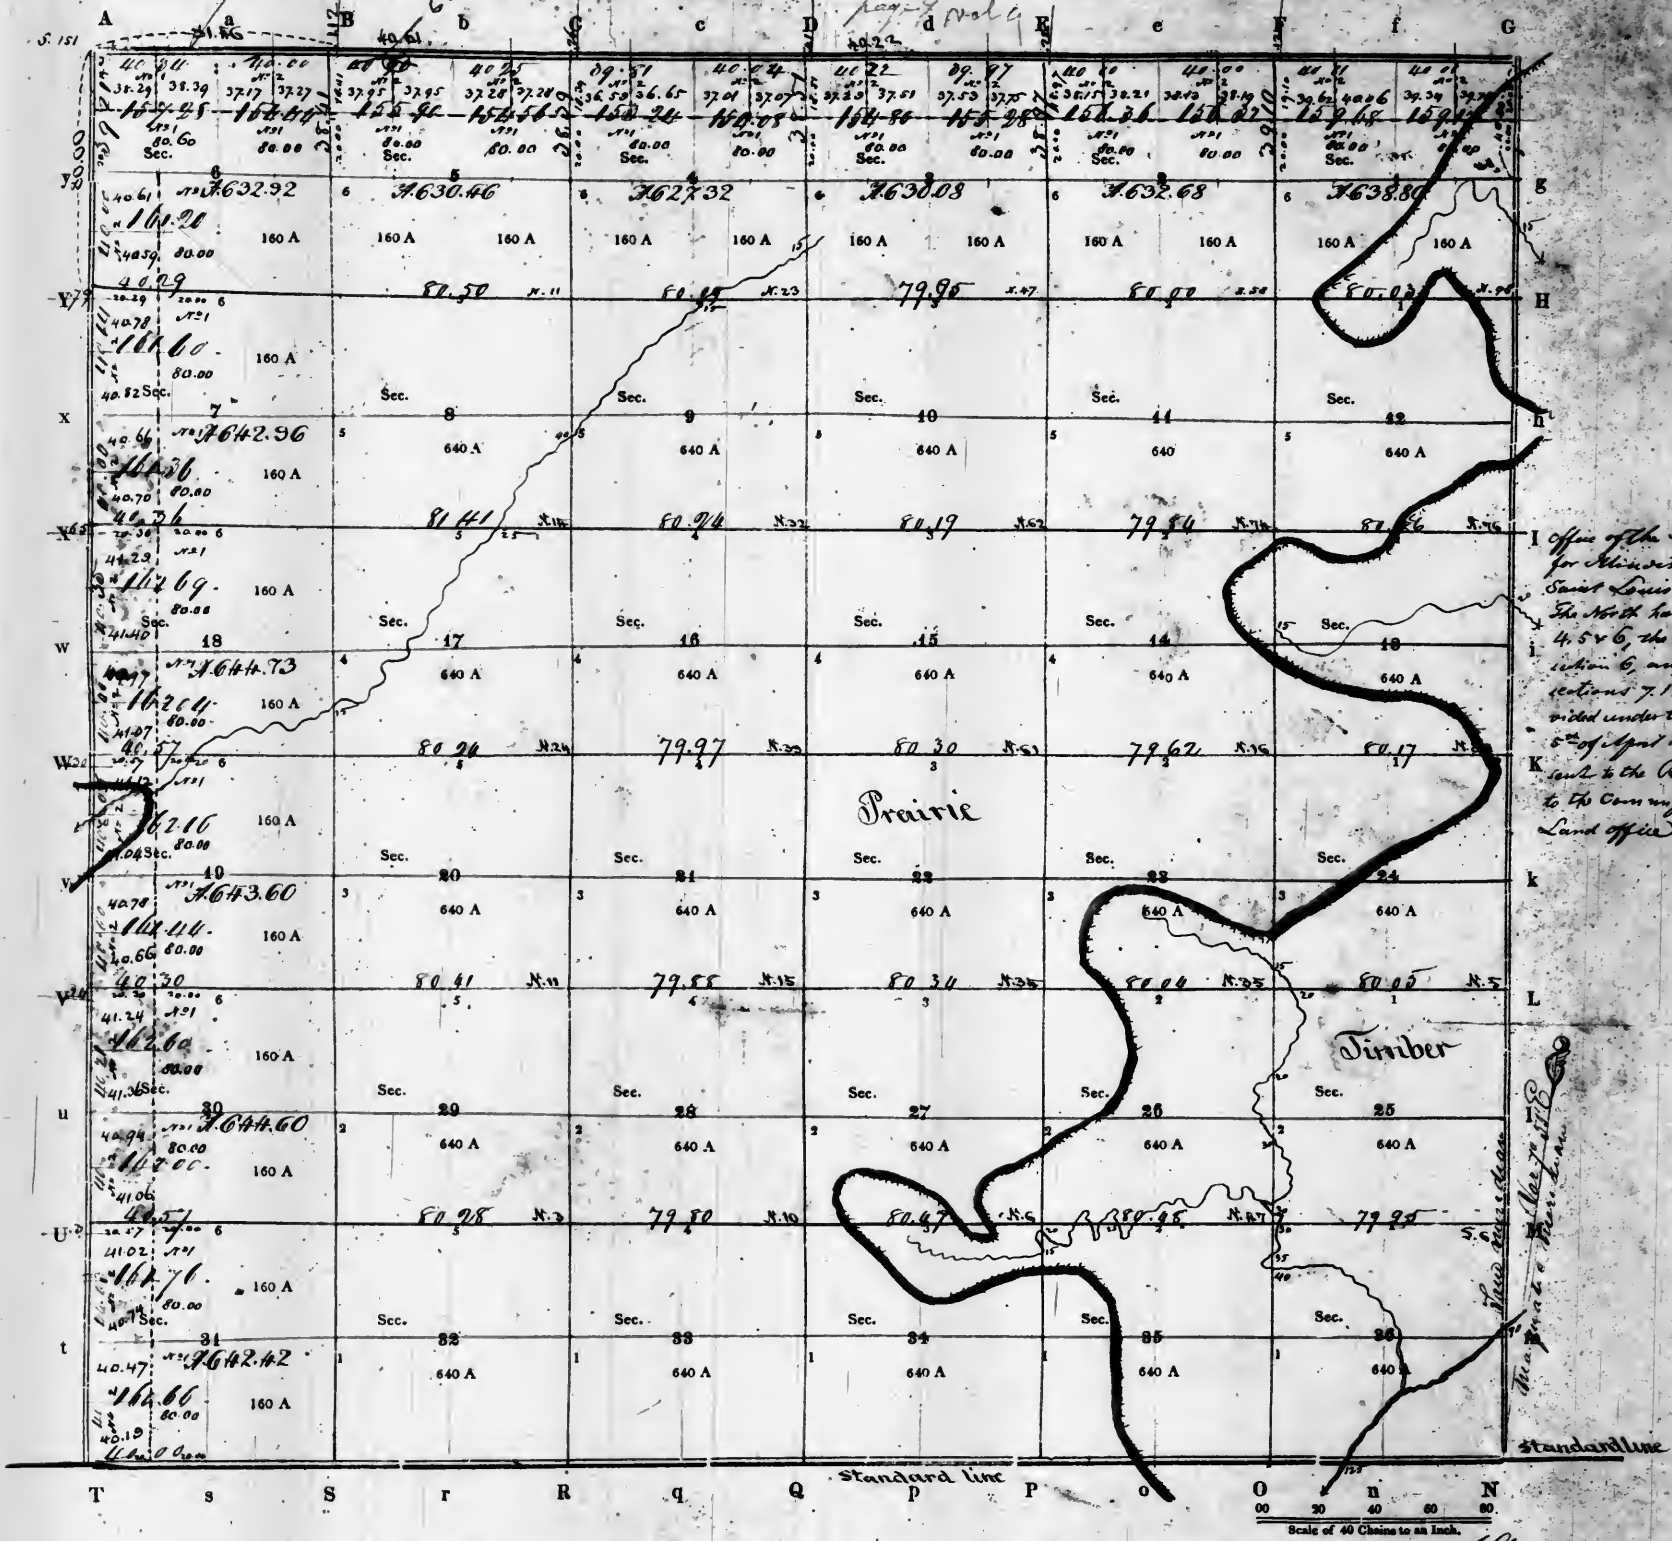

Office of the Surveyor General
Saint Louis Sept. 15th 1849
The North halves of sections 1, 2, 3,
4, 5 & 6, the South east quarter of
section 6, and the West halves of
sections 7, 18, 19, 30 & 31, were
sold under the act of Congress of the
5th of April 1832, and a plat
sent to the Register and another
to the Commissioner of the General
Land Office.

Surveyed by J. M. Smith

Standard line

Scale of 40 Chains to an Inch.

PURSUANT to a contract with, and instructions from WILLIAM RECTOR, Surveyor of the lands of the United States in the State of Illinois and Territories of Missouri & Arkansas bearing date the 18th day of May 1820

I have admeasured, laid out and surveyed the above described Township; and do hereby certify, that it had such marks and bounds, both natural and artificial, as are represented on said plat, and described in the field notes made thereof, and returned with this plat into the Office of the Surveyor of the lands of the United States, for the State of Illinois and Territory of Missouri & Arkansas

Certified this 10th day of October 1820

EXAMINED.


James Connor, SURVEYOR
for
Stephen Rector Esq
July 1820

Recorded

10

453.

Township No. 10 North of the base line, Range No. 5 East of the 3rd principal Meridian.

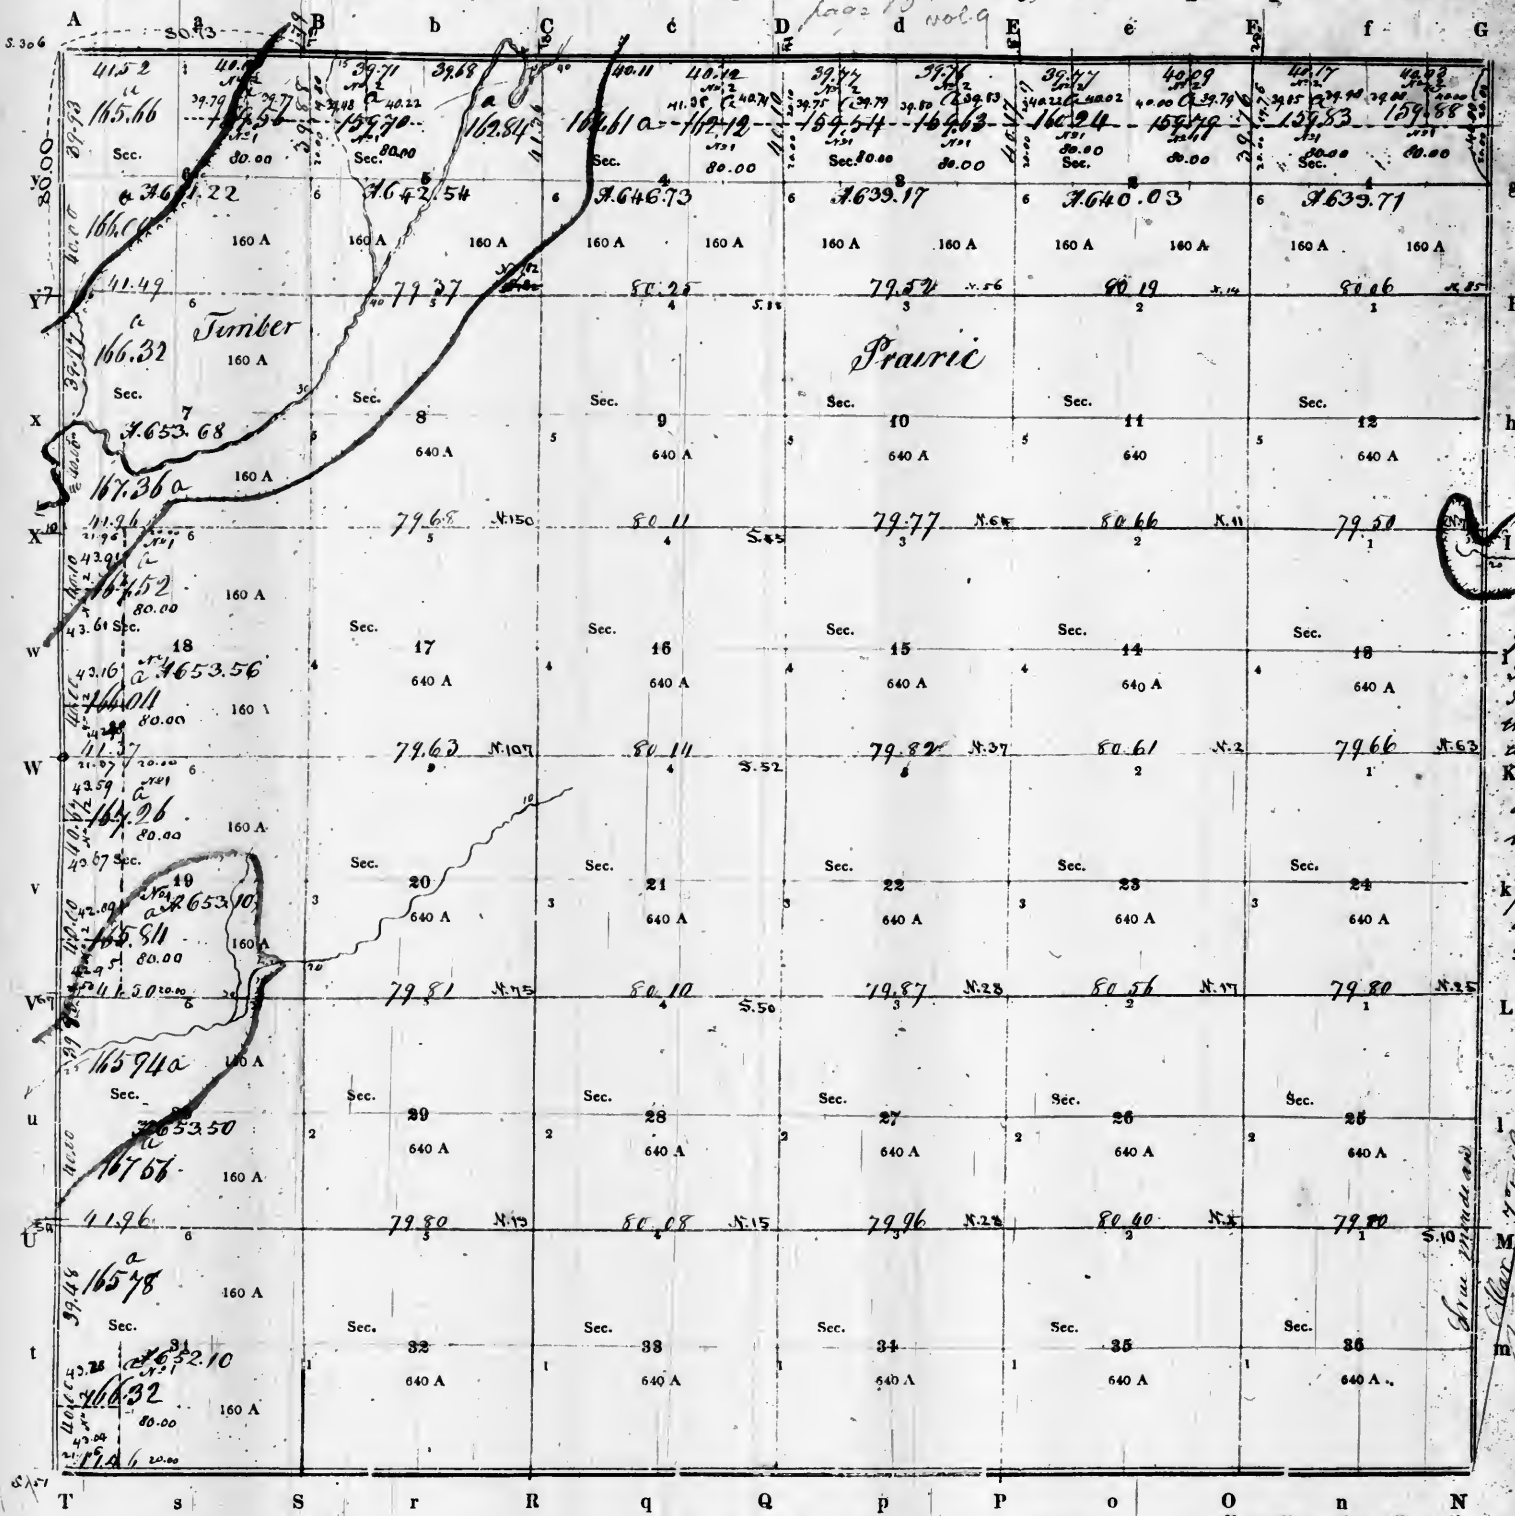

Office of the Surveyor General
for Illinois and Wisconsin
St. Louis Mo. 15th May 1820
The North halves of sections 1, 2, & 3
the North East quarter of section 4 & 5
the North West quarter of section 6
the West halves of sections 18 & 19,
and the South West quarter of section 21
subdivided under the act of Congress
of the 5th of April 1820, and a
plat sent to the Register and
another to the Commissioners of the
General Land Office.

See 2nd page of
Map of the East
of the 3rd principal Meridian.

Aggregate area = 23125.34 acres

Scale of 40 Chains to an Inch.


PURSUANT to a contract with, and instructions from WILLIAM RECTOR, Surveyor of the lands of the United States in the State of Illinois and Territory of Missouri & Arkansas bearing date the 18th day of May 1820
I have admeasured, laid out and surveyed the above described Township; and do hereby certify, that it had such marks and bounds, both natural and artificial, as are represented on said plat, and described in the field notes made thereof, and returned with this plat into the Office of the Surveyor of the lands of the United States, for the State of Illinois and Territory of Missouri and Arkansas
Certified this 10th day of October 1820

EXAMINED.

James Connor D. SURVEYOR
for
Stephen Taylor Esq
July 1820.

77

454

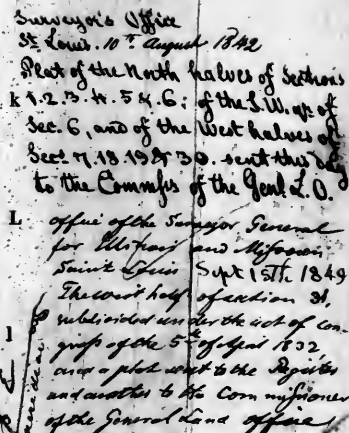


Green D. SURVEYOR.

EXAMINED.

Township No. 17 North of the base line, Range No. 5 East of the 3rd principal Meridian.

455

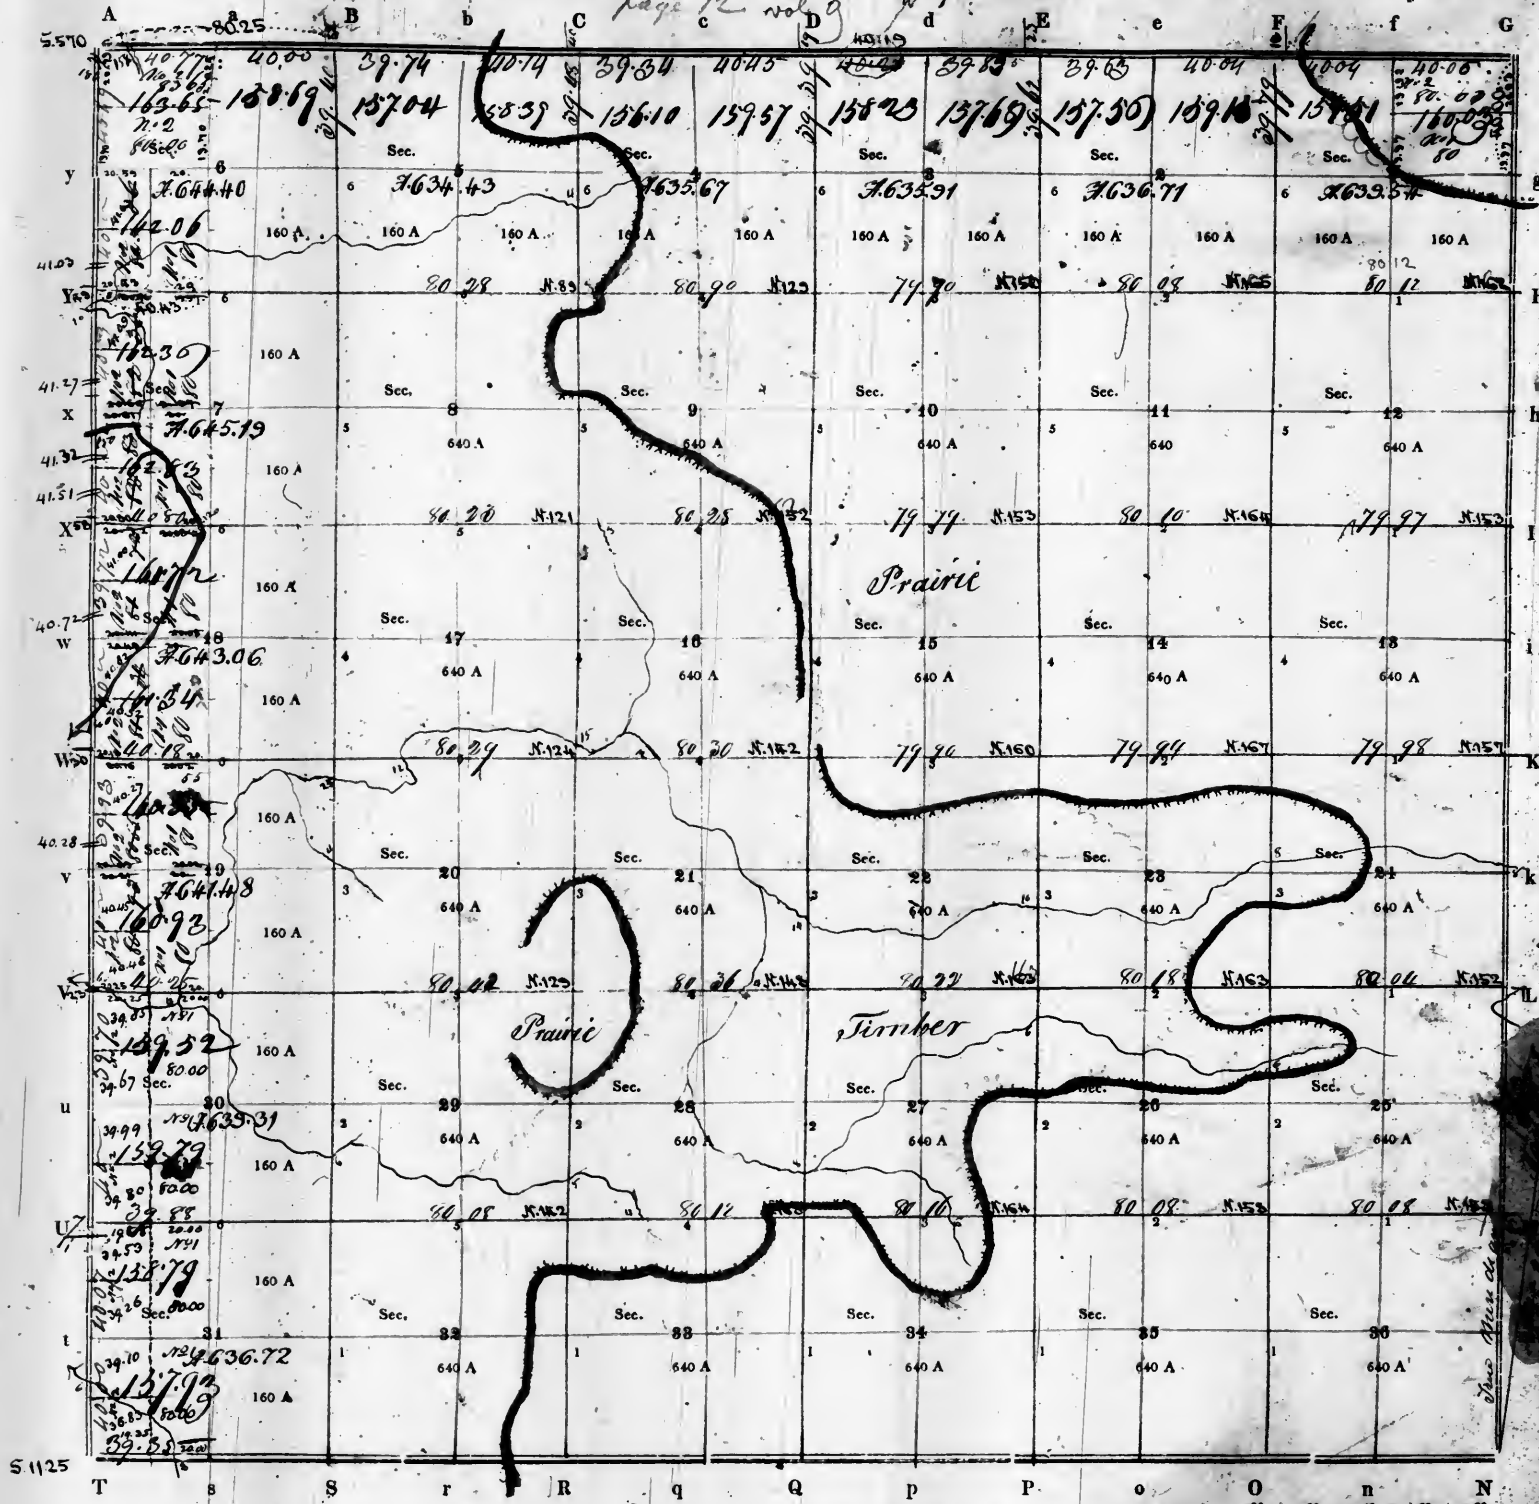

Surveyor's Office
sent this day to the Commr. of the
Genl Land Office.
Office of the Surveyor General
for Illinois & Missouri
Saint Louis Sept. 15th 1849.
The West halve of section 20 & 31.
subdivided under the act of
Congress of the 5th April 1820
and placed in the Register
and under the Com. of the
General Land Office
The Surveyor General
of Illinois & Missouri
July 19th 1851
and quarter of section
and halve of section
subdivided under the
act of Congress of the 5th April
1820, and placed in the
Register and under the Com.
of the General Land Office
Prairie, Mo.

Aggregate area = 23032.42 acres

Scale of 40 Chains to an Inch.

PURSUANT to a contract with, and instructions from WILLIAM RECTOR, Surveyor of the lands of the United States in the State of Missouri and Illinois and Territory of Arkansas - bearing date the third day of March 1849

I have admeasured, laid out and surveyed the above described Township; and do hereby certify, that it had such marks and bounds, both natural and artificial, as are represented on said plat, and described in the field notes made thereof, and returned with this plat into the Office of the Surveyor of the lands of the United States, for the State of Missouri & Illinois and Territory of Arkansas

Certified this 14 day of September 1849

EXAMINED.


W. Rector, D. SURVEYOR

Recorded

13

Township No. 13 North of the base line, Range No. 2 East of the 3rd principal Meridian.

456

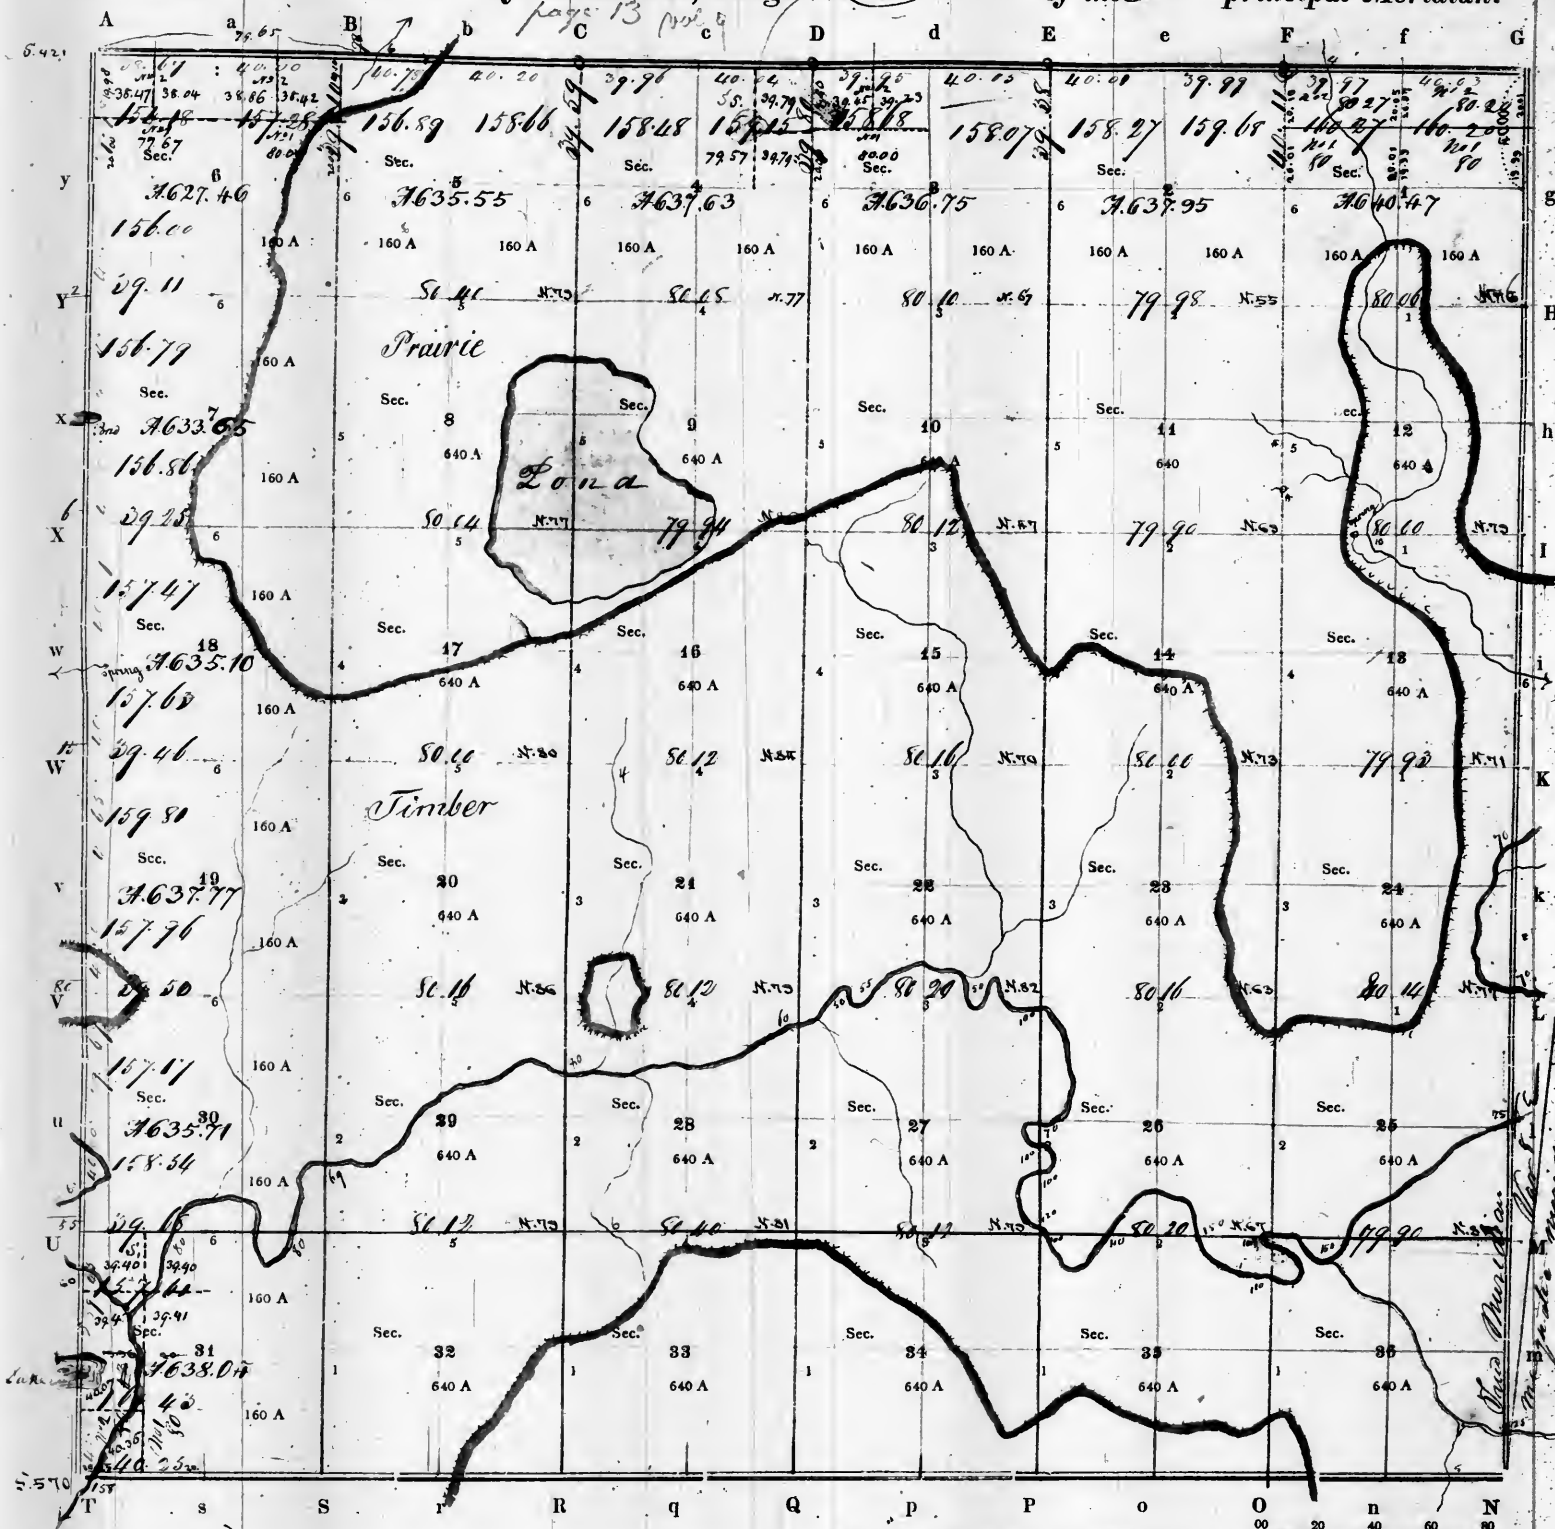

Aggregate area: 22926.08 acres

Scale of 40 Chains to an Inch.

PURSUANT to a contract with, and instructions from WILLIAM RECTOR, Surveyor of the lands of the United States in the States of Missouri and Territory of Arkansas -- bearing date the third day of March 1850

I have admeasured, laid out and surveyed the above described Township; and do hereby certify, that it had such marks and bounds, both natural and artificial, as are represented on said plat, and described in the field notes made thereof, and returned with this plat into the Office of the Surveyor of the lands of the United States, for the States of Missouri and Territory of Arkansas

Certified this 24th day of April 1851

EXAMINED.

W. D. SURVEYOR


Surveyor's Office
St. Louis 10th August 1851
Plat of the North half of Sec. 3
of the S.W. q. of Sec. 31 and
this day to the Commr of the
Genl Land Office
Office of the Surveyor General
for Missouri and Arkansas
Saint Louis July 11th 1850
The North west quarter of section 3
the North half of section 6, and the
South west quarter of section 31
of the 5th of April 1850, and
the North East quarter of section 4,
and the North West quarter of section
27, subdivided as well conform to
previous sales of marked S. 1,
and a plat sent to the Register
another to the Commr of the
General Land Office.

Records

15

Township No. 14 North of the base line, Range No. 5 East of the 3rd principal Meridian.

457

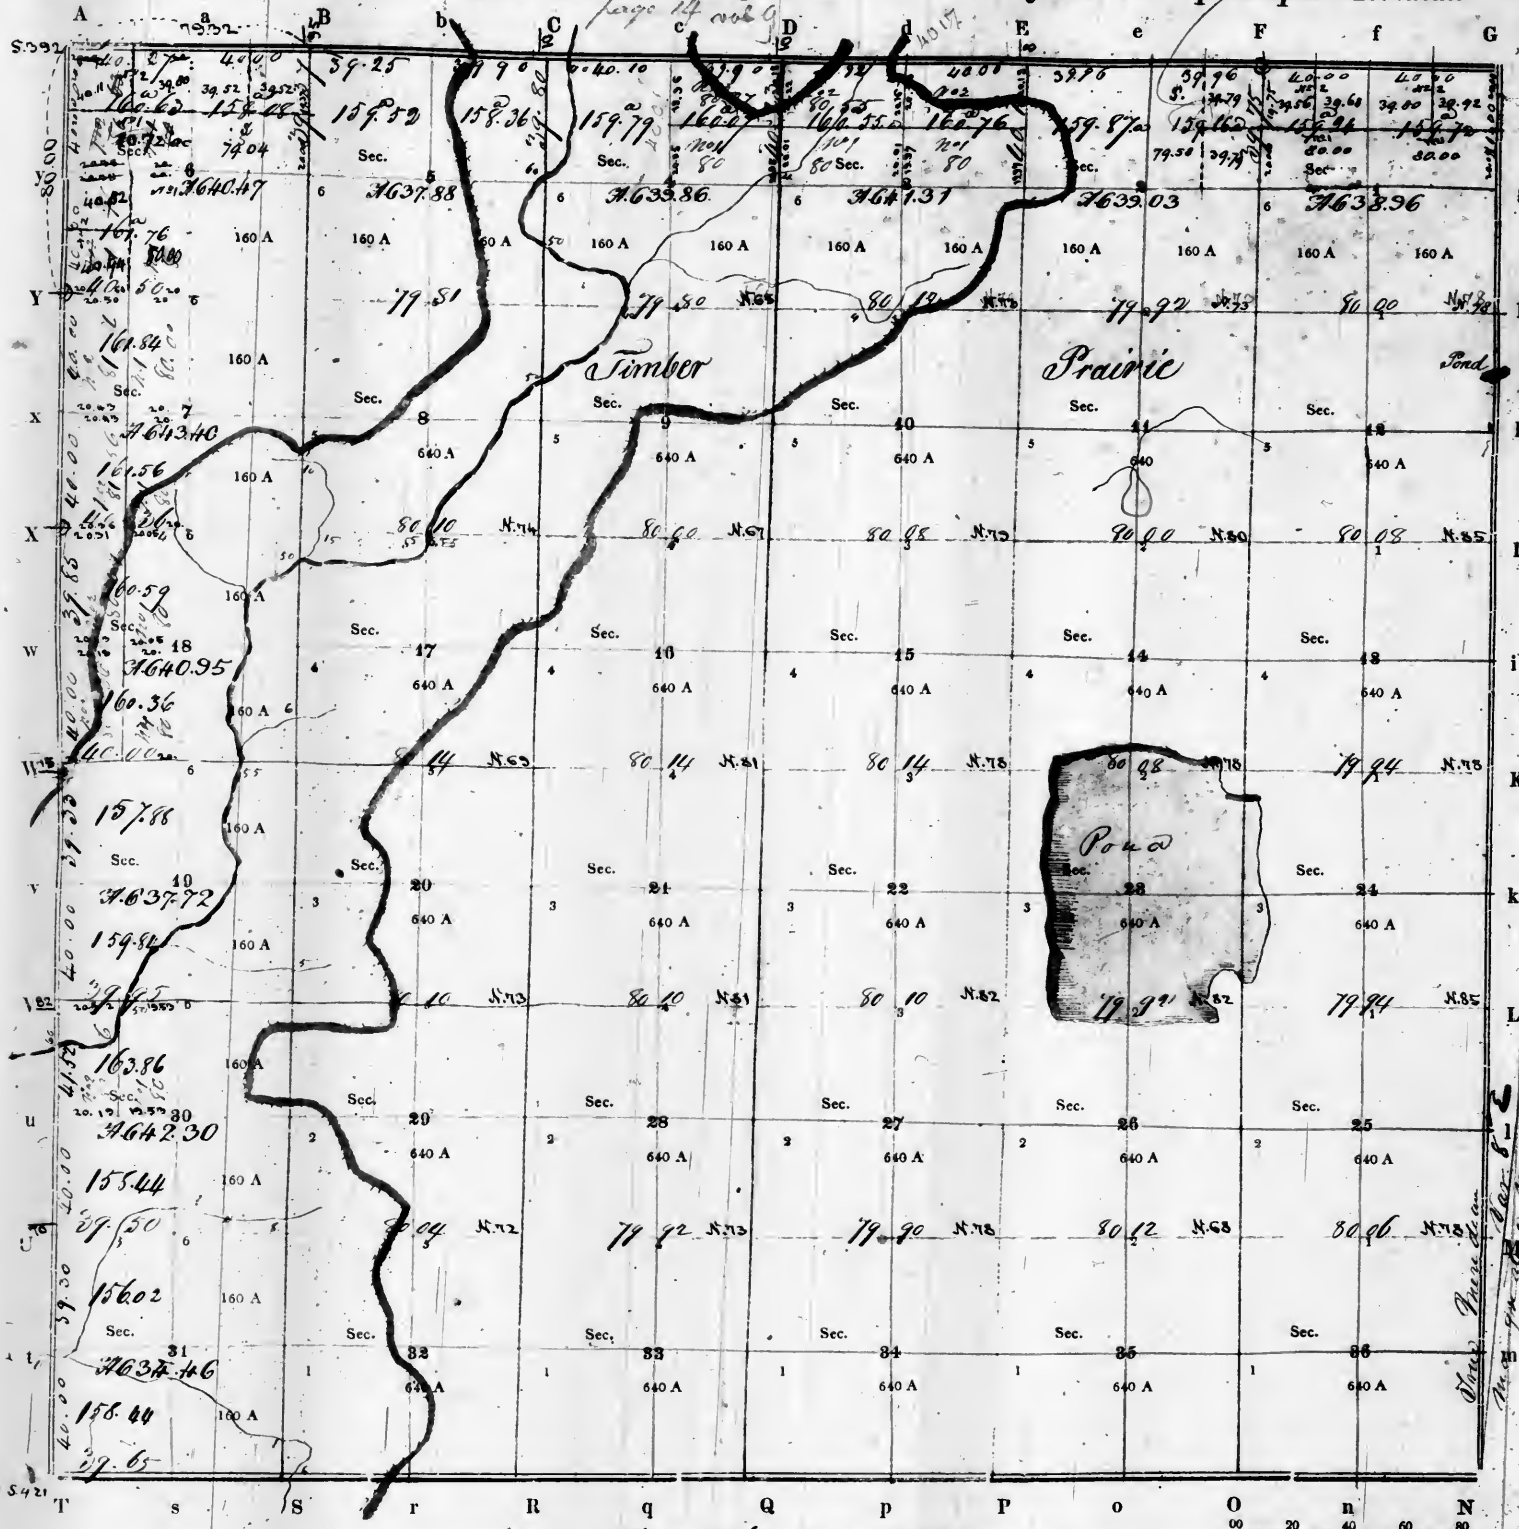

80 Sold

Surveyor's Office
St. Louis 10th August 1842.
Plat of the North half of sec. 3, of the
N.E. q. of sec. 4, of the West halves
of sec. 6, 7, & 18, and of the N.W. q. of
sec. 30 sent this day to the Comdr
of the Genl Land Office.
Office of the Surveyor General
for Illinois and Missouri
Saint Louis July 11th 1850
The North half of section 1, and
the West half of section 6, subdi-
vided under the act of Congress of
the 5th of April 1832, -
the North East quarter of section
2 & 6, subdivided so as to conform
to previous sales (marked S.),
and a plat sent to the Register and
another to the Commissioner of
the General Land Office

Aggregate area = 23036.34 acres

Scale of 40 Chains to an Inch.

PURSUANT to a contract with, and instructions from WILLIAM RECTOR, Surveyor of the lands of the United States in the State of Missouri
on a Illinois and Territory of Arkansas bearing date the Third day of March 1841


I have admeasured, laid out and surveyed the above described Township; and do hereby certify, that it had such marks and bounds, both natural
and artificial, as are represented on said plat, and described in the field notes made thereof, and returned with this plat into the Office of the Sur-
veyor of the lands of the United States, for the State of Missouri and Illinois and Territory of Arkansas

Certified this 24th day of Sept 1841

C. Steen D. SURVEYOR.

EXAMINED.


See plat on
the margin

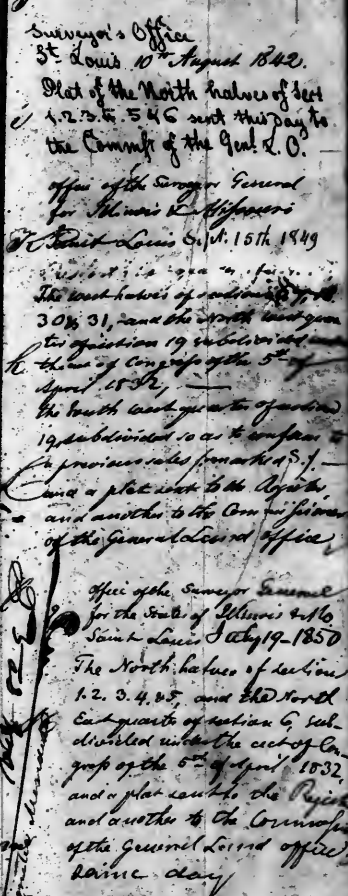

Pursuant to a Contract with and instructions from William Victor Surveyor of the lands of the United States in the States of Missouri and Illinois and Territory of Arkansas bearing date the 3^d day of March ~~1821~~ in the Year of 1821
I have admeasured laid out and surveyed the above described Township and do hereby certify that it had such marks and bounds both natural and artificial as are represented on said plat and described in the field notes made thereof and returned with this plat into the Office of the Surveyor of the lands of the United States for the States of Missouri and Illinois and Territory of Arkansas
Certified the 3^d day of May 1821
C. C. C.

459.

A 
 B 
 C 
 AW <

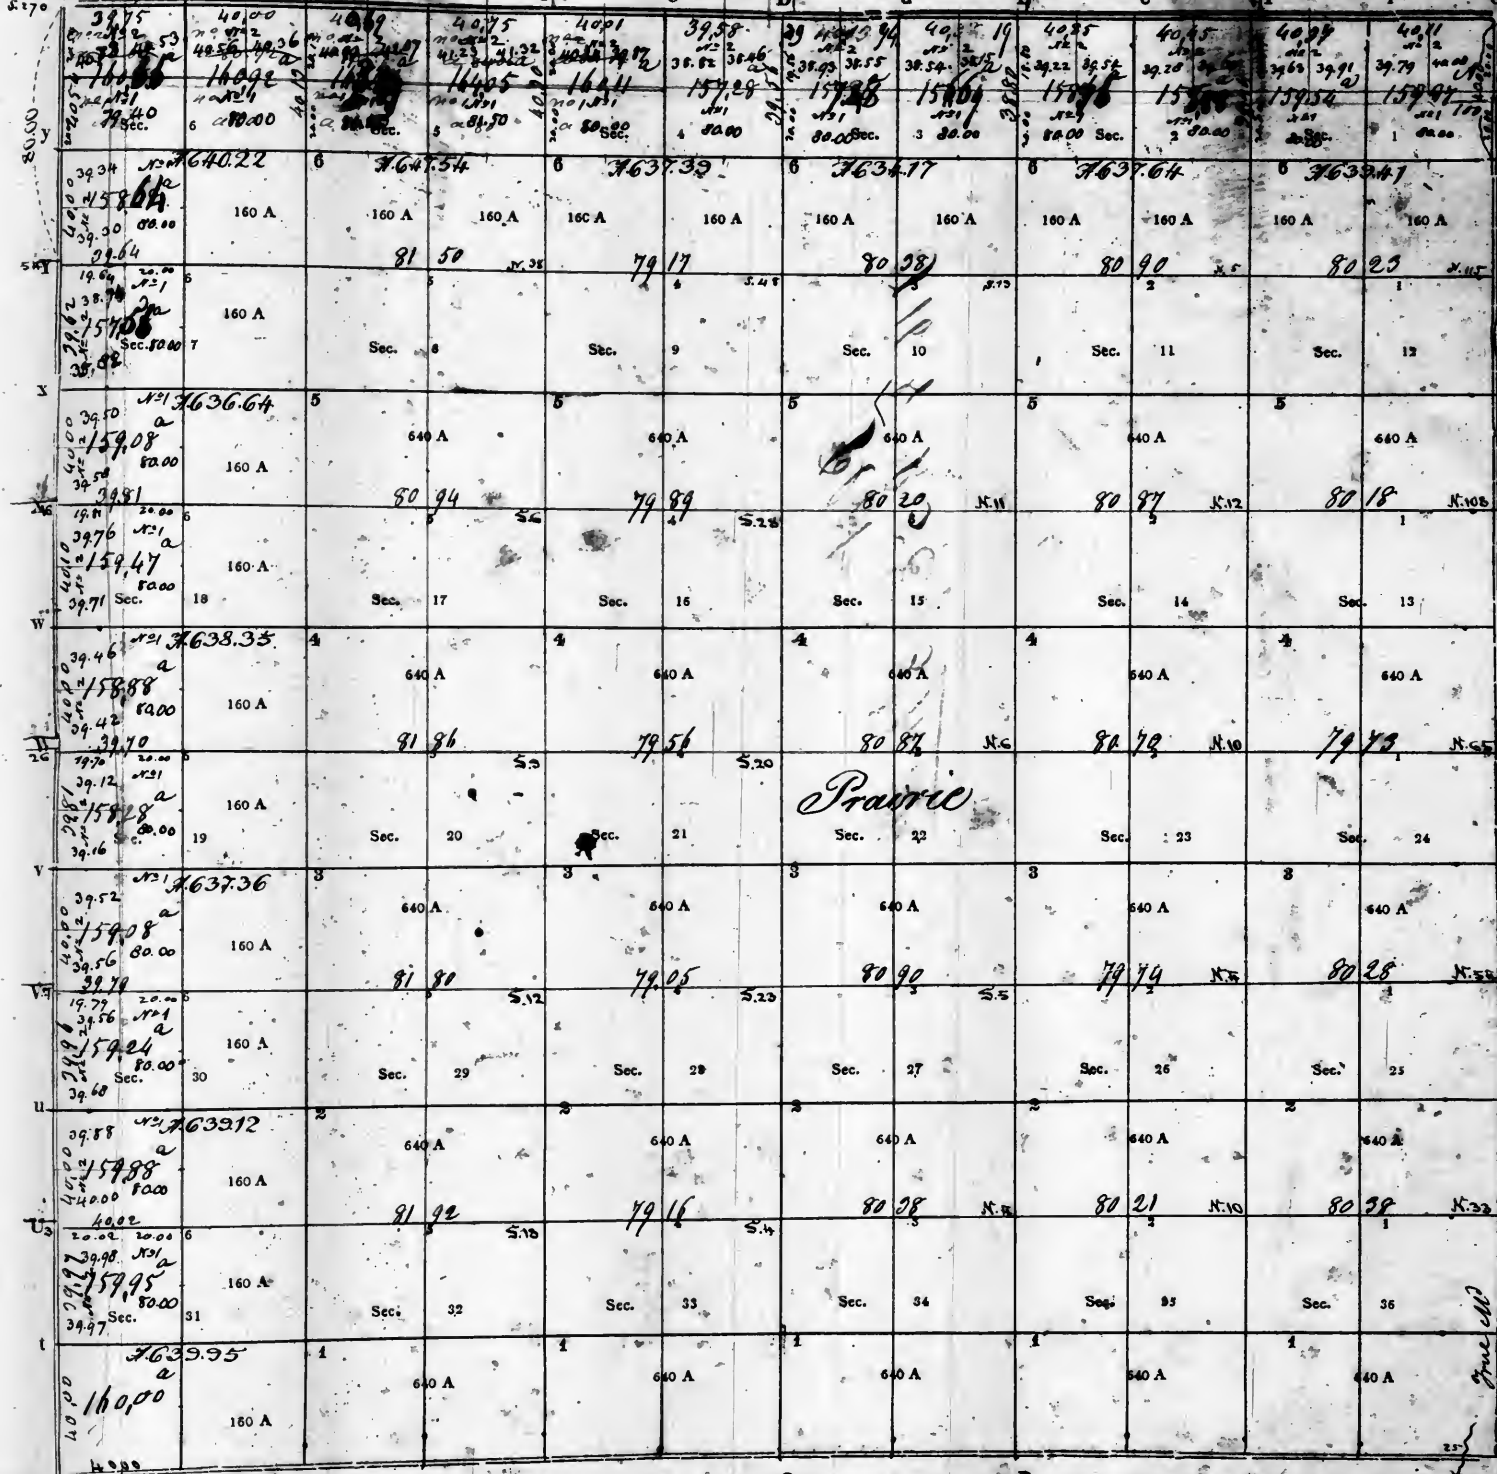

Office of the Surveyor General
for Missouri & Arkansas
Saint Louis Sept. 15th 1849
The North halves of sections 1, 2, 3, 4,
5 & 6, the South west quarter of
section 6, the west halves of sections
7, 15, 19 & 30, and the North west
quarter of section 31, exhibited to me
the act of Congress of the 5th of April
1832, and a placard to the Register
and collector to the Commissioners of the
General Land office. ✓

Na 4° 55' E
Mag 4.00

Aggregate area = 23027.79 acres

Scale of 40 Chains to an Inch

PURSUANT to a contract with, and instructions from William Rector, Surveyor of the lands of the United States in the State of Missouri bearing date the Nineteenth day of February 1832
Missouri and Territory of Arkansas
 I have admeasured, laid out and surveyed the above described Township; and do hereby certify, that it had such marks and bounds, both natural and artificial,
 as are represented on said plat, and described in the field notes made thereof, and returned with this plat into the Office of the Surveyor of the Lands of the
 United States, in the State of Illinois Missouri and Territory of Arkansas Surveyed by Rich^d J. Holliday
 Certified this 13th day of November 1832 for Elias Rector SURVEYOR.


EXAMINED.

Recorded

460.

Township No. 17 North of the base line, Range No. 5 East of the 3rd principal Meridian.

Surveyor's office
Saint Louis, Mo. 15-1849.
The North half of section 3 surveyed
and a plat sent to the Register and
another to the Commissioner of the
General Land Office

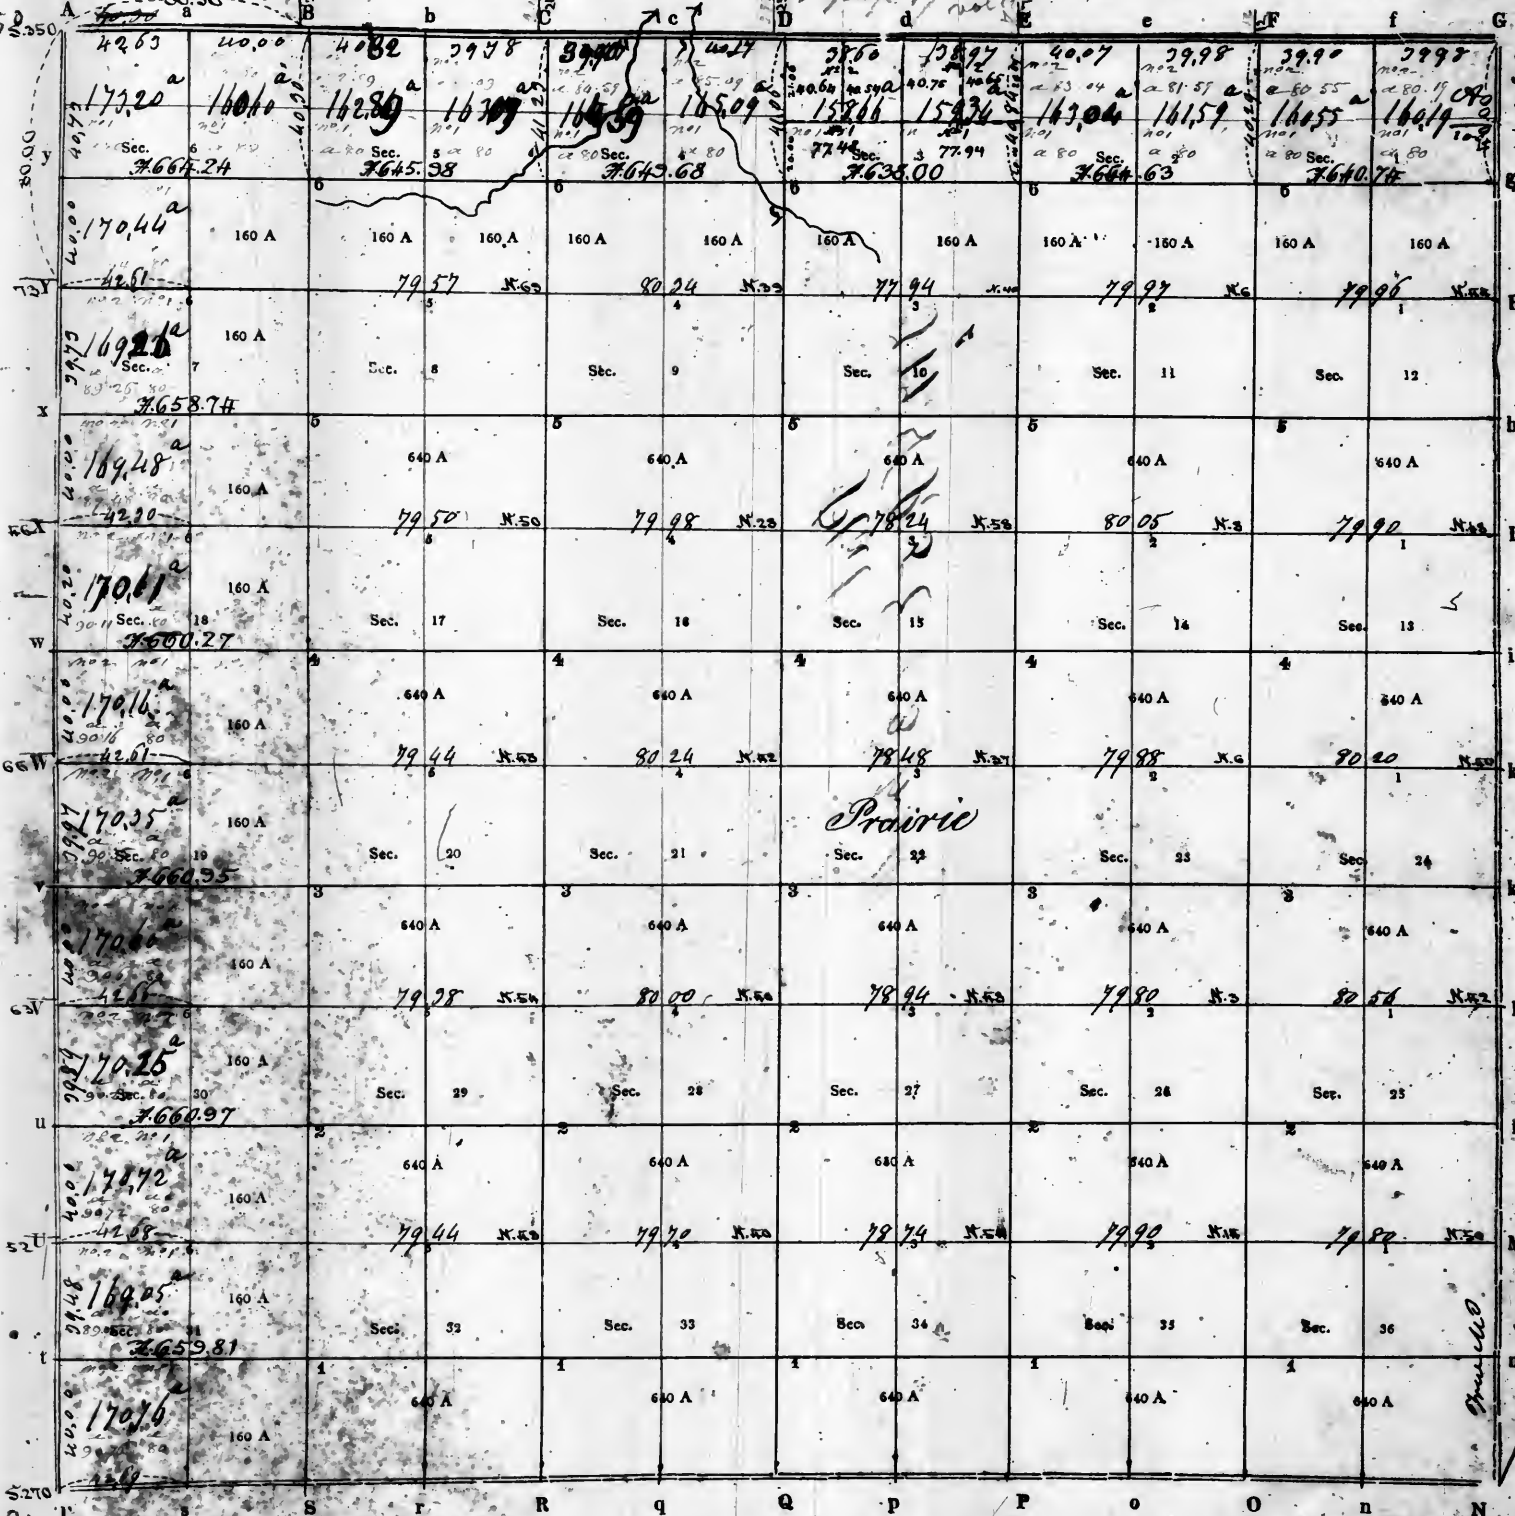

Aggregate area = 23184.01 acs

Scale of 40 Chains to an inch.


PURSUANT to a contract with, and instructions from William Rector, Surveyor of the lands of the United States in the State of Illinois, bearing date the 15th day of February 1882, I have surveyed, laid out and surveyed the above described Township; and do hereby certify, that it had such marks and bounds, both natural and artificial, as are represented on said plat, and described in the field notes made thereof, and returned with this plat into the Office of the Surveyor of the Lands of the United States, in the State of Illinois, Missouri and Territory of Arkansas, Surveyed by Richd. T. Holliday for Elias Rector, D. SURVEYOR.

EXAMINED.

Rounded

461

Township No. *18 North* of the base line, Range No. *5 East* of the *3^d* principal Meridian.

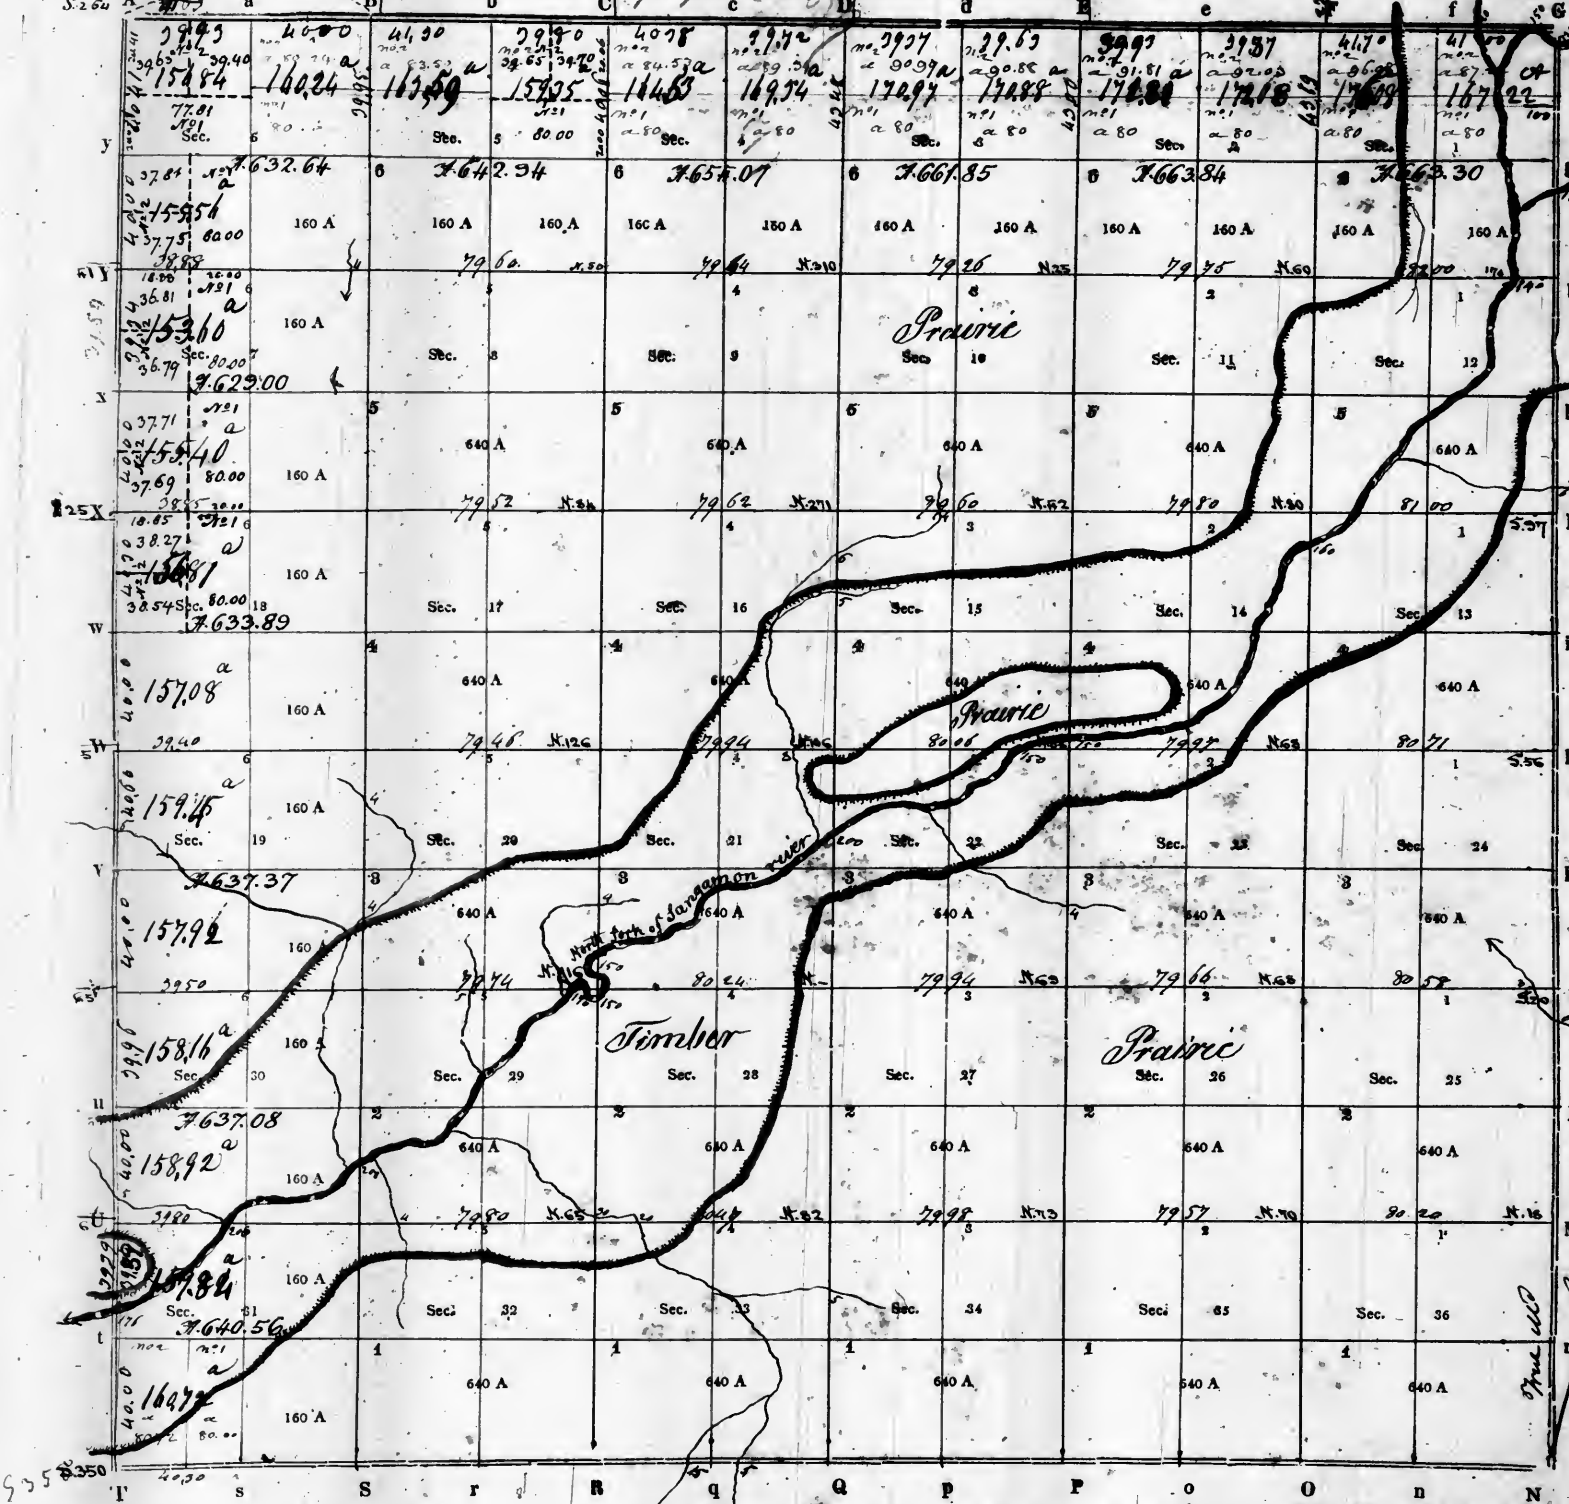

Surveyor's Office
Saint Louis, June 15th 1882.
The North East quarter of section 5,
the North West quarter of section 15,
the North East quarter of section 18,
the North West quarter of section 18
are subdivided and a plat sent to the
Register and another to the Com-
missioner of the General Land Office.

Aggregate area - 23096.54 acres

Scale of 40 Chains to an Inch.


PURSUANT to a contract with, and instructions from William Rector, Surveyor of the lands of the United States in the State of Illinois, and Territory of Arkansas, bearing date the *thirteenth* day of *February* 1882, I have admeasured, laid out and surveyed the above described Township; and do hereby certify, that it had such marks and bounds, both natural and artificial, as are represented on said plat, and described in the field notes made thereof, and returned with this plat into the Office of the Surveyor of the Lands of the United States, in the State of Illinois, Missouri and Territory of Arkansas, surveyed by *Richd. T. Holliday* for *Elmer Rector* D. SURVEYOR.

Certified this *thirteenth* day of *November* 1882.

EXAMINED.

Rounded

Township No. *19 North* of the base line, Range No. *5 East* of the *3^d* principal Meridian.

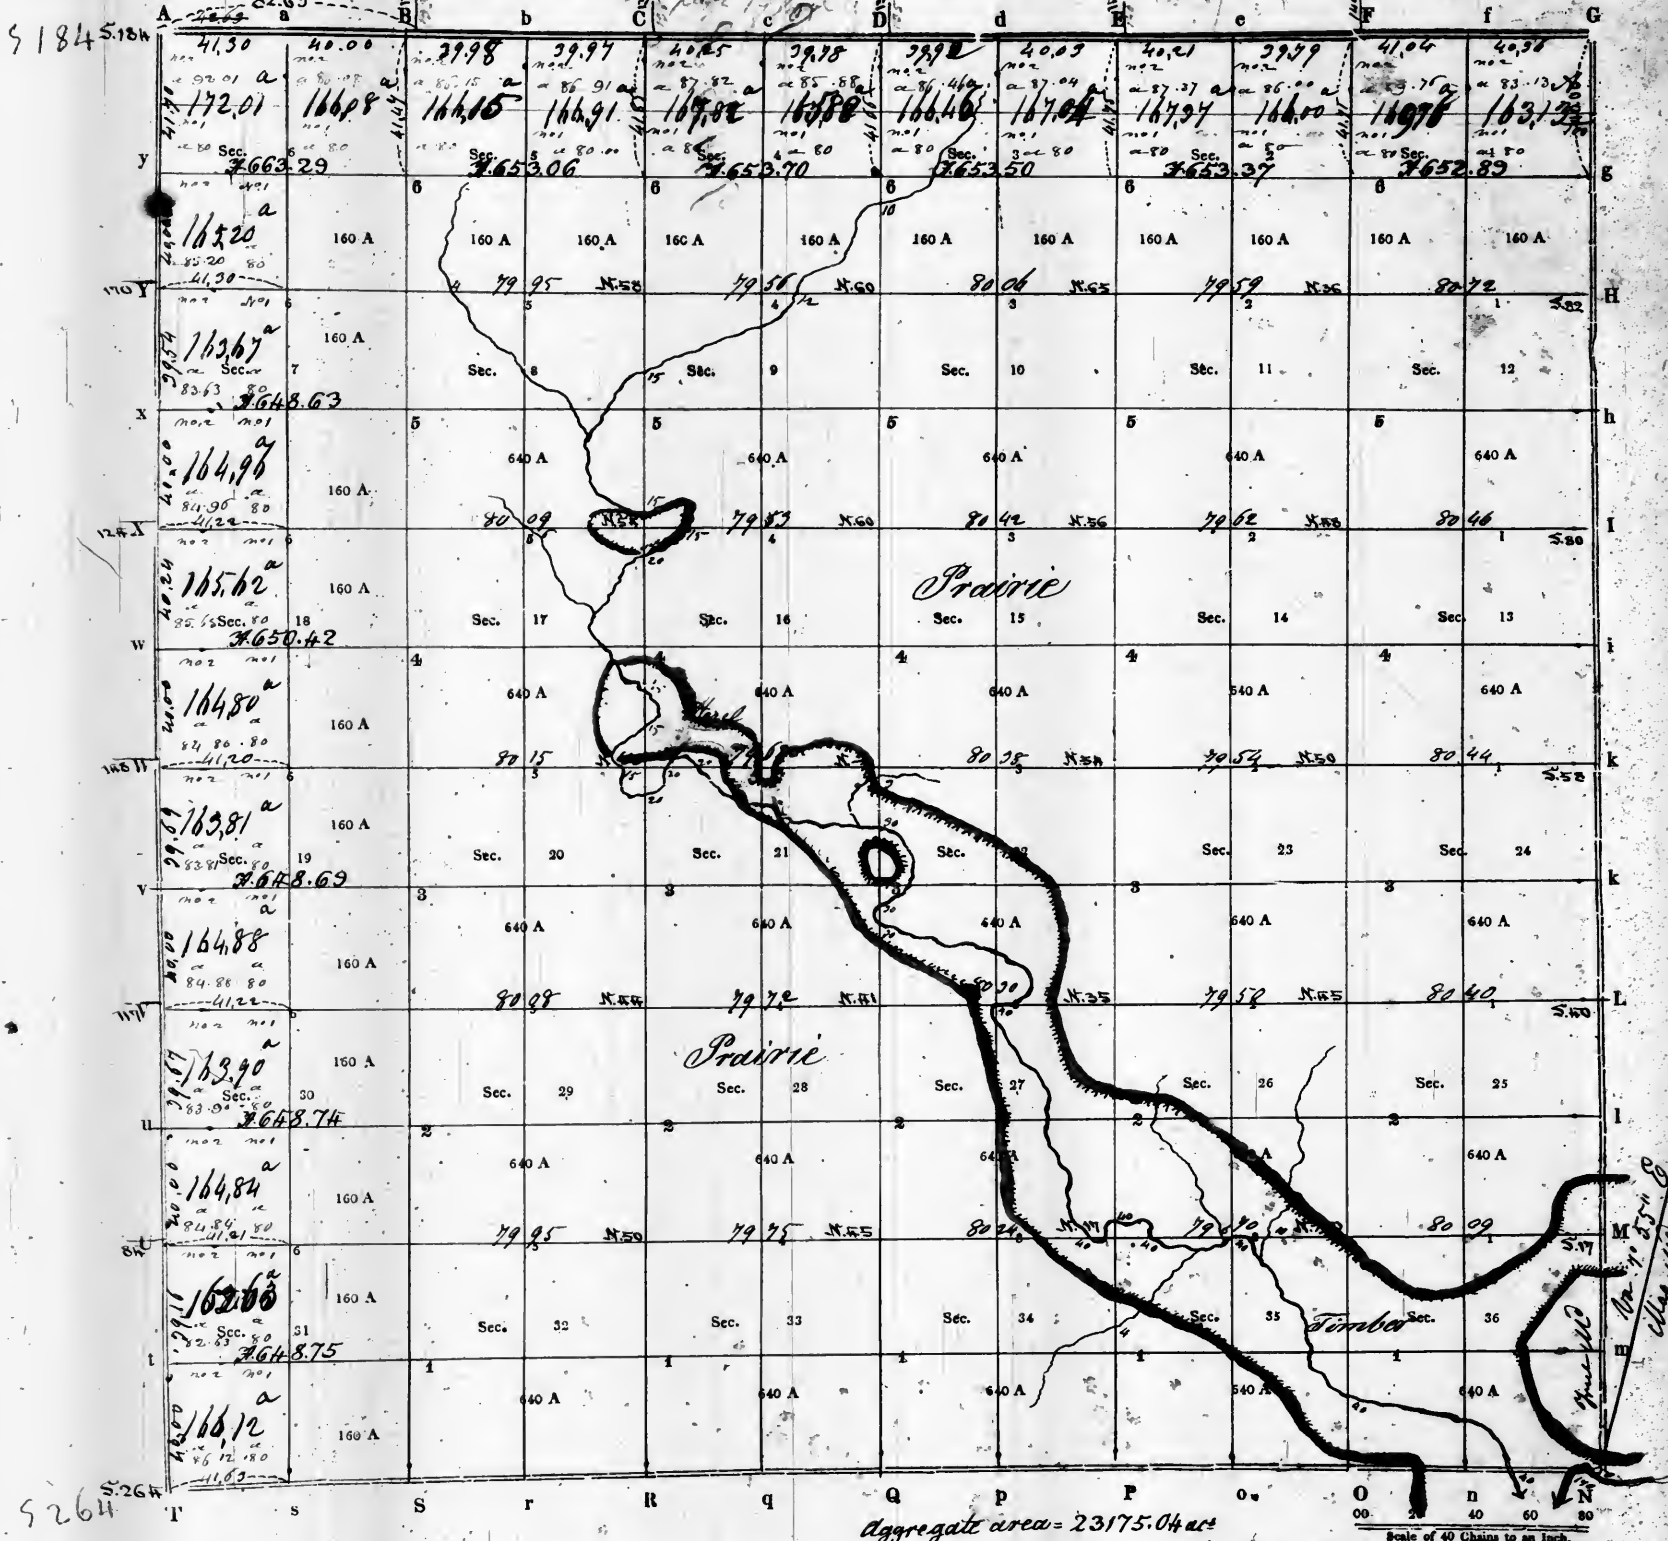


PURSUANT to a contract with, and instructions from William Reector, Surveyor of the lands of the United States in the *State of Illinois* and *Territory of Arkansas* bearing date the *thirtieth* day of *February* 1822 I have admeasured, laid out and surveyed the above described Township; and do hereby certify, that it had such marks and bounds, both natural and artificial, as are represented on said plat, and described in the field notes made thereof, and returned with this plat into the Office of the Surveyor of the Lands of the United States, in the *State of Illinois* *Missouri* and *Territory of Arkansas* Surveyed by *Richd. J. Holliday* for *Elias Reector* S. SURVEYOR.

Certified this *thirtieth* day of *November* 1822

EXAMINED.

Rounded

Township N^o 20 North of the Base line, Range N^o 5 East of the 3^d Principal Meridian

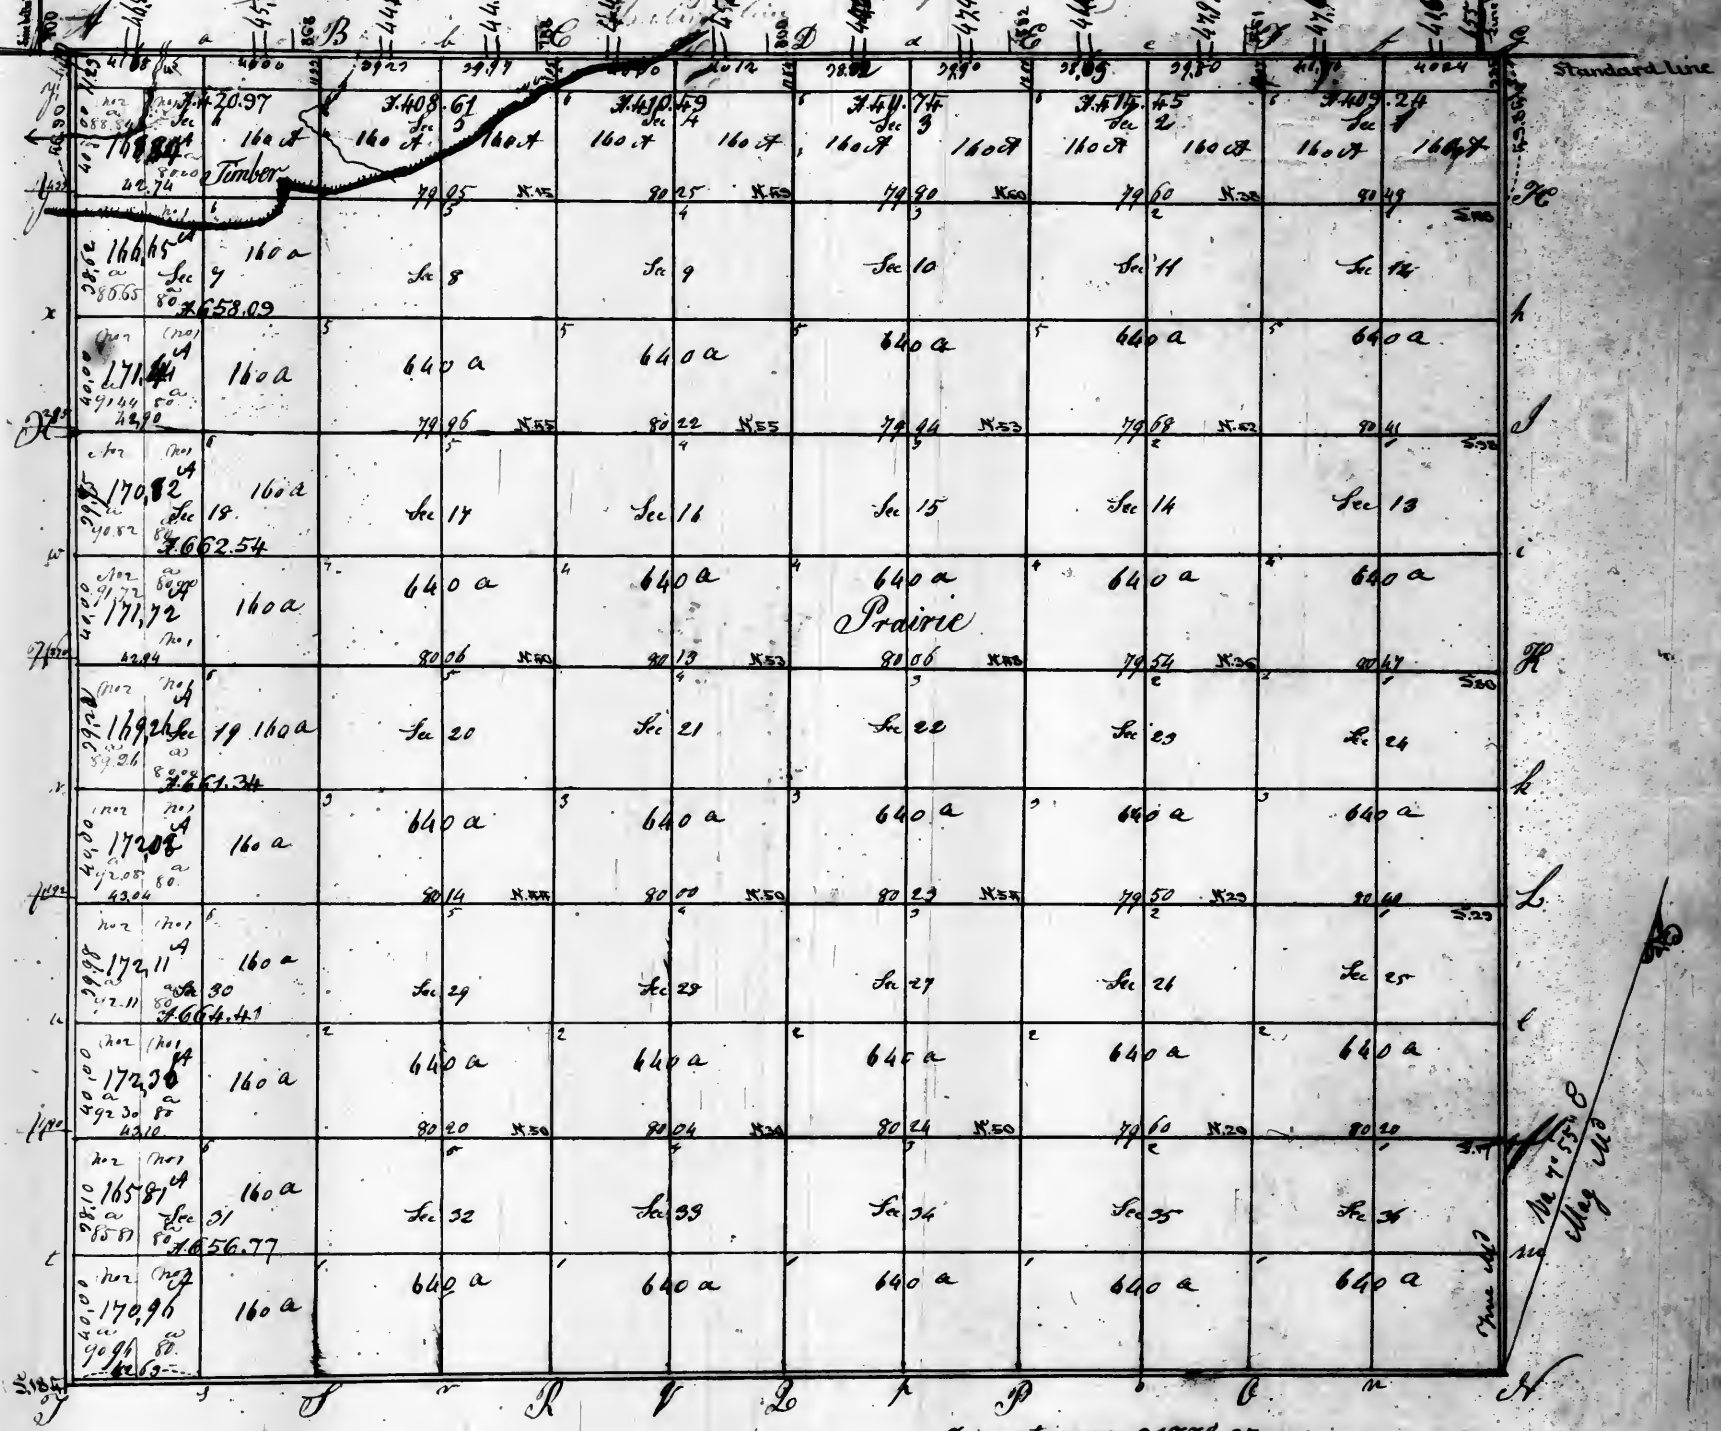


Aggregate area - 21778.65 ac

Pursuant to a contract with and instructions from William Reitor Surveyor of the Lands of the United States in the States of Illinois & Missouri & Territory of Arkansas bearing date the 19th day of February A.D. 1822 - I have examined said plat and surveyed the above described Township & do hereby certify that it had well marked and bounded both natural and artificial as are represented on said plat and described in the field notes made thereof and returned with this plat into the office of the Surveyor of the Lands of the United States in the States of Illinois & Missouri & Territory of Arkansas
 Witness my hand and seal this Thirtieth day of November 1822
 Examined
 Surveyed by Rich^d T. Polkaday
 for Elias Reitor Surveyor

51


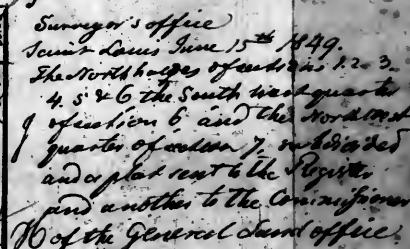

Scale of 40 chains to an inch.

Ex 21-Sub 100
100


Surveyor's Office St. Louis 30th September 1832
The above plat of Township 21 North Range 5 East of the 3^d principal meridian
is conformable to the field notes of the Survey thereof on file in this office, and as noted
in the Record.

John Baileiff Surveyor

Recorded

Township N. 22 North of the base line, Range N. 5 East of the 3rd Principal Meridian

Page 22

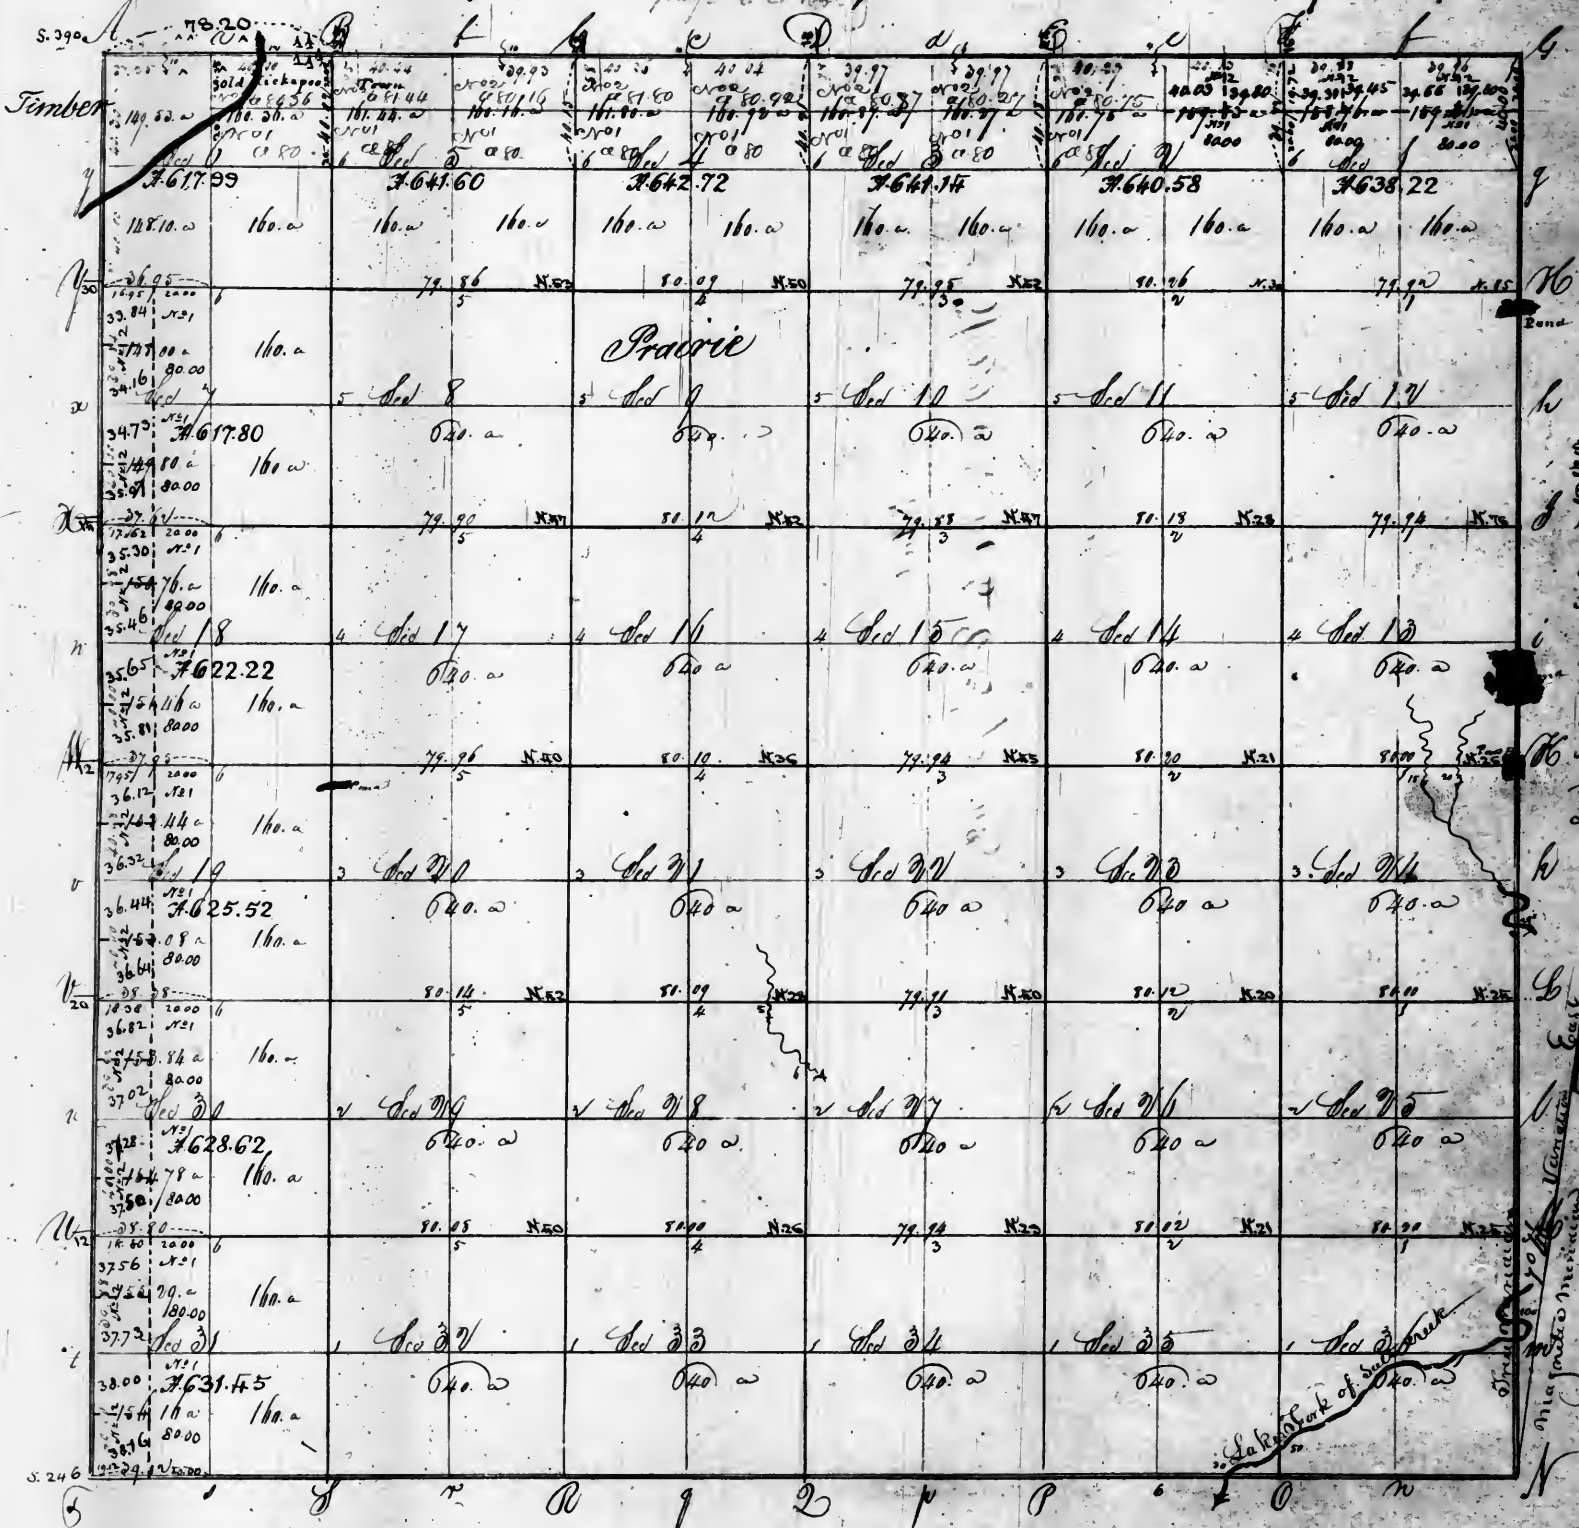

Surveyor's Office
St. Louis 16th Sept. 1842.
Plat of the N.E. quarter of Sect. 6
sent this day to the Commr of the Genl. L.O.

Surveyor's Office
Saint Louis June 15th 1849.
The North half of section 1, the North
East quarter of section 2, and the
West halves of sections 7, 12, 19, 30,
unsubdivided and a plat sent to the
Register and another to the Com-
missioner of the General
Land Office.

Aggregate area = 22947.86 ac.

Scale of 40 Chains to an inch

Pursuant to a contract with, and instructions from, William Hector Surveyor of the lands of the United States in the State of Illinois and Missouri and Territory of Arkansas, having date the first day of December 1830. I have admeasured, laid out and surveyed the above described Township; and as hereby Certified, that it has such marks and boundaries, both natural and artificial as are represented on said plat, and described in the field notes made thereof, and returned with the plat into the Office of the Surveyor of the lands of the United States in the State of Illinois and Missouri and Territory of Arkansas.


Certified this 23rd day of June 1844

John P. Farquhar

193
7931
4011
3920

Record

Township No. 23 North of the base line. Range No. 5 East of the 3rd principal Meridian

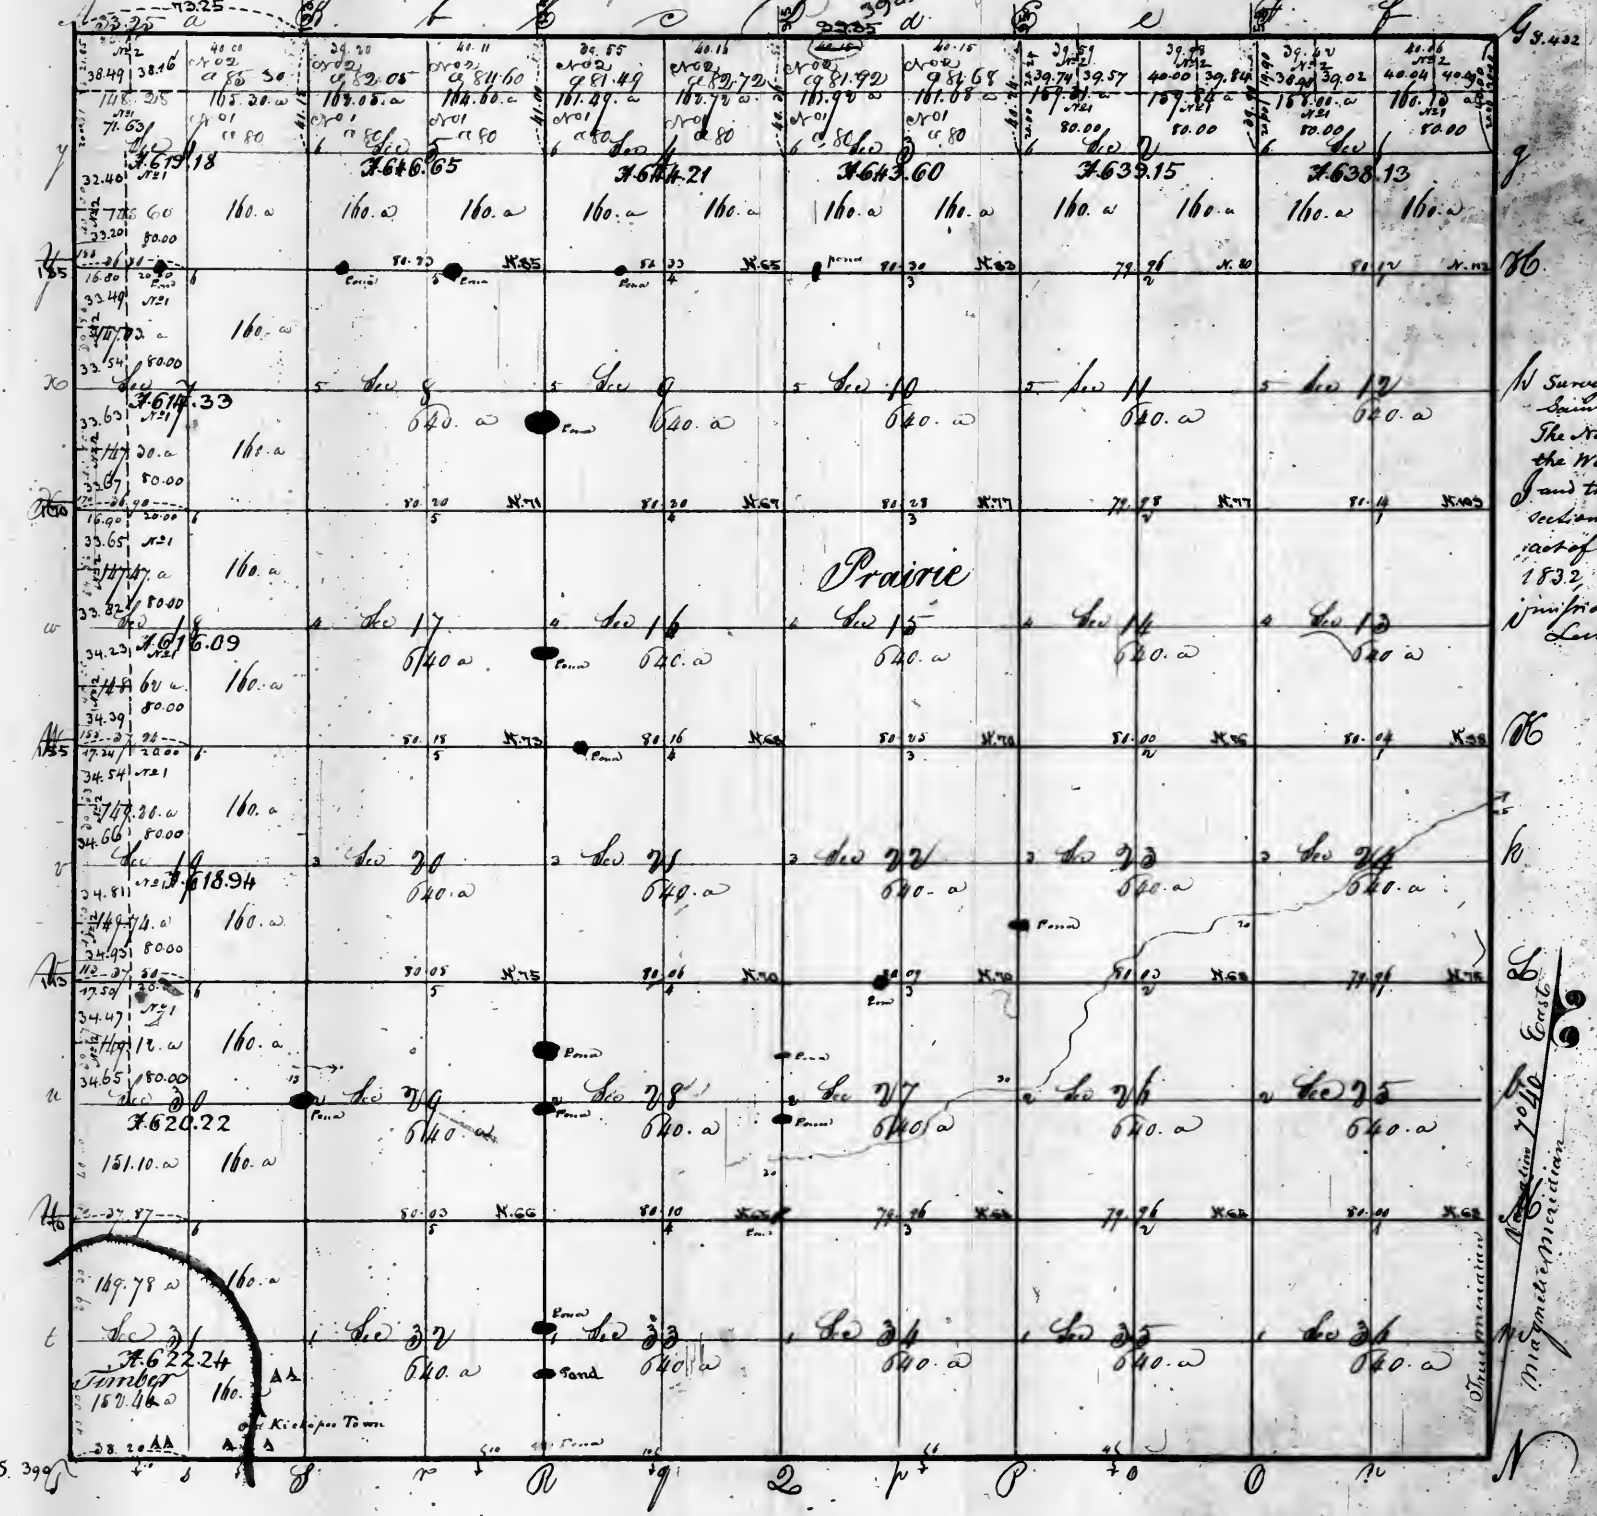

In Surveyor's office
Saint Louis June 15th 1849.
The North halves of sections 32, 33, 34, 1000.

Aggregate area = 22922.74 acs

Scale of 40 chains to an inch

Pursuant to contract with, and Instructions from, William Butler, Surveyor of the lands of the United States of Illinois and Missouri and Territory of Arkansas, bearing date the first day of December 1832. I have admeasured, laid out and surveyed the above described Township; and do hereby certify, that it had such marks and bounds, both natural and artificial as are represented on said plat, and described in the field notes made thereof, and returned with this plat into the Office of the Surveyor of the lands of the United States, in the State of Illinois and Missouri and Territory of Arkansas.


Certified this 23rd day of June 1847

John Barrett Surveyor

Revised

81.00
19
8081
4034
4047

Township N. 24 North of the base line, Range N. 5 East of the 3rd principal Meridian.

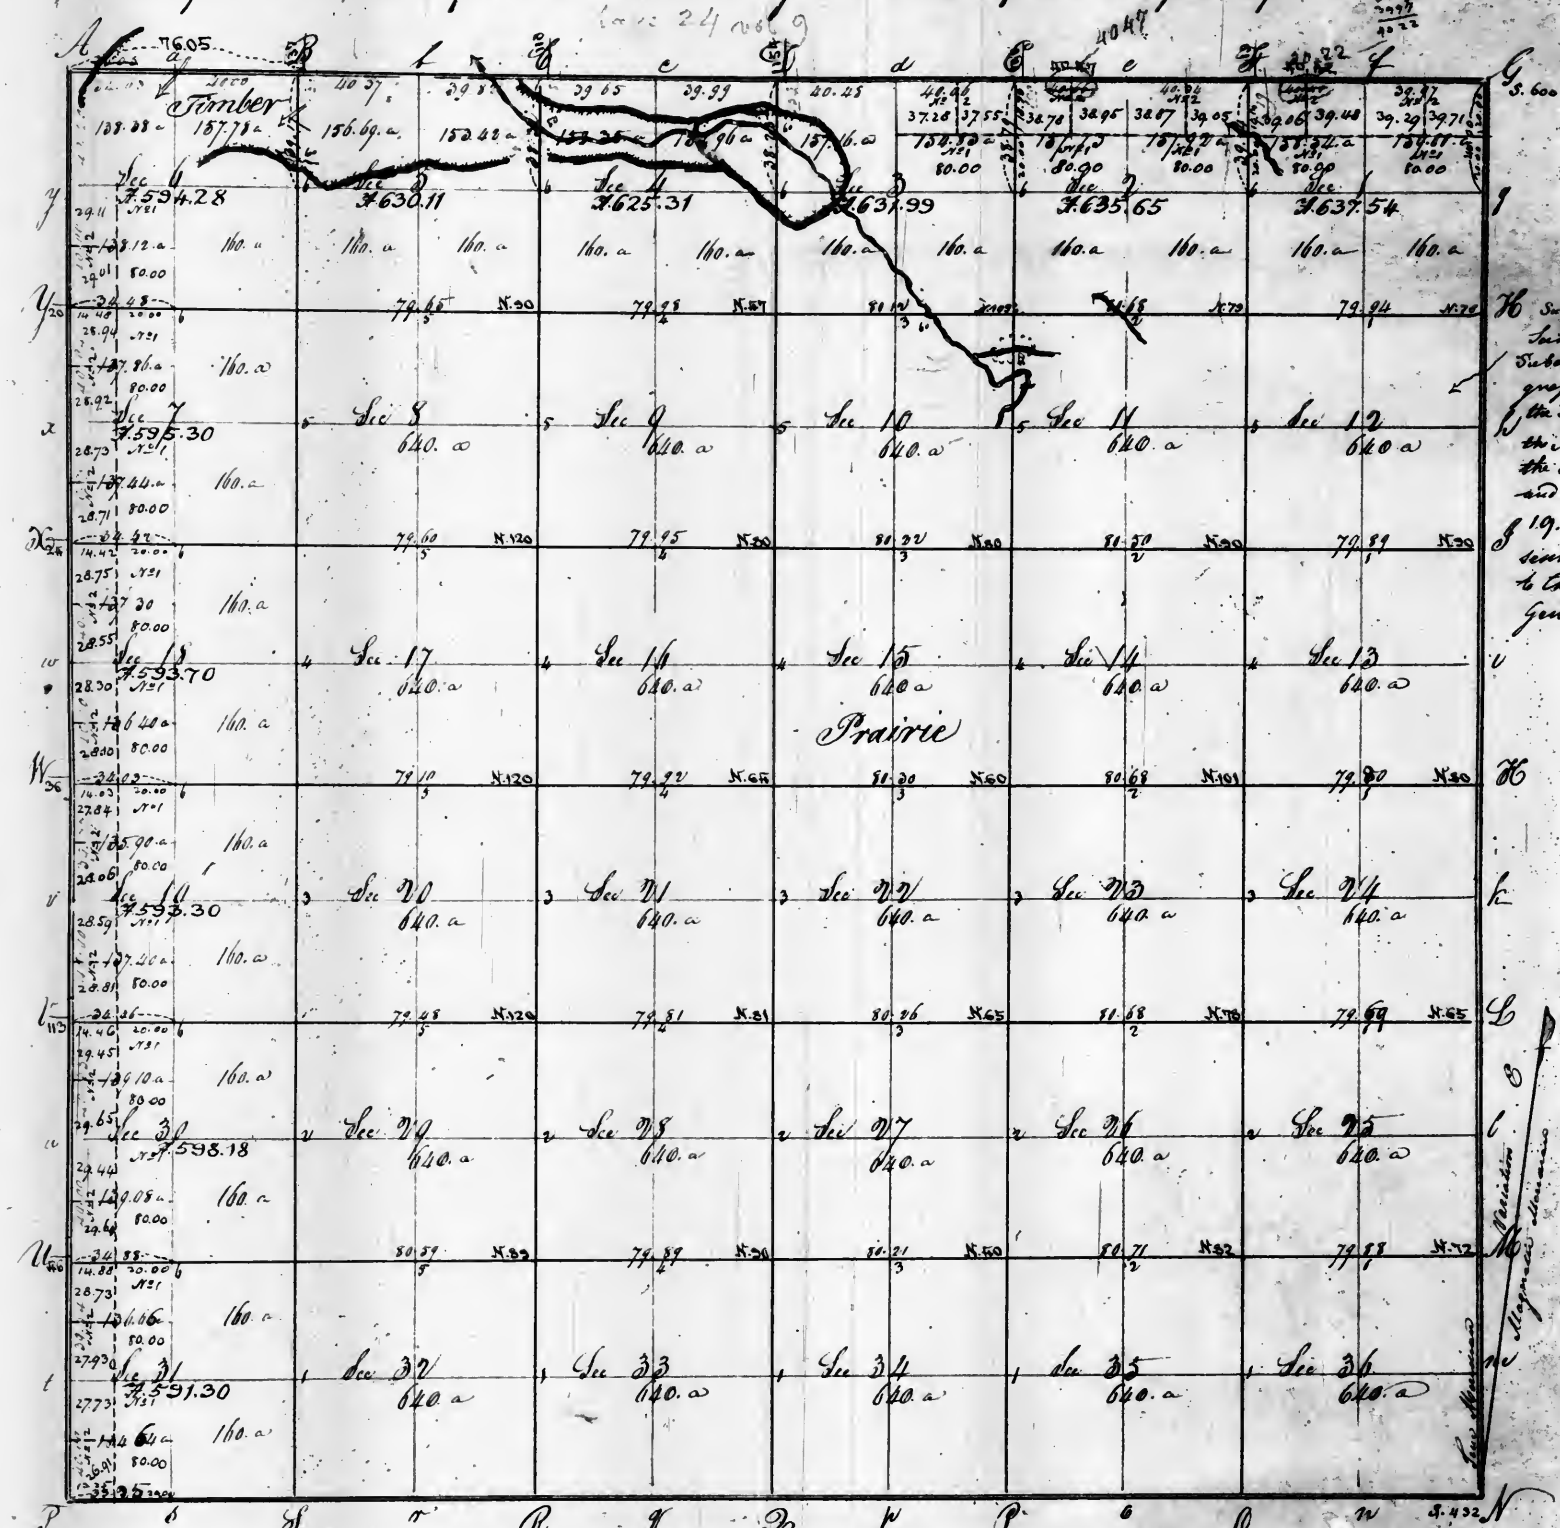

Surveyor's office
Saint Louis June 15th 1824
Subscribed under the act of Congress of the 5th of April 1820:
the North halves of sections 19, 20,
the North East quarter of section 3,
the South West quarter of section 6,
and the West halves of sections 7, 18,
19, 30 & 31, - whose plat is now
sent to the Register and another
to the Commissioner of the
General Land office.

Aggregate area - 22726.66 ac. Scale 40 Chains to an inch


Pursuant to a Contract with, and Instructions from William Rector Surveyor of the lands of the United States, in the State of Illinois and Missouri and Territory of Arkansas, bearing date the third day of October 1820. I have administered, laid out and surveyed the above described Township, and do hereby Certify that it has such marks and bounds, both natural and artificial, as are represented on said plat and described in the field notes made thereof, and returned with this plat to the Office of the Surveyor of the lands of the United States, in the State of Illinois and Missouri, and Territory of Arkansas.

Certified this Jan 20

1824

C. Rector Surveyor


Recorded
Township N. 25 North of the base line, Range N. 5 East of the 3^d Principal Meridian
Page 2 of 3
Or 52 R 6

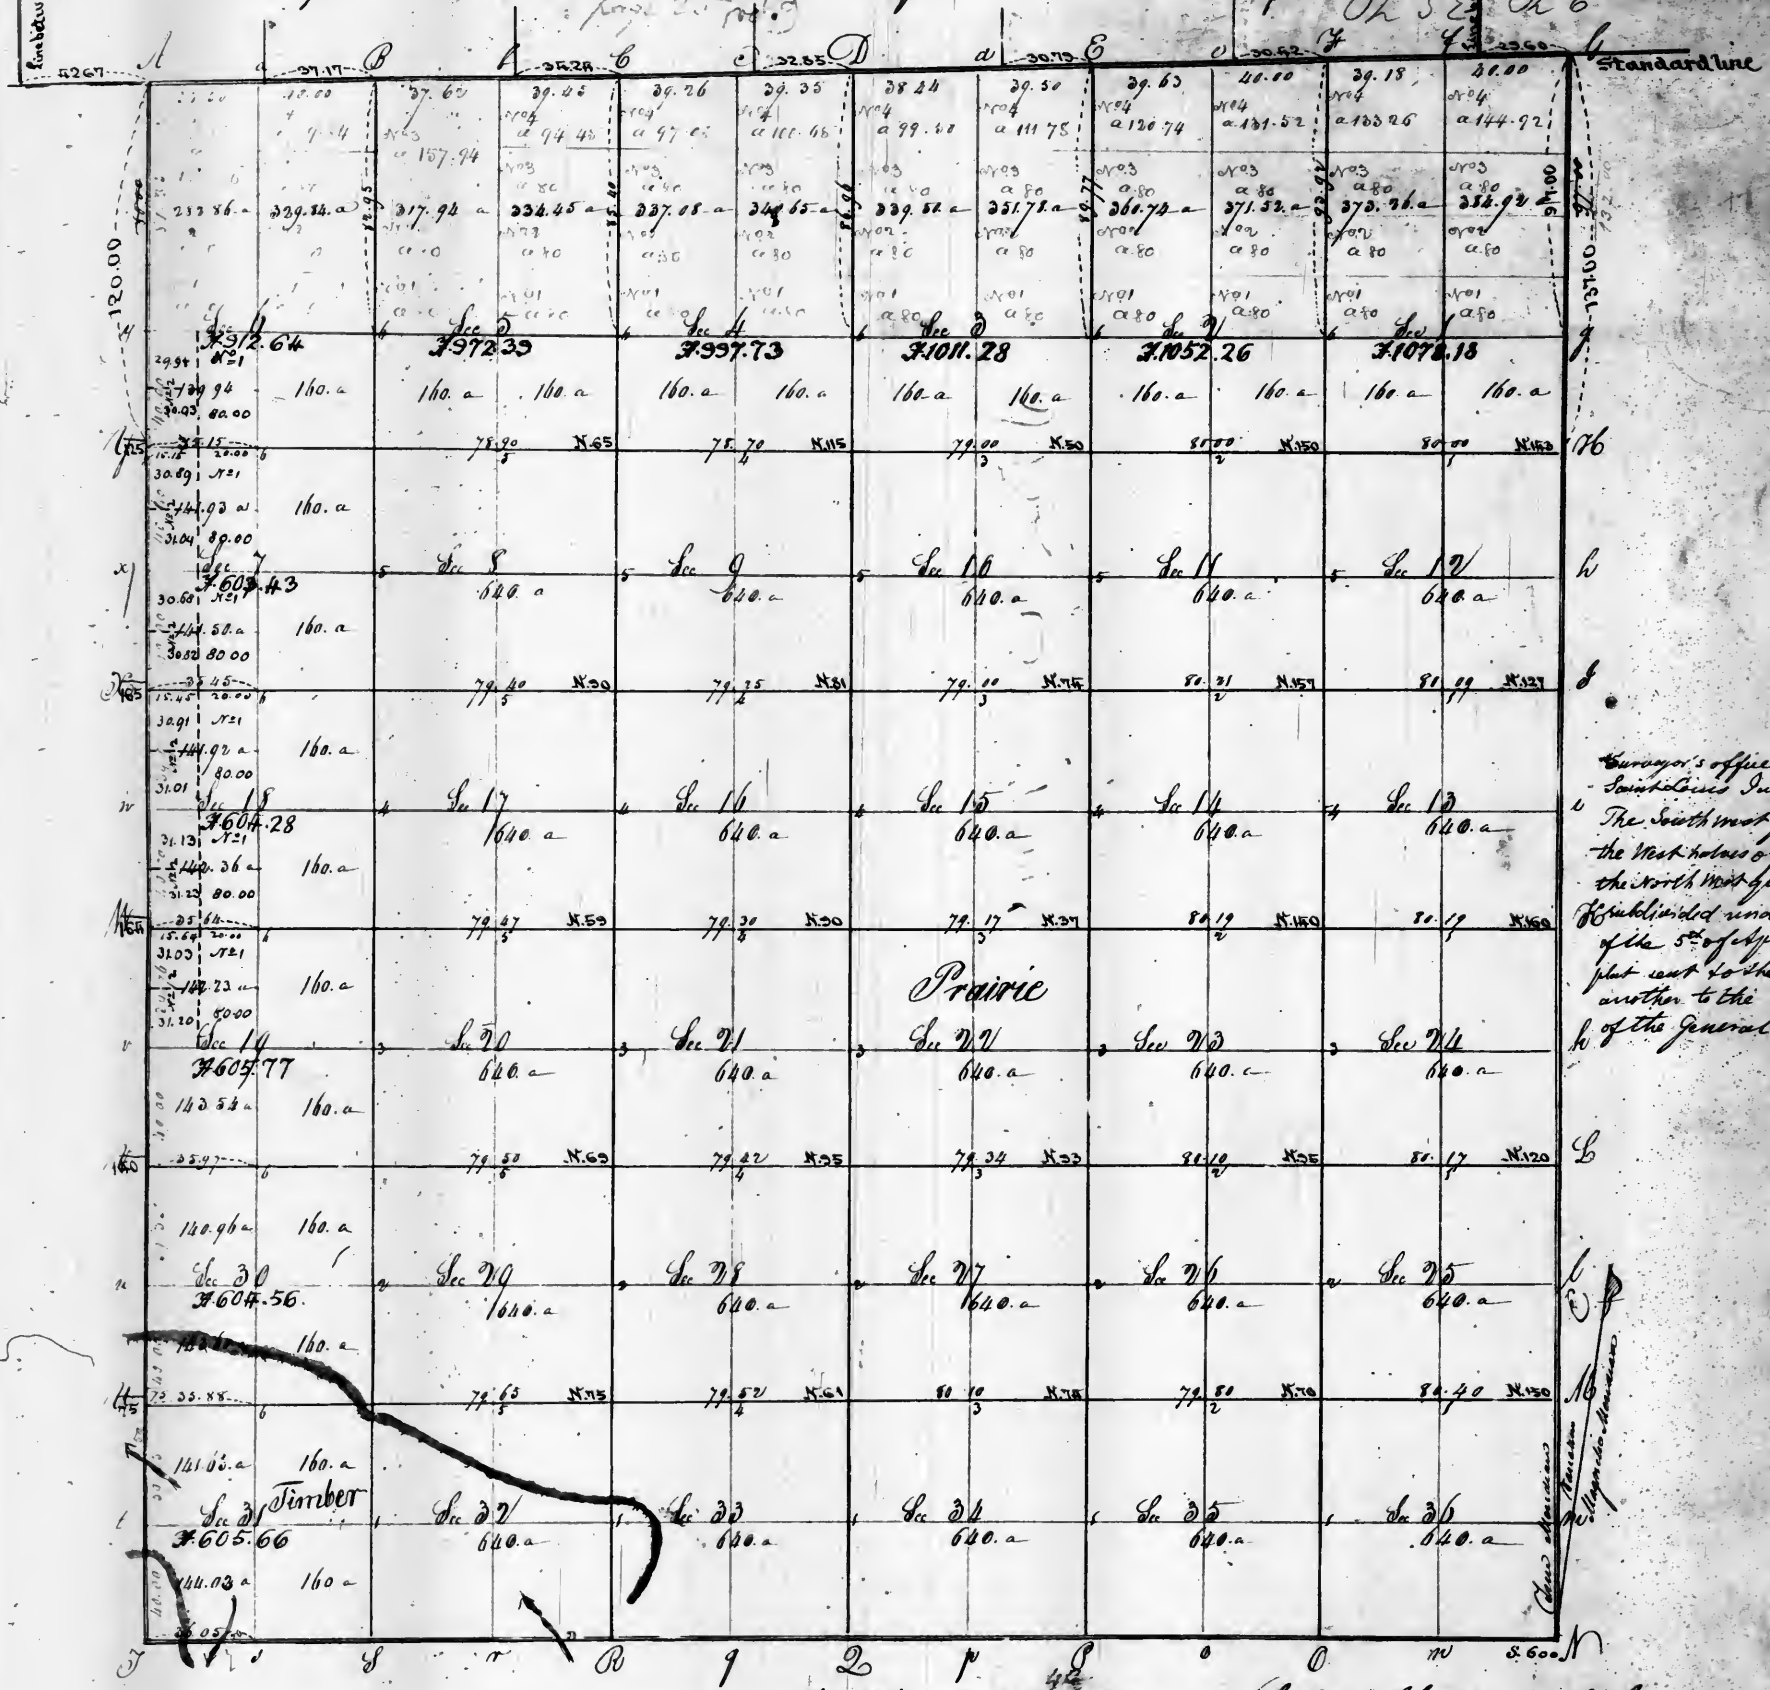

Surveyor's office
St. Louis June 15th 1849.
The South west quarter of section 6,
the West halves of sections 7, 18, and
the North West quarter of section 19
are included under the act of Congress
of the 5th of April 1832, and a
plat sent to the Register and
another to the Commissioner
of the General Land Office.

Pursuant to a contract with, and Instructions from, William Rector Surveyor of the lands of the United States in the State of
Illinois and Missouri and Territory of Arkansas, bearing date the third day of October 1832, I have measured, laid out and
surveyed the above described Township. And do hereby certify, that I had such marks and bands, both natural and artificial
as are represented on said plat, and described in the field notes made thereof, and returned with this plat into the Office
of the Surveyor of the lands of the United States in the State of Illinois and Missouri and Territory of Arkansas.
Certified this Jan 20 1824
E Rector D. Surveyor

Township No. 31 North of the base line, Range No. 5 East of the 3^d principal Meridian.

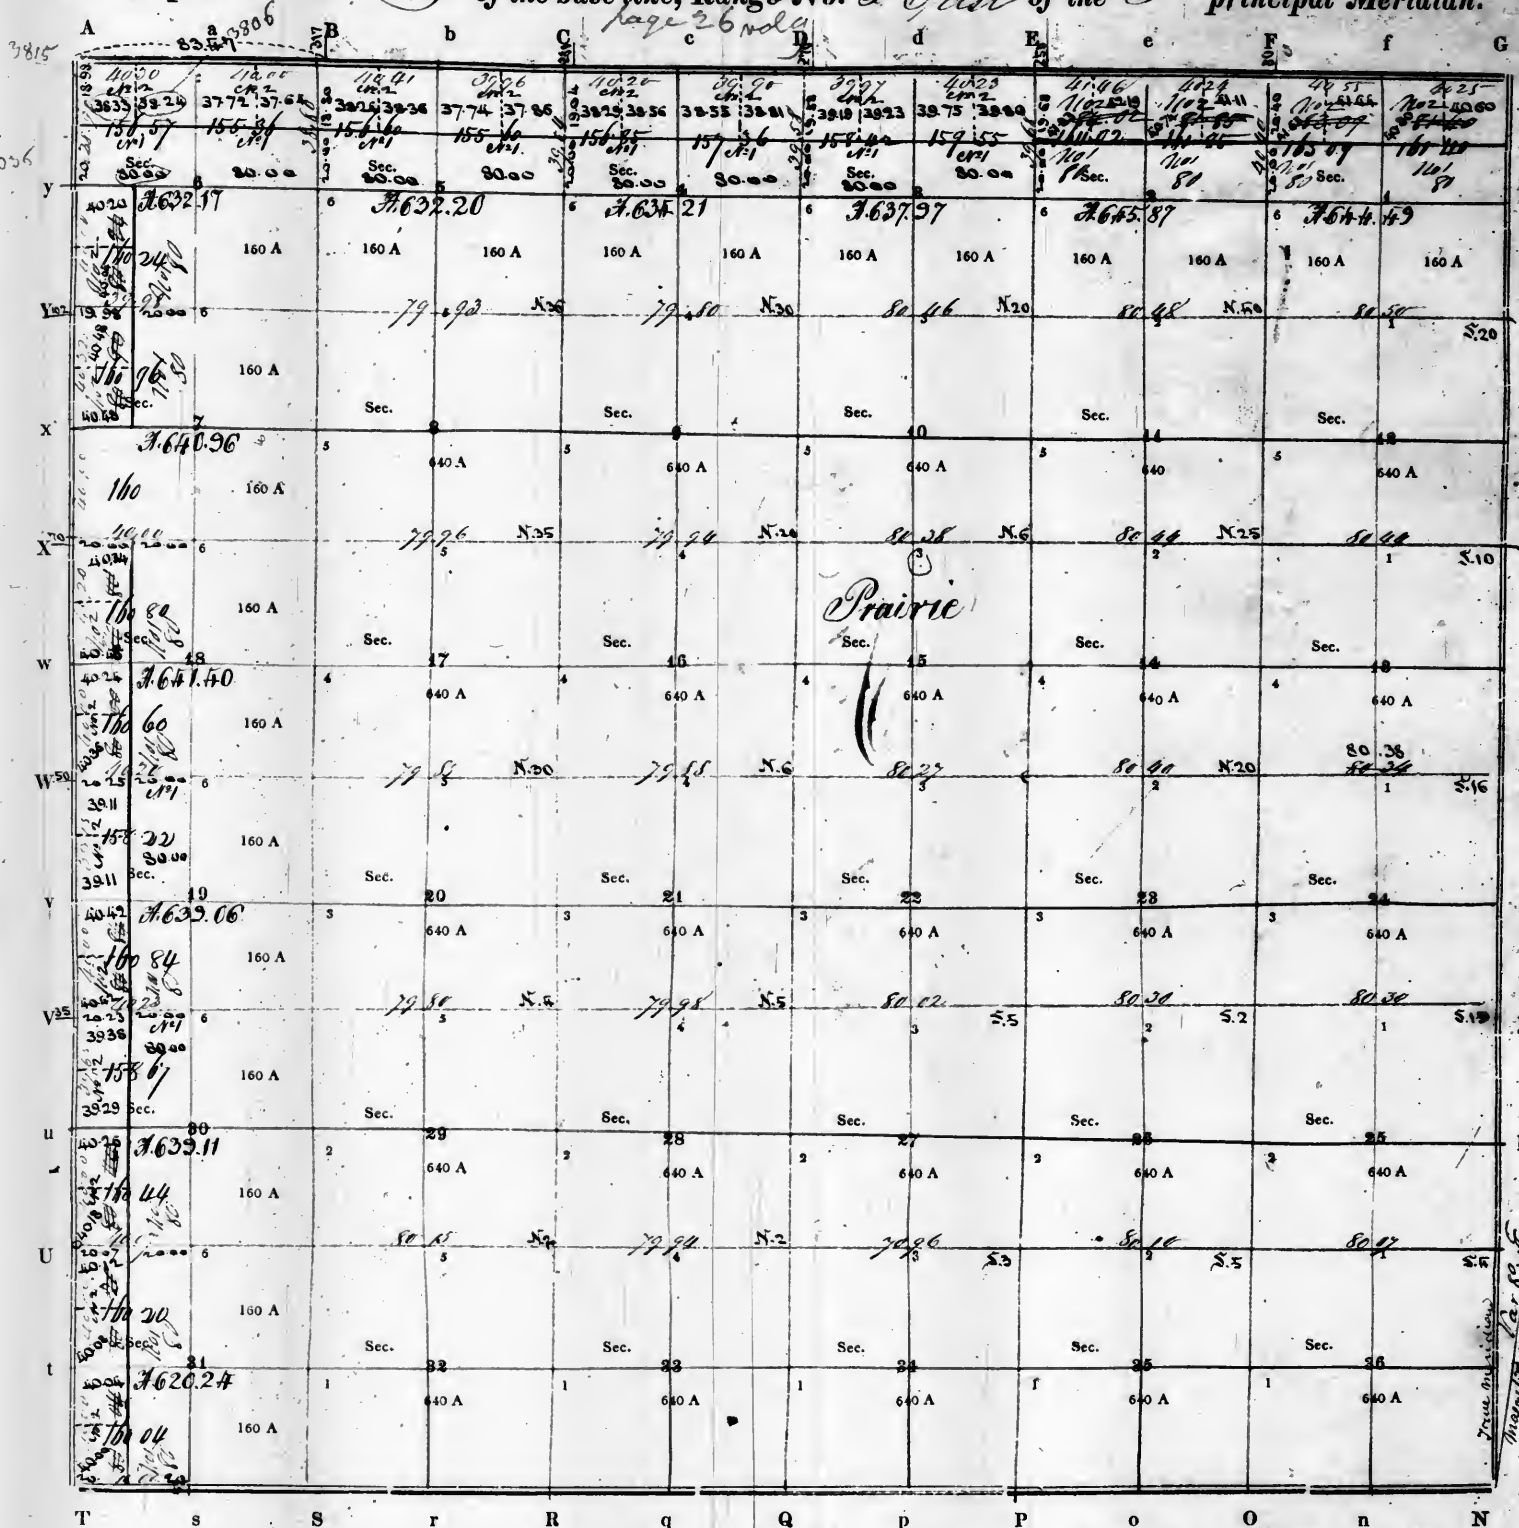

Aggregate area = 23007.68 acres

PURSUANT to a contract with, and instructions from WILLIAM RECTOR, Surveyor of the lands of the United States in the State of Missouri & Territory of Arkansas, bearing date the twentieth day of March 1821

I have admeasured, laid out and surveyed the above described Township; and do hereby certify, that it had such marks and bounds, both natural and artificial, as are represented on said plat, and described in the field notes made thereof, and returned with this plat into the Office of the Surveyor of the lands of the United States, for the State of Illinois & Missouri & Territory of Arkansas.

Certified this day of


EXAMINED.

Surveyed by James Wells
May 1821

D. SURVEYOR.

Surveyor's Office
Land Office, St. Louis, Mo.
Subscribed under the
Act of 1832, by the
Secy. of the Interior
of the U.S. the 1st day of
Aug. 1845


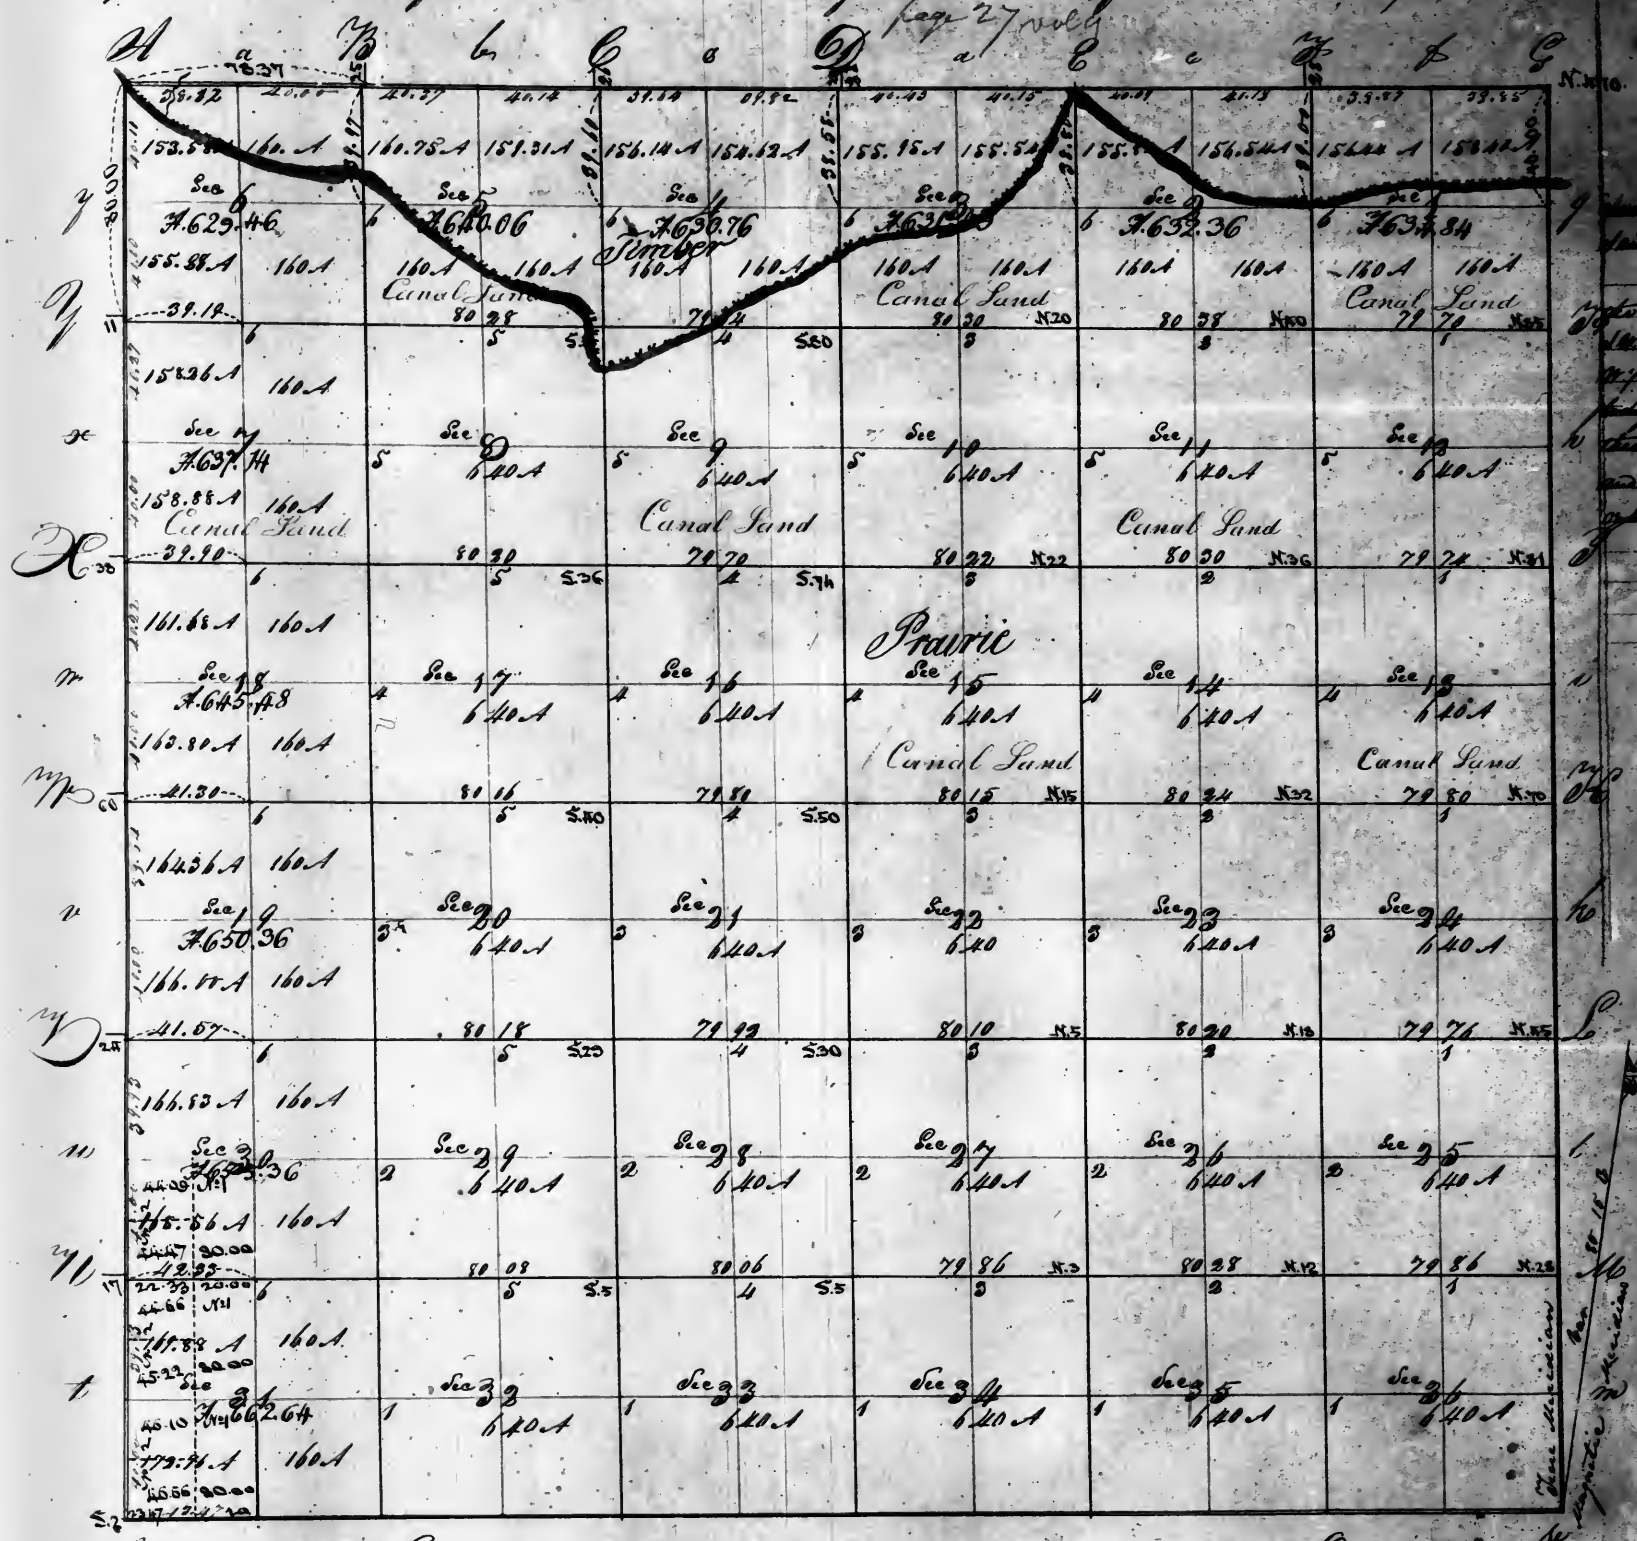


Subscribed and sworn to before me on the 27th day of August 1845

Aggregate area 23050.05 acres

Scale of 40 chains to an inch


Pursuant to a contract with, and instructions from William Hector Surveyor of the lands of the United States in the States of Illinois and Missouri and Territory of Arkansas bearing date the Twentieth day of March One thousand Eight hundred and Twenty and I have admeasured laid out and surveyed the above ascribed Township and do hereby certify that it had such marks and bounds both natural and artificial as are represented on said plat and described in the field notes made thereof and returned with this plat into the Office of the Surveyor of the lands of the United States for the States of Illinois and Missouri and Territory of Arkansas

page 25 vol 9

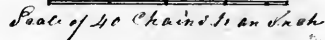

Certified this day of


Township N: 34 North of the base line, Range N: 5 East of the 3rd principal Meridian
page 29 vol 9

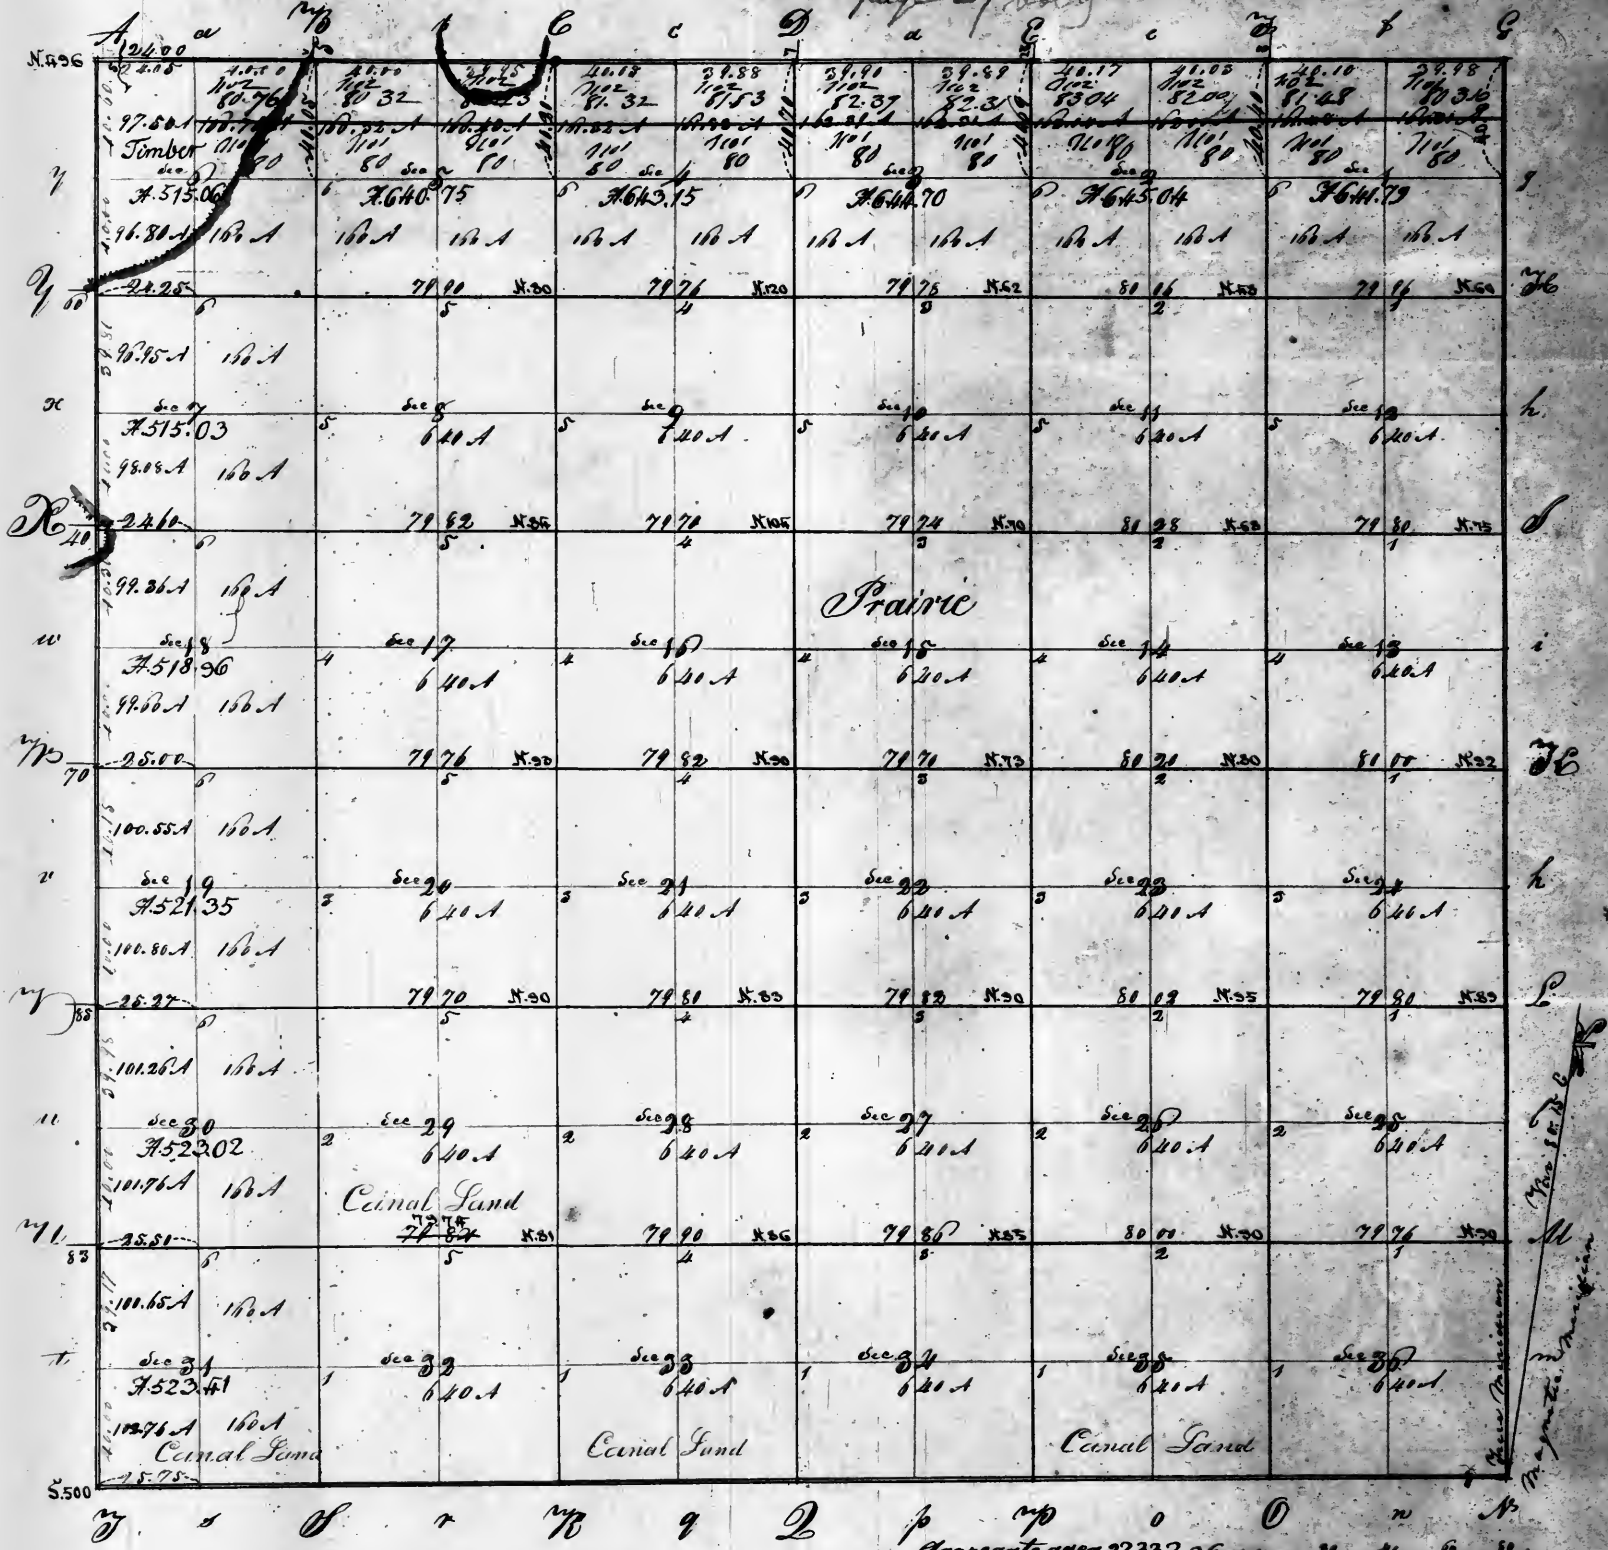

Pursuant to a contract with and instructions from William Rector Surveyor of the lands of the United States in the States of Illinois and Missouri and Territory of Arkansas bearing date the Twentieth day of March Eighteen hundred and Twenty one I have measured laid out and surveyed the above described Township and as hereby certify that it had such marks and bounds both natural and artificial as are represented on said plat and described in the field notes made therey and returned with this plat into the Office of the Surveyor of the lands of the United States for the states of Illinois and Missouri and Territory of Arkansas

D. Surveyor

Topical Township 21st ss. a north of the Base line Range 1st East of 2nd Principal Meridian
page 30

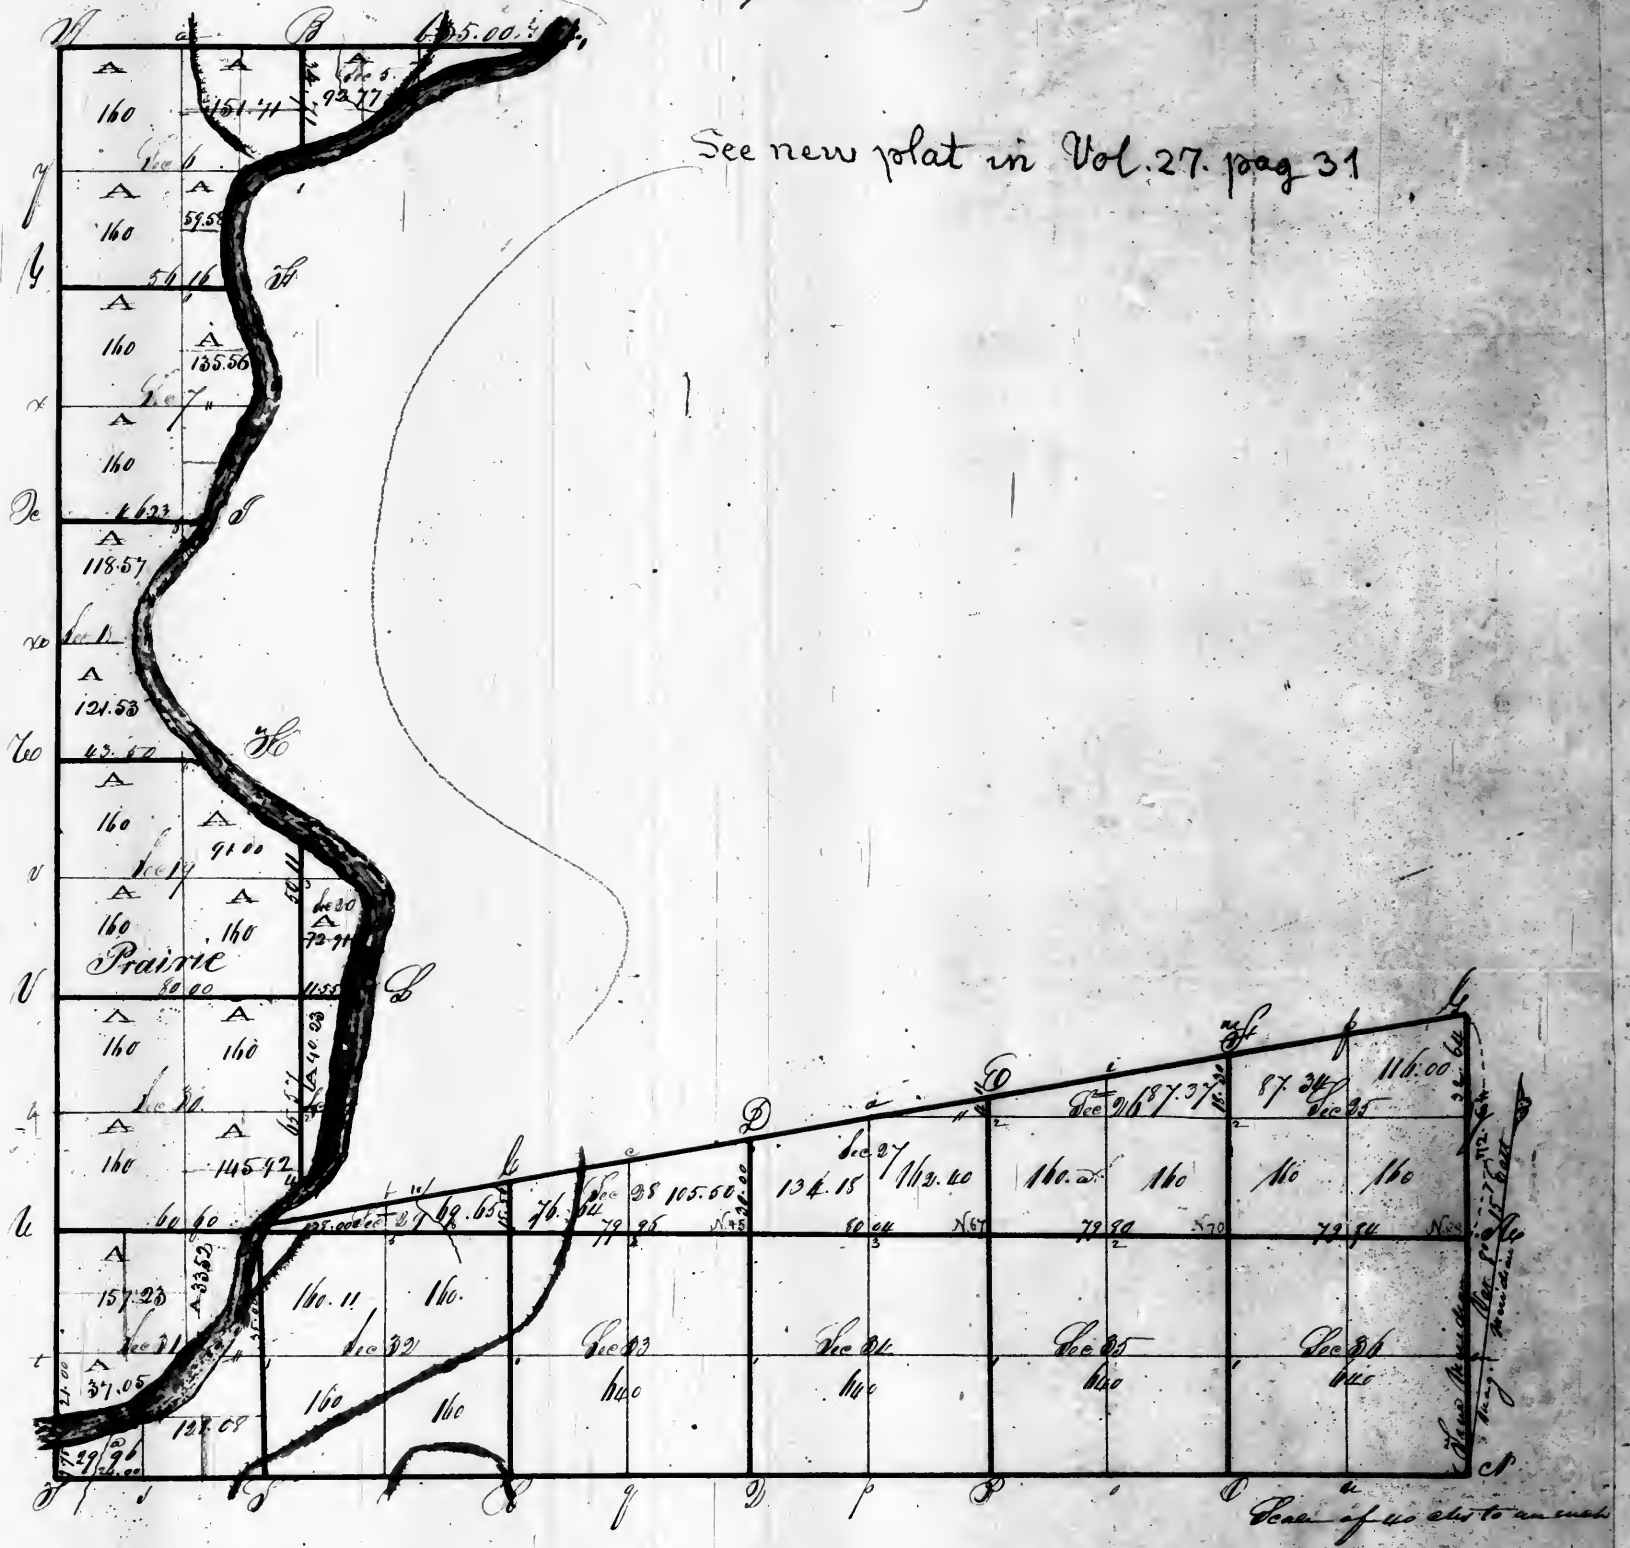

Pursuant to a contract with and instructions from William Rector Surveyor of the Lands of the United States
In the States of Illinois Missouri and Territory of Arkansas bearing date the twentieth day of March 1821
We have admeasured laid out and surveyed the above described Township and do hereby certify that it has
such marks and bounds both natural and artificial as are represented on said Plat and described in the plat
notes made thereof and returned with this plat into the office of the Surveyor of the Lands of the United
States in the States of Illinois Missouri and Territory of Arkansas

Cert. this First Nov 1822

Wm Rector
Stephen Dutton D. Surveyor

Trac. Township at 20. North of the Base line Range 10 East of 3rd Principal Meridian
page 31. Vol 9

Page 36 Vol 9



Scale of 40 Cts to an inch

I have read to a contract with and Instructions from William Foster Harvey of the land of the United States in the States of Illinois and Missouri and Territory of Arkansas bearing date the 20th day of March 1851 and have advised and laid out and surveyed the above described Township and do hereby certify that it has such marks and bounds both natural and artificial as are represented on said plat and described in the field notes made thereof and returned with this plat into the office of the Surveyor of the lands of the United States in the States of Illinois and Missouri and Territory of Arkansas.

Deputy Surveyor

Examined

Surveyor's Office

Examiné


Surgeon's Office
Saint Louis 23^d January 1844.

Collocated ^{and} subdivided, under the Act of Congress of the 5th April 1832, fractional sections 31 & 32 South of the Old Indian boundary line ^{and} West of the line B.C., as represented on this plat ^{and} sent, to-day, copies thereof, one to the Register of the district land office ^{and} another to the Commissioner of the Genl Land Office; All of T. 36 N. R. 5 E of the 3^d pl. M^d except the above designated ^{part} sections, has been surveyed in the E^d quarter of 1835 by Eli S. Prescott, under a Contract signed by the Surveyor General on the 8th of May, 1837 ^{and} by the said Prescott on the 3^d of June of the same year.

Silas Reed
Surveyor of the public lands in

Recorded

Township N. 1 North of base line Range N. 6 East of the 3^d Principal Meridian 464
page 32 m. of

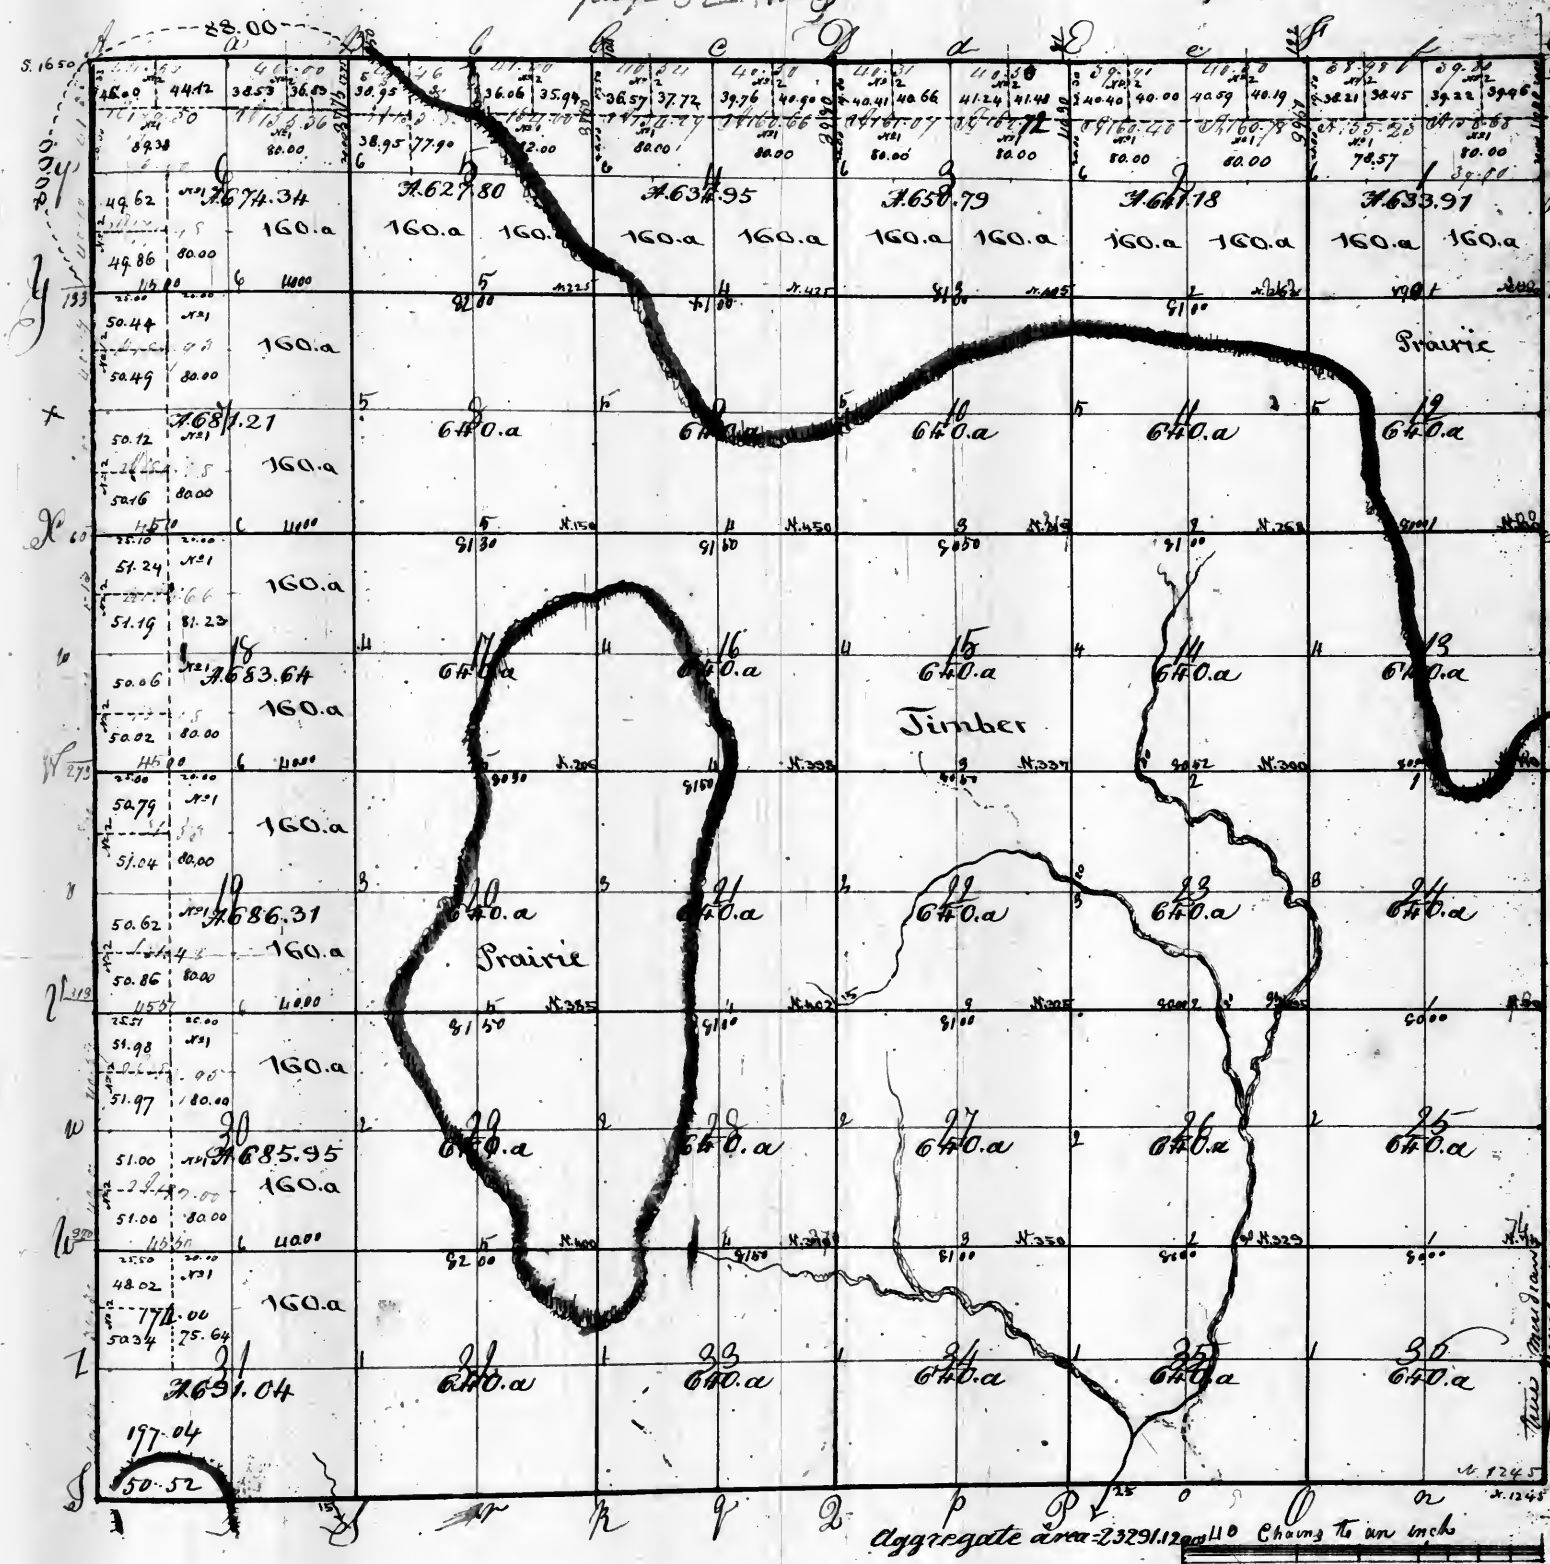

Office of the Surveyor General
for the State of Missouri
Saint Louis, Mo. July 19-1850
The North half of sections 1, 2,
3, 4, 5, 6, the North East quarter
of section 5, the South West quarter
of section 6, the West
half of section 7, 10, 19 & 20,
and the North West quarter of
section 31, situated under the
act of Congress of the 5th of
April 1850, and the North
West quarter of section 5, sub-
ject to a claim of a
person named (must be S.),
and a plat cut to the Register
and another to the Comptroller
of the General Land Office.
Same day


Wm. Boardley
Surveyor General
for Missouri
N. 12 45

Pursuant to a Contract with and instruction from William H. Rector, Surveyor of the Lands of the United States
in the Territory of Illinois and Missouri, bearing date the day of I have measured, laid out and surveyed
the above described township and to hereby certify, that it had such marks and bounds both natural and artificial, as are
represented on said plat, and described in the field notes made thereof, and returned with this plat into the office
of the Surveyor of the Lands of the United States, for the State of Illinois and Territory of Missouri.
Certified June 15th 1819.
Wm. Boardley D.S.

Recorded

Township No 2 North of the base line Range No 6 East of the 3rd Principal Meridian

#65

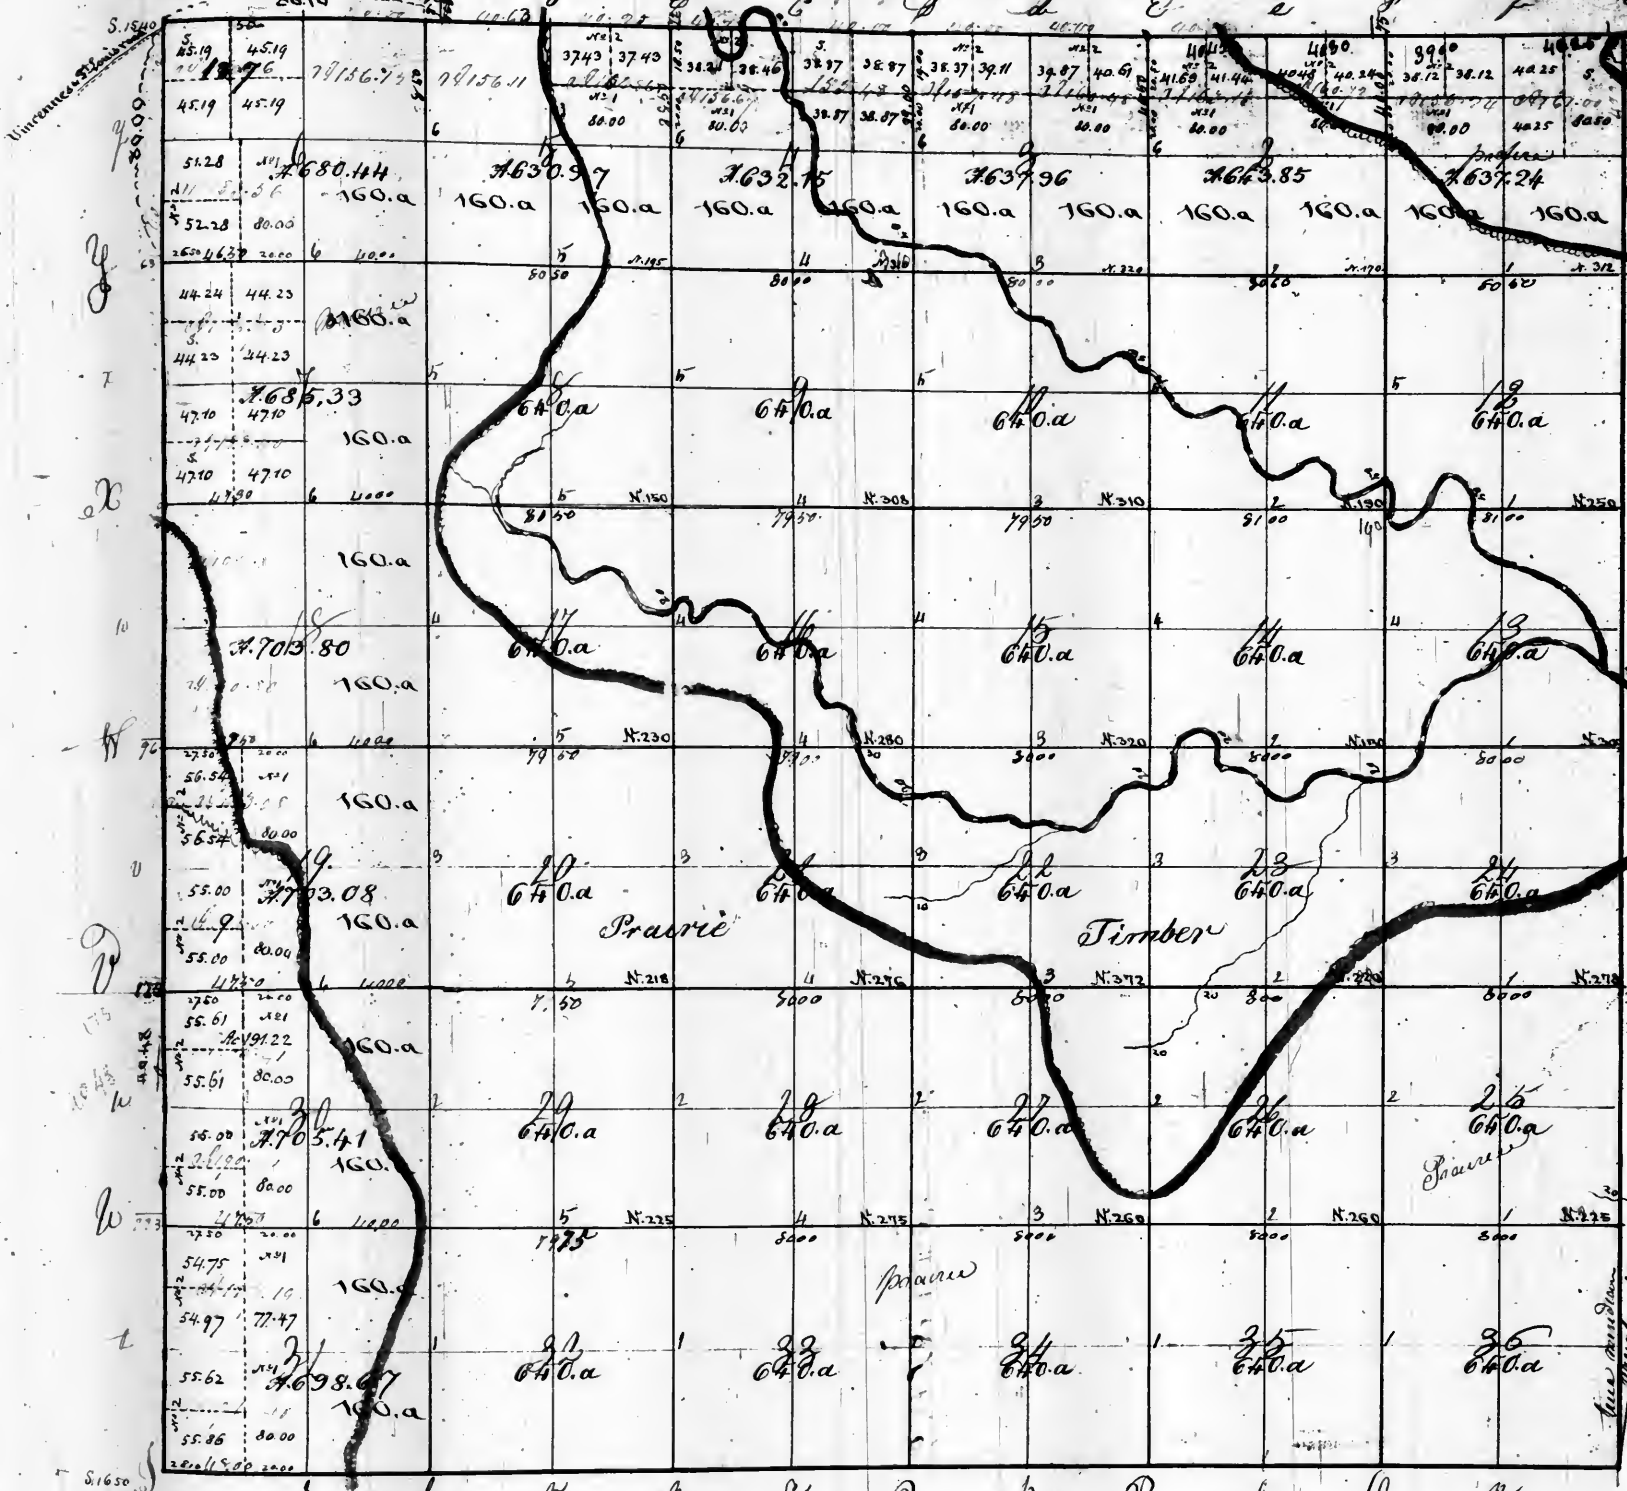

Office of the Surveyor General
for the State of Illinois
St. Louis, July 19th 1850
The North East quarter of section
17, 18, the North halves of sections
24, 25, the North East quarter of
section 5, the South East quarter
of section 6, and the East halves
of sections 19, 30, 31, subdivided
under the act of Congress of the
5th of April 1850, and also the
West half of section 14, the North West quarter
of section 6, and the East half
of section 7, subdivided as to
acres to previous sale,
marked &c, and added to
the Register and added to
the Commission of the
General Land Office
same day





Pursuant to a contract with and instruction from William Packer, Surveyor of the lands of the United States in the
Territories of Illinois and Missouri, bearing date the 21st day of October 1848, have a measured, laid out and surveyed the
above described Township and do hereby certify that it had such marks and found both natural and artificial, as are represented
on said plat, and described in the field notes made thereof, and returned with this plat into the Office of the Surveyor of the
lands of the United States for the State of Illinois and Territory of Missouri

certified June 15th 1849 H. H. Bradley D.S.

Township No 3 North of the Base line Range No 6 East of the 3rd Principal Meridian
page 34 vol 9

466

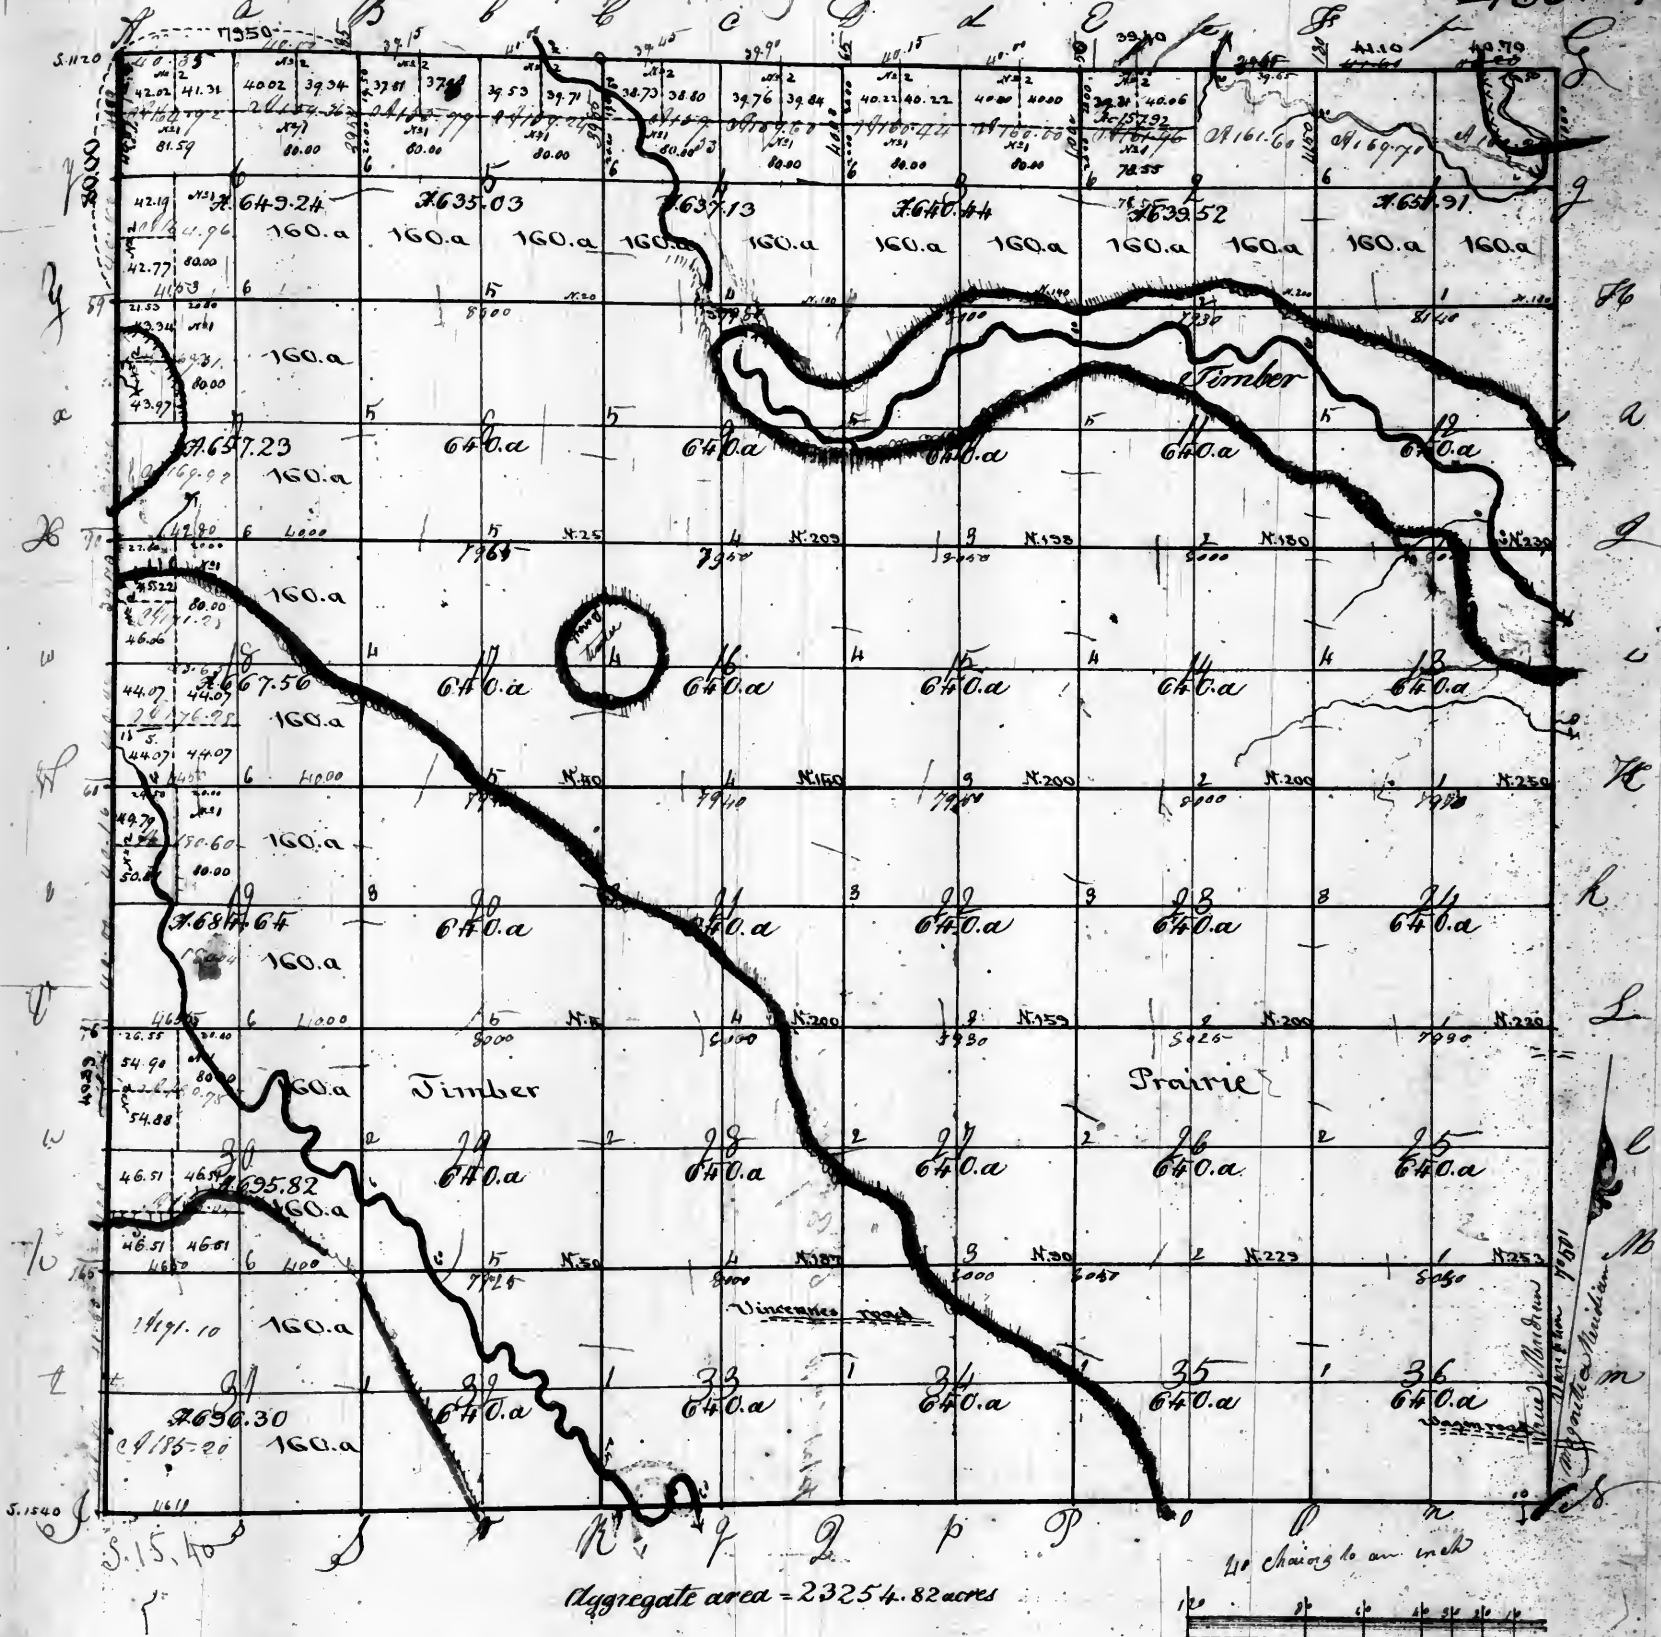

Pursuant to a contract with, and instructions from William Reeder, Surveyor of the Lands of the United States in the Territory of Illinois and Wisconsin, bearing date the 27th day of October 1878, have had measured, laid out and surveyed the above described Township and do hereby Certify, that it had such marks and bounds both natural and artificial as are represented on said plat, and described in the field notes made therefor, and returned with this plat to the office of the Surveyor of the Lands of the United States for the State of Illinois and Territory of Wisconsin.

Certified June 15th 1879
J. W. Bradley

Office of the Surveyor General
for the State of Illinois and Wisconsin
Saint Louis July 19th 1850
The North West quarter of sections 2, 7, 18, 19, & 30,
the North half of sections 3, 4, 5 & 6, and the South
West quarter of section 6, subdivided under the act of
Congress of April 5th 1820, also the South West
quarter of section 18 & 30, subdivided so as to conform
to previous sales, marked &c. and a plat sent to the Dept.
and another to the Commissioner of the General Land Office
same day.


Records

of

Township N. 4. South of the Baseline Range N. 6 East of the 3rd principal Meridian

page 35 and 9

467.

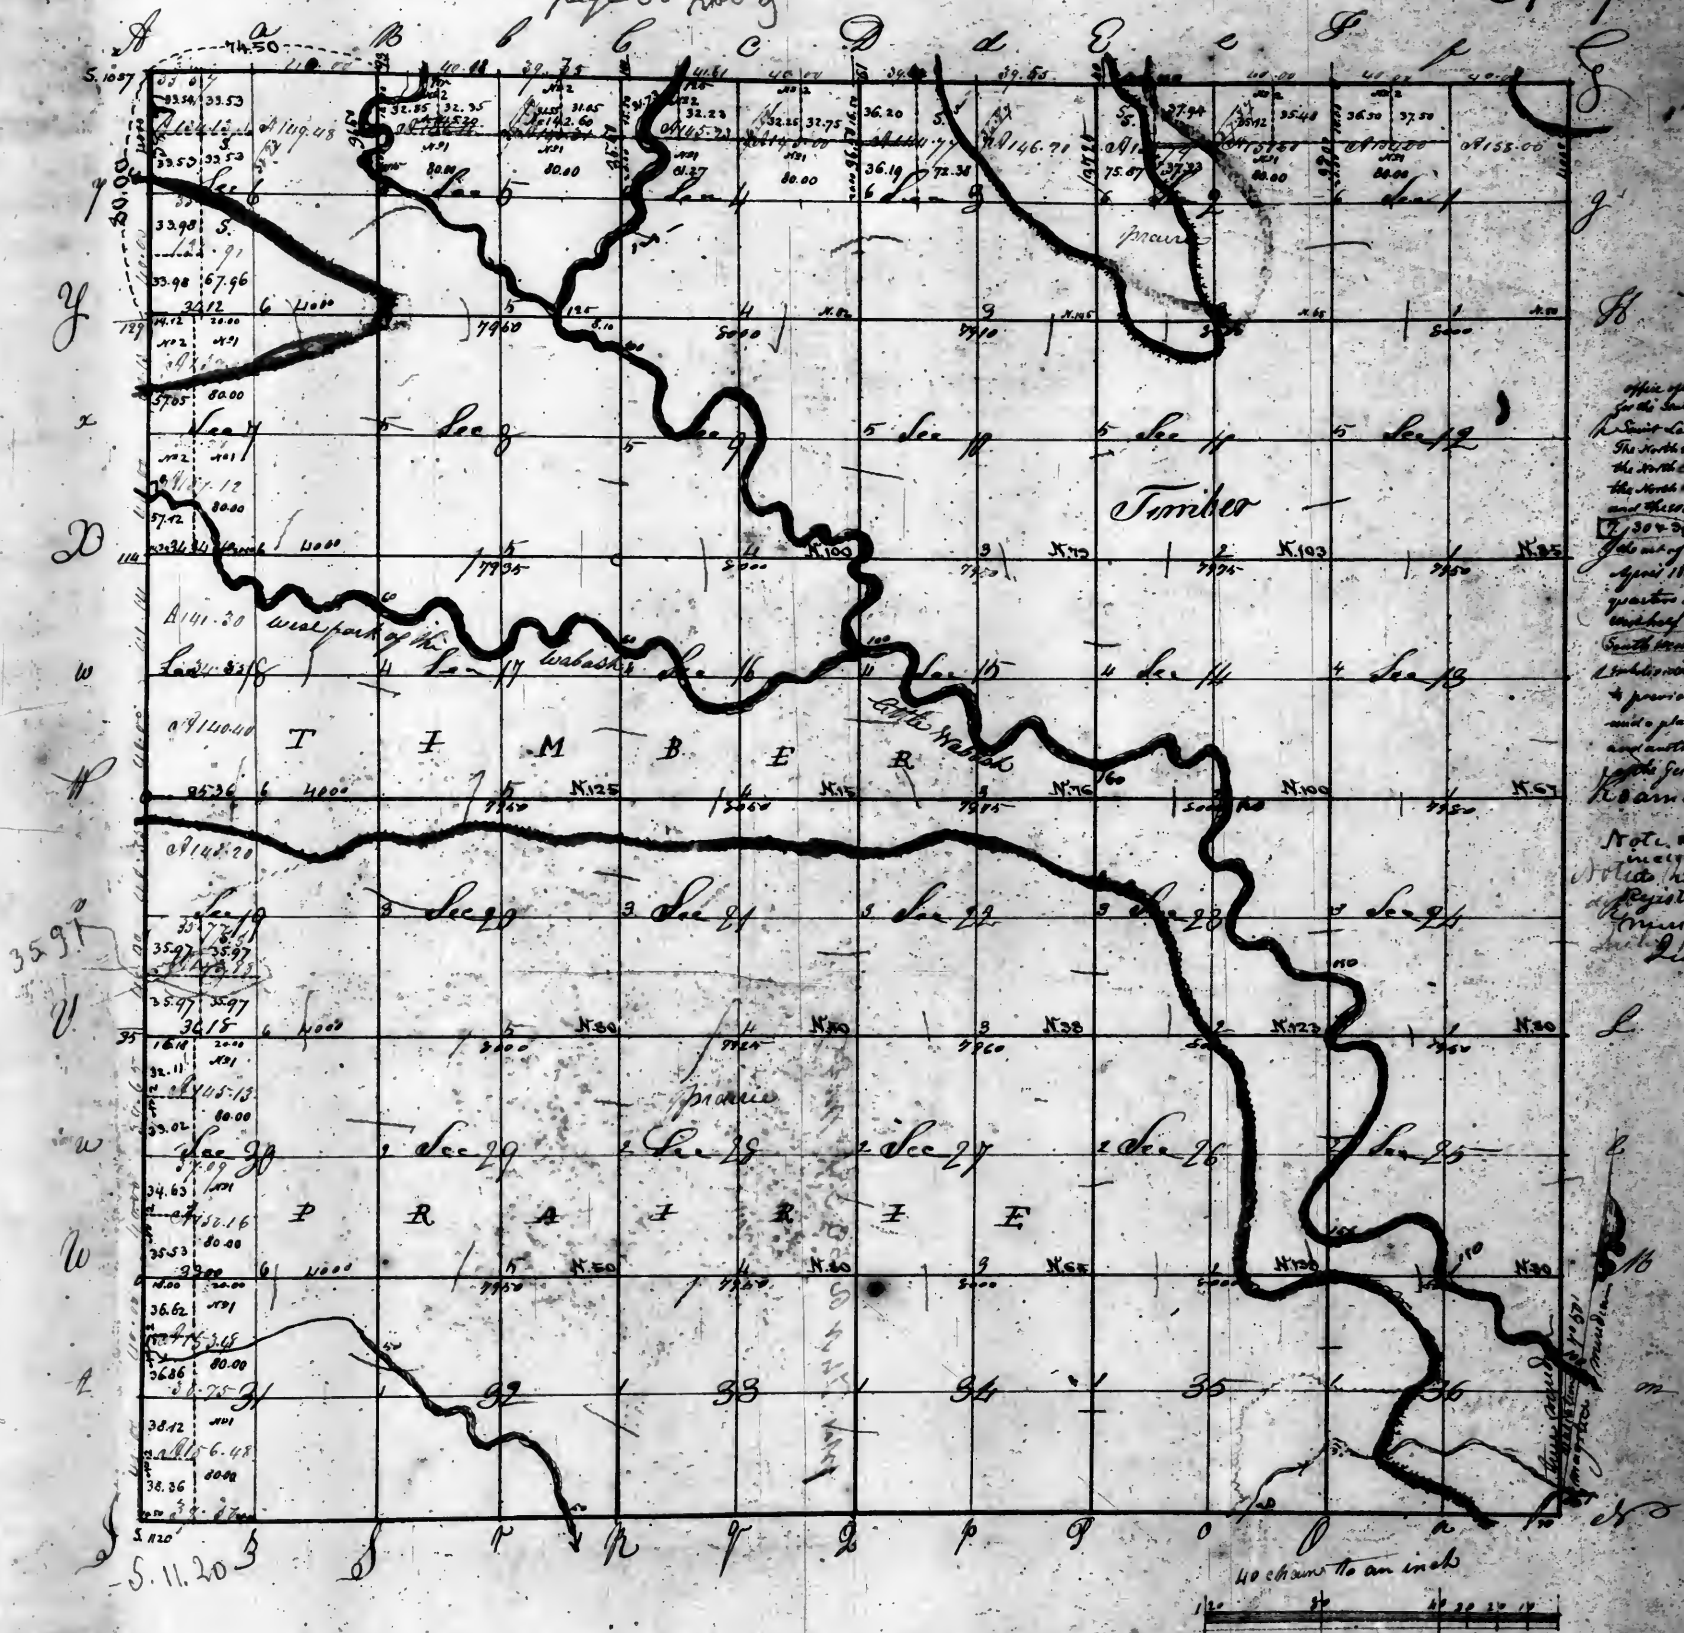

Office of the Surveyor General
for the State of Illinois
St. Louis, Mo. July 14th 1850
R. M. Cady.

Note. The sections
mentioned are brought
into line with the
Register and the General
Land Office. The 11th
July 1850

Pursuant to a Contract with and instructions from William Victor, Surveyor of the lands of the United States in the
Territories of Illinois and Missouri, bearing date the 24th day of October 1849, have a measured, laid out and surveyed
the above described Township and do hereby certify, that it has such marks and bounds both natural and artificial as are
represented on said plat, and described in the field notes made thereof, and returned with this plat to the office
of the Surveyor of the lands of the United States, for the State of Illinois and Territory of Missouri.


Certified June 15th 1849 Wm. Victor by J. J.

Pursuant to a Contract with, and instruction from William H. Miller, Surveyor of the Lands of the United States in the Territories
 of Illinois and Missouri, bearing date the 27th day of October, ¹⁸¹⁹ have admeasured, laid out and surveyed the above described
 Township and do hereby certify that it had such marks and bounds to the natural and artificial, as are represented
 on said plat, and described in the field notes made thereof, and returned with this plat into the office of the
 Surveyor of the Lands of the United States for the State of Illinois and Territory of Missouri.

Certified June 15th/819 Attest hereby D S

Swonship 407 North of the base line Range 406 East of the 3rd principal meridian


A a B b C Page 38 of 9 a e f g

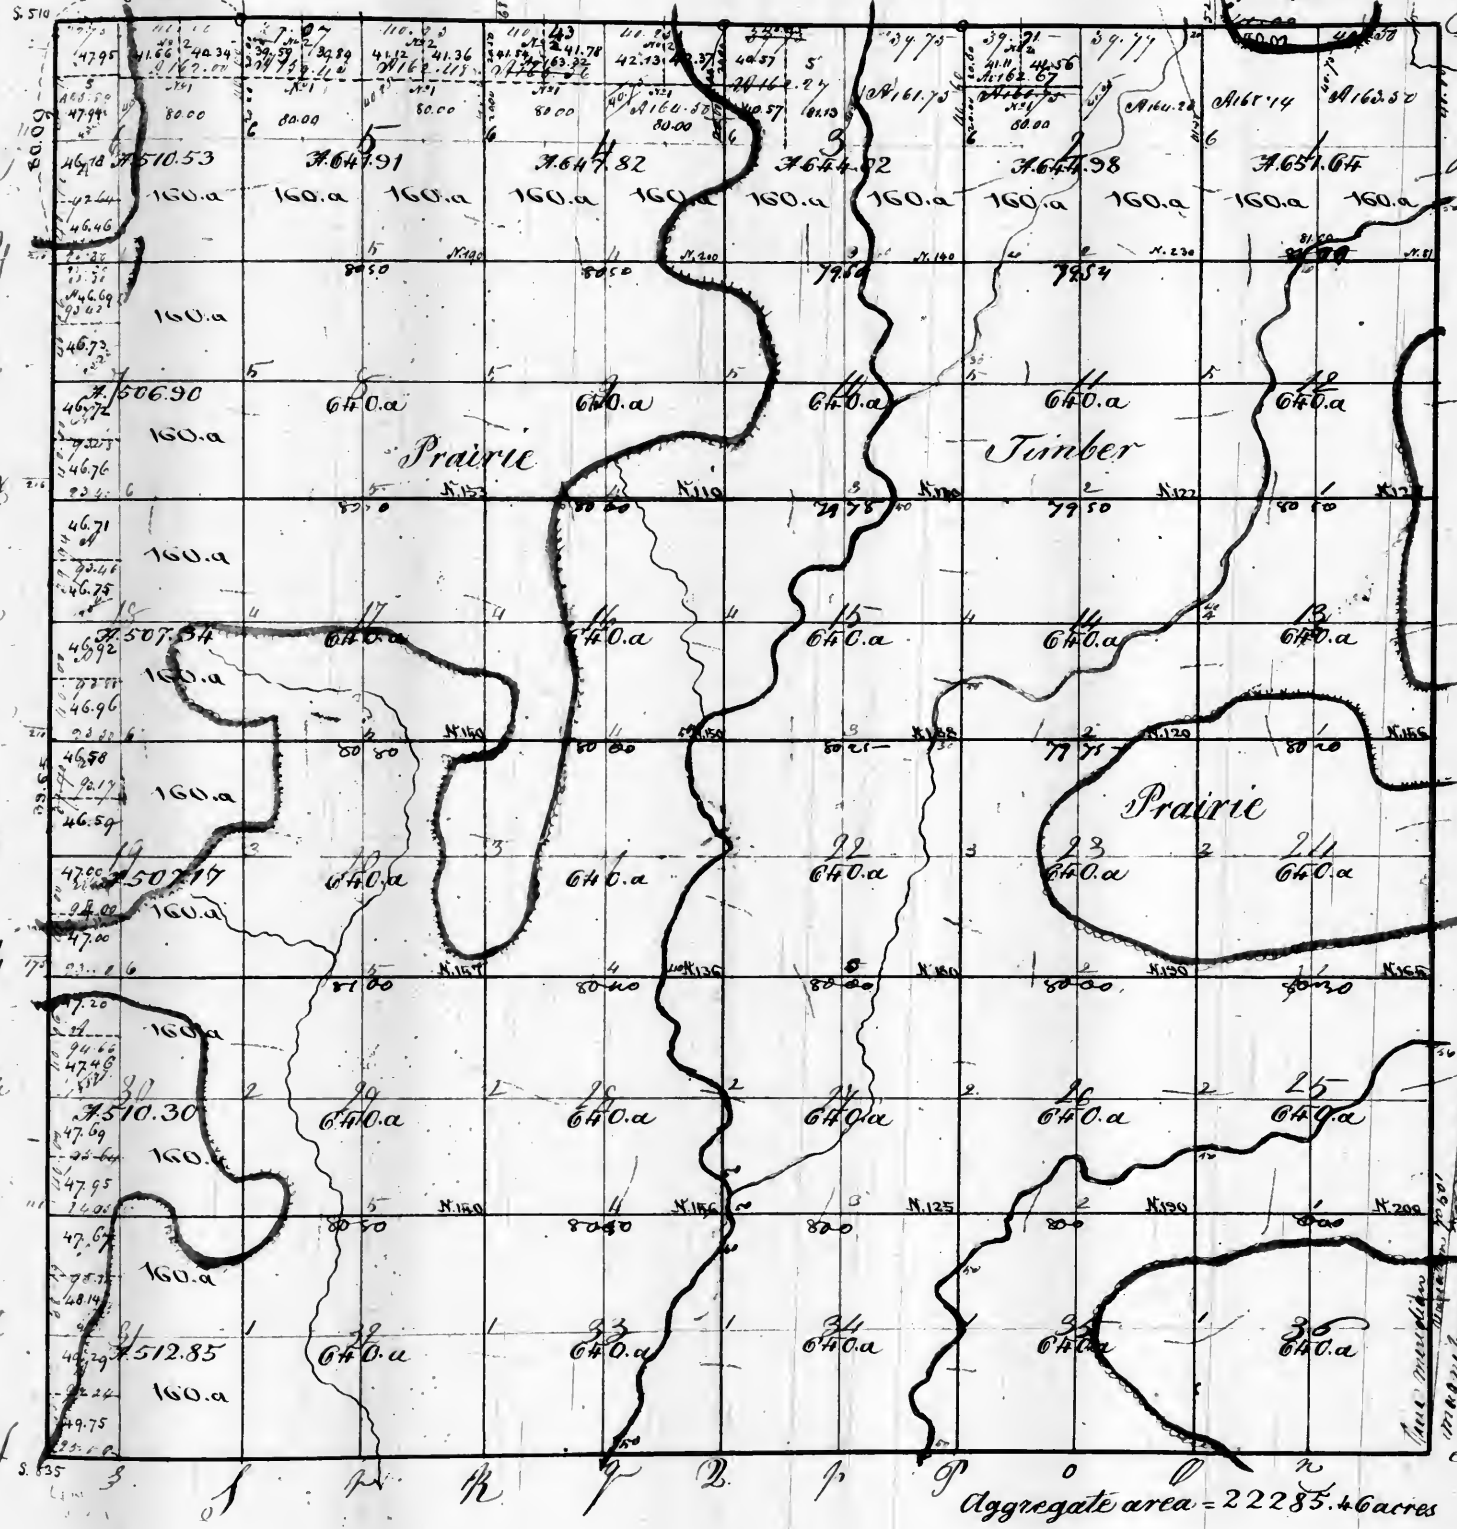

Office of the Surveyor General
for the State of Illinois & Missouri
Saint Louis July 19th 1850
The North west quarter of Section 2, the
North halves of sections 4 & 6, the North East
and South west quarter of section 6, and the
West halves of sections 7, 18, 19, 30 & 31, sub-
divided under the act of Congress of the
5th of April 1832, and the North west
quarter of sections 3 & 6 subdivided to
conform to previous sales & markings,
and a plat sent to the Register and another
to the Commissioner of the General Land Office
same day

Pursuant to a Contract with, and instruction from William H. Rector, Surveyor of the Lands of the United States in the
Territories of Illinois and Indiana, bearing date the 28th day of October 1848, have administered, laid out and surveyed the above
described Township and do hereby certify, that it had such marks and bounds both natural and artificial, as an representative on said
plat, and described in the field notes made thereof, and returned with this plat into the office of the Surveyor of the Lands of the
United States for the State of Illinois and Territory of Indiana
Certified and 15th 1849 Wm. H. Rector S. G.


127

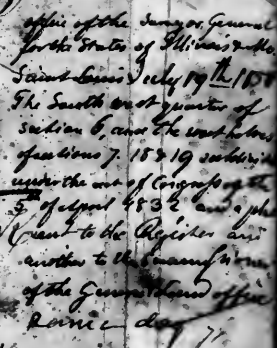

Received to a contract with and instructions from William Hodge Surveyor of the lands of the United States for the State of Illinois and Territory of Missouri and Arkansas running lot the _____ day of _____ I have had measured and laid out and surveyed the above described fractional tract and do hereby certify that it had been marked and bounded both natural and artificial as are represented on said plat and described in the field notes made thereof and returned with this plat into the office of the Surveyor of the lands of the United States for the State of Illinois and Territory of Missouri and Arkansas

Recorded
472

Township No. 9 North of the base line, Range No. 6 East of the 3rd principal Meridian.

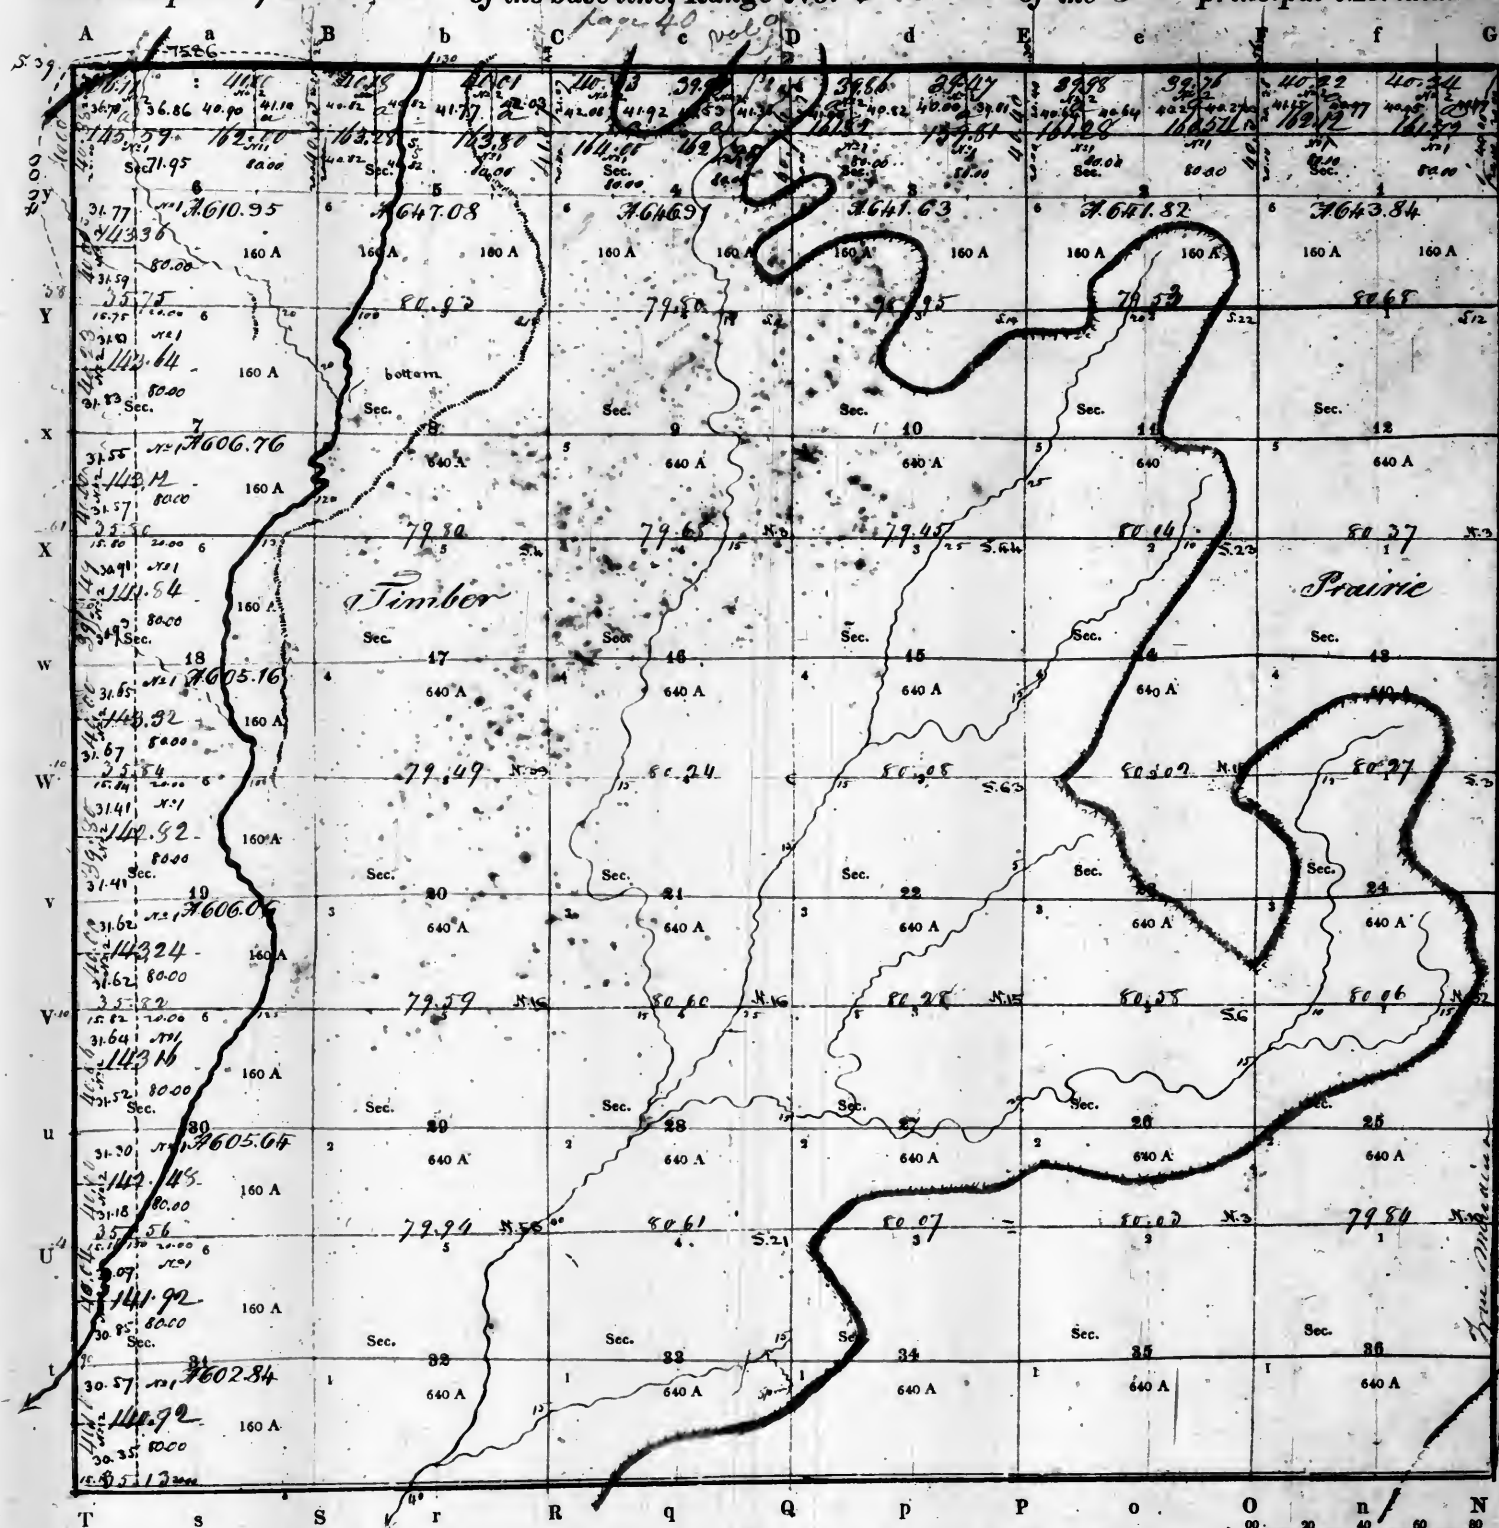

Office of the Surveyor General
for the State of Illinois

True meridians
M. Mer 757' East
M. Mer 757' East

Aggregate area - 22858.69 acres

PURSUANT to a contract with, and instructions from WILLIAM RECTOR, Surveyor of the lands of the United States in the State of Illinois
and Territory of Missouri & Arkansas bearing date the 18th day of May 1870


I have admeasured, laid out and surveyed the above described Township; and do hereby certify, that it had such marks and bounds, both natural and artificial, as are represented on said plat, and described in the field notes made thereof, and returned with this plat into the Office of the Surveyor of the lands of the United States, for the State of Illinois & Territory of Missouri & Arkansas

Certified this 10th day of October 1870

EXAMINED.

James Cannon S. SURVEYOR
for
Stephen Rector & S
September 1870

~~472~~ 51
Meridian. 473.

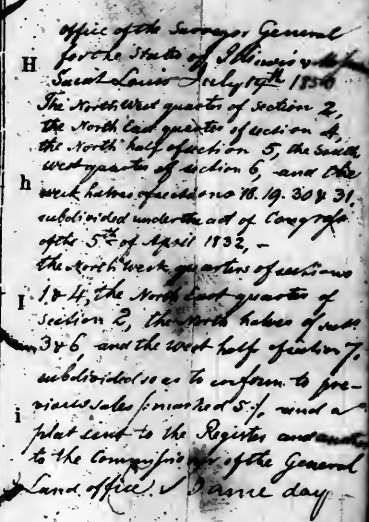

Scale of 40 Chains to an Inch.







Recorded

Township No. 11 North of the base line, Range No. 1 East of the 6th principal Meridian. 474

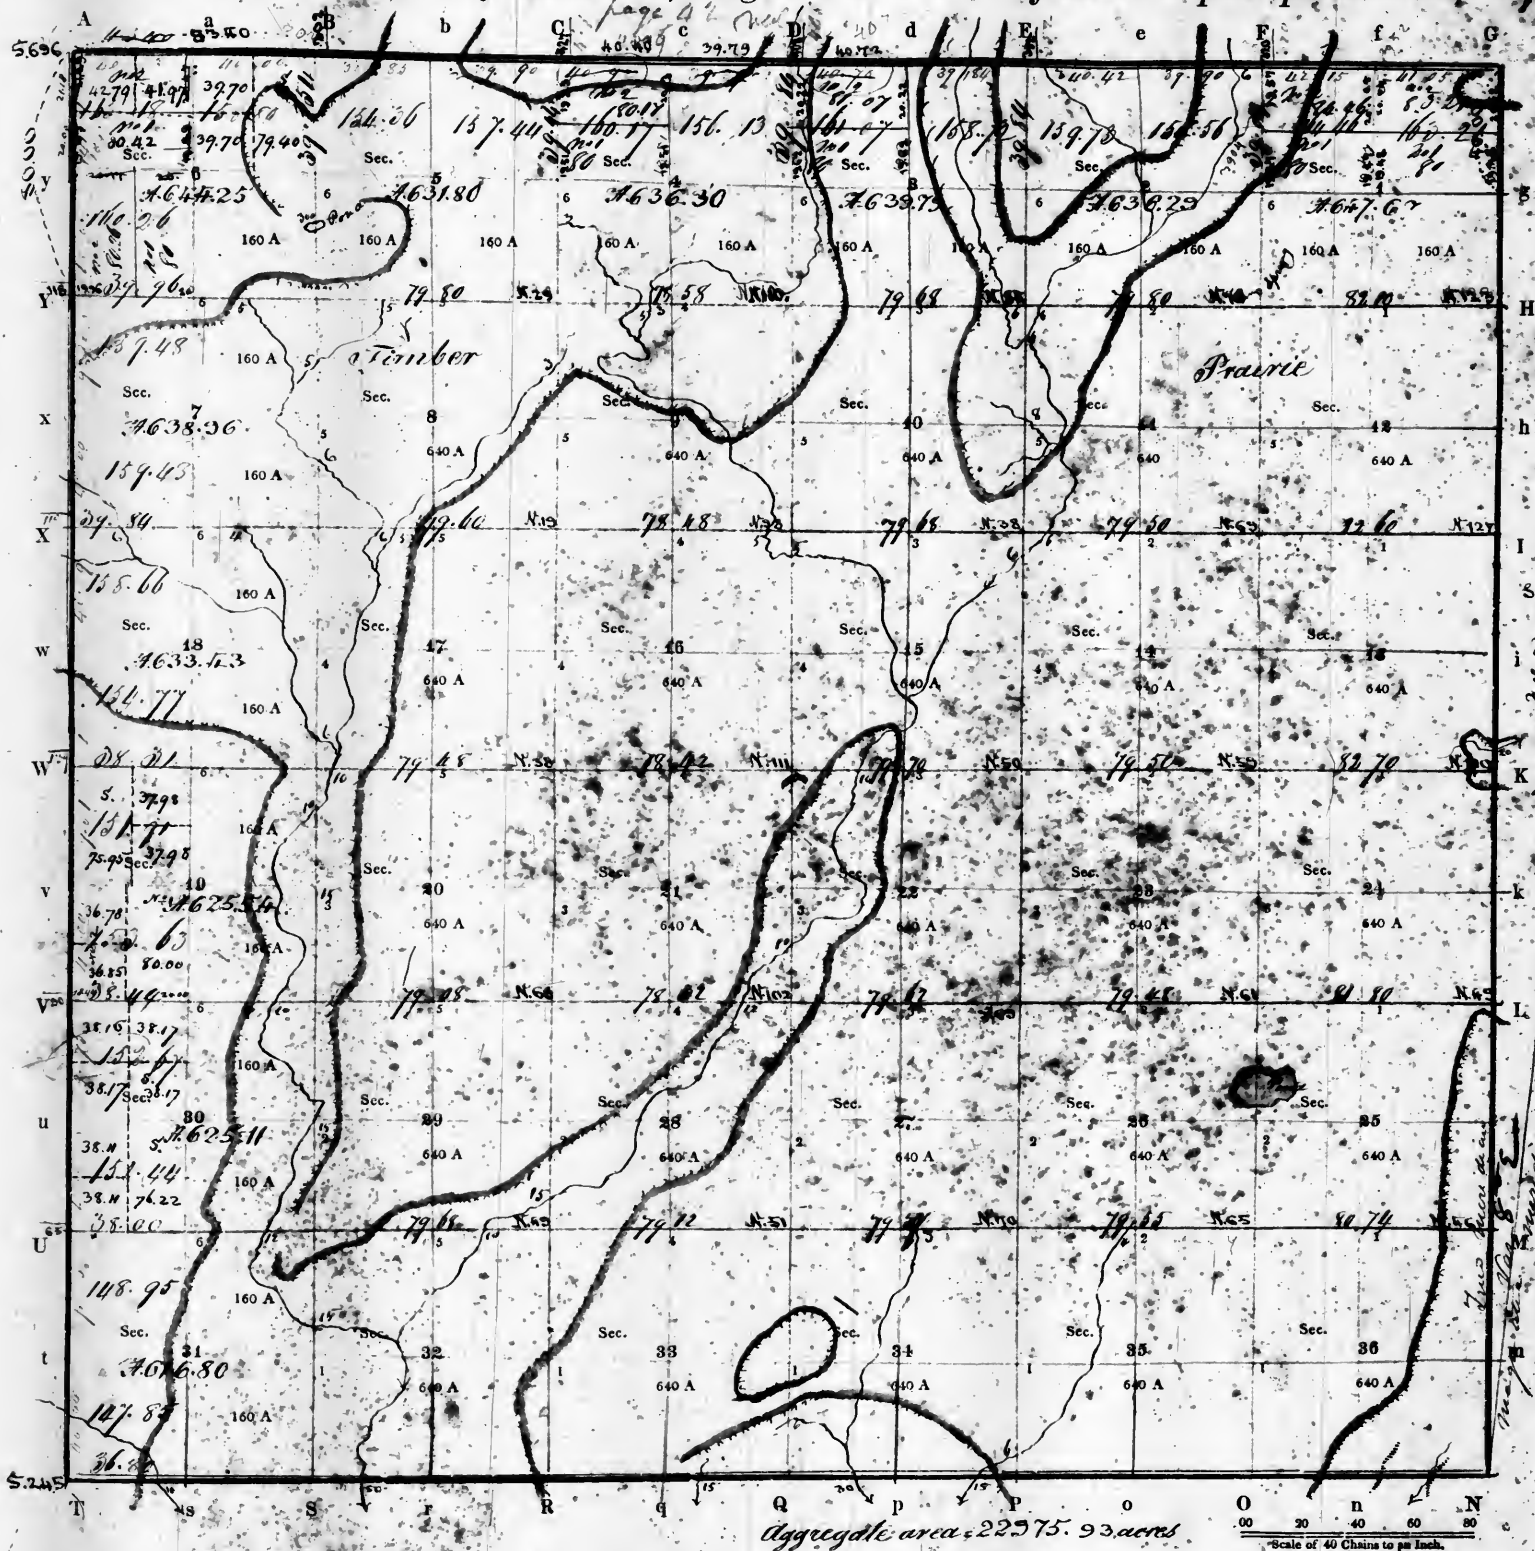


Surveyor's Office
St. Louis 10th April 1821
Plat of the North half of Sec. 1, of the
S.W. 1/4 of Sections 15 & 16, and of the
West half of Sec. 6 sent this day to
the Comptroller of the Genl. L.O.
Office of the Surveyor General
for the State of Missouri and Arkansas
Saint Louis July 11th 1821
The North west quarter of section 6, and
the South west quarter of section
19, subdivided under the act of the
5th of April 1820, and
the North east quarter of section
6, the North west quarter of
section 19, and the West half
of section 20, subdivided under
an act of Congress passed
5th April 1820, and a plat sent to the Register
and another to the Comptroller
of the General Land Office
St. Louis
Wm Rector
N 55 E 6 1/2
N 55 S 1/2 30 1/2 1/2
10 July

PURSUANT to a contract with, and instructions from WILLIAM RECTOR, Surveyor of the lands of the United States in the States of Missouri and Illinois and Territory of Arkansas bearing date the 3rd day of March 1821
I have admeasured, laid out and surveyed the above described Township; and do hereby certify, that it had such marks and bounds, both natural and artificial, as are represented on said plat, and described in the field notes made thereof, and returned with this plat into the Office of the Surveyor of the lands of the United States, for the States of Missouri and Illinois and Territory of Arkansas
Certified this 10th day of July 1821

Wm Rector
D. SURVEYOR.

Recorded

Township No. 12 North of the base line, Range No. 6 East of the 2nd principal Meridian.

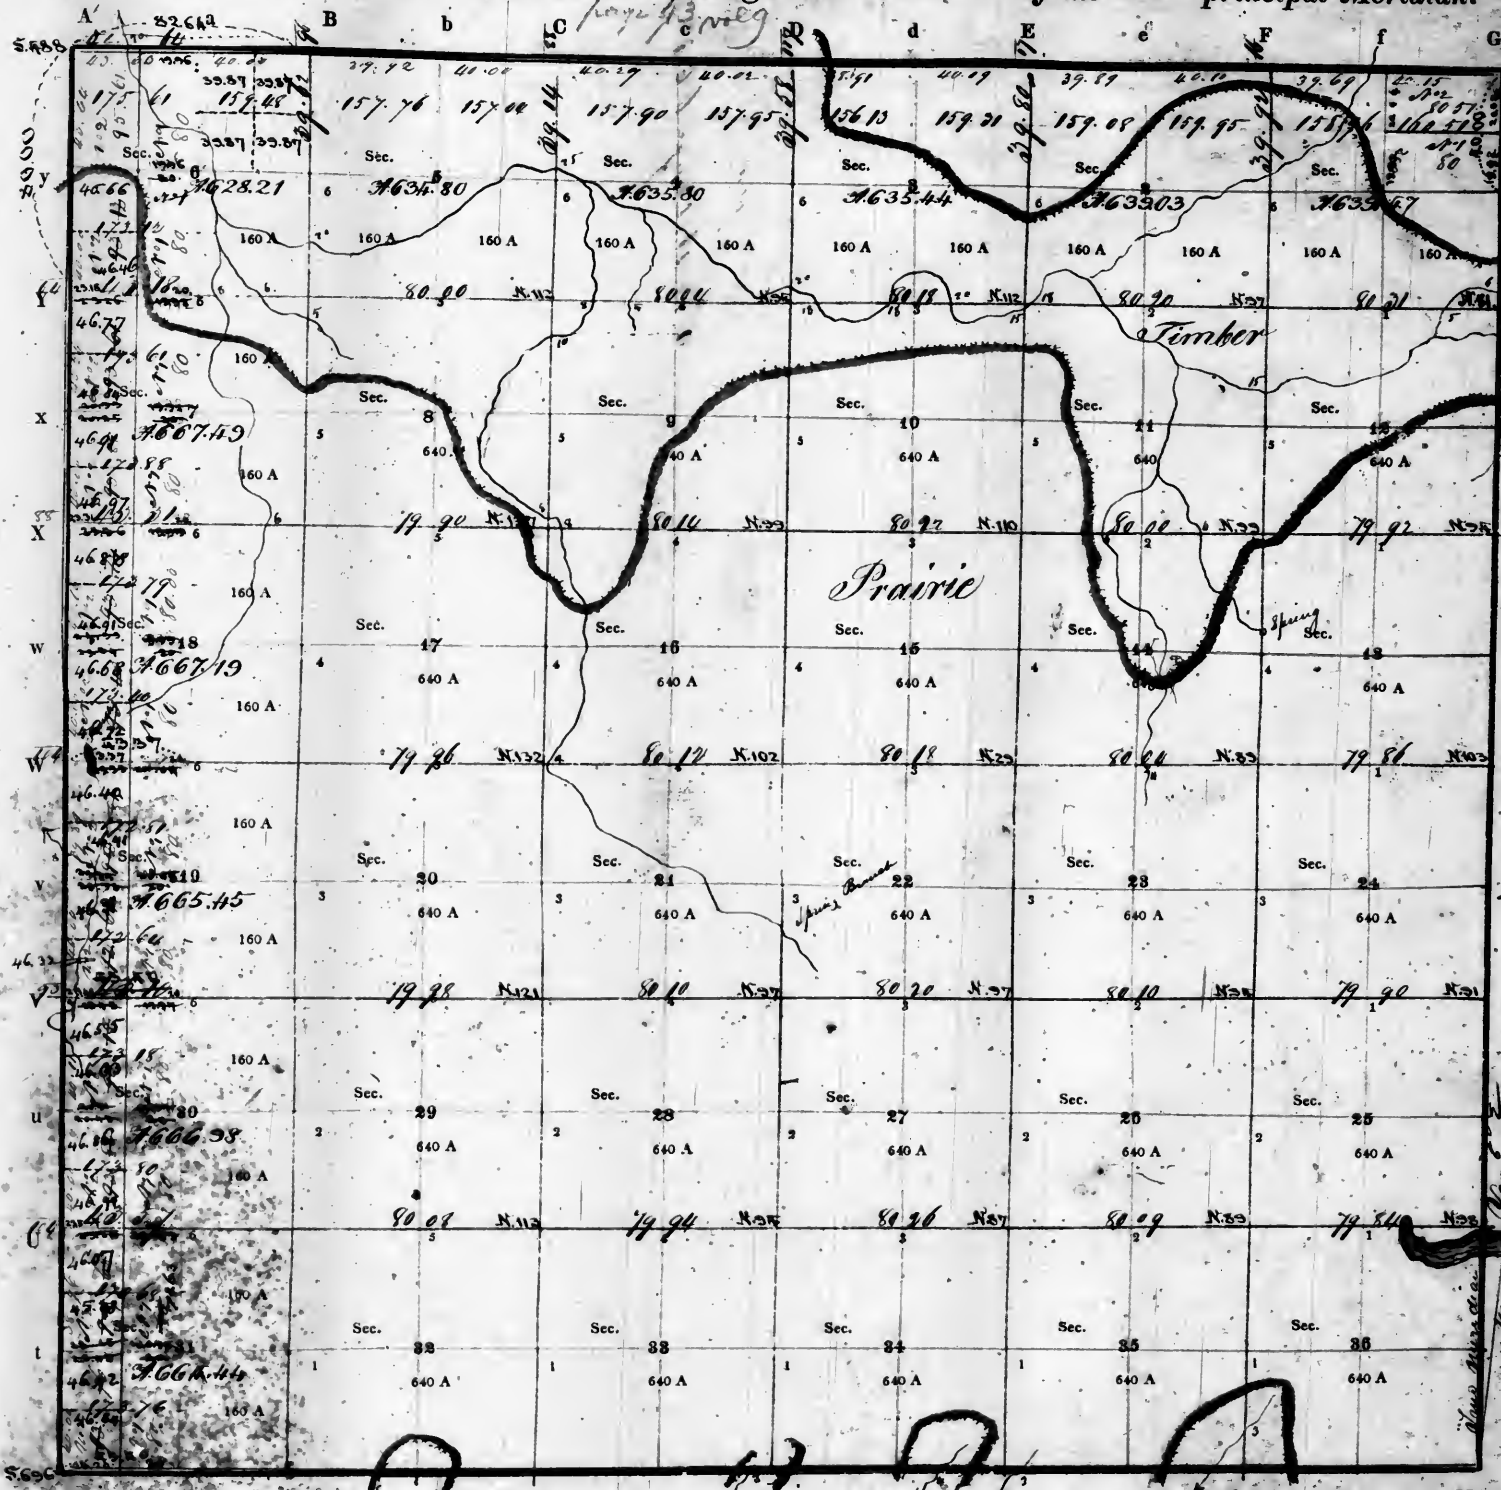

Aggregate area = 23184.35 acres

Office of the Surveyor General
for the State of Illinois and Missouri
St. Louis July 19th 1850
The South West quarter of section 6
and the west half of sections
7, 18, 19, 30 & 31, situated under the
act of Congress of the 5th of April
1820, and of plat 1 & 2, and
another to the Commissioner of
the General Land Office
Linn day

Surveyor's Office
St. Louis 10th April 1852
Plat of the NE 1/4 of Sec. 14 of the
west halves of Sec. 6, 7, 18, 19, 30 & 31
sent this day to the Commr of the
Genl. Land Office.

Surveyor's Office
St. Louis 27th Jan 1854
Subdivided this day the NE 1/4
of Sec. 6, so as to conform to a
previous sale, and sent a copy to
the Commissioner of the General
Land Office, (See Commr's letter
of 31st Decr 1850.) - and another
copy sent to the Register.


PURSUANT to a contract with, and instructions from WILLIAM, Rector, Surveyor of the lands of the United States in the State of Missouri and Territory of Arkansas - bearing date the third day of March 1821

I have admeasured, laid out and surveyed the above described Township; and do hereby certify, that it had such marks and bounds, both natural and artificial, as are represented on said plat, and described in the field notes made thereof, and returned with this plat into the Office of the Surveyor of the lands of the United States, for the State of Missouri and Territory of Arkansas

Certified this 11th day of July in the year of Chris- 1821

STEIN
D. SURVEYOR

Township No. 13 North of the base line, Range No. 1 East of the 2^d principal Meridian. 476

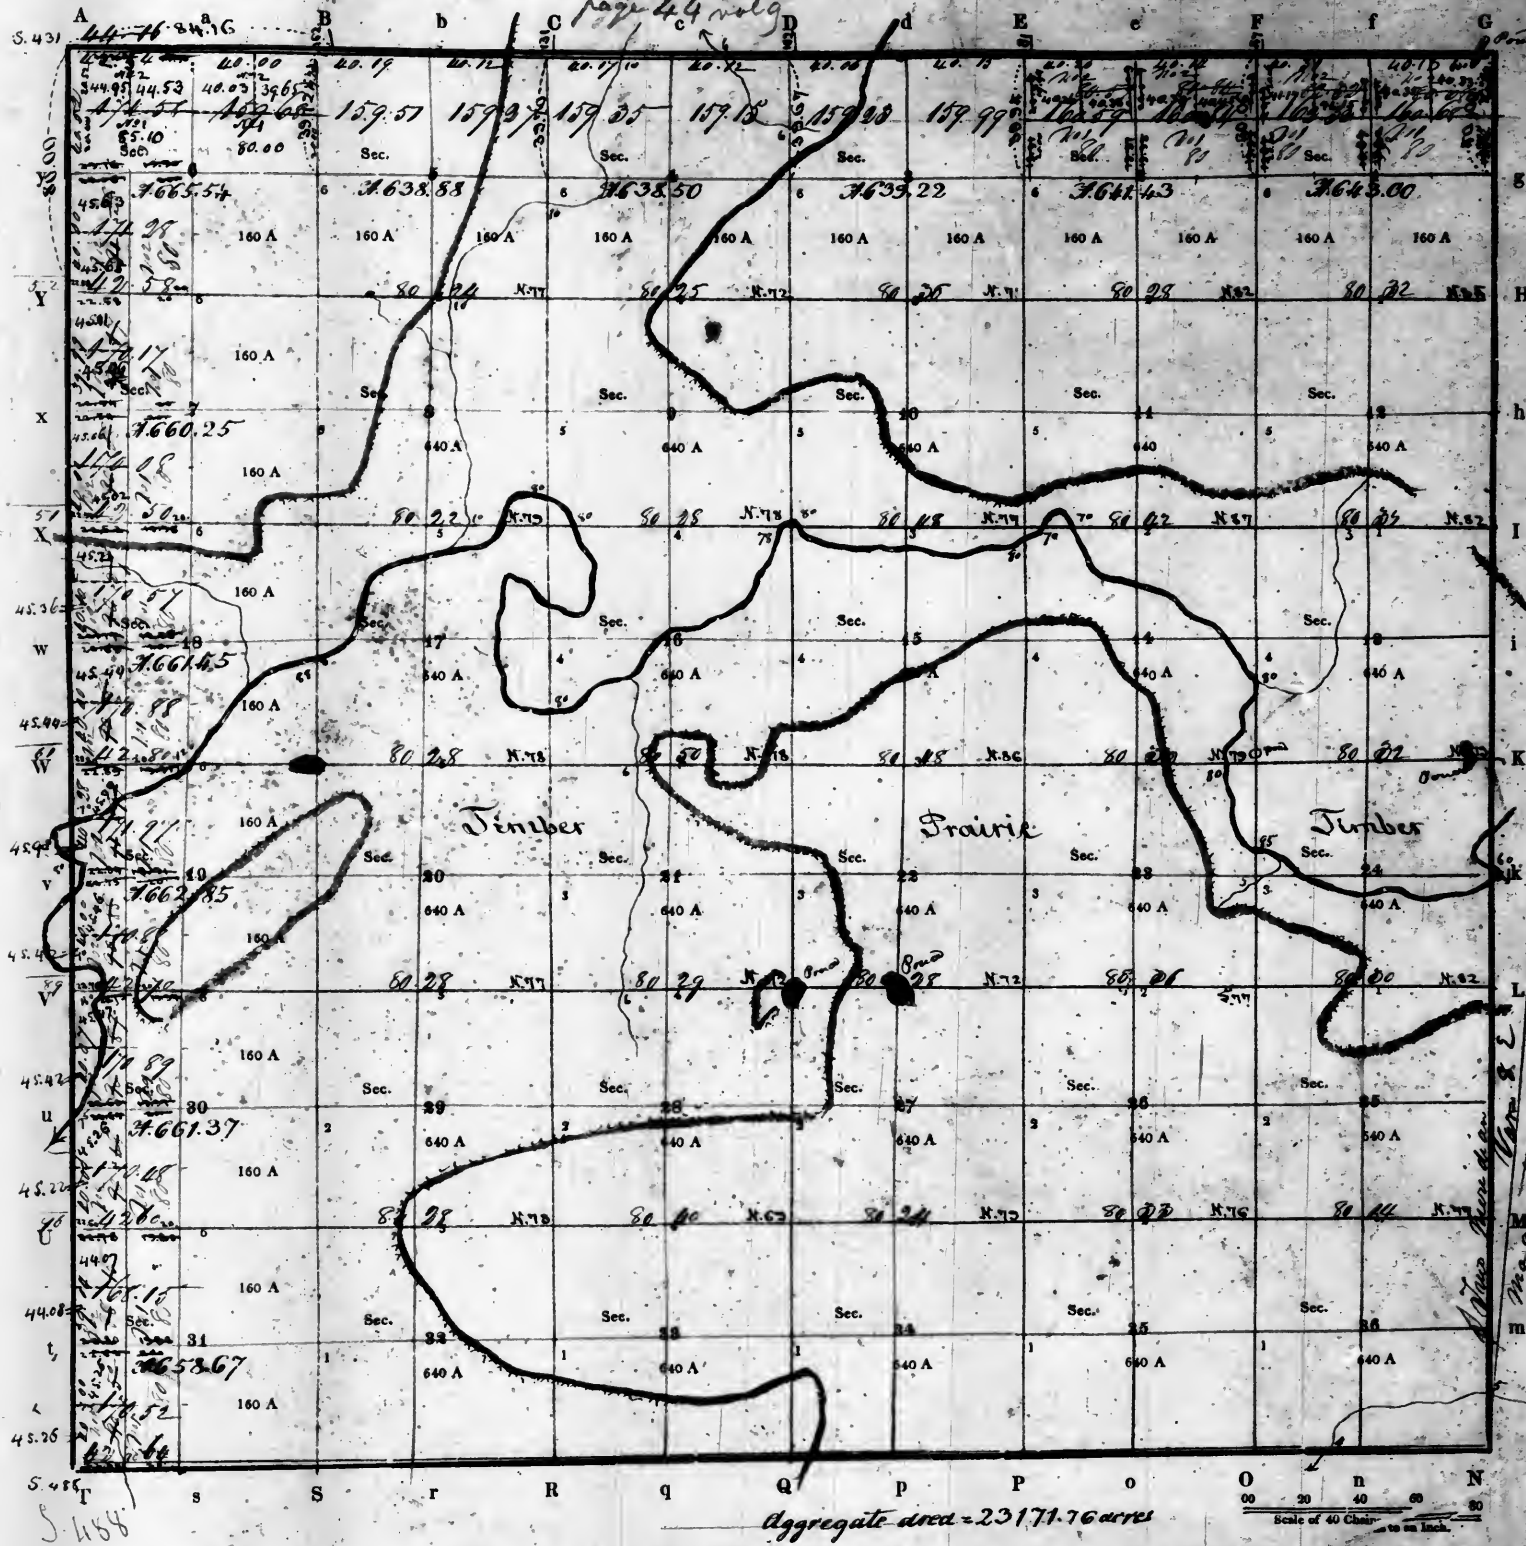

Office of the Surveyor General
for the State of Illinois, this was
Laid down July 19th 1850
The North halves of sections 16, 22,
the North half and the South east
quarters of sections 6, - under the
west halves of sections 7, 15, 19, 20 &
31, subdivided under the act of
Congress of the 5th of April 1850
and a plat sent to the Register
and another to the Commissioner
of the General Land office.
Same day

Surveyor's Office
St. Louis 10th August 1851
Plat of the North halves of sec 14 &
& of the West halves of sec 6, 14, 15,
20 & 31 sent this day to the
Commissioner of the Genl L.O.

PURSUANT to a contract with, and instructions from WILLIAM RECTOR, Surveyor of the lands of the United States in the State of Illinois and Territory of Arkansas - " " " " bearing date the 14th day of March 1850


I have admeasured, laid out and surveyed the above described Township; and do hereby certify, that it had such marks and bounds, both natural and artificial, as are represented on said plat, and described in the field notes made thereof, and returned with this plat into the Office of the Surveyor of the lands of the United States, for the States of Illinois and Territory of Arkansas

Certified this 14 day of September 1851

EXAMINED.

Wm. Rector
D. SURVEYOR.

422

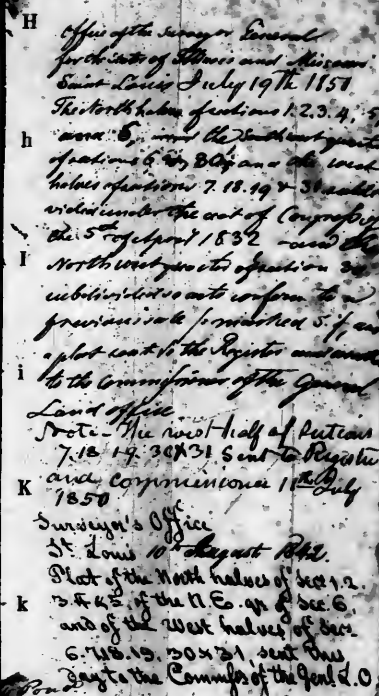

Aggregate area = 23252.20 acres

Scale of 40 Chains to an Inch.

PURSUANT to a contract with, and instructions from WILLIAM RECTOR, Surveyor of the lands of the United States in the
and Illinois and Territory of Arkansas — bearing date the third day of March 1821


I have admeasured, laid out and surveyed the above described Township; and do hereby certify, that it had such marks and bounds, both natural and artificial, as are represented on said plat, and described in the field notes made thereof, and returned with this plat into the Office of the Surveyor of the lands of the United States, for the *States of Missouri and Illinois in a Territory of Arkansas*

Certified this 13th day of September 1881

EXAMINED.

By Enos Steen D. SURVEYOR.

Township No. 15 North of the base line, Range No. 6 East of the 3rd principal Meridian.

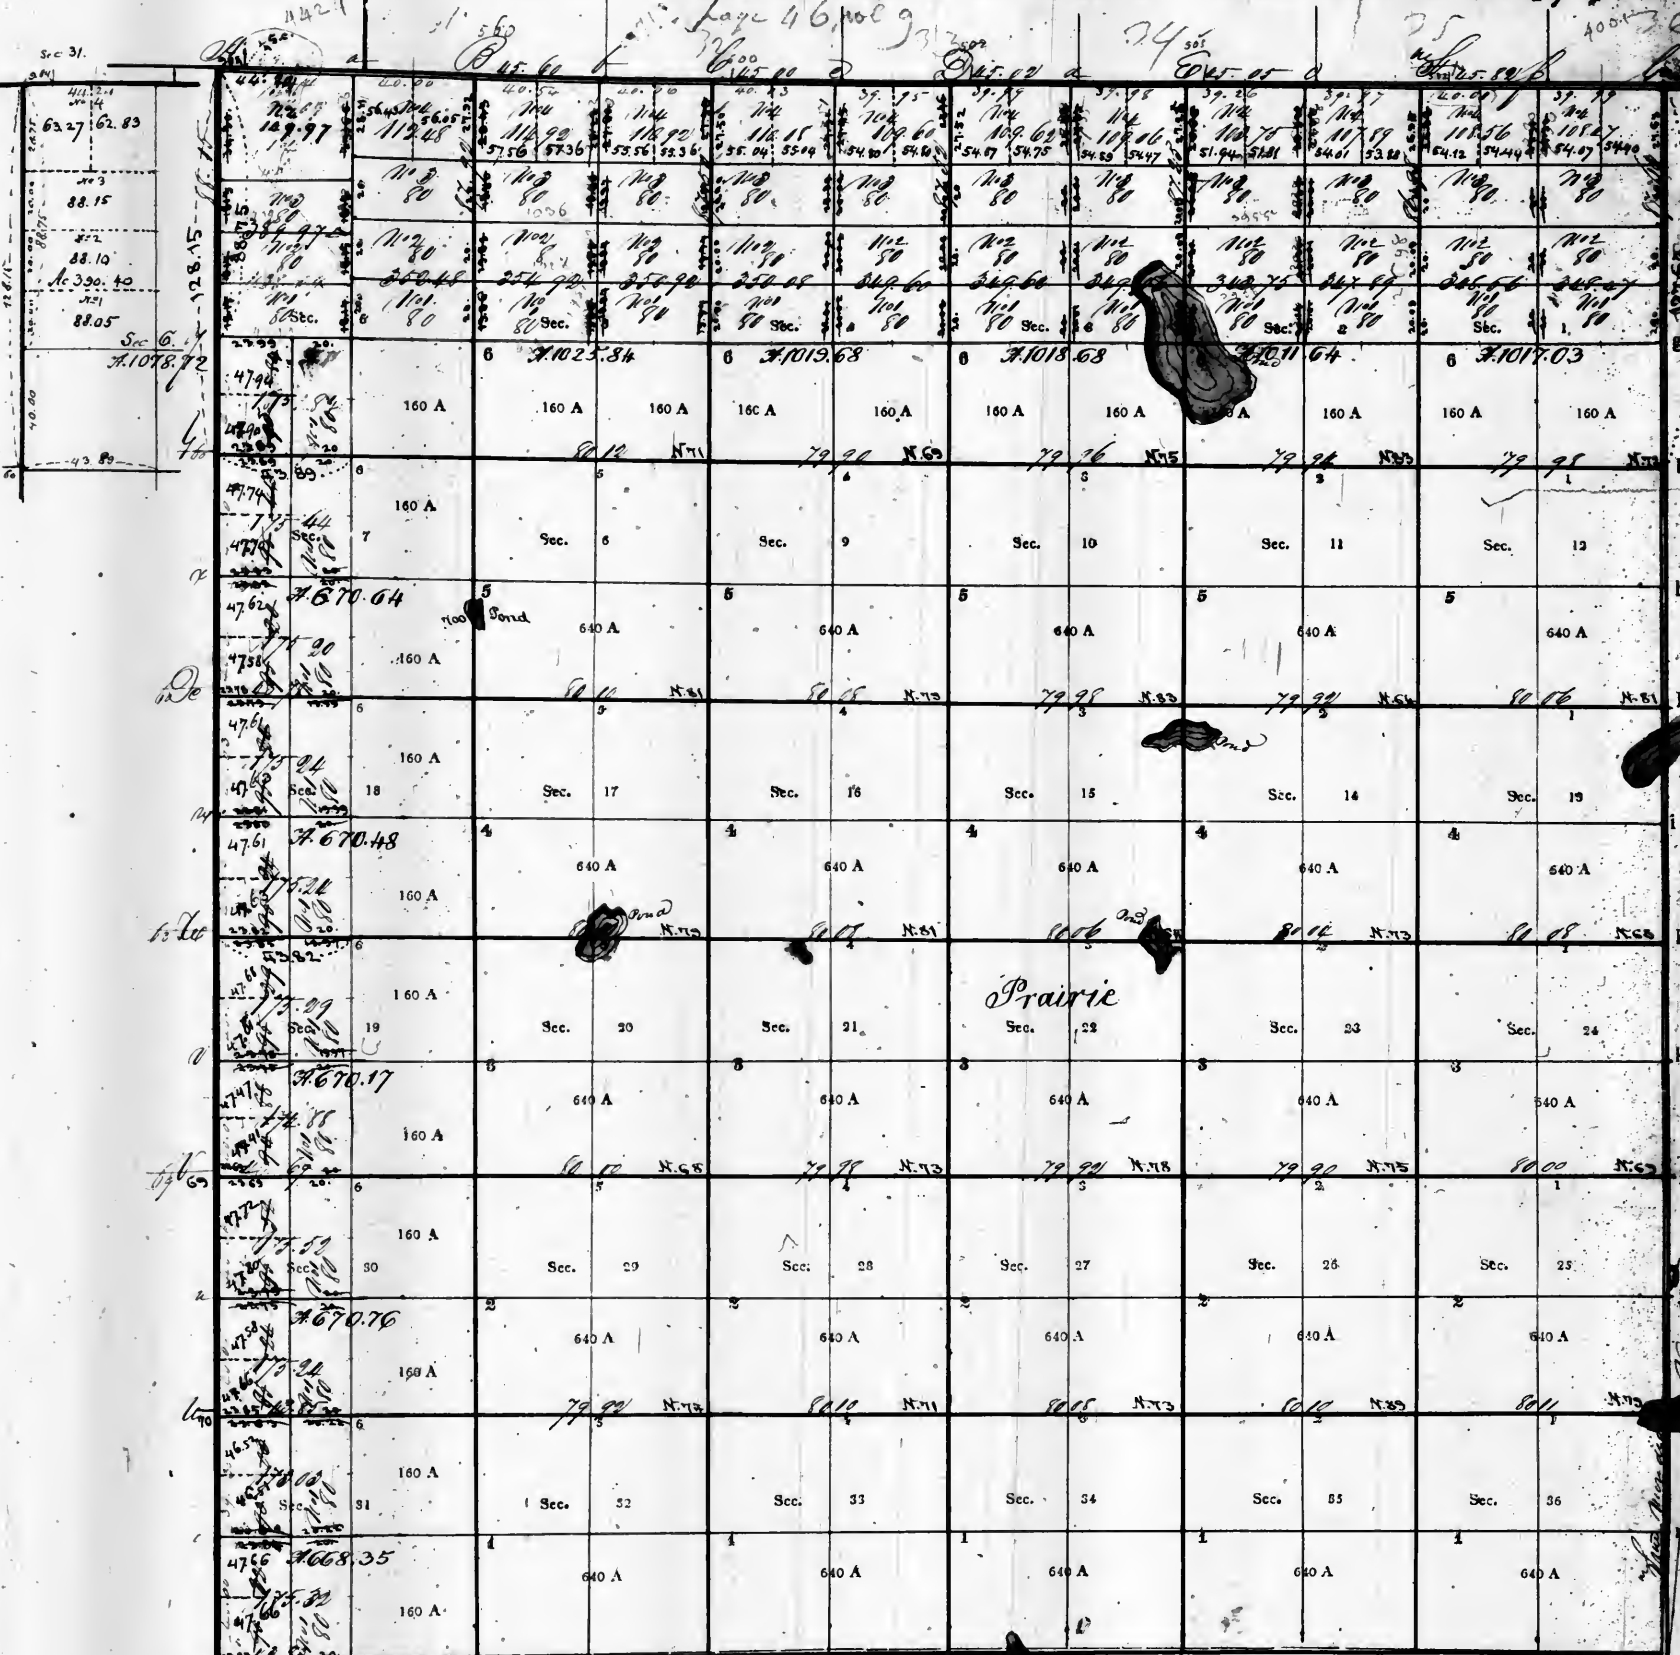

aggregate area - 25521.99 acres

PURSUANT to a contract with, and instructions from William Rector, Surveyor of the lands of the United States in the State of Missouri and Territory of Arkansas bearing date the 14th day of March 1857 I have measured, laid out and surveyed the above described Township; and do hereby certify, that it had such marks and bounds, both natural and artificial, as are represented on said plat, and described in the field notes made thereof, and returned with this plat into the Office of the Surveyor of the Lands of the United States, in the State of Missouri and Territory of Arkansas

Certified this 14th day of September 1857


By E. H. H. D. SURVEYOR

EXAMINED.

Office of the Surveyor General
for the State of Missouri and Territory of Arkansas
Saint Louis, July 19th 1857
The North halves of sections 1, 2, 3, 4 & 5 the North
half and the Southwest quarter of section 6, and the
North halves of sections 7, 18, 19, 30 & 31, subdivided under
the act of Congress of the 5th of April 1832, and a plat
sent to the Register and another to the Commissioner
of the General Land Office. Same day

479
Recorded

Township No. 16 North of the base line, Range No. 6 East of the 3^d principal Meridian.

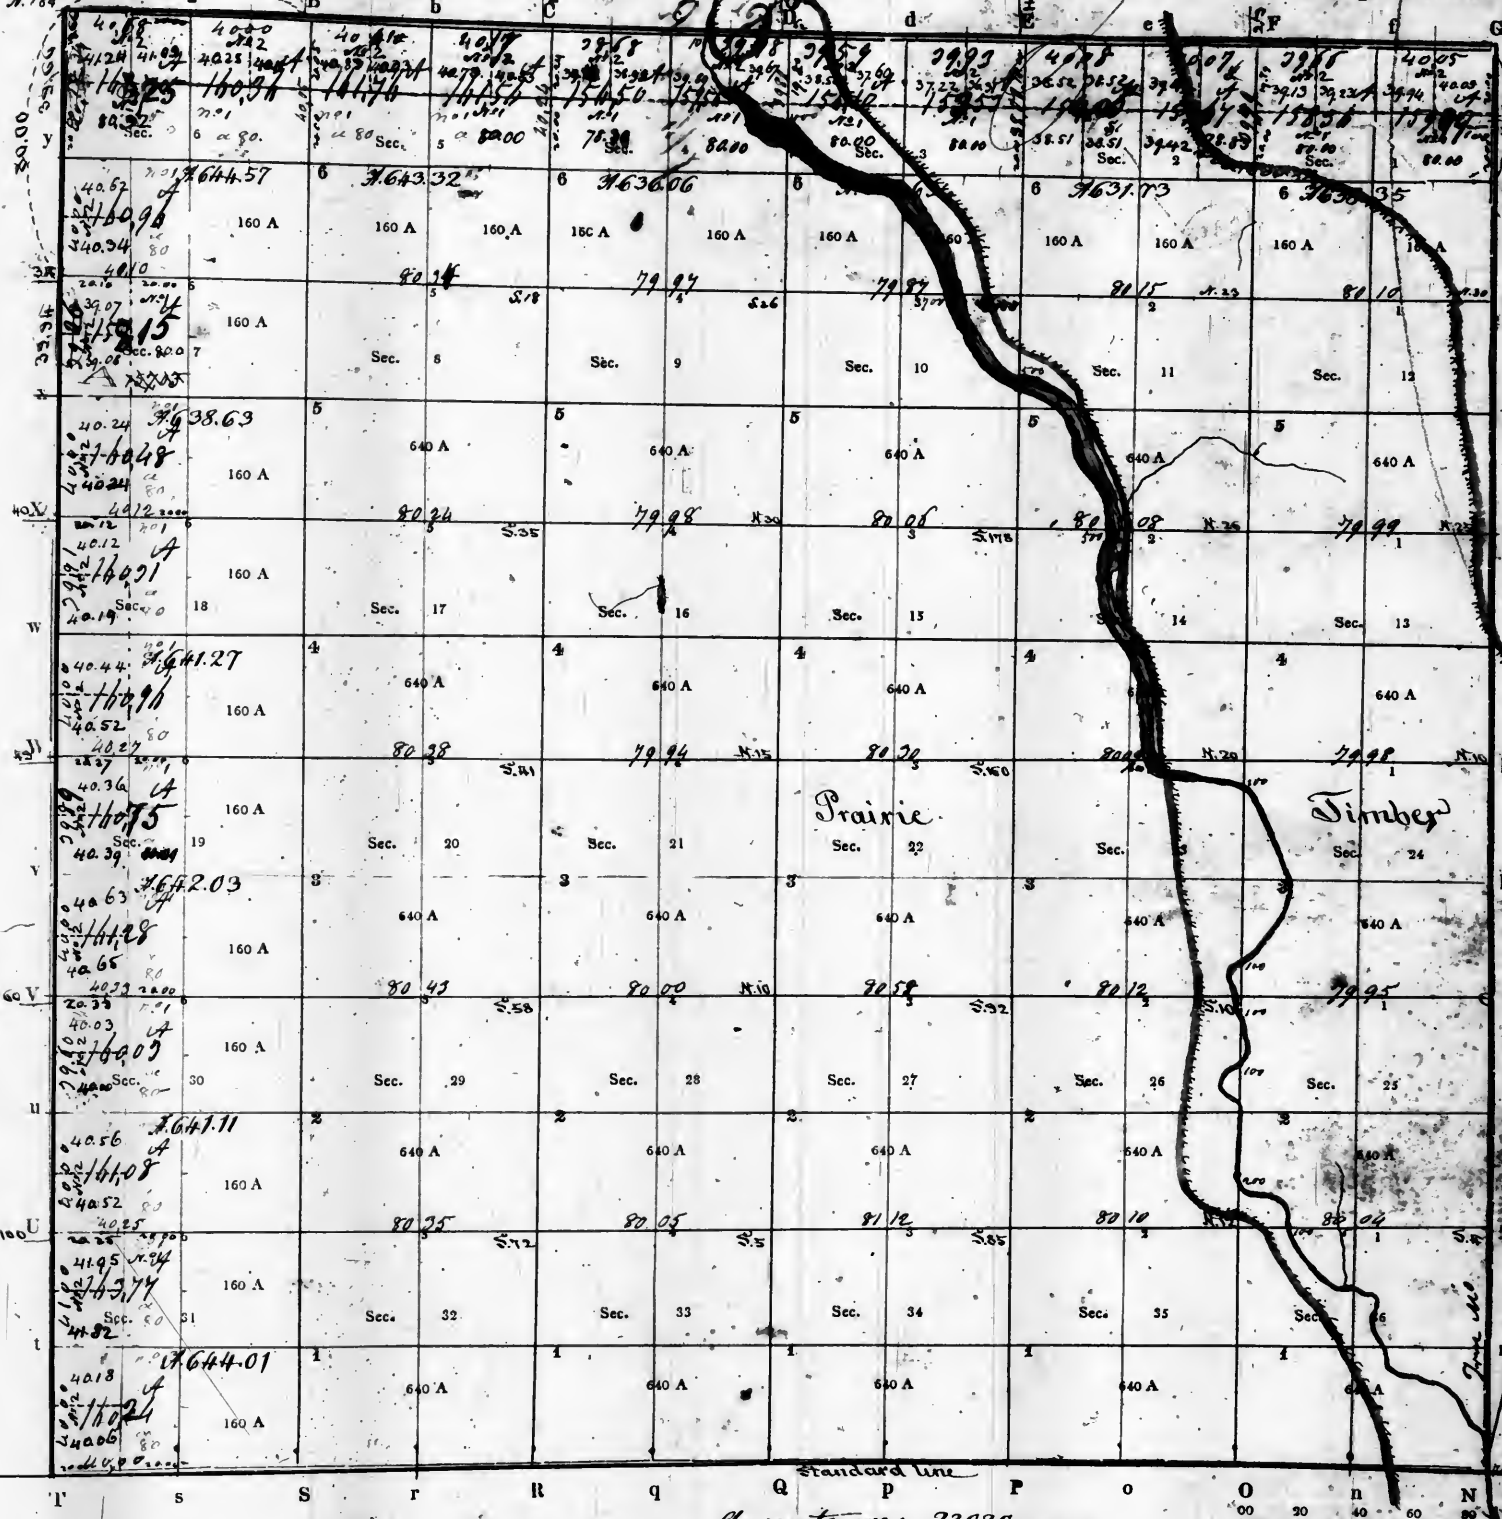

Office of the Surveyor General
for the State of Illinois and Missouri
Saint Louis, July 19th 1852
The North halves of sections 1, 2, 3, 4, 5
the North half and the South half of
section 6, and the West halves of
7, 18, 19, 30 & 31, subdivided
act of Congress of the 5th of April 1850
the North half of section 2, subdivided
to inform to previous sales
marked S, and a plat sent to the
Register and another to the Comptroller
of the General Land Office
same day
July 11th 1850

Aggregate area = 23030.71 acres


PURSUANT to a contract with, and instructions from William Rector, Surveyor of the lands of the United States in the
States of Missouri and Territory of Arkansas bearing date the nineteenth day of February 1852
I have measured, laid out and surveyed the above described Township; and do hereby certify, that it had such marks and bounds, both natural and artificial,
as are represented on said plat, and described in the field notes made thereof, and returned with this plat into the Office of the Surveyor of the Lands of the
United States, in the States of Illinois, Missouri and Territory of Arkansas Surveyed by Rich^d. T. Holliday
Certified this 13th day of November 1852
J. Elias Rector D. SURVEYOR

EXAMINED.

PURSUANT to a contract with, and instructions from William Rector, Surveyor of the lands of the United States in the *States of Illinois*
Missouri and Territory of *Arkansas* bearing date the *thirteenth* day of *February* 1822
I have measured, laid out and surveyed the above described Township; and do hereby certify, that it had such marks and bounds, both natural and artificial,
as are represented on said plat, and described in the field notes made thereof, and returned with this plat into the Office of the Surveyor of the Lands of the
United States, in the *States of Illinois Missouri* and Territory of *Arkansas* Surveyed by *Richd. J. Holliday*
Certified this *thirteenth* day of *November* 1822 for *Elias Rector* D. SURVEYOR.
EXAMINED.

Recorded

Township N° 18 North of the Base line Range N° 6 East of the 3^d principal Meridian

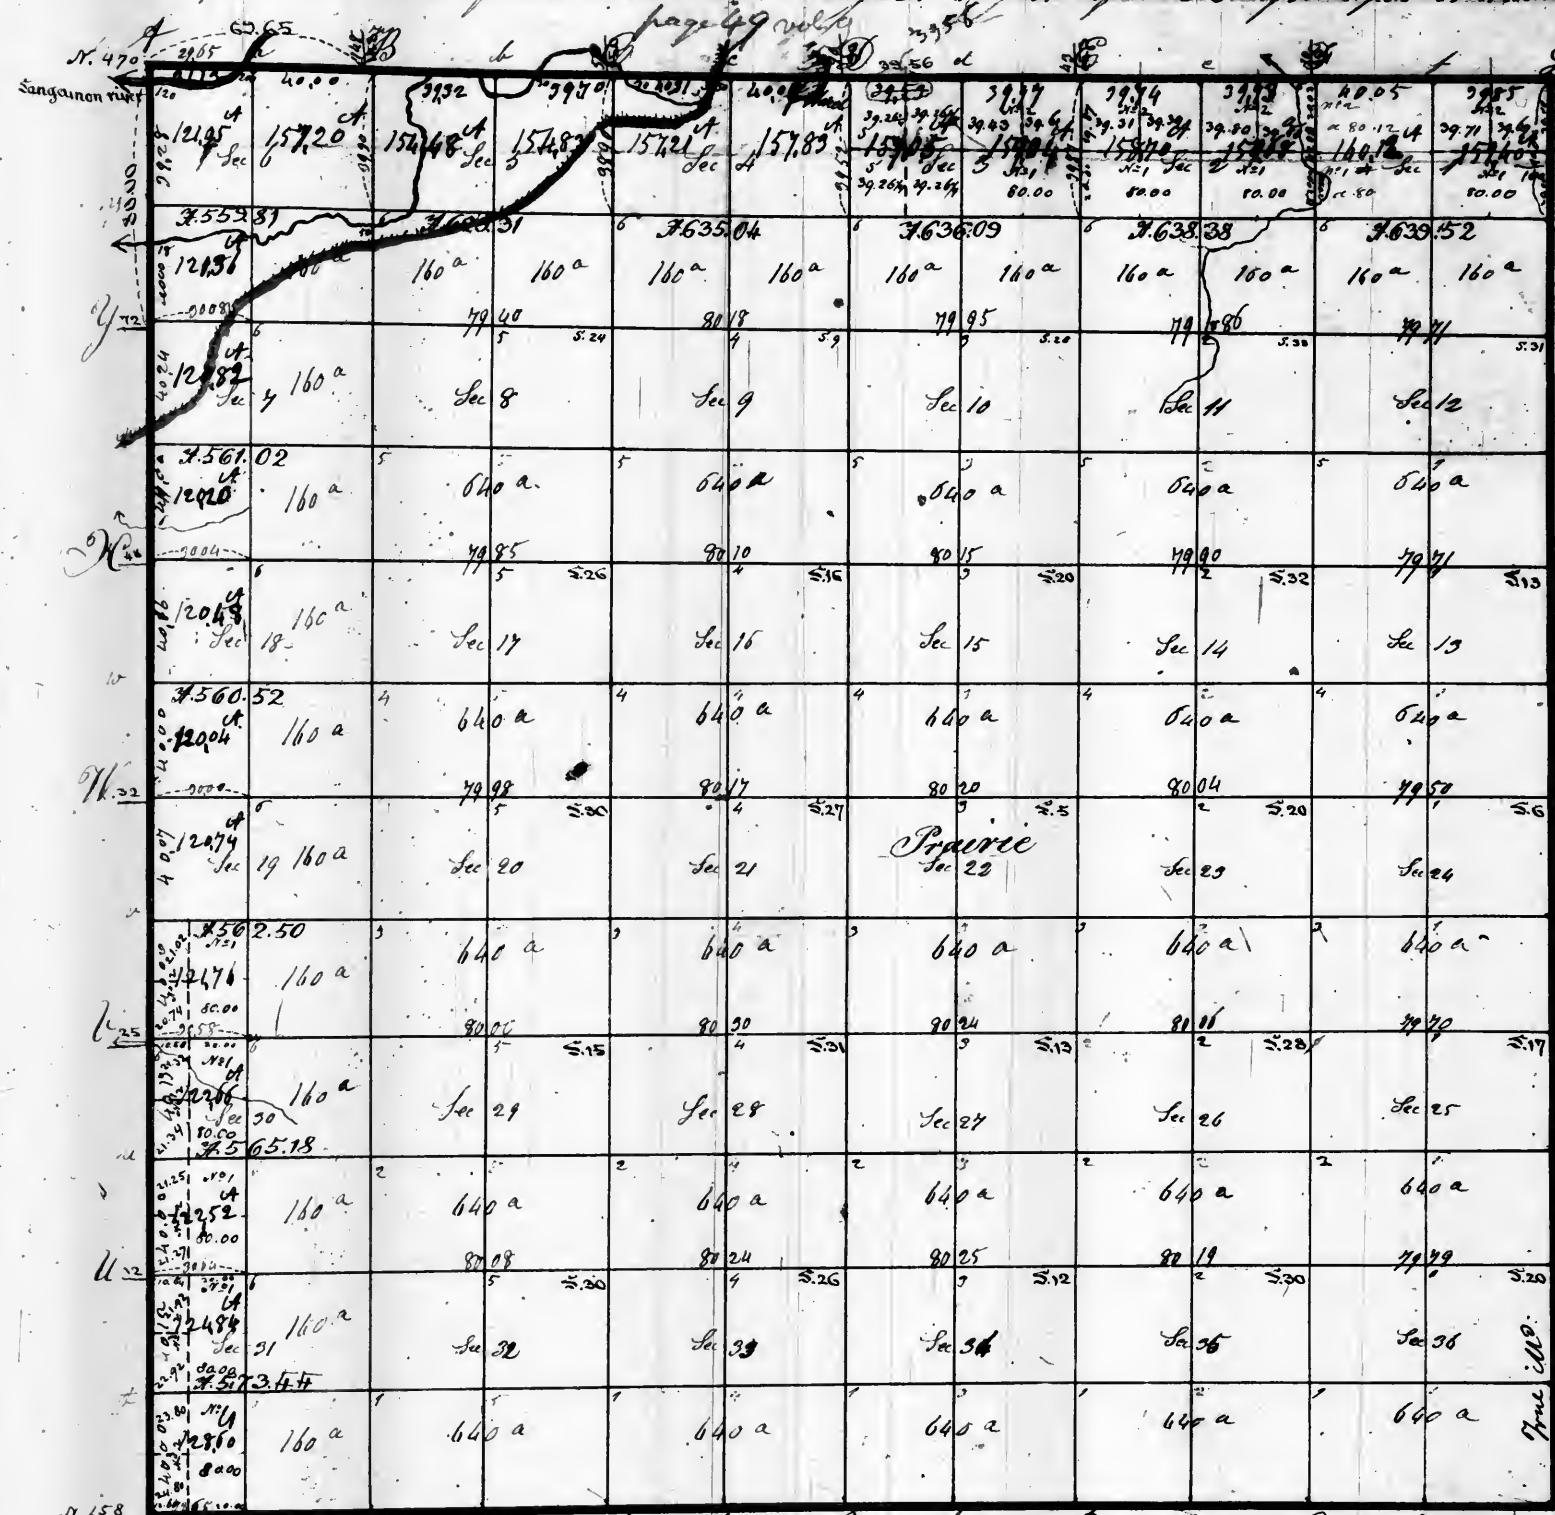

Surveyor's office
St. Louis, Mo. June 15th 1849.
The North east quarter of section 12,
the North half of section 13,
the South west quarter of section 14,
and the West half of section 15,
containing 30 x 30 section of land,
act of Congress of the 5th of
April 1832, and the
North west quarter of section
3, section 12 and 13, to be
conveyed to previous sale
for the purpose of a school
and another to the commissioners
of the General Land office.

W. H. Miller
Surveyor

Aggregate area = 22560.81 acs


Laid down by a scale of 40 chains to an inch.

Pursuant to a contract with & instructions from W^m Hector Surveyor of the Lands of the United States, in the States of Illinois Missouri & Territory of Arkansas bearing date the 1st day of February 1822 — I have admeasured laid out & surveyed the above described Township; & do hereby certify, that it had such marks & bounds, both natural & artificial as are represented on said Plat & described in the field notes made thereof, and returned with this plat into the Office of the Surveyor of the Land of United States in the States of Illinois Missouri & Territory of Arkansas Surveyed by Rich^d J. Holliday

Certified this 13th day of November 1822 for Elias Hector, D. Surveyor
Examined

Revised

Township N 19 North of the Base line Range N 6 East of the 3^d principal Meridian

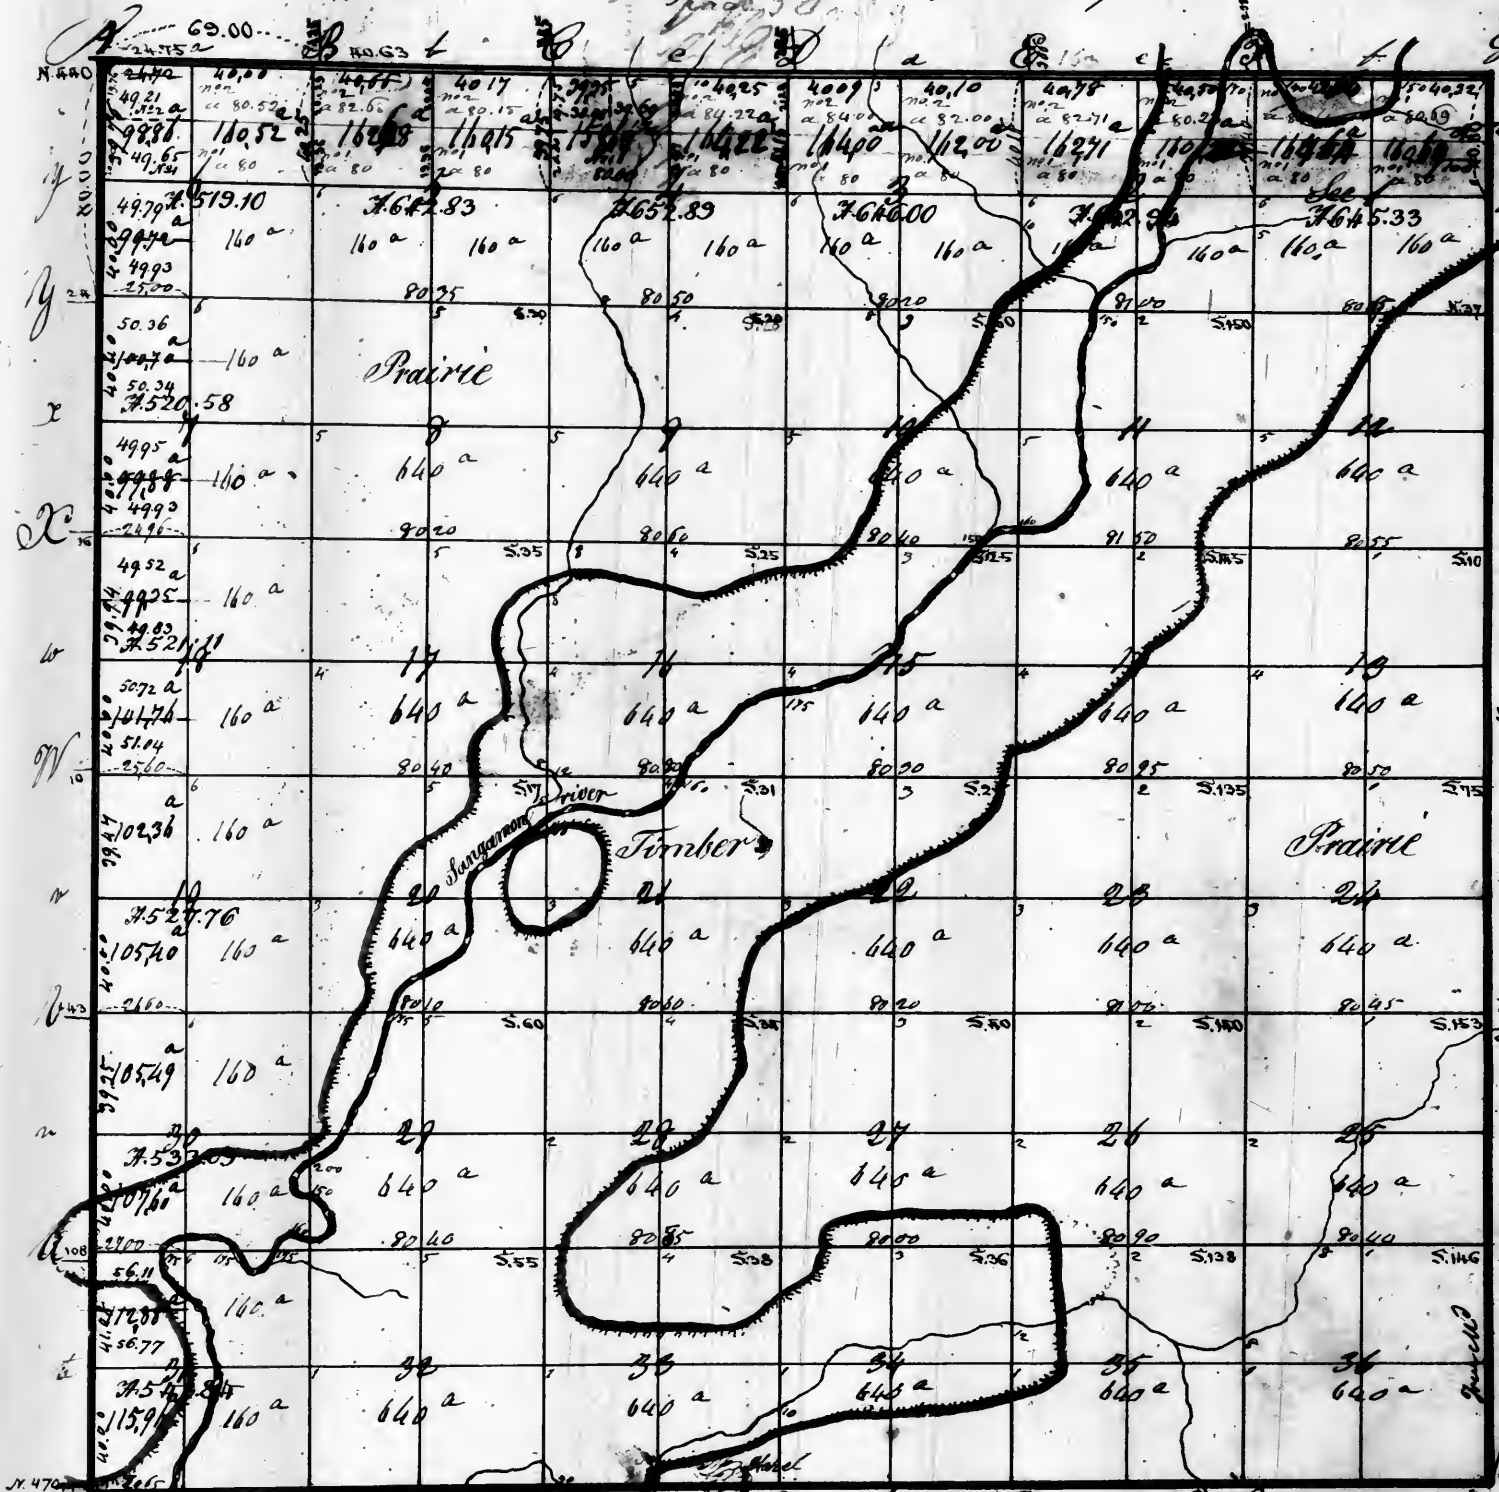

Surveyor's Office
St. Louis 10th Sept 1822.
Plat of the N 19 of R 6 E of the
3^d principal Meridian to the Comm.
the Genl. & O.
The Surveyor's Office
Saint Louis June 15th 1849.
The North West quarter of sections
4 & 51, and the West
halves of sections 6, 7, & 18
subdivided under the act of
Congress of the 5th of April
1832, & a plat sent to the
L. Genl. & O. to the
Commissioner of the Genl.
& Land Office.

Wm. H. Holliday
for Elias Reector, D. Surveyor

Aggregate area = 22400.57 ac.

Laid down by a scale of 40 Chains to an inch.

Pursuant to a contract with & instructions from William Reector Surveyor of the Lands of the United States in the States of Illinois, Missouri & Territory of Arkansas, bearing date the nineteenth day of February 1822 I have admeasured laid out & surveyed the above described Township & do hereby Certify that it had such marks & bounds both natural & artificial as are represented on said plat & described in the field notes made thereof & returned with this plat into the Office of the Surveyor of the Lands of the United States, in the States of Illinois, Missouri & Territory of Arkansas.


Certified this Thirtieth day of November 1822

Surveyed by Rich^d. J. Holliday
for Elias Reector, D. Surveyor

~~482~~ ~~480~~
483.

Township No. 20 North of the base line, Range No. 6 East of the 3rd principal Meridian.

Recorded

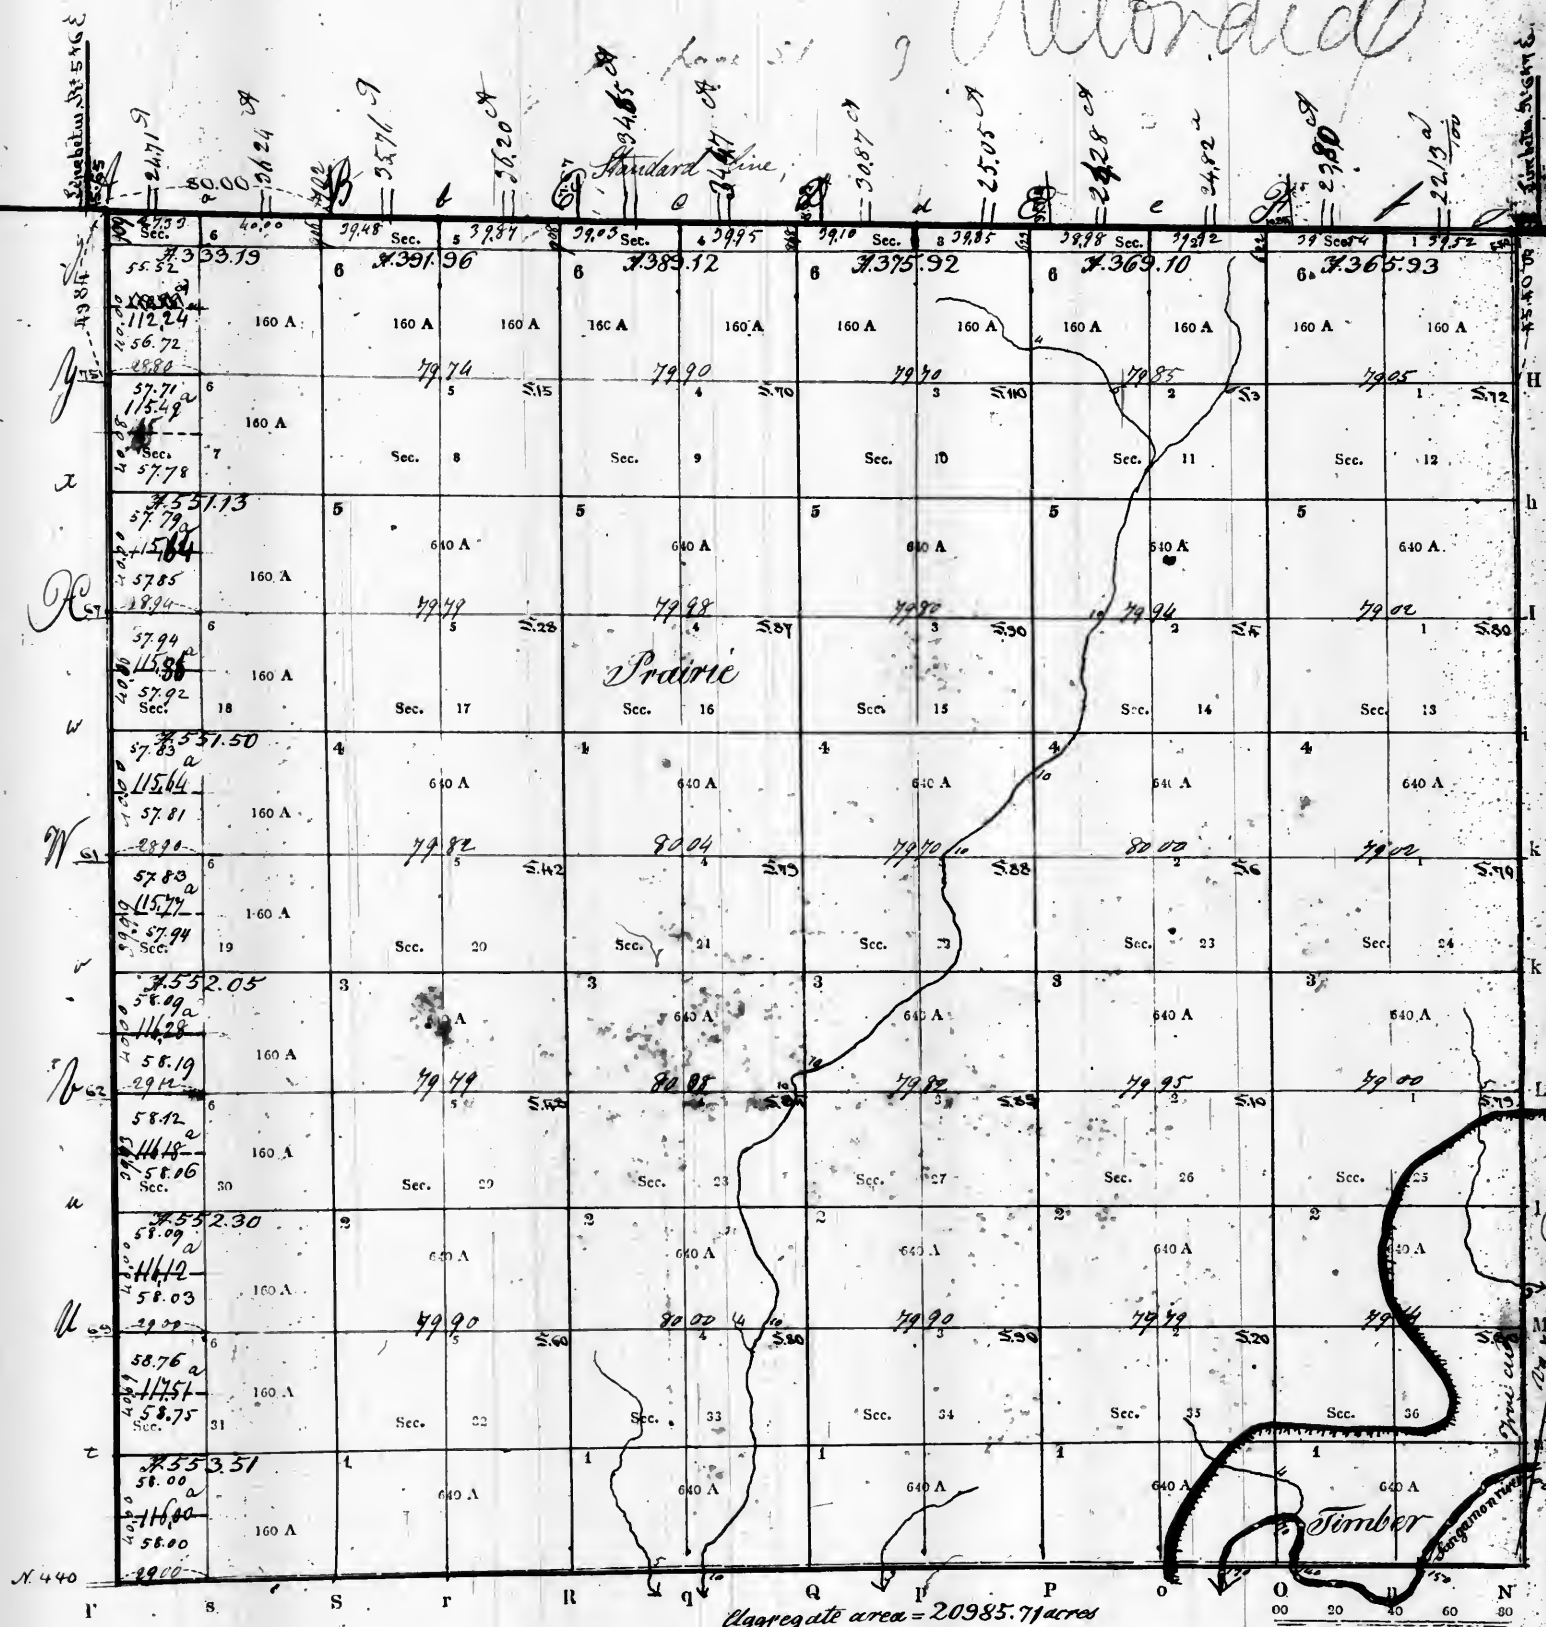

PURSUANT to a contract with, and instructions from William Rector, Surveyor of the lands of the United States in the bearing date the 11th day of February 1822
Missouri & Territory of Arkansas
I have measured, laid out and surveyed the above described Township; and do hereby certify, that it had such marks and bounds, both natural and artificial, as are represented on said plat, and described in the field notes made thereof, and returned with this plat into the Office of the Surveyor of the Lands of the United States, in the States of Illinois - Missouri & Territory of Arkansas Surveyed by Rich^d. J. Holliday
Certified this 13th day of November 1822 for Elias Rector D. SURVEYOR.


EXAMINED.
Surveyor's office
Saint Louis June 15th 1849.
The South west quarter of section 6 and the West halves of sections 7, 18, 19, 30 & 31, subdivided under the act of Congress of the 5th April 1832, and a plat sent to the Register and auditor to the Commissioner of the General Land office.

E. F. Longham

[illegible]

Recorded

Township N. 22 North of the base line, Range N. 6 East of the 3rd principal Meridian
 proc 53 vol 9

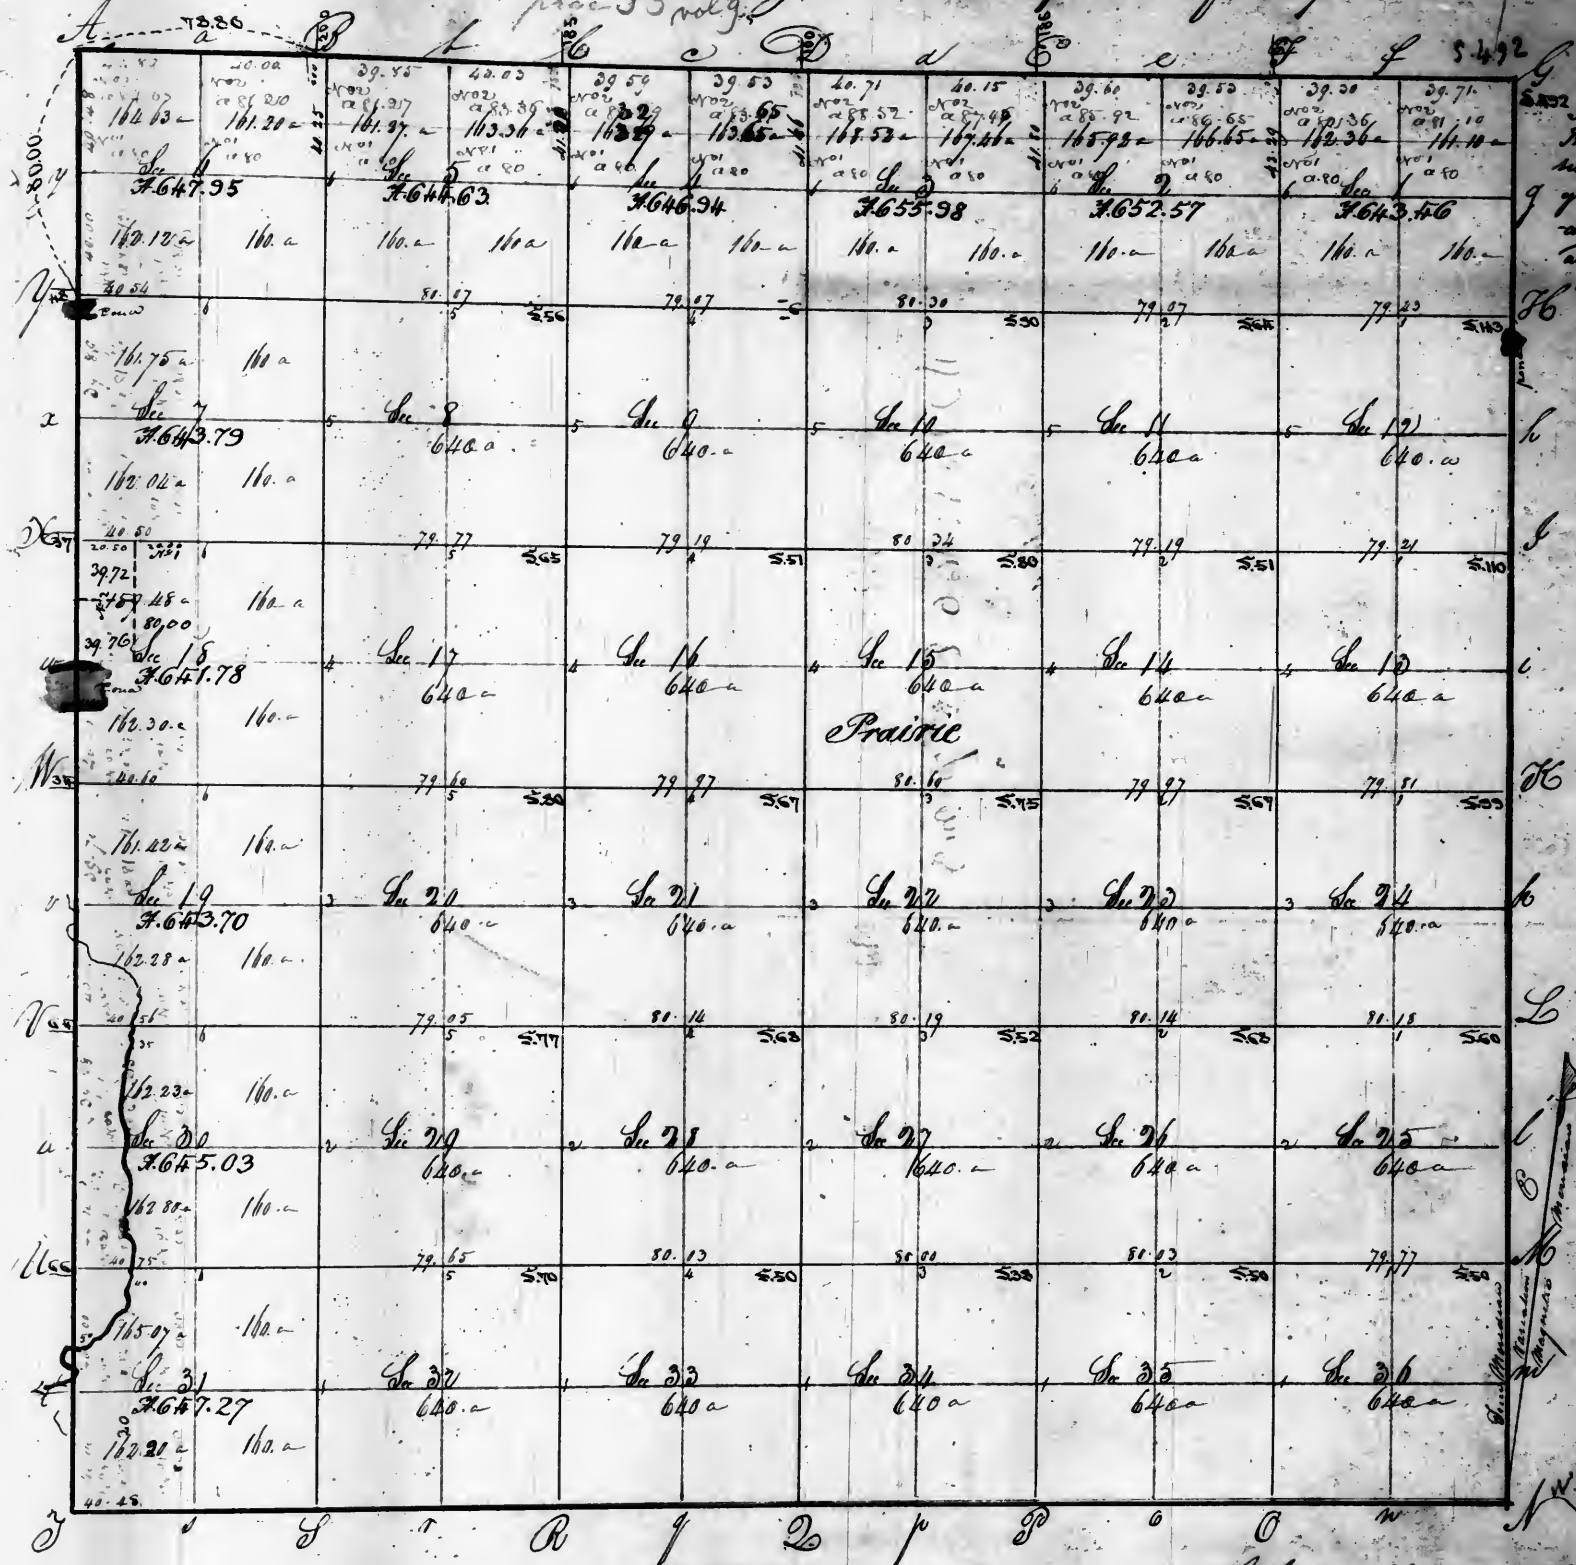

Surveyor's office

Pursuant to a contract with, and instructions from, William P. Rector, Surveyor of the lands of the United States in the States of Illinois and Missouri and Territory of Arkansas, bearing date the third day of October 1890, I have administered said out and surveyed the above described Township, and do hereby certify, that it has such marks and boundaries both natural and artificial as are represented on said plat, and described in the field notes made thereof, and returned with this plat into the Office of the Surveyor of the lands of the United States in the States of Illinois and Missouri and Territory of Arkansas.


Certified this 20th day of October 1894

W. P. Rector
 Surveyor

Examined and gave the Deputy Surveyor's certificate of the amount

Revised

Township N. 23 North of the baseline, Range N. 6 East of the 3rd principal Meridian

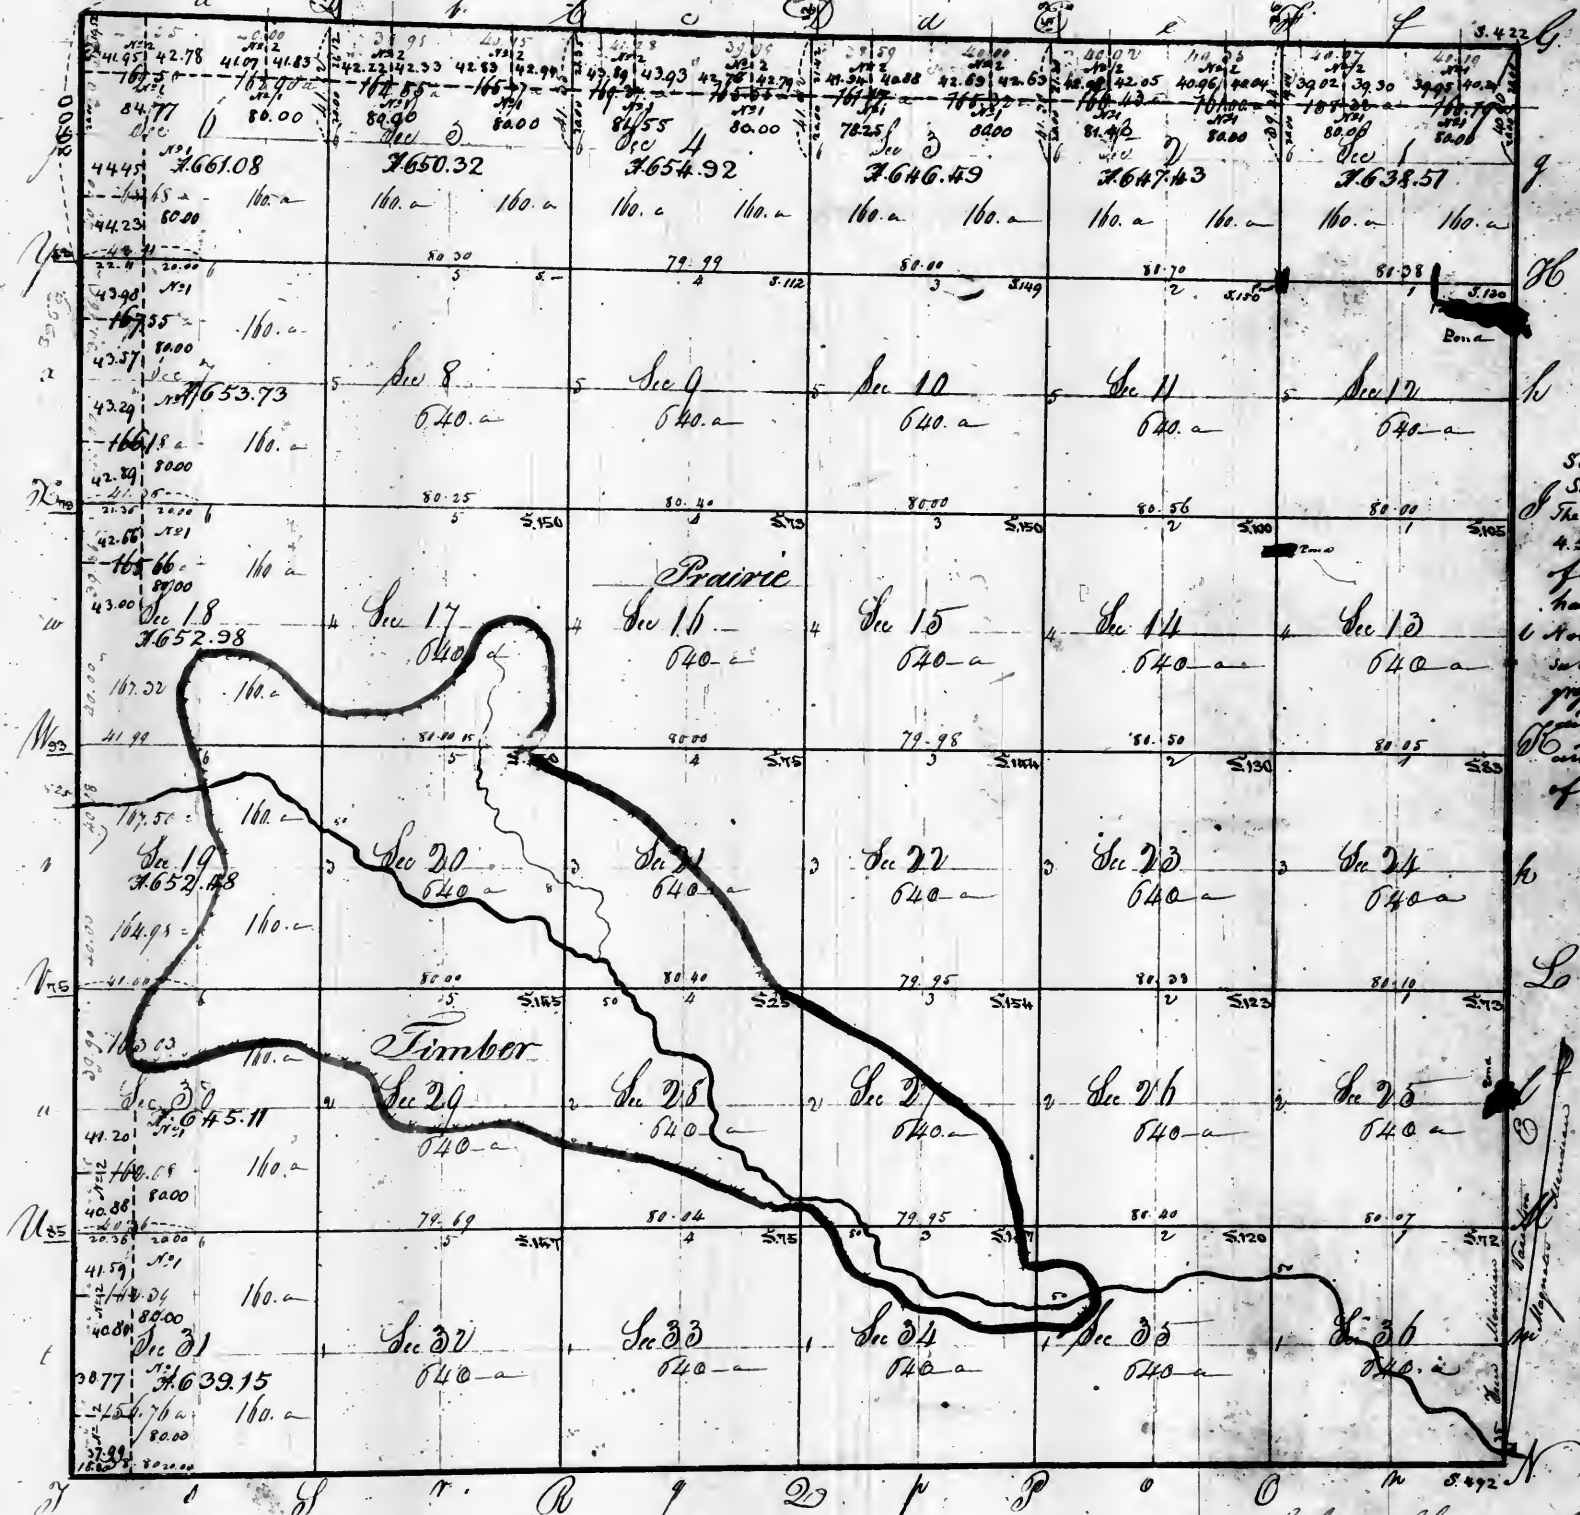

Surveyor's office
The North halves of sections 1, 2, 3,
4, 5 & 6, the South West quarter
of sections 6 & 30, the West
halves of sections 7 & 31, and the
North West quarter of section 18,
subdivided into 1/4 of 1/4 of 1/4 of 1/4
of the 5th of April 1832
found a portion of the original
and another to the Commission
of the General Land Office.

Aggregate area = 23142.20 acres.

Scale of 40 Chains to an Inch


Pursuant to a contract with, and Instructions from William Packer Surveyor of the lands of the United States in the States of Illinois and Missouri and Territory of Arkansas, bearing date the thirtieth day of October 1832. I have administered, laid out and surveyed the above described Township, and do hereby Certify, that it had such marks and bounds, both natural and artificial as are represented on said Map, and described in the field notes made thereof, and returned with this Map into the Office of the Surveyor of the lands of the United States in the States of Illinois and Missouri and Territory of Arkansas.

Certified this 20th day of 1844

E. Pector Surveyor

Examiner and gave the Deputy
Surveyor duplicate certificates of the
amount

Record
 Township N. 24 North of the base line, Range N. 6 East of the 3rd Principal Meridian

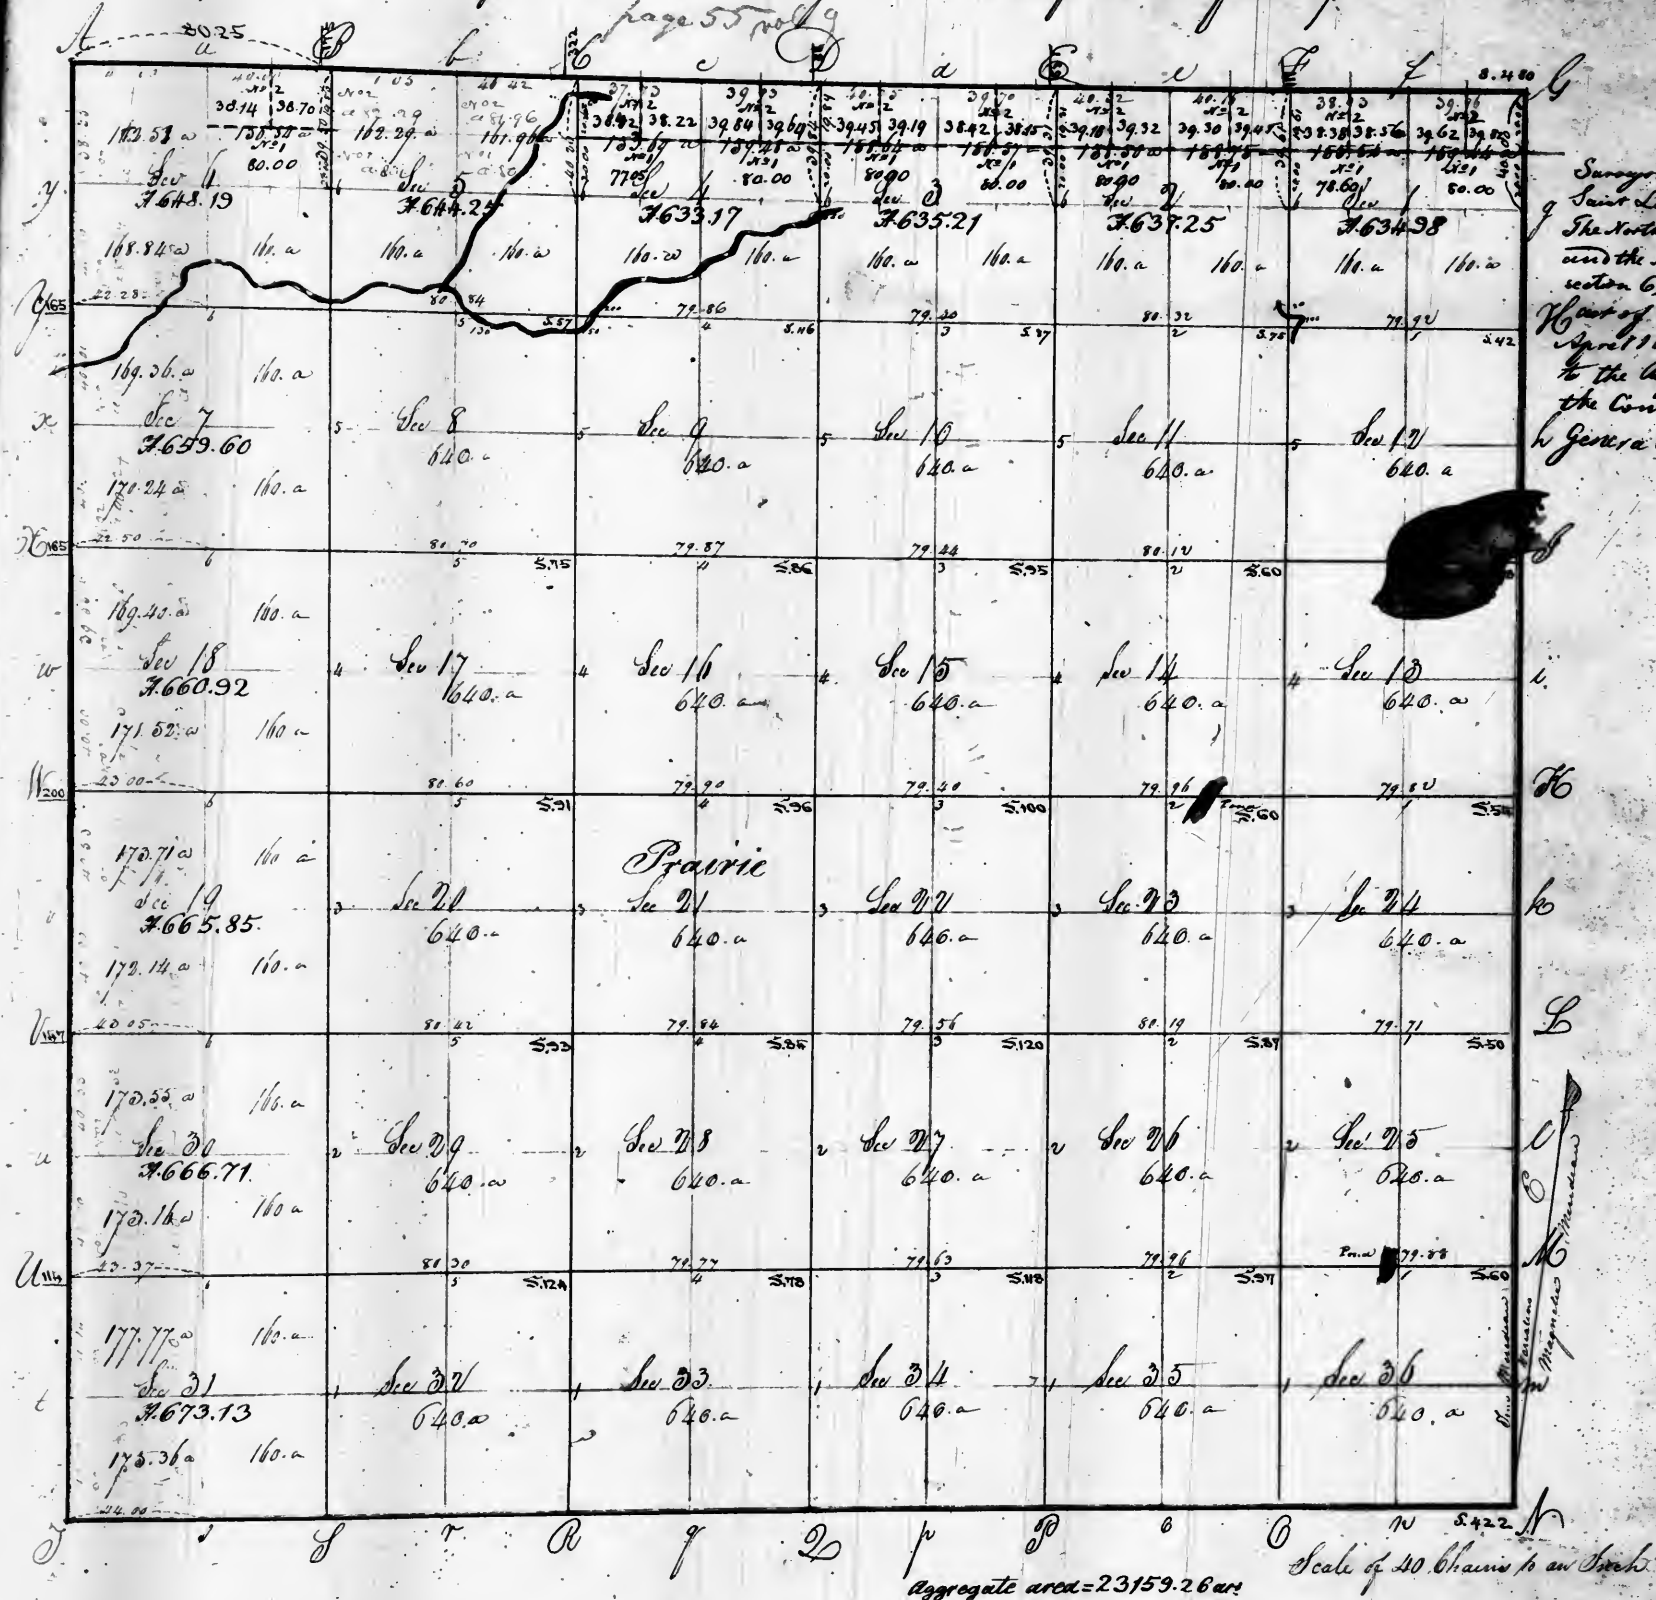

Surveyor's office
 Saint Louis June 15th 1849.
 The North halves of sections 1, 2, 3, 4, 5, 6, 7, 8, 9, 10, 11, 12, 13, 14, 15, 16, 17, 18, 19, 20, 21, 22, 23, 24, 25, 26, 27, 28, 29, 30, 31, 32, 33, 34, 35, 36, and the North East quarter of section 6, relinquished under the Act of Congress of the 5th of April 1832, and a plat sent to the Register and another to the Commissioner of the General Land Office.

Pursuant to a Contract with and Instructions from William Rector, Surveyor of the lands of the United States in the State of Illinois and Missouri and Territory of Arkansas, bearing date the third day of October 1823. I have admeasured, laid out and surveyed the above described Township, and do hereby Certify, that it has such marks and bounds both natural and artificial as are presented on said plat, and described in the field notes made thereof, and returned with this plat into the Office of the Surveyor of the Lands of the United States in the State of Missouri and Illinois, and Territory of Arkansas.


Certified this Jan 20 1824

E Rector Surveyor

Examiner and gave the Deputy Surveyor duplicate certificates of the amount

Recorded

Township N. 25 North of the base line, Range N. 6 East of the Principal Meridian

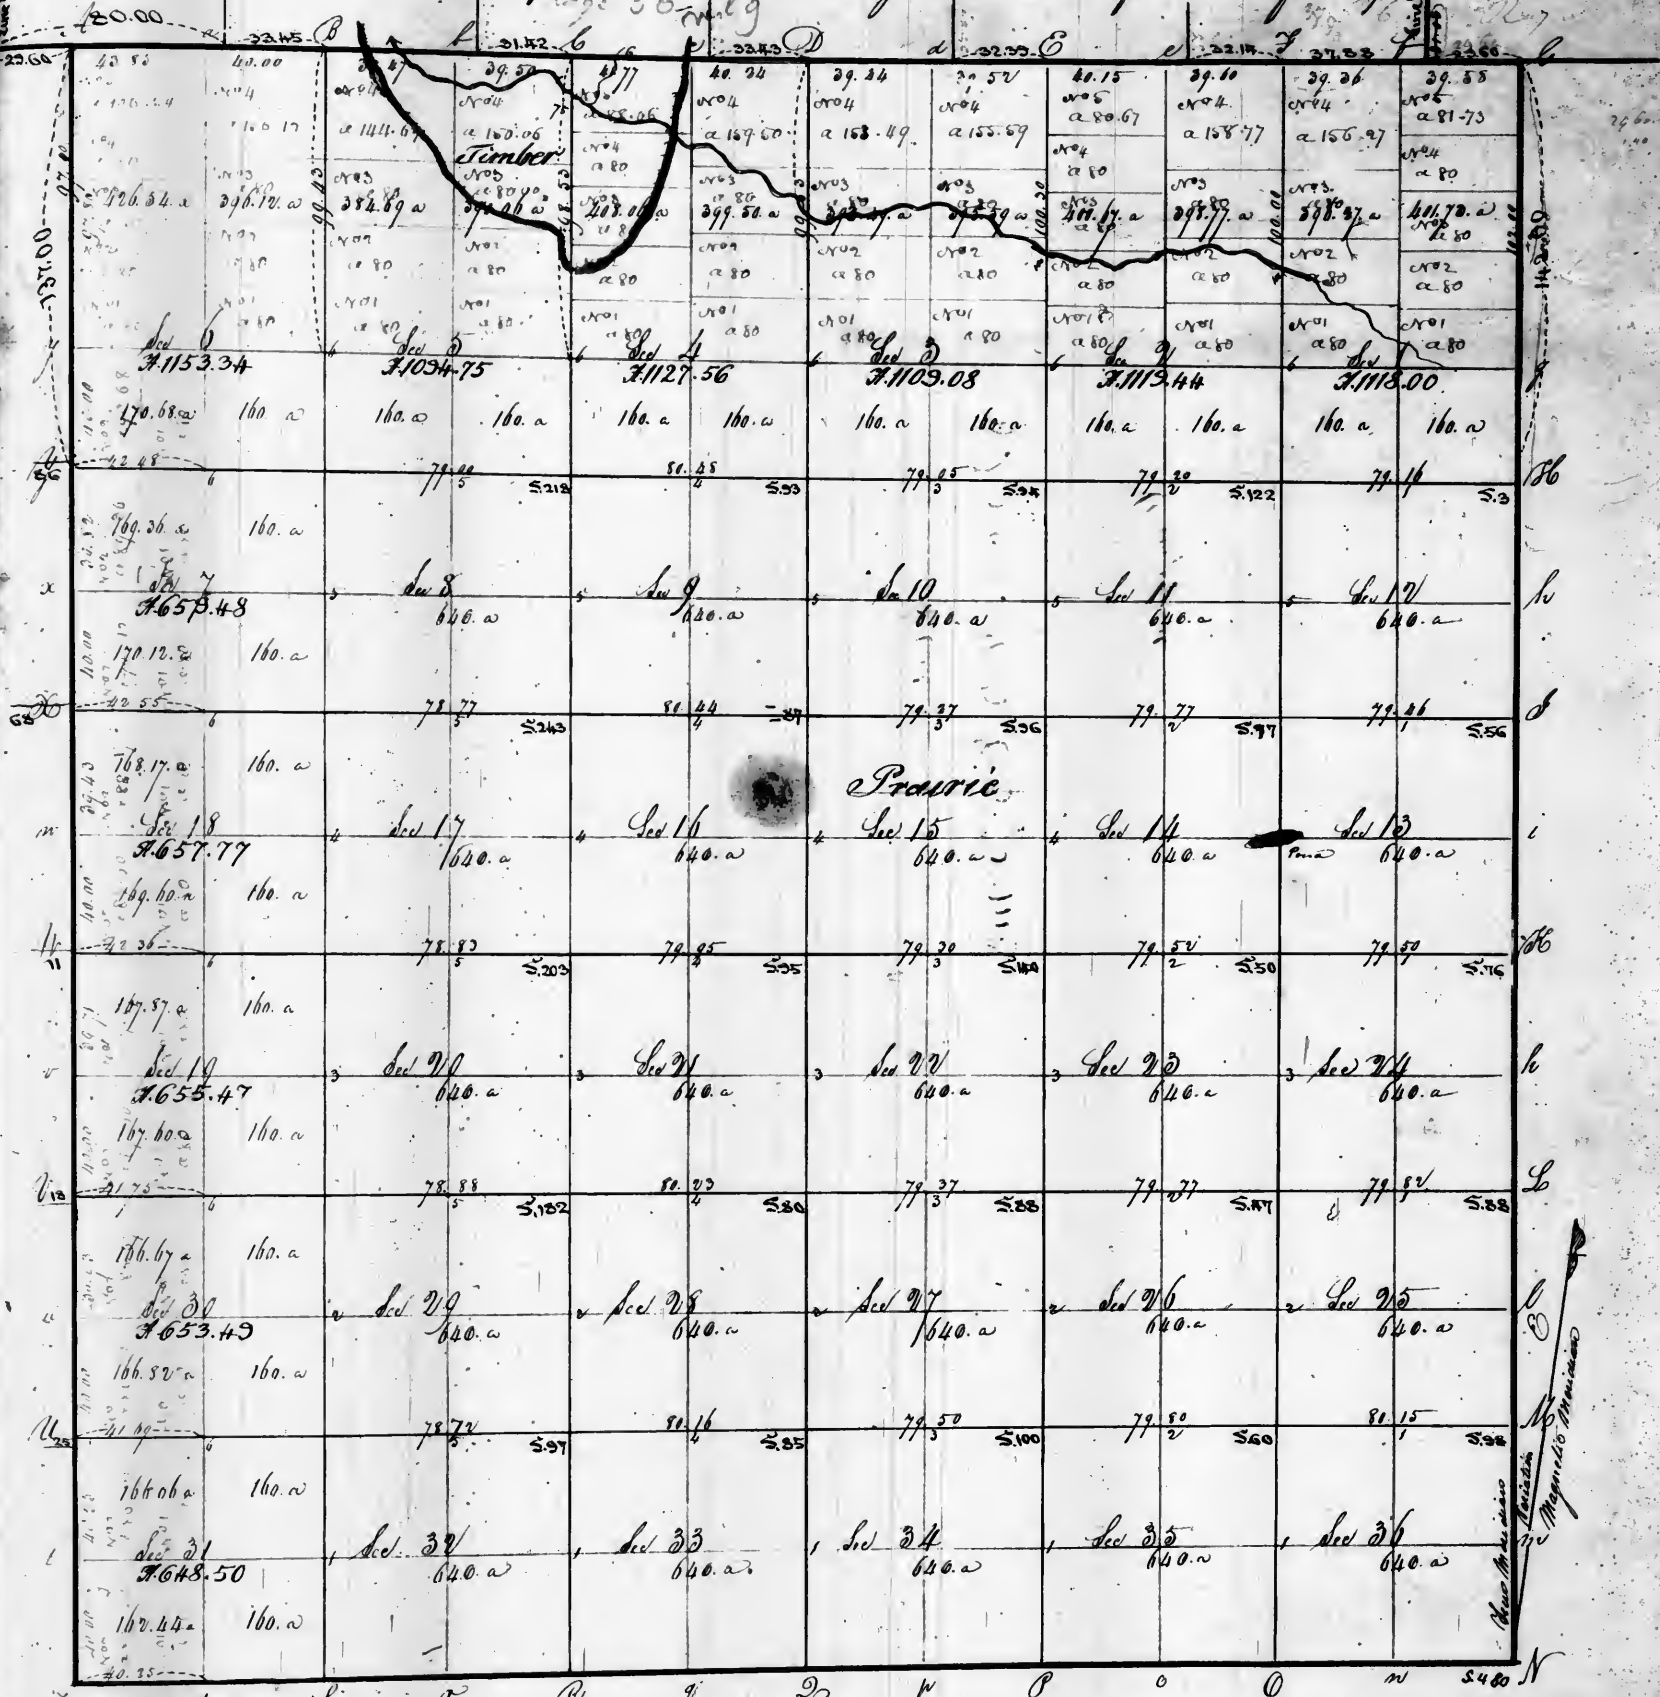

Aggregate area = 25996.88 ac.

Scale 40 Chains to an Inch


Pursuant to a contract with, and Instructions from, William Reiter Surveyor of the lands of the United States in the States of Illinois, Missouri and Territory of Arkansas, bearing date the third day of October 1890, I have administered, laid out and surveyed the above described Township, and do hereby certify that it has such marks both natural and artificial as are represented on said plat and returned with the field notes made thereof, and returned with this plat into the Office of the Surveyor of the lands of the United States in the States of Illinois and Missouri and Territory of Arkansas.

Certified this Jan. 20 1894

E. Reiter D. Surveyor

Examined and gave the Deputy Surveyor Duplicate certificate of the amount


base line, Range
C. page 5 C. mag

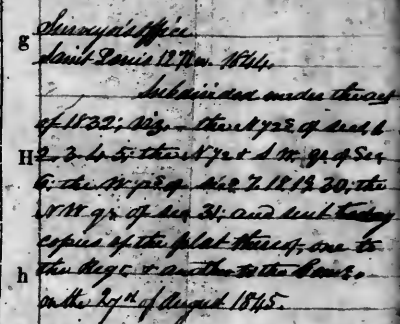

D. SUPERVISOR

EXAMINED.

Township No. 32 North of the base line, Range No. 6 East of the 3^d principal Meridian.

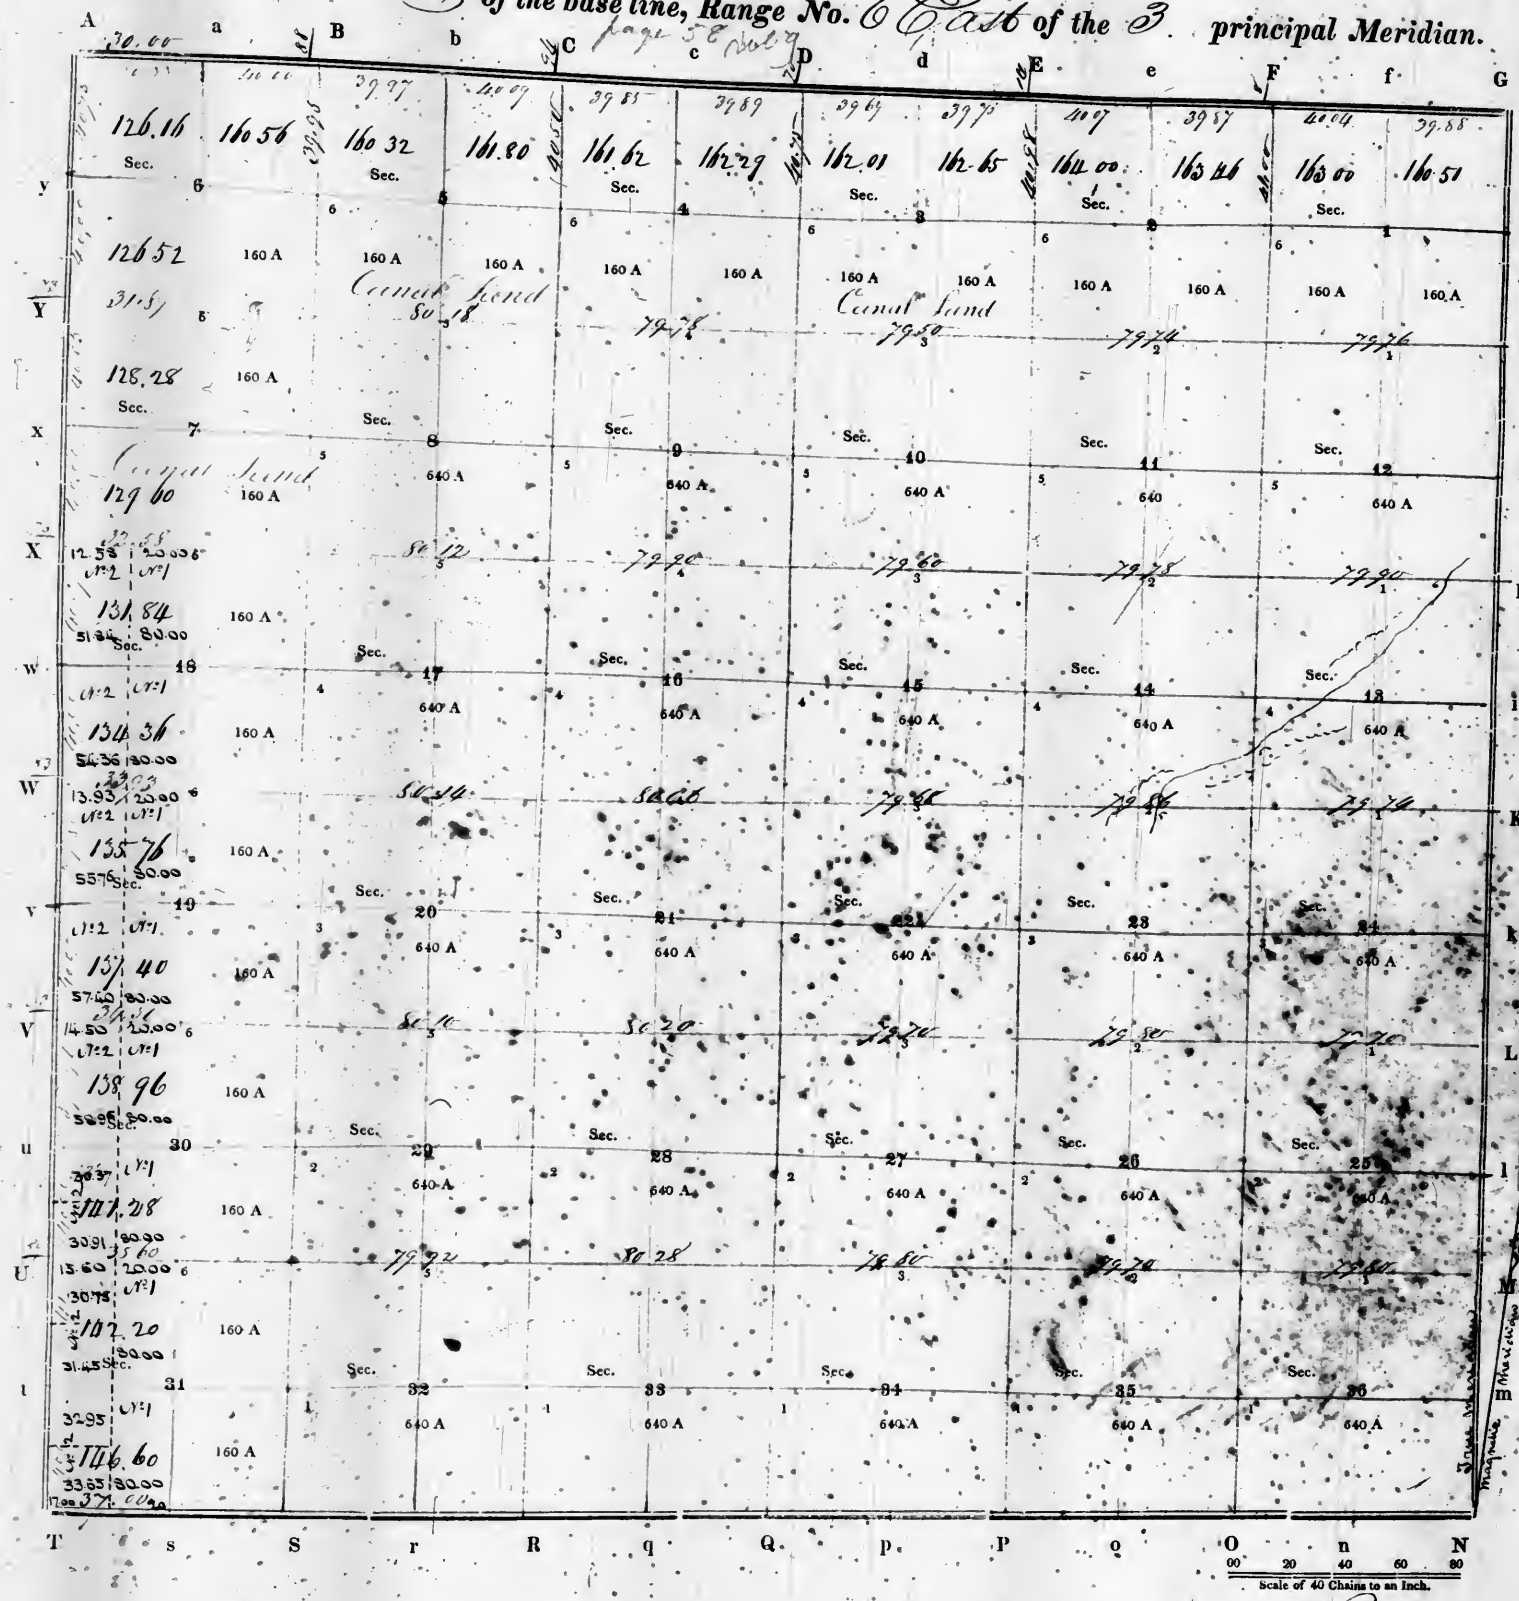

Surveyor's Office
the plat thereof, true to the Register,
and another to the Commissioner,
in 2^d August 1845.

PURSUANT to a contract with, and instructions from WILLIAM RECTOR, Surveyor of the lands of the United States in the State of Missouri & Territory of Arkansas bearing date the 20th day of March 1845


I have admeasured, laid out and surveyed the above described Township; and do hereby certify, that it had such marks and bounds, both natural and artificial, as are represented on said plat, and described in the field notes made thereof, and returned with this plat into the Office of the Surveyor of the lands of the United States, for the State of Missouri & Territory of Arkansas.

Certified this day of

EXAMINED.

D. SURVEYOR.

Township No 33. North of the Indian Range No 6 East of the 3^d Principal Meridian

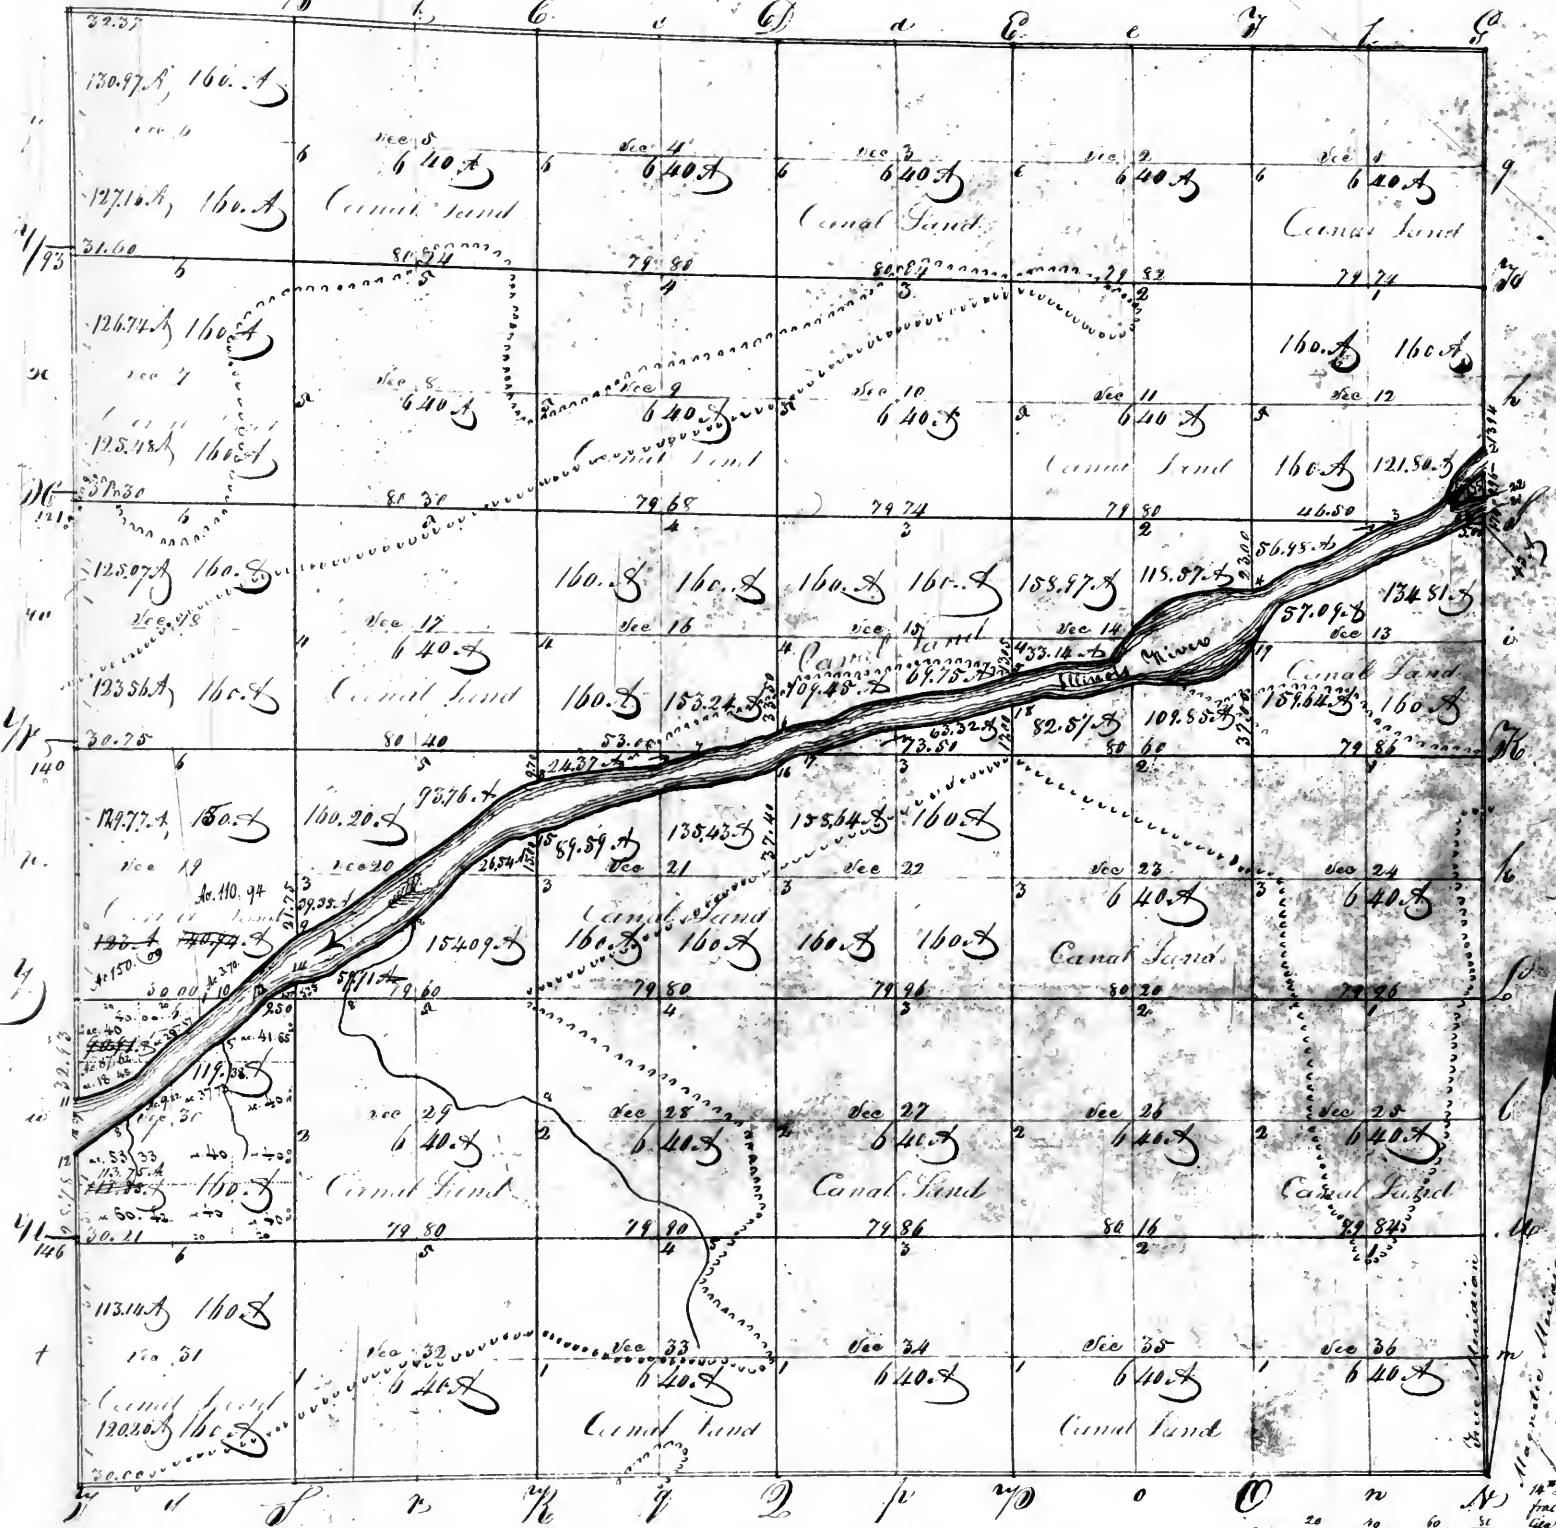


Pursuant to a contract with and instructions from William Victor Surveyor of the lands of the United States, in the States of Illinois and Missouri and Territory of Arkansas being date the 20th day of March 1841. I have accordingly laid out and surveyed the above described Township and do hereby certify that it has been marked and bounded both natural and artificial as are represented on said plat and describe in the field notes made thereof and returned with this plat into the office of the Surveyor of the lands of the United States, in the State of Illinois and Missouri and Territory of Arkansas.

14th Dec. 1840. A copy of the plat of this Township No 33 North of the Indian Range No 6 East of the 3^d Principal Meridian was sent to the State Land Office.

VOL 12

VOL. XII

Page 124

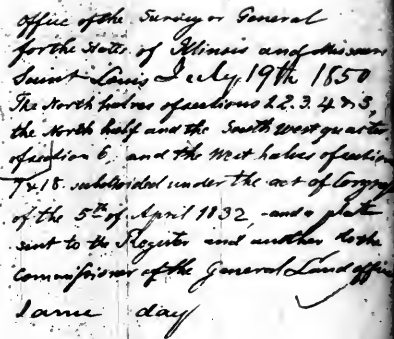


Certified 9th March 1819

John F. M. Collins D. S.
S. W. K. N. W. side U. S.

Recorded

486.

Township N. 3 N of the Base Line Range N. 7 East of the 3rd Principal Meridian

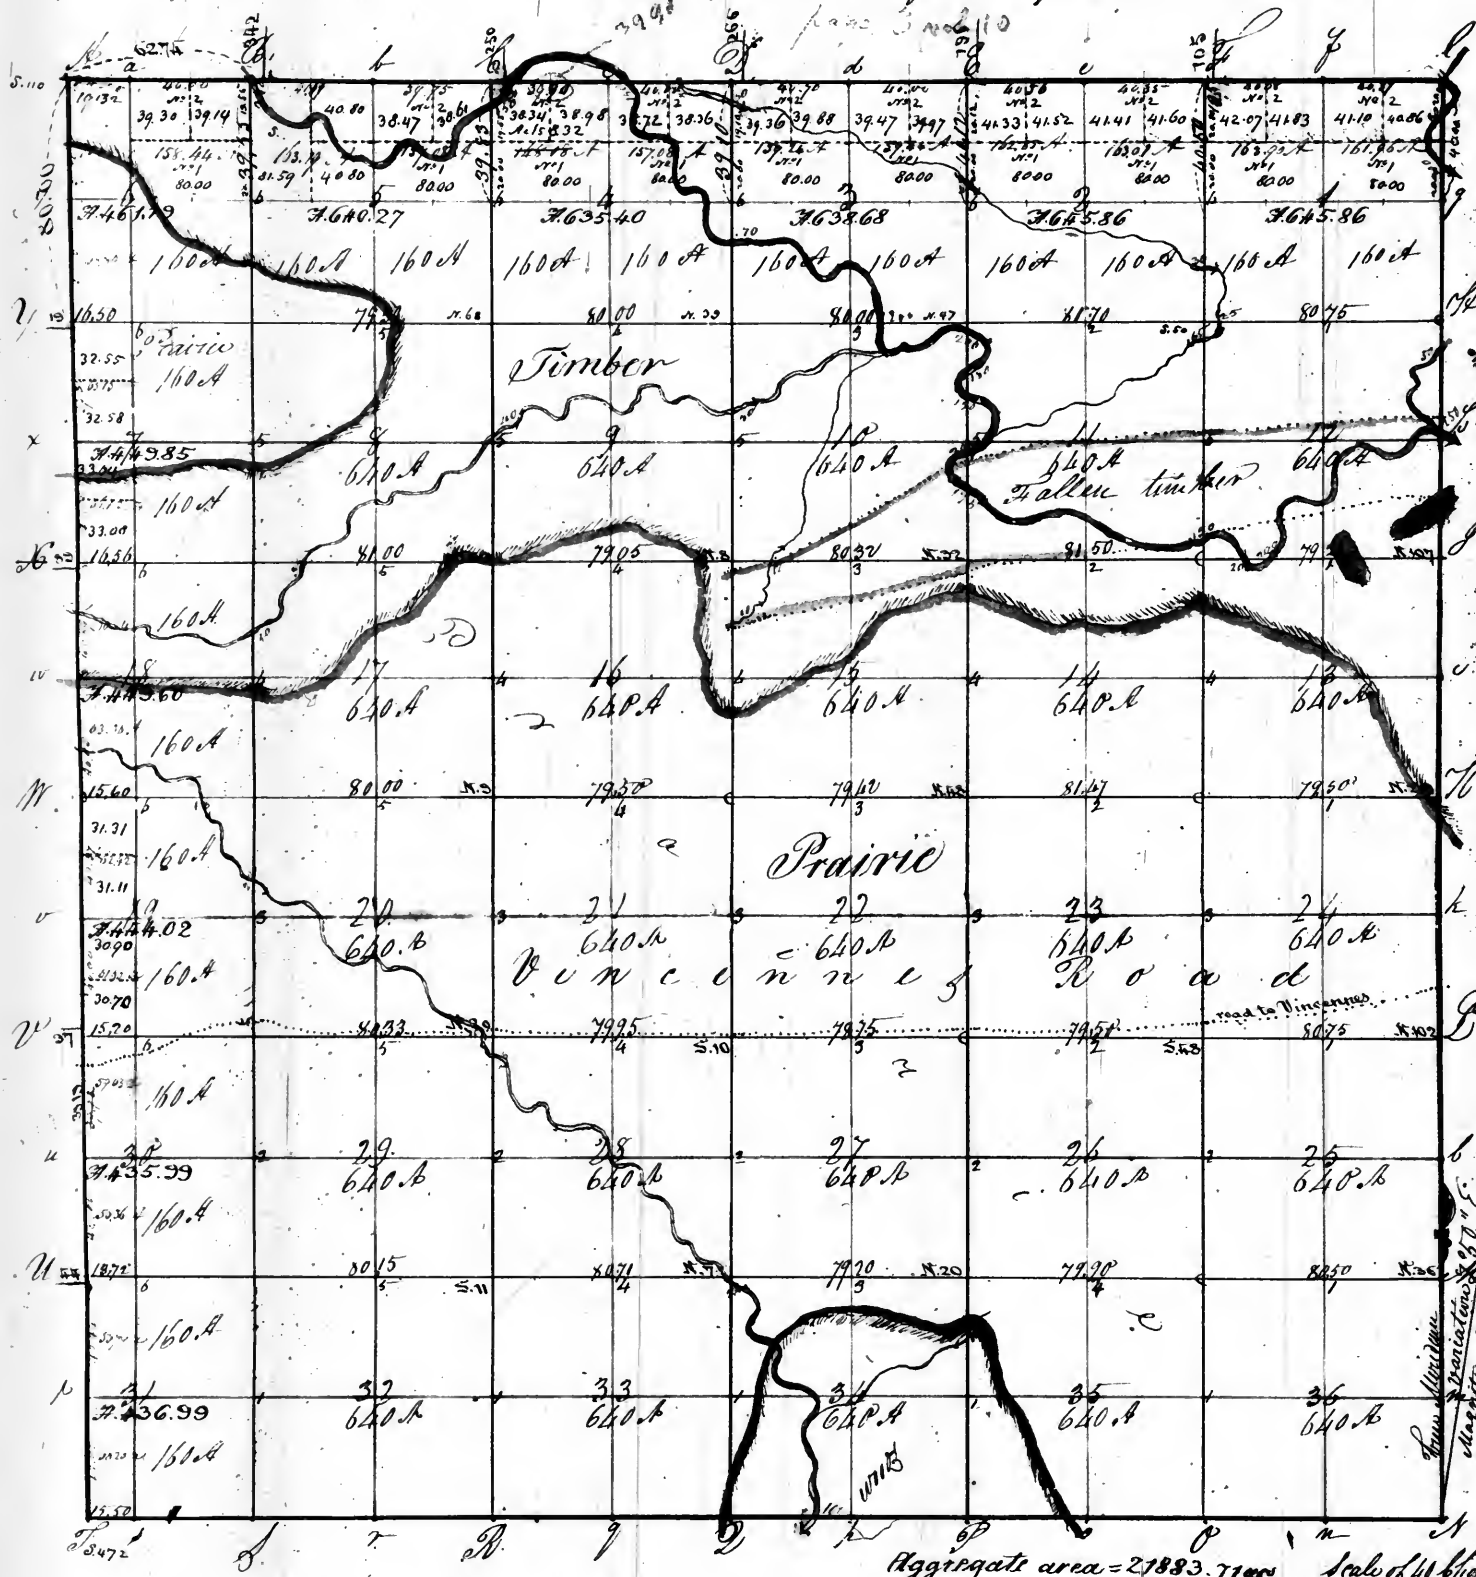

Office of the Surveyor General
for the State of Illinois and Missouri
another to the Commissioners of the
General Land Office.

Aggregate area = 21883.71 acres Scale of 1/4 inch = 1 mile


Pursuant to a contract with and instructions from William A. Rector Esq. Surveyor of the lands of the United States in the
Territories of Illinois and Missouri bearing date the 27 day of October 1848. We have accurately laid out and surveyed
the above described Township and do hereby certify that it has such marks and boundaries natural and artificial as are represented
on said plat and recorded in the field notes made thereof and returned with this plat into the office of the Surveyor of the lands of the United
States for the Territories of Illinois and Missouri

Certified 9th March 1849

J. W. White & S
John F. Collins & S

5

487.

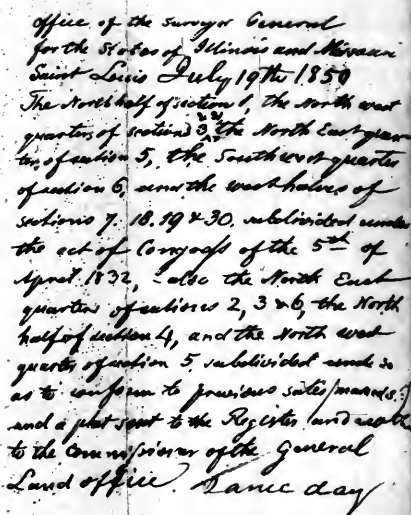

40 Chains to an Inch


Certified this 9th day of March 1819

Sto Whitby 23
Jno & M Collins D L

488

Township 5 North of the Base Line Range No. 7 East of the 3rd Principal Meridian

Page 5 of 10

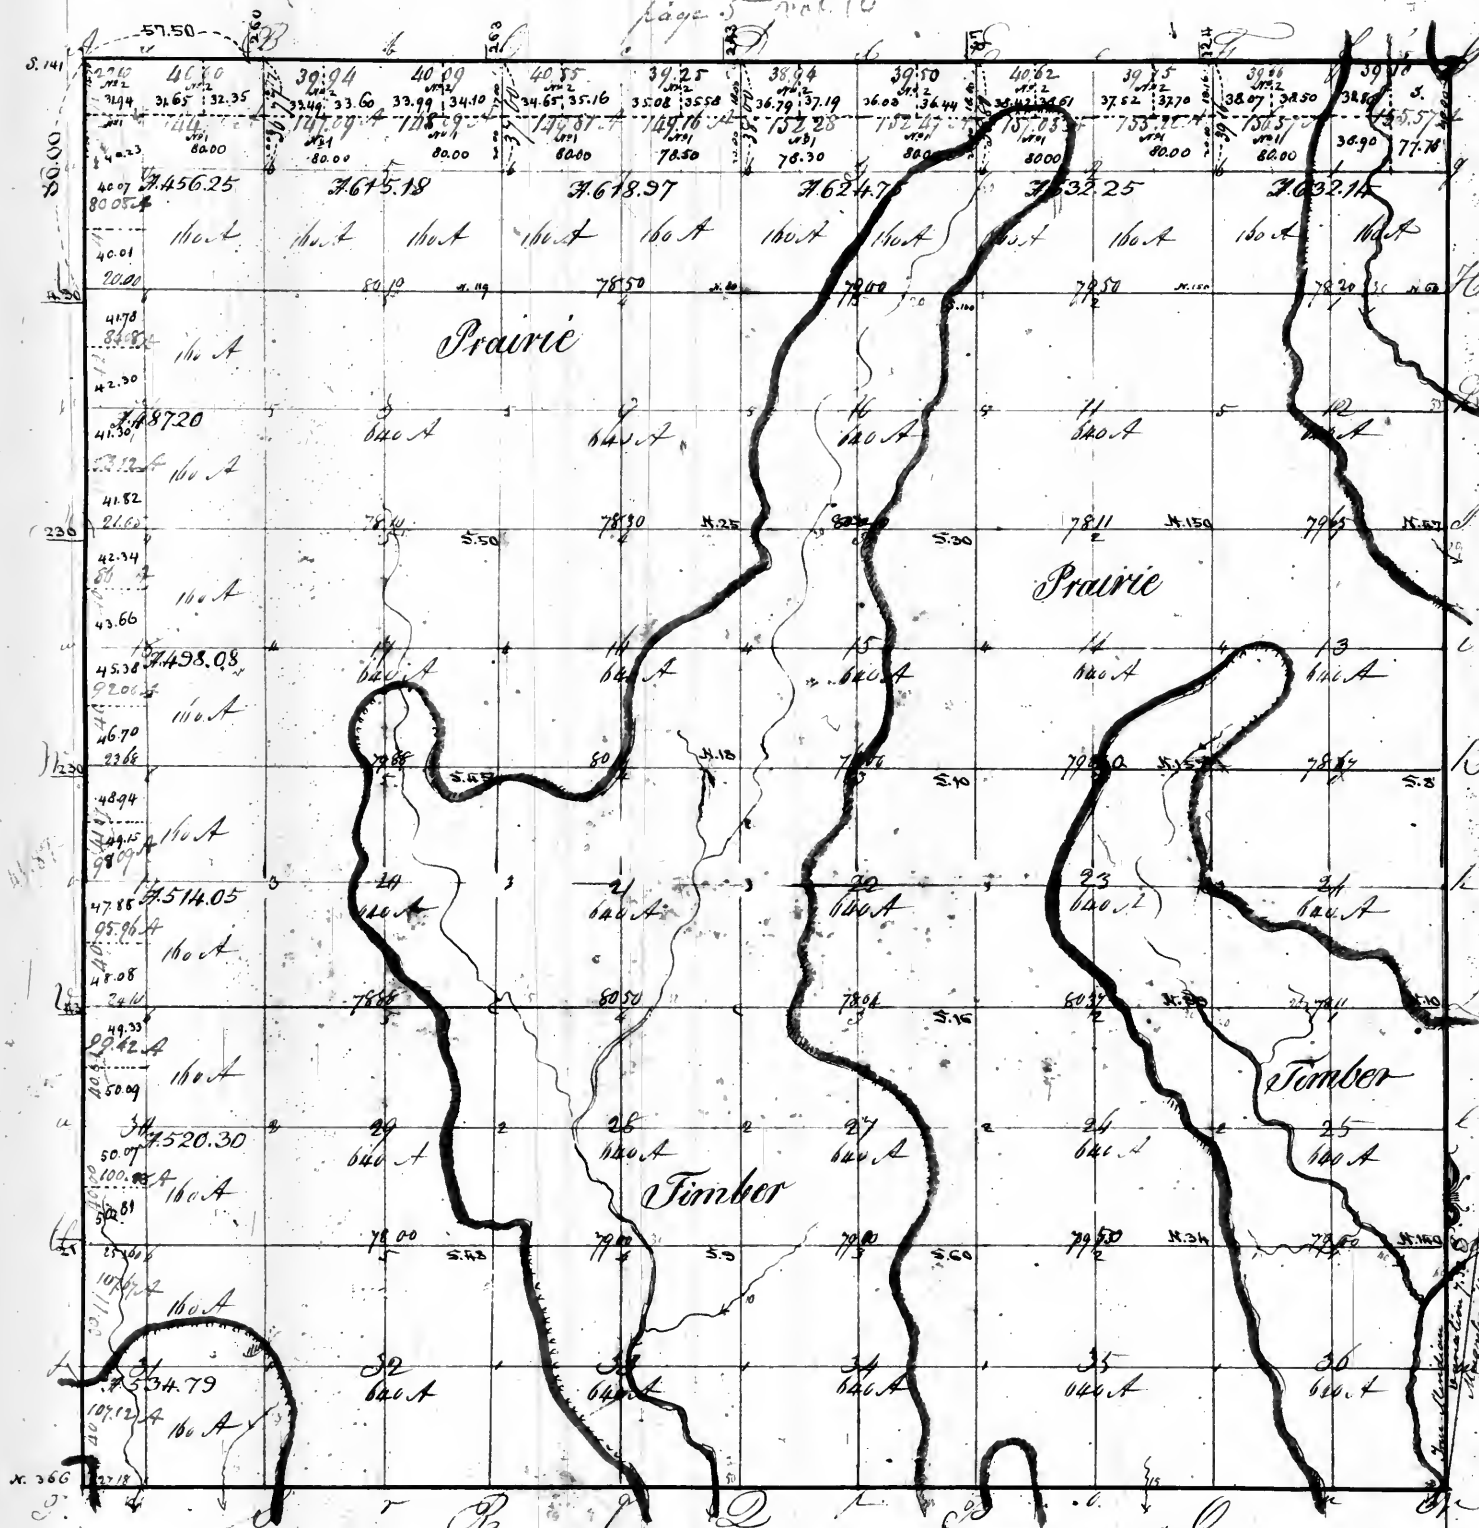

Office of the Surveyor General
for the States of Illinois and Missouri
Saint Louis July 19th 1859
The North west quarter of section 6, the
the North halves of sections 2, 3, 4 & 5, the
North half and the South West quarter of
section 6, and the West halves of sections
7, 18, 19 & 30, subdivided under the act
of Congress of the 5th of April 1832,
also the North East quarter of section 1,
subdivided so as to conform to a previous
sale; marked S. & J. - and a plat sent
to the Register and another to the
Commissioner of the General Land
office. Some day

Aggregate area = 22133.96 acs

Whereof 5 is covered with a subdivision from William Preston Esq. Surveyor of the Lands of the United States in the Territory of Illinois & Missouri bearing date the 27th day of October 1818. We have examined said plat & surveyed the above described Township, & do hereby certify that it had been marked & bounded both natural & artificial as are represented on said plat & described in the field notes made therefor & returned into the Office of the Surveyor of the Lands of the United States for the Territory of Illinois & Missouri.
Certified this 9th day of March 1849

Wm. H. Phillips Esq.
John F. McCallum Esq.


Recorded

6

489

Township N. 6 North of the Base Line Range No. 7 East of the 3rd principal Meridian

page 6 of 10

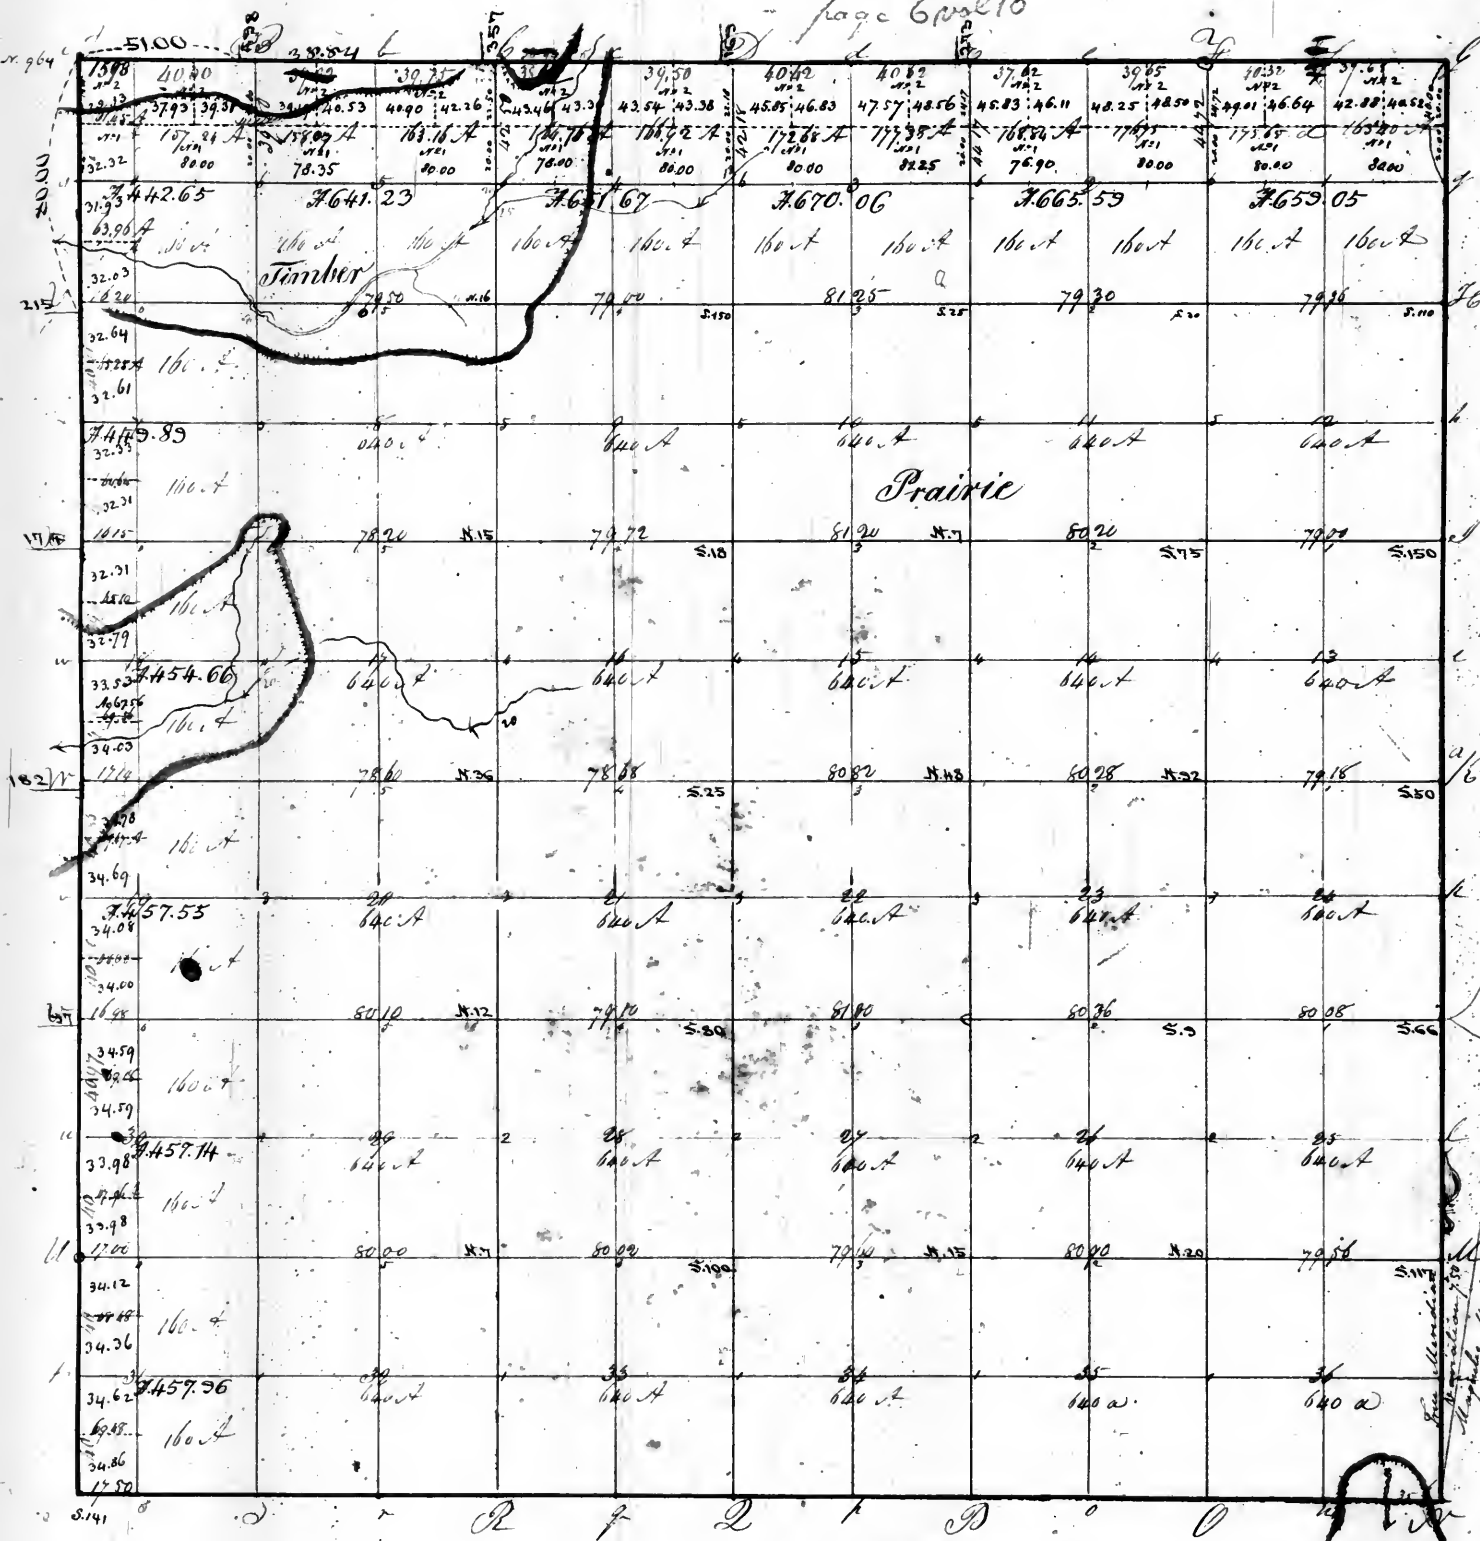

Office of the Surveyor General
for the State of Illinois and Missouri
Saint Louis July 19th 1850
The north halves of sections 1, 2, 3, 4 & 5,
the north half north west quarter
of section 6, and the east halves of
sections 7, 18, 19, 30 & 31, relative to the
the act of Congress of the 5th of April 1832
and a plat sent to the Register and under
to the Commissioner of the General
Land office same day

Aggregate area: 22007.45 ac

40 Chains to an inch

Surveyed by a contract with instructions from William Reeder Esq. Surveyor of the Lands of the United States in the Territory of Illinois & Missouri bearing date the 27th
day of October 1818. It was then and since surveyed the above described Township & its hereby certify that it had such marks & bounds both natural & artificial as are referred
to on the plat & described in the plat notes made there of & returned with this plat into the Office of the Surveyor of the Lands of the United States for the Territory of Illinois & Missouri

Certified this 9th day of March 1850


W. D. Whiteside Esq
John H. Collins Esq

Recorded

~~#89~~ ~~#17~~
490

Township 10 North of the base line Range No. 7 East of the 3rd Principal Meridian

page 7 vol 10

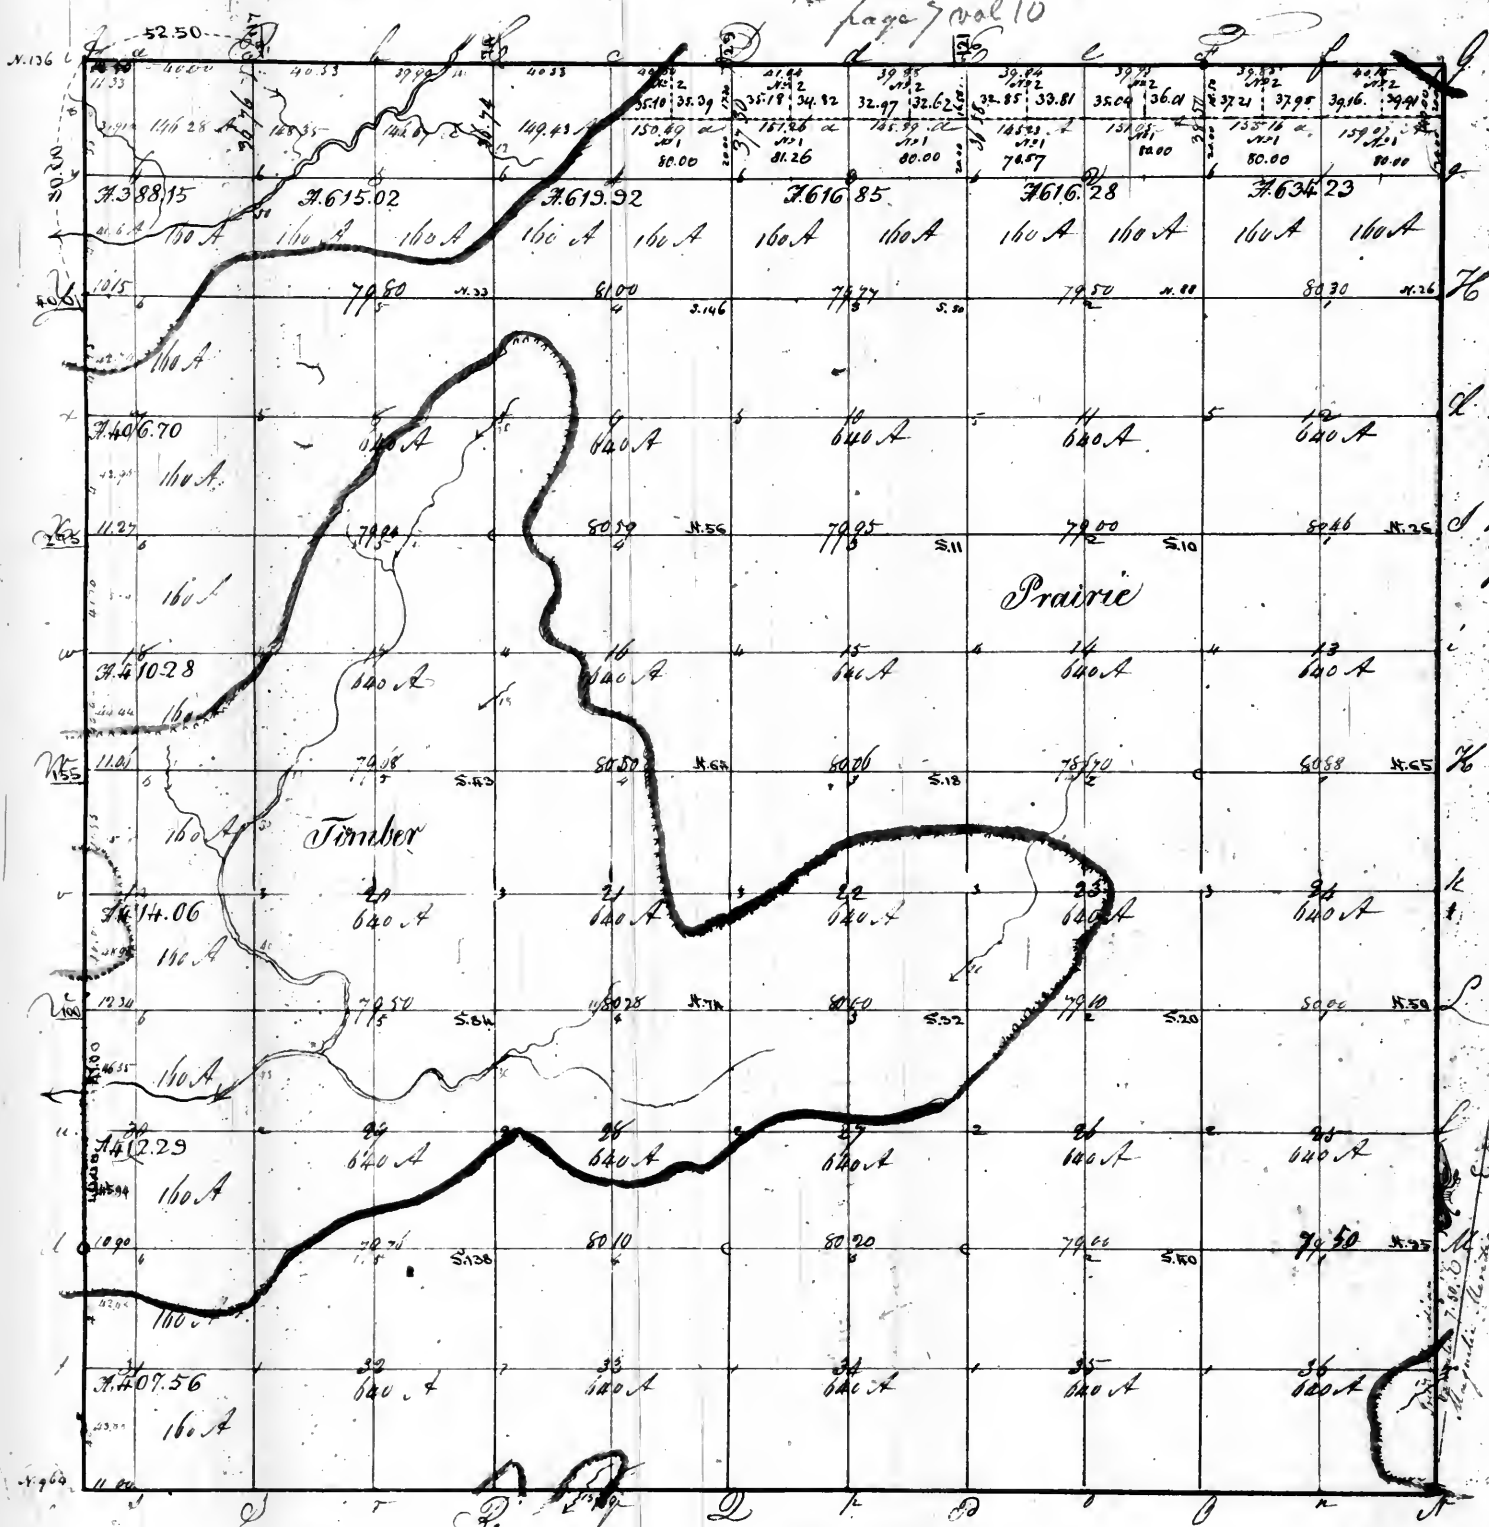

Office of the Surveyor General
for the State of Illinois and Missouri
Saint Louis July 19th 1858
The North half of section 1, 2 & 3
and the North East quarter of section
4, subdivided under the act of Congress
of the 5th of April 1832, and a
plot sent to the Register and
another to the Commissioner of the
General Land Office same day

Aggregate area = 21541.34 ac

40 Chains to an Inch

1858-59, continued with instructions from William Keeler Esq. Surveyor of the Lands of the United States in the Territory of Illinois & Missouri bearing date the 27th day
of October 1858 We have administered and out Surveyed the above described Township & hereby certify that it has such marks & bounds both natural & artificial
as are mentioned on said plat & described in the field notes made thereof & returned with the plat into the office of the Surveyor of the Lands of the United States for the Territory
of Illinois & Missouri.


certified this 9th day of March 1859

Wm. D. Whitledge
John F. McCallum

Township N. 8 North of the Park and Range 7 East of Principal Meridian

page 8 vol 10

#8
491

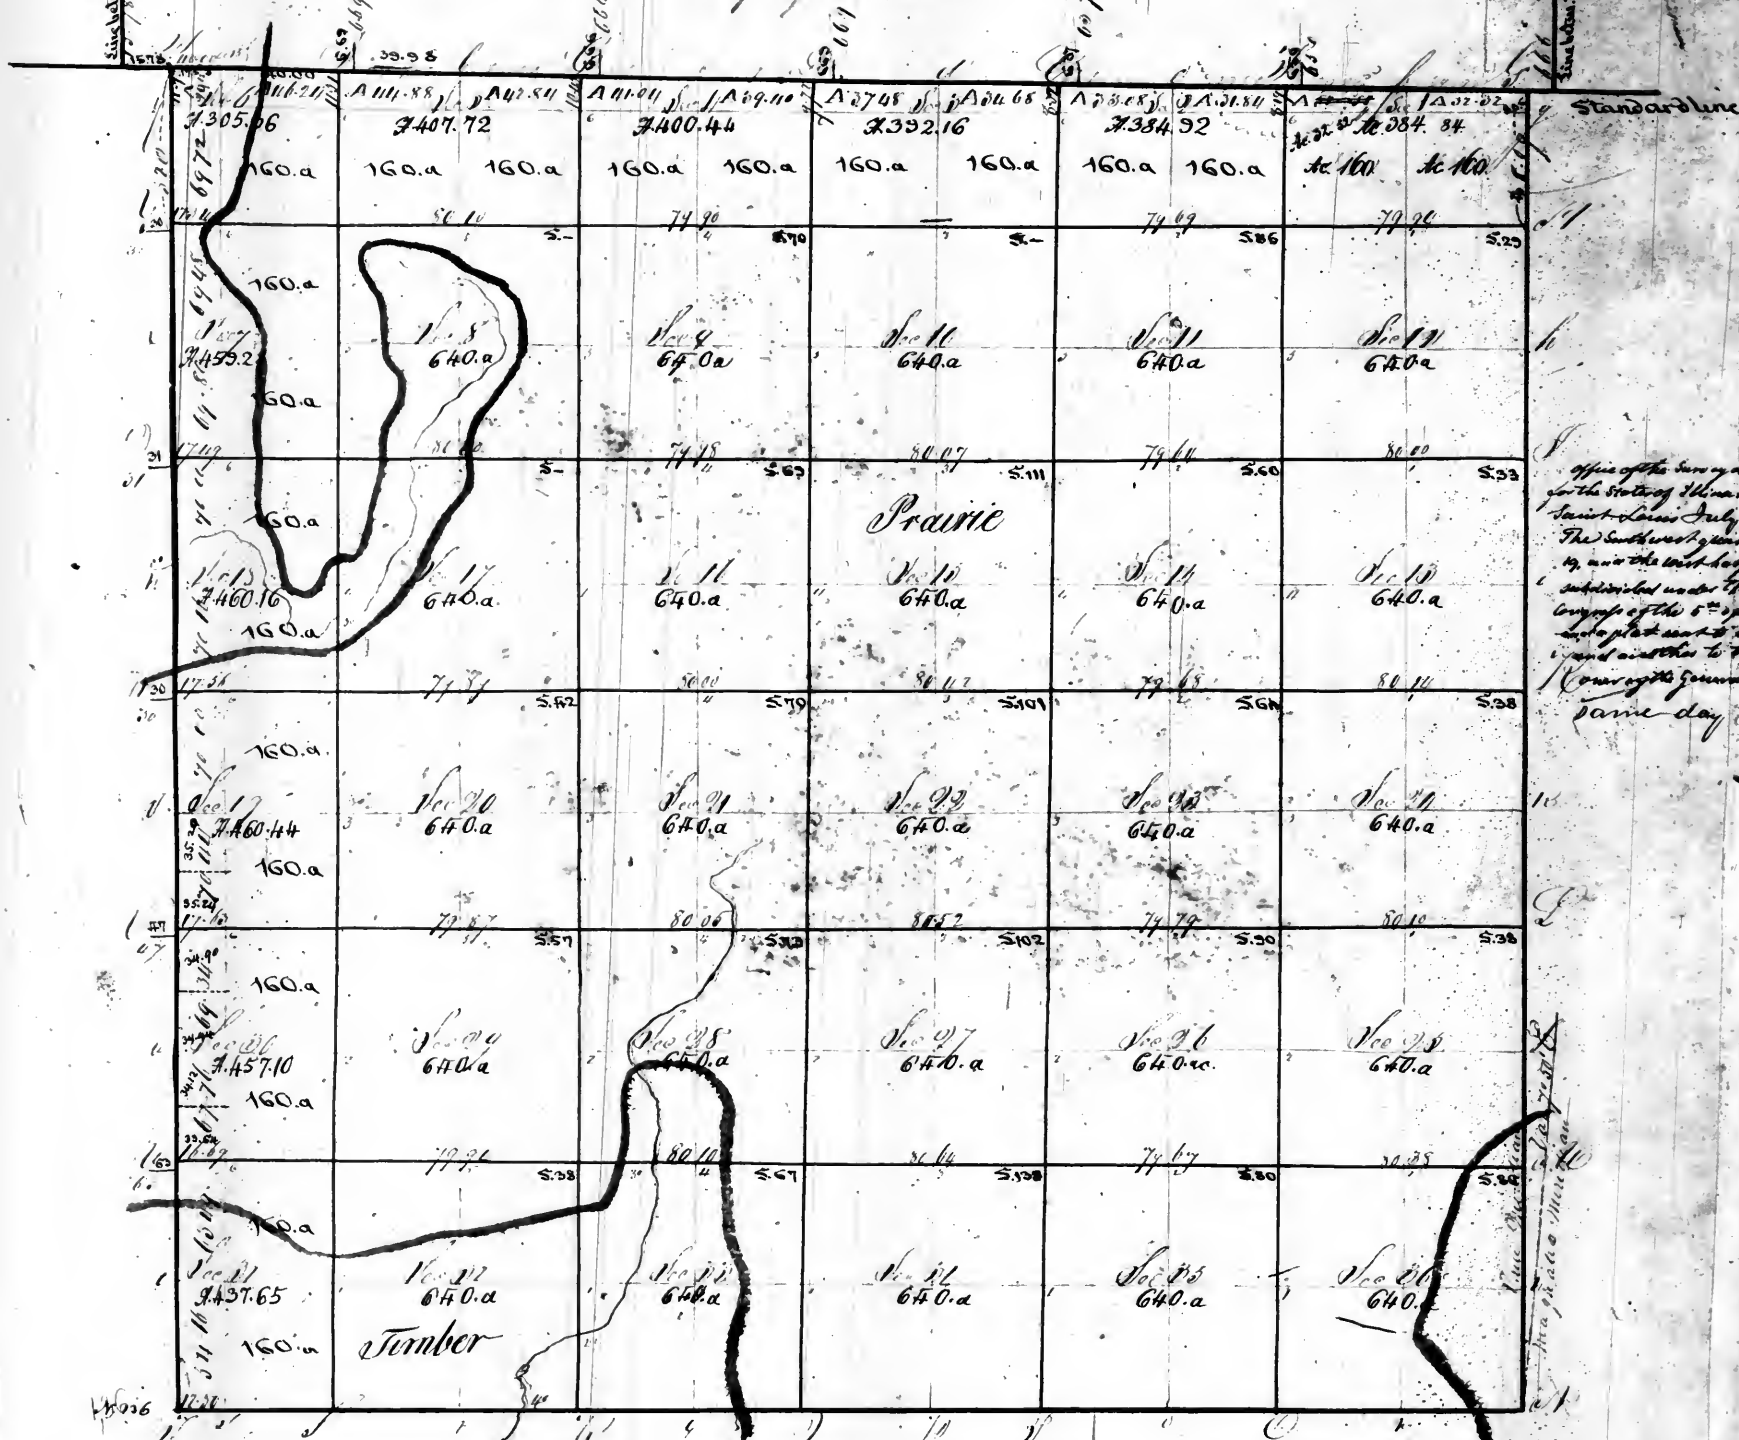

Office of the Surveyor General
for the State of Illinois
The Surveyor General of the
State of Illinois is hereby
subscribed under the act of
Congress of the 5th of April 1832
and a plat made of the
same and is to be
the same day

Aggregate area - 20550.07 ac

Scale of 1/2 inch to 1 mile


Surveyor's Office
The area of the 1/4 section of the township
the figures representing the former and
and a copy of the plat of said quarter
to the Register of the district and
General Land Office

William Miller
Surveyor General
In pursuance to a contract with and instructions from William Porter Surveyor of the
lands of the United States for the State of Illinois and Territory of Wisconsin and
and a plat made of the same and is to be the same day
I have a measure and laid
out and surveyed the above described Township; and do hereby certify that
it had been made by and under both natural and artificial as and represented on
said plat and described in the field notes made thereof and returned with the
plat into the Office of the Surveyor of the Lands of the United States for the
State of Illinois and Territory of Wisconsin and Arkansas

page 9 vol 10

492

Township No. 9 North of the base line, Range No. 7 East of the 3rd principal Meridian.

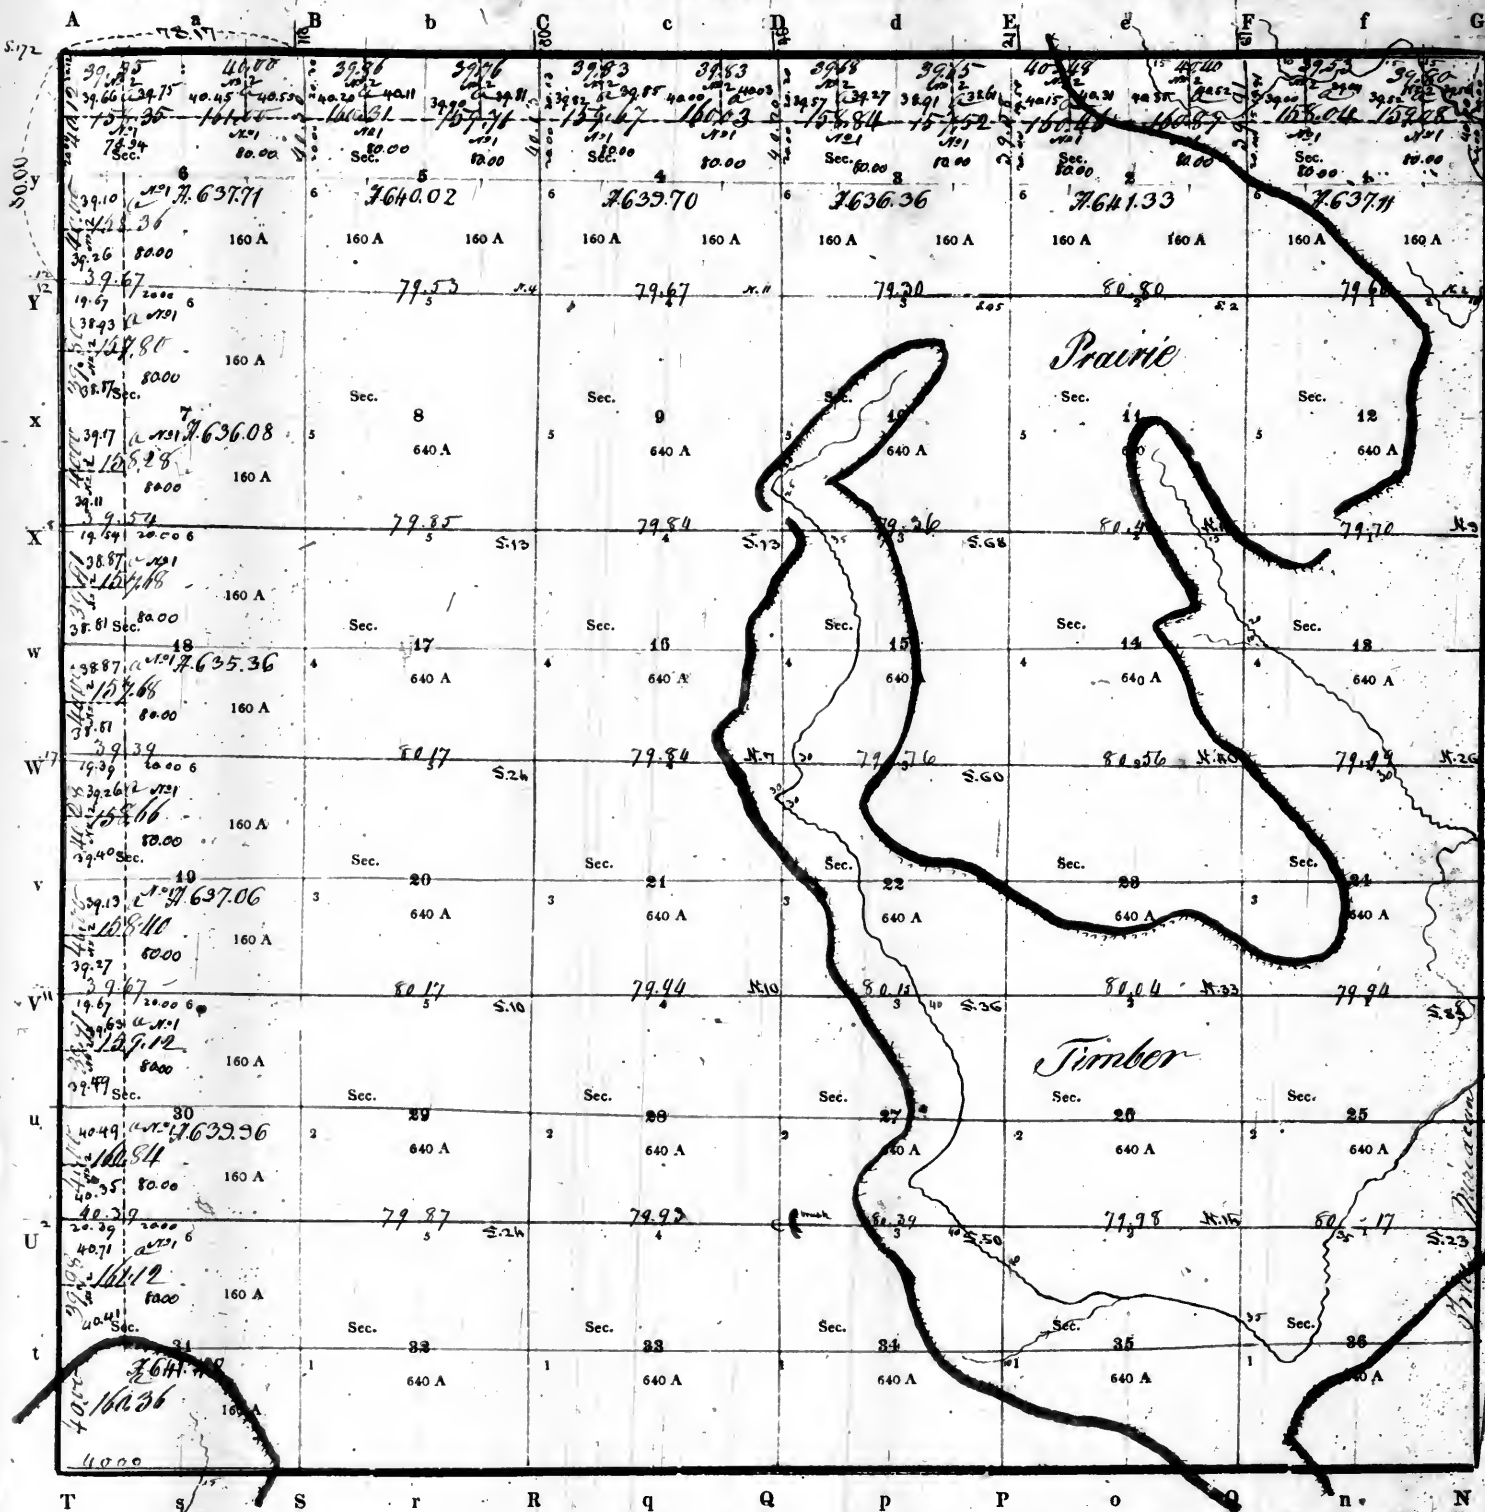

Office of the Surveyor General
for the State of Illinois and Missouri
Surveyed July 19th 1857
The north halves of sections 1, 2, 3, 4, 5, the North halves and the South
West quarters of sections 6, the West
halves of sections 7, 12, 19 & 30, and
the North West quarter of section
31, subdivided under the act of
Congress of the 5th of April 1832
and a plat sent to the Register
and another to the Commissioner
of the General Land Office
same day

Aggregate area = 23022.18 ac.

Scale of 40 Chains to an Inch.

PURSUANT to a contract with, and instructions from WILLIAM RECTOR, Surveyor of the lands of the United States in the State of Illinois and Territories of Missouri & Arkansas - bearing date the 18th day of May 1890.

I have admeasured, laid out and surveyed the above described Township; and do hereby certify, that it had such marks and bounds, both natural and artificial, as are represented on said plat, and described in the field notes made thereof, and returned with this plat into the Office of the Surveyor of the lands of the United States, for the State of Illinois & Territories of Missouri & Arkansas.

Certified this 10th day of October 1890

EXAMINED.

James Connard, SURVEYOR.


Stephen Rector, Esq.

August 1890

Recorded

10

Township No. 10 North of the base line, Range No. 7 East of the 3rd principal Meridian.

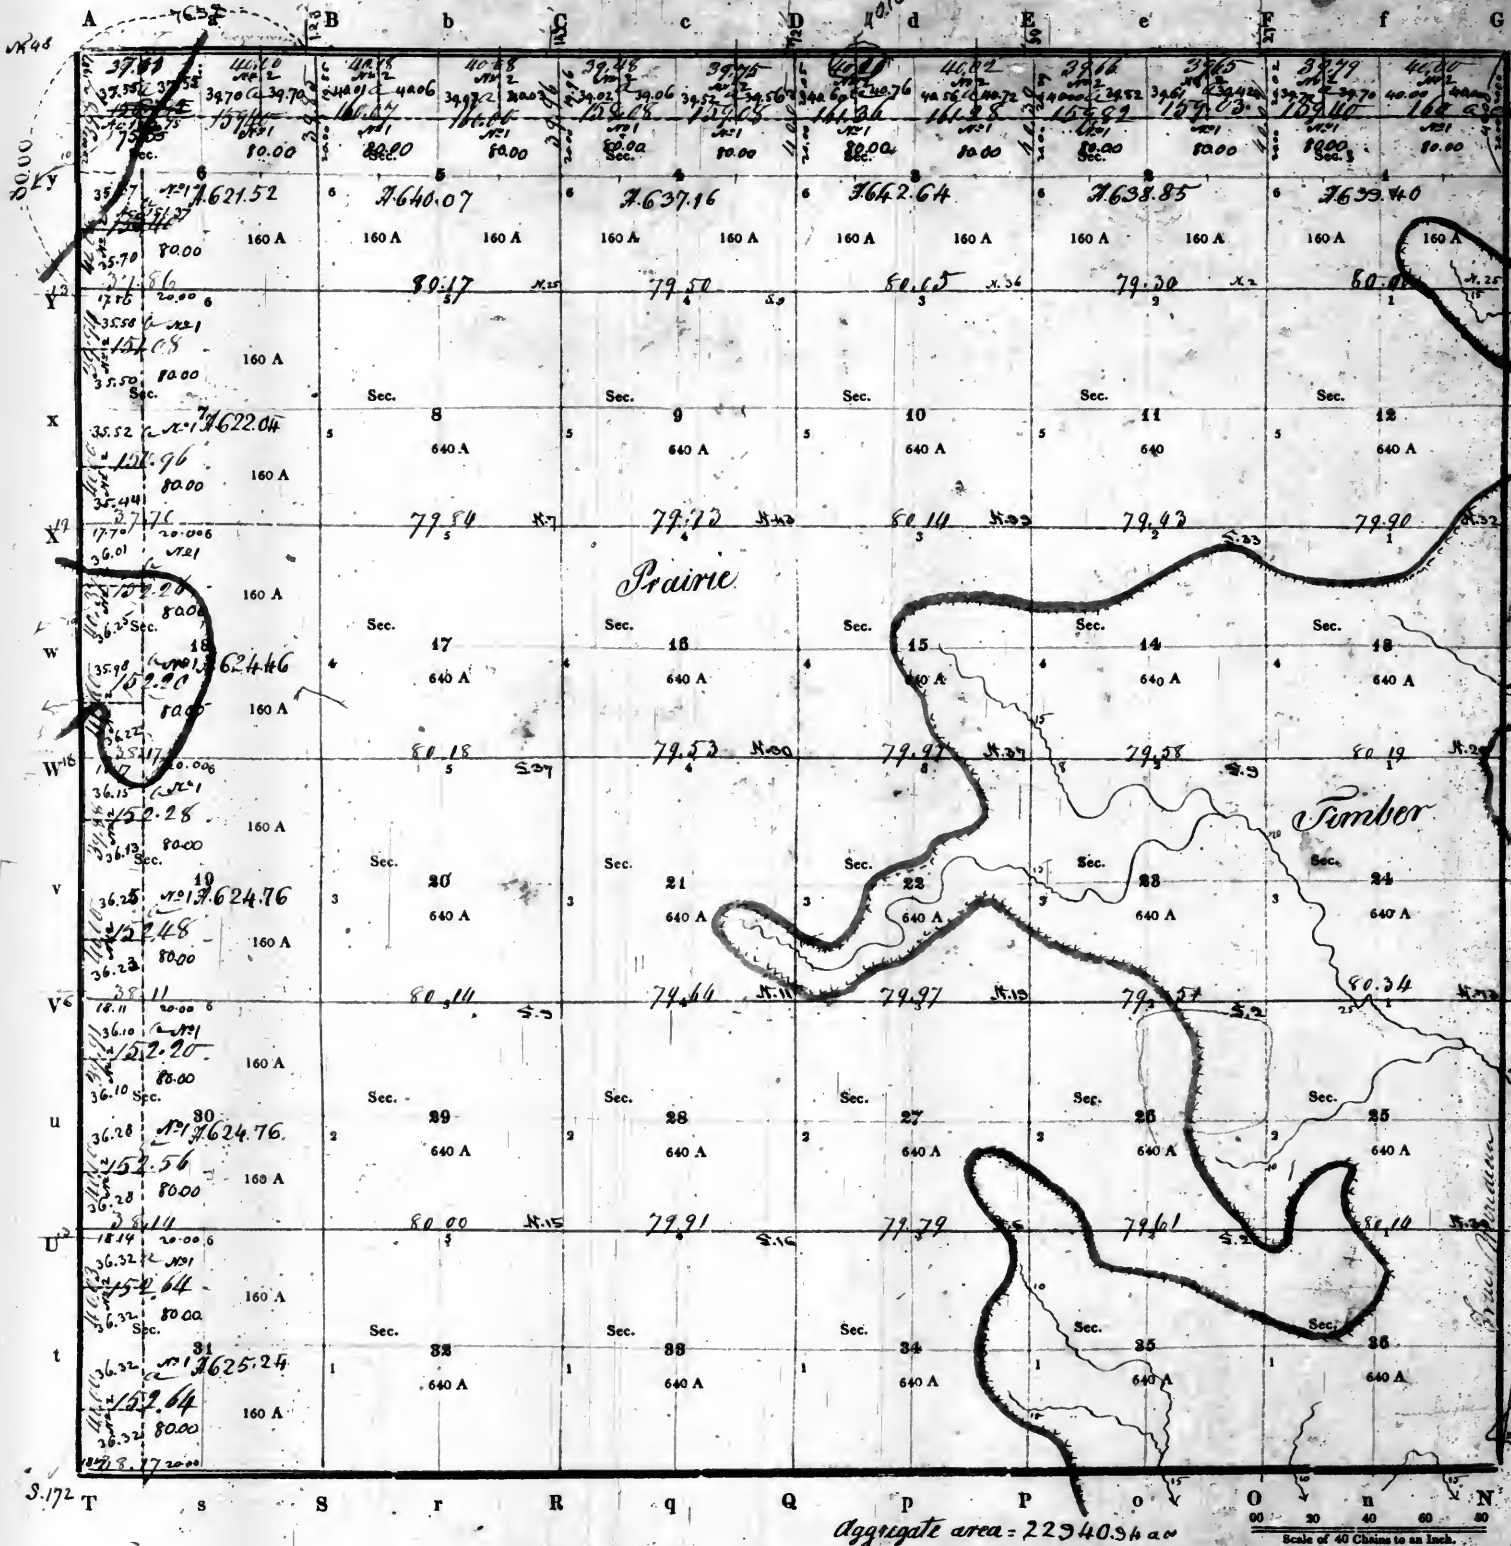

Office of the Surveyor General
for the State of Illinois and Missouri
Saint Louis July 19th 1857

PURSUANT to a contract with, and instructions from WILLIAM RECTOR, Surveyor of the lands of the United States in the State of Illinois and Territories of Missouri & Arkansas bearing date the 18th day of May 1870
I have admeasured, laid out and surveyed the above described Township; and do hereby certify, that it had such marks and bounds, both natural and artificial, as are represented on said plat, and described in the field notes made thereof, and returned with this plat into the Office of the Surveyor of the lands of the United States, for the State of Illinois & Territories of Missouri & Arkansas
Certified this 10th day of October 1870


EXAMINED.

James Connor D. SURVEYOR
for
Stephen Rector D.S.
August 1870

Recorded *494*

Township No 11 North of the base line Range No 7 East of the 3^d Principal Meridian

11

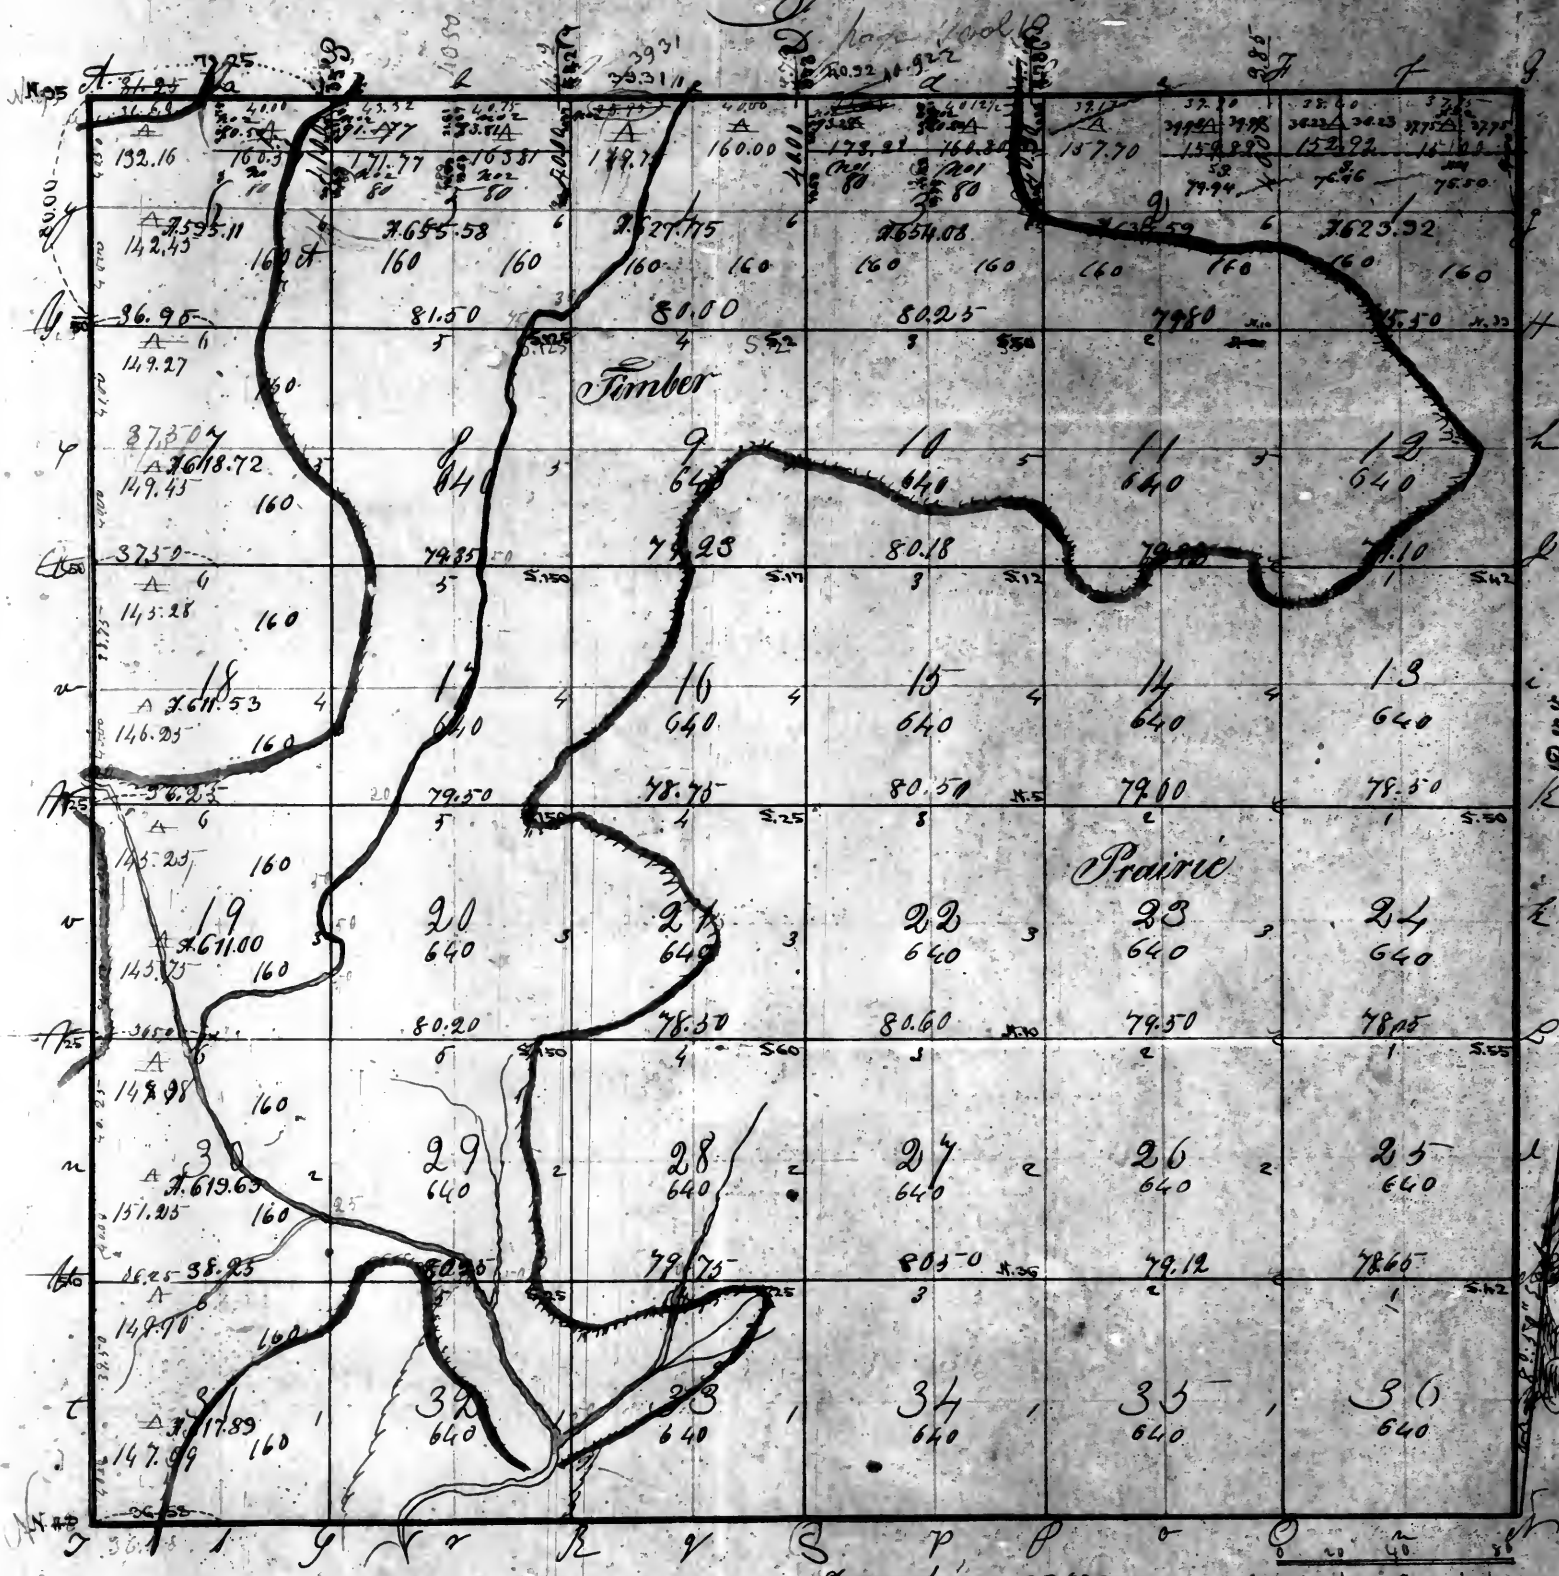

Surveyor's Office
St. Louis Mo August 1821
That if the North halves
of Sect 24 5, and of the
N.E. 1/4 of Sec 6, sent this
day to the Commr of the
Genl L.O.

Aggregate area - 22872.80 acs Scale 1 in showing 1000 yds

478
354
93

Pursuant to a Contract with & instructions from William Burtor Surveyor of the Lands of the United States, in the States of Illinois & Missouri bearing date the 6th day of March A.D. 1821. I have accordingly laid out & surveyed the above described Township, & do hereby certify that it has such marks & bounds both natural & artificial as are represented on said plat & described in the field notes made thereof & returned with this plat into the Office of the Surveyor of the Lands of the United States for the States of Illinois & Missouri.

Witness my hand & seal this 1st day of July A.D. 1821

Am. Blandram N. Surveyor

Office of the Surveyor General
for the States of Illinois & Missouri
Saint Louis July 19th 1850
The North East quarter of section 1, relinquished under the act
of Congress of the 6th of April 1833, and the North West quarter
of section 1, and the North East quarter of section 2, relinquished
as to conform to previous sales (marked 3), and a plat sent
to the General Land Office at St. Louis, Mo.


Reconnoiter

12

Township No 12, North of the base line, Range No 7, East of this principal meridian.

495

page 12 vol 10

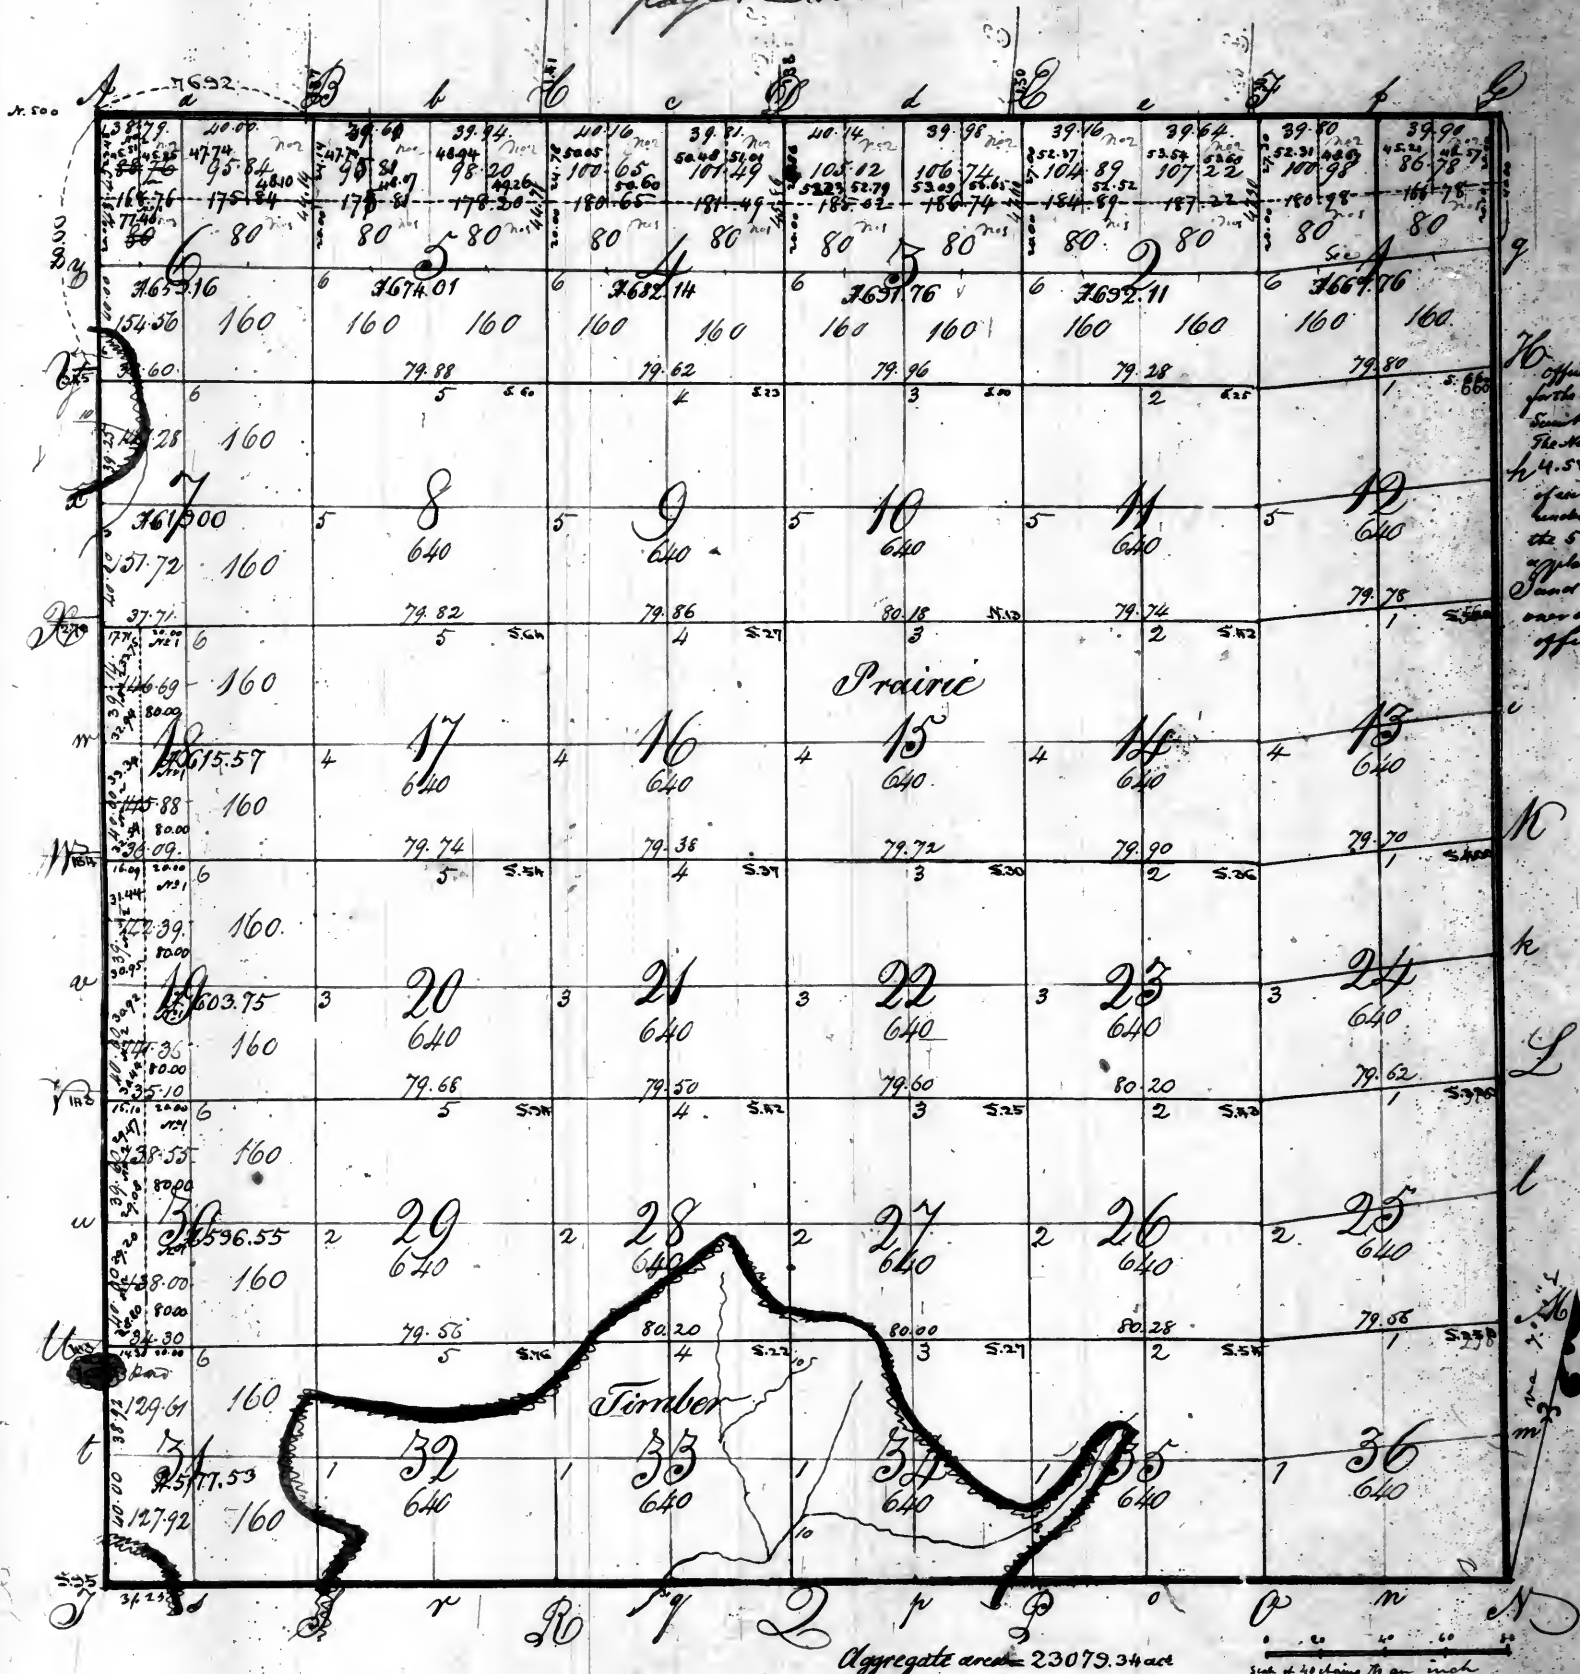

Office of the Surveyor General
for the State of Illinois and Missouri
The North halves of sections 1, 2, 3,
4, 5, 6, and 16 West halves
of sections 10, 19, 30, containing
under the act of Congress of
the 5th of April 1832, and
applied out to the Register
and another to the Commissioner
of the General Land
office at St. Louis day

Pursuant to a contract with, and instructions from William Greaser, Surveyor of the lands of the United States, for the States of Illinois & Missouri Territory of Arkansas, bearing date the 5th day of March 1822, I have admeasured, laid out & surveyed the above described Township, and do hereby certify, that it has such bounds & marks both natural & artificial, as are represented in said plat, and deposited in the field notes made thereof, and returned with this plat into the Office of the Surveyor of the lands of the United States, for the States of Illinois & Missouri Territory of Arkansas.


Certified this 24th day of June 1822.

A. H. Cantrancey U.S.

Recorded

496

Township No 13 North of the base line Range No 7 East of the third principal meridian
page 13 vol 10

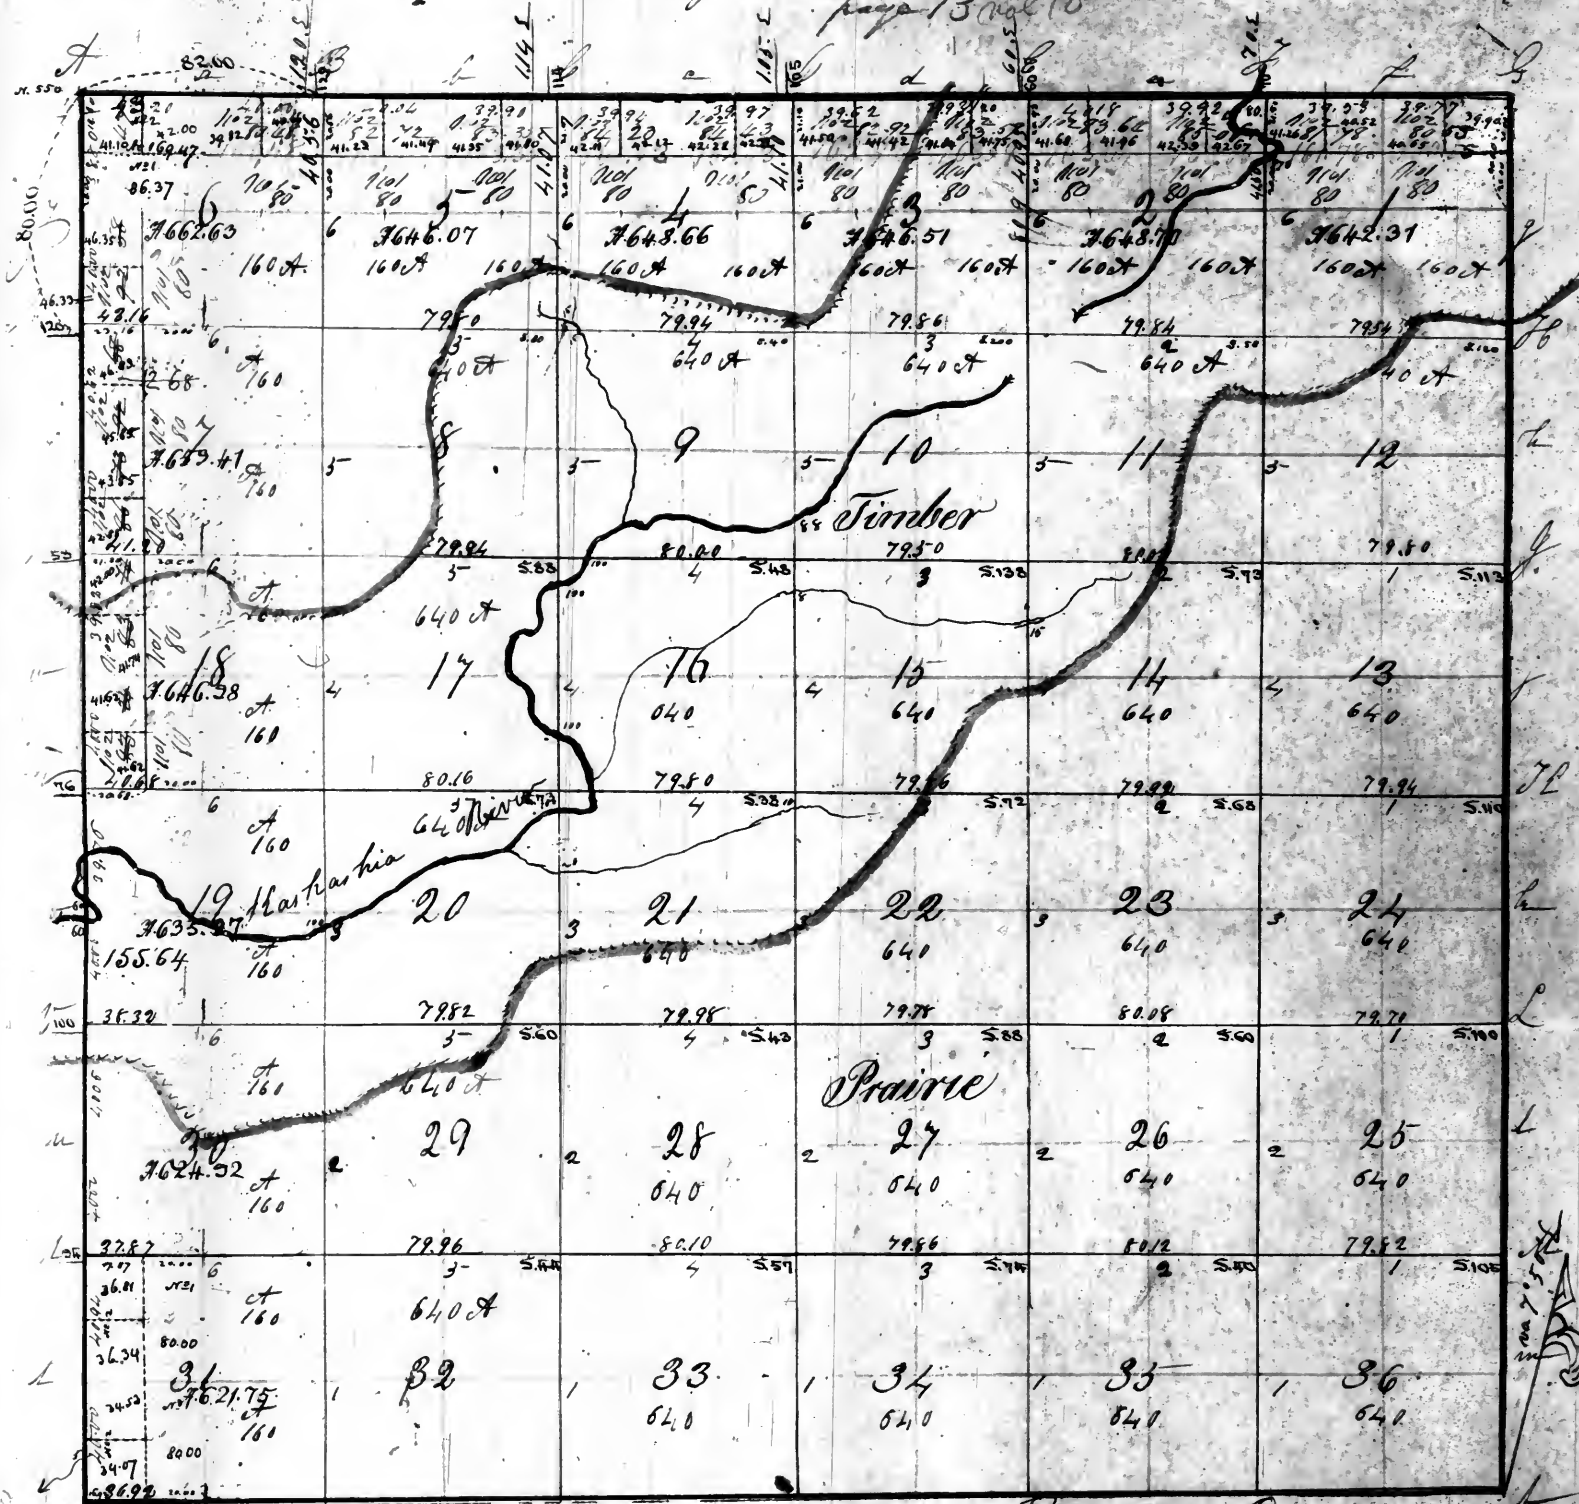

Aggregate area: 23083.21 ac

Scale of 40 chains to an inch

In witness whereof a contract with and instructions from the Surveyor of the lands of the United States for the State of Missouri & Illinois, bearing date 6th March 1821, I have accordingly laid out & surveyed the above described Township, and do hereby certify that it had such marks and bounds both natural & artificial as are represented on said plat and described in the field notes made thereof & returned with this plat into the office of the Surveyor of the lands of the United States for the State of Illinois & Missouri & Territory of Arkansas.

Certified this 24th day of June 1821

Alexr M. Leitch


Office of the Surveyor General
for the States of Illinois and Missouri
Saint Louis July 19th 1850

The North halves of sections 1, 2, 3, 4, 5, the West half of section 6, and the east halves of sections 7, 10, 31, subdivided under the act of Congress of the 5th of April 1832, and a plat sent to the Register and Clerk of the Court prior to the General Land office some day

Recorded

15

Township 14 North of the base line Range 7 East of the third principal Meridian 497.
page 14 vol 10

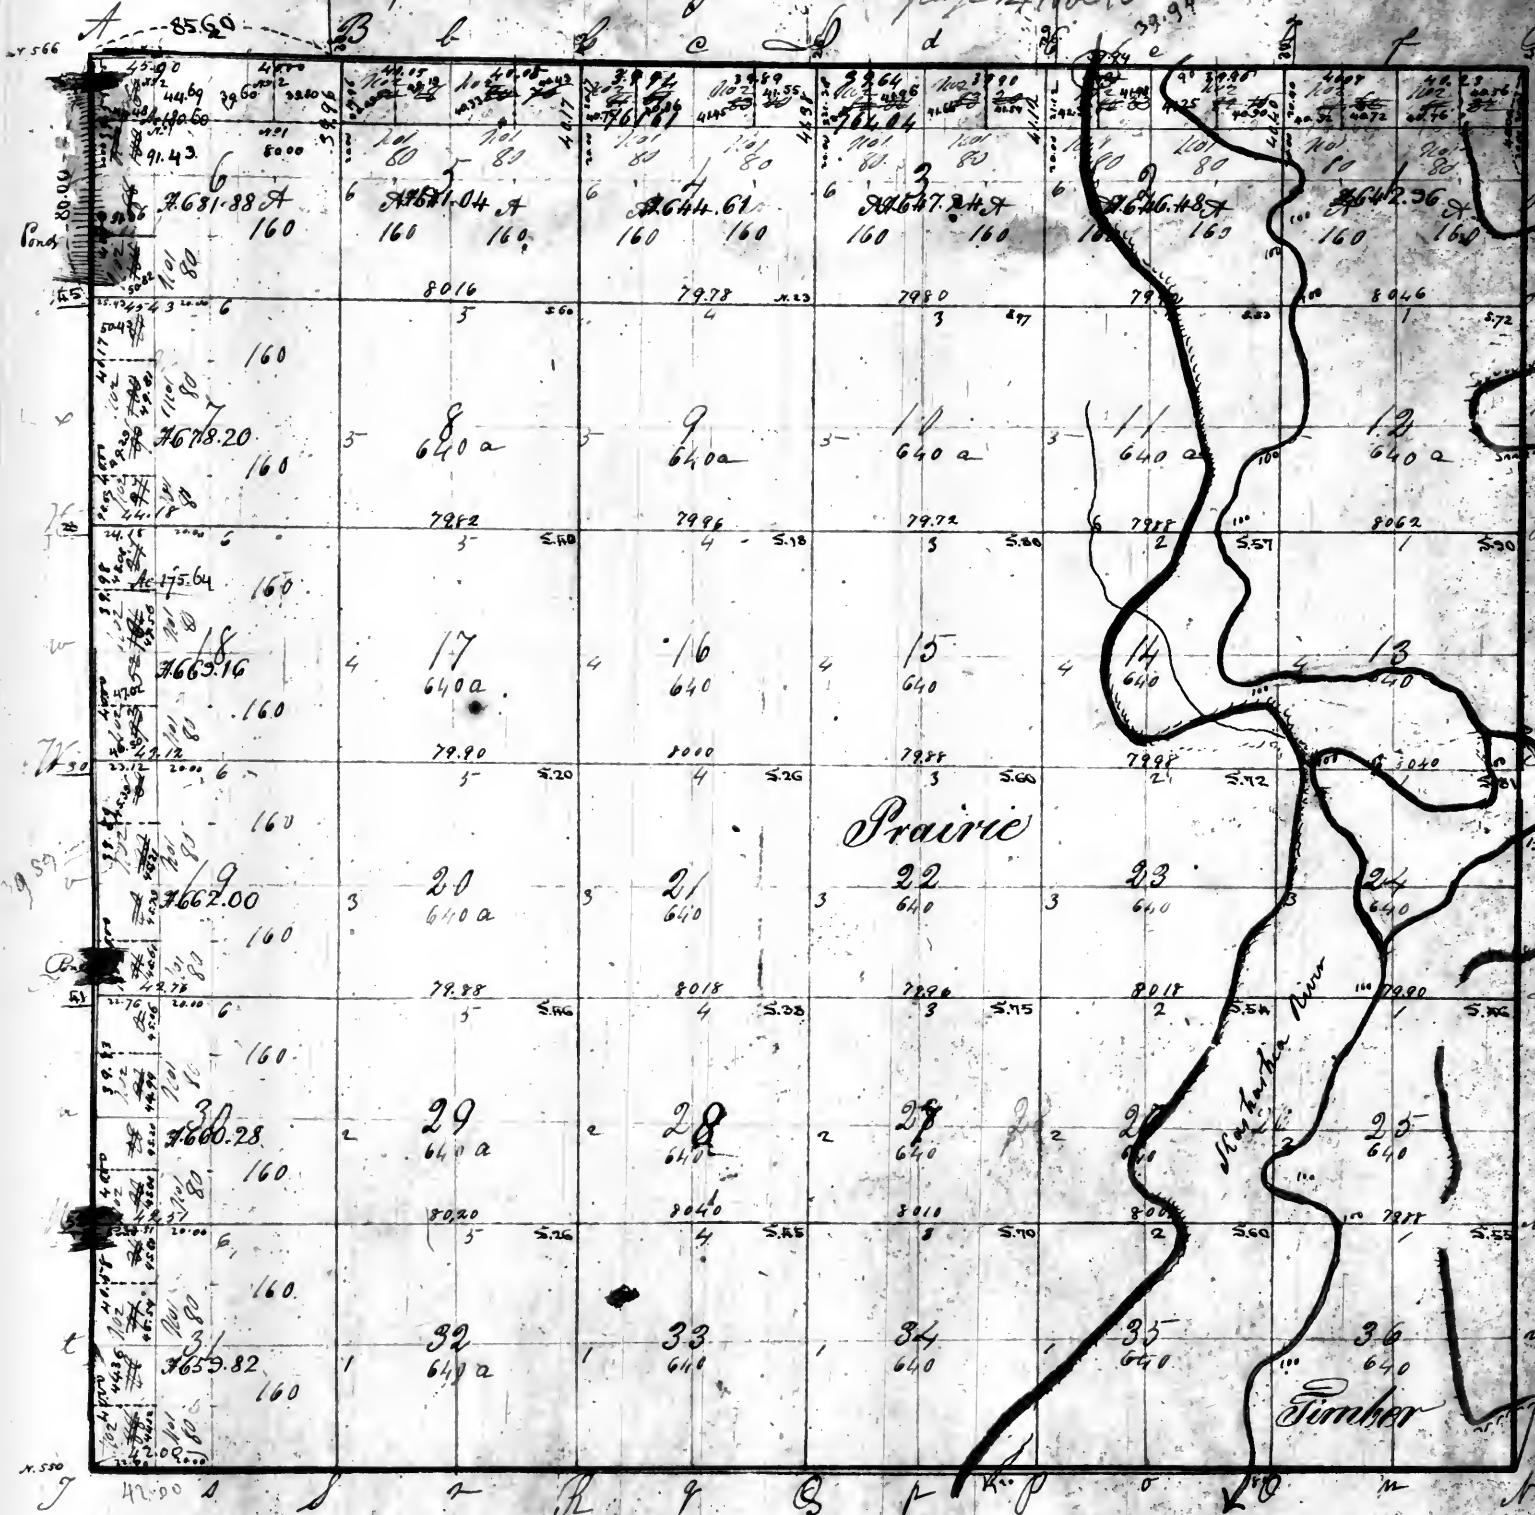

Office of the Surveyor General
for the States of Illinois and Missouri
Saint Louis July 19th 1850
The North halves of sections 1, 2, 3, 4, 5
of the North half and the South west
quarter of section 6, and the West
halves of sections 7, 18, 19, 30 & 31
subdivided under the act of Congress
of the 5th of April 1835, and
reported and to the Register and
submitted to the Commissioners
of the General Land Office
St. Louis Mo

Aggregate area = 23241.30 acres
Scale of 40 chains to an inch


Pursuant to a contract with and instructions from Mrs. Hector Surveyor of the lands of the United States for the
States of Illinois and Missouri bearing date 6th March 1821 I have admeasured laid out & surveyed the above descri-
bed Township and do hereby certify that it has such marks & bounds both natural and artificial as are represen-
ted on 2d plat & described in the field notes made thereof and returned into the Office of the Surveyor of the United
States for the States of Illinois & Missouri Territory of Arkansas
Certified this 24th day of June 1822
A. M. Hamtramck S. L.

Recorded ~~497~~

15

Township No 15, North of the base line Range No 7, East of the Third Principal Meridian.
page 15 vol 10

498

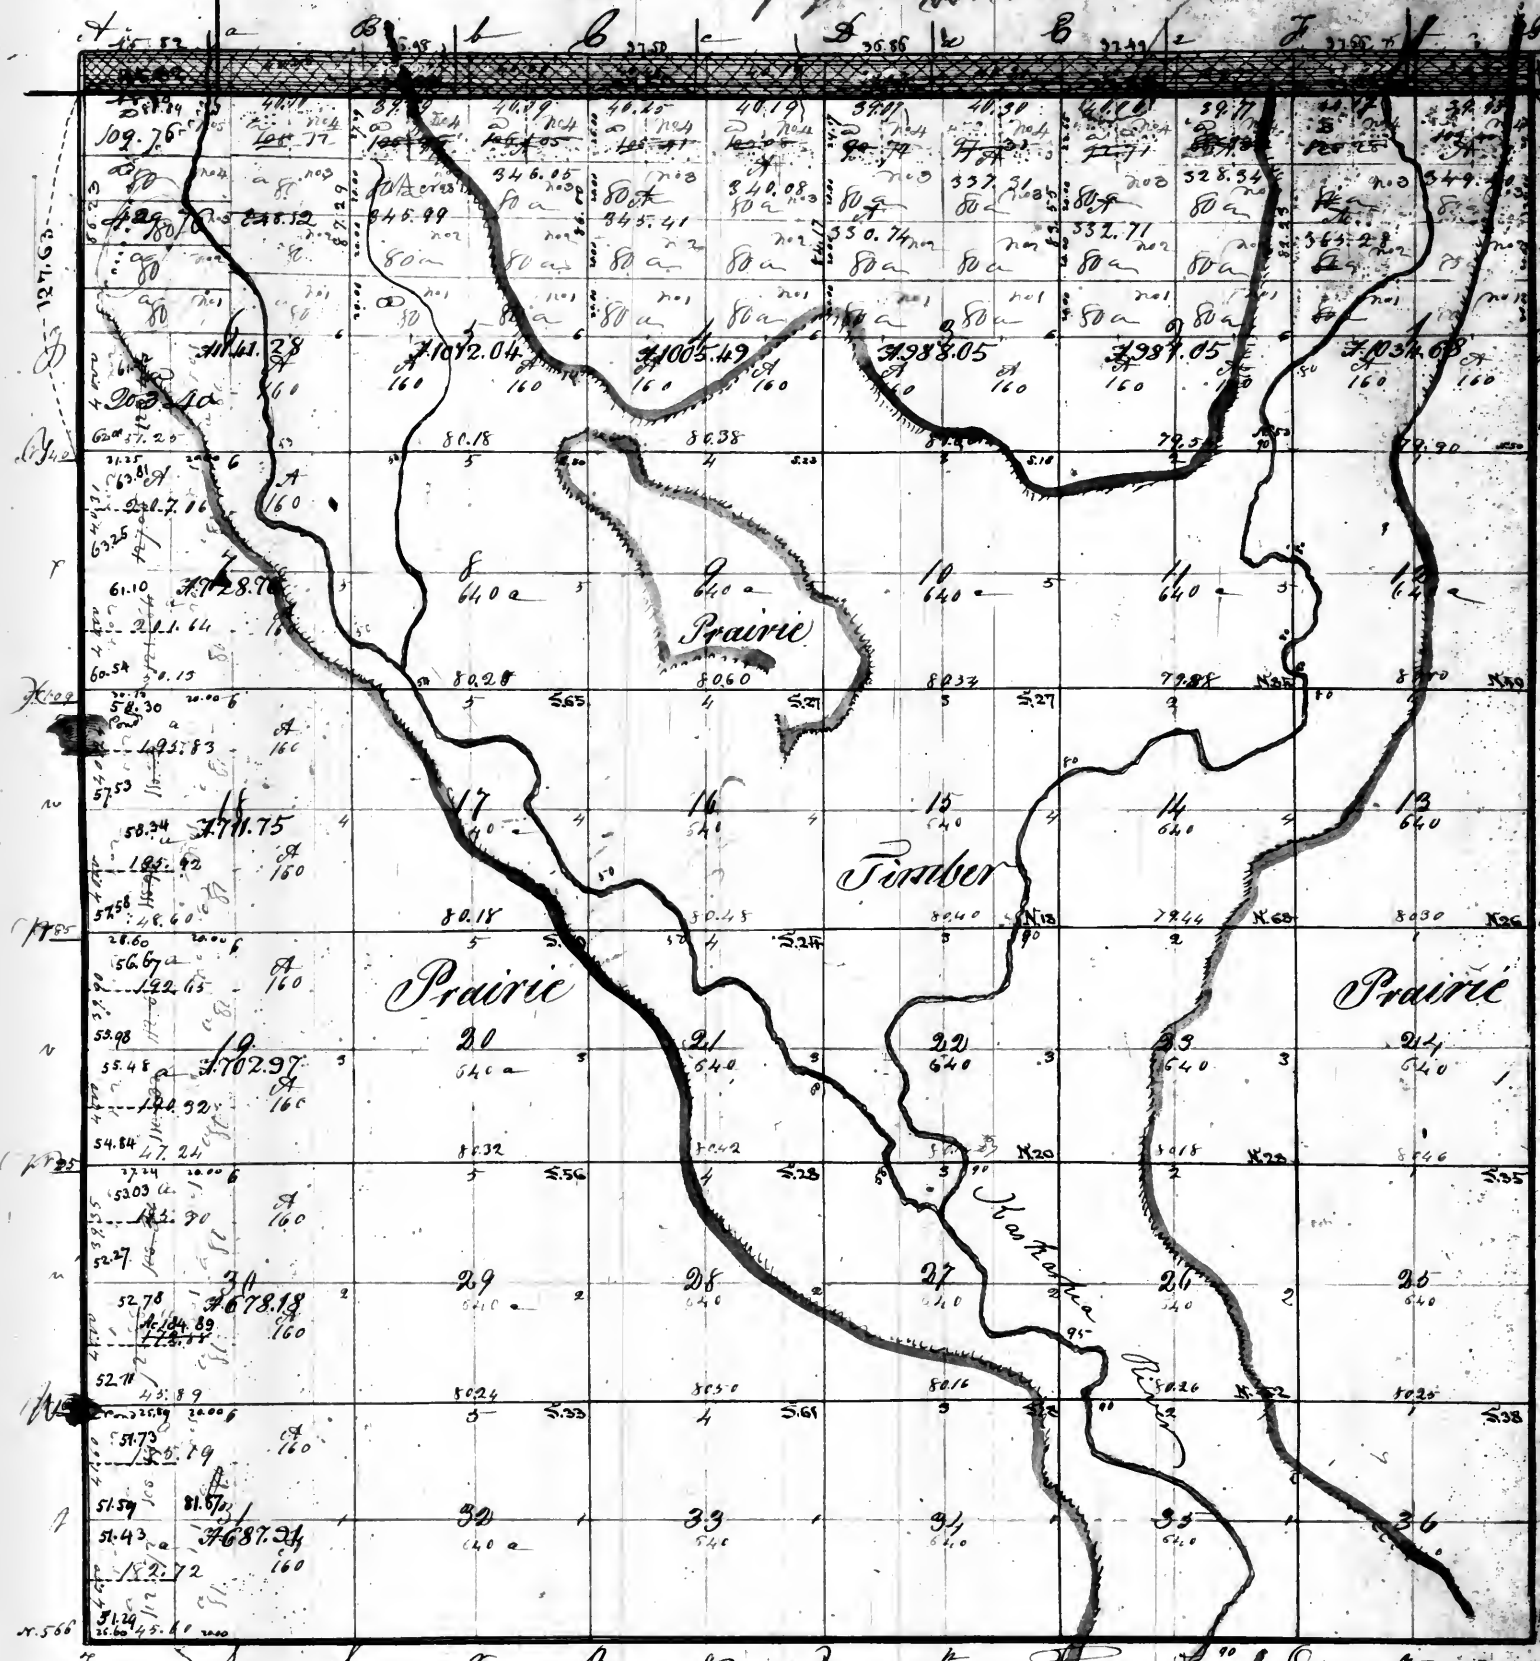

of the 5th of April 1832, and a
plat sent to the Register and
another to the Commissioner
of the General Land Office
No same day

37.66
33.06
54.62
39.95
44.67


Aggregate area = 25672.10 acres

Scale of 40 chains to an inch

Pursuant to a contract with, and instructions from William Rector, Surveyor of the lands of the United States in the State of Illinois, & Kentucky and

499.

Township No. 16 North of the base line, Range No. 27 East of the 3rd principal Meridian.

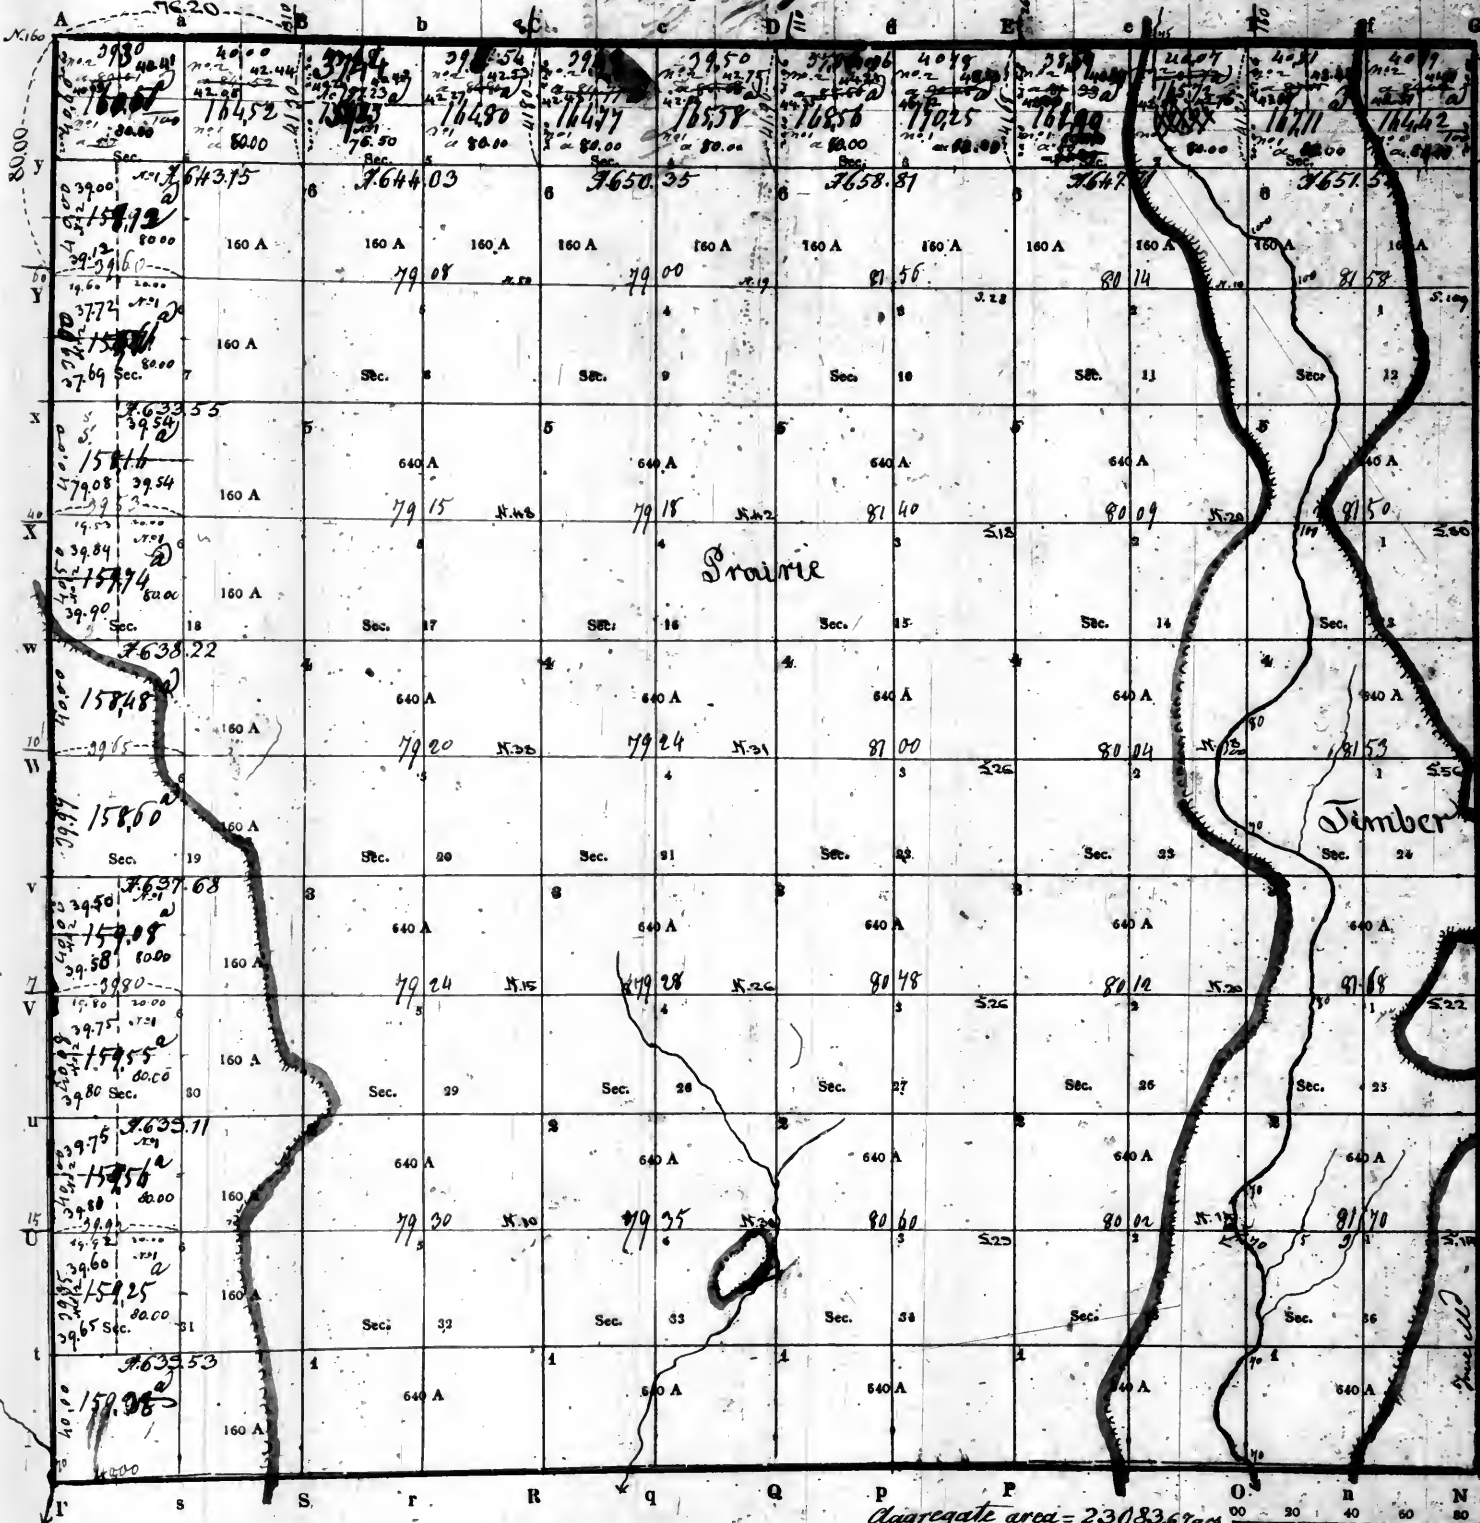

Office of the Surveyor General
for the States of Illinois and Missouri
Saint Louis, July 19th 1852
The North half of Sec. 1, 2, 3, 4 & 5
the North half of the South East quarter
of Sec. 6, the North East quarter of
Sec. 7, 18 & 31, the South East
quarter of Sec. 19, one of the NW
half of Sec. 28 the NW quarter of
the NW of Cor. of the 5th of April
1832, - the South East quarter of
Sec. 29, 30, 31, 32, 33, 34, 35, 36
are hereby sold to the highest bidder
to a private sale in pursuance of a
plat sent to the Register and another
to the Commissioner of the General
Land Office same day 170


PURSUANT to a contract with, and instructions from William Rector, Surveyor of the lands of the United States in the
States of Illinois, Missouri and Territory of Arkansas bearing date the nineteenth day of February 1832
I have admeasured, laid out and surveyed the above described Township; and do hereby certify, that it had such marks and bounds, both natural and artificial,
as are represented on said plat, and described in the field notes made thereof, and returned with this plat into the Office of the Surveyor of the Lands of the
United States, in the States of Illinois, Missouri and Territory of Arkansas. Surveyed by Richd. P. Holladay.
Certified this Thirtieth day of November 1832
EXAMINED.
J. Elias Rector, D. SURVEYOR.

Record

500.

page 17 vol 10

Township No. 17 North of the base line, Range No. 4 East of the principal Meridian.

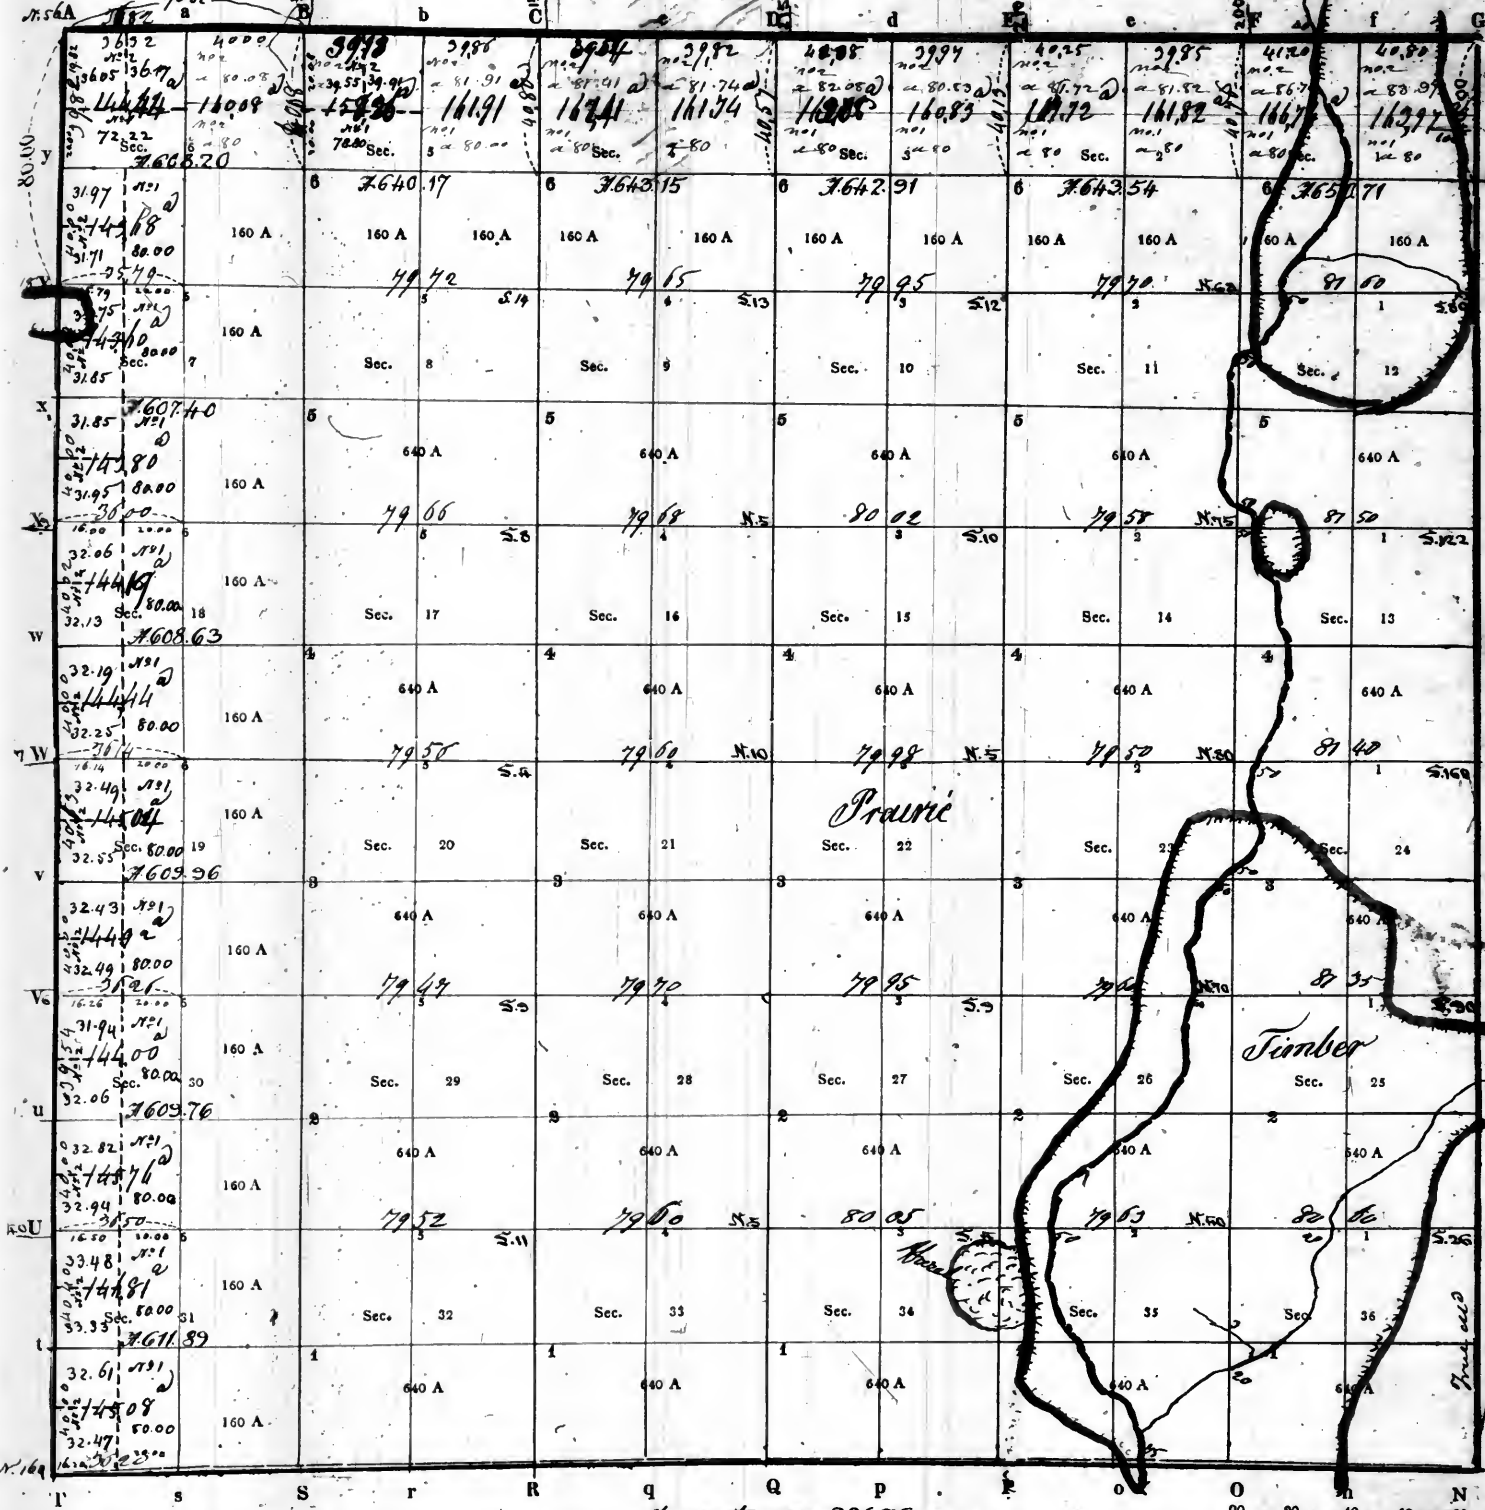

Surveyor's office
St. Louis, Mo. 15th 1849.
The North West quarter of section 5, and
the West halves of sections 6 & 7, 18 & 19, 30 & 31
included and a plat sent to the Register
and another to the Com. Agr. of the
General Land Office.

Prairie

Timber

Dr. 1.55° Oak
very old

Aggregate area-22876.32 acres

Scale of 40 Chains to an inch.

PURSUANT to a contract with, and instructions from William Rector, Surveyor of the lands of the United States in the
States of Missouri & Territory of Arkansas bearing date the 11th day of February 1832
I have admeasured, laid out and surveyed the above described Township; and do hereby certify, that it had such marks and bounds, both natural and artificial,
as are represented on said plat, and described in the field notes made thereof, and returned with this plat into the Office of the Surveyor of the Lands of the
United States, in the States of Illinois, Missouri and Territory of Arkansas Surveyed by Rich^d. T. Holliday
Certified this 17th day of November 1832 for Elias Rector D. SURVEYOR.


EXAMINED.

Recorded

501.

page 18 vol 10

Township No. 18 North of the base line, Range No. 4 East of the 3^d principal Meridian.

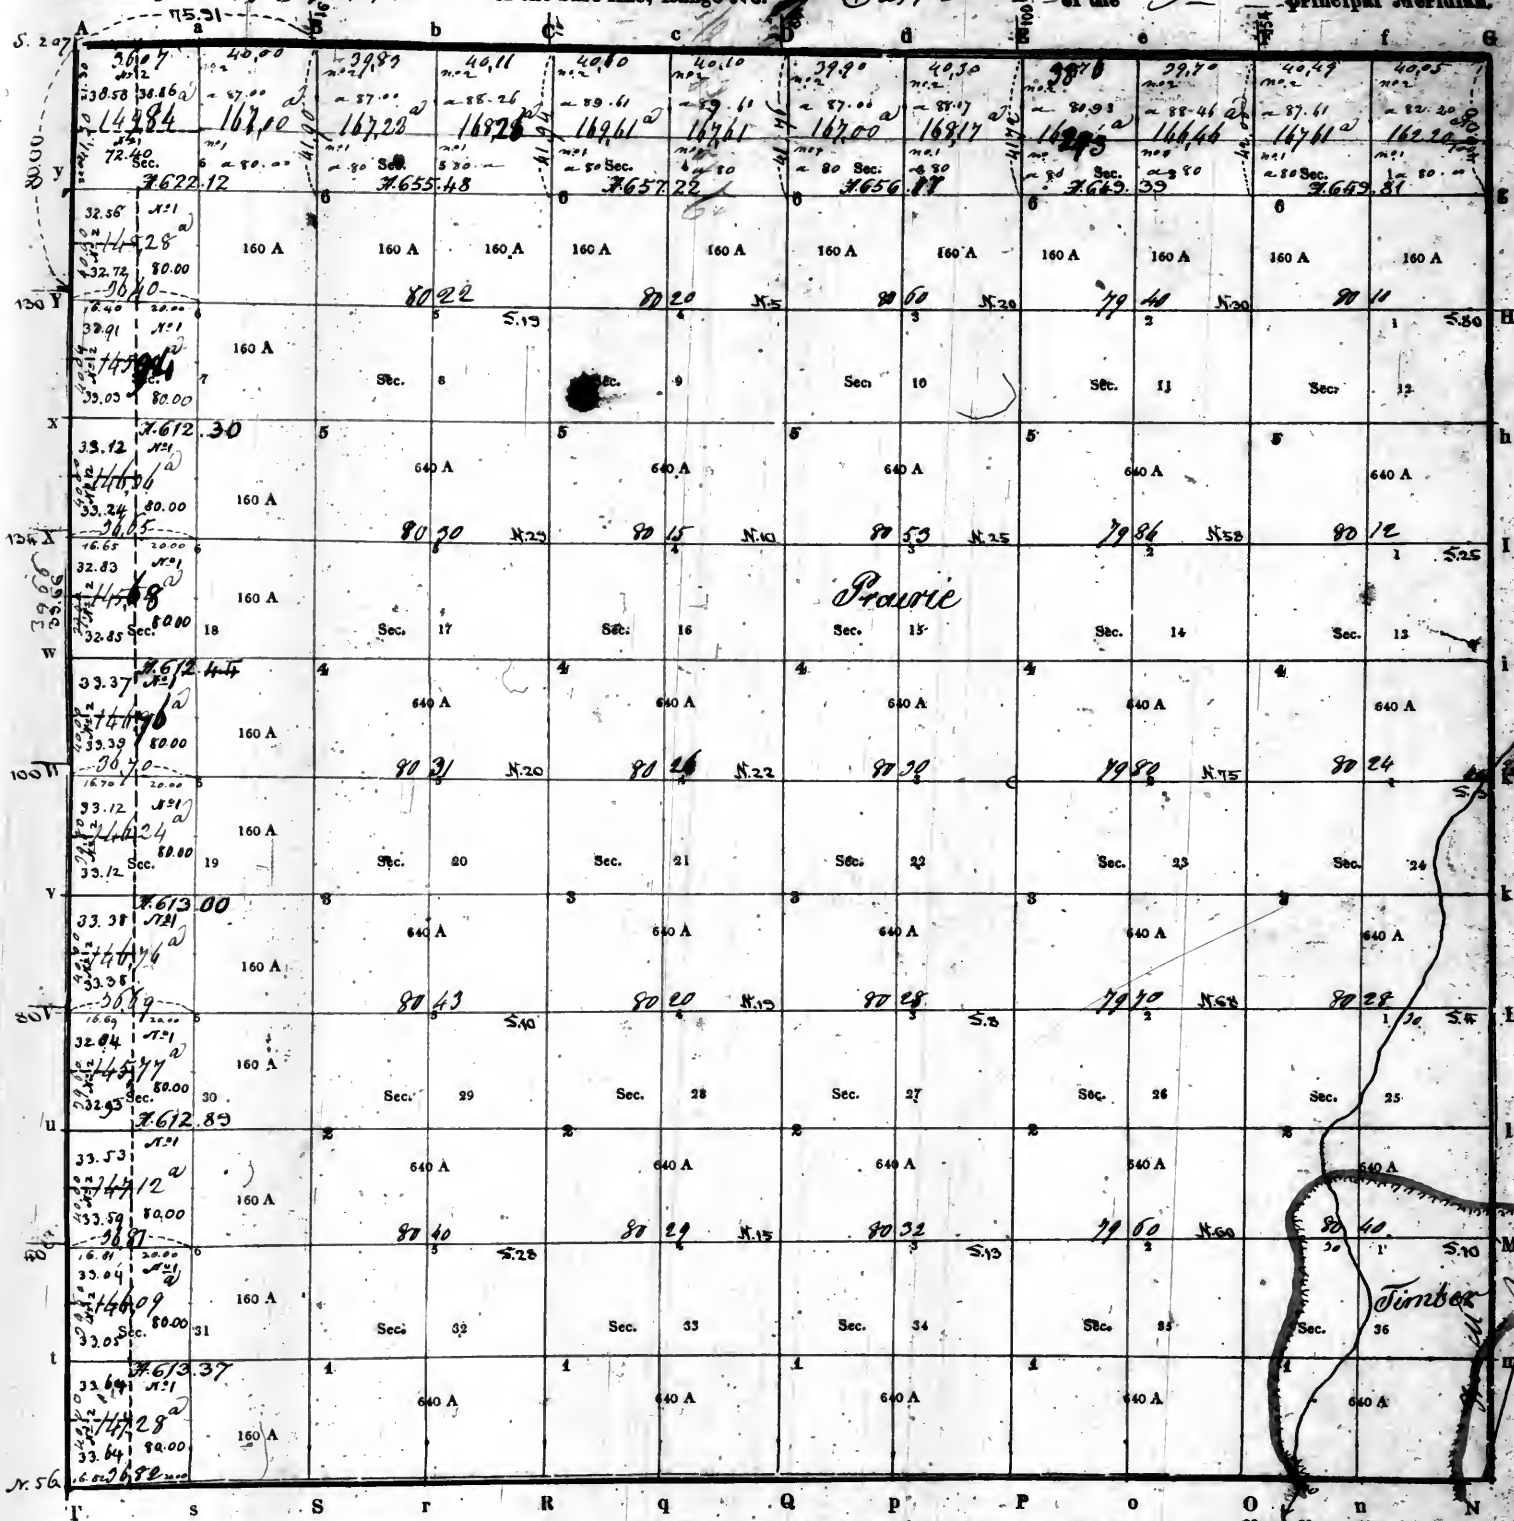

Surveyor's office
Saint Louis June 15th 1849.
The West halves of sections 6, 7, 8, 9, 30, 31, 32,1000.


Aggregate area = 22954.79 ac

Scale of 40 Chains to an inch.

PURSUANT to a contract with, and instructions from William Rector, Surveyor of the lands of the United States in the State of Missouri, I have admeasured, laid out and surveyed the above described Township; and do hereby certify, that it had such marks and bounds, both natural and artificial, as are represented on said plat, and described in the field notes made thereof, and returned with this plat into the Office of the Surveyor of the Lands of the United States, in the State of Missouri, and Territory of Arkansas. Surveyed by Rich. T. Holliday for Elias Rector D. SURVEYOR.

Recorded

Township No. 19 North of the base line, Range No. 4 East of the 3 principal Meridian.

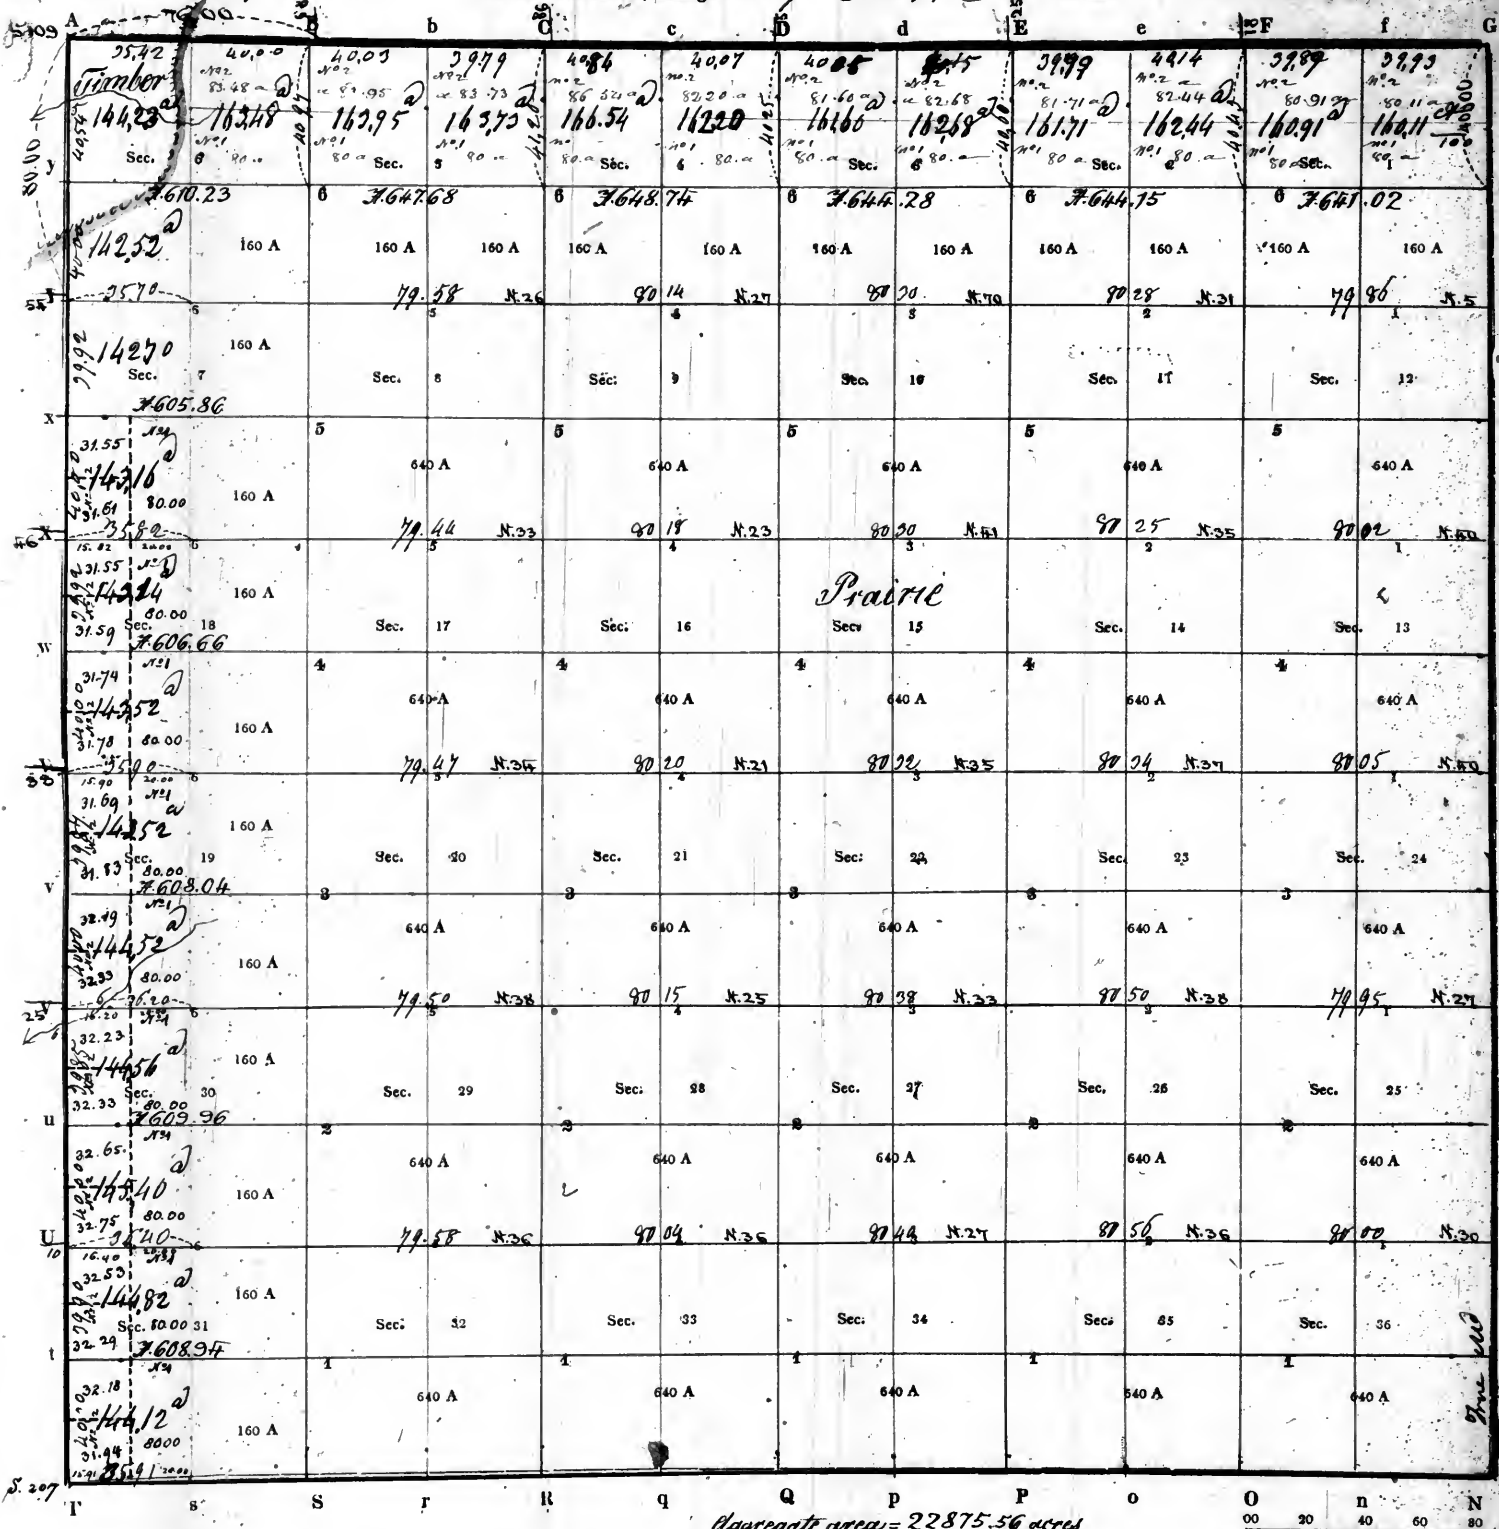

Surveyor's office
Saint Louis June 15th 1849.
The South West quarter of
section 7, and the two halves
of sections 18, 19, 30 & 31, were
divided under the act of Congress
of the 5th of April 1832, and a
plat sent to the Register and
another to the Commissioner
of the General Land Office.

*in 755th
Wagon Road*


Aggregate area = 22875.56 acres

PURSUANT to a contract with, and instructions from William Rector, Surveyor of the lands of the United States in the
State of Missouri and Territory of Arkansas bearing date the *fourteenth* day of *February* 1832
I have measured, laid out and surveyed the above described Township; and do hereby certify, that it had such marks and bounds, both natural and artificial,
as are represented on said plat, and described in the field notes made thereof, and returned with this plat into the Office of the Surveyor of the Lands of the
United States, in the *State of Missouri and Territory of Arkansas* Surveyed by *Richd. P. Holliday*
Certified this *fourteenth* day of *November* 1832 for *Elias Rector* D. SURVEYOR.
EXAMINED.

Recorded

Township 20 North of the Base line Range 4 East of 3^d Principal Meridian

page 20 vol 10

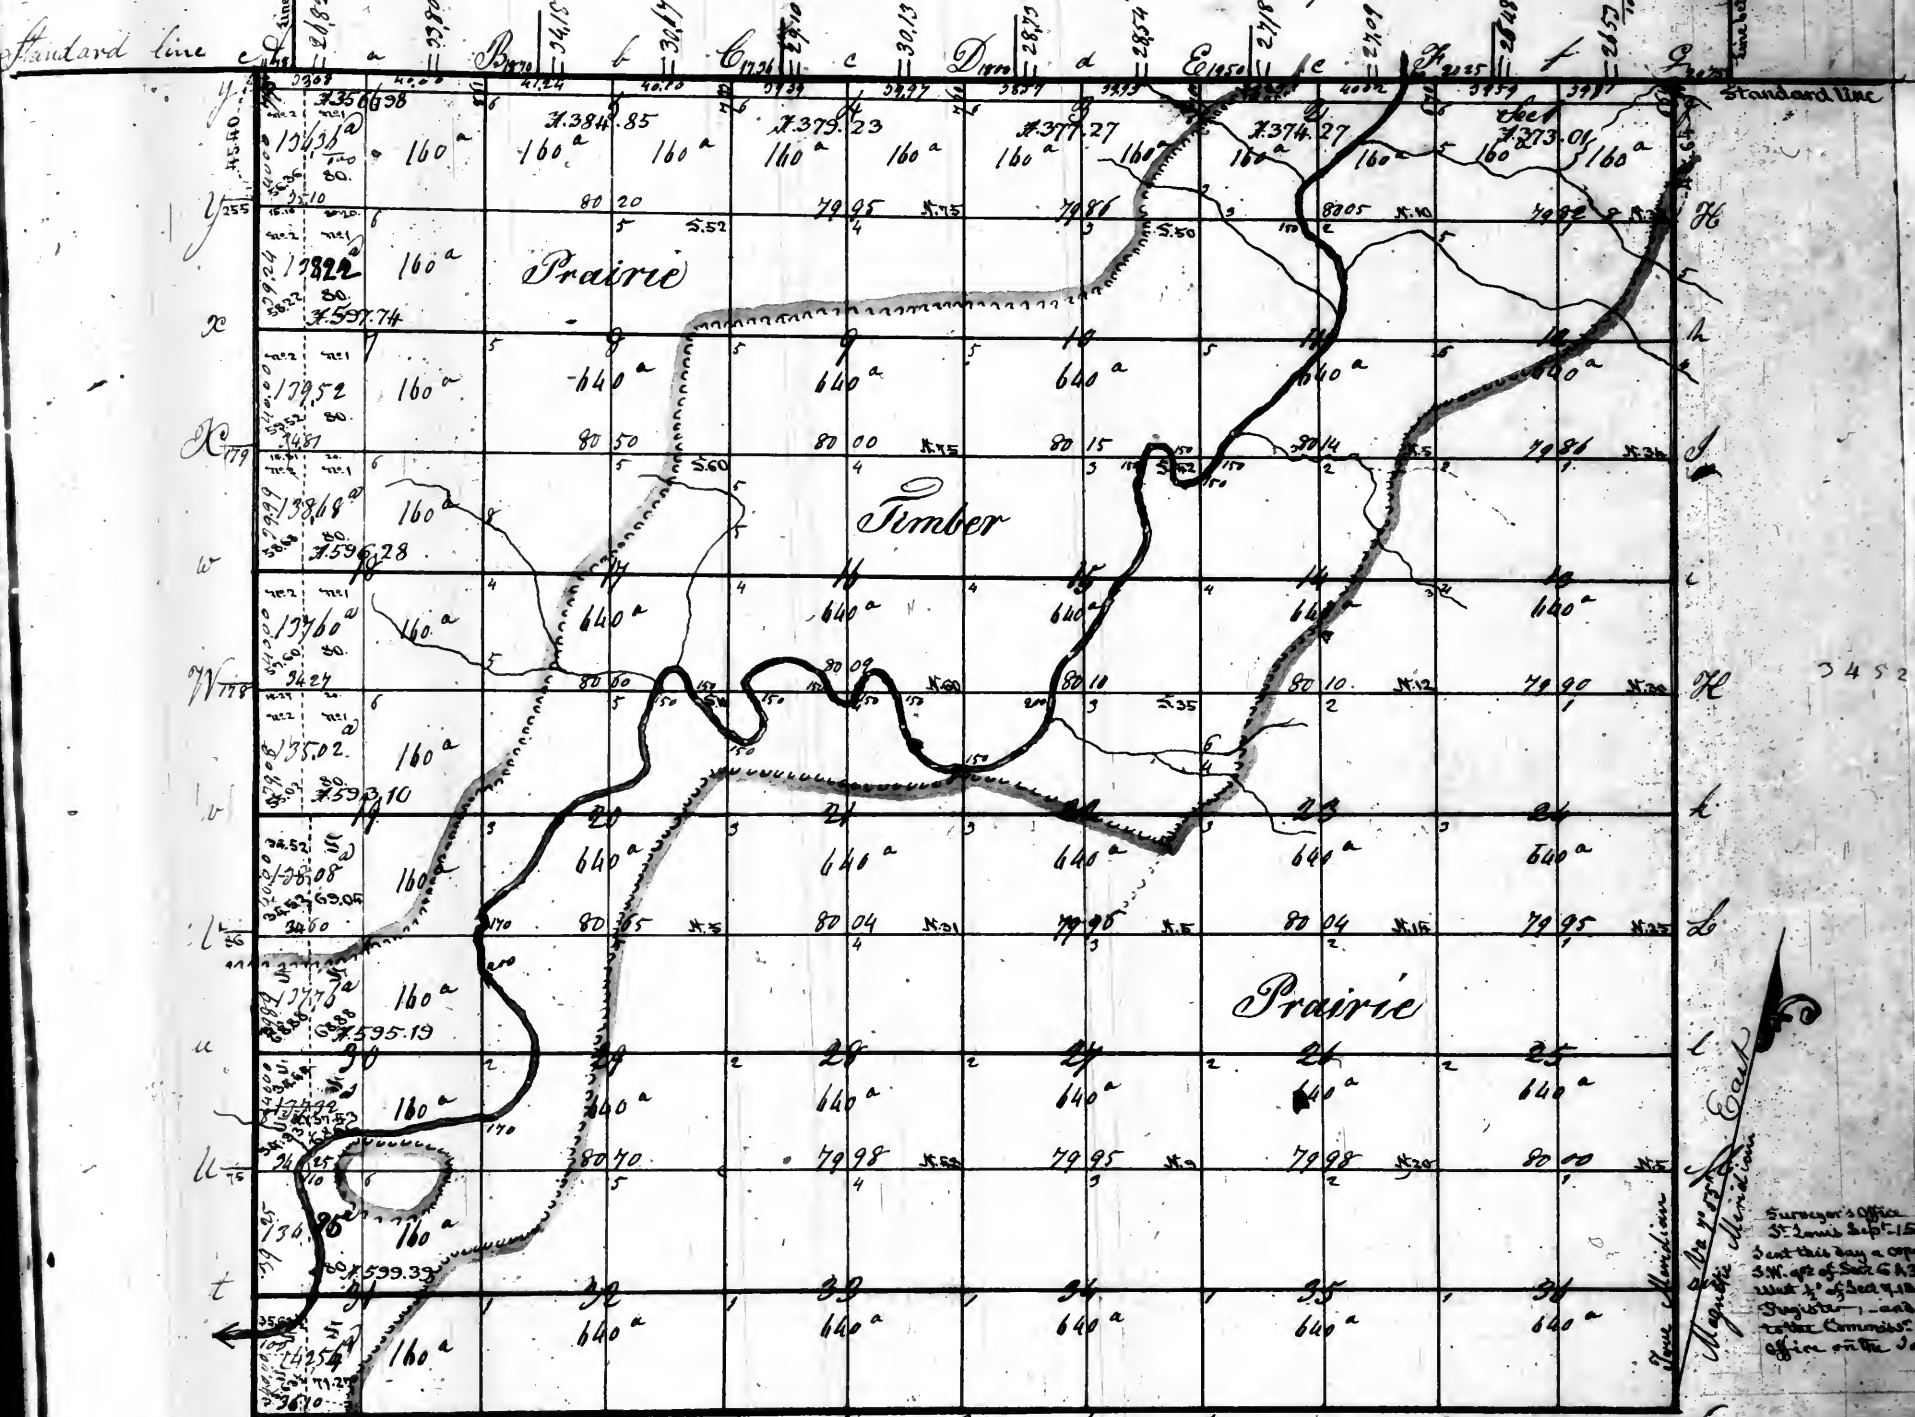

Aggregate area = 19227.31 acs

Laid down by a scale of 40 Chas. to an inch

Pursuant to a contract with & instructions from William Rector Surveyor of the Lands of the United States in the States of Illinois - Missouri and Territory of Arkansas bearing date the nineteenth day of February 1822 I have administered laid out and surveyed the above described Township & do hereby certify that it had such marks and bounds both natural and artificial as are represented on said plat and described in the field notes made thereof and returned with this plat into the Office of the Surveyor of the Lands of the United States in the States of Illinois Missouri & Territory of Arkansas

Certified this 13th day of November 1822

Surveyed by Richd. T. Holliday
for Elias Rector, D. Surveyor

Examined

Surveyor's Office
St. Louis Sept. 15. 1846
Sent this day a copy of plat of the
S.W. 1/4 of Sect 6 & 34, and of the
W. 1/2 of Sect 9, 12, 13 & 36 to the
Register, and under proper
orders Committed to the Land
Office on the same day.


Recorded

15

Township 14 North of the base line Range 7 East of the third principal Meridian

497

page 14 vol 10

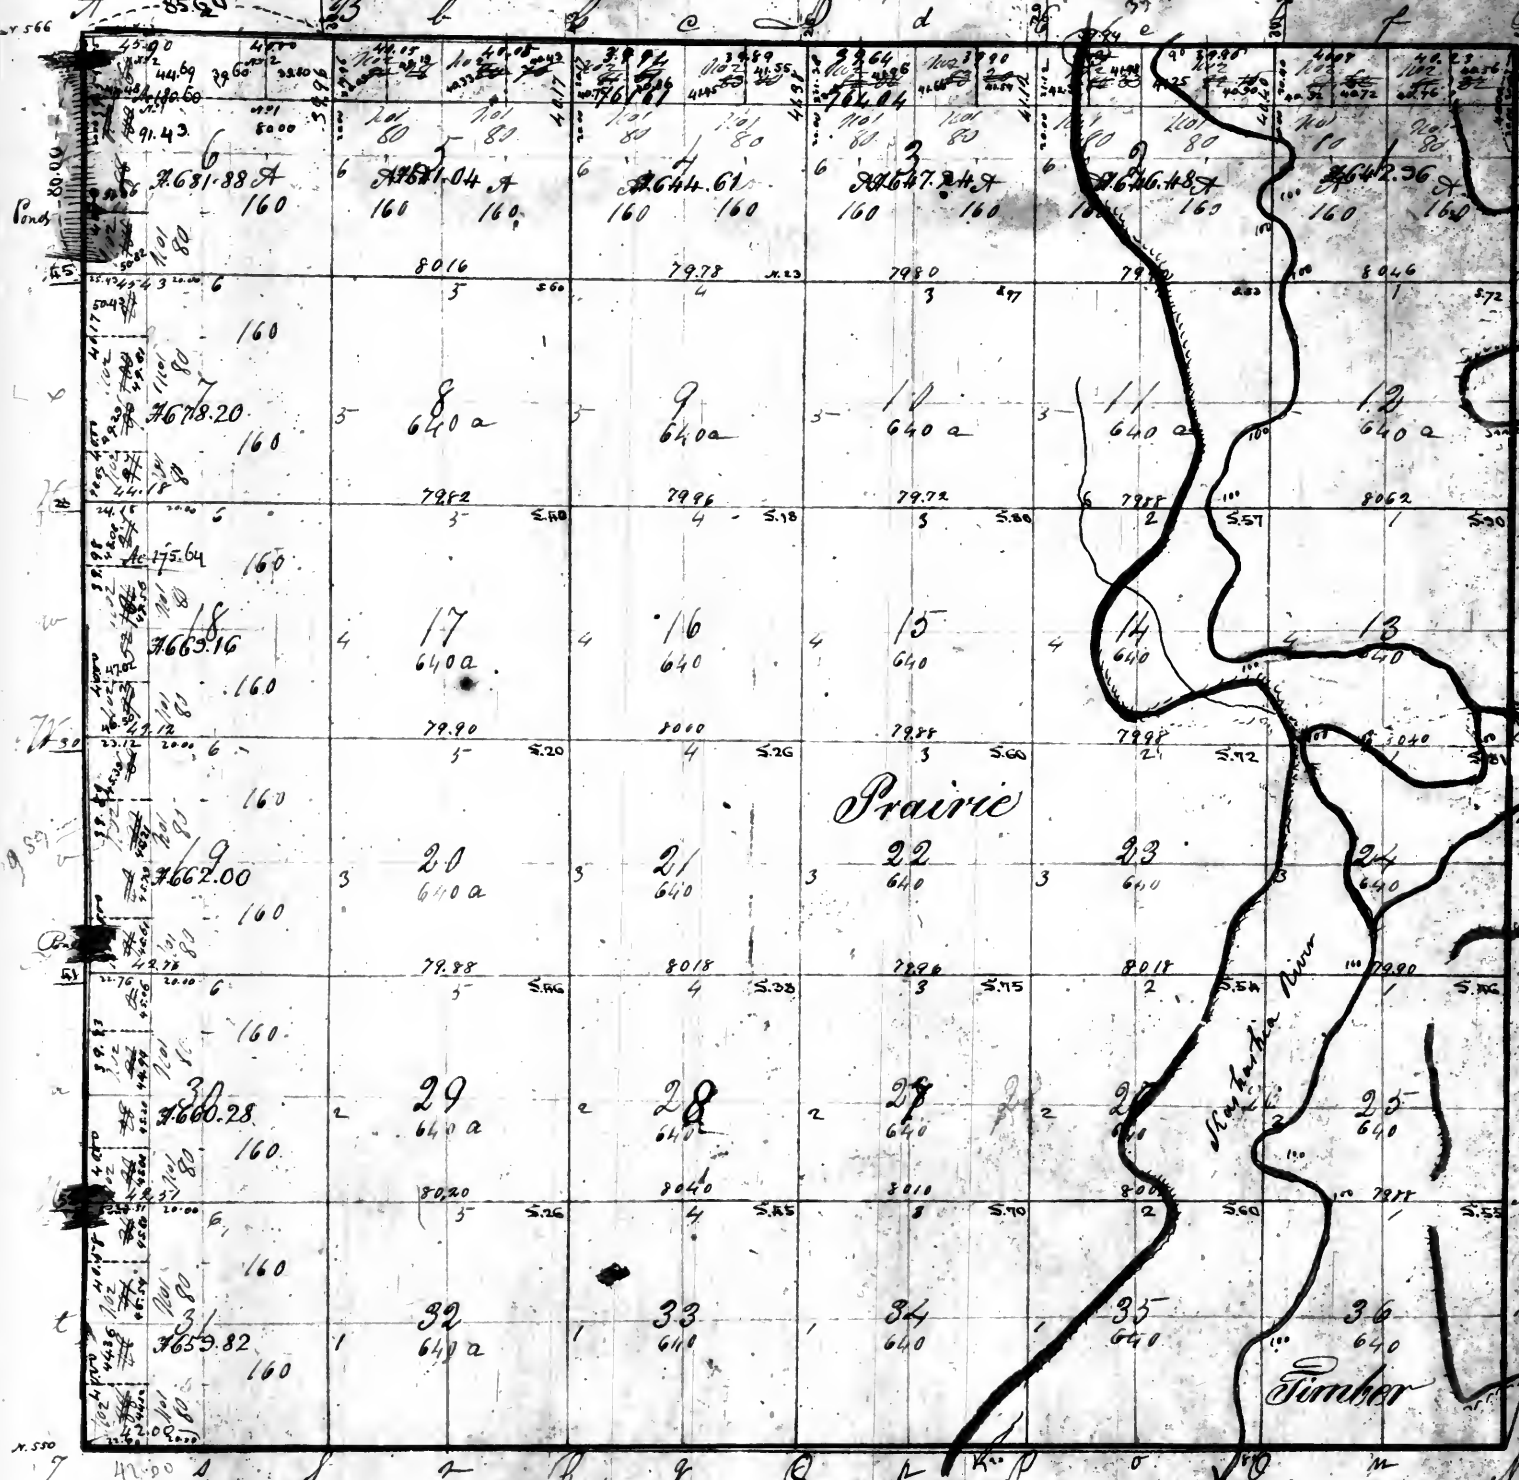

Office of the Surveyor General
for the States of Illinois and Missouri
Saint Louis July 19th 1850
The North halves of sections 21, 22, 23, 24, 25, 26, 27, 28, 29, 30, 31, 32, 33, 34, 35, 36, and the West halves of sections 7, 18, 19, 30 & 31
submitted under the act of Congress
of the 5th of April 1832, and
referred to the Register and
Comptroller of the General Land Office
same day

Pursuant to a contract with and instructions from Mrs. Hector, Surveyor of the lands of the United States for the
Territory of Arkansas
States of Illinois and Missouri bearing date 6th March 1821 I have admeasured laid out & surveyed the above descri-
bed Township and do hereby certify that it had such marks & bounds both natural and artificial as are repre-
sented on 2d plat & described in the file now made thereof and returned into the Office of the Surveyor of the United
States for the States of Illinois & Missouri Territory of Arkansas
Certified this 24th day of June 1822


Wm. H. Hartsenrath D.S.

Township No 15, North of the base line Range No 7, East of the Third Principal Meridian.
page 15 vol 10

Page 15 vol. 10

Record ~~#97~~

498

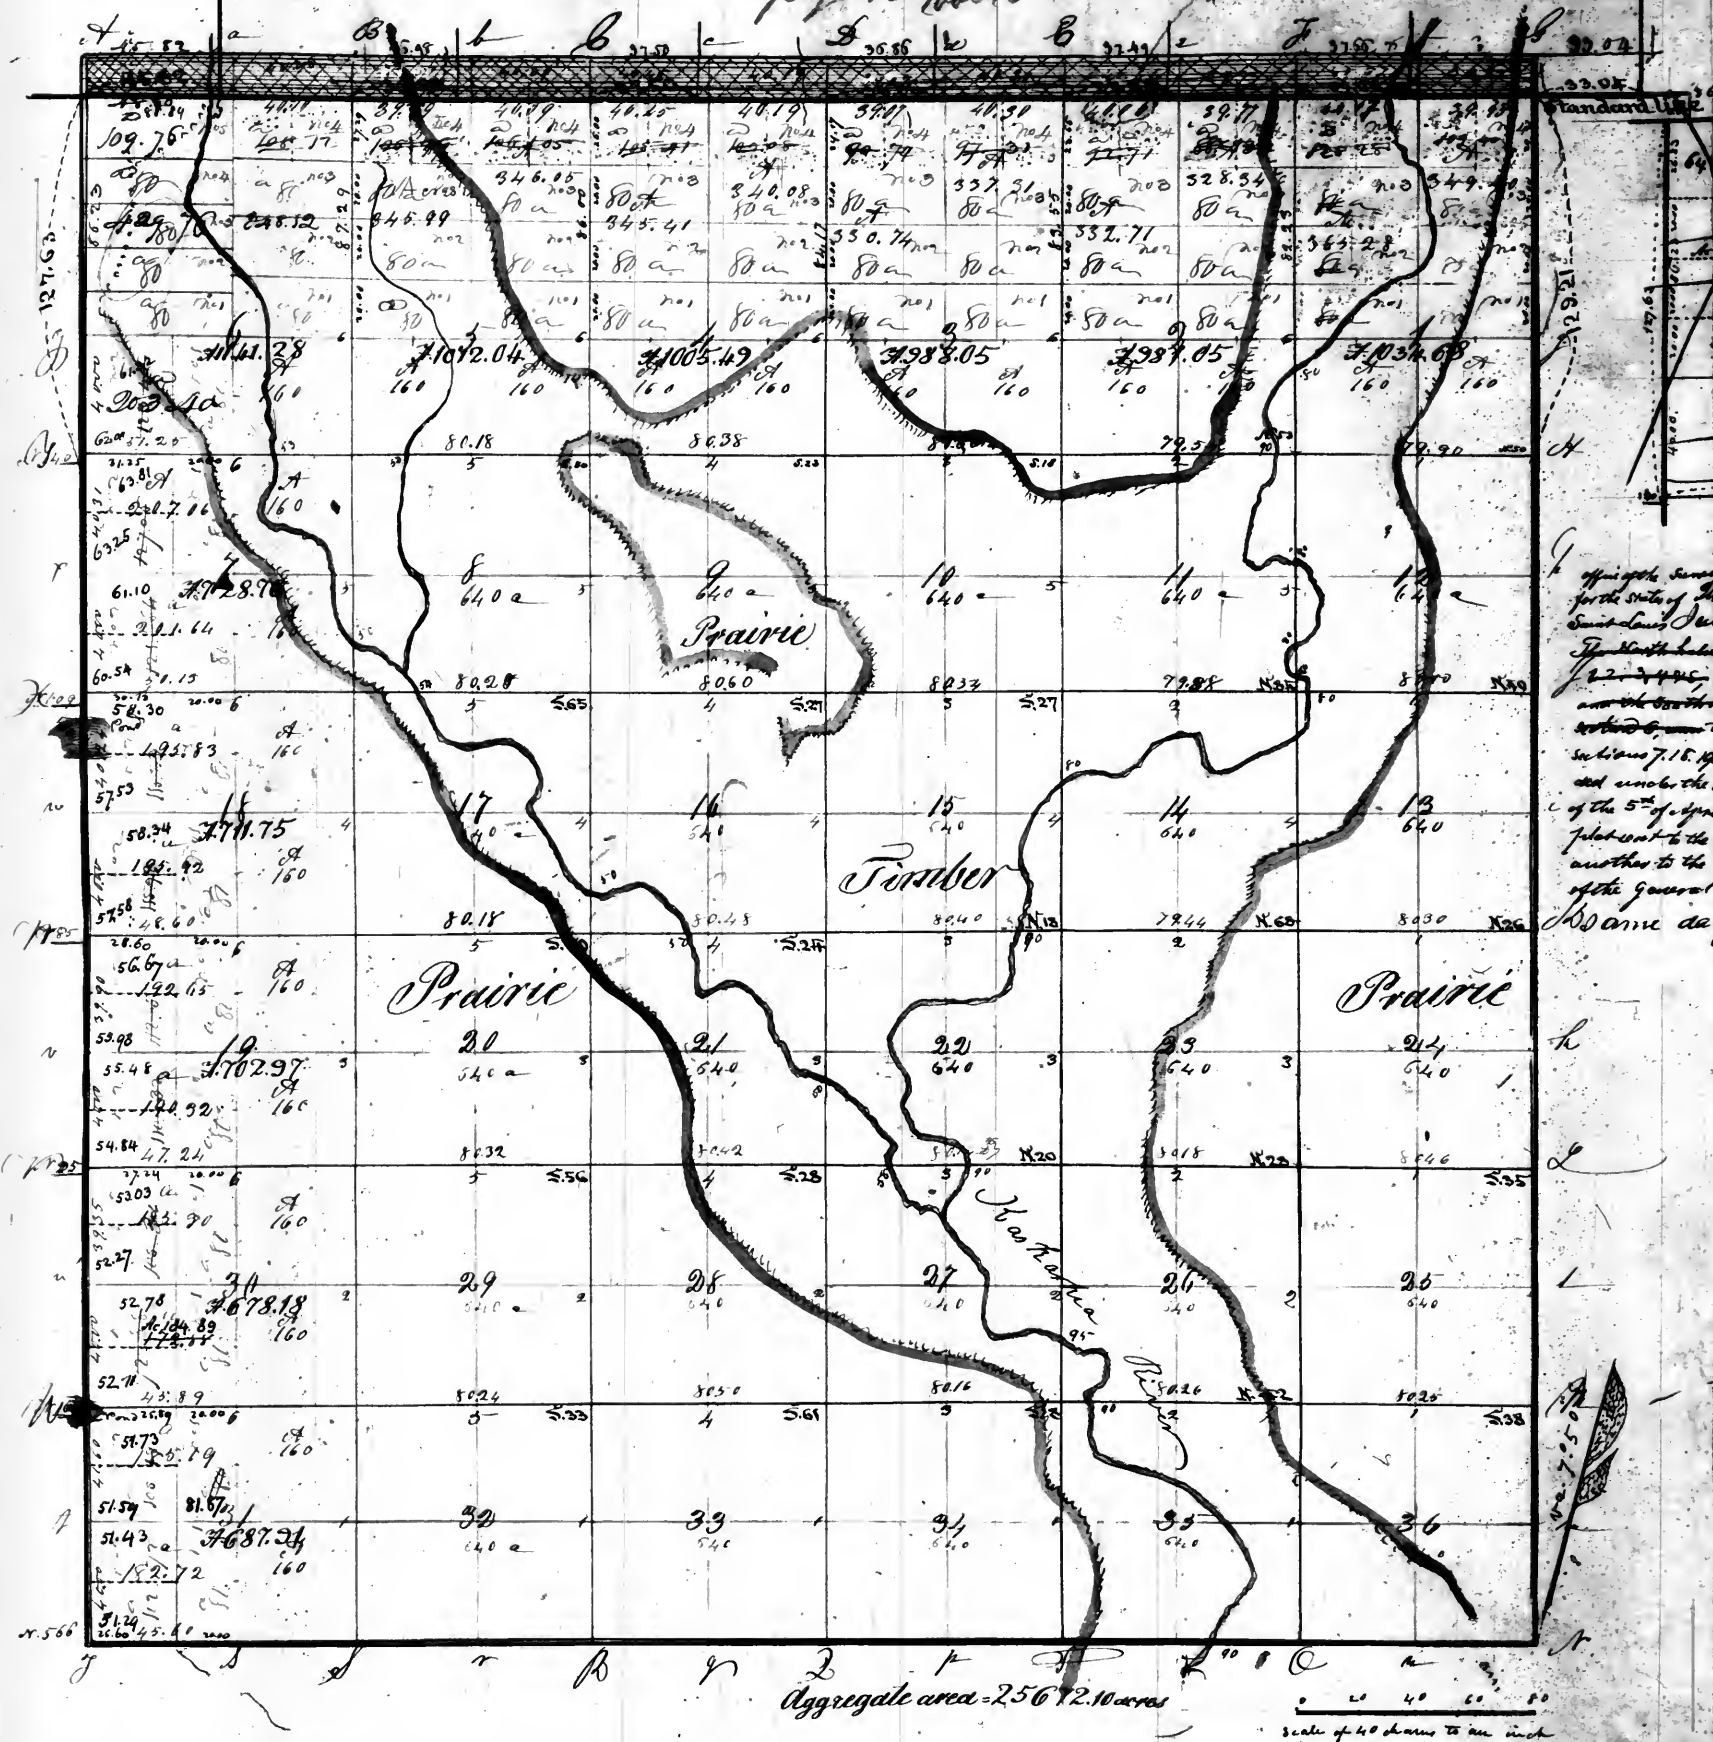

been 7, 18, 19, 30, 31 and
and under the care of
of the 5th of April 1832, and
placed in the Register
and another to the Commission
of the General Land Office
Same day


I, pursuant to a contract with, and instructions from William Rector, Surveyor of the lands of the United States in the States of Illinois & Missouri and Territory of Arkansas, bearing date March 6th 1821, I have come and surveyed the above described Township, and do hereby certify, that it has such marks & bounds both natural & artificial, as are represented on said plat, and described in the field notes made thereof. I return with this plat into the Office of the Surveyor of the lands of the United States, for the States of Illinois & Missouri, and Territory of Arkansas.

Certified this 24th day of June 1822!

Rep. M. J. Anderson, D. S.

499.

Township No. 16 North of the base line, Range No. 7 East of the principal Meridian.

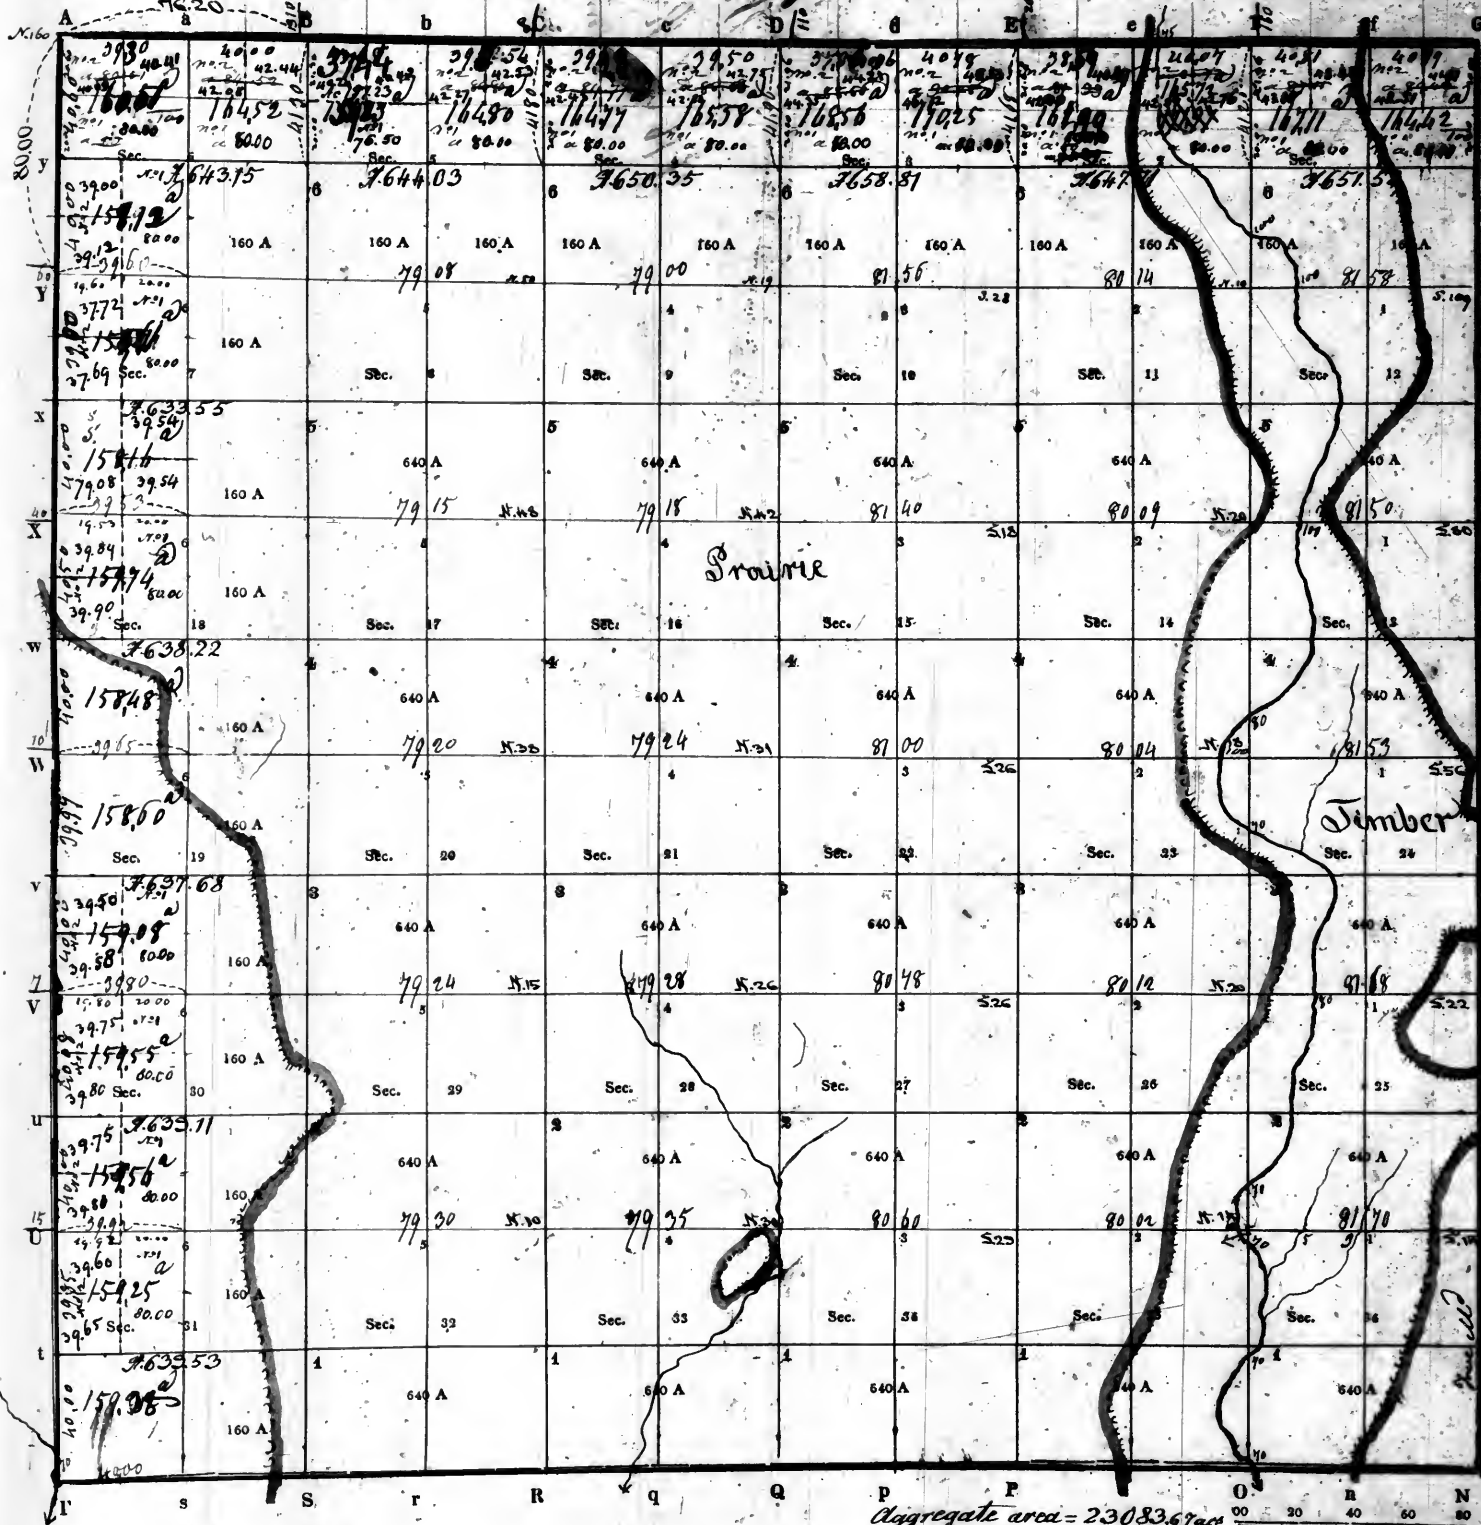

Office of the Surveyor General
for the State of Illinois and Missouri
Sankle, July 19th 1853
The North half of section 1, 2, 3, 4 & 5
the North half of the South west quarter
of section 6, the North west quarter of
section 7, 18 & 31, the South west
quarter of section 19, and the west
half of section 30 be sold under the
act of Congress of the 5th of April
1820, - the South west quarter of
section 7 subdivided as a township
to a previous sale; in accordance with
a plat sent to the Register and another
to the Commissioner of the General
Land Office same day 170

PURSUANT to a contract with, and instructions from William Rector, Surveyor of the lands of the United States in the
States of Illinois and Territory of Arkansas - bearing date the nineteenth day of February 1852
I have admeasured, laid out and surveyed the above described Township; and do hereby certify, that it had such marks and bounds, both natural and artificial,
as are represented on said plat, and described in the field notes made thereof, and returned with this plat into the Office of the Surveyor of the Lands of the
United States, in the States of Illinois, Missouri and Territory of Arkansas. Surveyed by Rich. P. Holliday.
Certified this Thirtieth day of November 1852
E. Rector D. SURVEYOR.
EXAMINED.


Recorder

500.

17

page 17 vol 10

Township No. 17 North of the base line, Range No. 4 East of the principal Meridian.

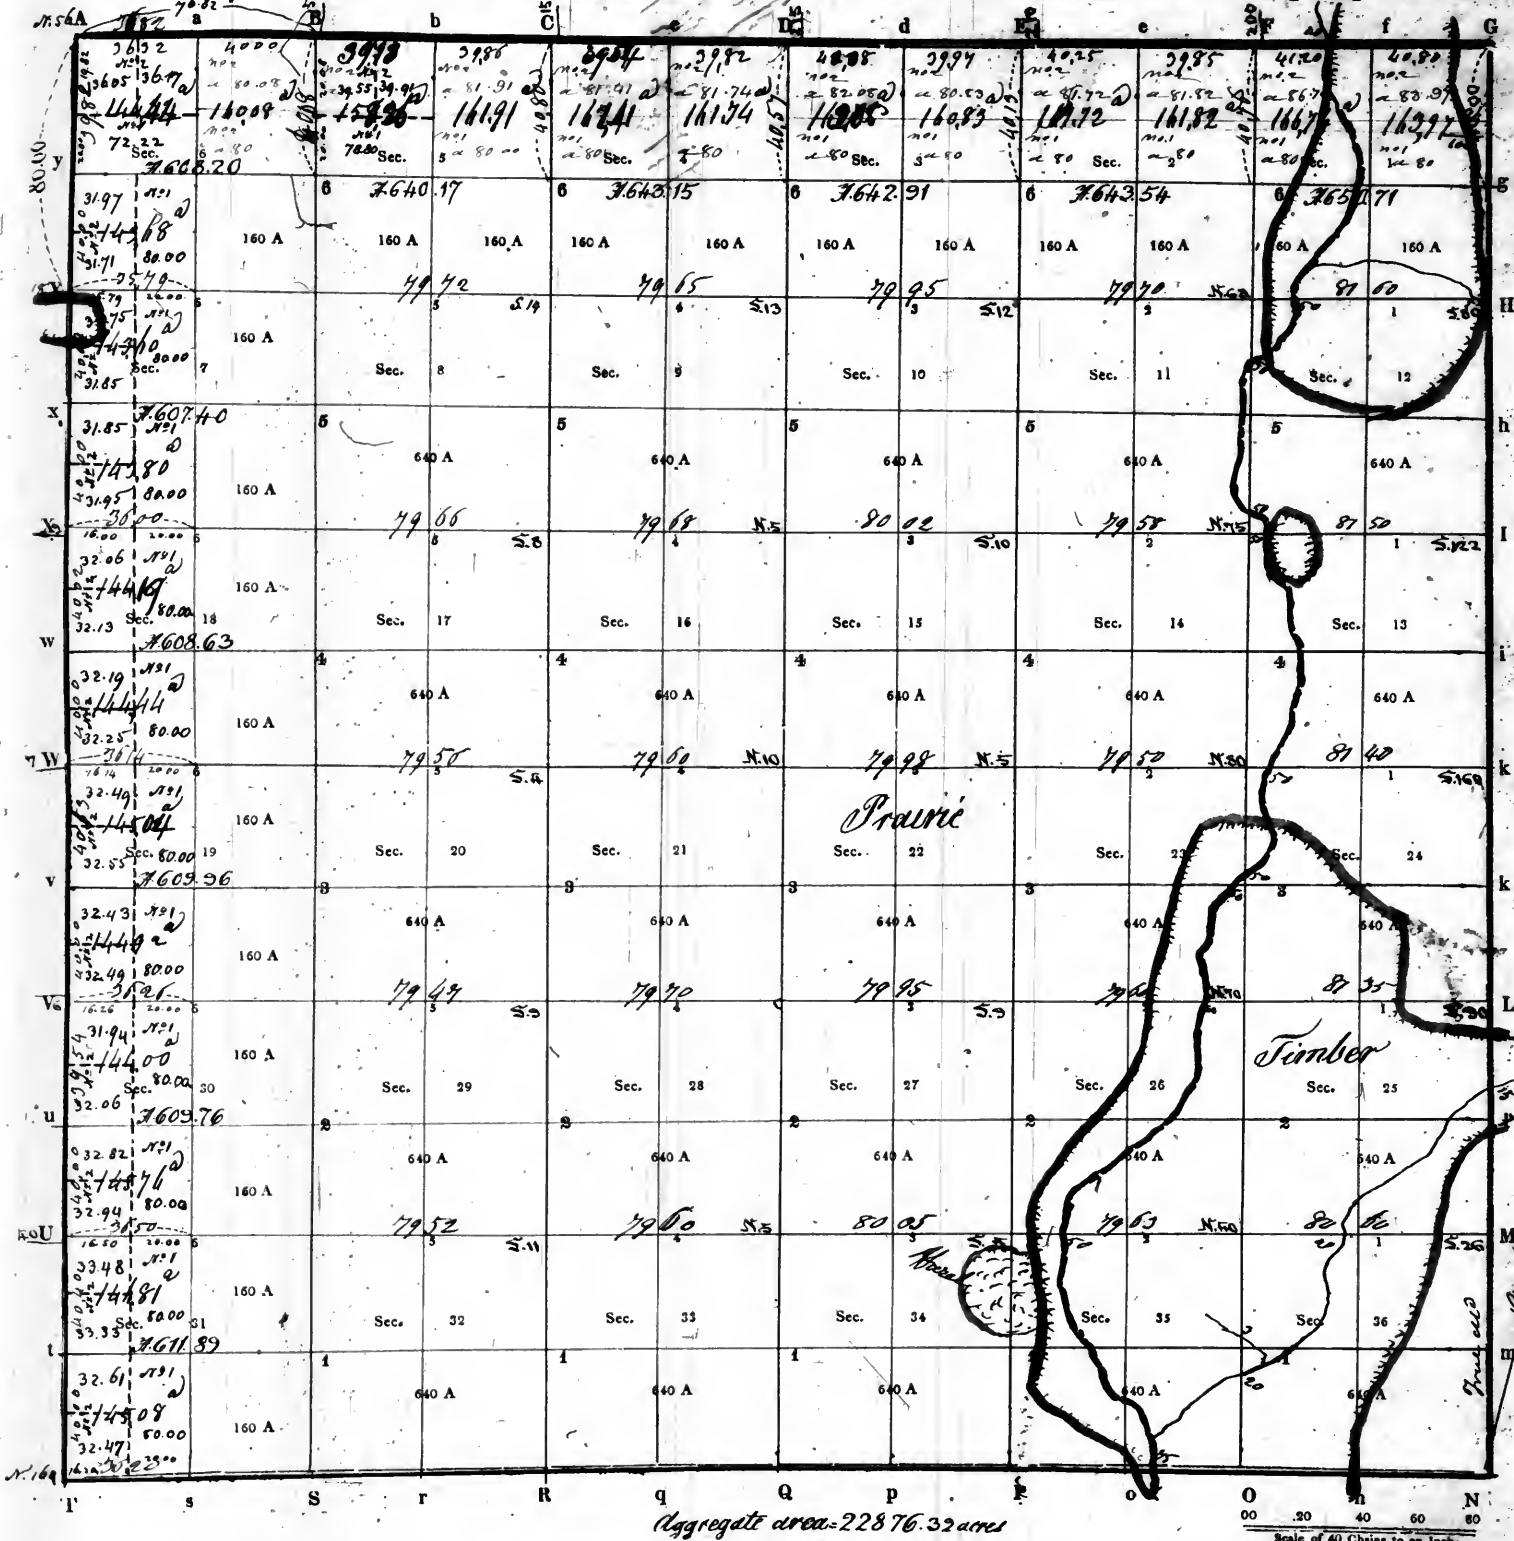

Surveyor's office
St. Louis, Mo. 1549.
The North West quarter of section 5 and
the West halves of sections 6 & 12 in 30 & 31
subdivided and a plat sent to the Register
and another to the Comptroller of the
General Land Office.

On 7.55. 1882

PURSUANT to a contract with, and instructions from William Rector, Surveyor of the lands of the United States in the
States of Illinois
I have measured, laid out and surveyed the above described Township; and do hereby certify, that it had such marks and
bearing date the 17th day of February 1882
as are represented on said plat, and described in the field notes made thereof, and returned with this plat into the Office of the Surveyor of the Lands of the
United States, in the States of Illinois, Missouri and Territory of Arkansas - Surveyed by Rich. T. Holliday
Certified this 17th day of November 1882
for Elias Rector D. SURVEYOR.


EXAMINED.

Recorded

571

page 18 vol 10

Township No. 18 North of the base line, Range No. 4 East of the 3rd principal Meridian.

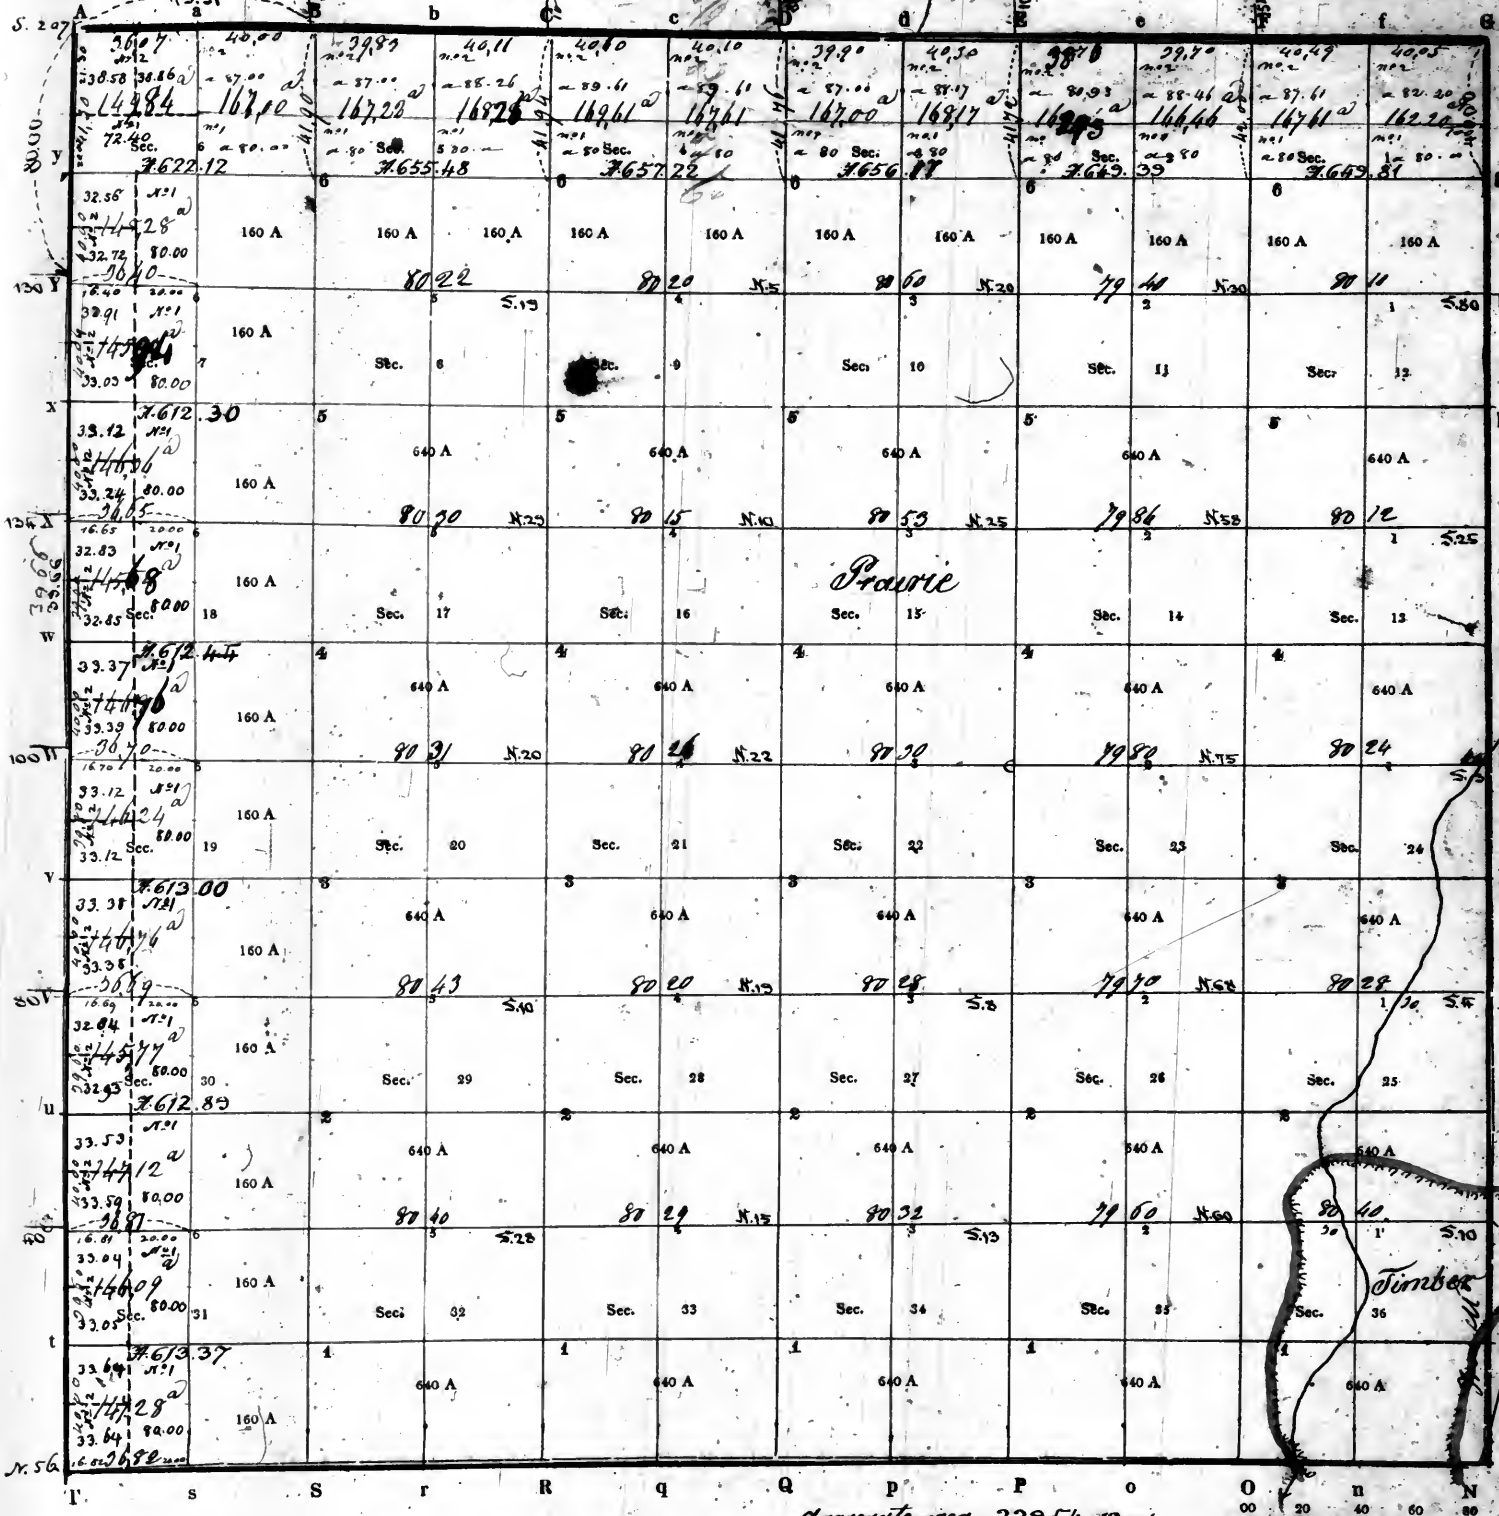

Surveyor's office
Saint Louis June 15th 1849.
The West halves of sections 6, 7, 14, 15, 22, 23
relocated and a plat sent to the Register
and another to the Commissioner of the
General Land Office.


Aggregate area = 22954.19 ac

PURSUANT to a contract with, and instructions from William Rector, Surveyor of the lands of the United States in the
Missouri Territory of Arkansas bearing date the 10th day of February 1842
I have measured, laid out and surveyed the above described Township; and do hereby certify, that it had such marks and bounds, both natural and artificial,
as are represented on said plat, and described in the field notes made thereof, and returned with this plat into the Office of the Surveyor of the Lands of the
United States, in the States of Illinois, Missouri and Territory of Arkansas Surveyed by Richd. T. Holliday
Certified this 10th day of November 1842 for Elias Rector D. SURVEYOR.

EXAMINED.

Recorded

Township No. 19 North of the base line, Range No. 4 East of the 3 principal Meridian.

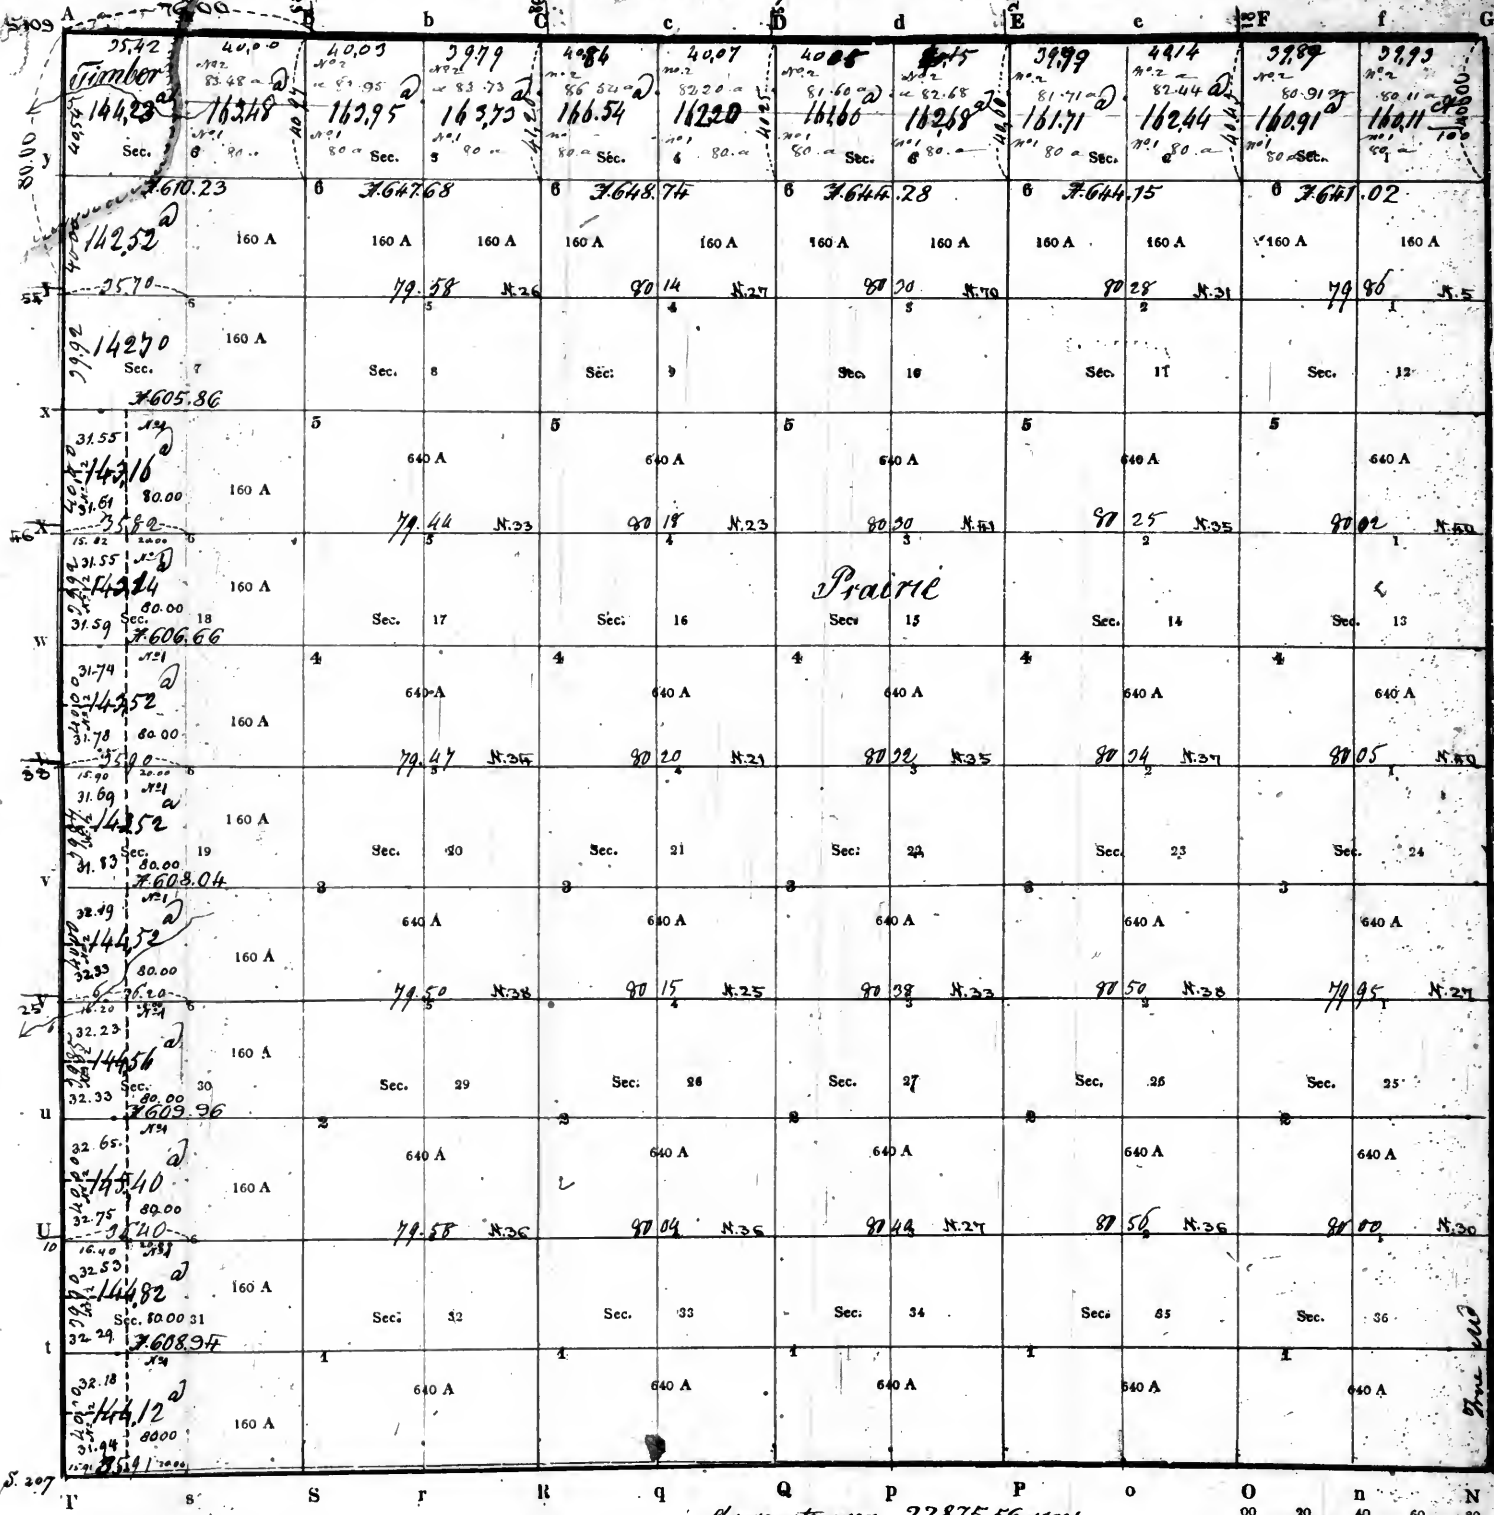

Surveyor's Office
Saint Louis June 15th 1849.
The South West quarter of
section 7, and the east halves
of sections 18, 19, 30 & 31, sub-
divided under the act of Congress
of the 5th of April 1832, and as
plat sent to the Register and
another to the Commissioner
of the General Land Office.

Aggregate area = 22875.56 acres

Scale of 40 Chains to an inch.


PURSUANT to a contract with, and instructions from William Rector, Surveyor of the lands of the United States in the
Missouri and Territory of Arkansas bearing date the *Nineteenth* day of *February* 1822
I have measured, laid out and surveyed the above described Township; and do hereby certify, that it had such marks and bounds, both natural and artificial,
as are represented on said plat, and described in the field notes made thereof, and returned with this plat into the Office of the Surveyor of the Lands of the
United States, in the *States of Missouri, Missouri and Territory of Arkansas*
Certified this *Nineteenth* day of *November* 1822
Surveyed by *Richd. P. Holliday*
for *Elias Rector* D. SURVEYOR.

EXAMINED.

Recorded

Township 20 North of the Base line Range 4 East of 3rd Principal Meridian

page 20 vol 10

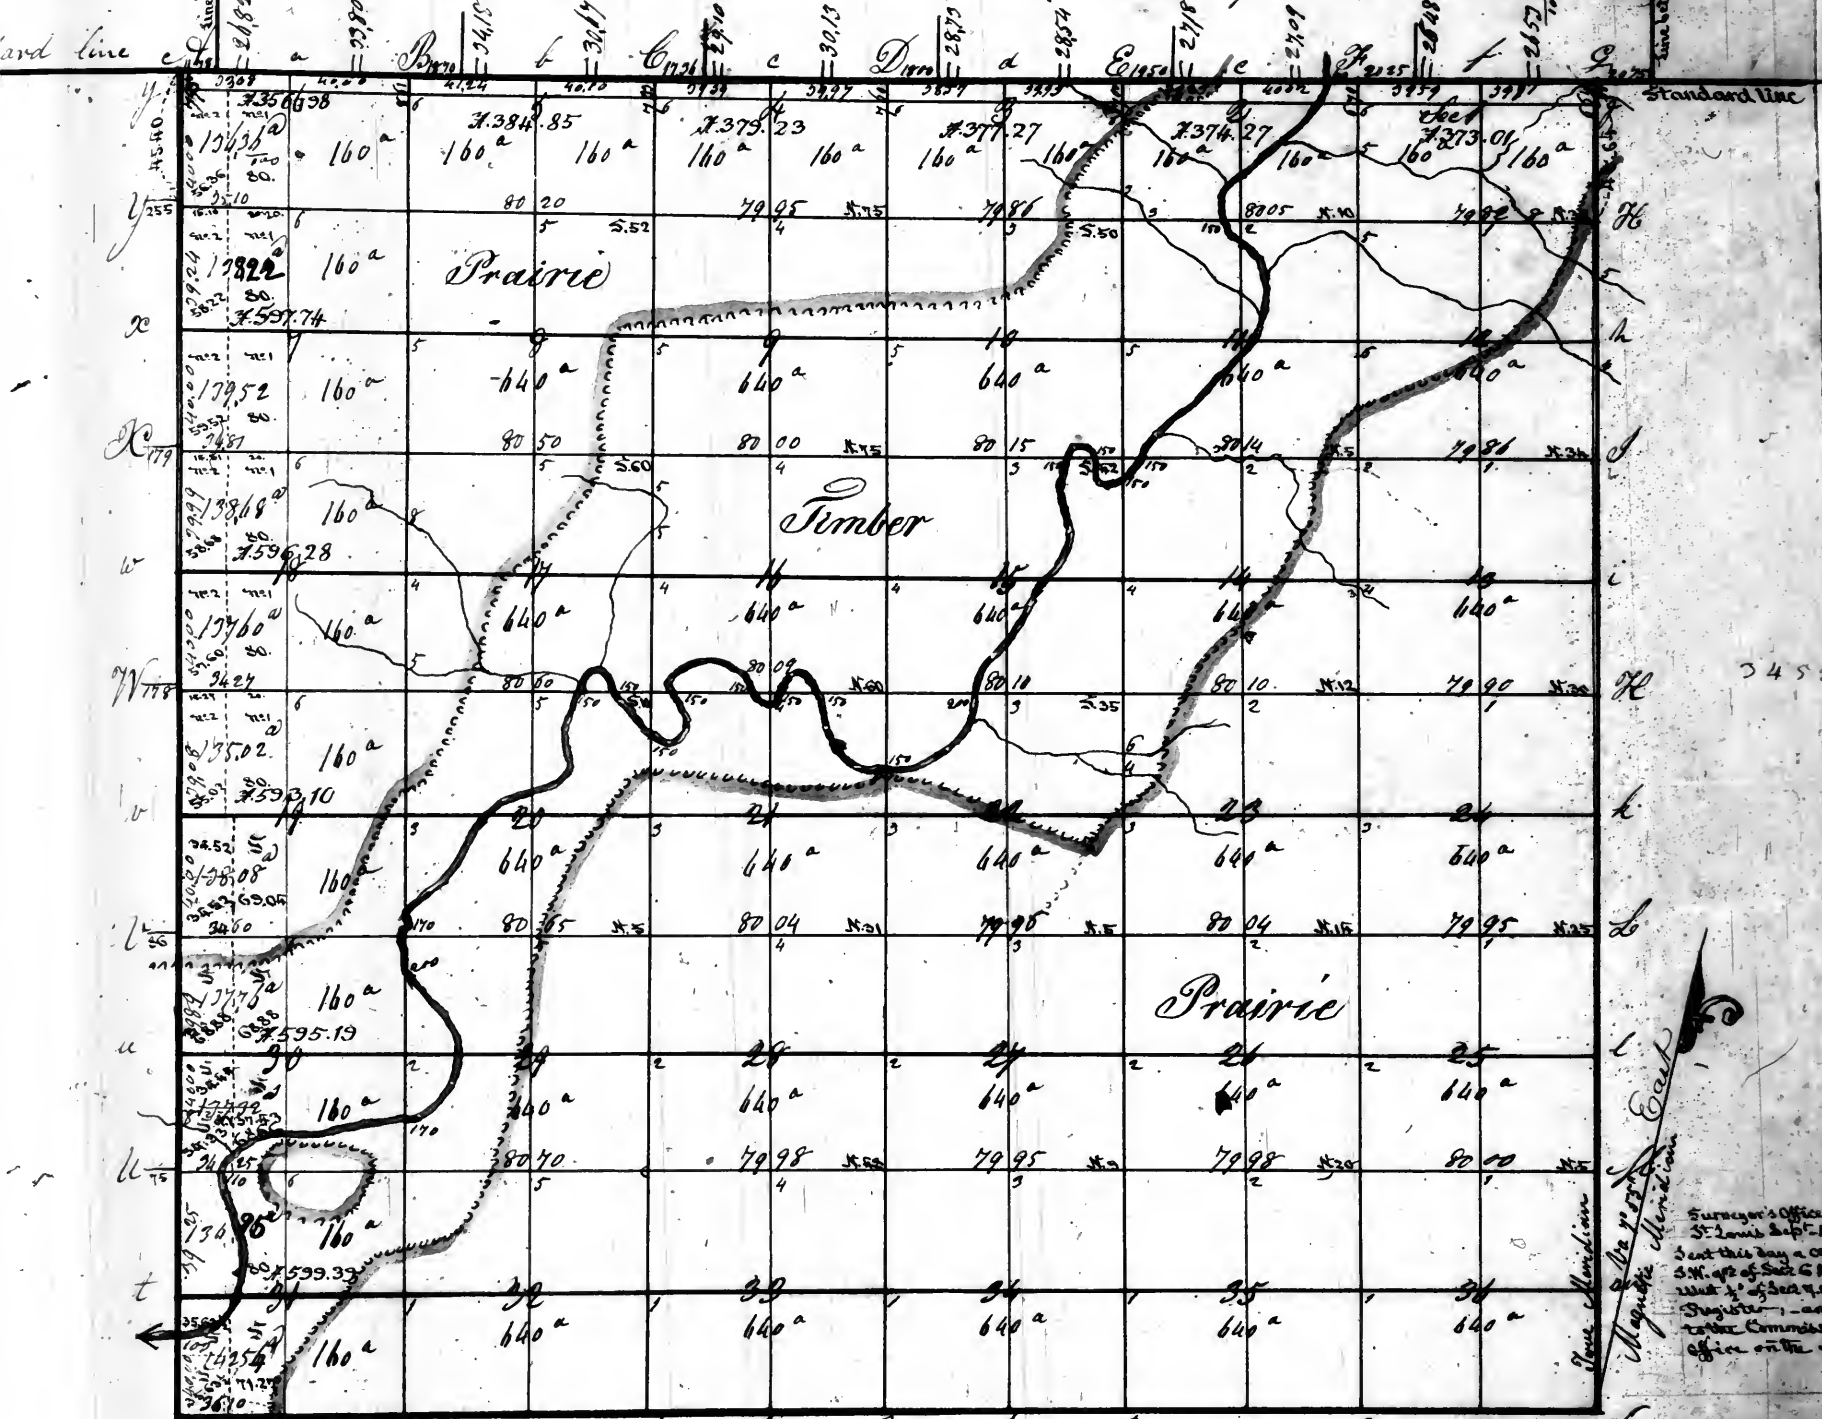

Surveyor's Office
St. Louis Sept. 15. 1846
Sent this day a copy of plat of the
S.W. 1/4 of Sec. 6 & 13, and of the
W. 1/2 of Sec. 9, 10, 14 & 20 to the
Register, and another copy
to the Commr. of the Land
Office on the same day.

Pursuant to a contract with & instructions from William Hector Surveyor of the Lands of the United States in the States of Illinois - Missouri and Territory of Arkansas bearing date the nineteenth day of February 1822 I have measured laid out and surveyed the above described Township & do hereby certify that it had such marks and bounds both natural and artificial as are represented on said plat and described in the field notes made thereof and returned with this plat into the Office of the Surveyor of the Lands of the United States in the States of Illinois Missouri & Territory of Arkansas

Certified this 15th day of November 1822

Surveyed by Rich. T. Halliday
for Elias Hector D. Surveyor

Examined


Recorded

Township 21 North of the Base line Range 4 East of the third Principal Meridian
page 21 vol 10

by D. Anderson & P. O. Lee
apparently in Sept. 1833 & on 7.30
book 314

The notes used in the construction of this plat are contained in field books numbered and conditions as follows viz:
of the South bound line in a field book numbered 113 and signed Joseph Brough
Var. not stated
Of the East West North boundaries in a field book numbered 314 and signed "Sword"
"Anderson, D." Variation 7.30 E
Of the subdivisions lines in a field book numbered 536 and signed David Anderson, D.
Variation 7.30 East

Surveyor's Office
Saint Louis June 15th 1849.
The North halves of sections 12, 4, 5 & 6, the North West quarter of section 2, the West halves of sections 18, 19 & 30, and the South West quarter of section 31 subdivided under the act of Congress of the 5th of April 1832, and a plat sent to the Register and another to the St. Commissioner of the General Land Office.

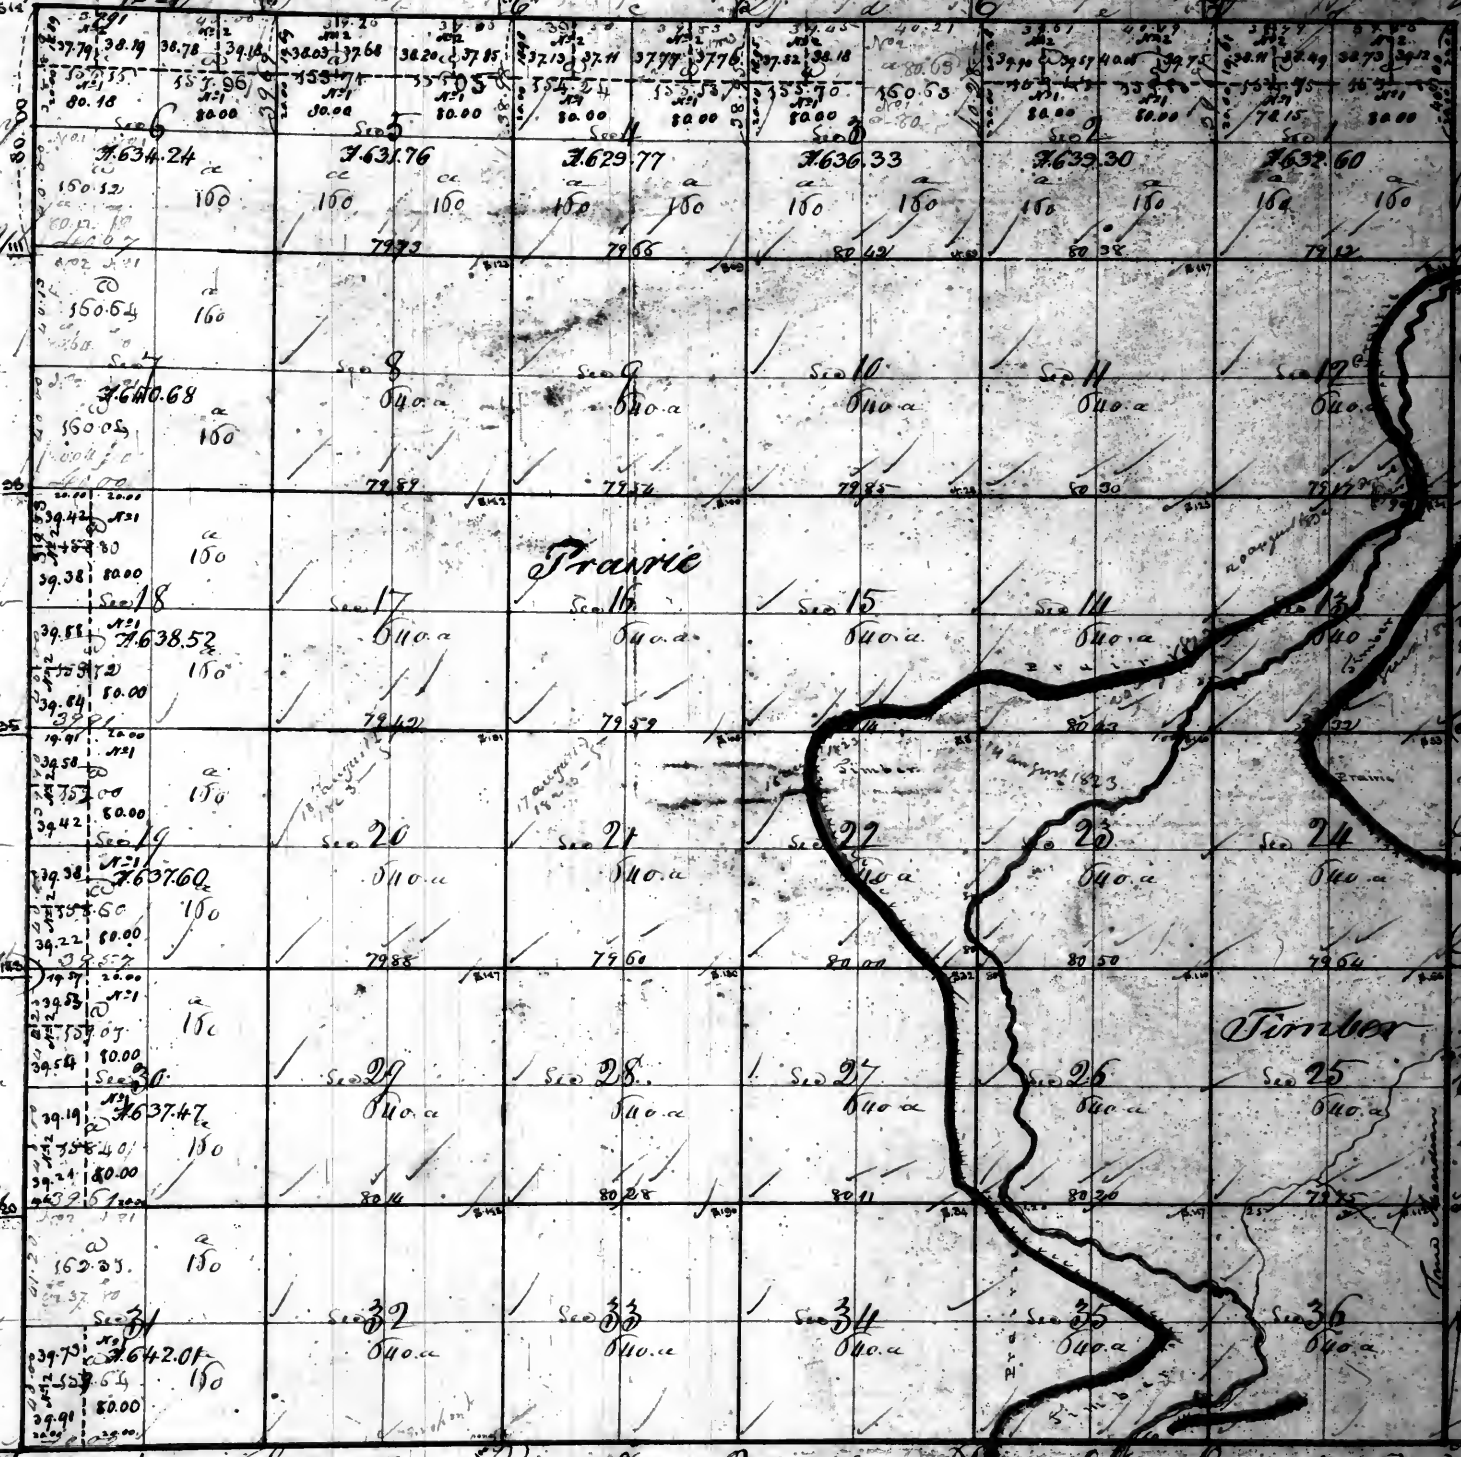

Aggregate area - 23000 acres

Pursuant to a contract with and instructions from William Rector Surveyor of the Land of the United States in the State of Illinois and Missouri and Territory of Arkansas bearing date the 21st day of June 1833 to have administered laid out and surveyed the above described Township and do hereby certify that it had such marks and bounds both natural and artificial as are represented in said plat and described in the field notes made thereof and returned with plat into the office of the Surveyor of the Land of the United States in the State of Illinois and Missouri and Territory of Arkansas.

Certified this 23rd day of August 1833

David Anderson Surveyor

Patrick O. Lee

Surveyor's Office St. Louis 30th Sept. 1832.
The above plat of Township 21 North, Range 4 East of the 3rd principal Meridian is conformable to the field notes of the survey thereof on file in this office, as stated in the margin.


E. T. Langhorn

Recorded

Township N. 32 North of the Base line Range N. 7 East of the third Principal Meridian

page 22 vol 10

Surveyor's office?
Saint Louis June 15th 1849.
The North East 1/4 of section 1,
the North West 1/4 of section 4,
and the West halves of sections
6, 7, 18, 19, 30 & 31 subdivided
this day, and a plat sent to
the Register and another to
the Commissioner of the
General Land office.

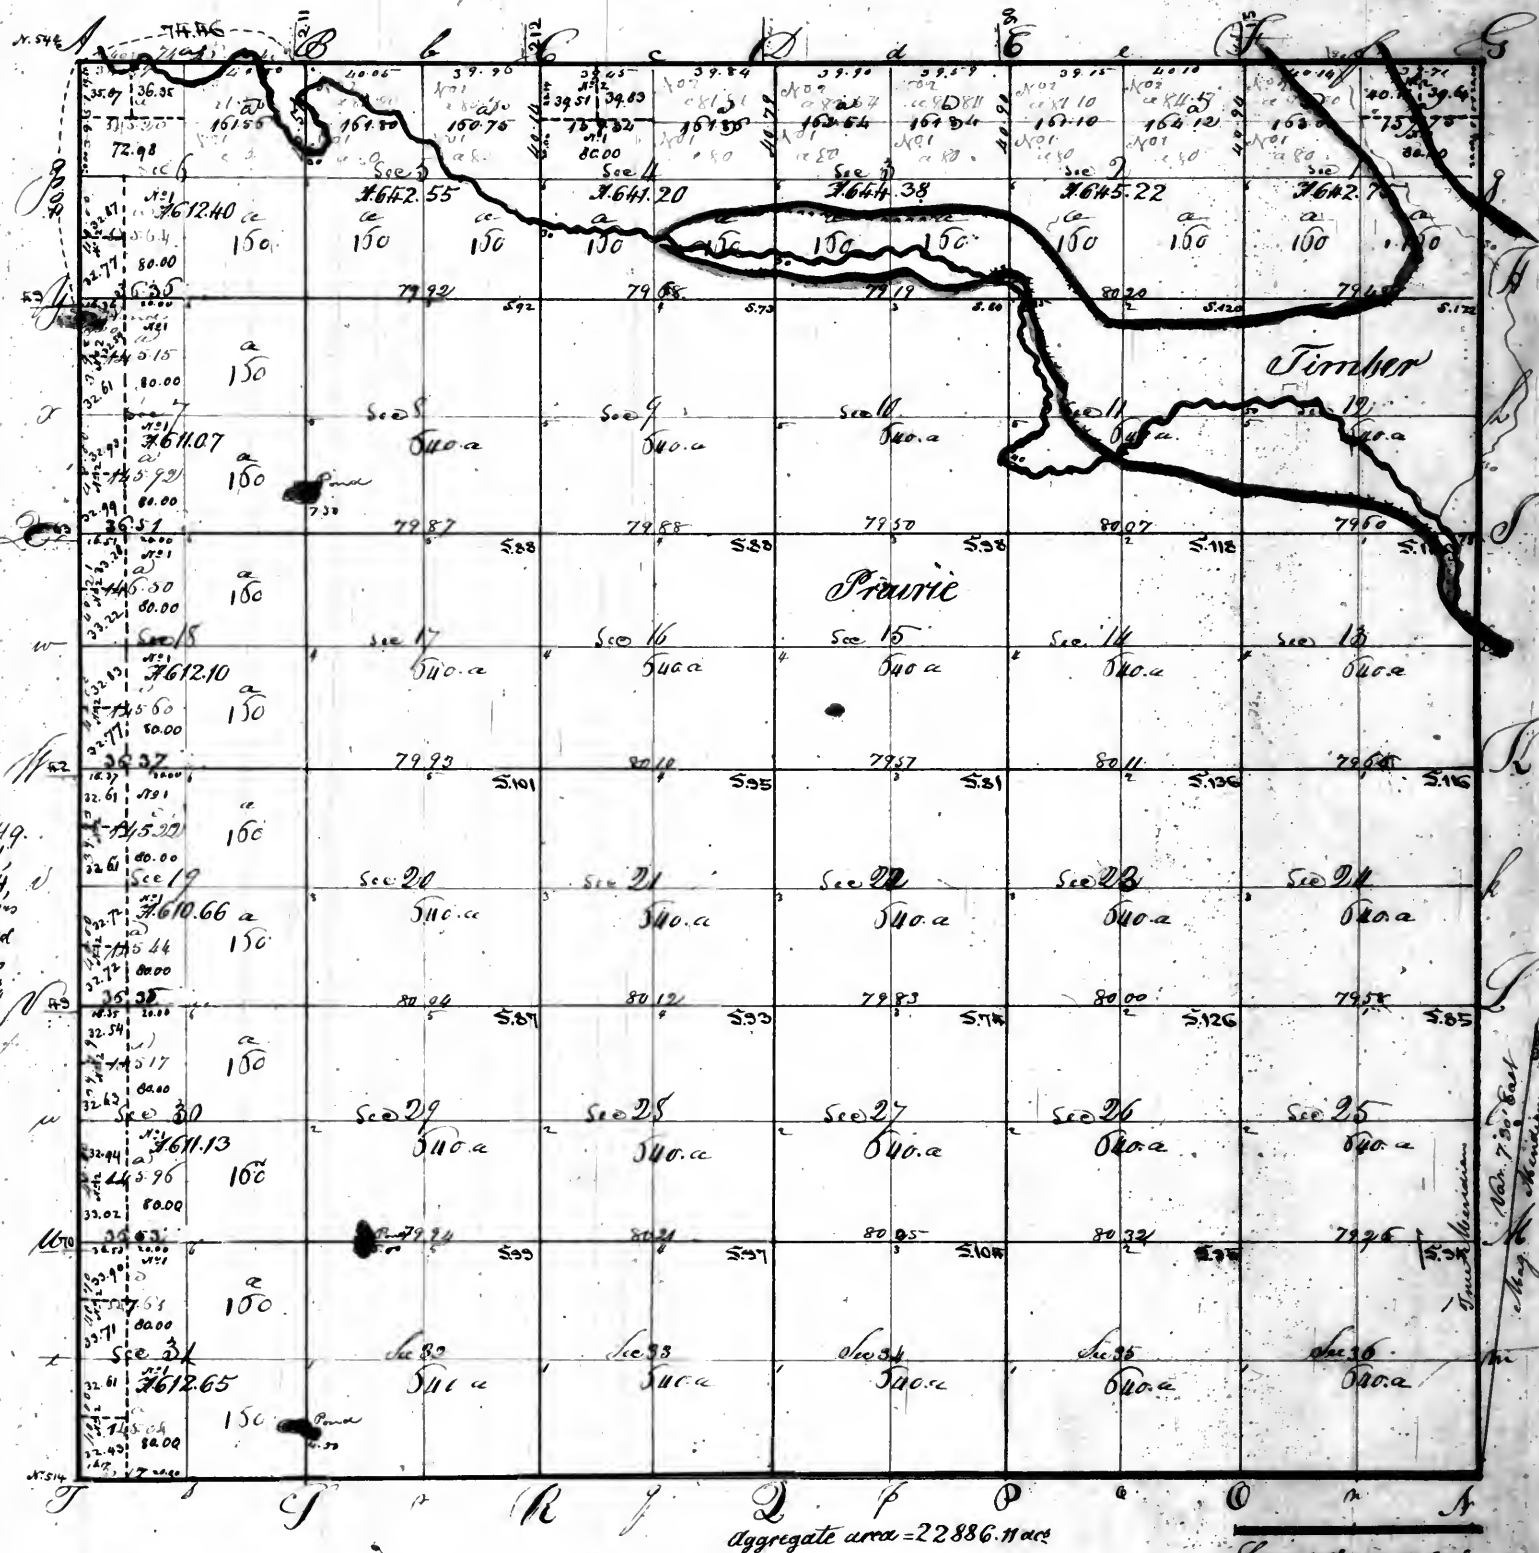


Pursuant to a contract with and instructions from William Rector Surveyor of the Land of the United States in the States of Illinois and Missouri and Territory of Arkansas bearing date the 1st day of June 1849. We have measured laid out and surveyed the above described Township and do hereby certify that it has such marks and bounds both natural and artificial as are represented on said plat and described in the file notes made thereof and returned with this plat into the office of the Surveyor of the Land of the United States in the States of Illinois and Missouri and Territory of Arkansas—

but since the 31st day Oct 1853

David Anderson } D. Surveyor
Patrick H. Oscar } Lt.

Recorded


Township 23 North of the Base line Range 27 East of the 3rd Principal Meridian
Page 23 vol 10

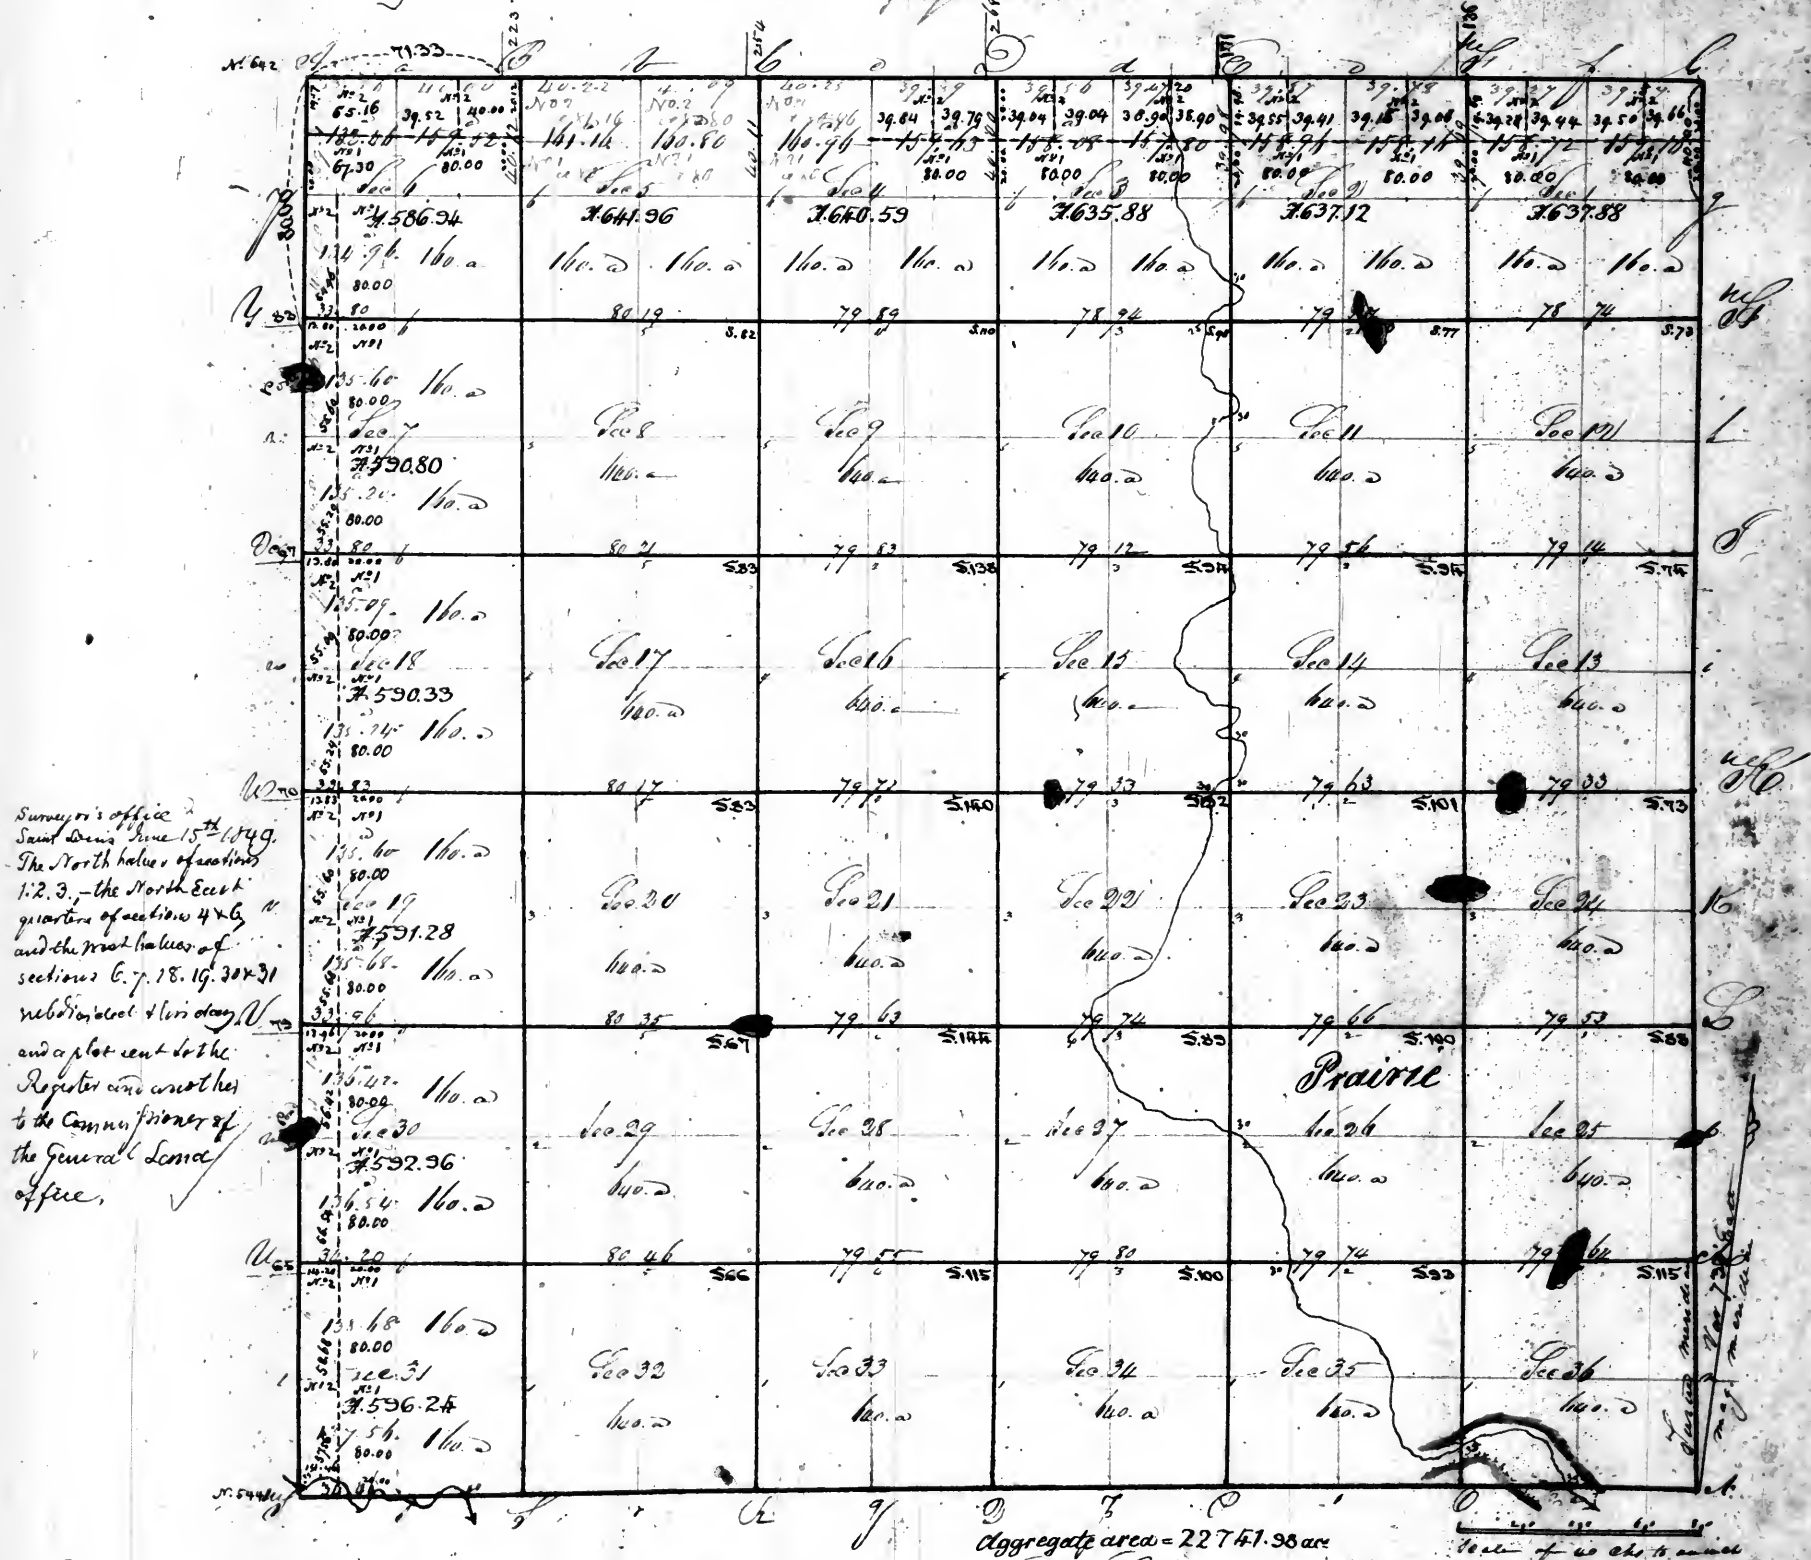

Pursuant to a contract with and instructions from William Belter Surveyor of the lands of the United States in the States of Illinois and Missouri and Territory of Arkansas bearing date the 10th day of June 1848 have a measured laid out and surveyed the above described Township and do hereby certify that it has been measured and bounds both natural and artificial as are substantiated on said plat and described in the field notes made thereof and returned with this plat into the office of the Surveyor of the lands of the United States in the States of Illinois and Missouri and Territory of Arkansas
Certified this 23rd day of December 1843
Platman
Patrick M. Lee Deputy Surveyor
David Anderson

Record

Township N. 24 North of the base line, Range N. 7 East of the Principal Meridian

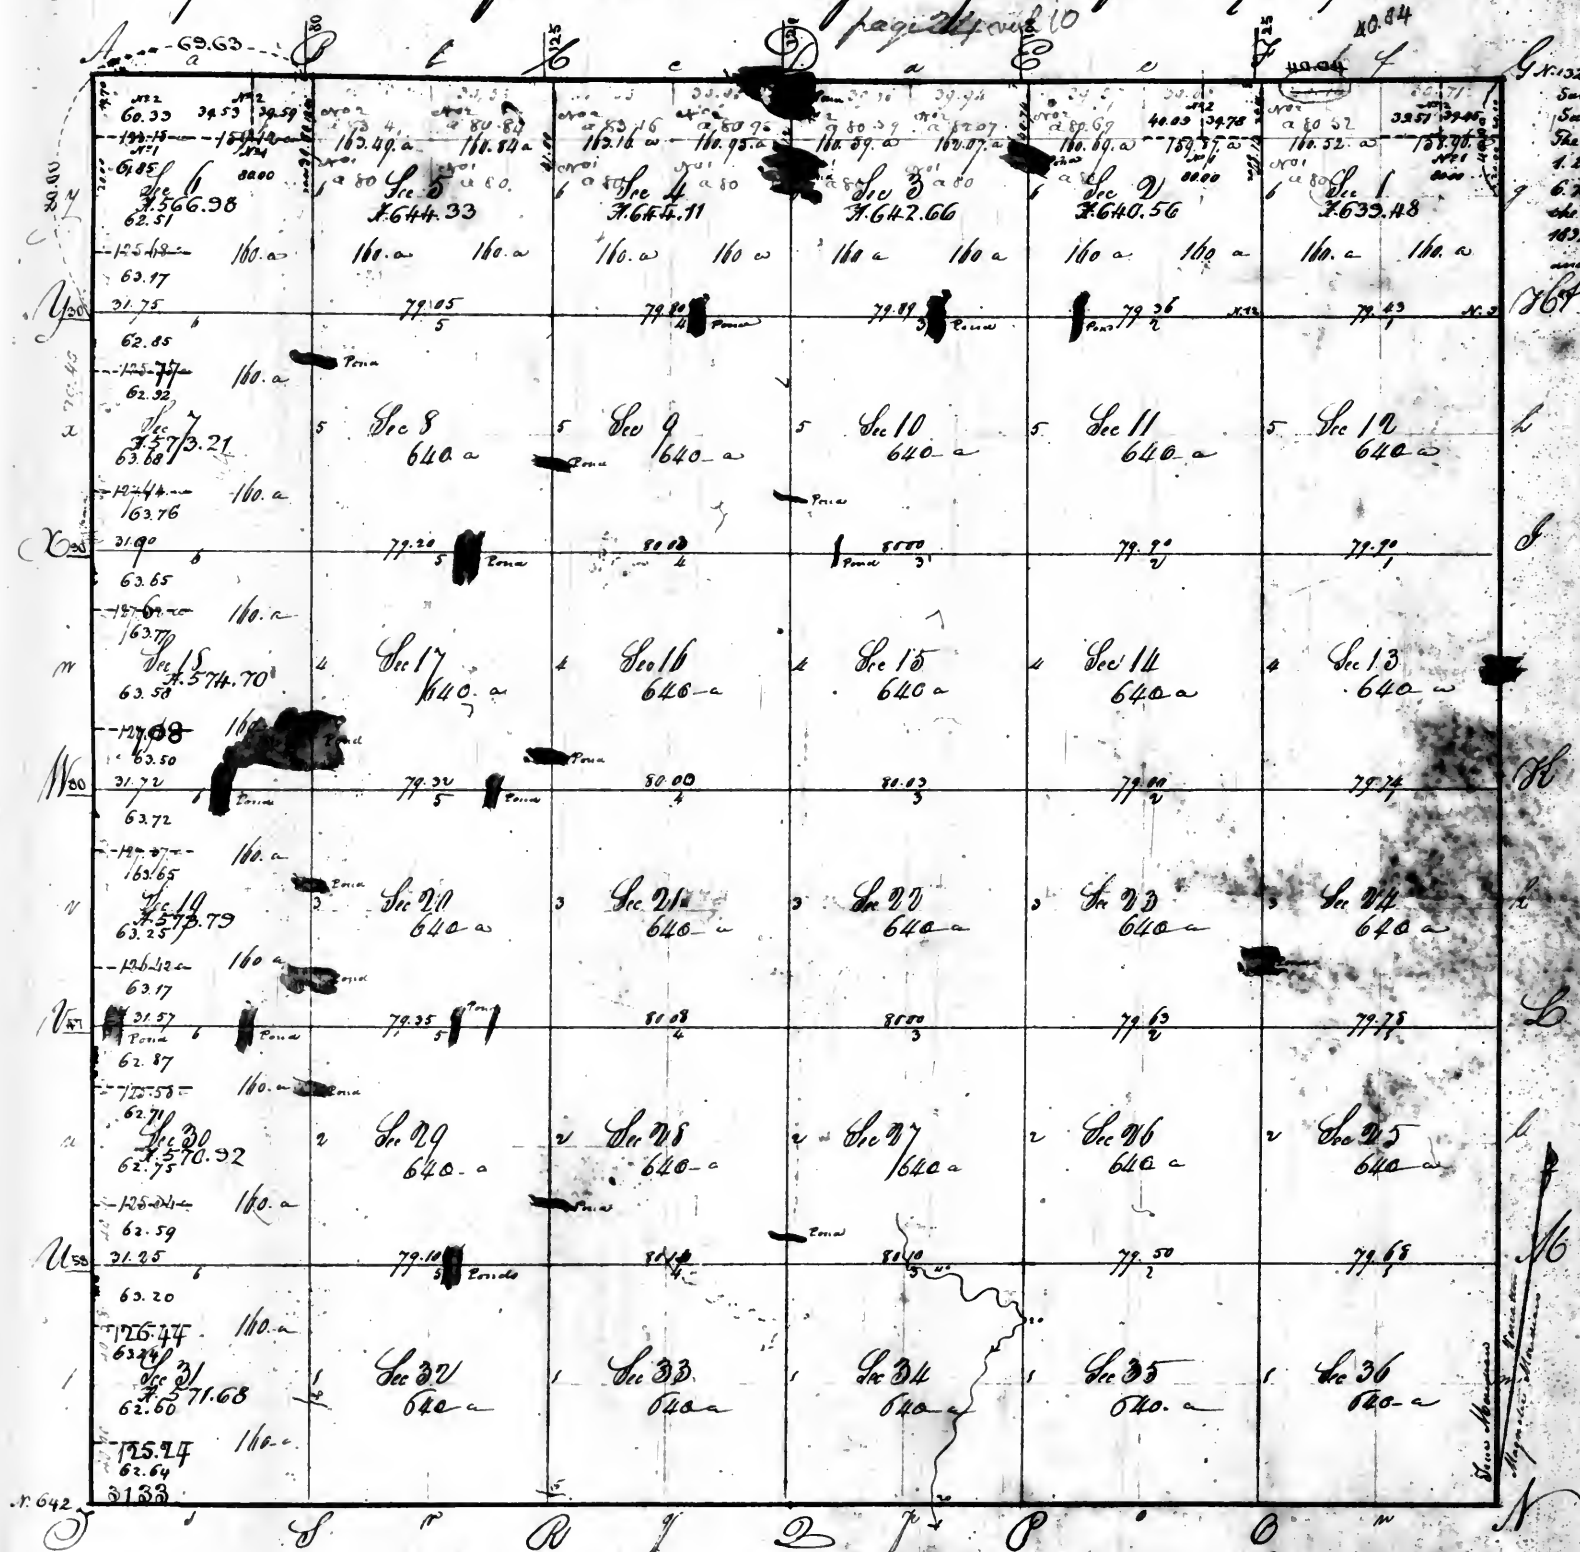


Whereas it is a Contract with, and instructions from, William Rector, Surveyor of the lands of the United States in the States of Illinois and Missouri and Territory of Arkansas. bearing date the third day of October 1823. I have admeasured, laid out and surveyed the above described Township. And do hereby certify, that it has such marks and bounds both natural and artificial as are represented in said plat, and described in the field notes made thereof, and returned with this plat into the office of the Surveyor of the Lands of the United States, in the States of Illinois and Missouri and Territory of Arkansas.

Certified this Jan 20 1824

E. Rector, Surveyor

Recorded
 Township No. 25 North of the Base line, Range No. 7 East of the 3rd Principal Meridian
 page 25 vol 10
 1960

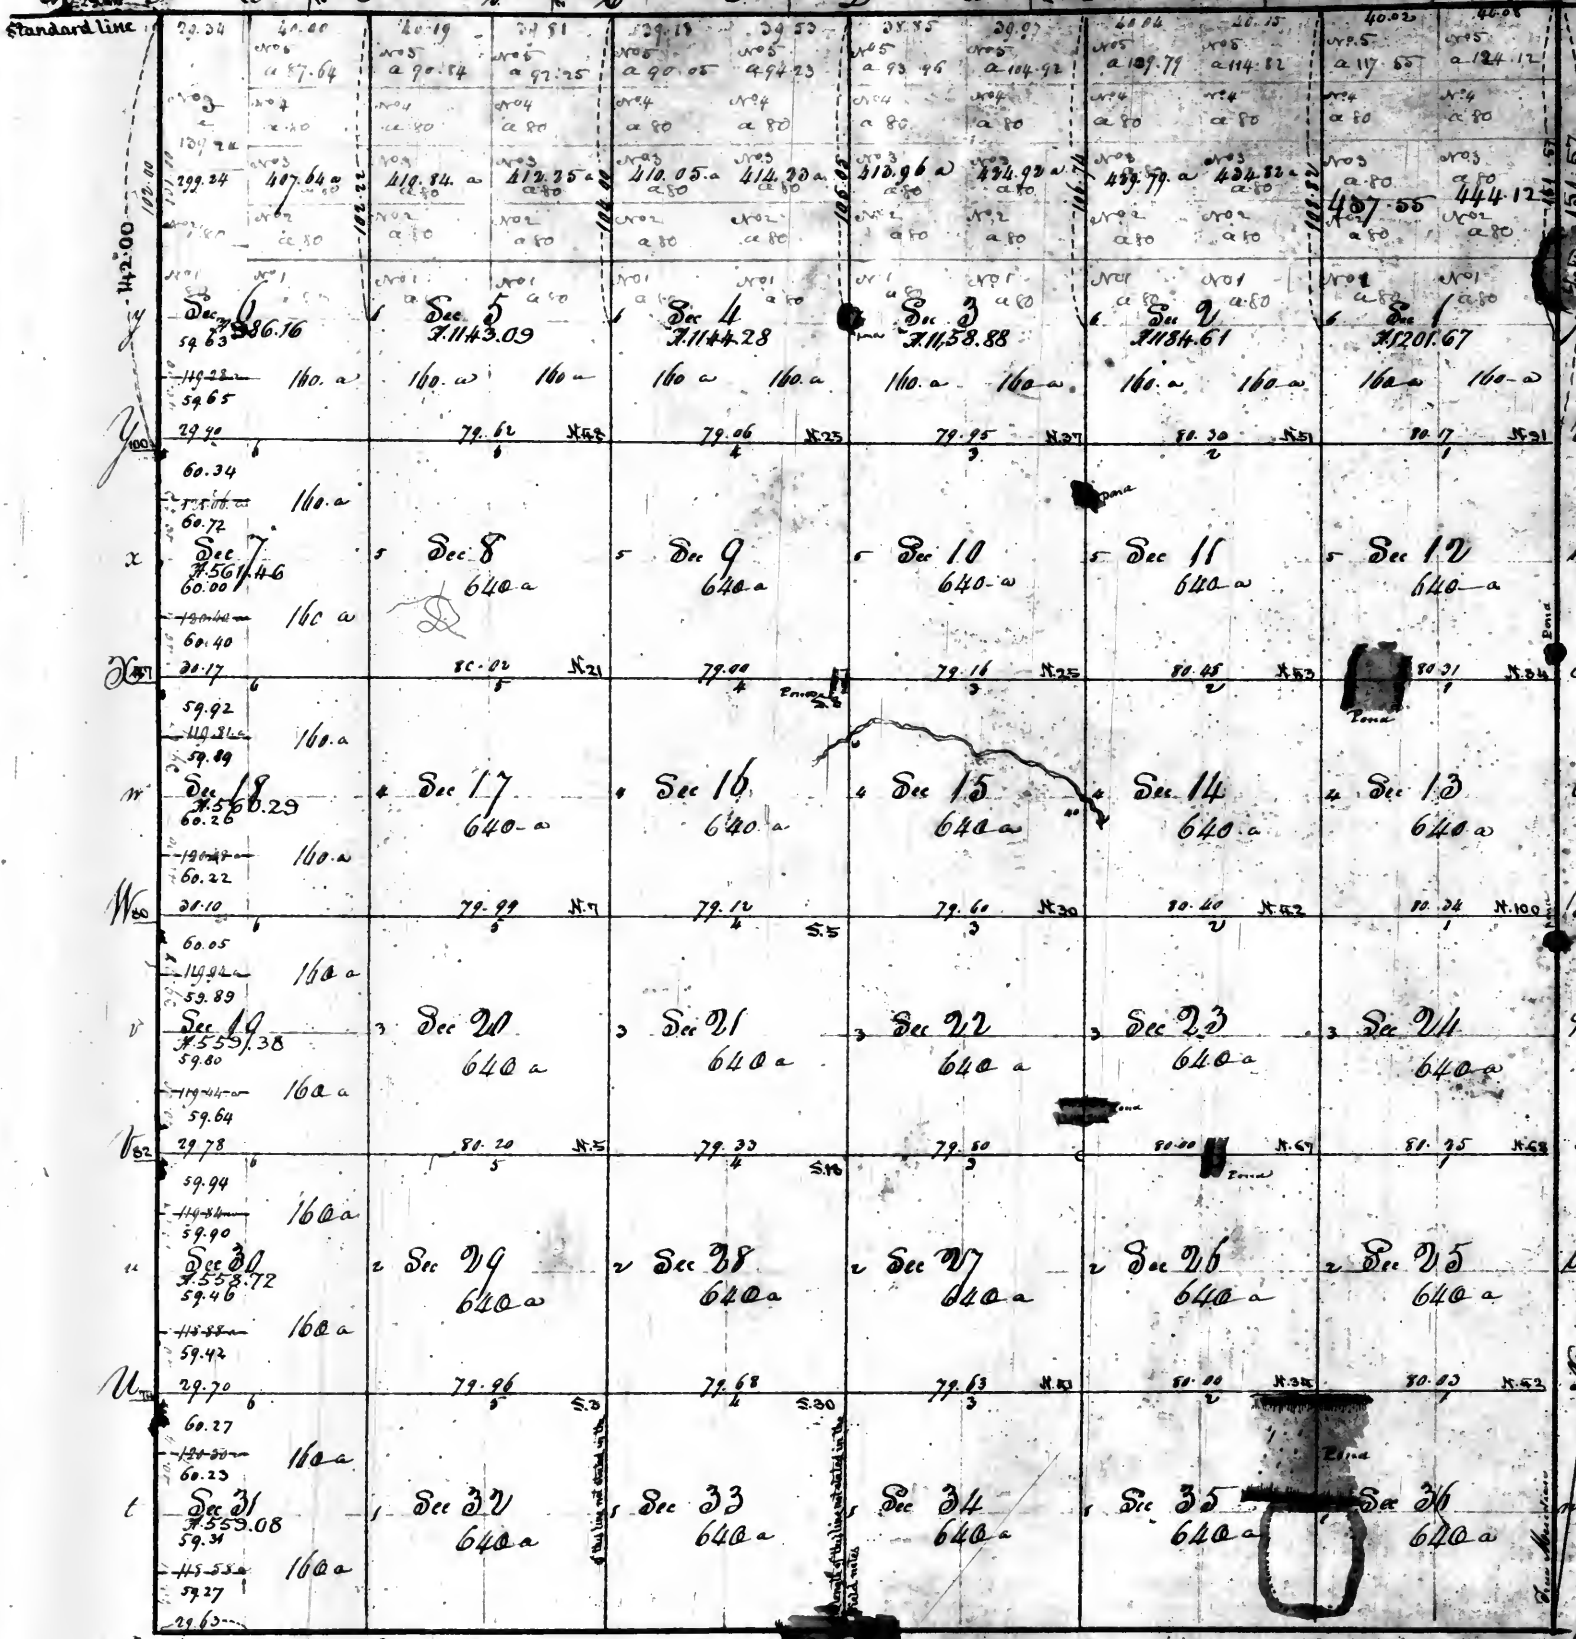

Small Laid June 9th 1849.
 The South West quarter of section 25 and the West halves of sections 26, 27, 28, 29, 30, 31, 32, 33, 34, 35, 36, under the Congress of the 5th of April 1849, and a plat sent to the Register and a plat sent to the Commissioner of the General Land Office.


105.05
 106.82
 213.87
 106.93

Pursuant to a contract with, and instructions from William Reiter, Surveyor of the lands of the United States in the States of Illinois and Missouri and Territory of Arkansas, bearing date the third day of October 1820. I have, as directed, laid out and surveyed the above described Township. And do hereby certify that it had such marks and bounds as both natural and artificial as are represented on said plat, and described in the field notes made during, and returned with this plat into the office of the Surveyor of the Lands of the United States, in the States of Illinois and Missouri and Territory of Arkansas.

Verified the 20 1824

E. Reiter D. Surveyor

26

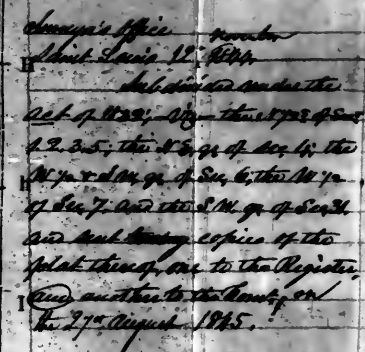

I have admeasured, laid out and surveyed the above described Township; and do hereby certify, that it had such marks and bounds, both natural and artificial, as are represented on said plat, and described in the field notes made thereof, and returned with this plat into the Office of the Surveyor of the lands of the United States, for the *States of Illinois & Missouri & Territory of Arkansas.*


Certified this _____ day of _____

EXAMINED.

• D. SURVEYOR

Township No. *20* North of the base line, Range No. *7* East of the *3^d* principal Meridian.

739.

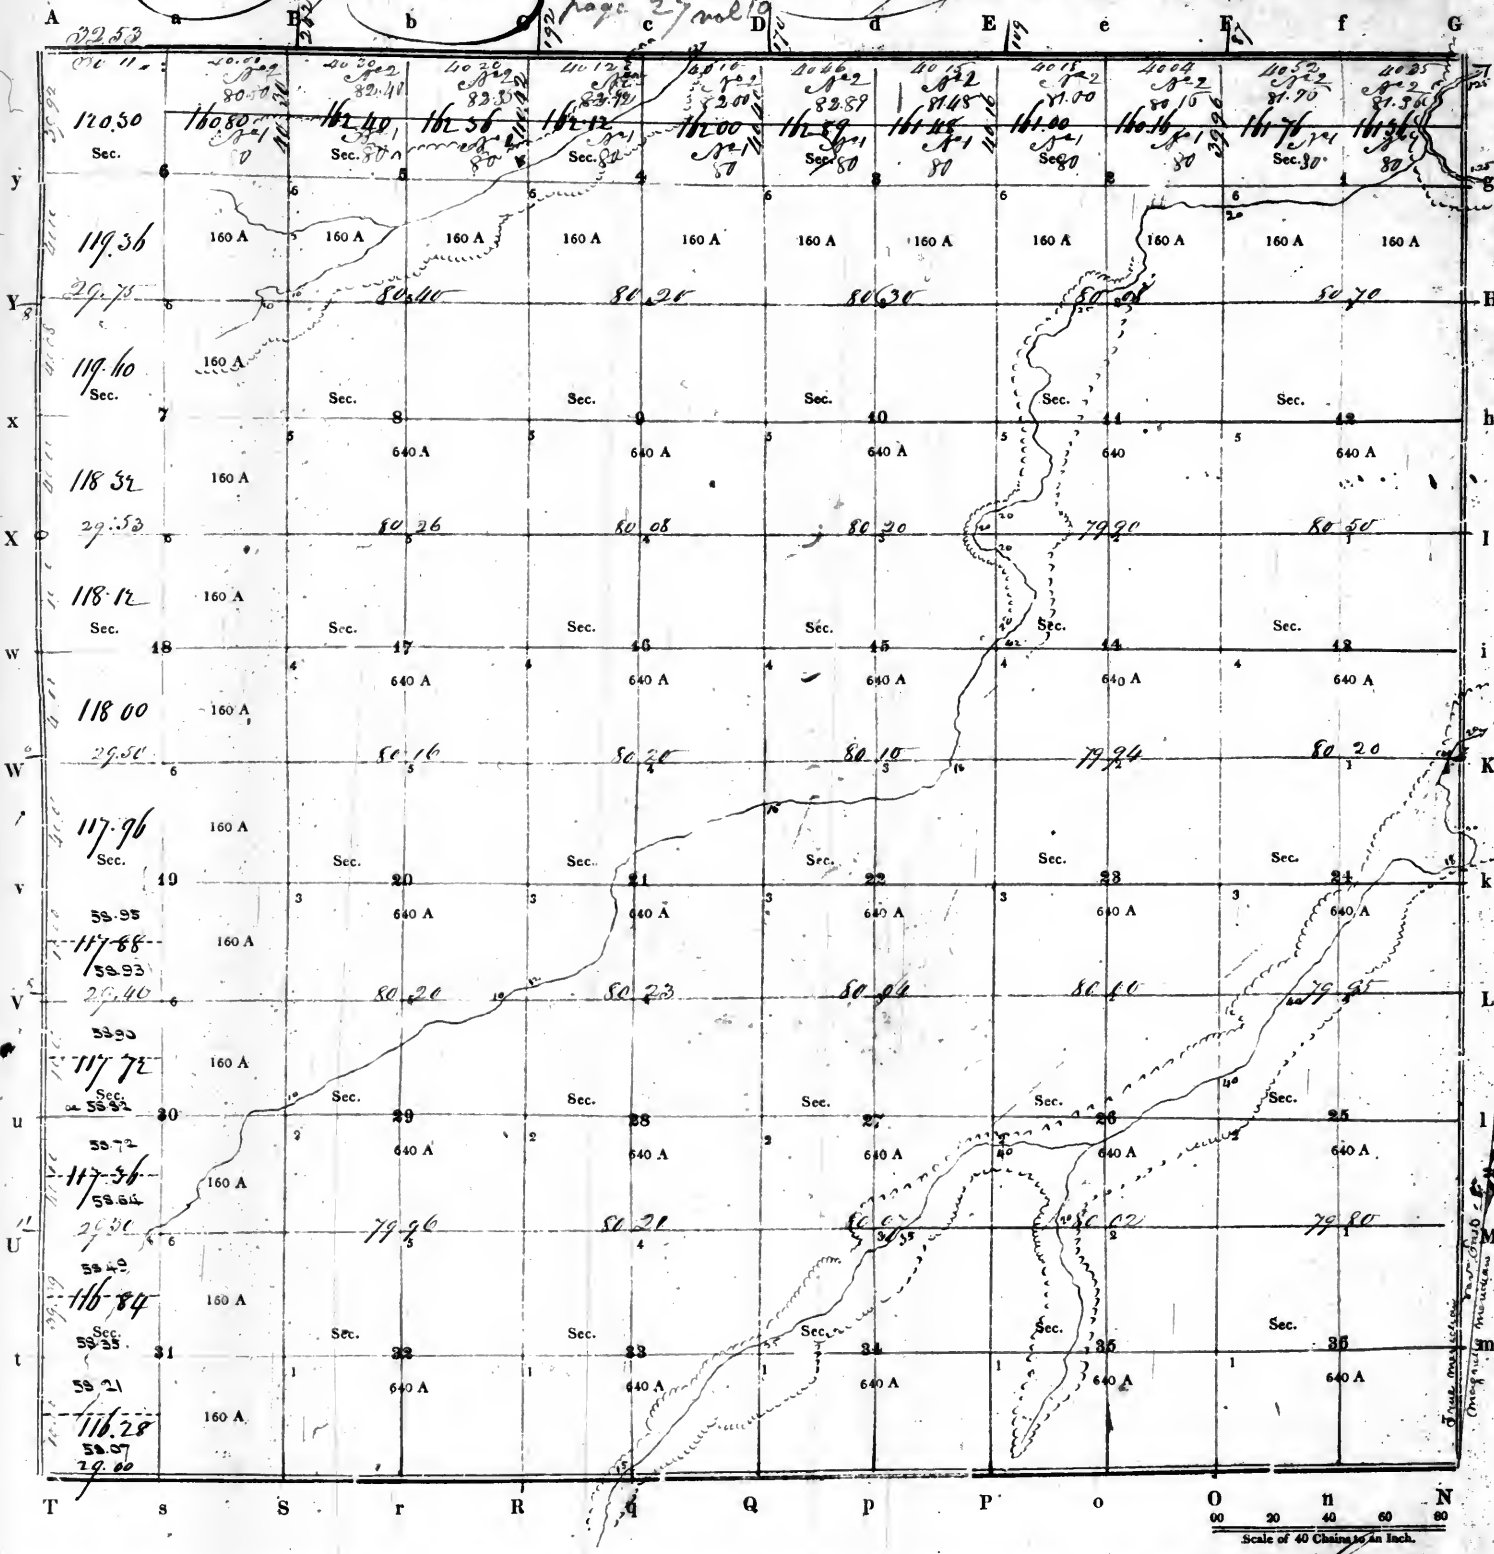

Surveyor's Office, November 12, 1821.
Subdivided under the act of 1132, 1133, the S. M. 90 of Sec. 15, the W. 1/2 of S. 30 & 31, and had today a copy of this plat made, one to the Reg. & another to the Comr. or the 27th of August 1845.

PURSUANT to a contract with, and instructions from WILLIAM RECTOR, Surveyor of the lands of the United States in the *State of Missouri & Territory of Arkansas* bearing date the *twentieth* day of *March* 1821


I have admeasured, laid out and surveyed the above described Township; and do hereby certify, that it had such marks and bounds, both natural and artificial, as are represented on said plat, and described in the field notes made thereof, and returned with this plat into the Office of the Surveyor of the lands of the United States, for the *State of Missouri & Territory of Arkansas*.

Certified this *11* day of *June* 1821

EXAMINED.

June 1821


Township No. 22 North of the base line Range No. 7 East of the 2^d principal Meridian
page 28

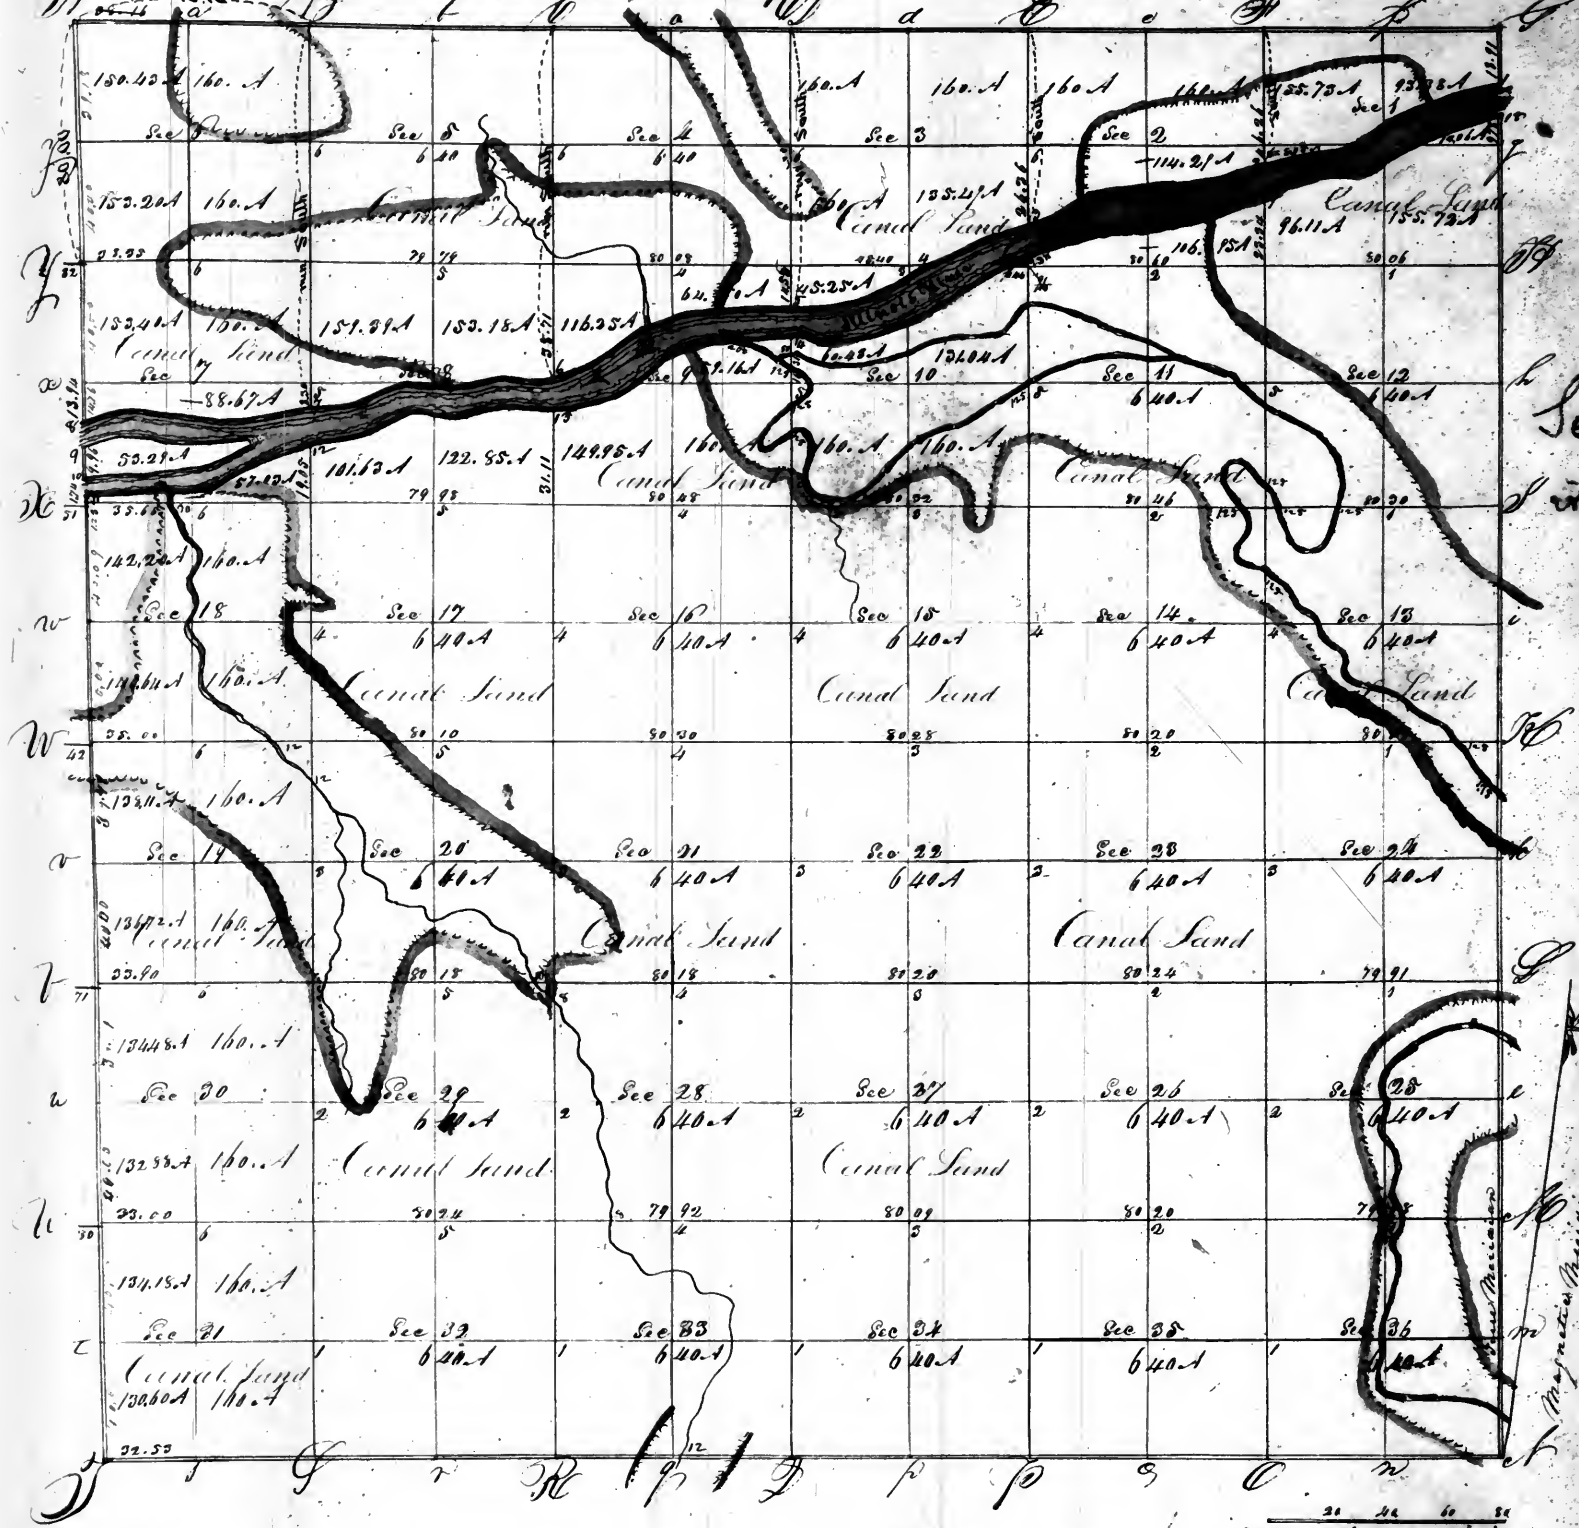

See the plat
in Vol. 28, p. 8

Pursuant to a Contract with and instructions from William Hector, Surveyor of the lands of the United States in the States of Illinois and Missouri and Territory of Arkansas bearing date the 30th day of March 1825 I have administered, laid out and surveyed the above described Township and do hereby Certify that it has such marks and bounds, both Natural and artificial as are represented on said plat and described in the field notes made thereof and returned with this plat into the office of the Surveyor of the Lands of the United States in the States of Illinois and Missouri and Territory of Arkansas

Township No. *34 North* of the base line, Range No. *7 East* of the *3^d* principal Meridian.

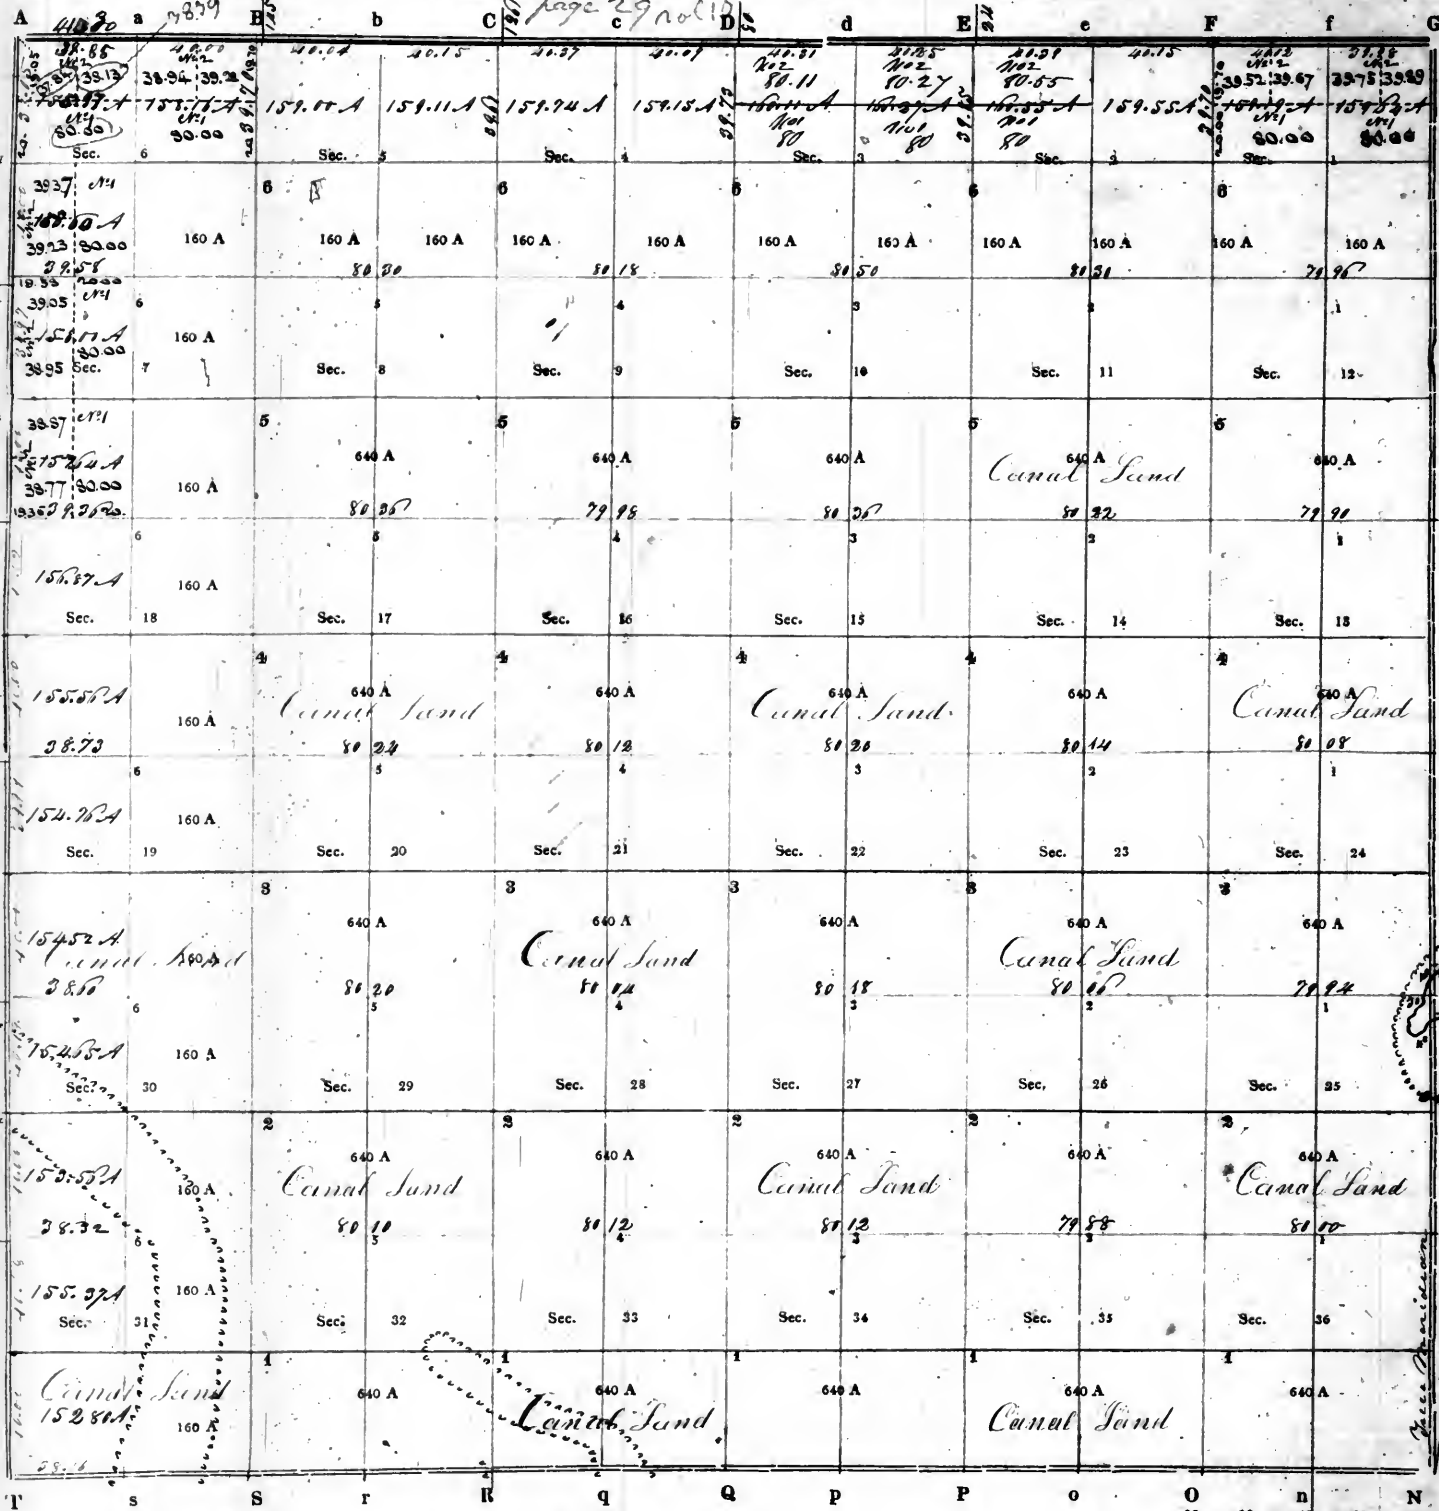

Surveyor's Office
St. Louis 12 Nov. 1864
decided under the act of
the 10th of August 1865.

PURSUANT to a contract with, and instructions from **William Rector**, Surveyor of the lands of the United States in the *States of Illinois and*
Missouri and Territory of Arkansas bearing date the *Twenty-fifth day of March - 1865*
 I have admeasured, laid out and surveyed the above described Township; and do hereby certify, that it had such marks and bounds, both natural and artificial,
 as are represented on said plat, and described in the field notes made thereof, and returned with this plat into the Office of the Surveyor of the Lands of the
 United States, in the *States of Illinois and Missouri and Territory of Arkansas*

Certified this

day of


1865

EXAMINED.

D. SURVEYOR.

Recorded

Page 31, vol 10

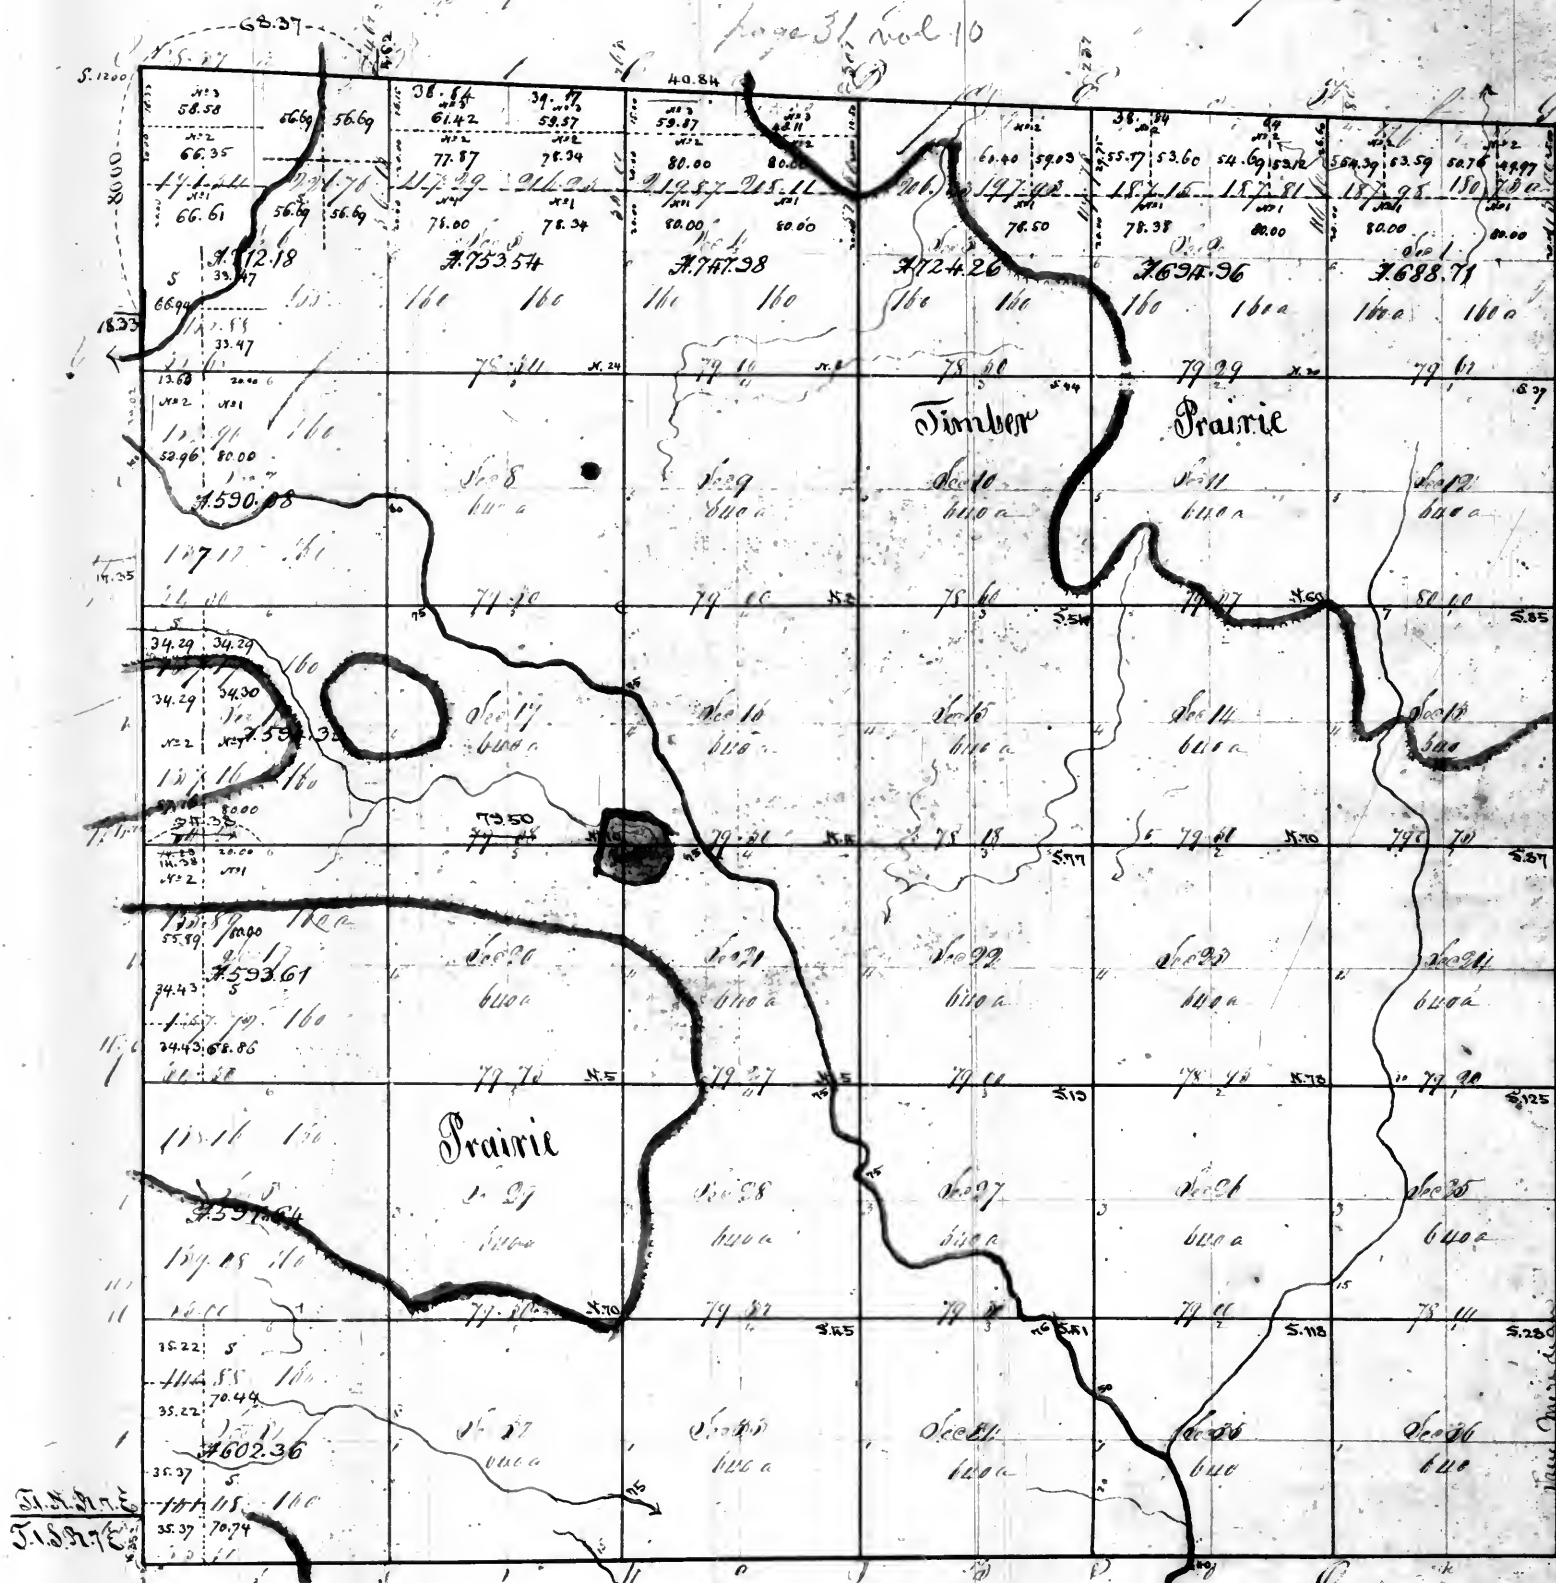

Office of the Surveyor General
for the State of Illinois
Saint Louis July 19th 1857

The North half of section 1, 2, 4 & 5
the North East quarter of section 3
the North West quarter of section 6, 7, 8, 9
and the South East quarter of section 10
subdivided under the act of Congress
of the 5th of June 1832 - 1833

The North East and the South East
quarters of section 6, the North East
quarter of section 10, the South East
quarter of section 19, and the West
half of section 21, subdivided under the
act of Congress of the 5th of June 1832 - 1833
and a plat sent to the Register and
returned to the Surveyor General of the
General Land Office, Saint Louis

Note: The West half of section
18, 19, 20, 21 and 22 July 18th 1857
D. W. J. S. H. H. H.
July 18, 19 & 21 and
11th July

I have a duplicate of a plat and a description in the field notes made there of
the United States in the State of Illinois and Territories of Missouri and Arkansas bearing
date of the day of the month of July 1857



D. Surveyor

Plat of Township N. 2 North of the Base line
Range N. 8 East of the 3rd principal Meridian

505.

page 32 vol 10

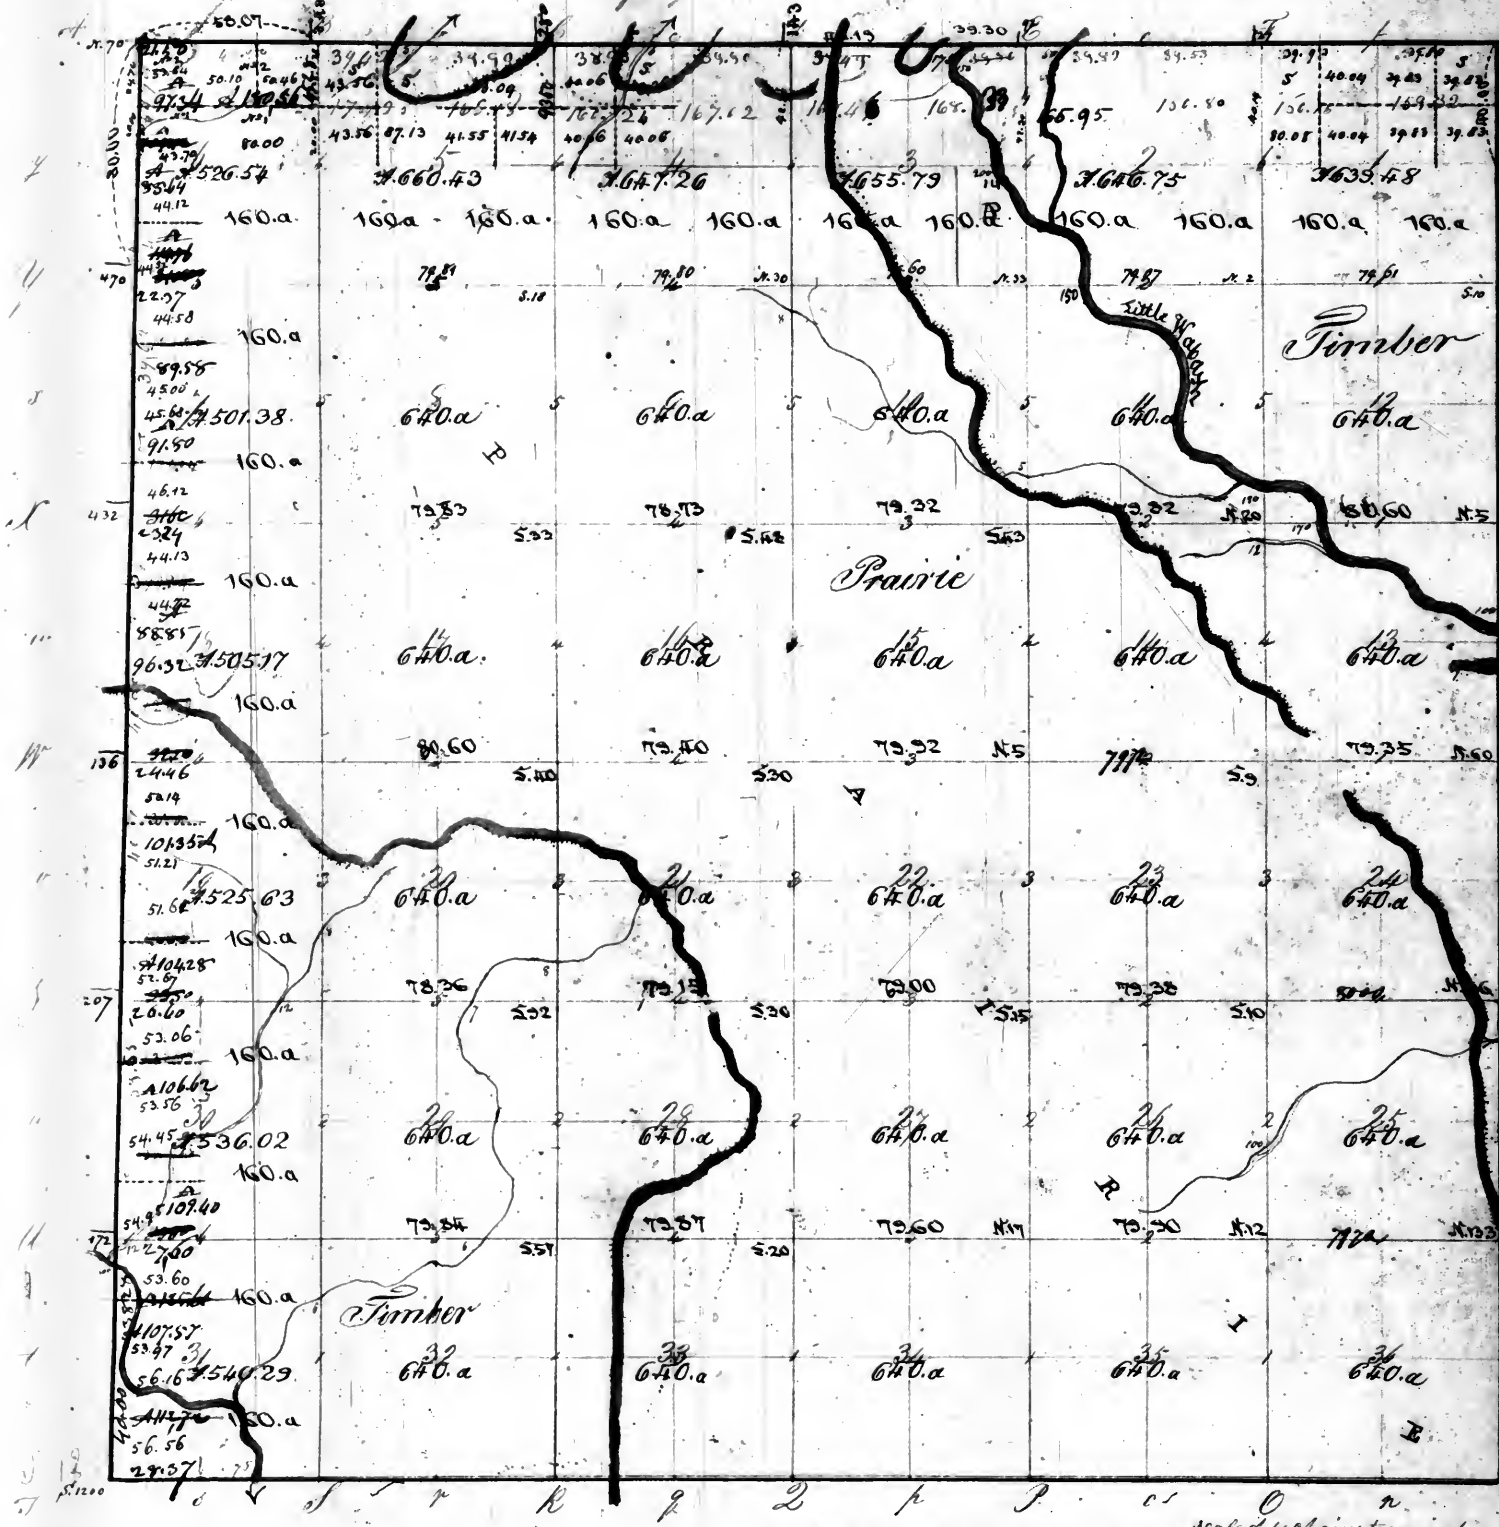


Office of the Surveyor General
for the State of Illinois and Missouri
Saint Louis July 19th 1858
The north half and the south east quarter
of section 6, the west half of section
7, 19.30 x 31, and the north west
quarter of section 18, including also
under them of township of the 5th
of April 1832 - also the north
half of section 14, 5, and the
north west quarter of section 4
including also to conform to the
survey made by the said
to the Register and master to the
Commissioner of the General
Land Office same day.

Aggregate area: 22384.74 acres
Scale of 10 chains to an inch

Pursuant to a contract, with and instructions from William Weston Surveyor of the United States in the Territories
of Illinois and Missouri having date the 5th day of November 1818 I have admeasured laid off and surveyed
the above described Township and do hereby certify that it has such marks both natural and artificial as
are represented on said plat and described in the field notes made thereof and returned with this plat. unto the
Office of the Surveyor of the lands of the United States for the Territories of Illinois and Missouri

William Biggs

~~GA~~
507

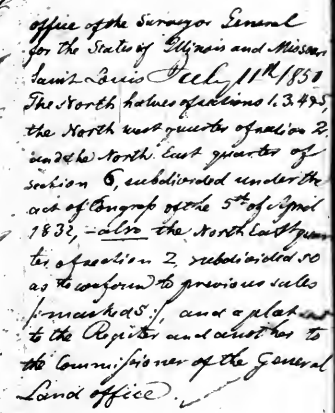

Scale of 100 chains to an inch


Received by Mrs Bagg, 28
January 1849

Recorded

Plat of Township N^o 5 North of the Base line
Range N^o 8 East of the 3rd principal Meridian

page 35 vol 10

508.

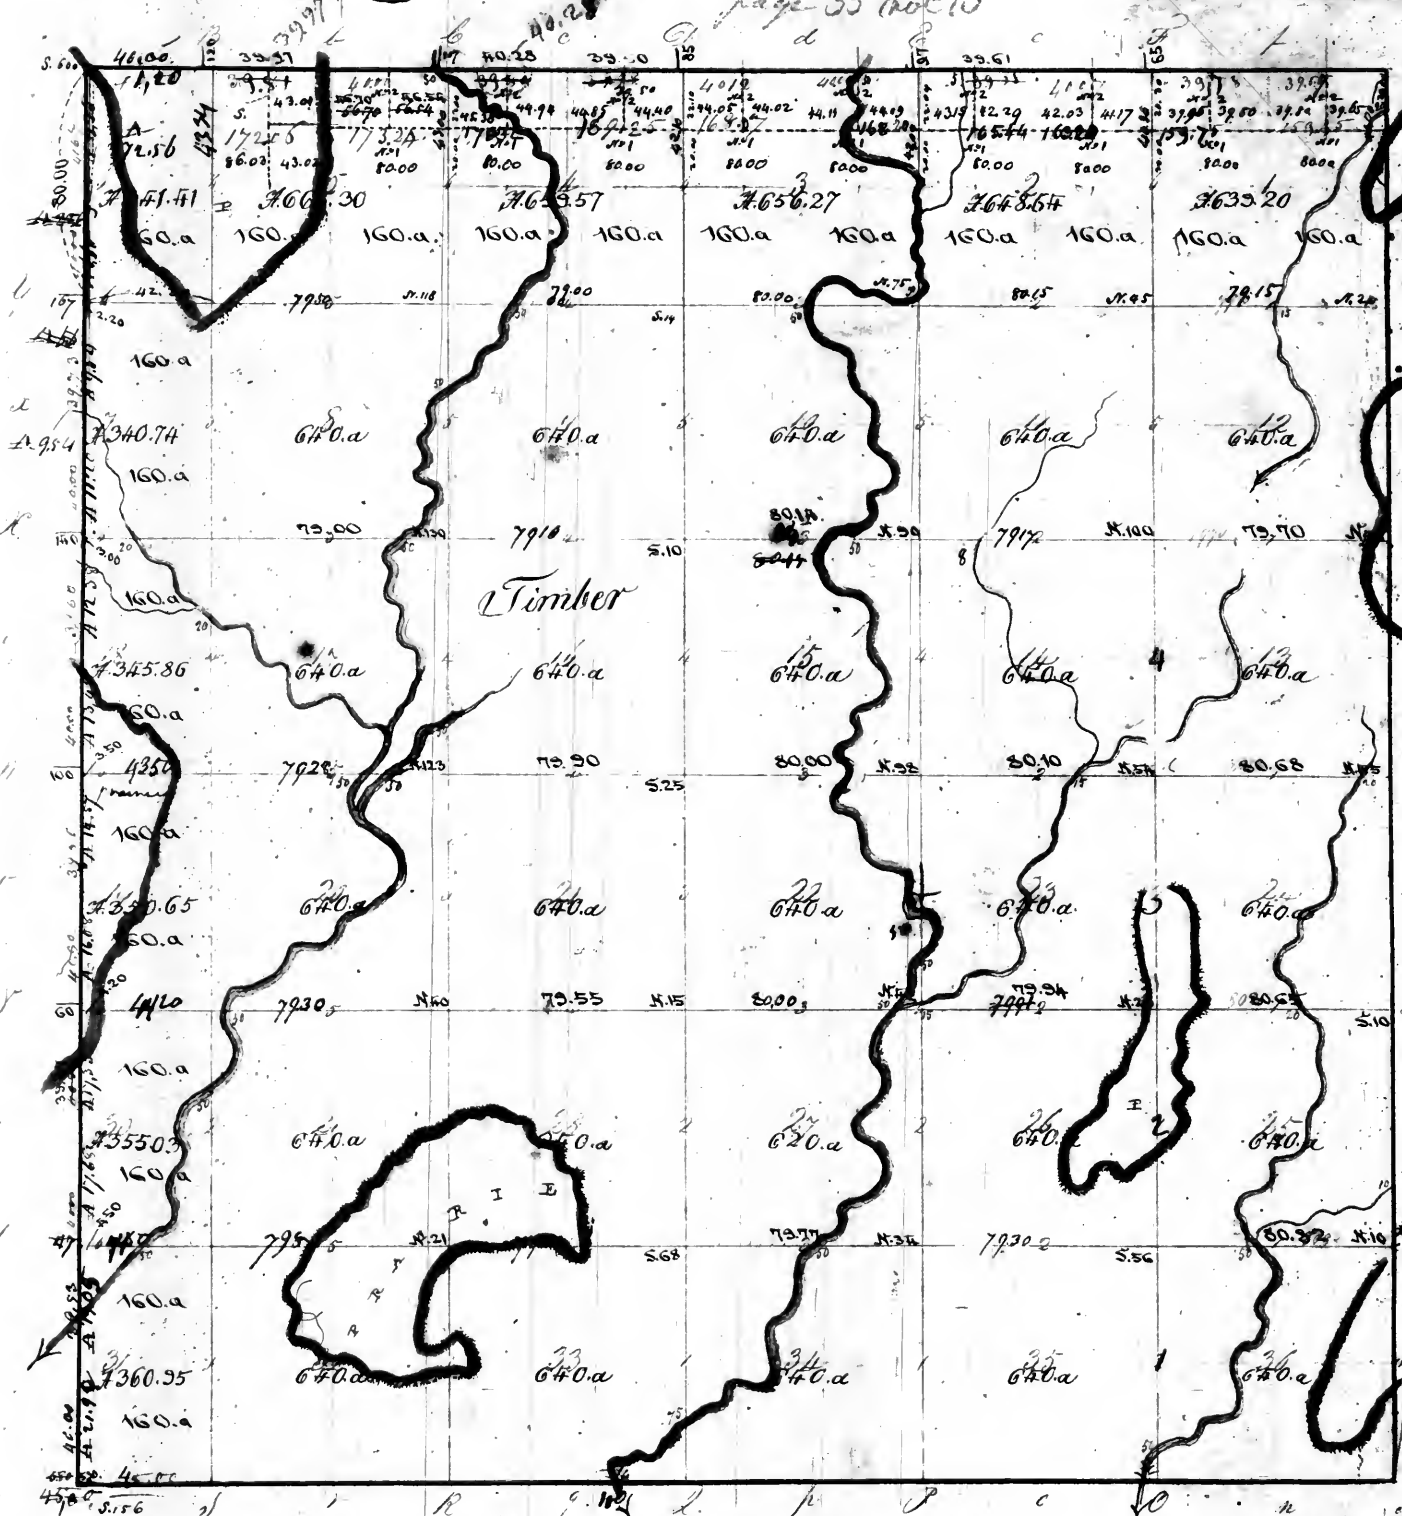

Aggregate area = 21363.62 ac.

Scale of 40 Chains to an inch

Office of the Surveyor General
and the North East quarter of
section 5, subdivided according to
an act of Congress of the 5th of April 1832
also the North West quarter of
section 5, subdivided into lots con-
form to a previous sale, forming
a plat out to the
Register and another copy to the
Commissioner of the General
Land Office. Same day

Office of the Surveyor General
for the State of Missouri, May 2nd 1853
A copy of the N.E. of Sec. 5
was sent this day to the
Register and another copy to the
Commissioner of the General Land Office
See Com^r Letter of
the 19th April 1853.


Pursuant to a contract with and instructions from William Picard Surveyor of the United States in the Territory
of Missouri to the said Surveyor, on the 1st day of November 1853, I have examined the above described Township, and hereby certify that it had such marks and bounds, both natural
and artificial as are represented on said plat, and describe in the field notes made at that
time and returned into the Office of the Surveyor of the Land of the United States for the Territory of Missouri.

William Picard

Recorded

Township of 6 north of the Base line Range 8 East of 3rd E.W. 559

page 36 vol 10

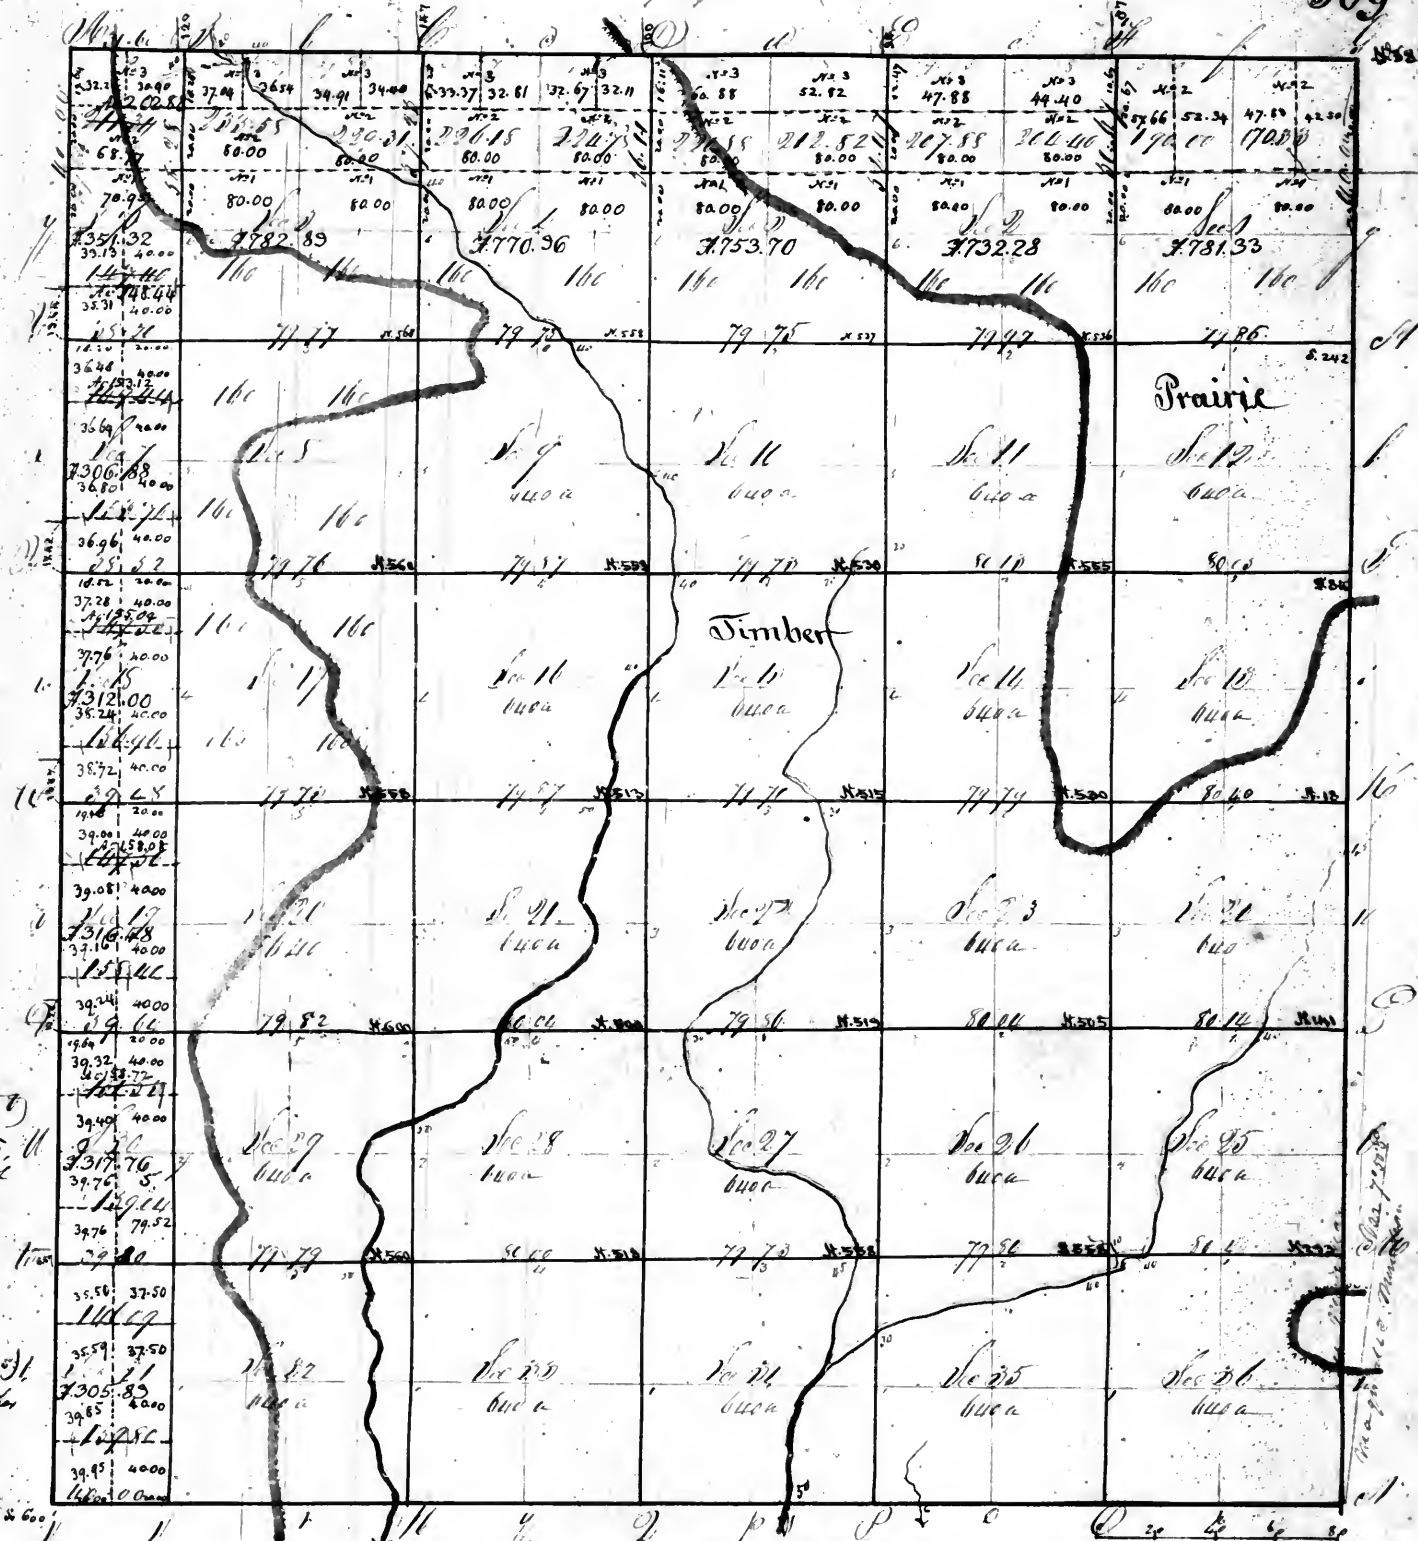


Office of the Surveyor General
for the States of Illinois and Missouri
Saint Louis July 19th 1858

The North halves of sections 1, 2, 3, 4 & 5
the North halves the south west corners of
section 6, the east halves of sections
7, 18, 19 & 31, and the North west
quarters of section 30, not divided
under the act of Congress of the 5th
of April 1832, - also the North west
quarters of section 30, not divided so as
to conform to a previous sale (mentioned)
and a plat sent to the Register and another
to the Commissioner of the General
Land office same day

aggregate area = 21631.45 acres

Warrant to a Contract with and Instructions from William Walter Surgo of the Lands
of the United States for the State of Illinois and Territories of Missouri and Arkansas
bearing date the day of I have measured land out and
surveyed the above described fractional Township and hereby Certify that it had
such marks and boundaries both natural and artificial as are represented on
said plat and described in the field notes made thereof and returned with
the same into the Office of the Surveyor of the Lands of the United States
at the State of Illinois and Territories of Missouri and Arkansas

67
510

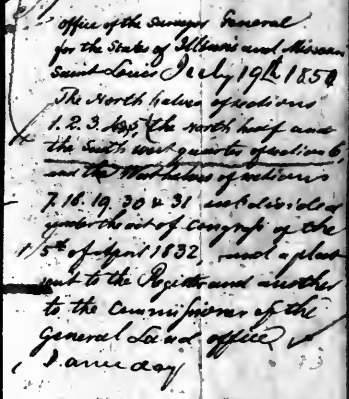


Scale of 40 cts to an in ch

I have had measured, laid out and surveyed the aforesaid fractional townships; and do hereby certify that it has been done, and the natural and artificial as are represented on said plat, and described in the field notes made thereof, and returned with this plat into the Office of the Surveyor of the Lands of the United States for the State of Illinois and Territories of Missouri and Arkansas.

Recorded 511.

Township N. 8 north of the Base line in Range 8 East of 3rd. CW?
Page 3 of 10

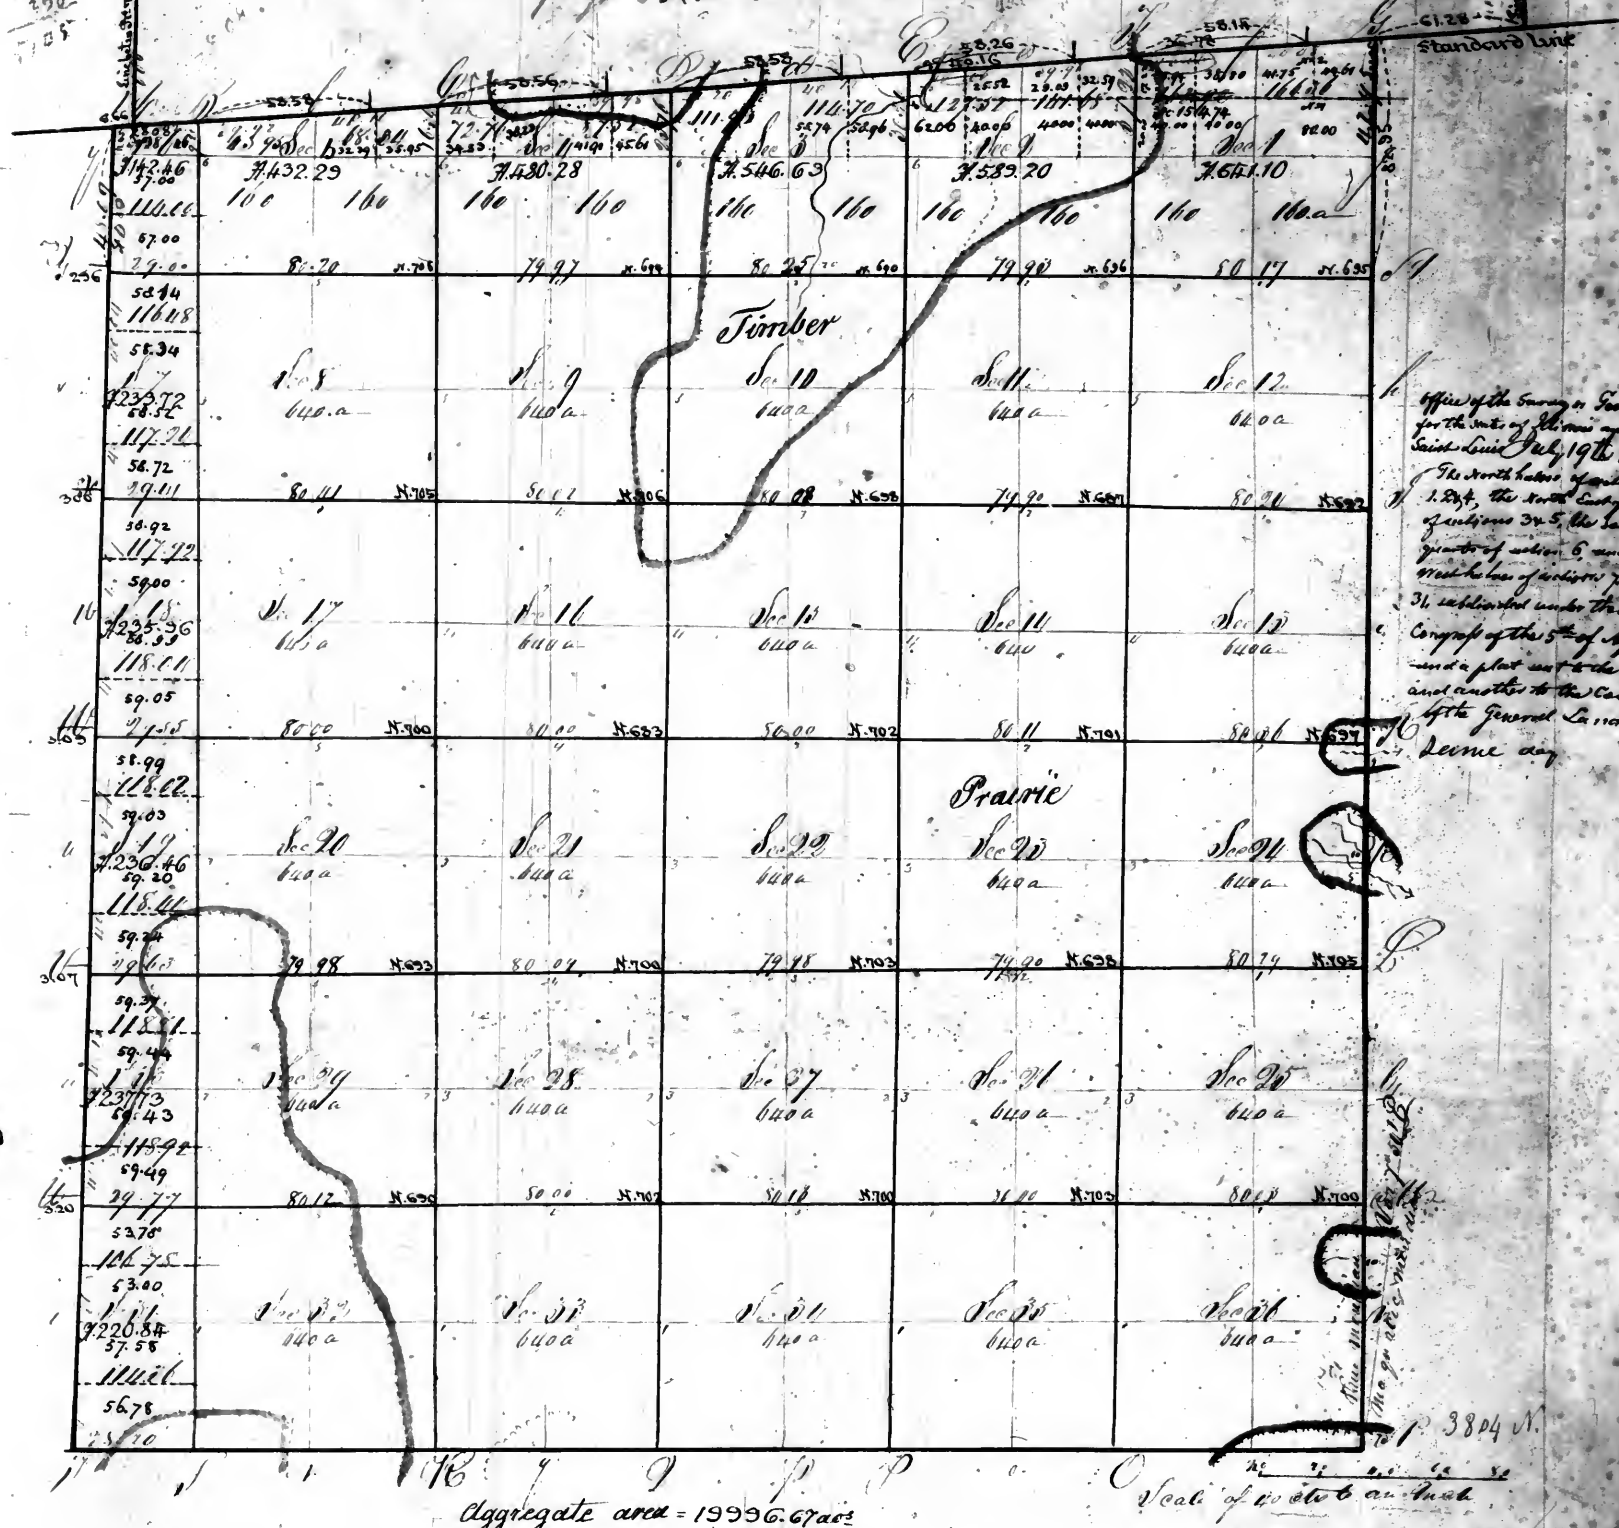

Office of the Surveyor General
for the State of Illinois and Missouri
Saint Louis July 19th 1857
The North halves of sections
Congress of the 5th of April 1832
and a plat set out in the Register
and another to the Commissioner
of the General Land office


Received to a contract with and a distinction from William Victor Surveyor of the Lands
of the United States for the State of Illinois and Territories of Missouri and Arkansas
I have a measure laid out and
I hereby certify that it has
been surveyed the above described fractional Township and do hereby certify that it has
been surveyed and bounded both natural and artificial as are represented on said
plat and described in the field notes made thereof and returned with the plat
into the office of the Surveyor of the Lands of the United States for the State
of Illinois and Territories of Missouri and Arkansas -

Records

39

Township No. 9 North of the base line, Range No. 8 East of the 3^d principal Meridian.

512

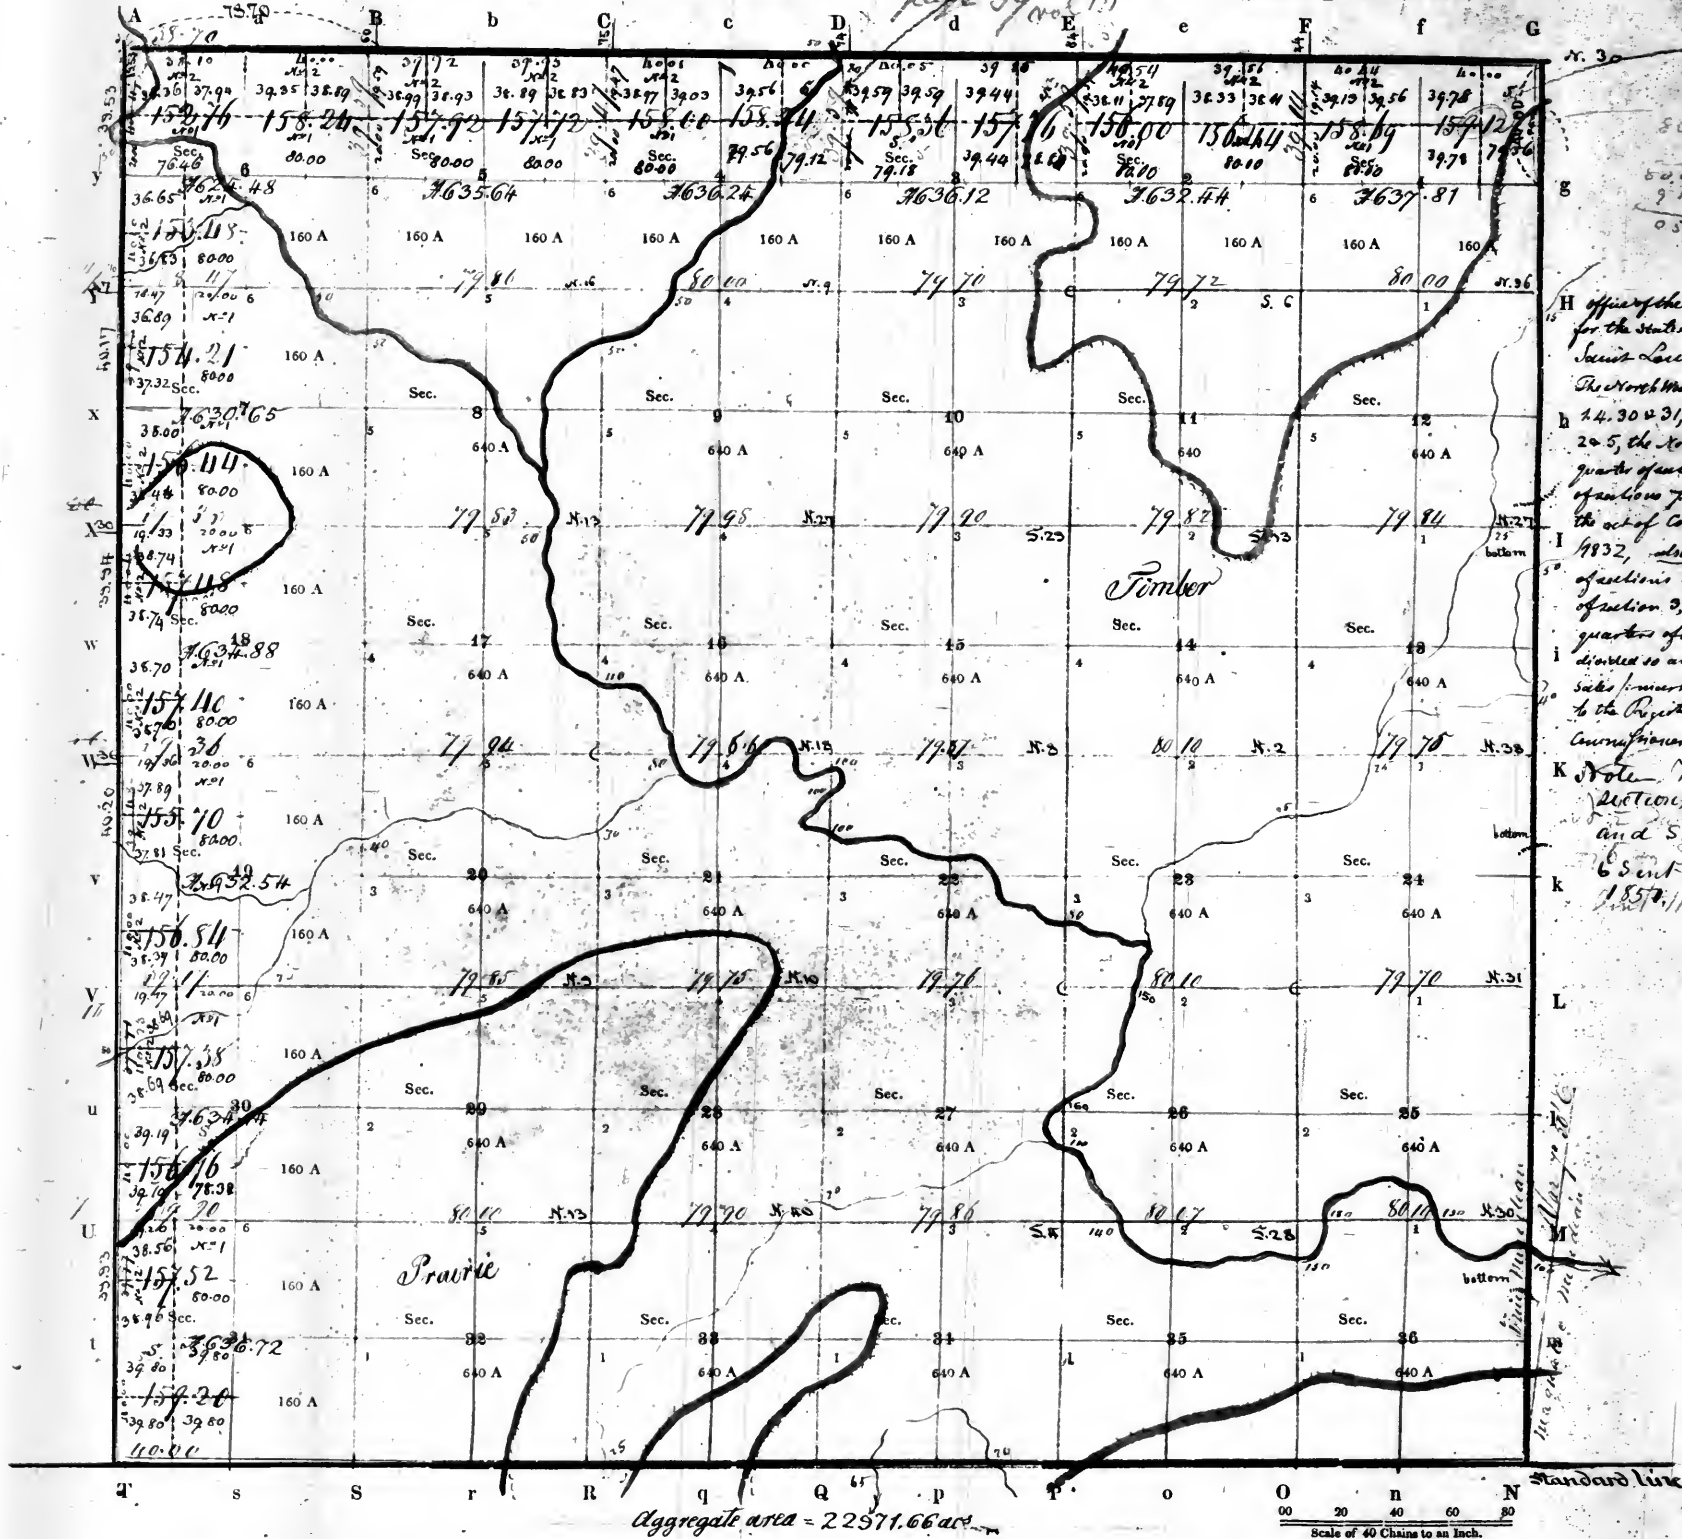

H Office of the Surveyor General
for the State of Illinois
Saint Louis July 19th 1851
The North West quarter of section
24, 30 & 31, the North halves of section
2 & 5, the North half and the South West
quarter of section 6, and the West halves
of sections 7, 18 & 19 subdivided under
the act of Congress of the 5th of April
1832, and the North East quarter
of section 18 & 19, the North half
of section 3, and the South West
quarter of section 30 & 31, Sub-
divided so as to conform to previous
sales, numbered 31, was plat sent
to the Register and another to the
Commissioner of the General Land Office.
K Note: The North half of
sections 1, 2, 3, 4, 5, 6
and S.W. 1/4 of section
6 sent Nov 1st July
1851. D. July

PURSUANT to a contract with, and instructions from WILLIAM RECTOR, Surveyor of the lands of the United States in the State of Illinois
and territories of Missouri and Arkansas
bearing date the 18th day of May 1850.

I have admeasured, laid out and surveyed the above described Township; and do hereby certify, that it had such marks and bounds, both natural
and artificial, as are represented on said plat, and described in the field notes made thereof, and returned with this plat into the Office of the Sur-
veyor of the lands of the United States, for the State of Illinois and territories of Missouri and Arkansas

Certified this day of

EXAMINED.


Laid out by Benjamin E. D. SURVEYOR.
for Stephen Rector, D.
August & September 1850.

Recorded

50

Township No. 16 North of the base line, Range No. 8 East of the principal Meridian.

513

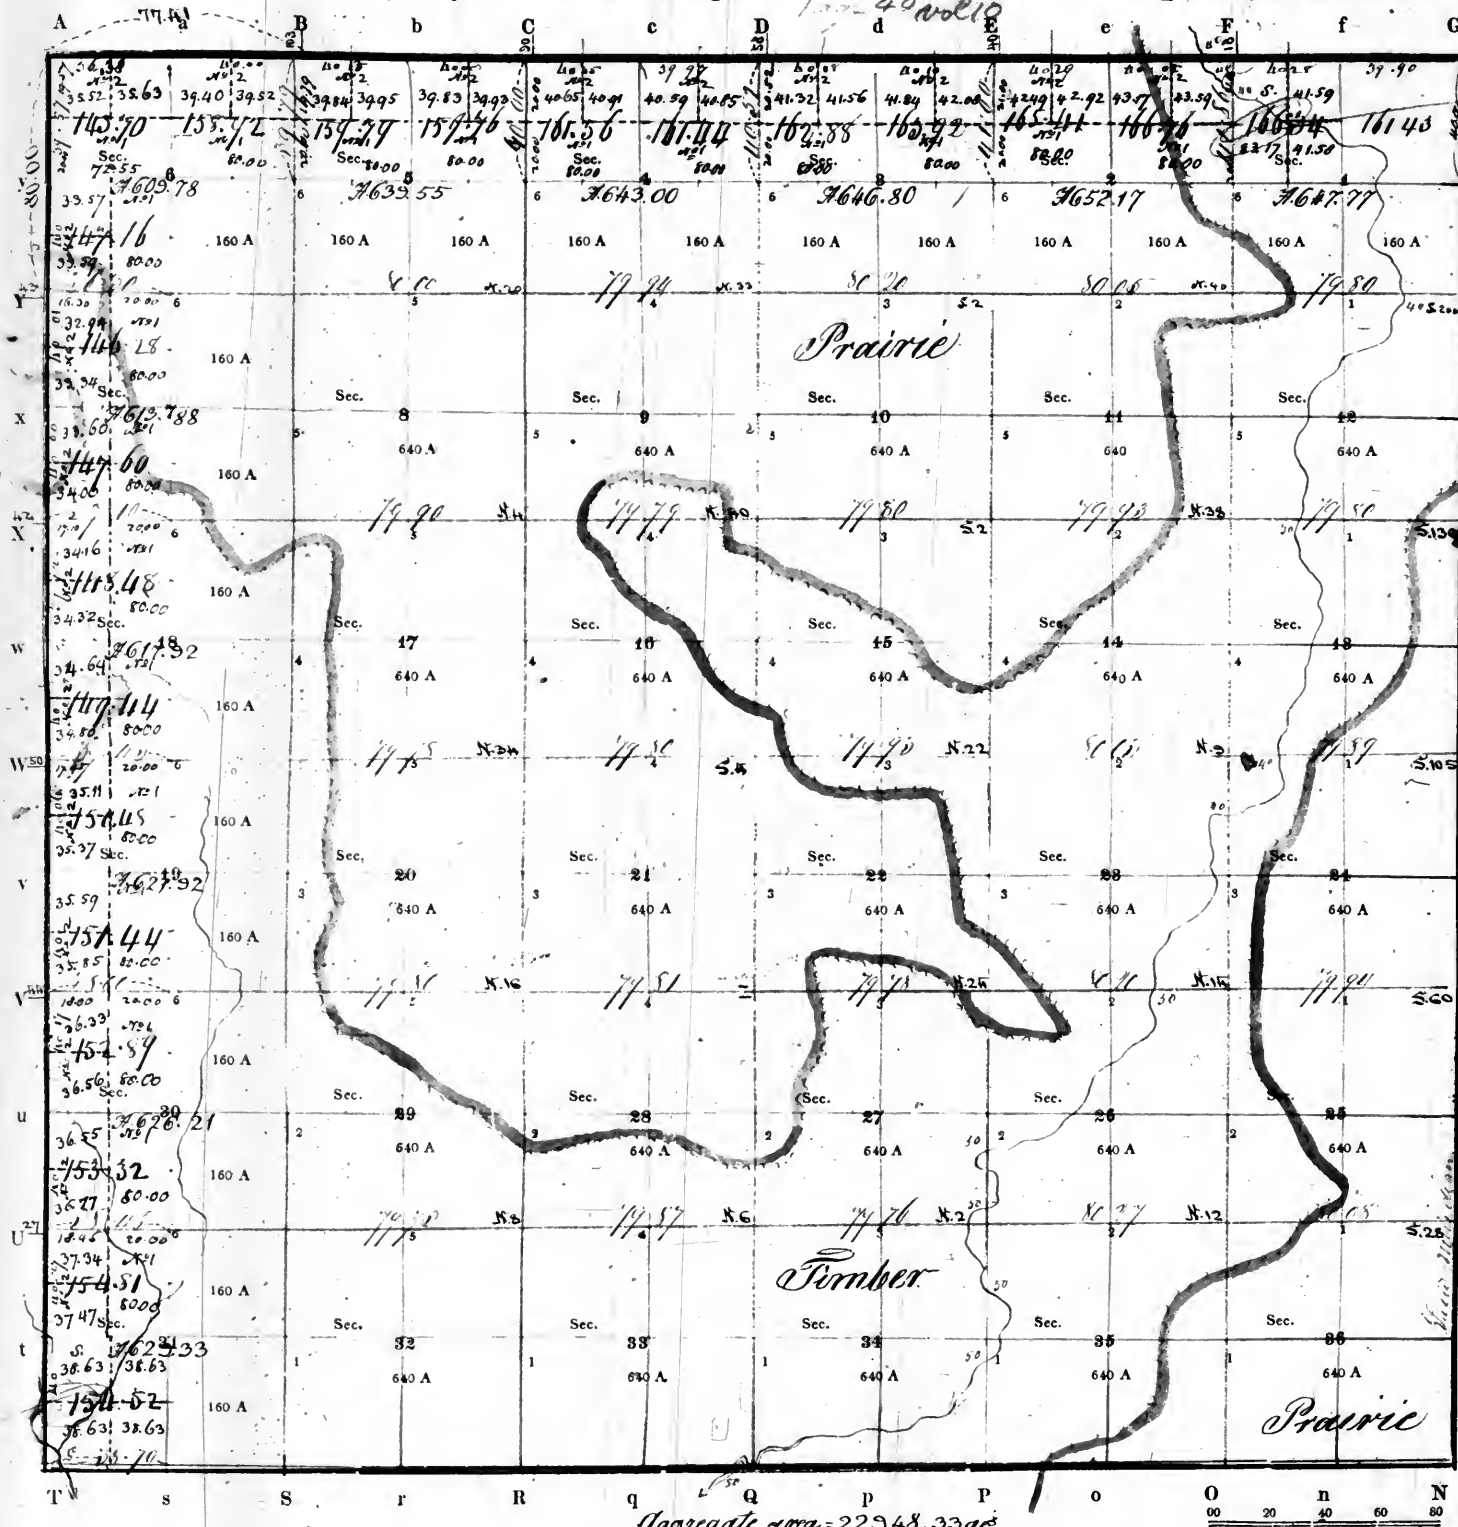

h office of the Surveyor General of the State of Illinois and Chicago
 The North half of section 2, 3, 4 & 5, the North half of the South West quarter of section 6, the West halves of sections 7, 18, 19 & 30, and the North West quarter of section 31, subdivided under the entry Com. of the 5th of August 1832, also the North West quarter of section 1, and the South West quarter of section 31, subdivided as a to conform to previous sales purchased S. J. and a plat sent to the Register and county to the General Surveyor of the General Land office.

W. J. Varney, Surveyor

Aggregate area = 22548.33 ac

Scale of 40 Chains to an Inch.

PURSUANT to a contract with, and instructions from WILLIAM RECTOR, Surveyor of the lands of the United States in the State of Illinois, bearing date the 18th day of May 1820.


I have admeasured, laid out and surveyed the above described Township; and do hereby certify, that it had such marks and bounds, both natural and artificial, as are represented on said plat, and described in the field notes made thereof, and returned with this plat into the Office of the Surveyor of the lands of the United States, for the State of Illinois and Territory of Missouri and Arkansas.

Certified this day of

Surveyed by Benjamin Fort D. SURVEYOR.
 for Stephen Rector & Co
 September 18 20

EXAMINED.

✓

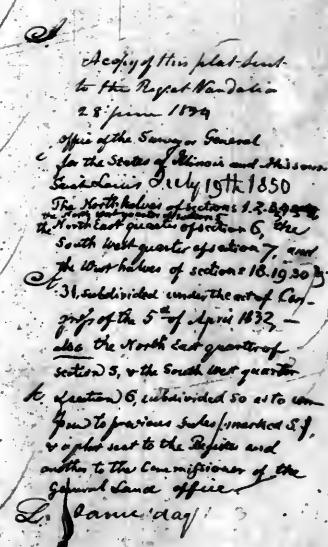


Aggregate area = 22868.73 ac.

11 E J Langham

Township 13 North of the base line Range 10 East of the 3d Principal Meridian

page 3 of 10

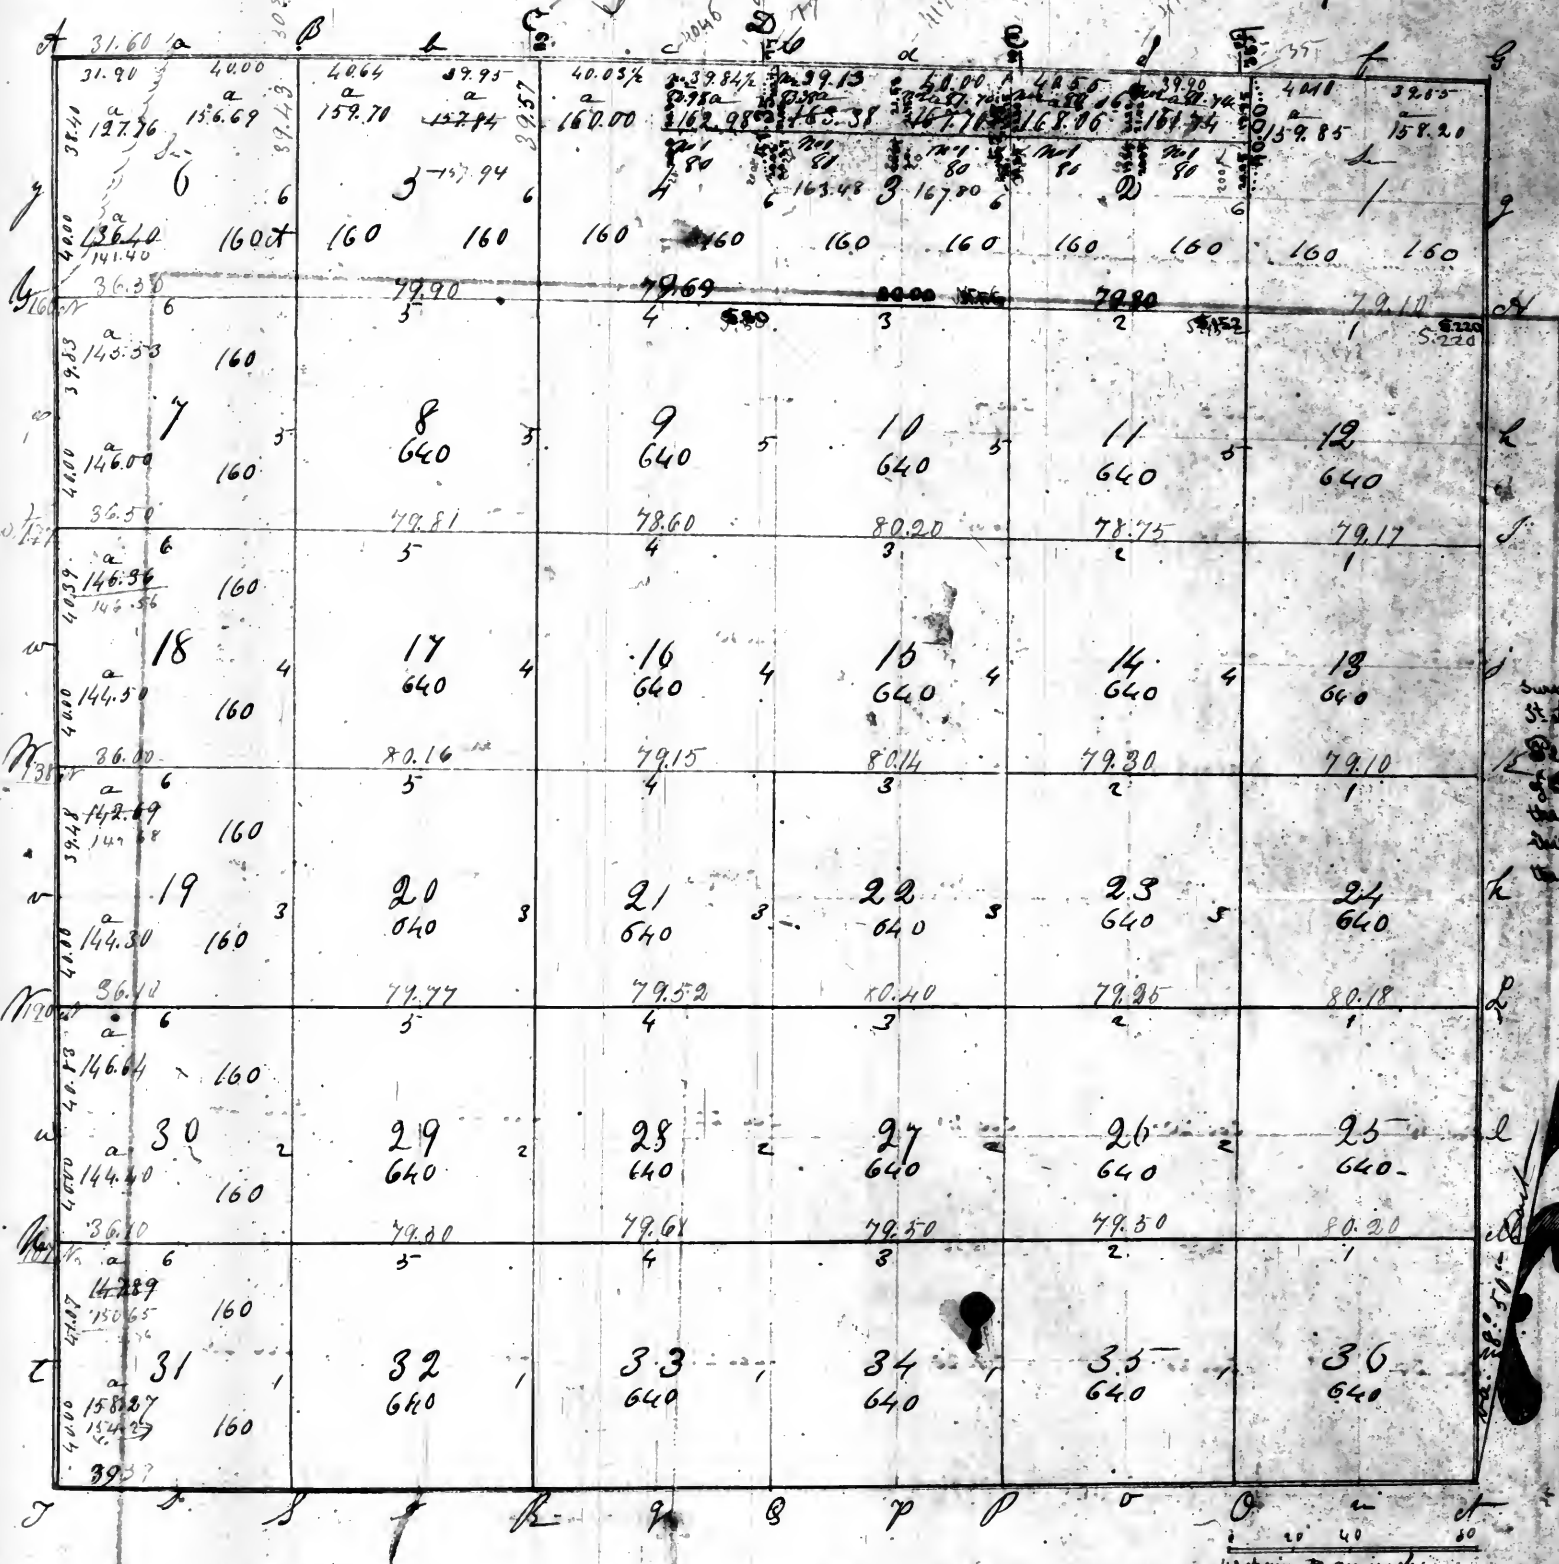


Surveyor's Office
St. Louis 10th August 1821.
Beal of the north halves
of Section 12, 13 and of
the N.E. 1/4 of Sec. 14, not
surveyed to the corner of
the 1st 10.

Proceeding to retrieve with instructions from William Heston surveyor of the lands of the United States in the State of Illinois & Missouri in bearing date the 6th day of March 1821. I have advanced and surveyed the above described township and do hereby certify that it had such marks & bounds both natural & artificial as are expressed on said plat & described in the field notes made thereof & returned with this plat into the Office of the Surveyor of the Lands of the United States for the States of Illinois & Missouri
certified this 5th day of July 1821
A. H. Bannan Surveyor

Record

TOWNSHIP No 14 NORTH of the BASE LINE, Range No 8 EAST of the 3rd PRINCIPAL MERIDIAN.

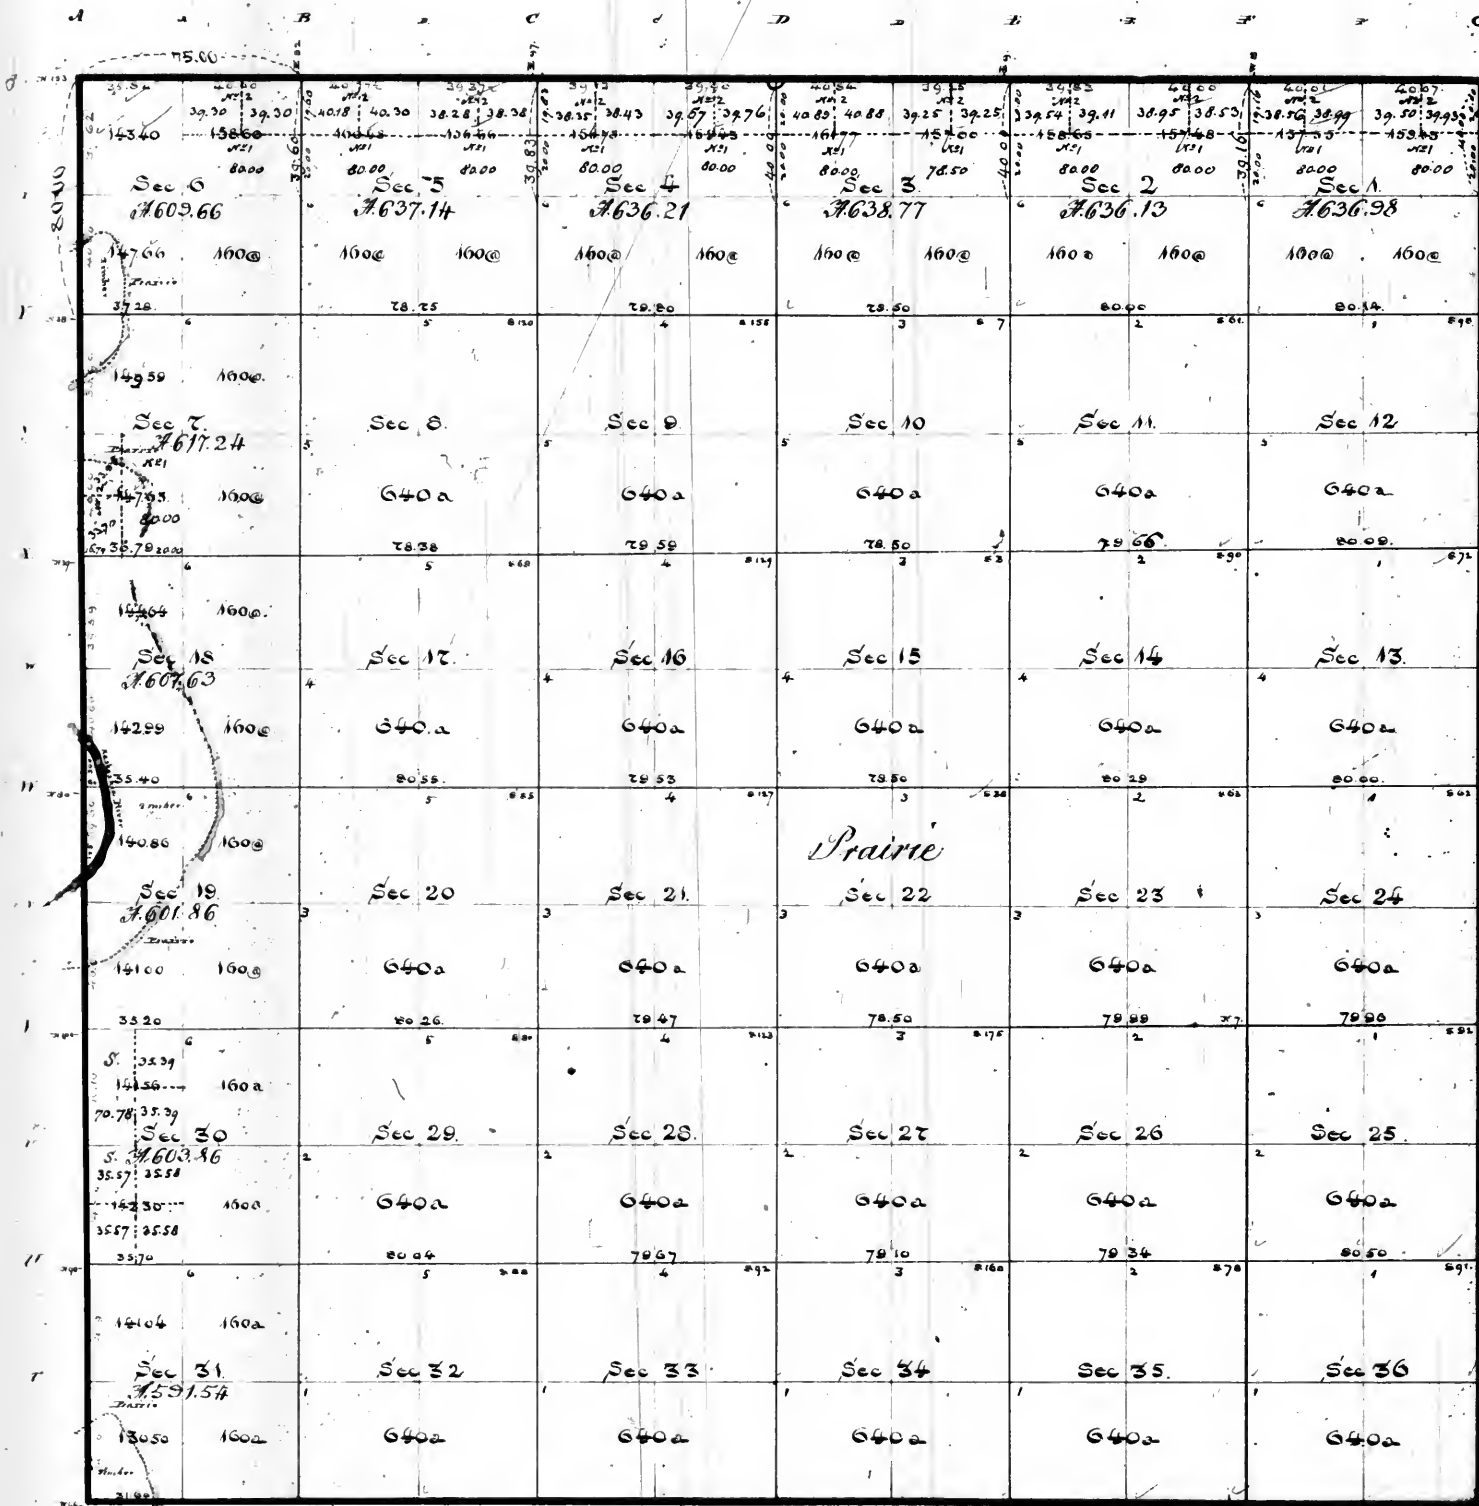

A copy of this plat sent to the Regt. at Vandalia 28th June 1834
 Office of the Surveyor General for the State of Illinois at St. Louis, Mo. July 11th 1835
 The North half of section 6, and the North East quarter of section 6, and the South West quarter of section 7, subdivided under the act of Congress of the 3rd of April 1832, also the West half of section 30, subdivided so as to conform to previous sales, marked and a plat sent to the Register, and another to the Commissioner of the General Land Office

Aggregate area = 22817.02 acres

Surveyors Office
 St. Louis June 28th 1834

The above Plat of Township 14 North of the Base line, Range 8 East of the 3rd Principal Meridian, is conformable to the field notes of the Survey thereof on file in this Office.


E. J. Snyham

Recorded

517

Survey of the line between the land of S. East of the 35 principal meridian

page 44 vol 10

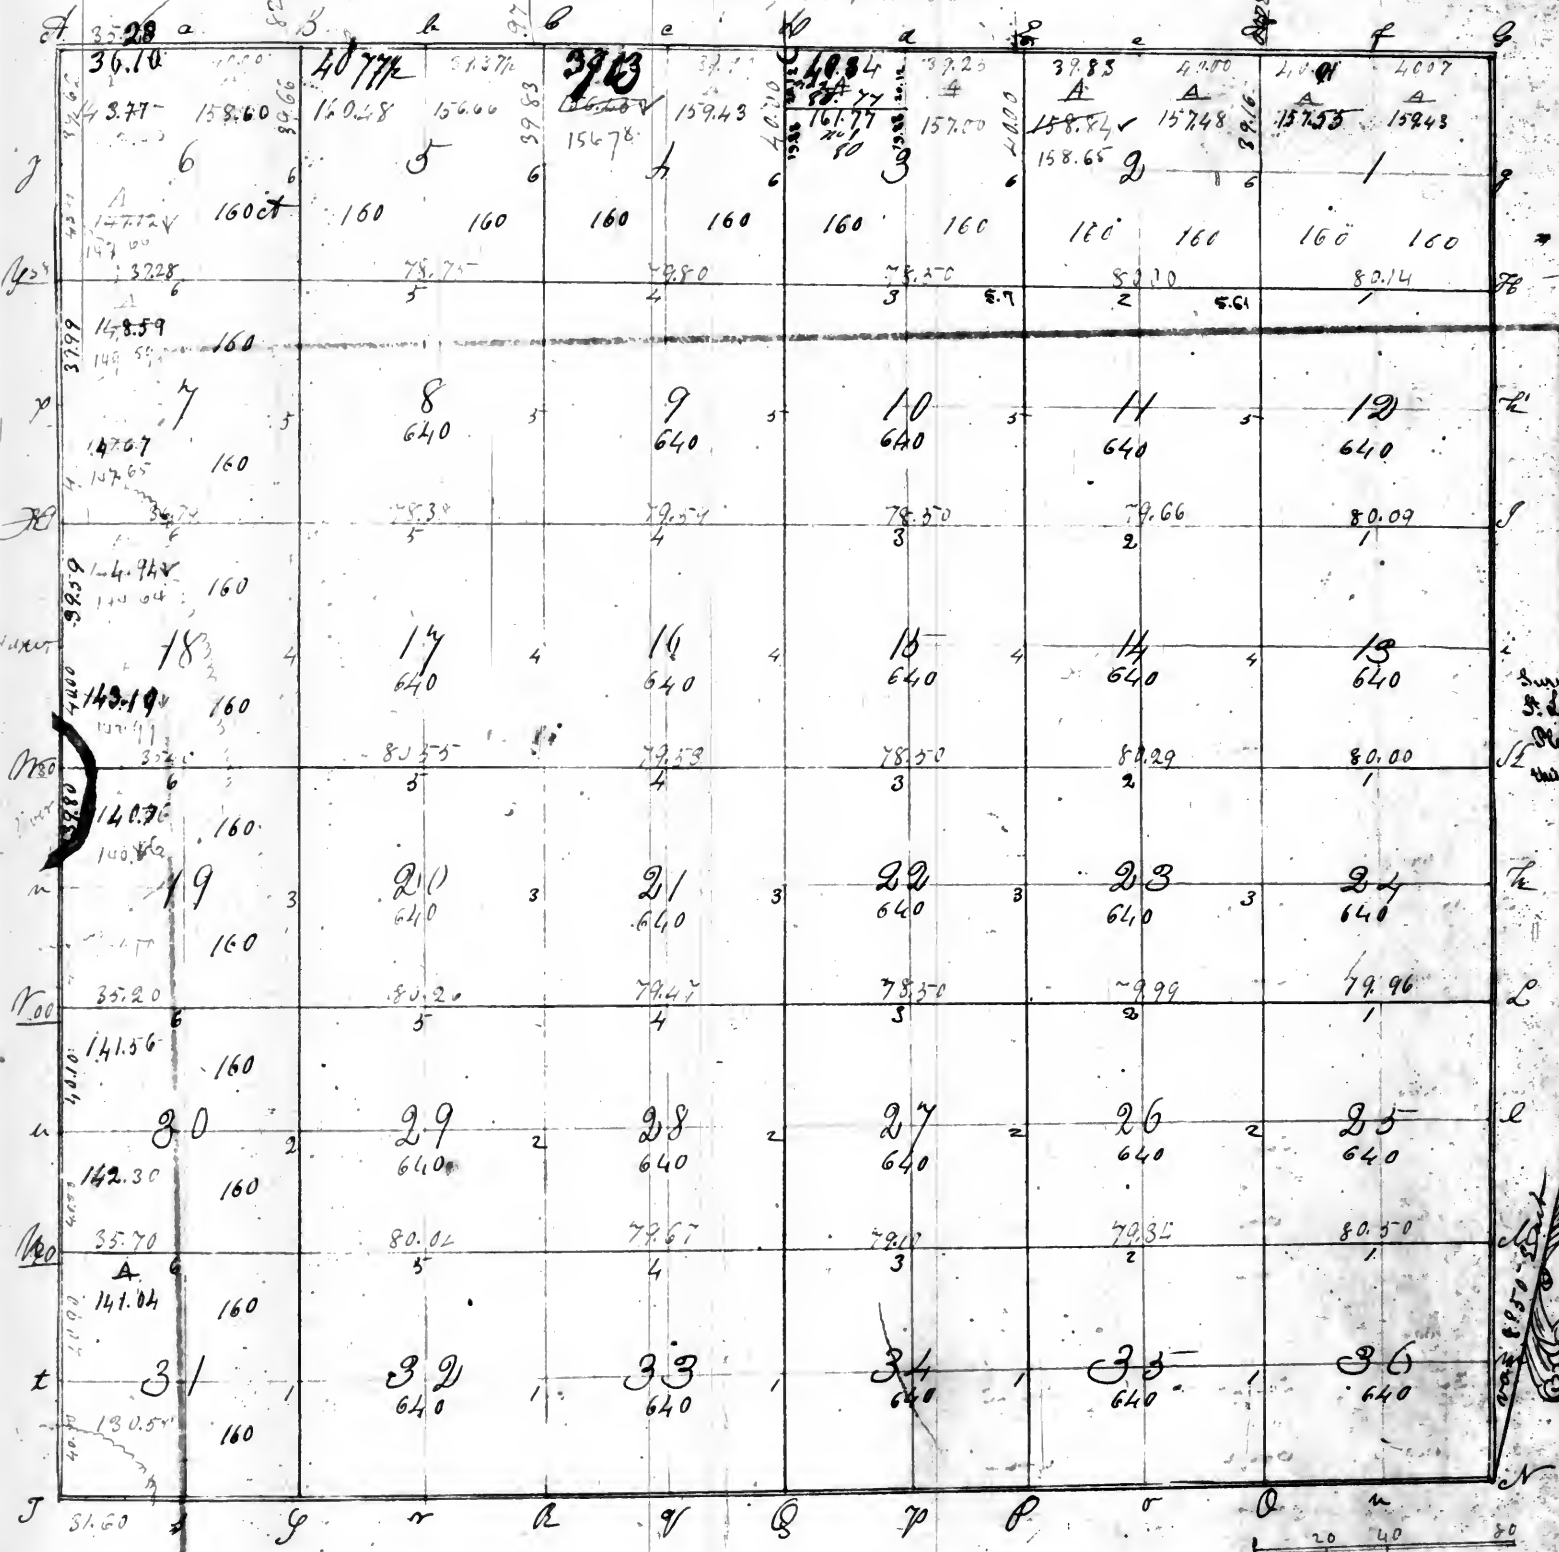

Surveyor's Office
St. Louis 11th August 1842.
Plat of the N.W. cor. of Sec. 3, sent
this day to the Commr. of the Genl. O.

Pursuant to contract with & instructions from William Brewster Surveyor of the Lands of the United States
in the State of Illinois & Missouri bearing date 6th day of March A.D. 1821 I have accordingly laid out & surveyed
the above described Township; & do hereby certify that it has such marks & bounds both natural & artificial as
are represented on said plat & described in the field notes made thereof & returned with this plat into the Office of the
Surveyor of the Lands of the United States for the State of Illinois & Missouri
certified this 1st day of July A.D. 1821
A. H. Hammonck Jr. Surveyor

Richard

A copy of this plat sent to
the Register at Vandalia
28th June 1834

The North halves of sections 1, 2, 3, 4 & 5, the North East quarter of section 6, the North West quarters of sections 18 & 21, and the South West quarter of section 30, subdivided under the act of Congress of the 5th of April 1832, also the South West quarter of sections 6, 7, 19 & 21, and the North West quarter of section 30, subdivided so as to conform to previous sales marked S. 1, and a plat sent to the Register and another to the Commissioners of the General Land Office.

S. M. 92 Sur 7X 19
M. M. 92 Sur 18
Next halves of Sutures
30931 Sent to the
Register and Com.
July 11th 1850

Sent July 11-

Aggregate area = 25187.49 acres


6/15054
376

The above Plat of Township 15 North of the Baseline, Range 8 East of the 3rd principal Meridian, is conformable to the field notes of the Survey thereof on file in this Office.

11
E. J. Sanborn

Recorded

Township 15 North Range No 8 East of the 32 Principal Meridian

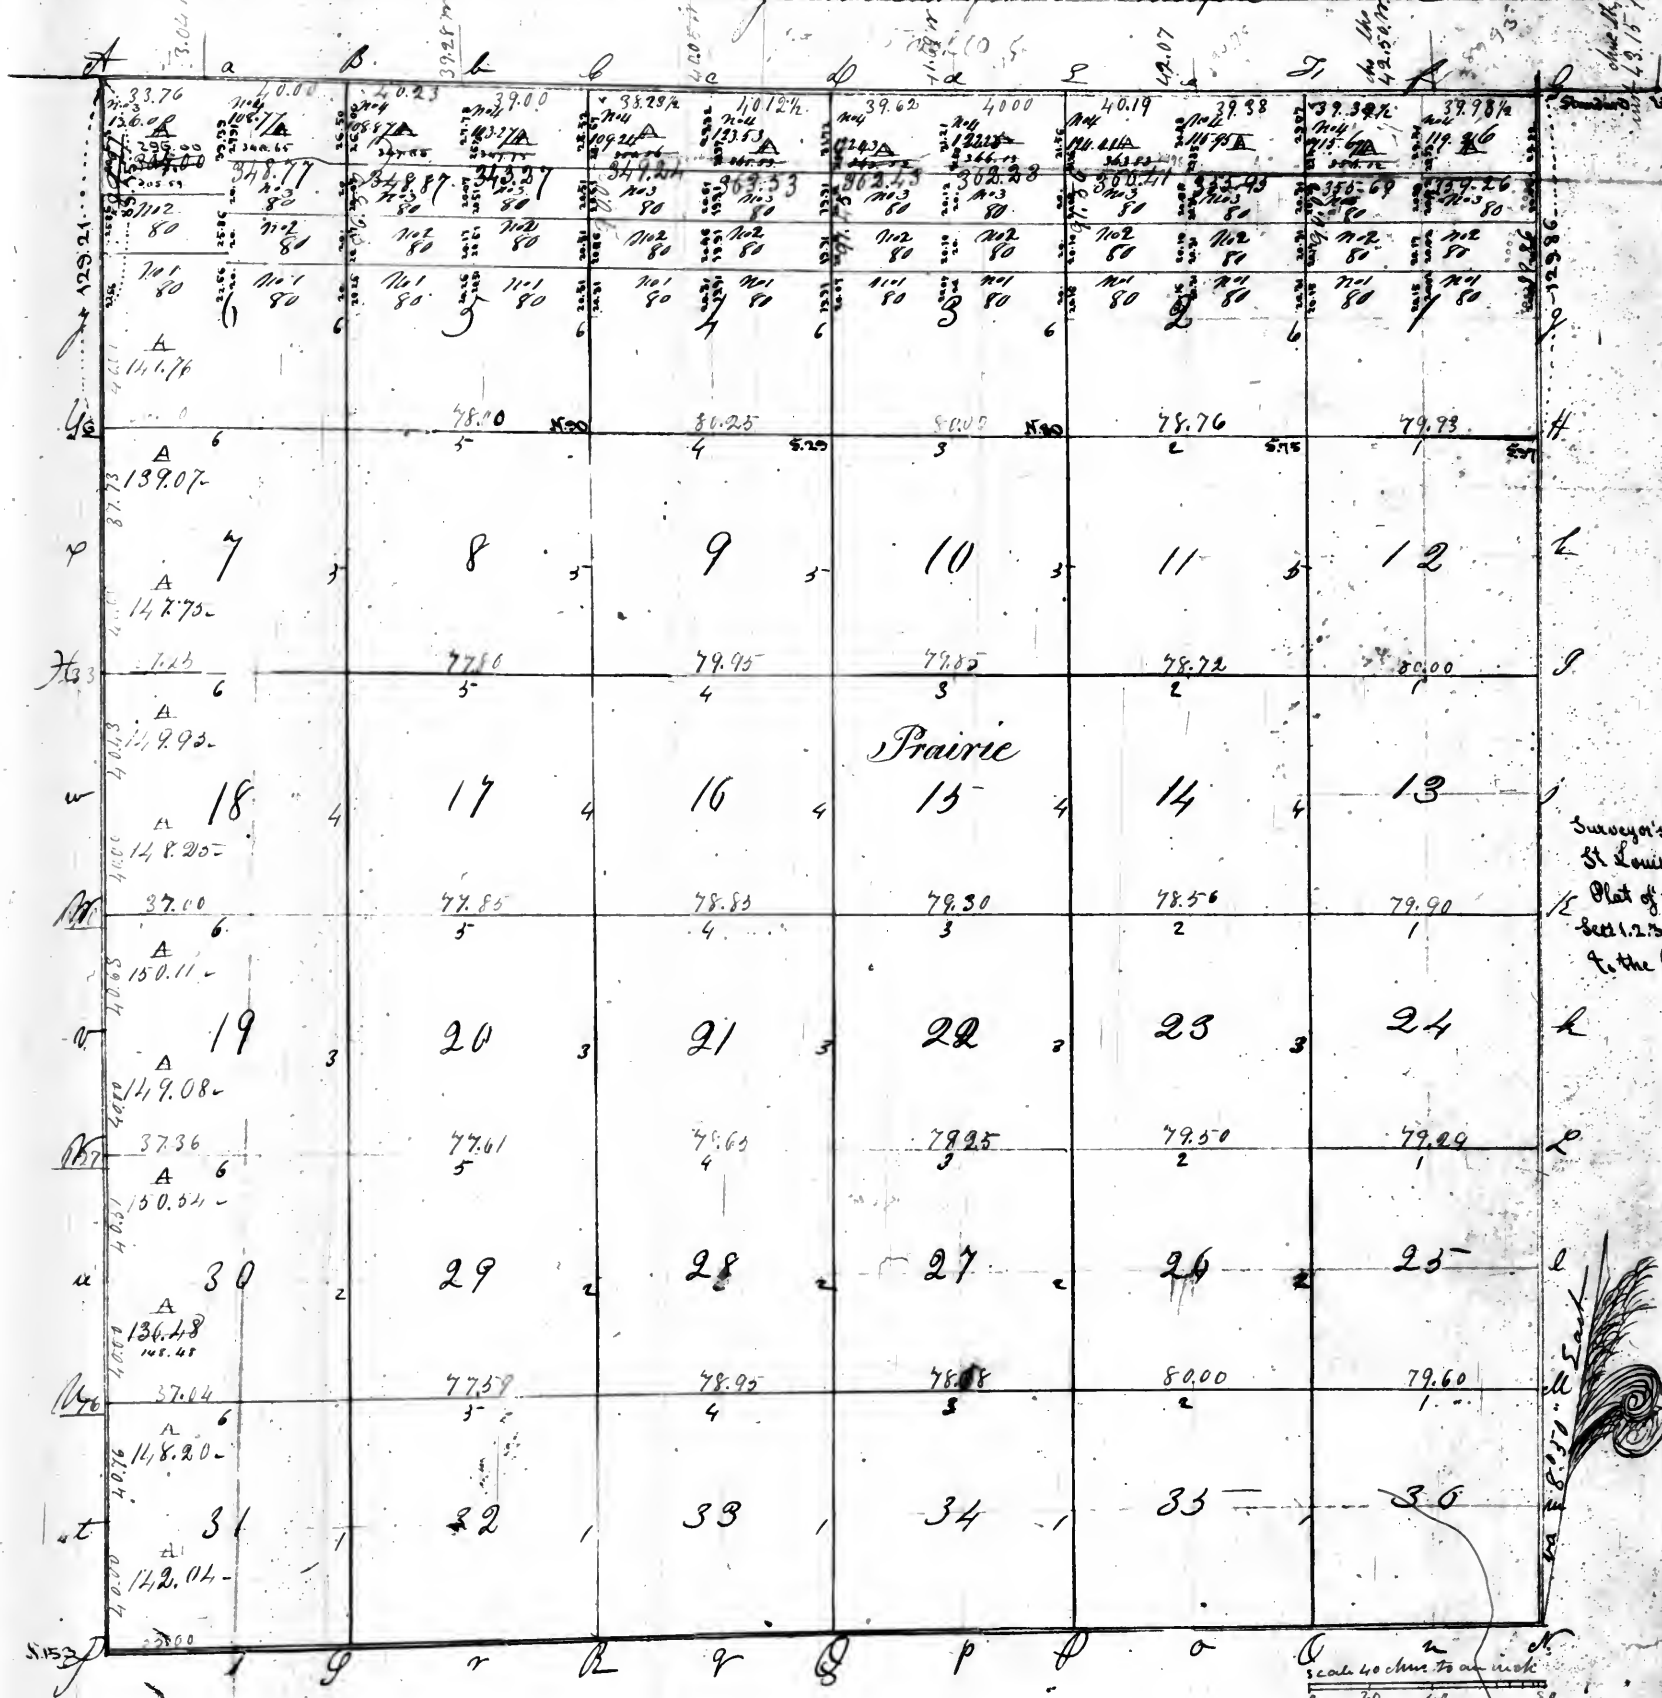

Surveyor's Office
St. Louis 10th August 1821.
Plat of the North halves of
Secs 1, 2, 3, 5, 54, 6, sent this day
to the Comptroller of the Genl. L.O.




I do hereby certify that the above plat was made in accordance with and instructions from William B. Rector Surveyor General of the
lands of the United States in the State of Illinois & Missouri bearing date the 6th day of March 1821
I have examined said plat & Surveyor's field notes & index Township; and do hereby certify that it has
been made & bounds, both natural & artificial, as are represented on said plat & described in the field
notes made thereof & returned with this plat into the Office of the Surveyor of the Lands of the United States
for the Territory of Illinois & Missouri
certified this 30th day of July A.D. 1821

Am. B. Rector Surveyor

Recorded

Township No. 16 North of the base line, Range No. 8 East of the 3^d principal Meridian.

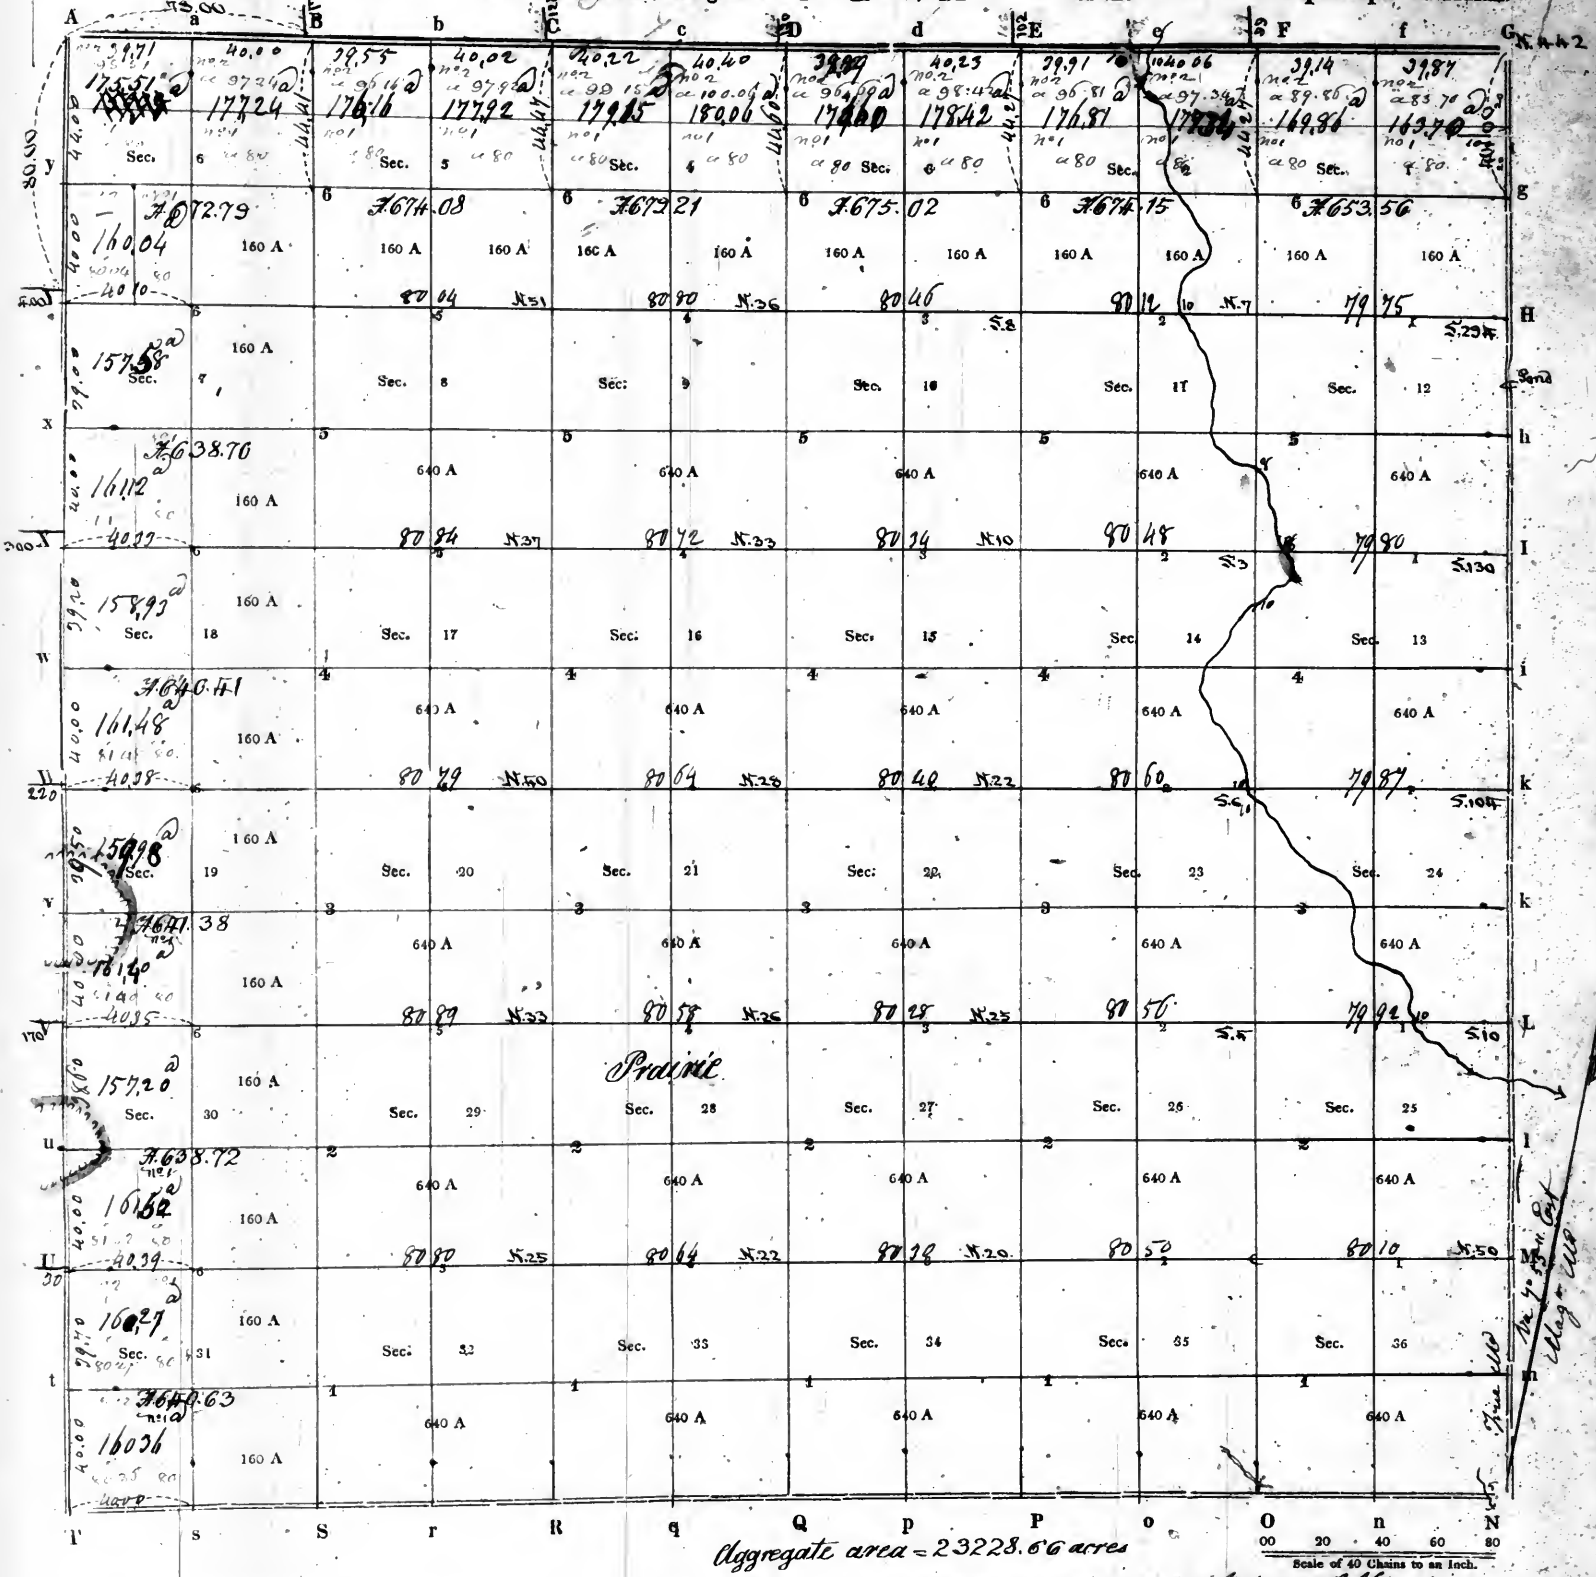

PURSUANT to a contract with, and instructions from William Rector, Surveyor of the lands of the United States in the *State of Illinois* bearing date the *fourteenth* day of *February* 1822 I have a measure laid out and surveyed the above described Township; and do hereby certify, that it had such marks and bounds, both natural and artificial, as are represented on said plat, and described in the field notes made thereof, and returned with this plat into the Office of the Surveyor of the Lands of the United States, in the *State of Illinois - Missouri & Territory of Arkansas* Surveyed by *Richd. T. Holliday* for *Wm. Rector* D. SURVEYOR.


Certified this *fourteenth* day of *November* 1822.

EXAMINED.

Recorded

page 47 vol 10.

Township No. 17 North of the base line, Range No. 3 East of the 3 principal Meridian.

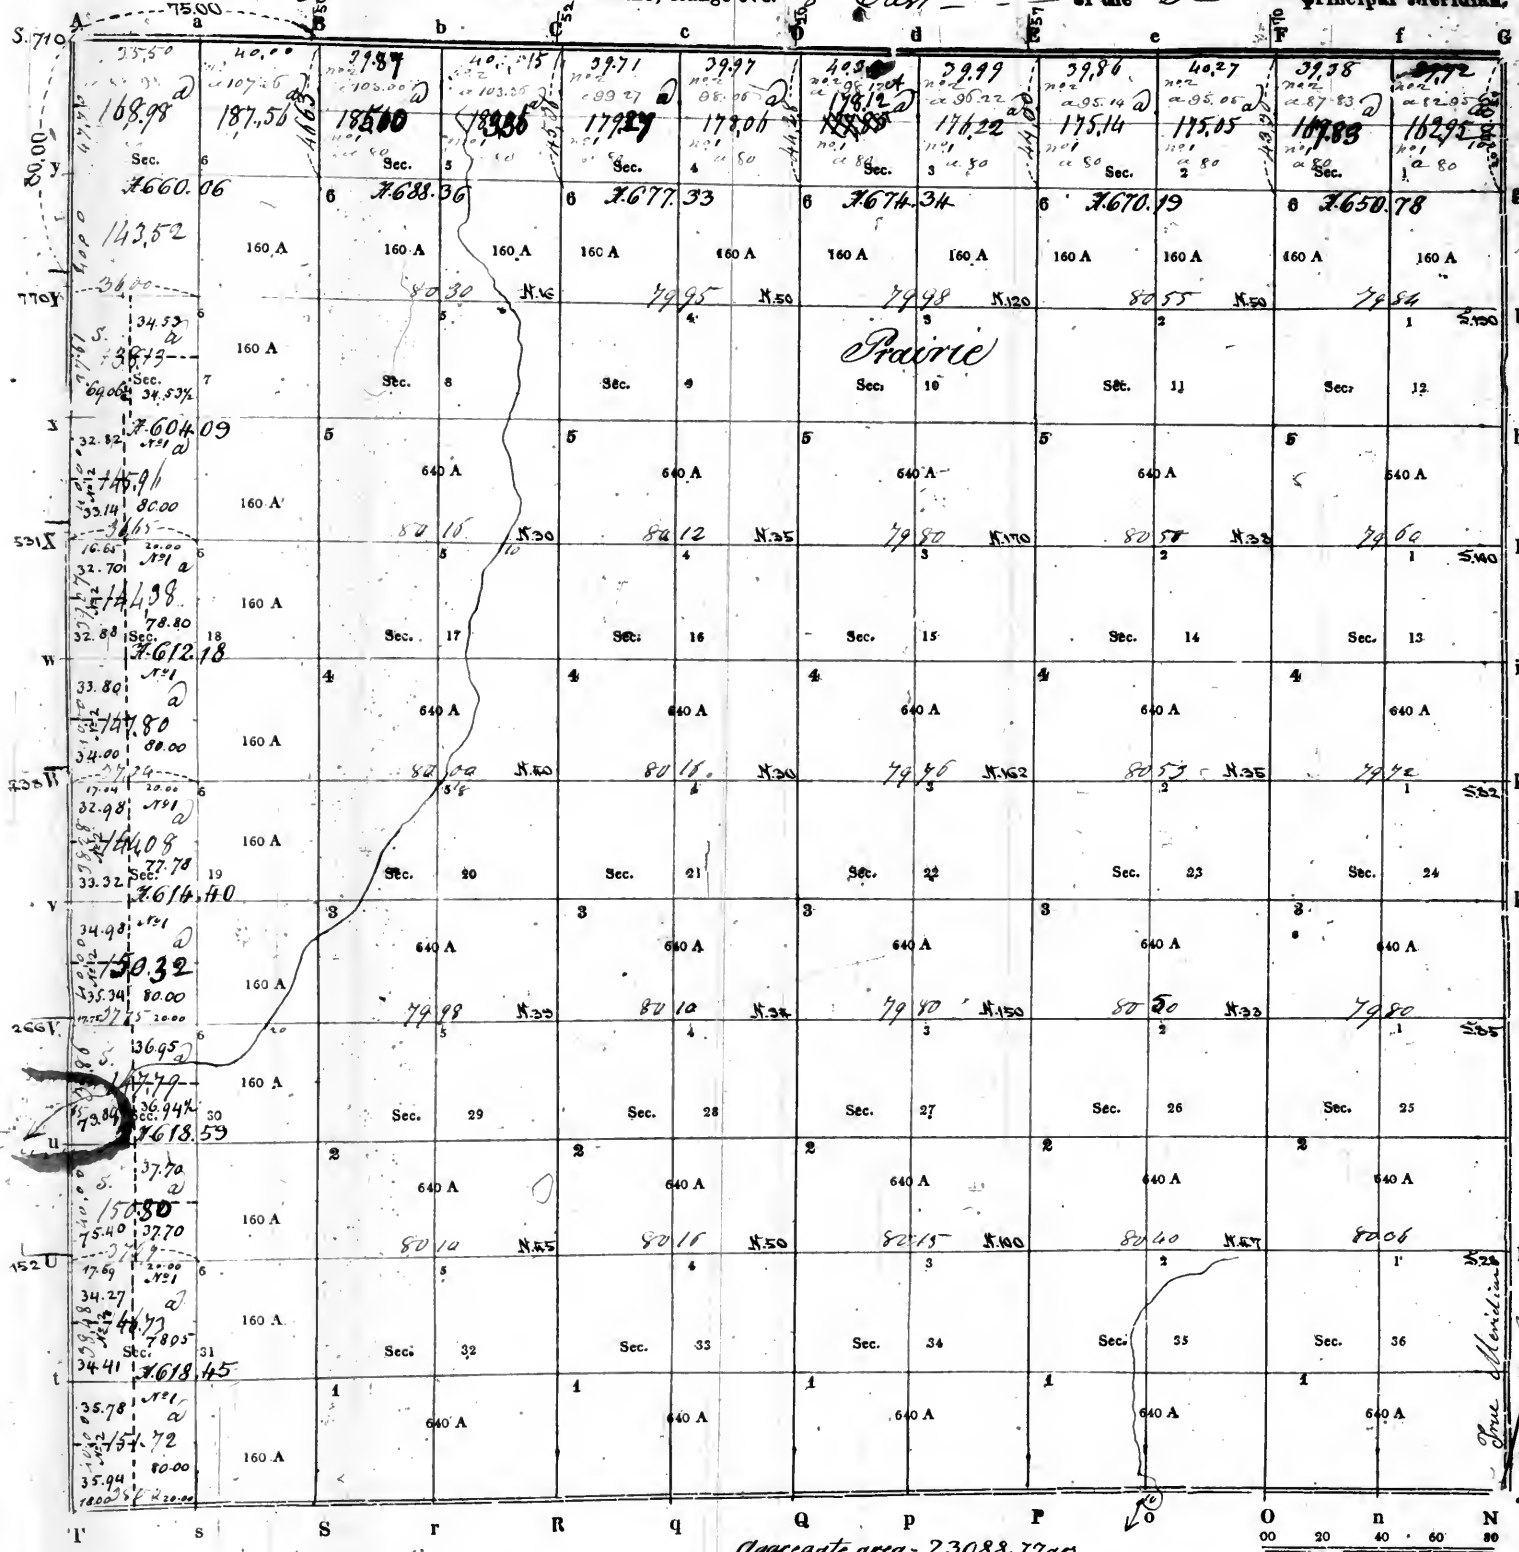


Surveyor's office
Saint Louis June 9th 1849
The South east quarter of section 7,
the West halves of sections 8, 19 & 20
situated under the act of Congress
of the 5th of April 1820, and the
west quarter of section 7, and the
west half of section 30, situated
so as to conform to previous sales,
marked 5, and a plat sent to the
Register and another to the Comptroller
of the General Land Office.

True Meridian
Magnetic 1842
N. 442

PURSUANT to a contract with, and instructions from William Rector, Surveyor of the lands of the United States in the State of Illinois, I have measured, laid out and surveyed the above described Township; and do hereby certify, that it had such marks and bounds, both natural and artificial, as are represented on said plat, and described in the field notes made thereof, and returned with this plat into the Office of the Surveyor of the Lands of the United States, in the State of Illinois, Missouri and Territory of Arkansas. Certified this 17th day of November 1822. EXAMINED, [Signature] D. SURVEYOR.

Township No. 18 North of the base line, Range No. 8 East of the 3rd principal Meridian.

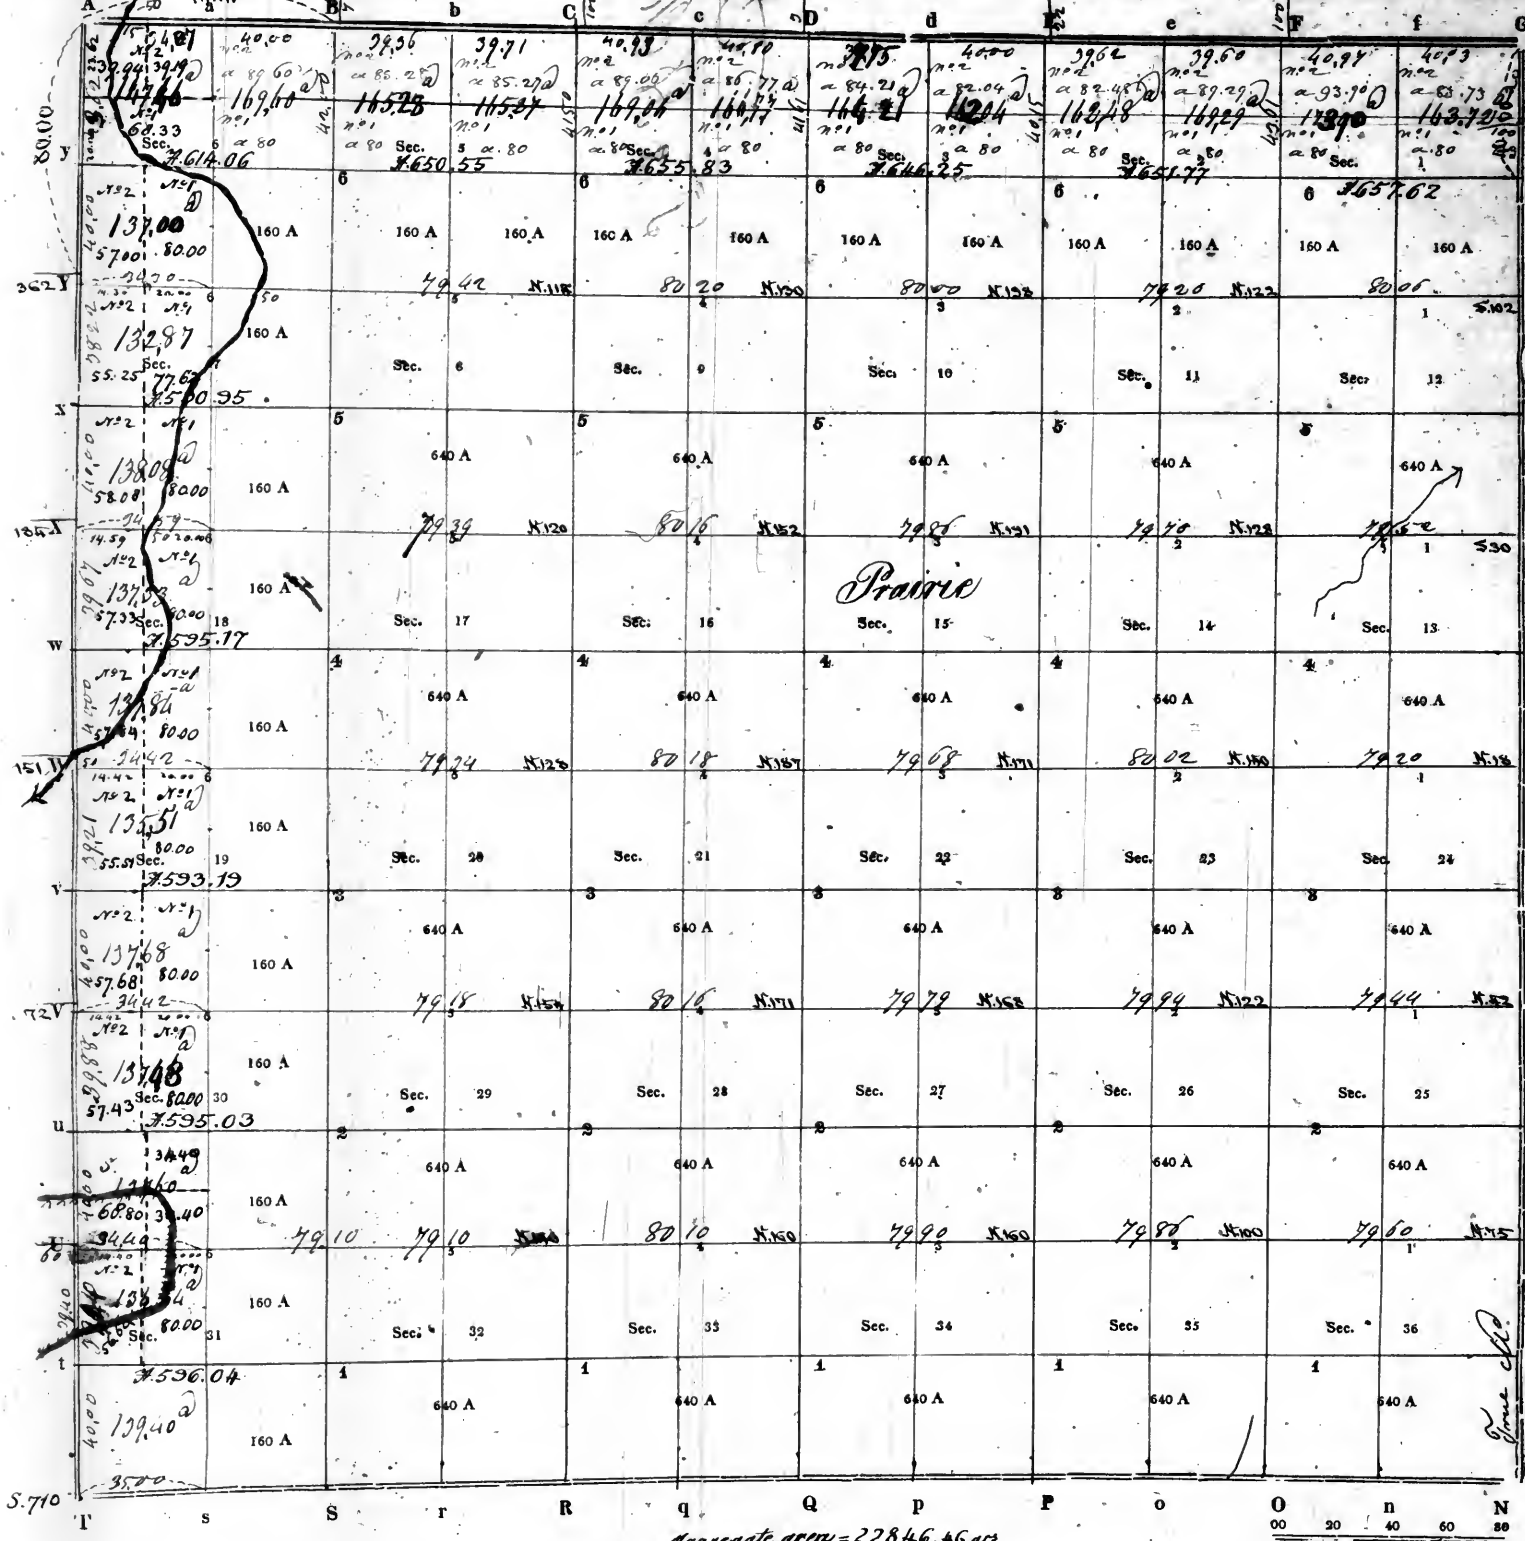

Surveyor's office

One 7.55m. Cont.
Time 11/11

aggregate area = 22846.46 ac

PURSUANT to a contract with, and instructions from William Rector, Surveyor of the lands of the United States in the State of Illinois, bearing date the 11th day of February 1892, I have measured, laid out and surveyed the above described Township; and do hereby certify, that it had such marks and bounds, both natural and artificial, as are represented on said plat, and described in the field notes made thereof, and returned with this plat into the Office of the Surveyor of the Lands of the United States, in the State of Illinois, Missouri and Territory of Arkansas, surveyed by Richd. Holliday or Elias Rector.

Certified this 11th day of November 1892

EXAMINED.

D. SURVEYOR.


Records

522

59

page 49 vol 10

Township No. *19 North* of the base line, Range No. *8 East* of the *3^d* principal Meridian.

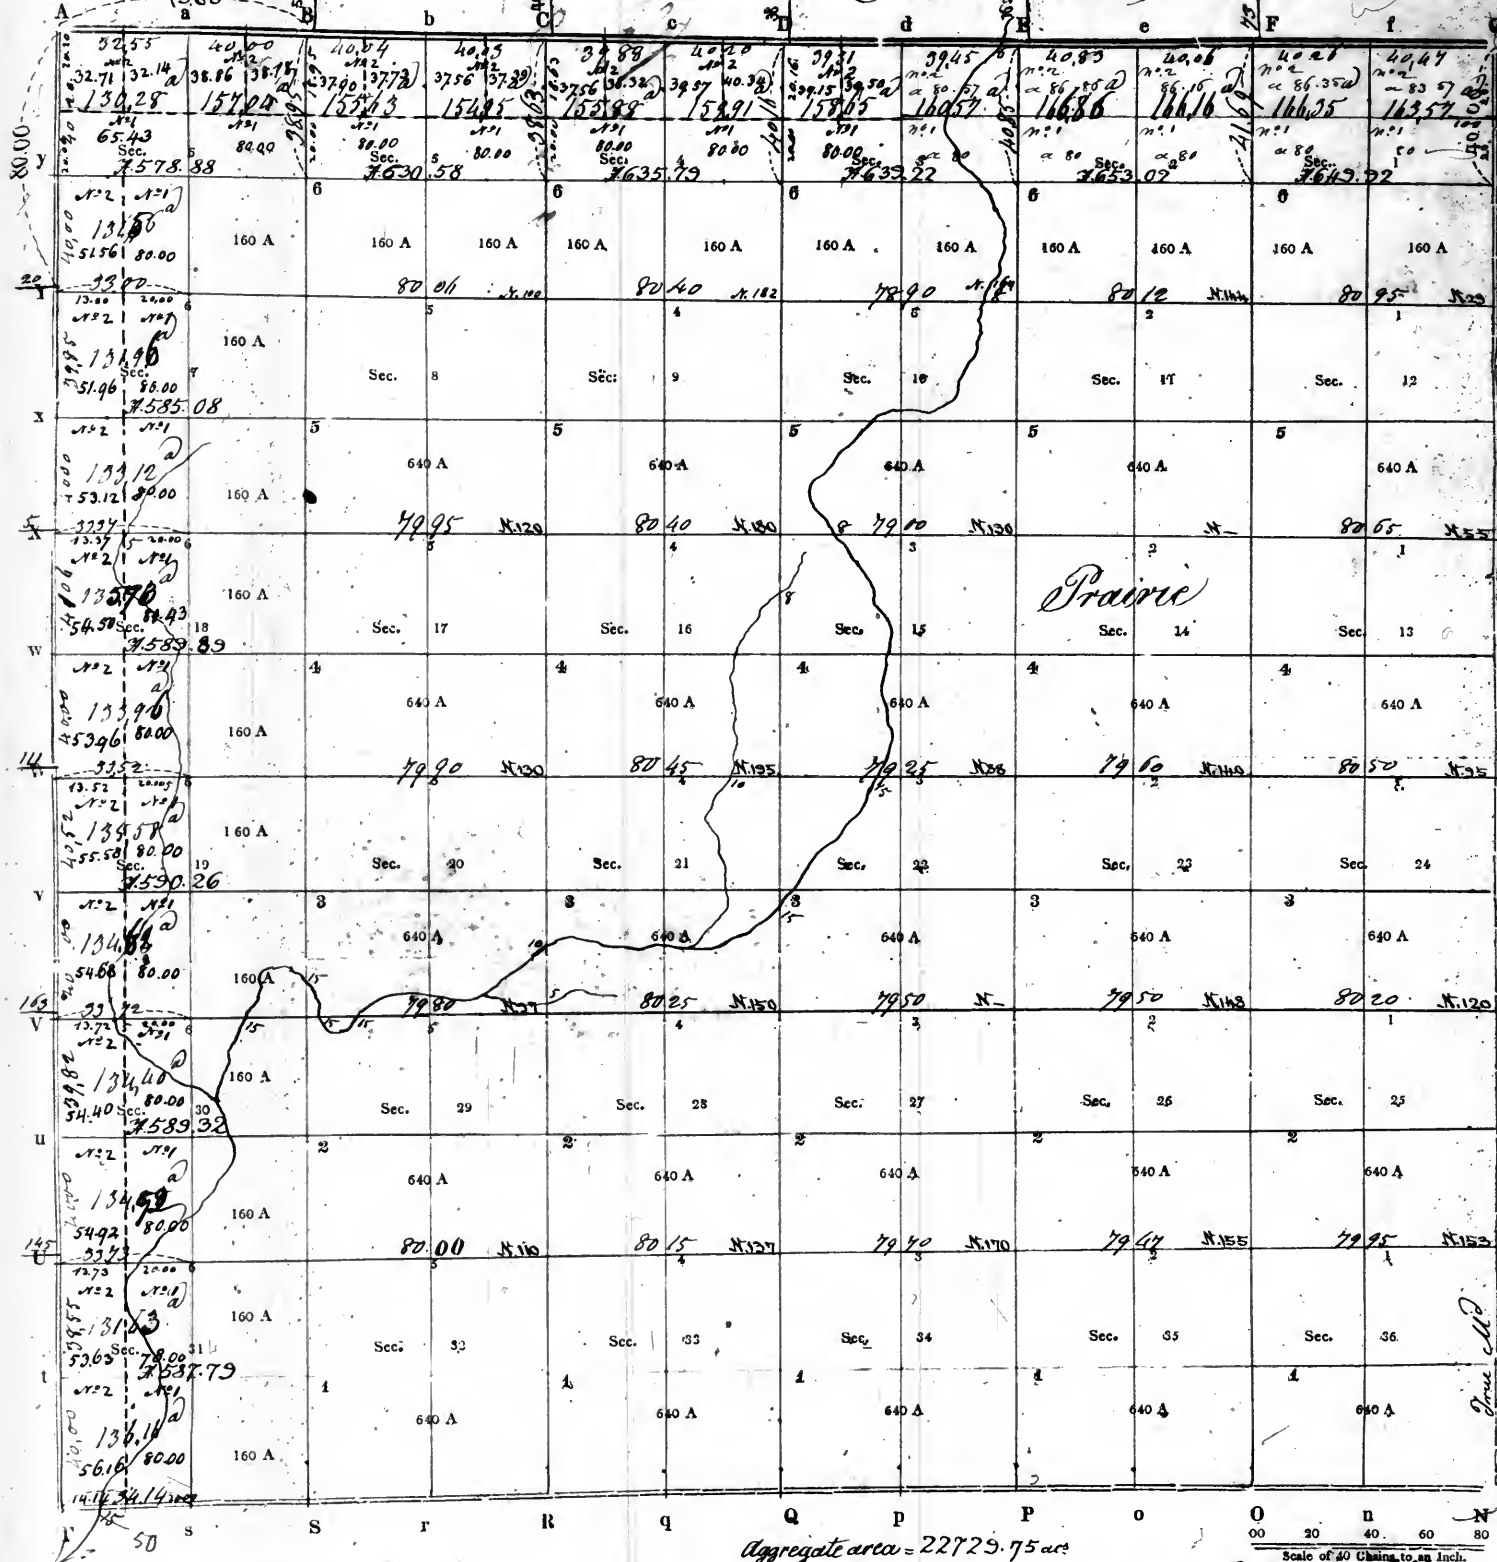

*Surveyor's office
Saint Louis June 9-1882
The North west quarter of section
3, the North half of section
4, 5 & 6, the South west quarter
of section 6, and the west
half of section 19, 20 & 21
subdivided into lots of
1/2 acre each, 3^d of April
1882 and a plat was
filed in the Register and
the Commissioner of the
General Land office.*

*Mc 4-55-1 East
College Hill
June 1882
N. 910*

Aggregate area = 22729.75 ac


Scale of 40 Chains to an Inch.

PURSUANT to a contract with, and instructions from William Rector, Surveyor of the lands of the United States in the *States of Illinois*
Missouri and Territory of Arkansas bearing date the *fourteenth* day of *February* 1882
I have measured, laid out and surveyed the above described Township; and do hereby certify, that it had such marks and bounds, both natural and artificial,
as are represented on said plat, and described in the field notes made thereof, and returned with this plat into the Office of the Surveyor of the Lands of the
United States, in the *States of Illinois Missouri and Territory of Arkansas* surveyed by *Richd. P. Holliday*
Certified this *fourteenth* day of *November* 1882 for *William Rector* S. SURVEYOR.

EXAMINED.

Recorded 523.

Town N. 20 South of the Base line Range N. 8 East of the 3^d Principal Meridian

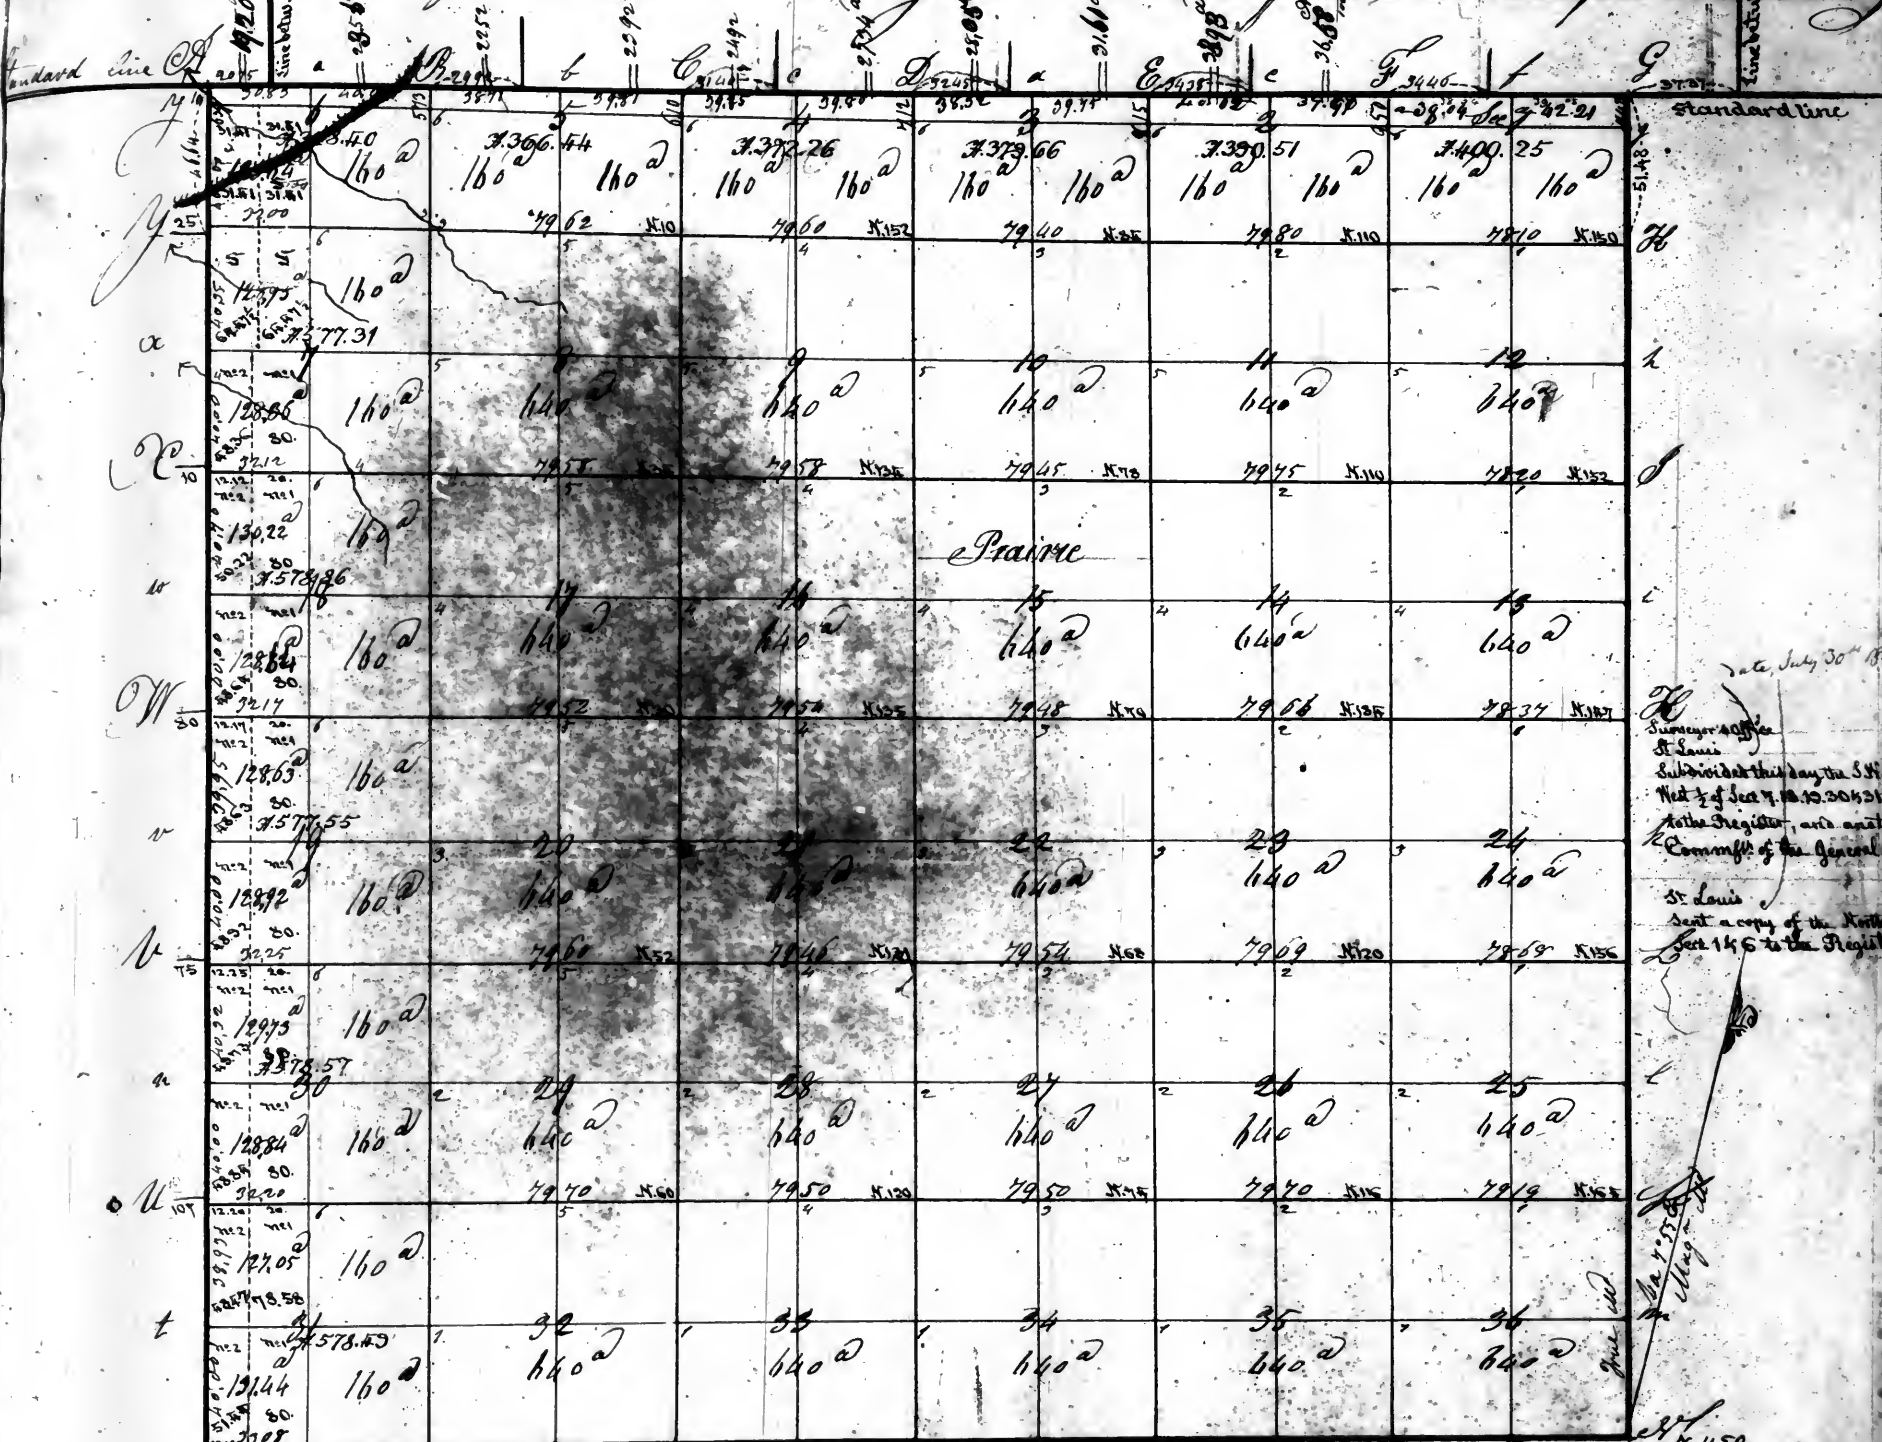

Date, July 30th 1827
Surveyor's Office
St. Louis
Subscribed this day the S. H. of Sec. 6 and
West 1/2 of Sec. 7, 8, 9, 10, 20, 43, 51, and sent a copy
to the Register, and another to the
Comptroller of the General Land Office
St. Louis
Sent a copy of the North halves of
Sec. 14 & 15 to the Register.

Pursuant to a contract with and instructions from William Hector Surveyor of the Lands of the United States in the States of Illinois, Missouri and Territory of Arkansas bearing date the nineteenth day of February 1822, I have admeasured laid out and surveyed the above described Townstrip and do hereby certify that it had such marks and bounds both natural and artificial as are represented on said plat and described in the field notes made thereof and returned with this plat into the Office of the Surveyor of Lands of the United States in the States of Illinois, Missouri and Territory of Arkansas.

Certified this 13th day of November 1822

Examined

Plaid down by a scale of 40 chains to an inch

Aggregate area = 21128.30 acs

Surveyed by Rich^d. J. Holliday
for Elias Hector, S. Surveyor

above plat of township 21 North,
of the 3^d W. is conformable with
the survey thereof on file in this
with the exceptions noted in the



the line between
being in the pre-
cable to such


David Anderson } D. Surgeon
Patrick C. Lee } D. L.

42-52 vol 10



David Anderson } B. Surveyors
Patrick R. Oler }

Township 1st 28 North of the Base line Range 1st 8 East of the 3rd Principal Meridian
page 53 vol 10.

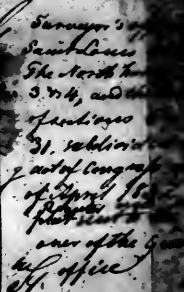


Patrick K. C. Lee Deputy Surveyor
David Anderson

Record

Township 17 N. Fork of the State line Range 11 E. East of the 3rd Principal Meridian
page 54 vol 10


Surveyor's Office
Saint Louis June 9th 1849.
The North East quarter of
section 6, the North
west quarter of section 5
and the West halves of
sections 6, 7, 18, 19, 30 & 31
as delineated under the act
of Congress of the 5th of
April 1832, and a plat
sent to the Register and
another to the Commis-
sioner of the General Land
Office.

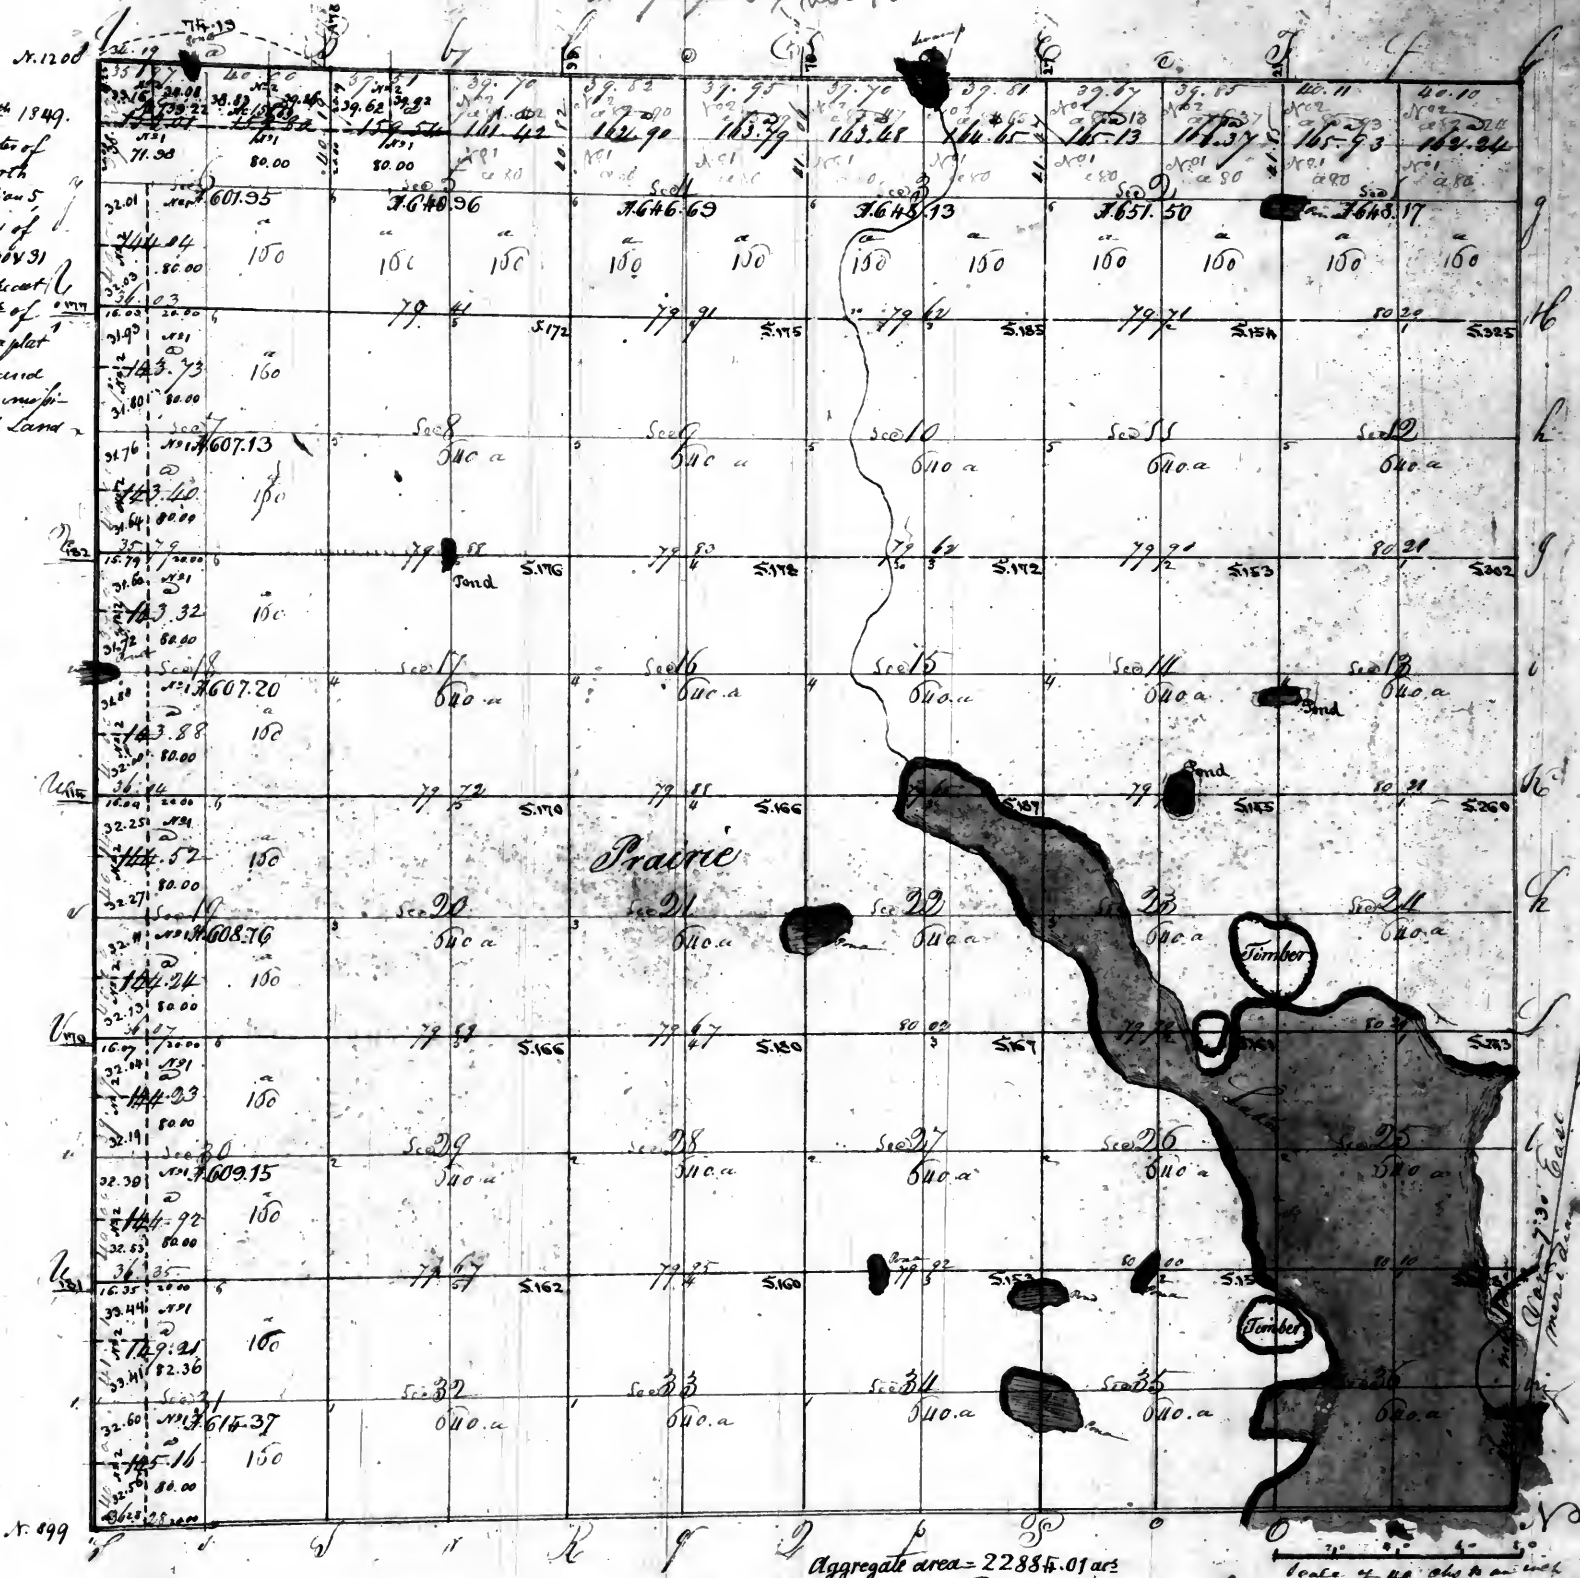

Pursuant to a contract with and instructions from William B. Rice, Surveyor of the lands of the United States in the States of Illinois and Missouri and Territory of Arkansas bearing date the Twelfth day of June, 1823, have been laid out and Surveyed the above described Township and do hereby certify that it has such marks and boundaries both natural and artificial as are represented on said plat and described in the field notes made thereof and returned with this plat into the office of the Surveyor of the lands of the United States in the States of Illinois and Missouri and Territory of Arkansas.

Witness my hand and seal this 23rd day of December 1823

David Anderson
Peter C. Lee } D. Surveyor

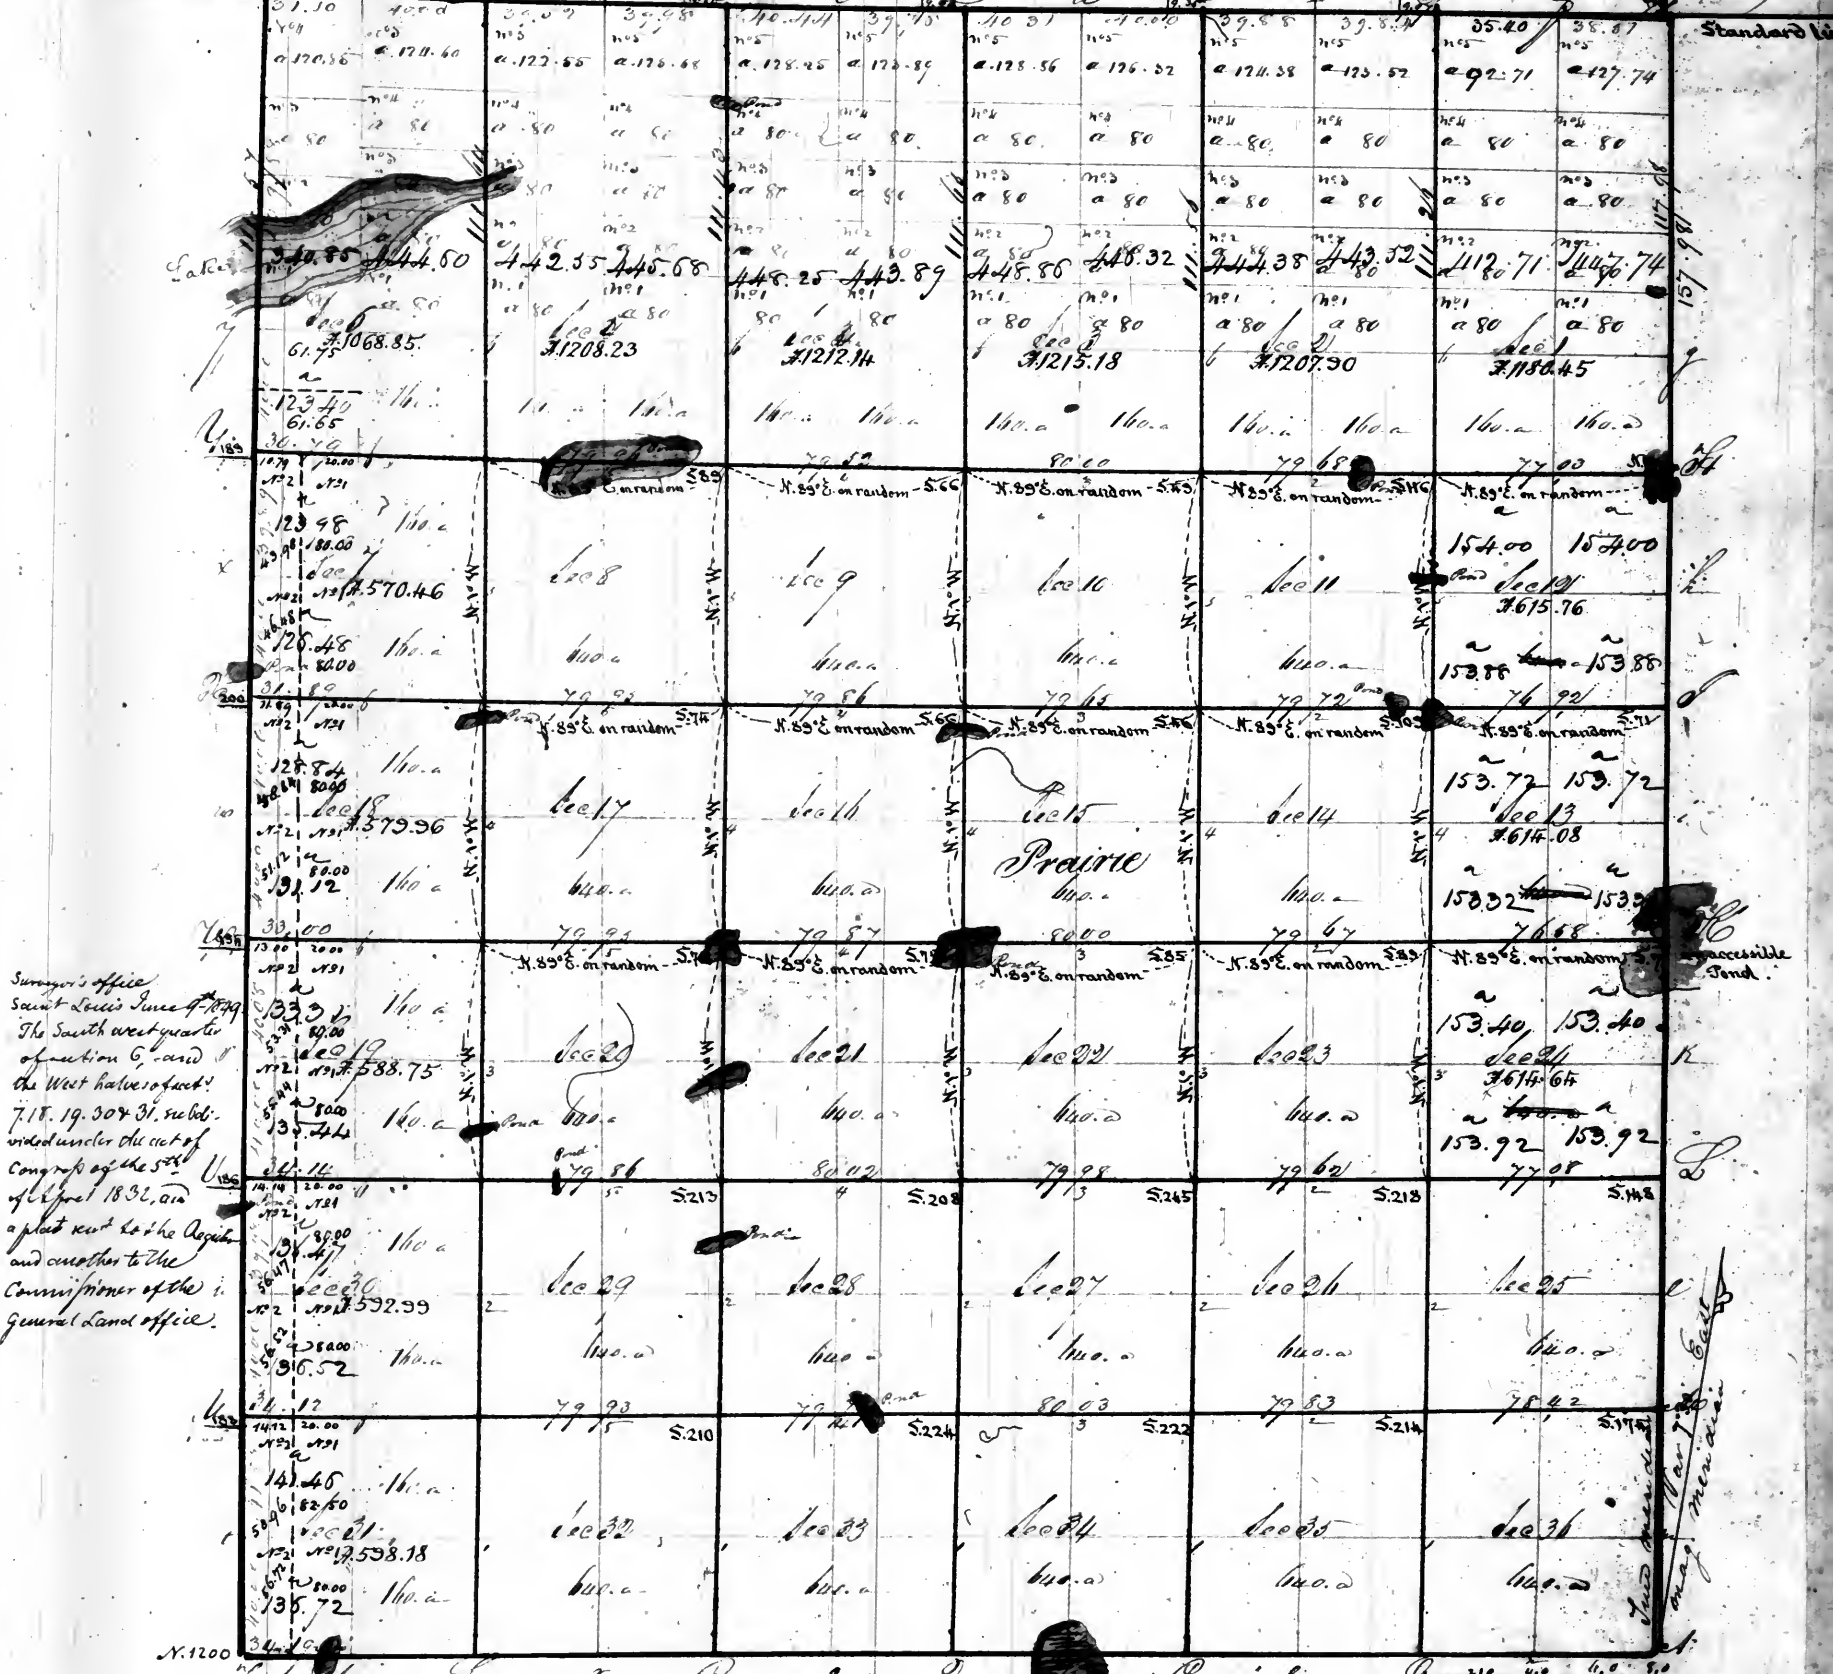

Sumner's office
 The Smith west quarter
 of section 6, and
 the West halves of sect.
 7 & 18. 19. 30 & 31, sec 36.
 were under the act of
 Congress of the 5th
 of April 1832, via 1836
 a plat sent to the Register
 and another to the
 Commissioner of the
 General Land office.


Aggregate area = 25947.57 acs

Pursuant to a contract with and instructions from William Hector Surveyor of the lands of
 the United States in the States of Illinois and Missouri and Territory of Arkansas bearing date the
 twelfth day of June 1823 Edward A. McCaskey laid out and surveyed the above described Township and do
 hereby certify that it has such marks and bounds both natural and artificial as are represented
 on said plat and described in the field notes made thereof and returned with this plat into the office
 of the Surveyor of the lands of the United States in the States of Illinois and Missouri and Territory of Arkansas
 Certified this Twenty-third day of December 1820.

Patrick H. O'Leary Deputy Surgeon
David Anderson


Township No. *31* of the base line, Range No. *East* of the *3* principal Meridian.

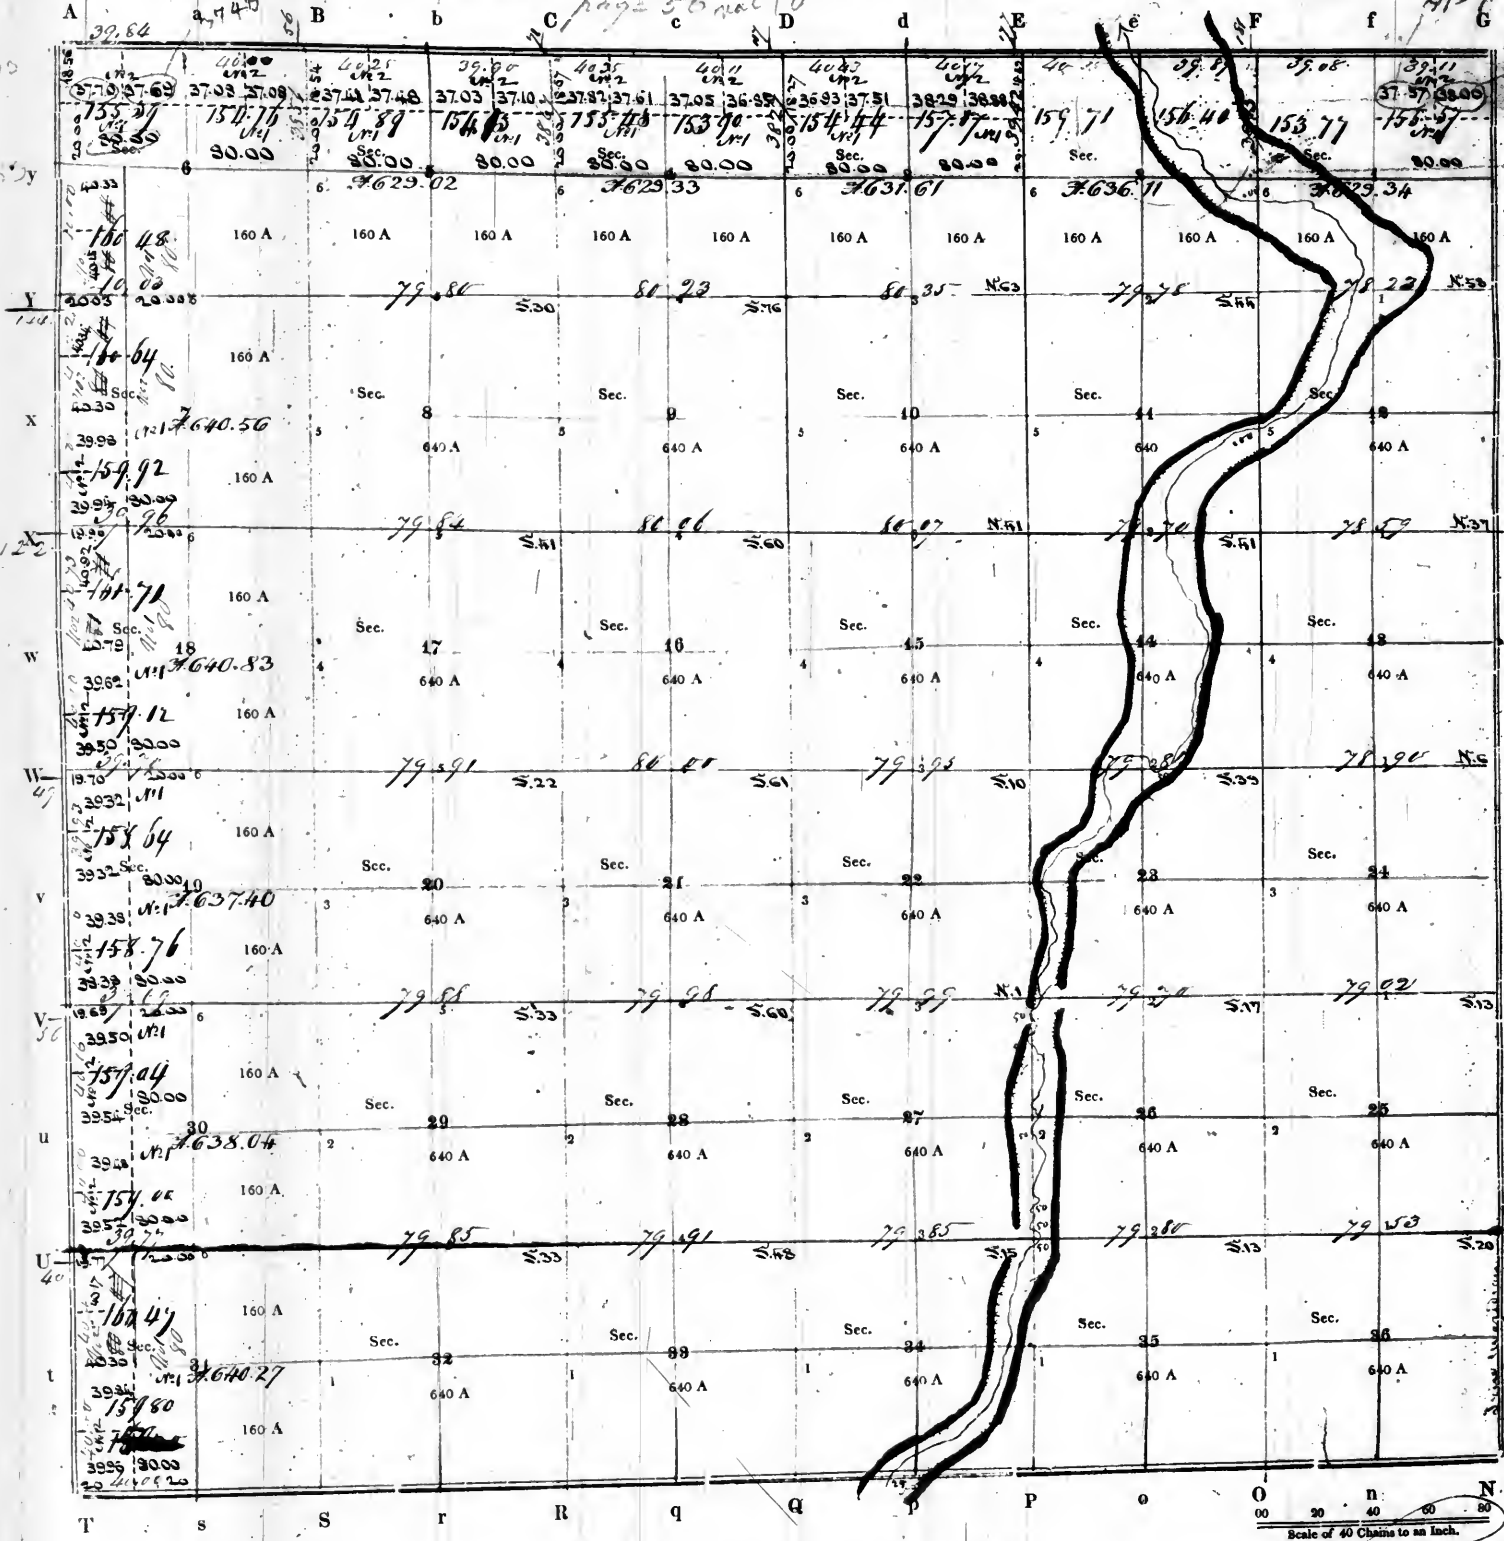


Subdivided under the act of 1832, viz. the N. E. 1/4 of Sec. 1; the N. W. 1/4 of Sec. 3, 4, 5, 6; the S. E. 1/4 of Sec. 7, 18, 19, 30, & 31, and sent today copies of the plat thereof, one to the Register, and another to the Commissioner, on the 27th of August 1845.

PURSUANT to a contract with, and instructions from WILLIAM RECTOR, Surveyor of the lands of the United States in the State of *Missouri*, bearing date the *twentieth* day of *March*, 1821. I have measured, laid out and surveyed the above described Township; and do hereby certify, that it had such marks and bounds, both natural and artificial, as are represented on said plat, and described in the field notes made thereof, and returned with this plat into the Office of the Surveyor of the lands of the United States, for the State of *Missouri*.

Certified this _____ day of _____

D. SURVEYOR

EXAMINED.

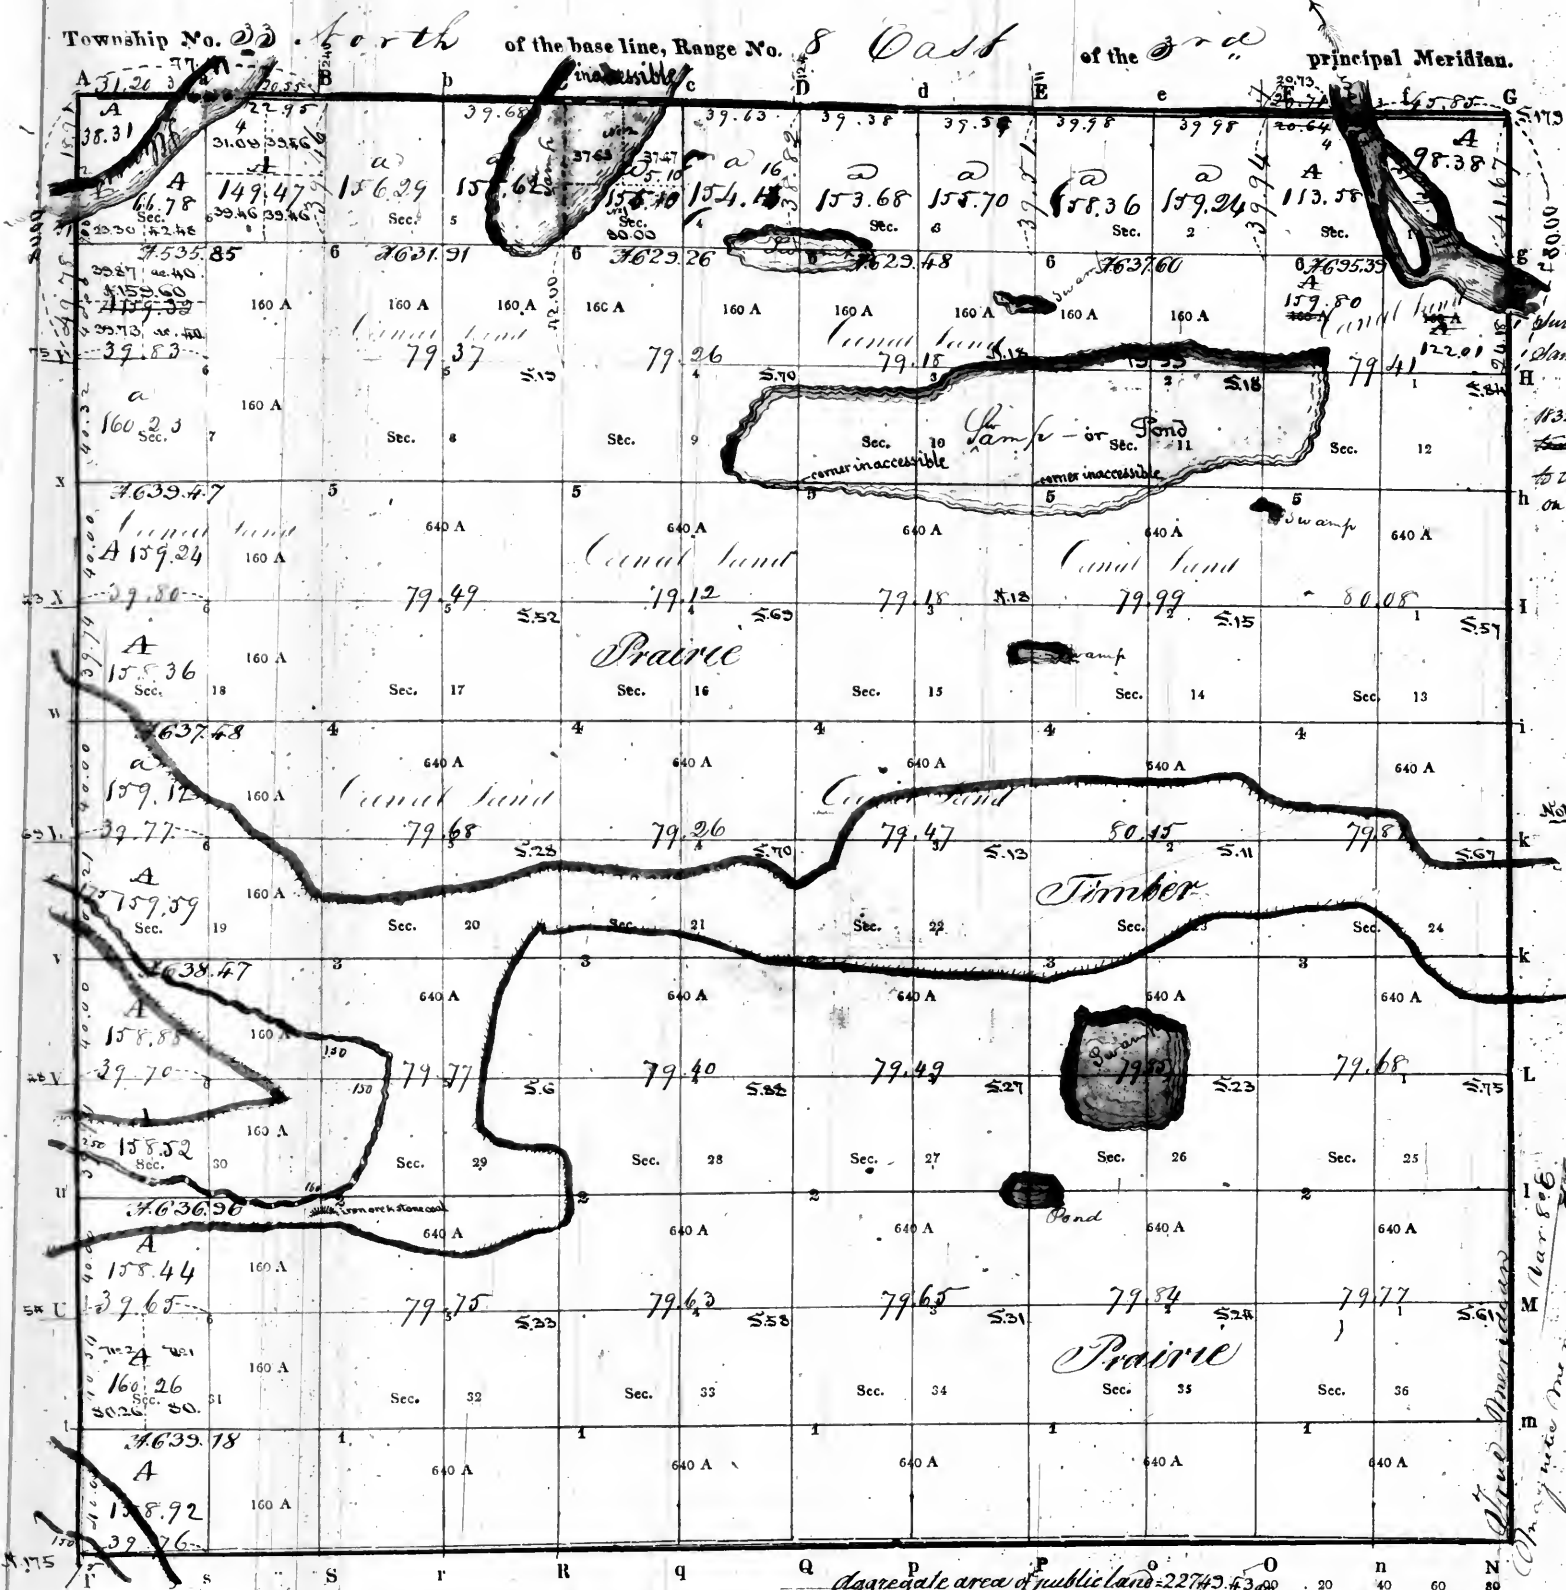

Surveyor's Office
St. Louis, Mo. 12 Nov 1844.
Subscribed under the Act of
1832, by the S. W. of Sec. 4, and sent
true copies of the plat thereof, one
to the Regt. and another to the Comd.
on the 24th of August 1845.

Note. - The line between Sections 14 & 15
T. 22 N. R. 8 E. of the 3rd pr. Meridian
only surveyed from the Section corner
North to the Swamp. The balance
of the line being inaccessible. In order
to calculate the areas in the northern
quarters of these sections, a mean
was taken between the line of Sect. 3
& 4, 5 & 6 and also of their intersec-
tion on the Township line giving a
distance to the line between Sect. 4
& 5 of 39.14 chs and its intersection
132 links East of the Section corner
on the Township line. -
The line between Sect. 24 & 11 being
in a swamp or pond, was run
by offsets and not corrected, conse-
quently there is no quarter Sec. cor.
established on that line.

Wm. H. S. G.
Surveyor

Aggregate area of public land = 22745.43 ac.
Estimated area of the river = 150.00
Total = 22895.43 ac.
Scale of 40 Chains to an Inch.

PURSUANT to a contract with, and instructions from William Rector, Surveyor of the lands of the United States in the
Territory of Arkansas -
I have measured, laid out and surveyed the above described Township; and do hereby certify, that it had such marks and bounds, both natural and artificial,
as are represented on said plat, and described in the field notes made thereof, and returned with this plat into the Office of the Surveyor of the Lands of the
United States, in the State of Illinois and Territory of Arkansas -


Certified this _____ day of _____ 1842
B. SURVEYOR.

EXAMINED.

746

20. Pursuant to a contract, with and instructions from William P. Foster, Surveyor of the lands of the United States of the States of Illinois and Missouri and Territory of Arkansas bearing date the 20th day of March 1852 - I have admeasured laid out and Surveyed the above described Township and do hereby certify that it has such marks and bounds both natural and artificial as are represented on said plat and described in the field notes made thereof and returned with this plat into the office of the Surveyor of the lands of the United States in the States of Illinois and Missouri and Territory of Arkansas

Sectional Township No. 35 North of the base line. Range No. 8 East of the 3rd principal meridian

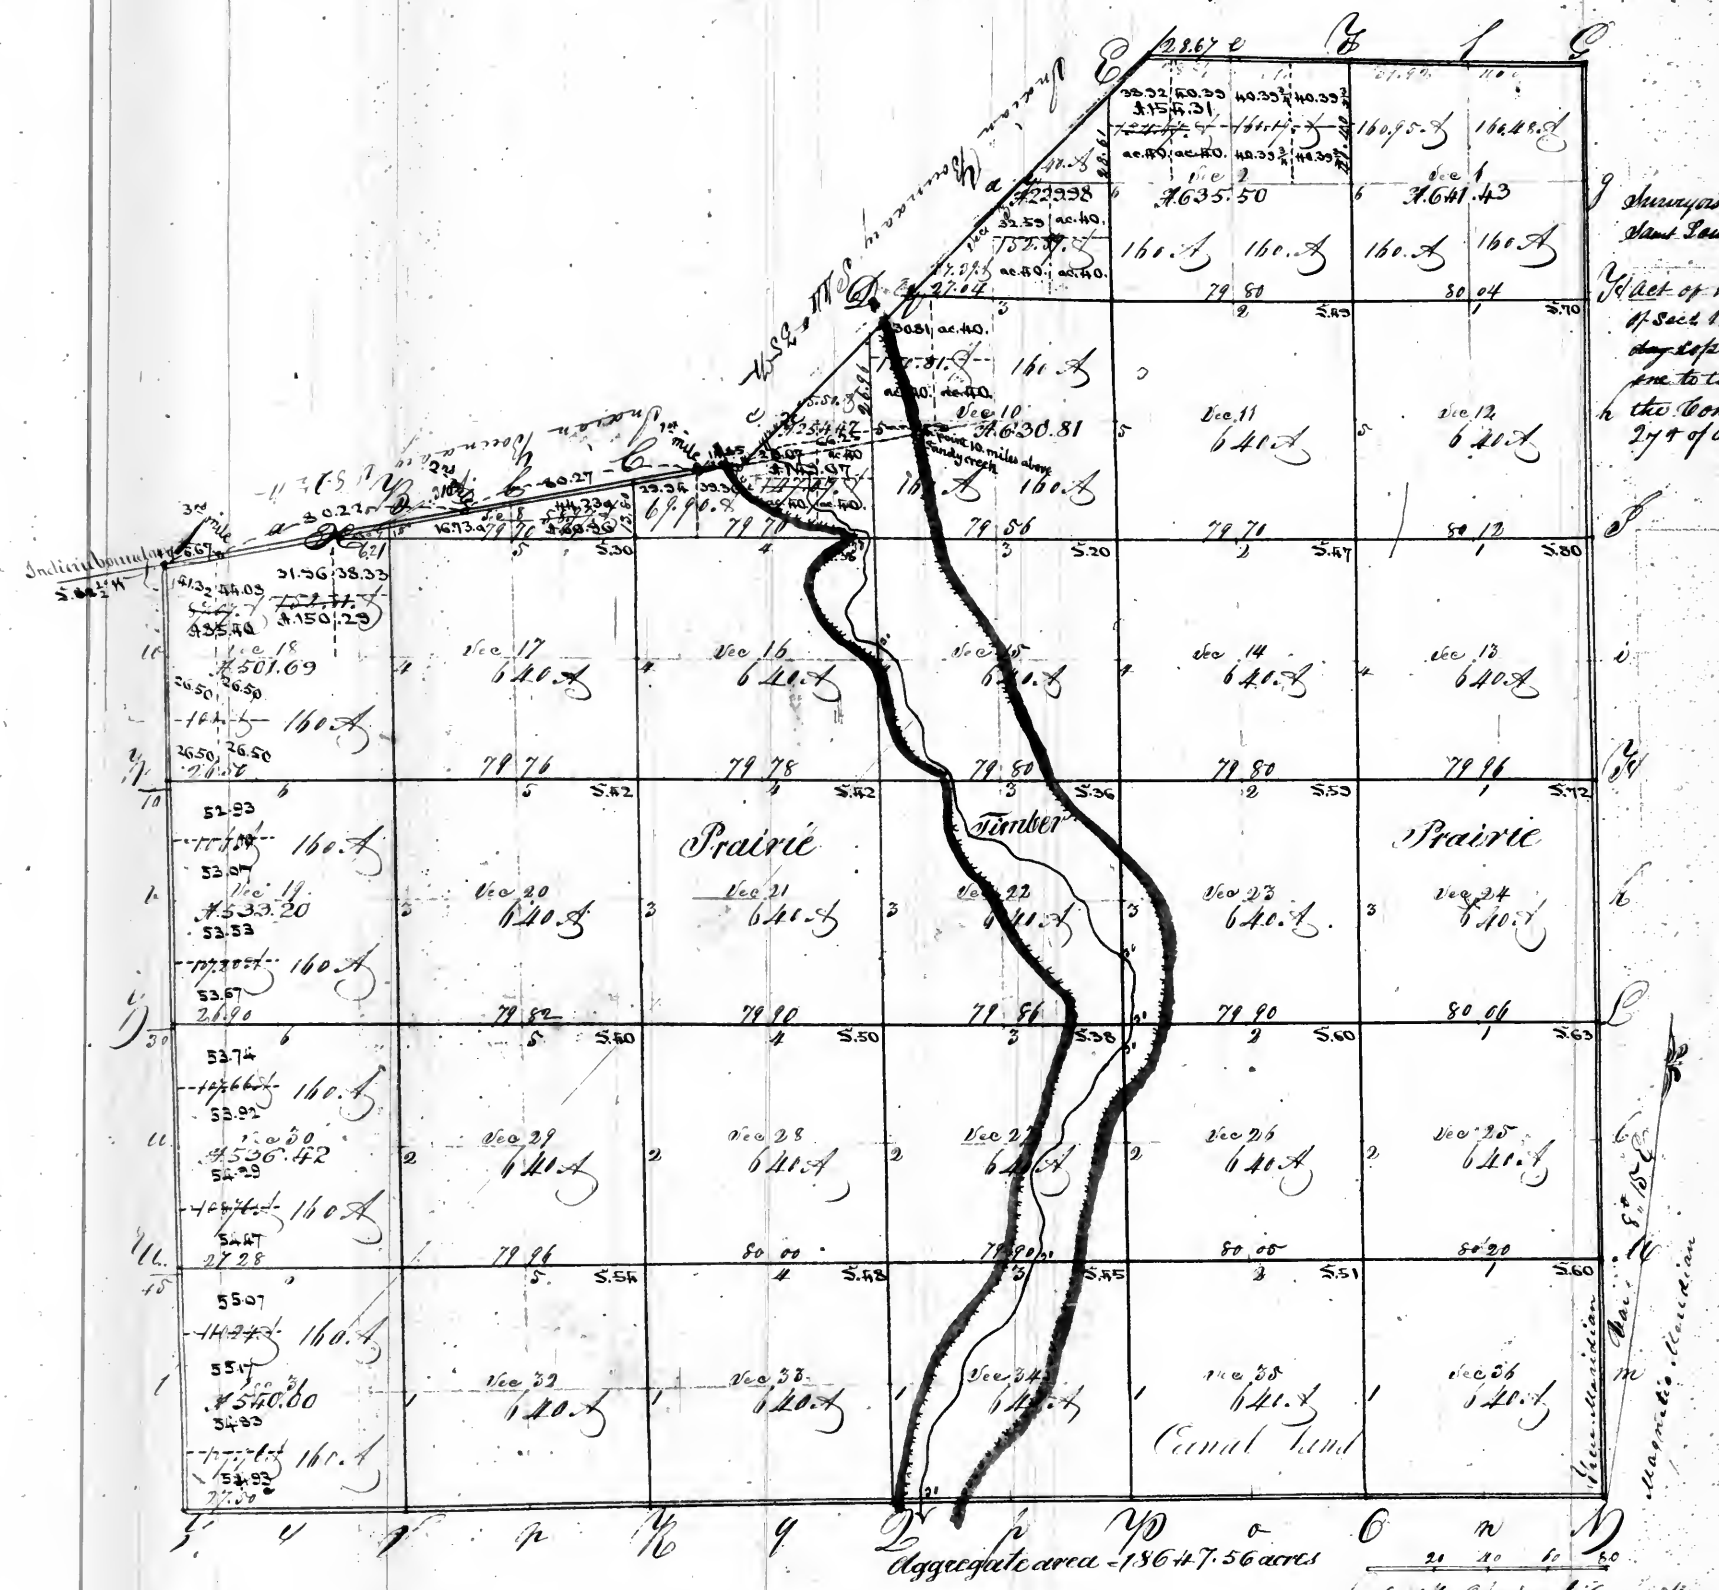


Surveyor's Office
St. Louis 12th Nov. 1844
Subscribed under the
Act of 1832, viz. the 10th
of Sept. 17, 30 & 31 and sent to
day copies of the plat thereof
one to the Regr. & another to
the Commissioner on the
27th of August 1845.

Pursuant to a contract with and instructions from William Reed Surveyor of the Lands
of the United States in the States of Illinois and Missouri and Territory of Arkansas bearing
date the Twentieth day of March 1821
I have hereunto laid out and surveyed the above described Sectional Town
ship and distinctly certified that it had such marks and bounds both natural
and artificial as an authentic and valid plat and described in the field
notes made thereof and returned with this plat into the Office of the Surveyor
of the Lands of the United States in the States of Illinois and Missouri and Territory
of Arkansas
Certified this day of

Town of Township 11.36 North of the Indian
 Range No. 8 East of the 3rd Meridian and
 page 61 vol 10

648
 1118

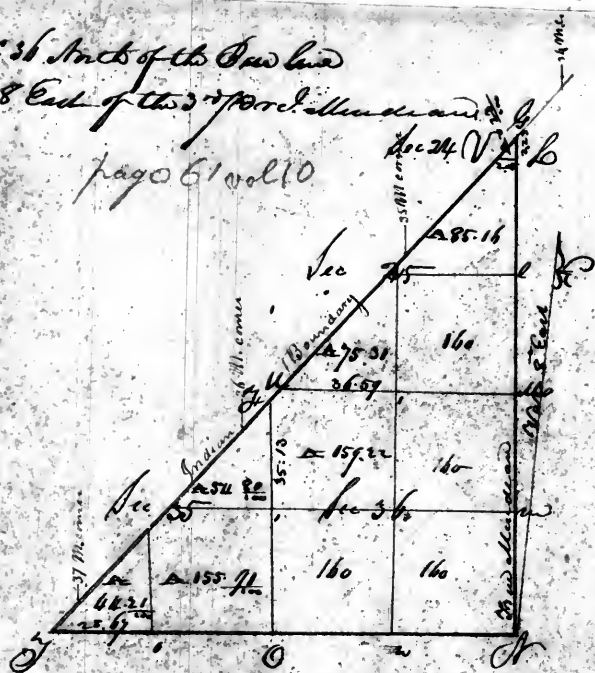


Pursuant to a contract with and instructions from William Rector
 Surveyor of the Lands of the United States of Illinois, Michigan and
 Territory of Arkansas, bearing date the twentieth day of March 1821
 We have measured laid out and surveyed the above described
 Township and do hereby certify that it has such marks and
 bounds both natural and artificial as are represented in
 the plat and described in the field notes made thereof
 and returned with this plat into the office of the Surveyor
 of the Lands of the United States in the State of Illinois
 We Survey and Surveyor of Arkansas
 Certified the Sixth day of November 1822

VOL. 13

Township 8th S. Range 3rd E. of the 3rd Principal Meridian 524.
Page 1 of 1

Not. Nat. sent to
Register Oct 30th 1850

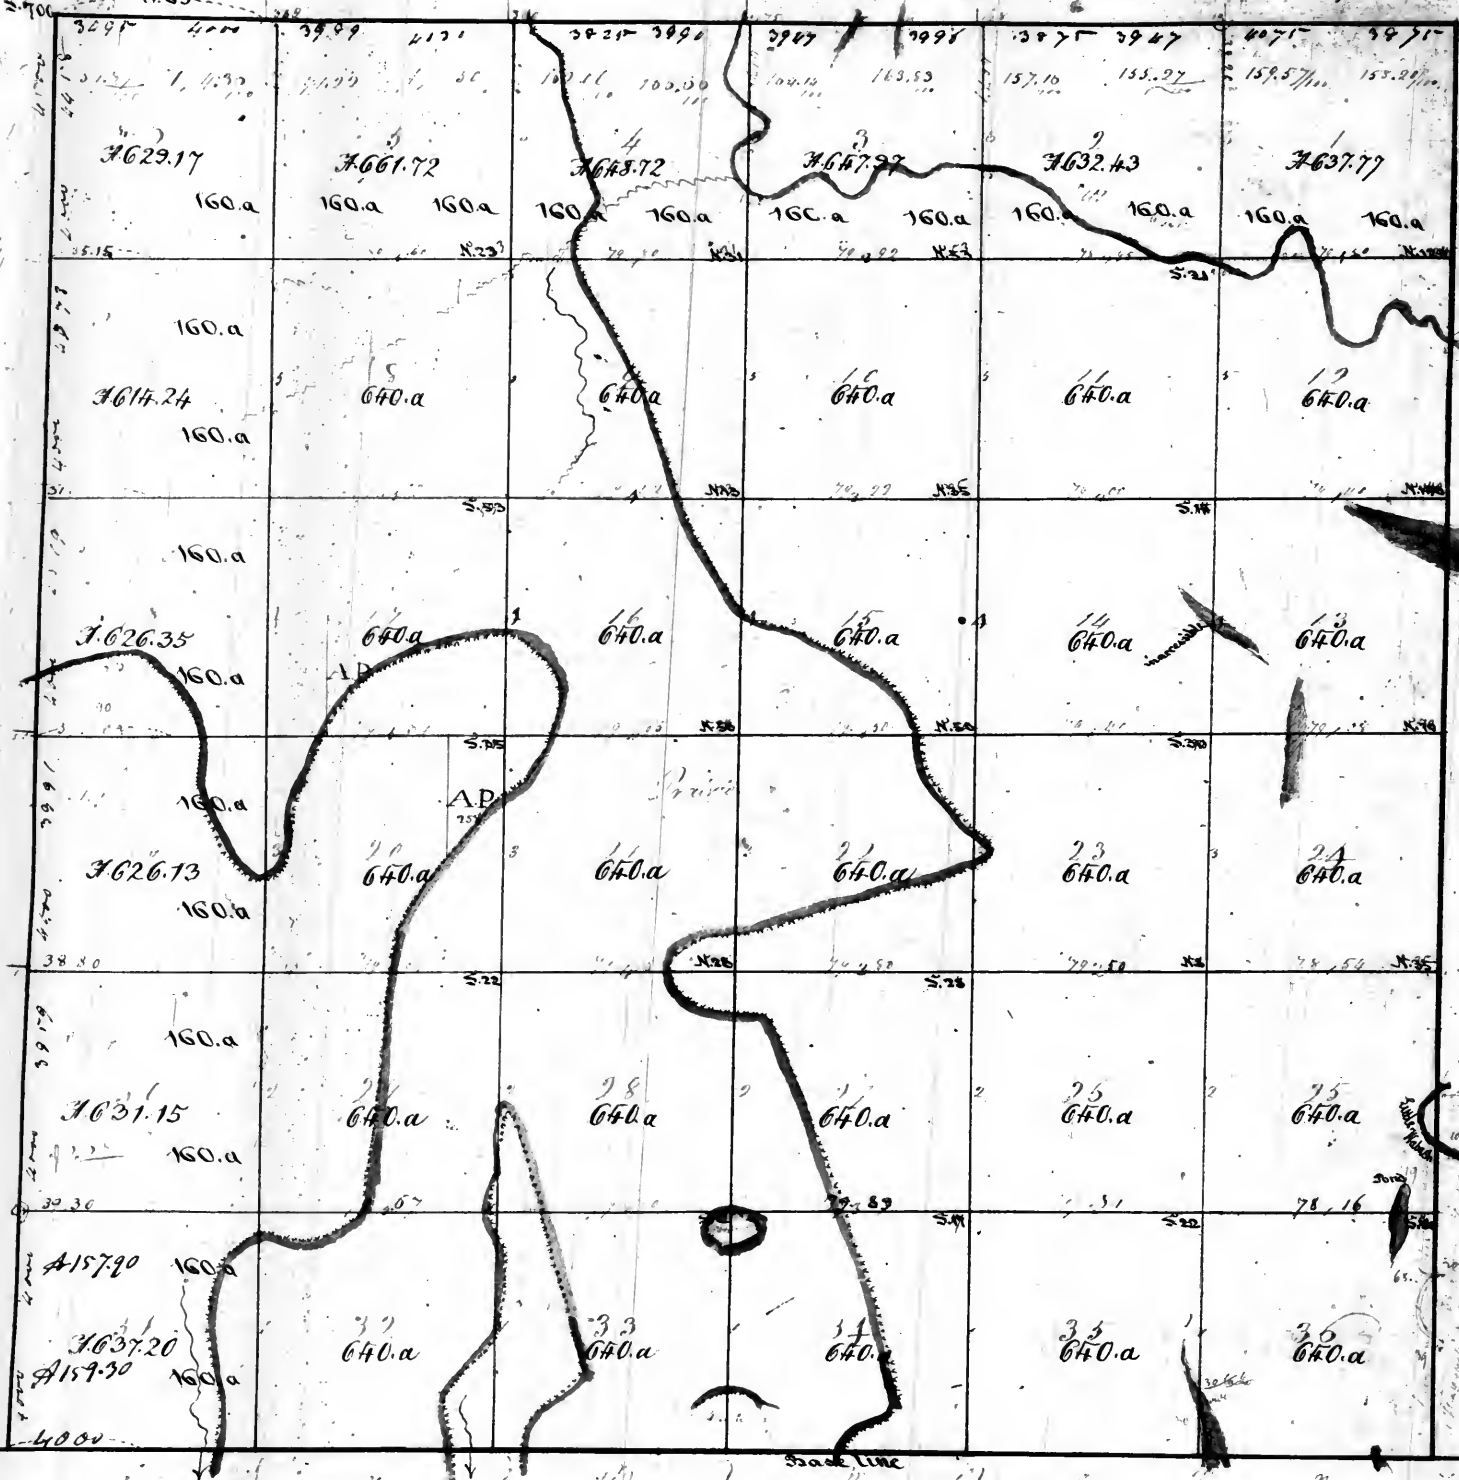


Aggregate area - 23990.95 acres

...from William L. ...
...the 21st ...
...the 21st ...


Wm. Moore

Township No. 2 North of Range No. 9 East of the 3 Principal Meridians
 (2) page 2 vol 11
 525

New Plat sent to
 Register Oct 30th 1850

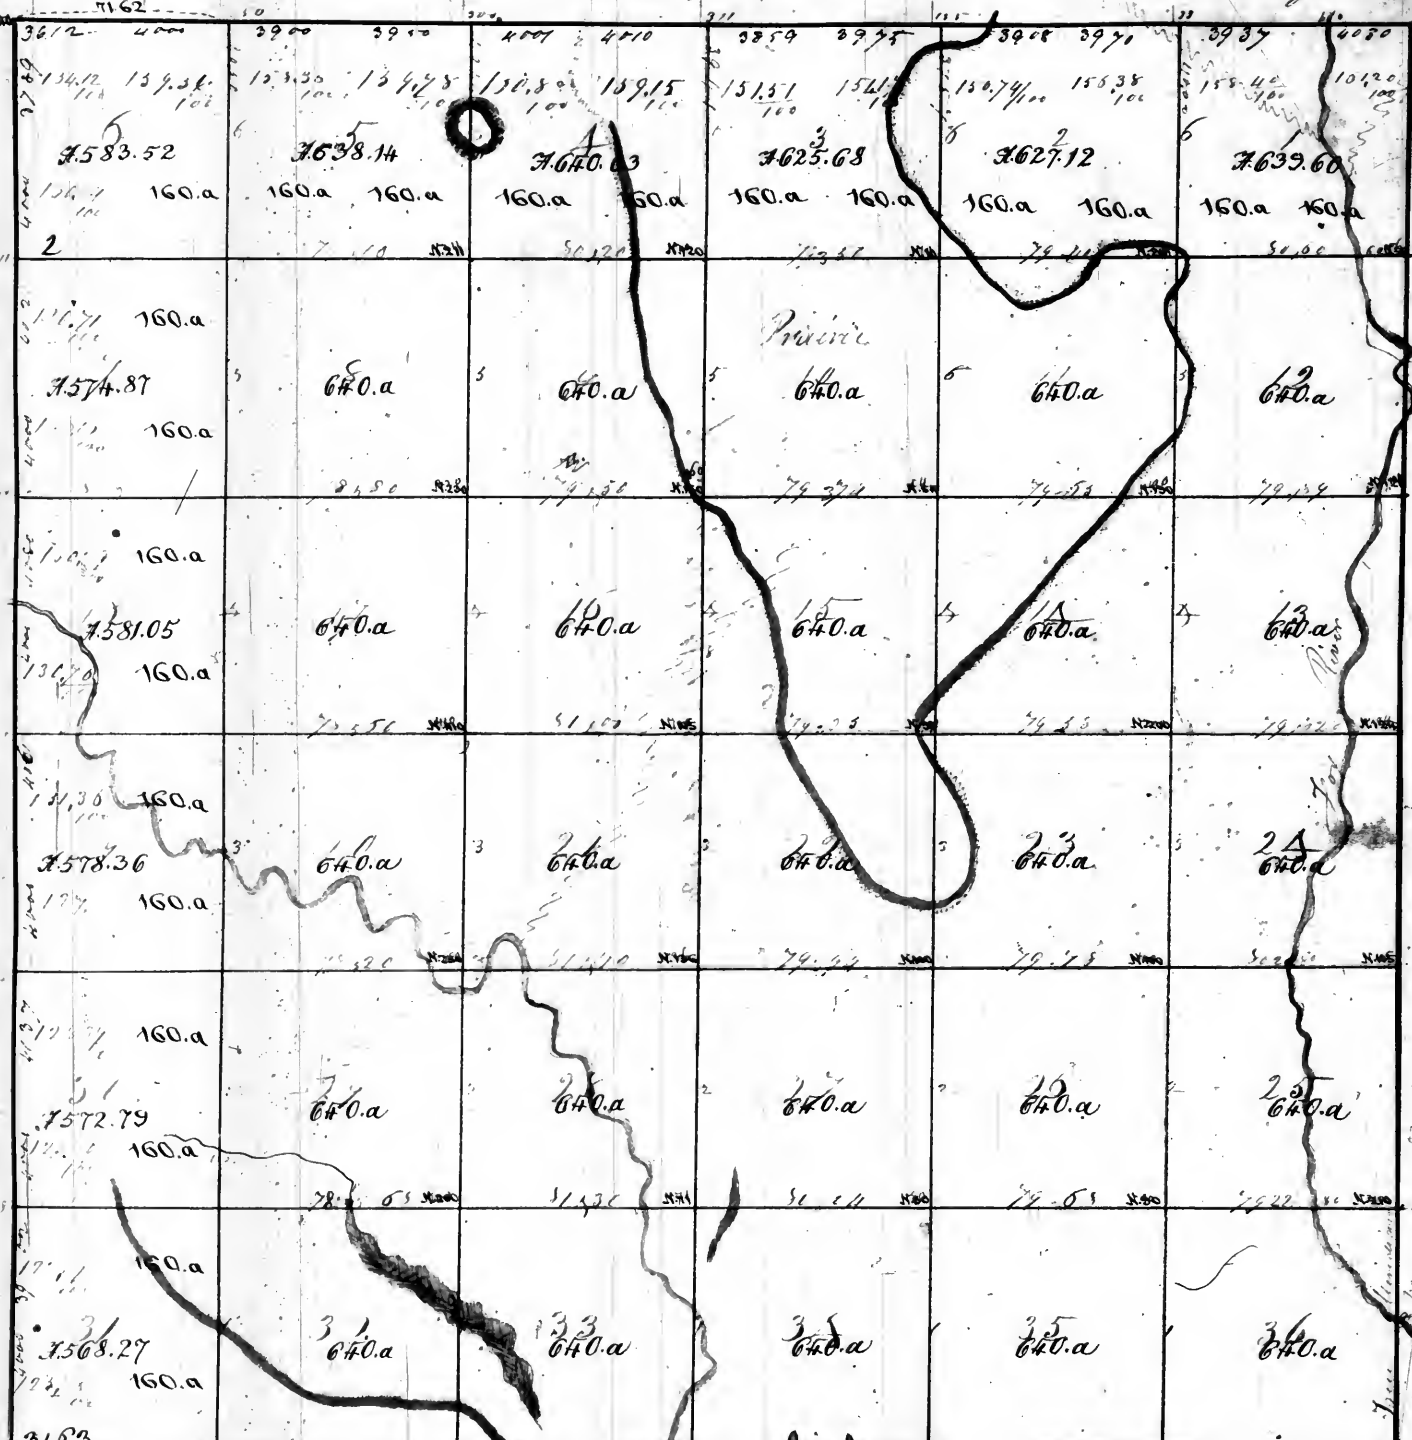

Aggregate area = 22629.43 acres

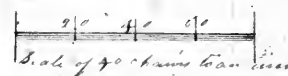





New plat sent to
Register Oct. 30th/85

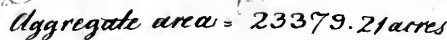

1
2
Continued 20th March 1819

Am Moore Dr.

527. #

Township 17th North of range 1st East of the 3 Principal Meridian
page 4 vol 11
D. 24th E

New plat sent to
Register Oct. 30th 1850

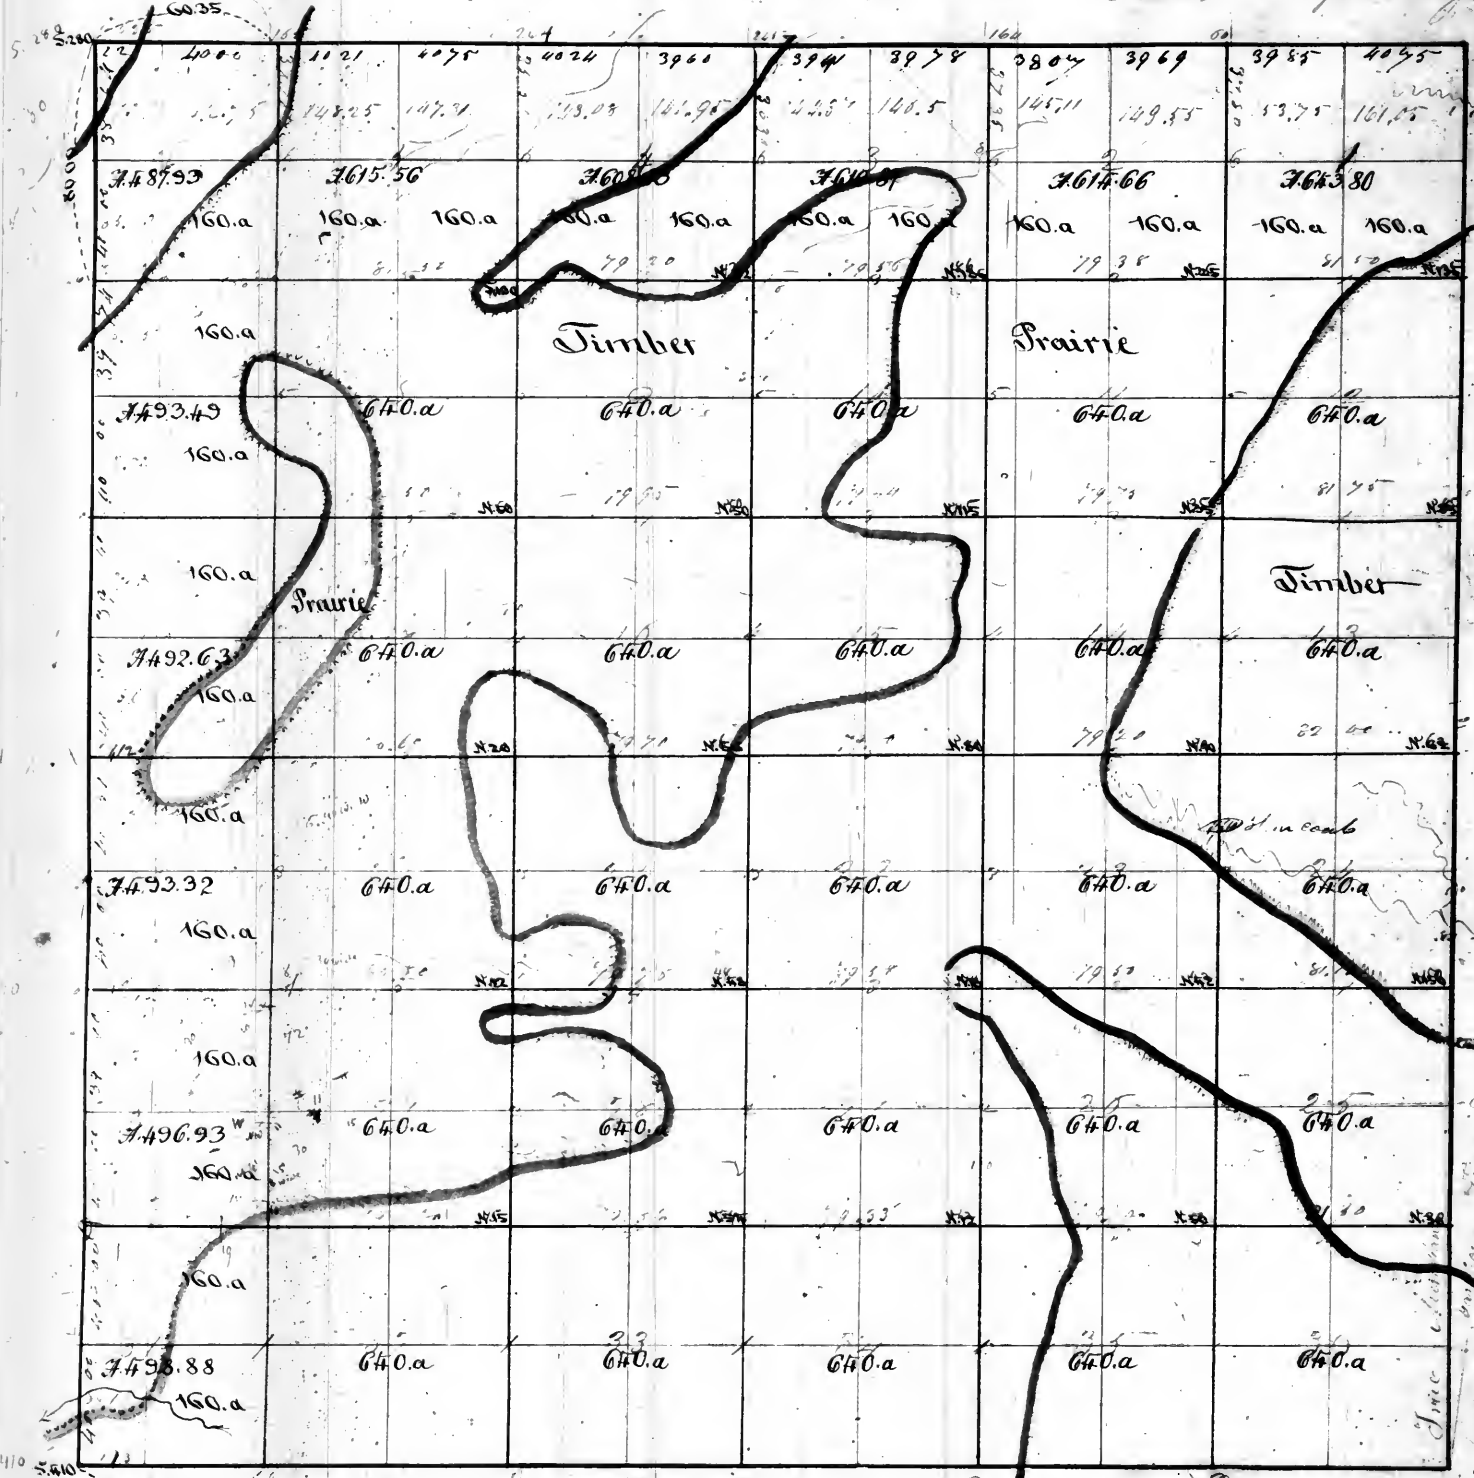

Aggregate area = 23047.10 acres






Township 15 North of Range 12 East of the 3rd Principal Meridian
 page 5 of 11
 528.550

New plat sent to
 Register Oct. 30th 1855

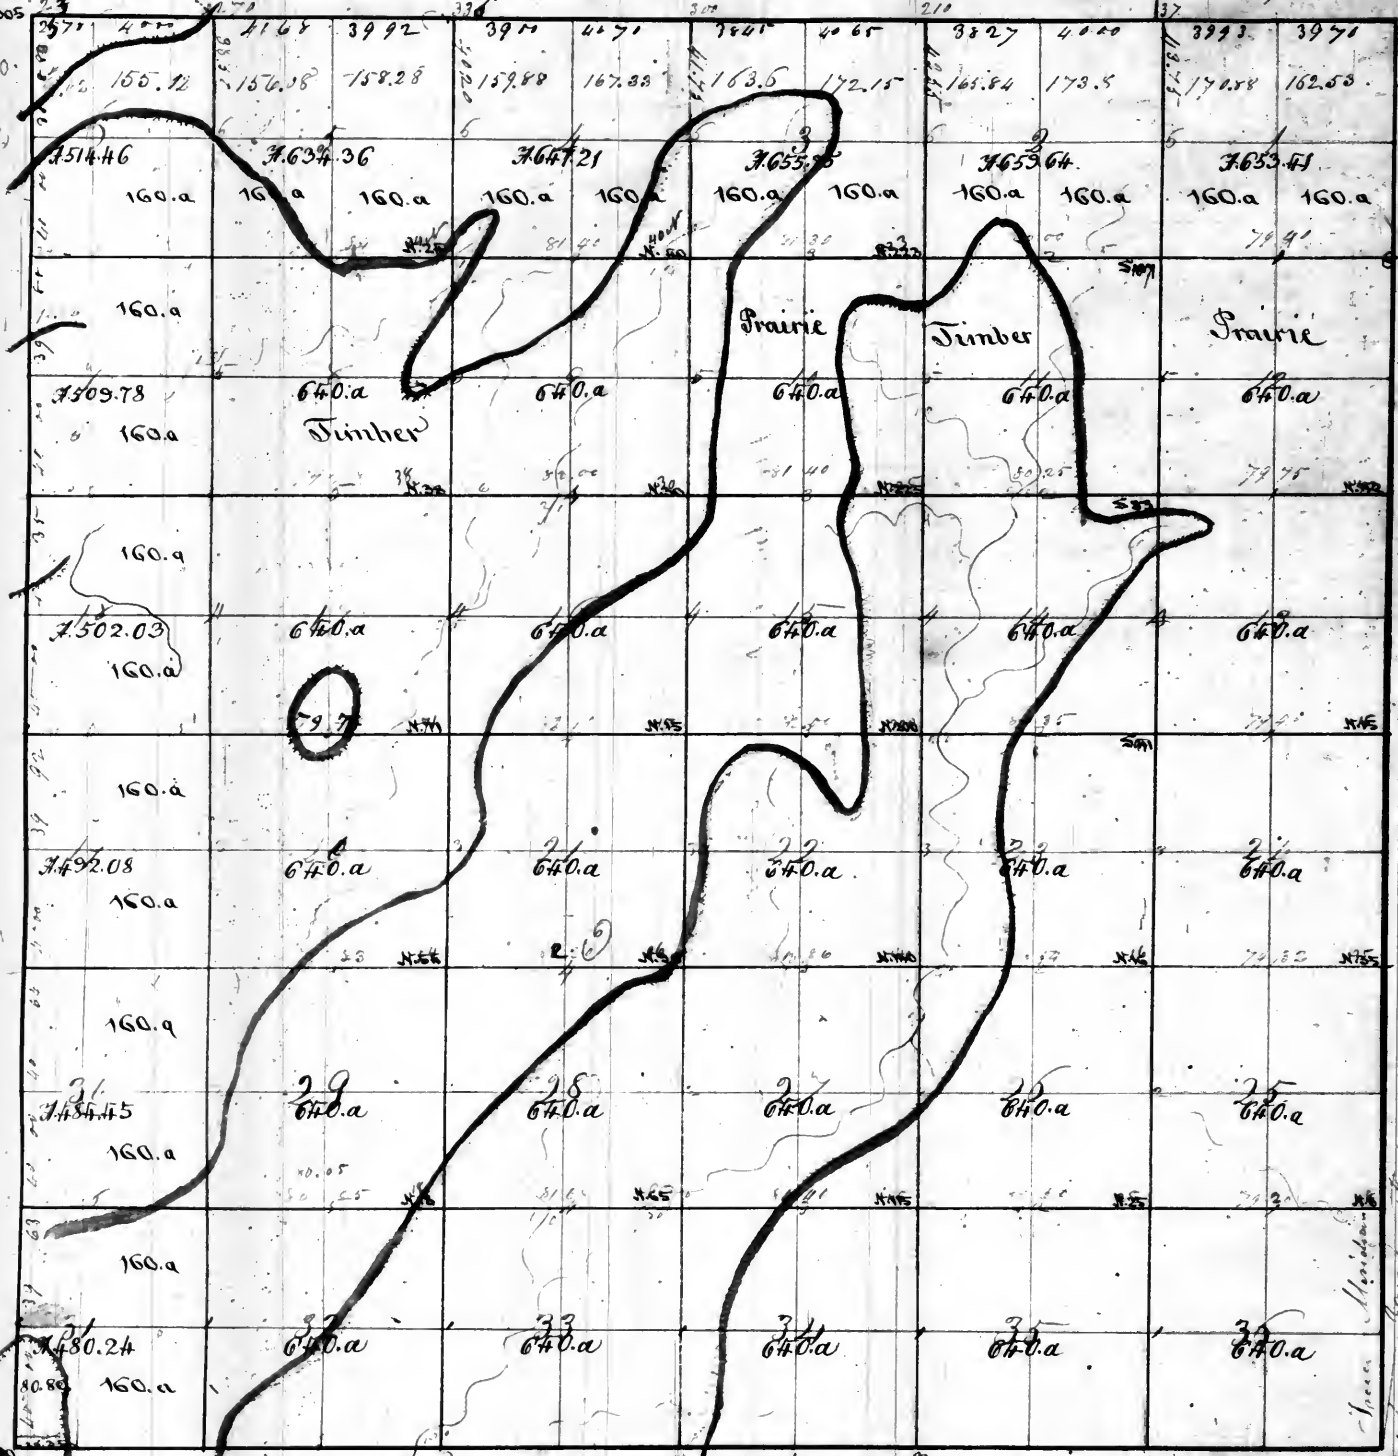


Aggregate area - 22233.41 acres




Township No. 6 North of the base line, Range No. 9 East of the 3rd principal Meridian.

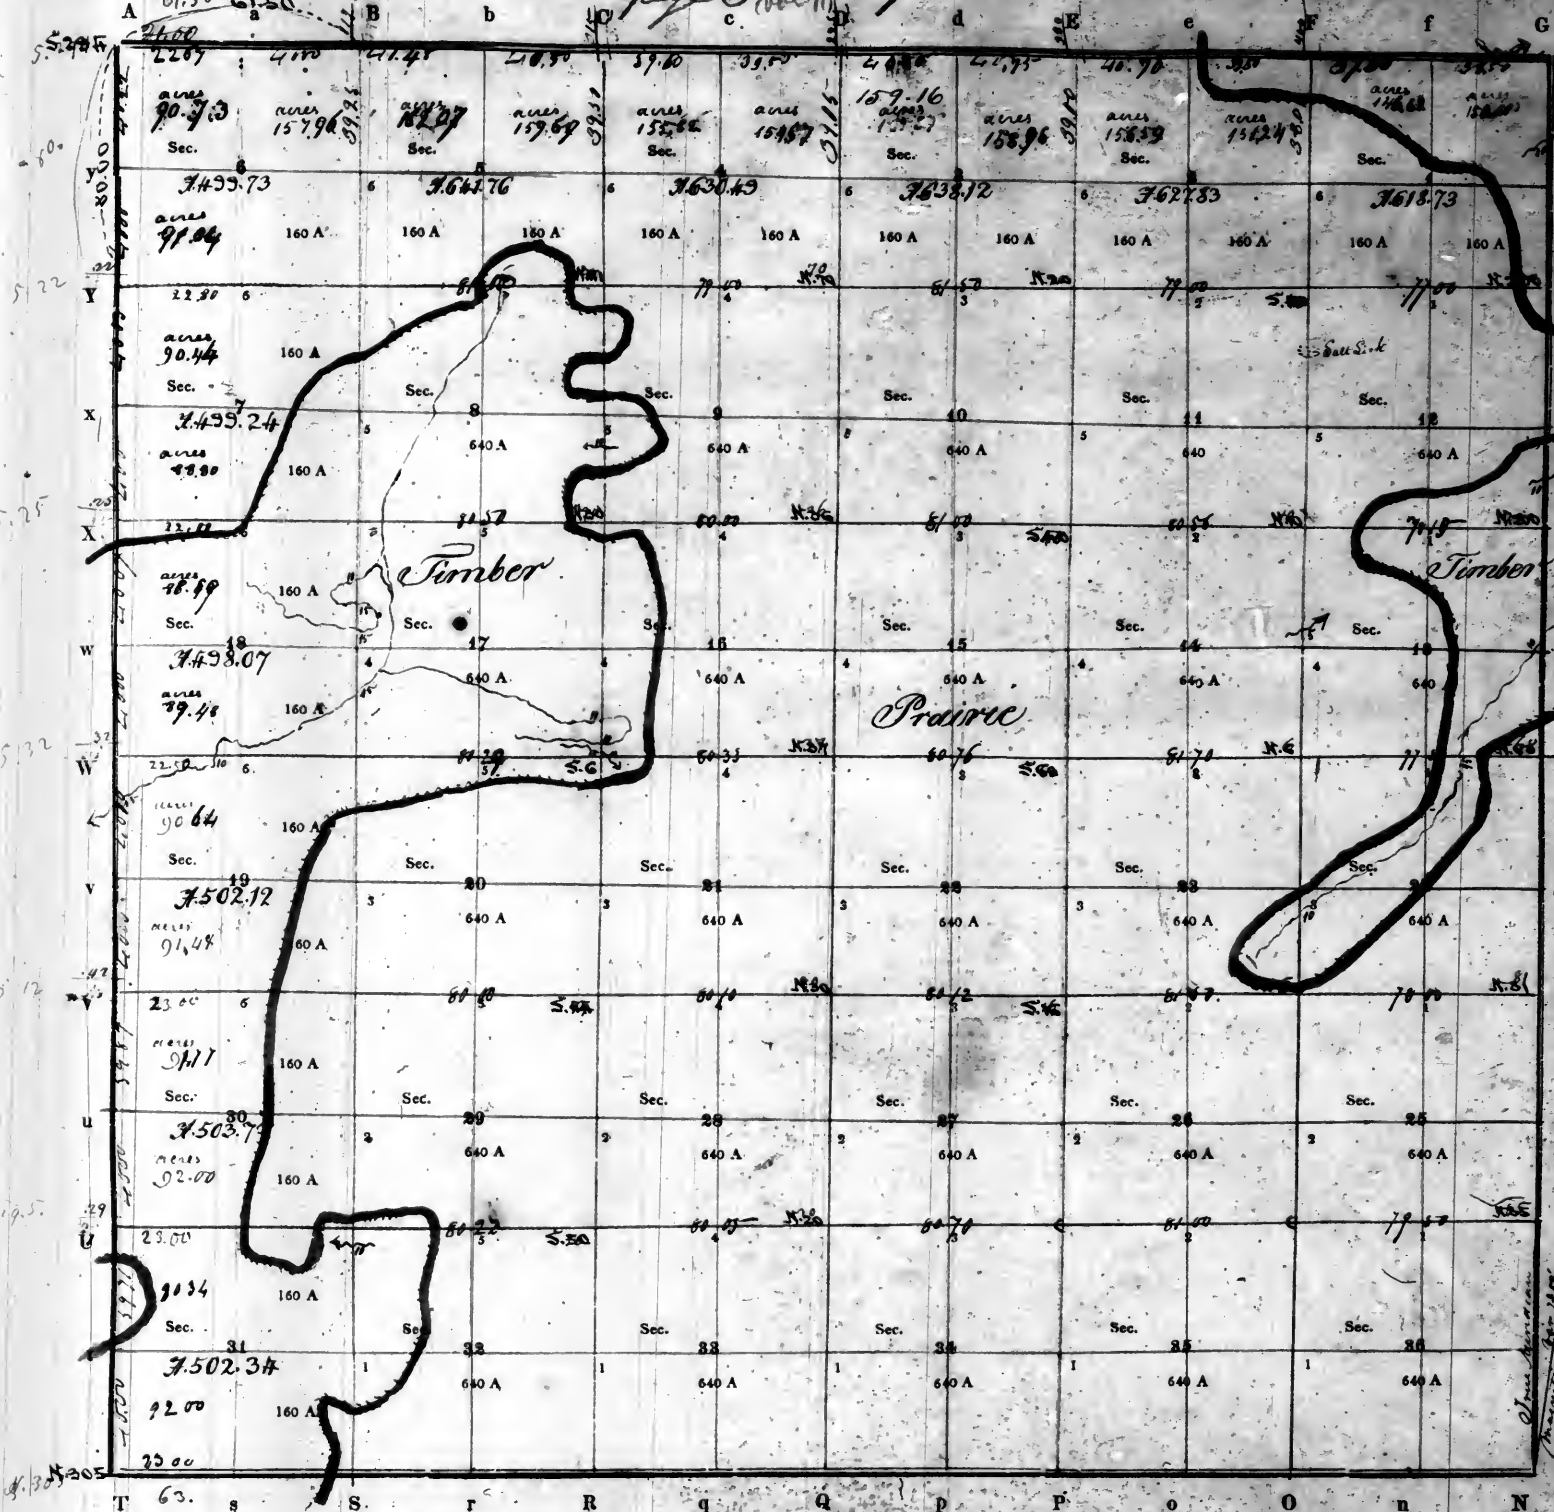


PURSUANT to a contract with, and instructions from WILLIAM RECTOR, Surveyor of the lands of the United States in the State of Illinois and Territories of Missouri and Arkansas bearing date the 18th day of May 1820

I have admeasured, laid out and surveyed the above described Township; and do hereby certify, that it had such marks and bounds, both natural and artificial, as are represented on said plat, and described in the field notes made thereof, and returned with this plat into the Office of the Surveyor of the lands of the United States, for the State of Illinois and Territories of Missouri and Arkansas

Certified this day of

Chas. Brent D. SURVEYOR

EXAMINED.

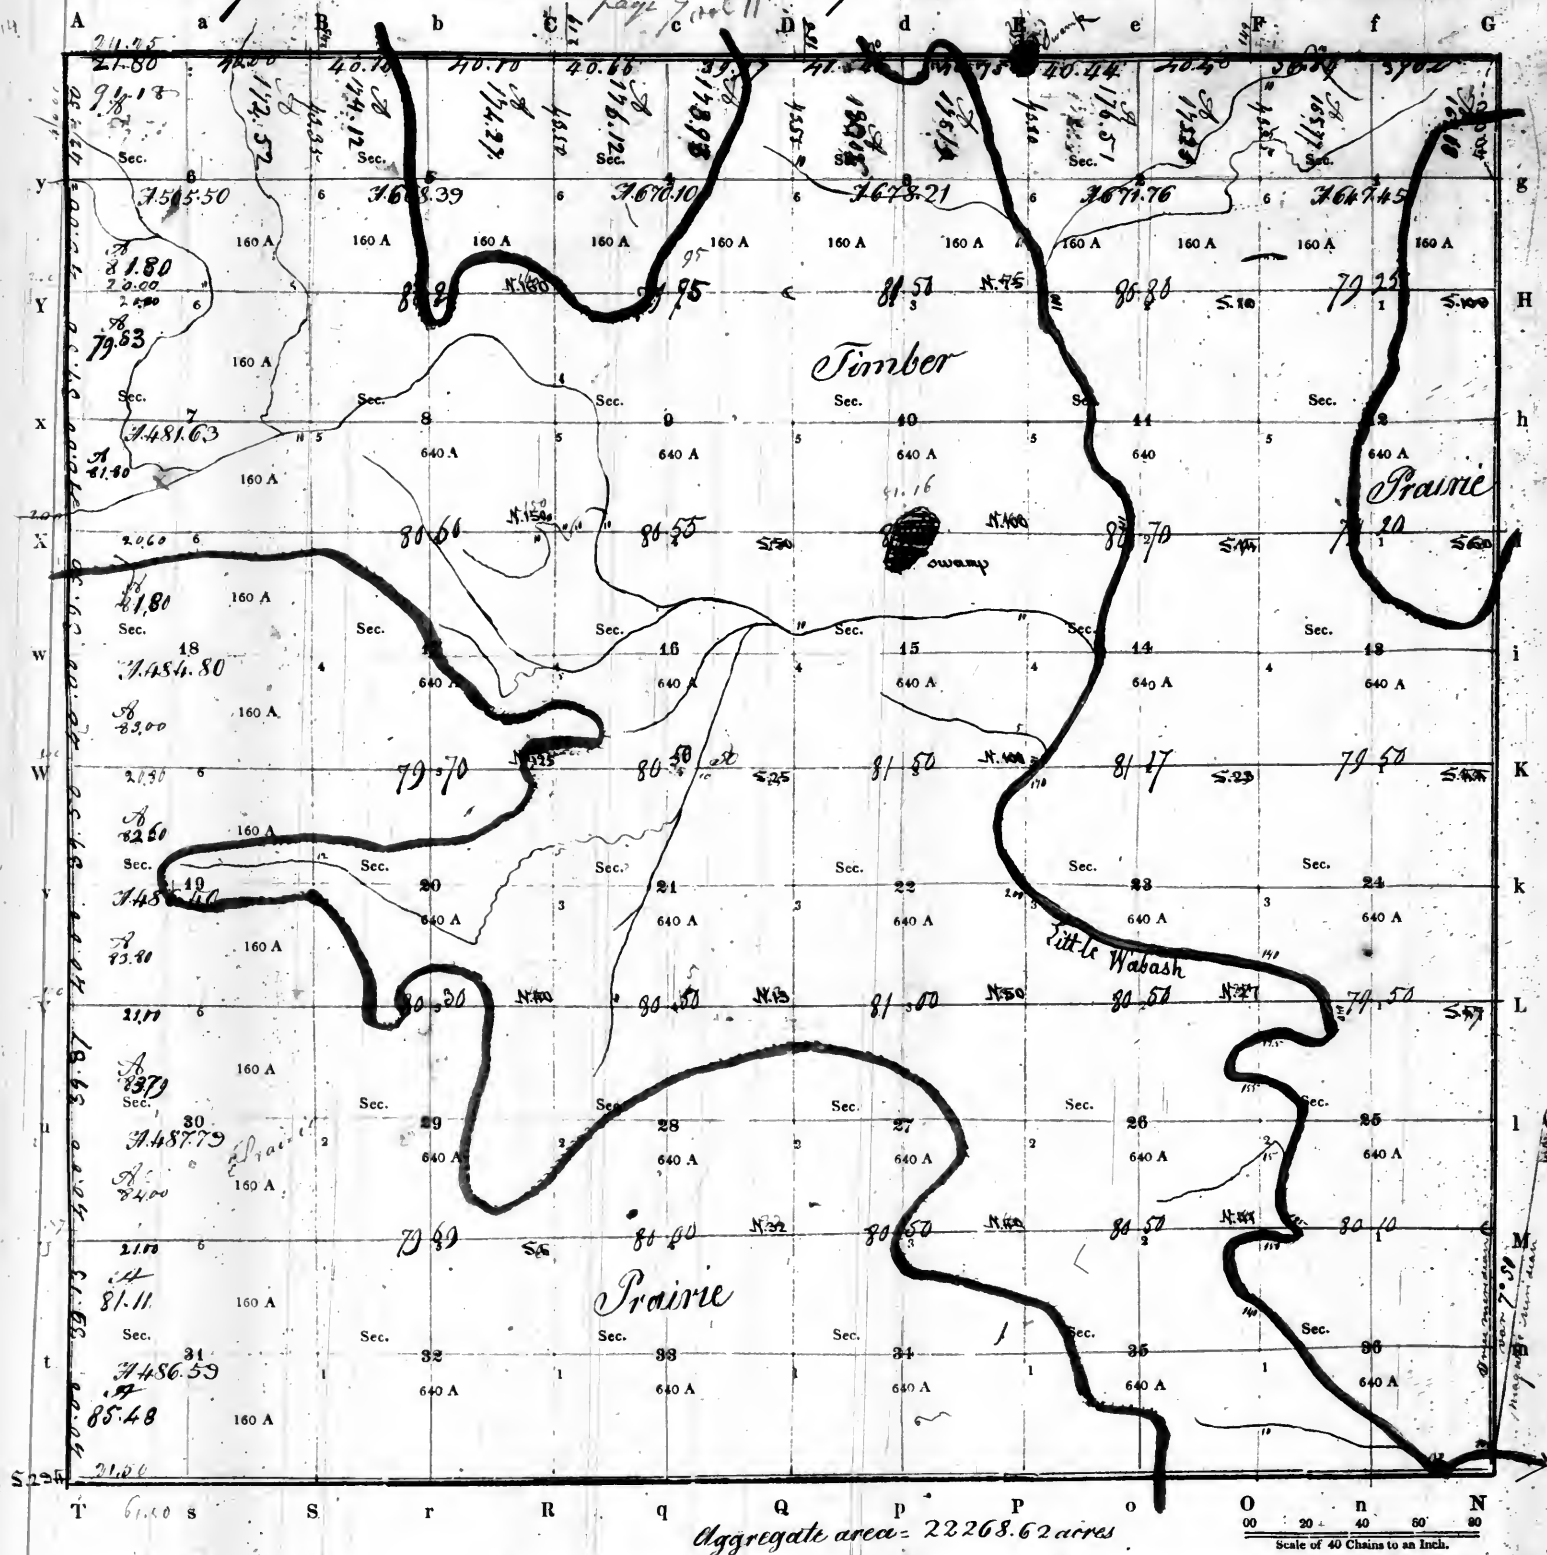


PURSUANT to a contract with, and instructions from WILLIAM RECTOR, Surveyor of the lands of the United States in the State of *Mississippi*
and Territories of *Missouri and Arkansas* bearing date the 18th day of *May* 1820

I have admeasured, laid out and surveyed the above described Township; and do hereby certify, that it had such marks and bounds, both natural and artificial, as are represented on said plat, and described in the field notes made thereof, and returned with this plat into the Office of the Surveyor of the lands of the United States, for the State of *Missouri and Territories of Missouri and Arkansas*

Certified this _____ day of _____

EXAMINED.

Chas. B. Bent D. SURVEYOR.

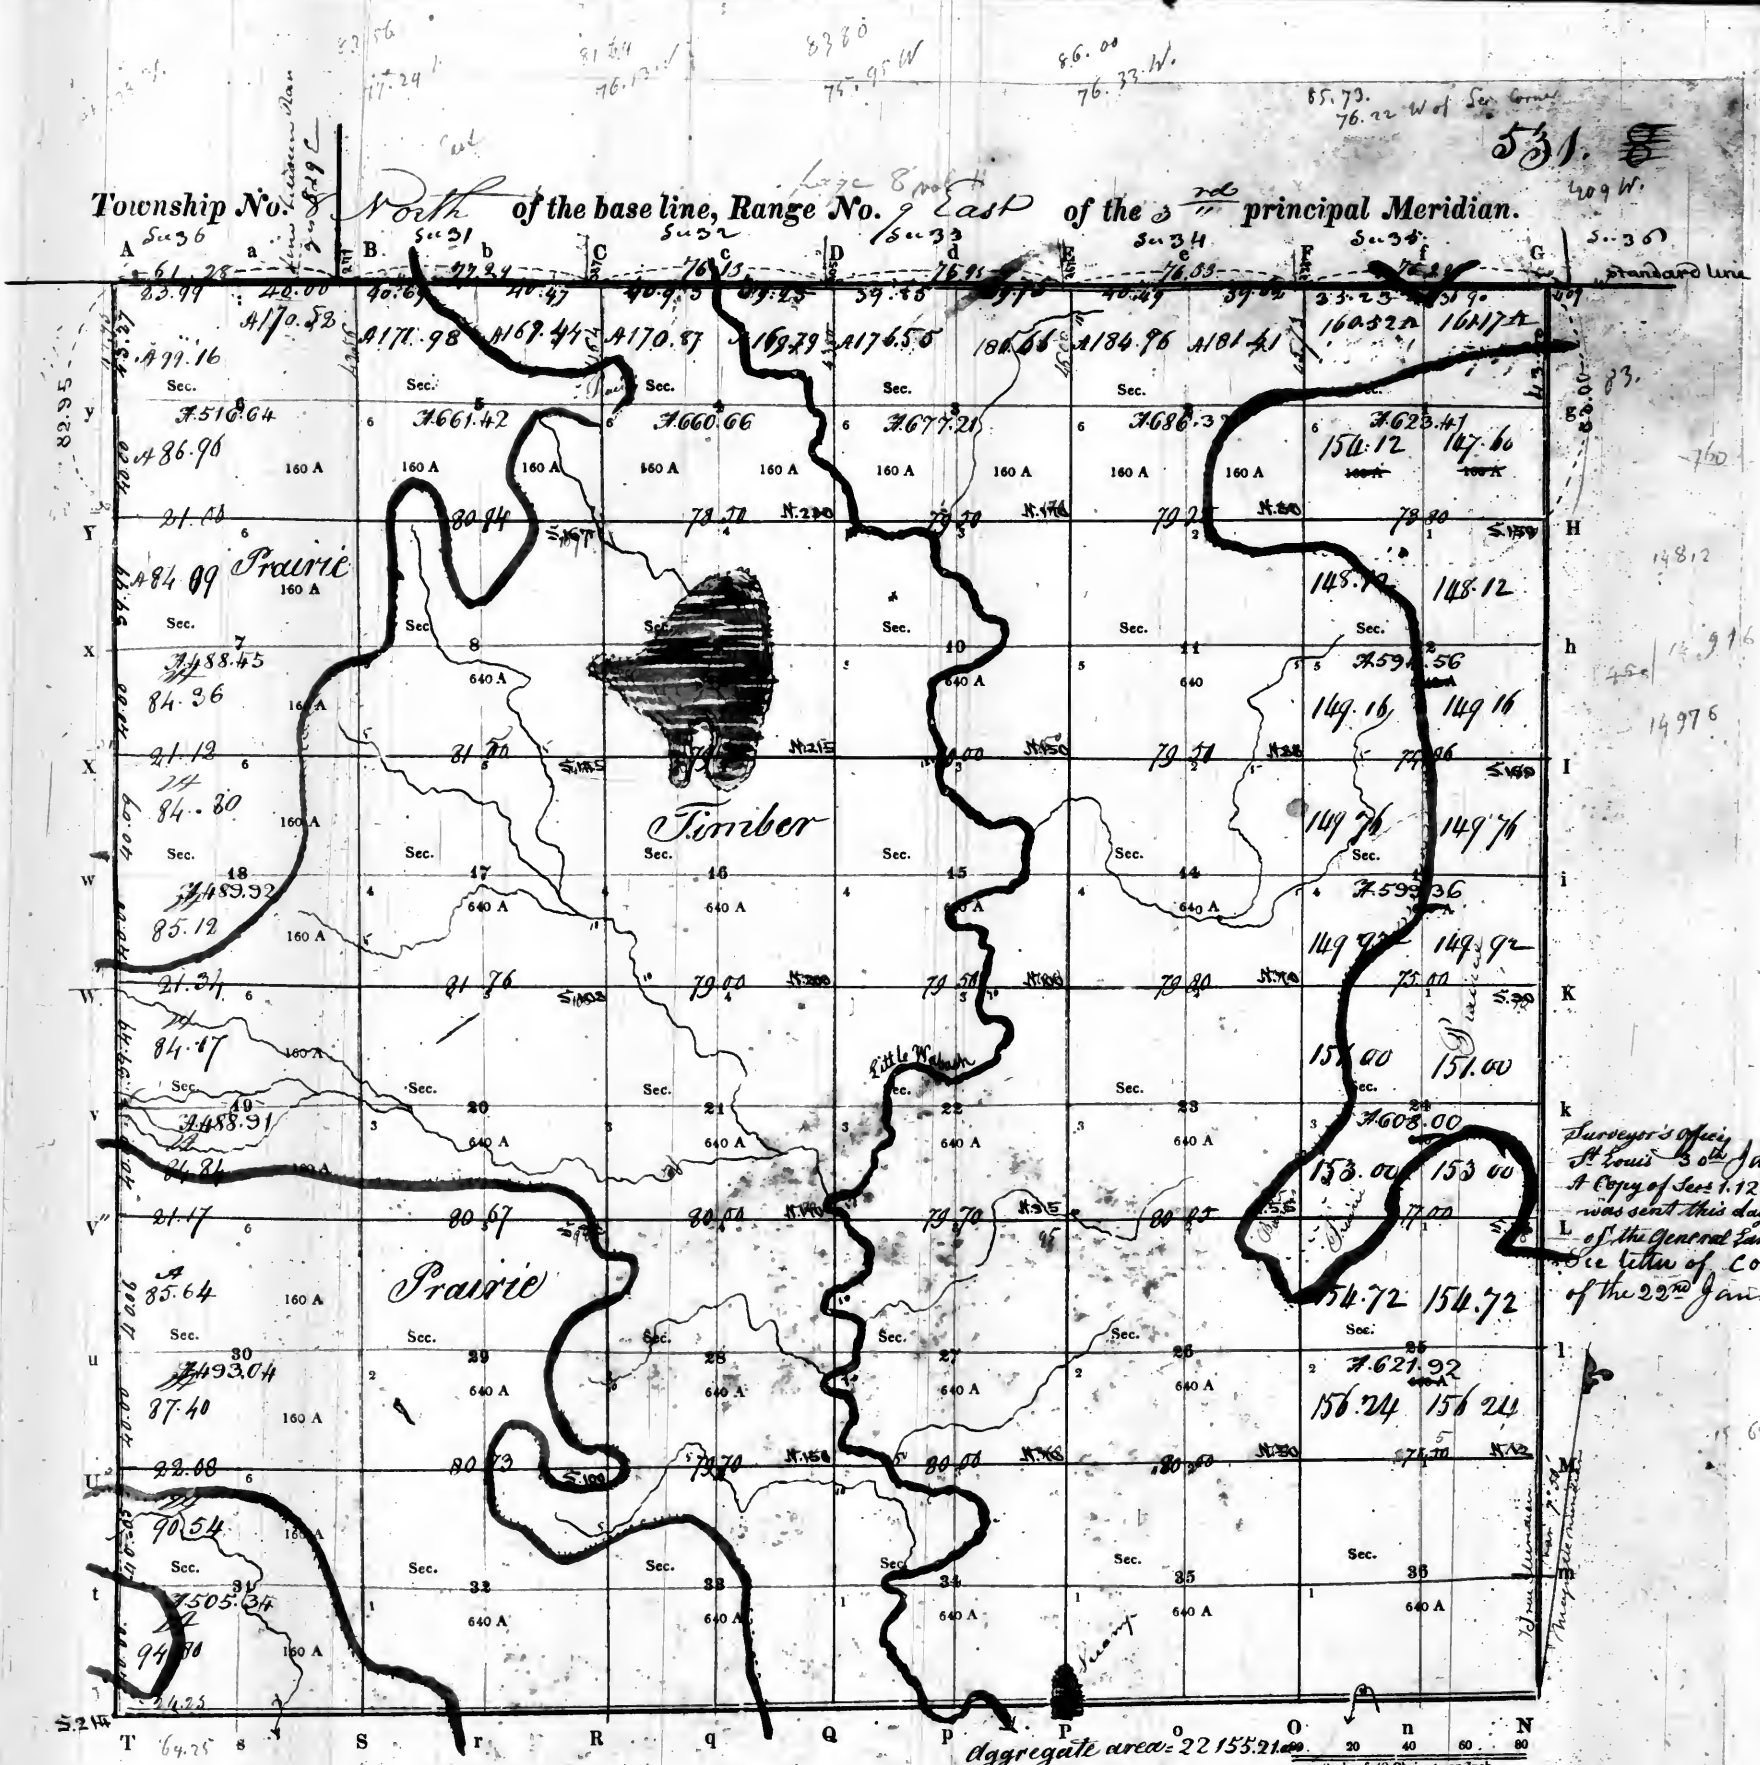

Surveyor's Office
St. Louis 30th Jan 1857
A copy of Secs 1, 12, 13, 24, 25 & 36
was sent this day to the Comptroller
of the General Land Office.
See letter of Commissioners

PURSUANT to a contract with, and instructions from WILLIAM RECTOR, Surveyor of the lands of the United States in the State of Illinois



Certified this day of

Chas Bent
D. SURVEYOR

EXAMINED.

Township No. 9 North of the base line, Range No. 9 East of the 3rd principal Meridian.

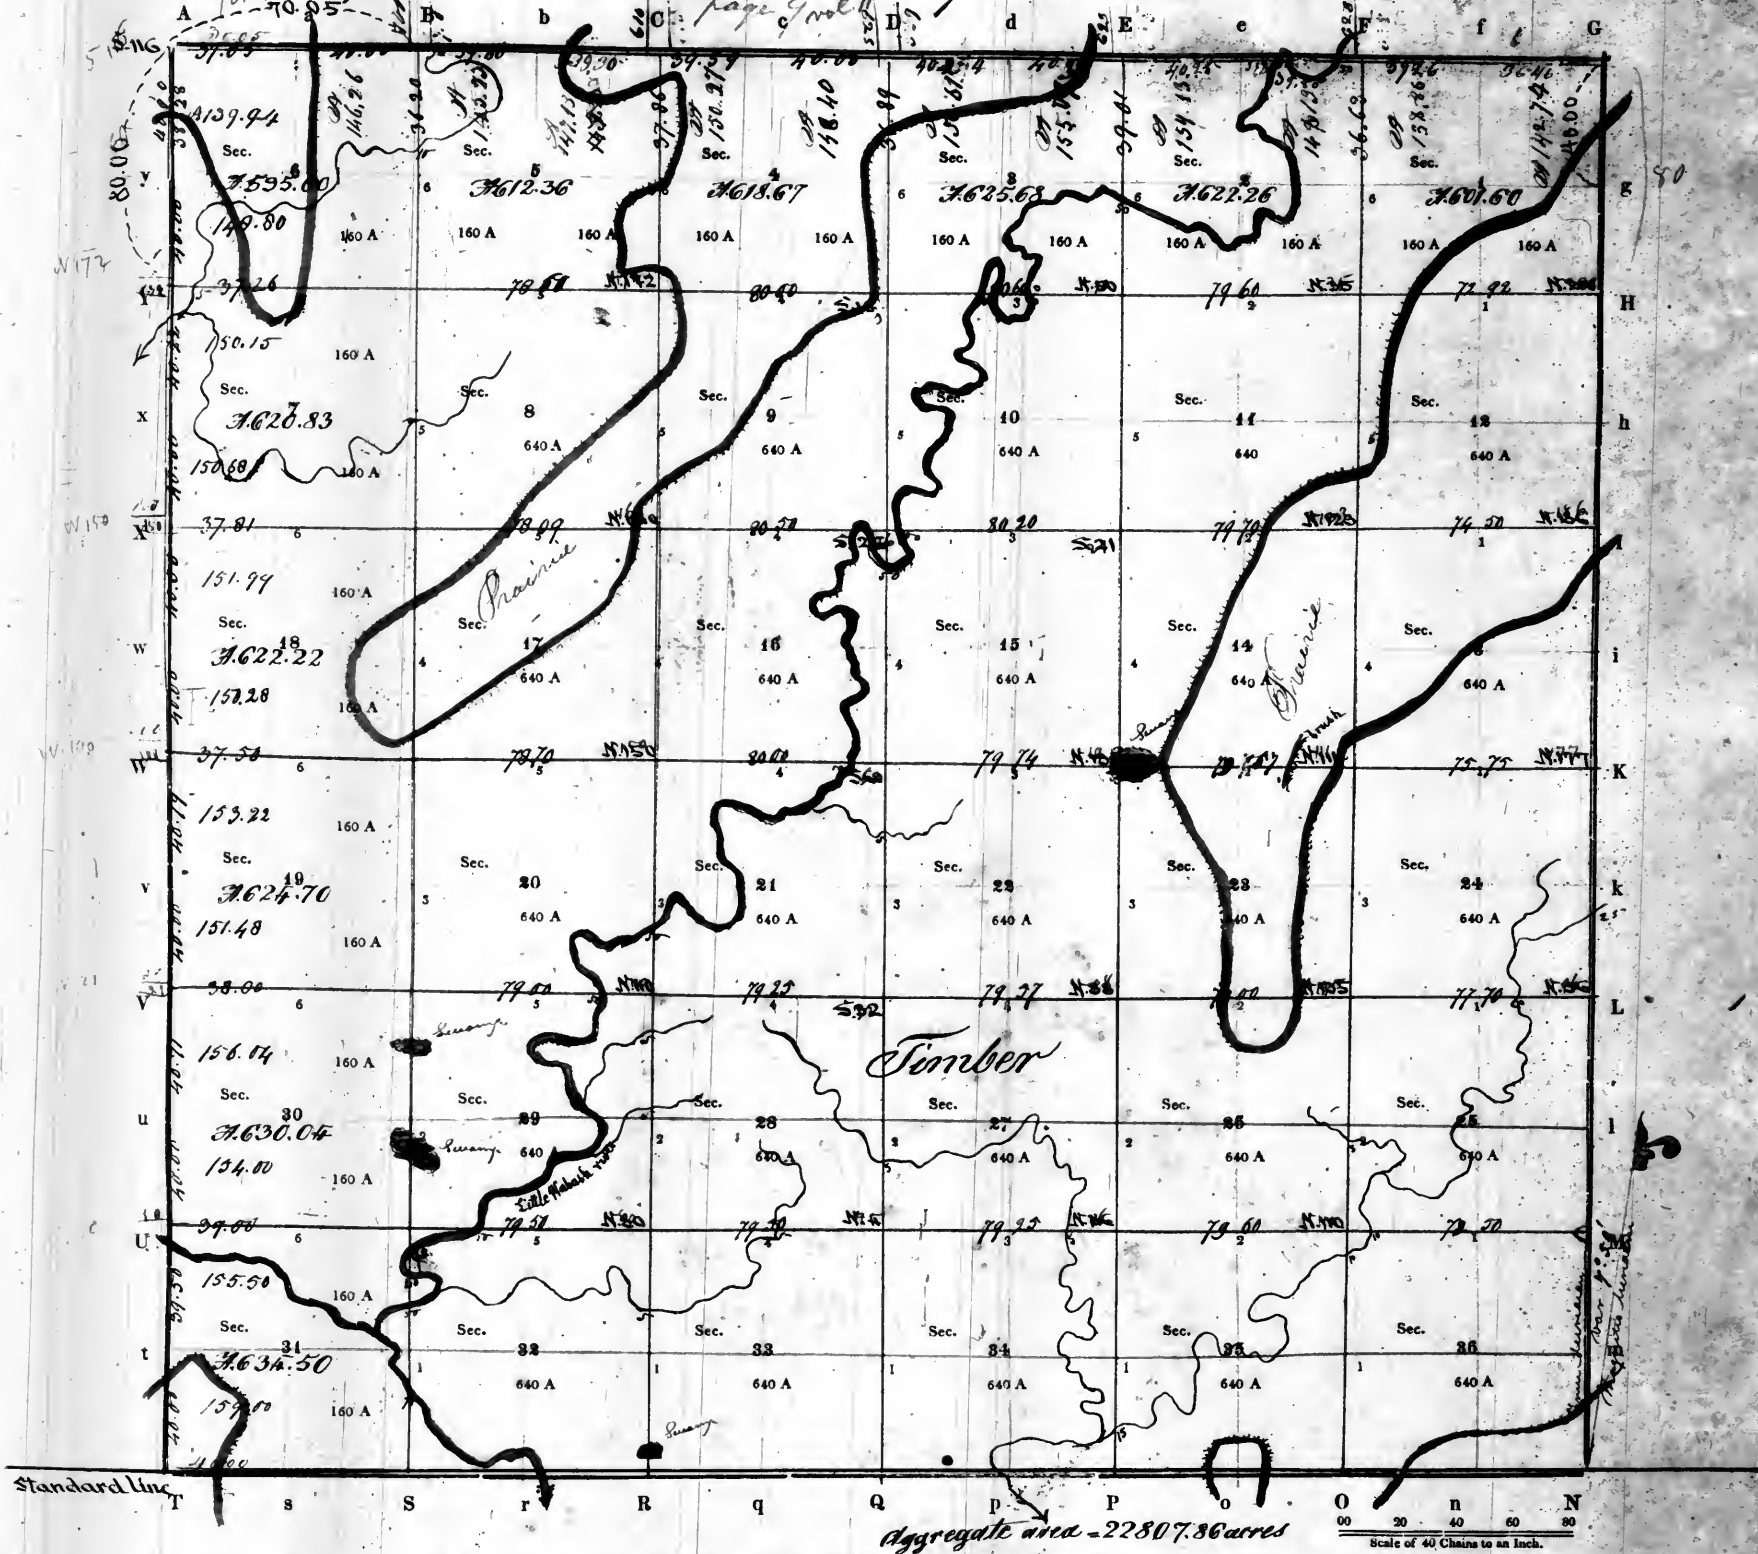

PURSUANT to a contract with, and instructions from WILLIAM RECTOR, Surveyor of the lands of the United States in the State of Illinois and Territories of Missouri and Arkansas - bearing date the - 15th day of May 1820

I have admeasured, laid out and surveyed the above described Township; and do hereby certify, that it had such marks and bounds, both natural and artificial, as are represented on said plat, and described in the field notes made thereof, and returned with this plat into the Office of the Surveyor of the lands of the United States, for the State of Illinois and Territories of Missouri and Arkansas.


Certified this day of

EXAMINED.

Chas. Bent D. SURVEYOR

Township No. 11 North of the base line, Range No. 9 East of the 3rd principal Meridian.

10

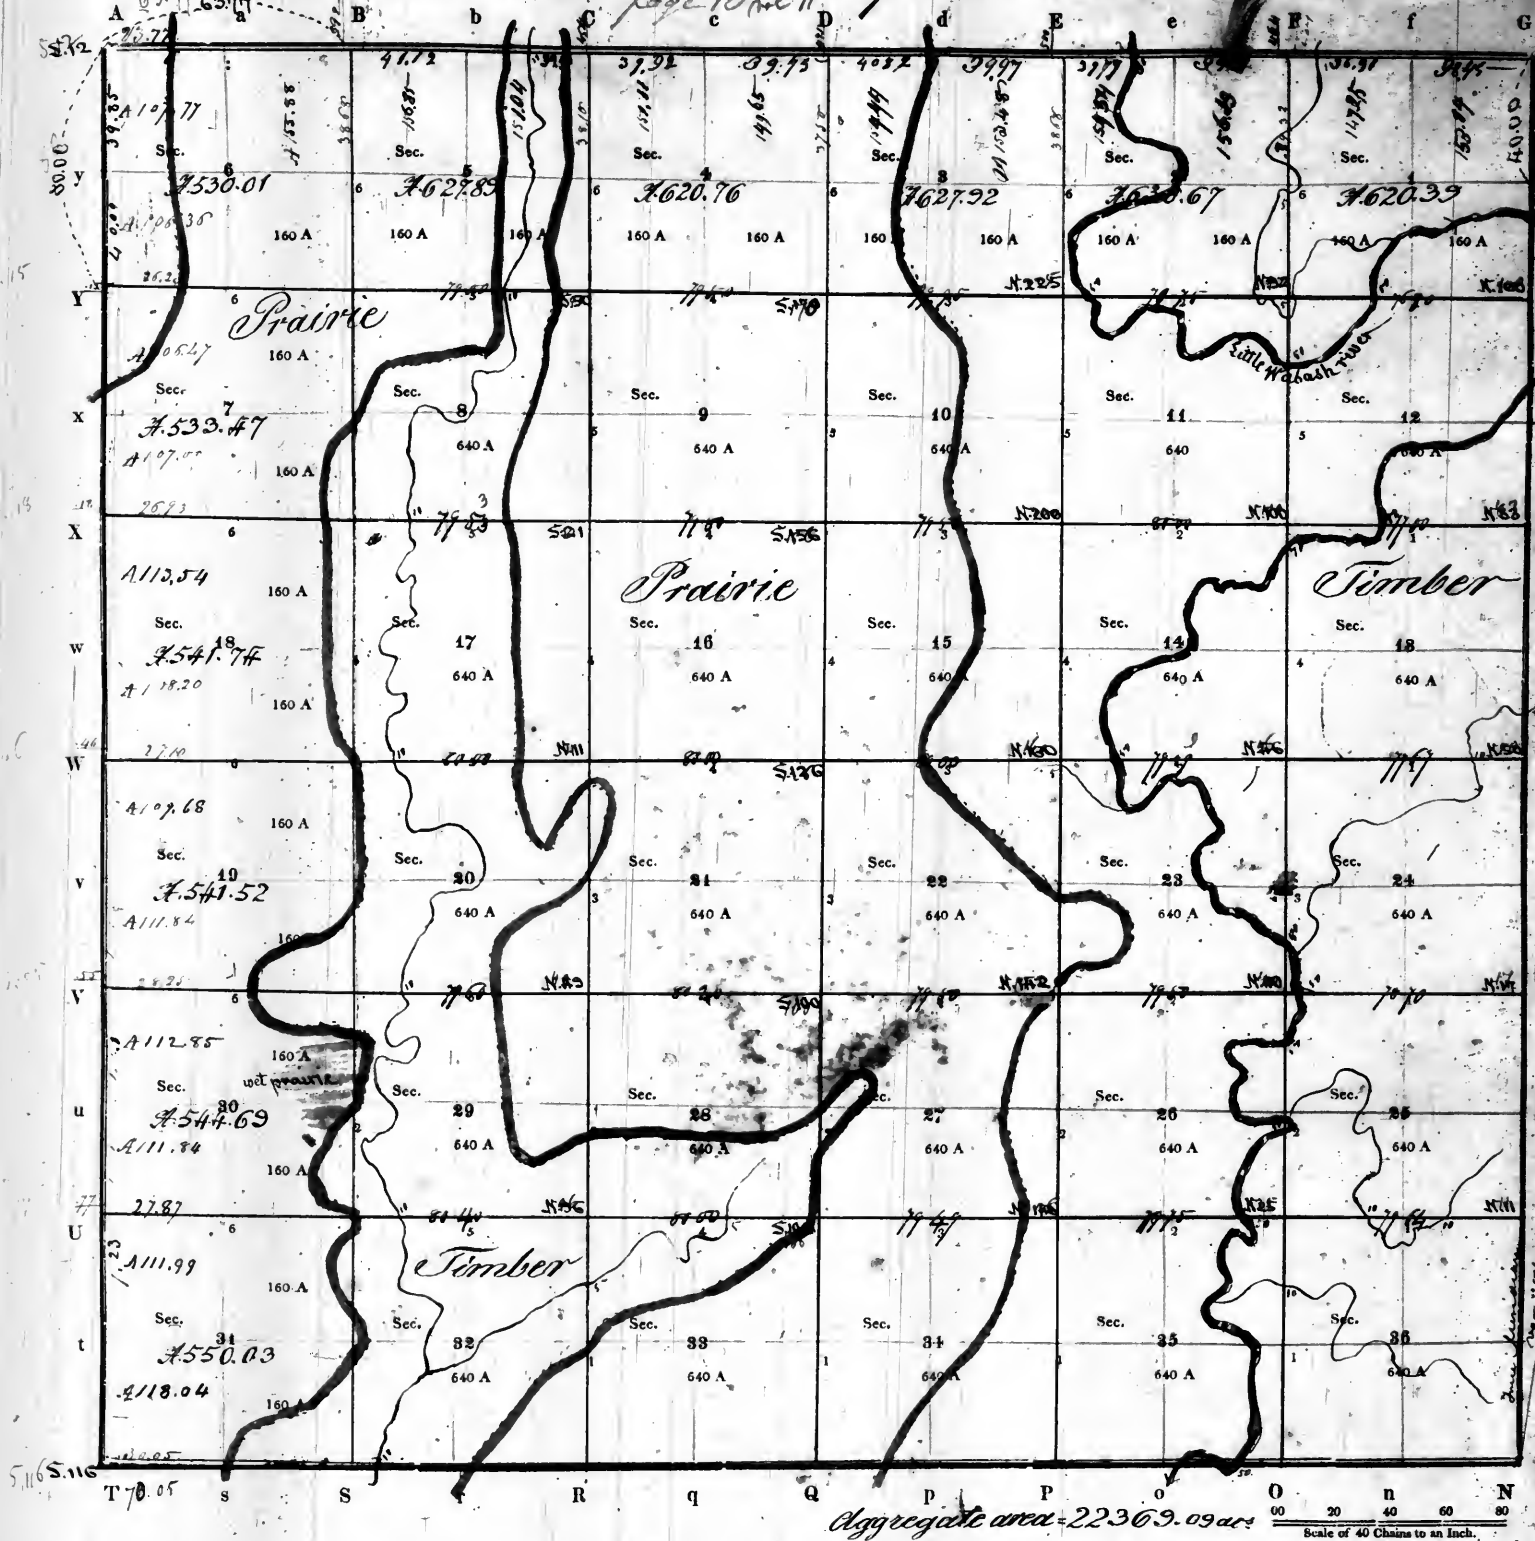

PURSUANT to a contract with, and instructions from WILLIAM RECTOR, Surveyor of the lands of the United States in the State of Illinois and Territory of Missouri and Arkansas bearing date the 18th day of May 1820

I have admeasured, laid out and surveyed the above described Township; and do hereby certify, that it had such marks and bounds, both natural and artificial, as are represented on said plat, and described in the field notes made thereof, and returned with this plat into the Office of the Surveyor of the lands of the United States, for the State of Illinois and Territory of Missouri and Arkansas


Certified this day of

EXAMINED.

Wm. Bent D. SURVEYOR.

534

Township No. 11 North of the base line, Range No. 9 East of the 3rd principal Meridian

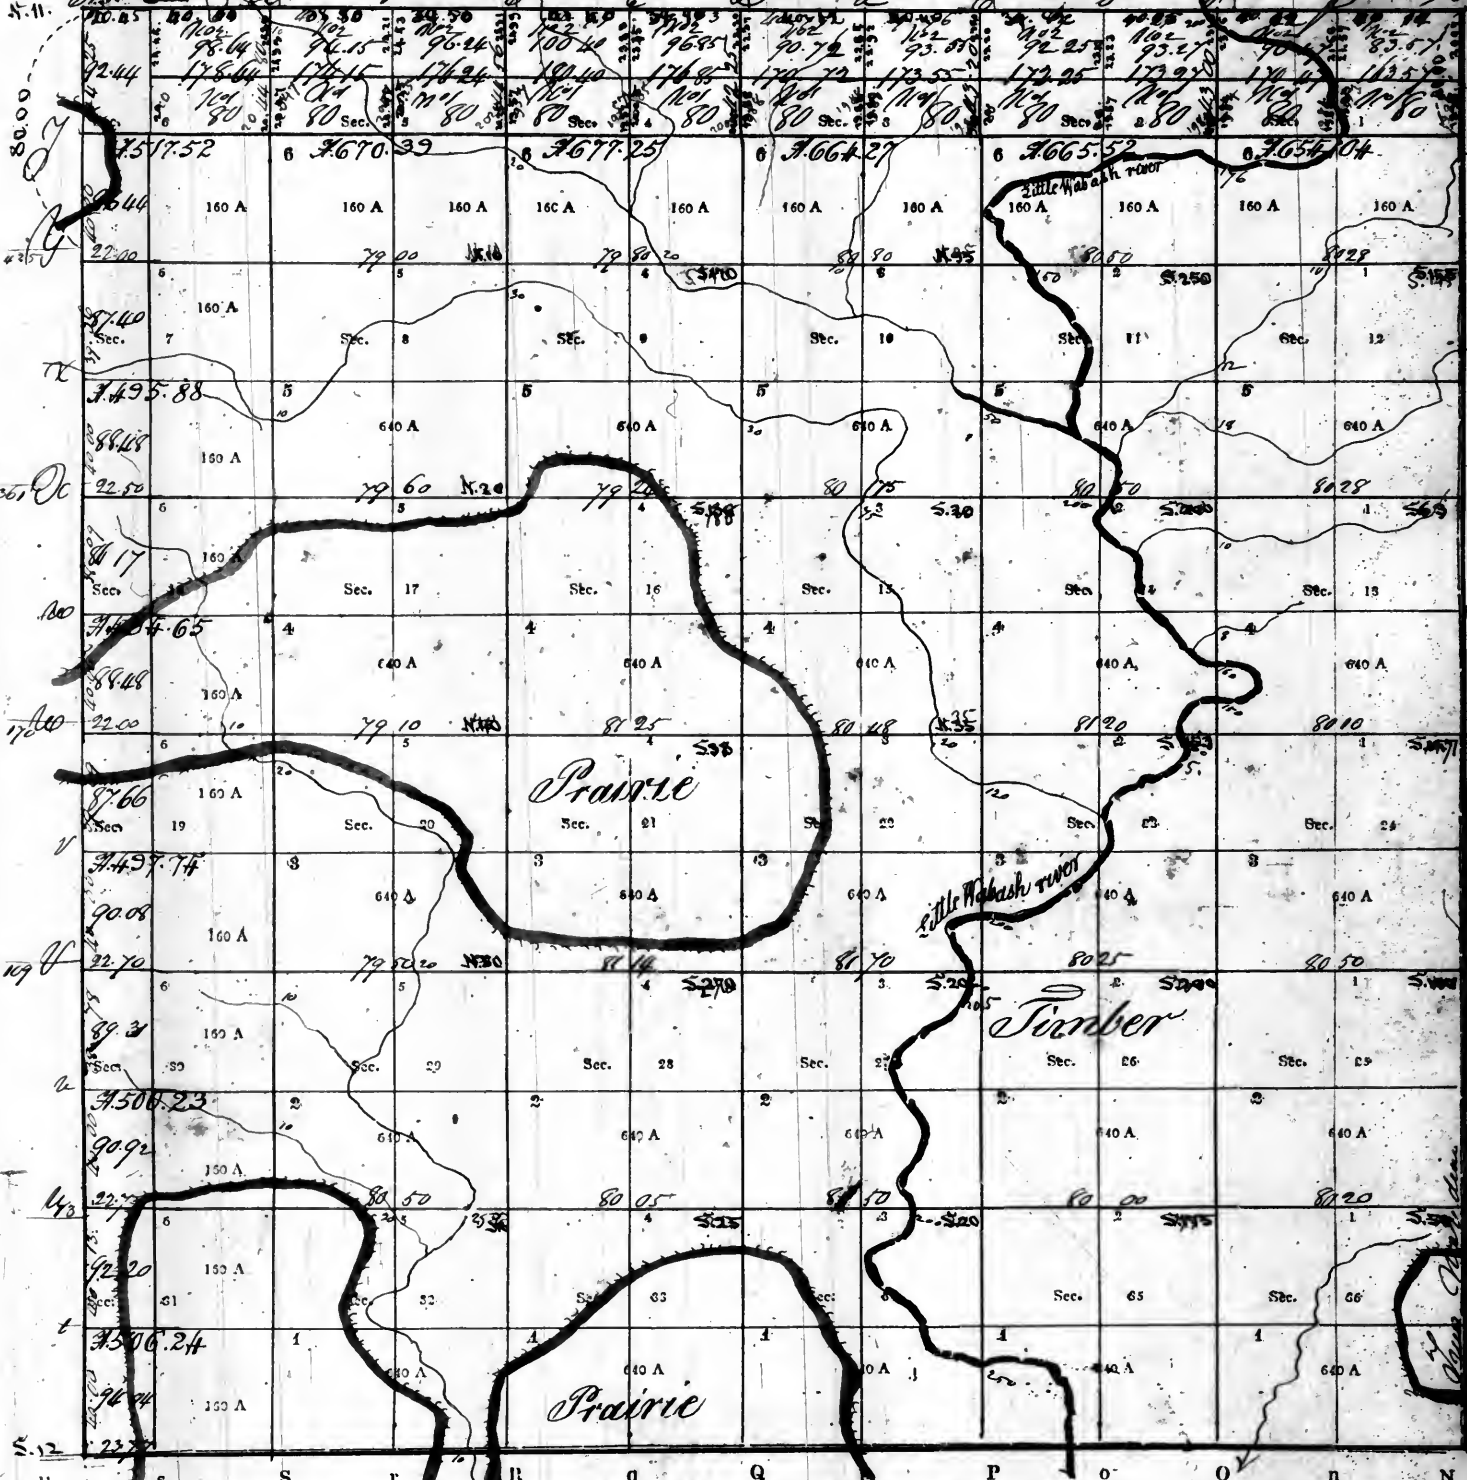

aggregate area = 22343.73 acres

PURSUANT to a contract with, and instructions from William Rector, Surveyor of the lands of the United States in the State of Missouri and Secretary of Arkansas, bearing date the 12th day of April 1881, I have measured, laid out and surveyed the above described Township; and do hereby certify, that it had such marks and bounds, both natural and artificial, as are represented on said plat, and described in the field notes made thereof and returned with this plat into the Office of the Surveyor of the Lands of the United States, in the State of Missouri and Secretary of Arkansas.


Certified this 18th day of April 1881 D. SURVEYOR.

EXAMINED.

Surveyor's Office
St. Louis, Mo. July 1842.
Plat of the North halves
of Sects 1, 2, 3, 4, 5 & 6 of the
S.E. 1/4 of Sec. 6, sent this day
to the Commr of the Genl.
Land Office.

John C. Rector

Township 12 North of the Base Line Range No 9 East of the 3^d Principal Meridian

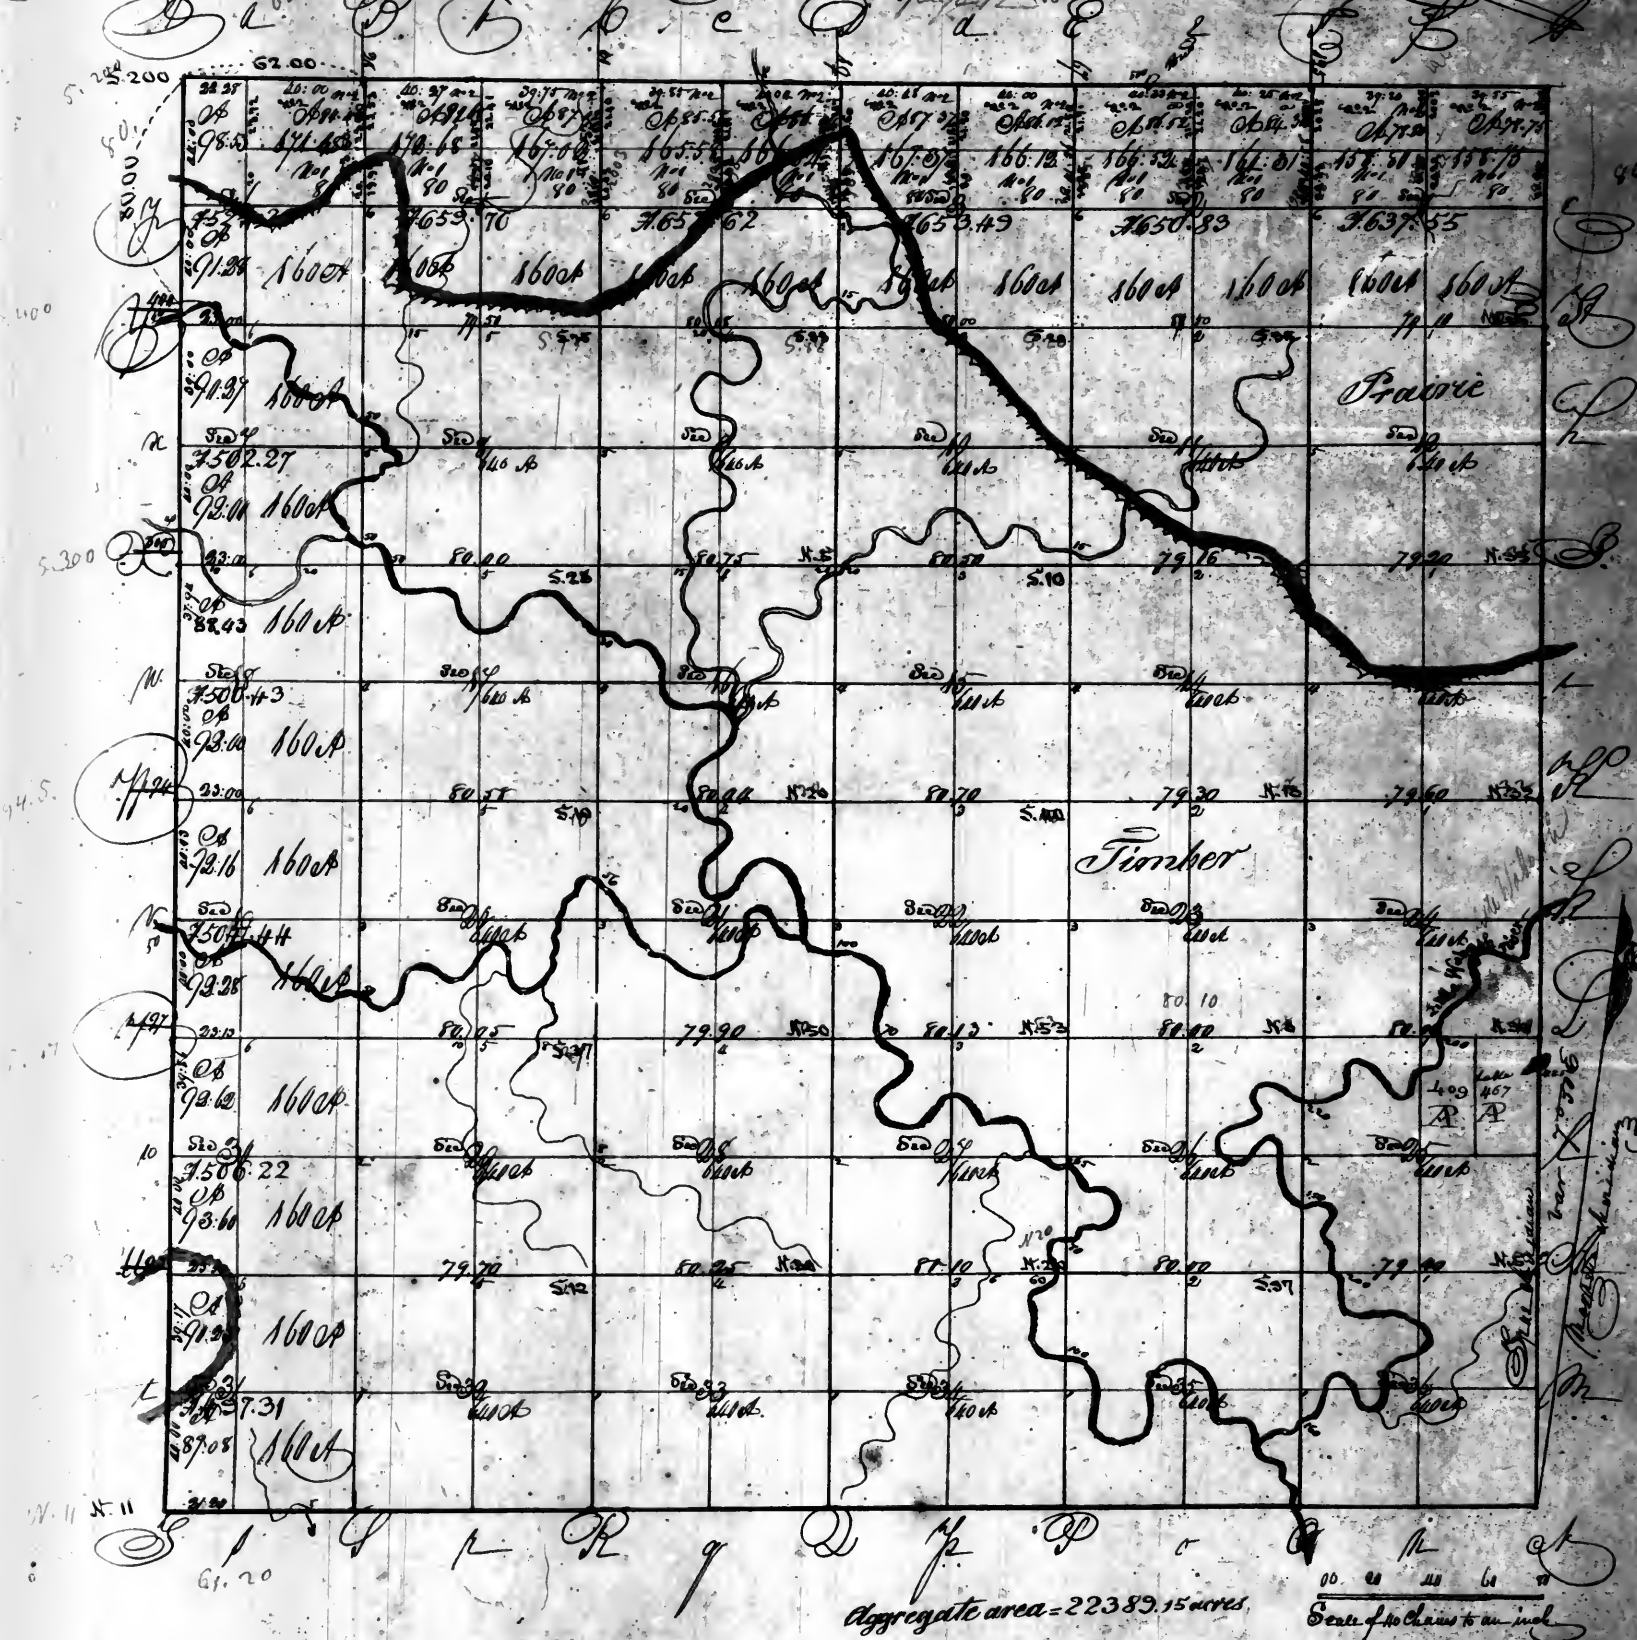


Surveyor's Office
St. Louis 10th May 1842.
Plat of the North halves
of Sects 1, 2, 3, 4, 5 & 6
of the R. 9th East of Sect. 6 sent
this day to the Comr of
the Genl Land Office.

Pursuant to a contract with and Instructions from Wm. Hector, Surveyor of the Lands of the United States in the States of Missouri and Wisconsin and Territory of Arkansas bearing date the 9th day of March 1841 I have admeasured laid out and surveyed the above described Township and do hereby certify that it has such marks and bounds both natural and artificial as are represented on the plat and described in the field notes made thereof and returned with this plat into the Office of the Surveyor of the Lands of the United States for the States of Missouri and Wisconsin and Territory of Arkansas.

Certified this 21st day of November in the year of Christ 1841 by Wm. May 83

Township N-13 North of the Base Line Range N-9 East of the 3rd Principal Meridian


Page 13 of 11

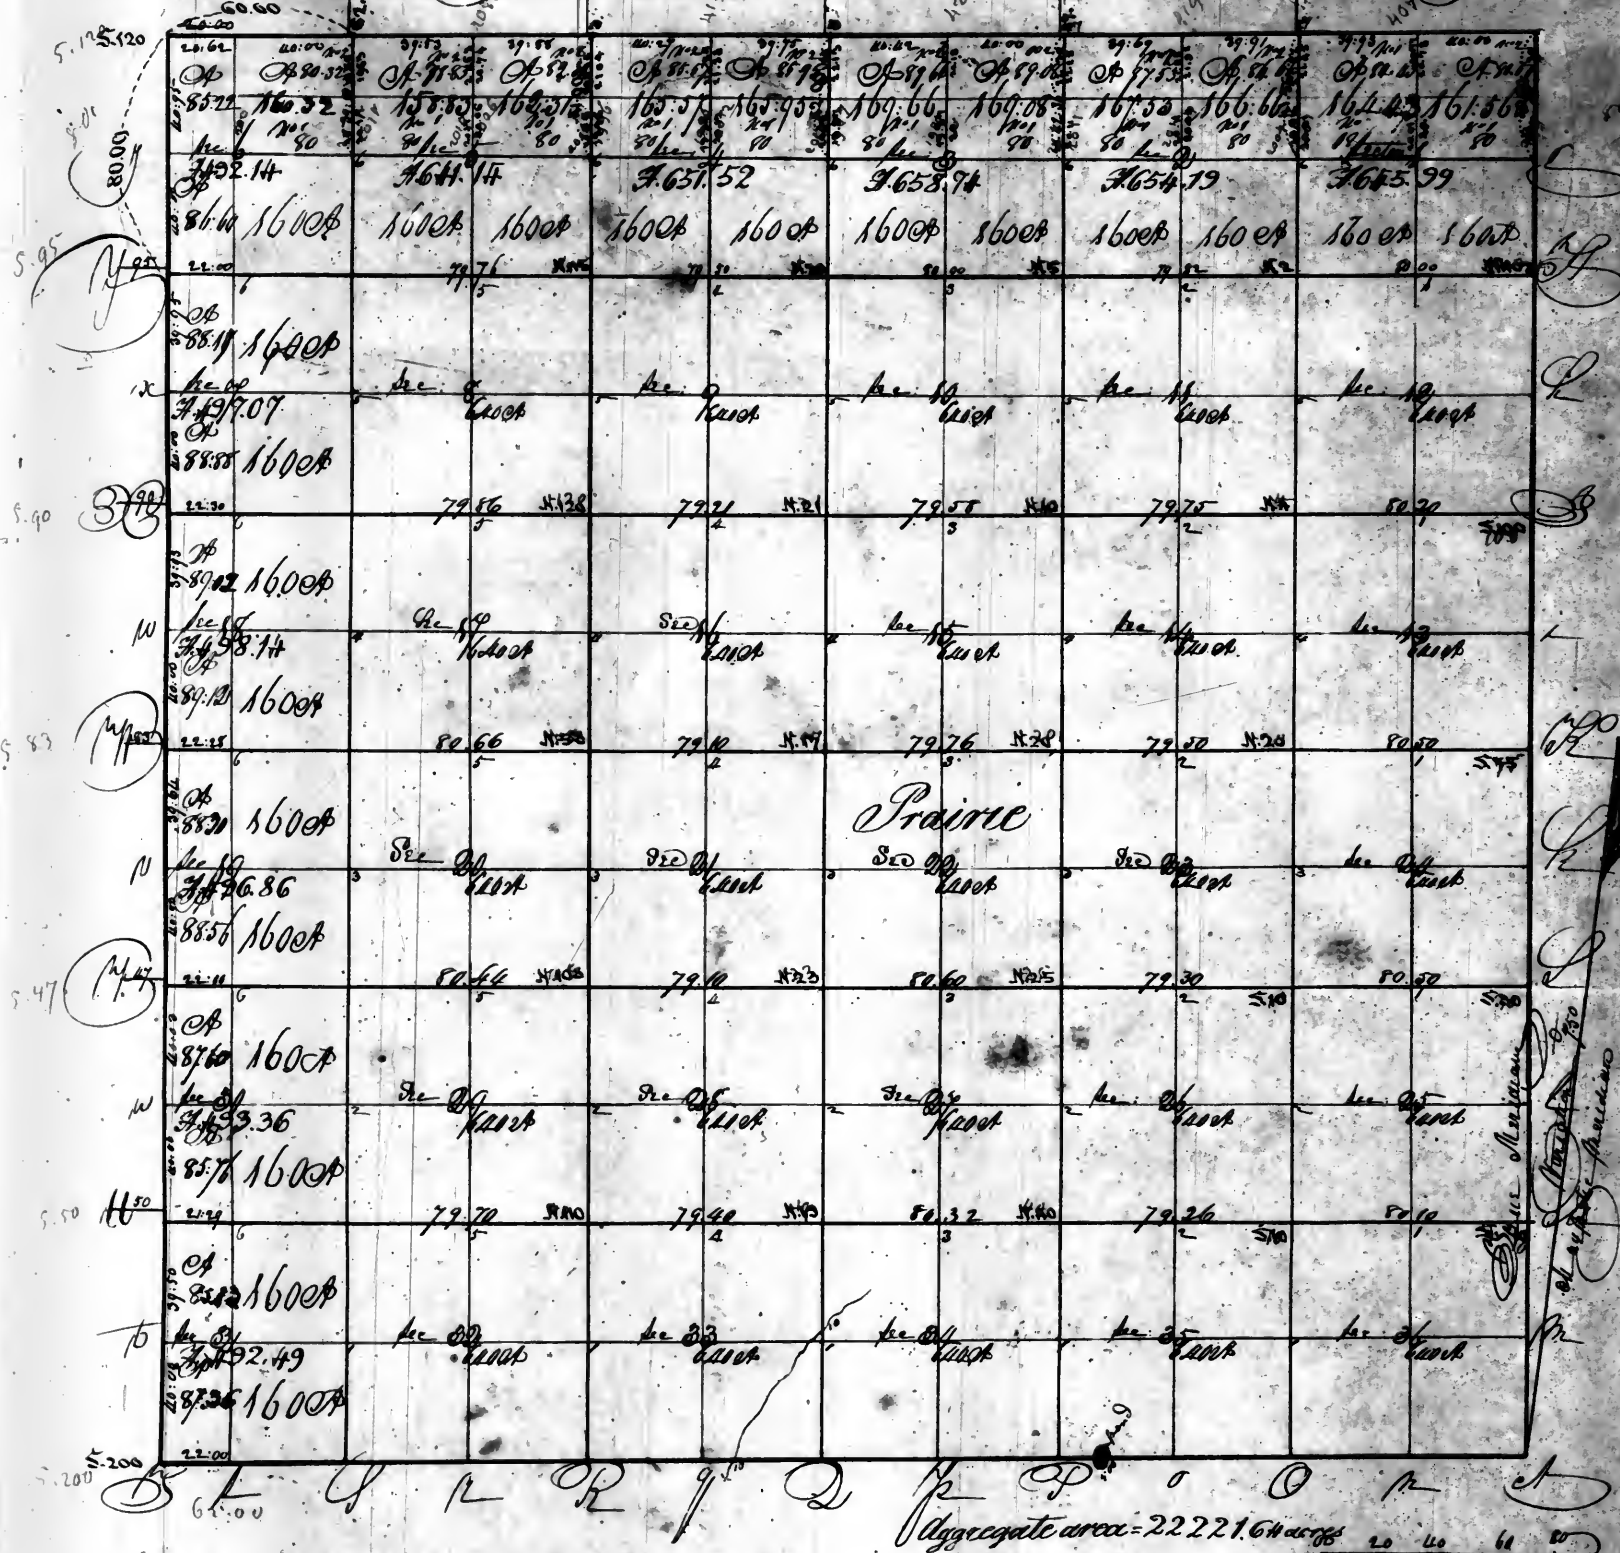

Office of the Surveyor of the Lands of the United States for the

William L. Chapin
Surveyor


Township No. 14 North of the Base Line Range No. 9 East of the 3rd Principal Meridian
 page 44 vol 11
 79.00 50W 79.00 20W 78.00 18W 79.66 3W 537

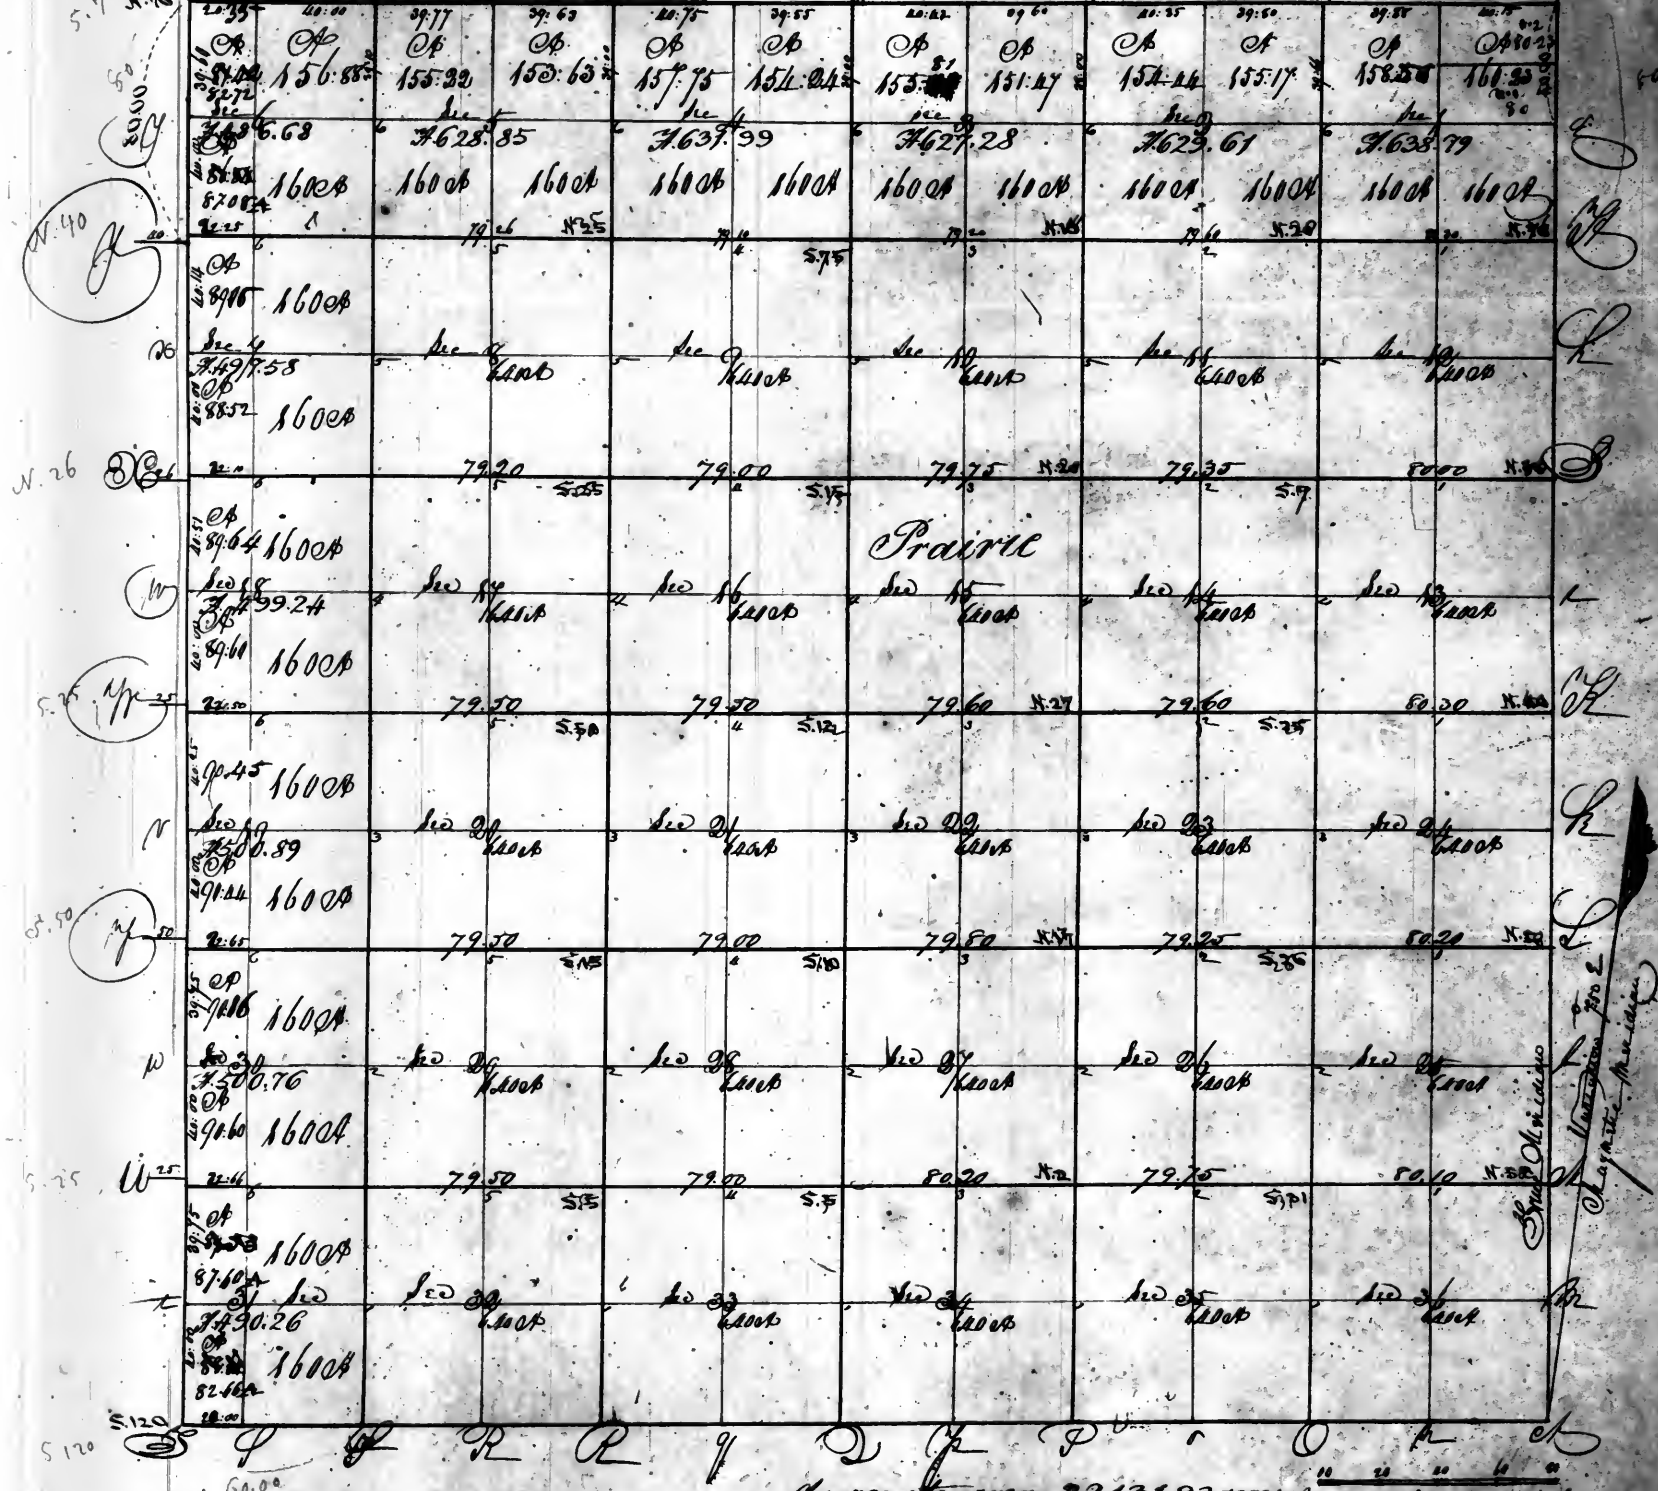


Aggregate area - 22131.93 acres

Pursuant to a Contract with and instructions from William Rector Surveyor of the Lands of the United States in the State of Illinois and Territory of Arkansas bearing date 11th day of March 1825
 I have administered said survey the above described Township and do hereby certify that it has such marks as found both natural and artificial as are represented on said plat and described in the said plat and brief returned with the plat into the Office of the Surveyor of the Lands of the United States in the
 Certified this 20th day of November 1825
 William C. May

Section 15 North of the Pine Line Range No 9 East of the 3rd Principal Meridian
Page 13 of 11
130.00 65.78 65.71 W 132.7 133.70 338.0

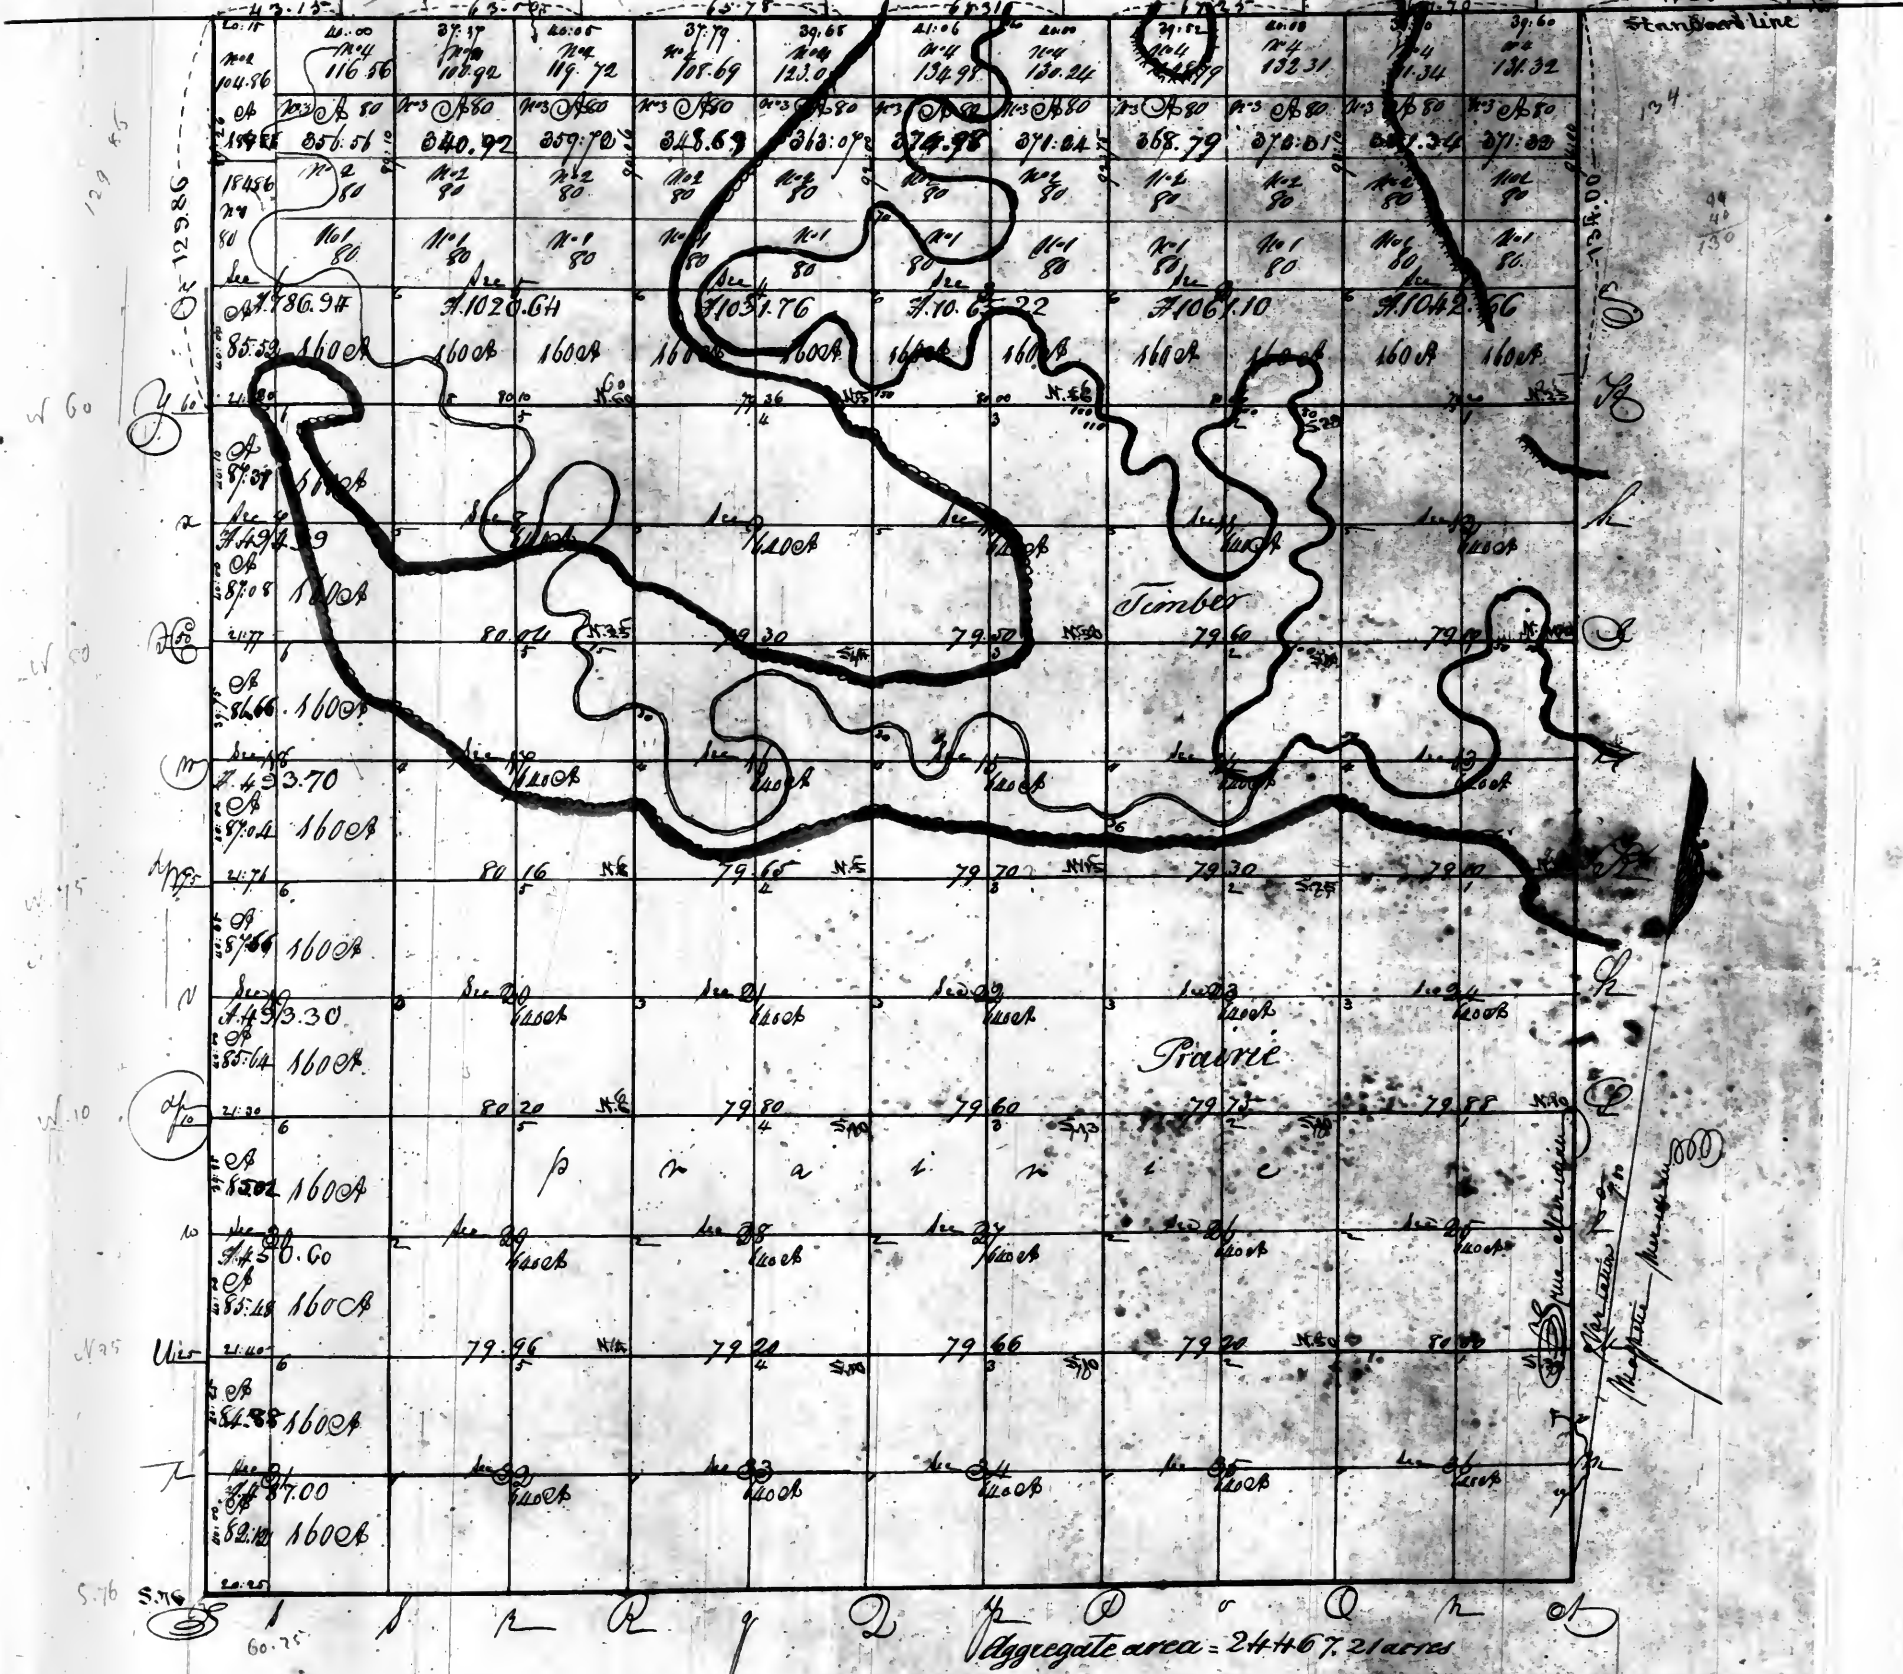


Pursuant to a contract with and instructions from William Reitor Surveyor of the Land of the United States in the State of Illinois and Missouri Territory of Arkansas — having done the Month day of March 1821
I have measured laid out and surveyed the above described Township and do hereby certify that it has been marked and bounded both natural and artificial as are represented on said plat and describe in the State those marks thereof and return with this plat into the office of the Surveyor of the Land of the United States for the Territory this 21st day of March 1821
William L. May
Surveyor

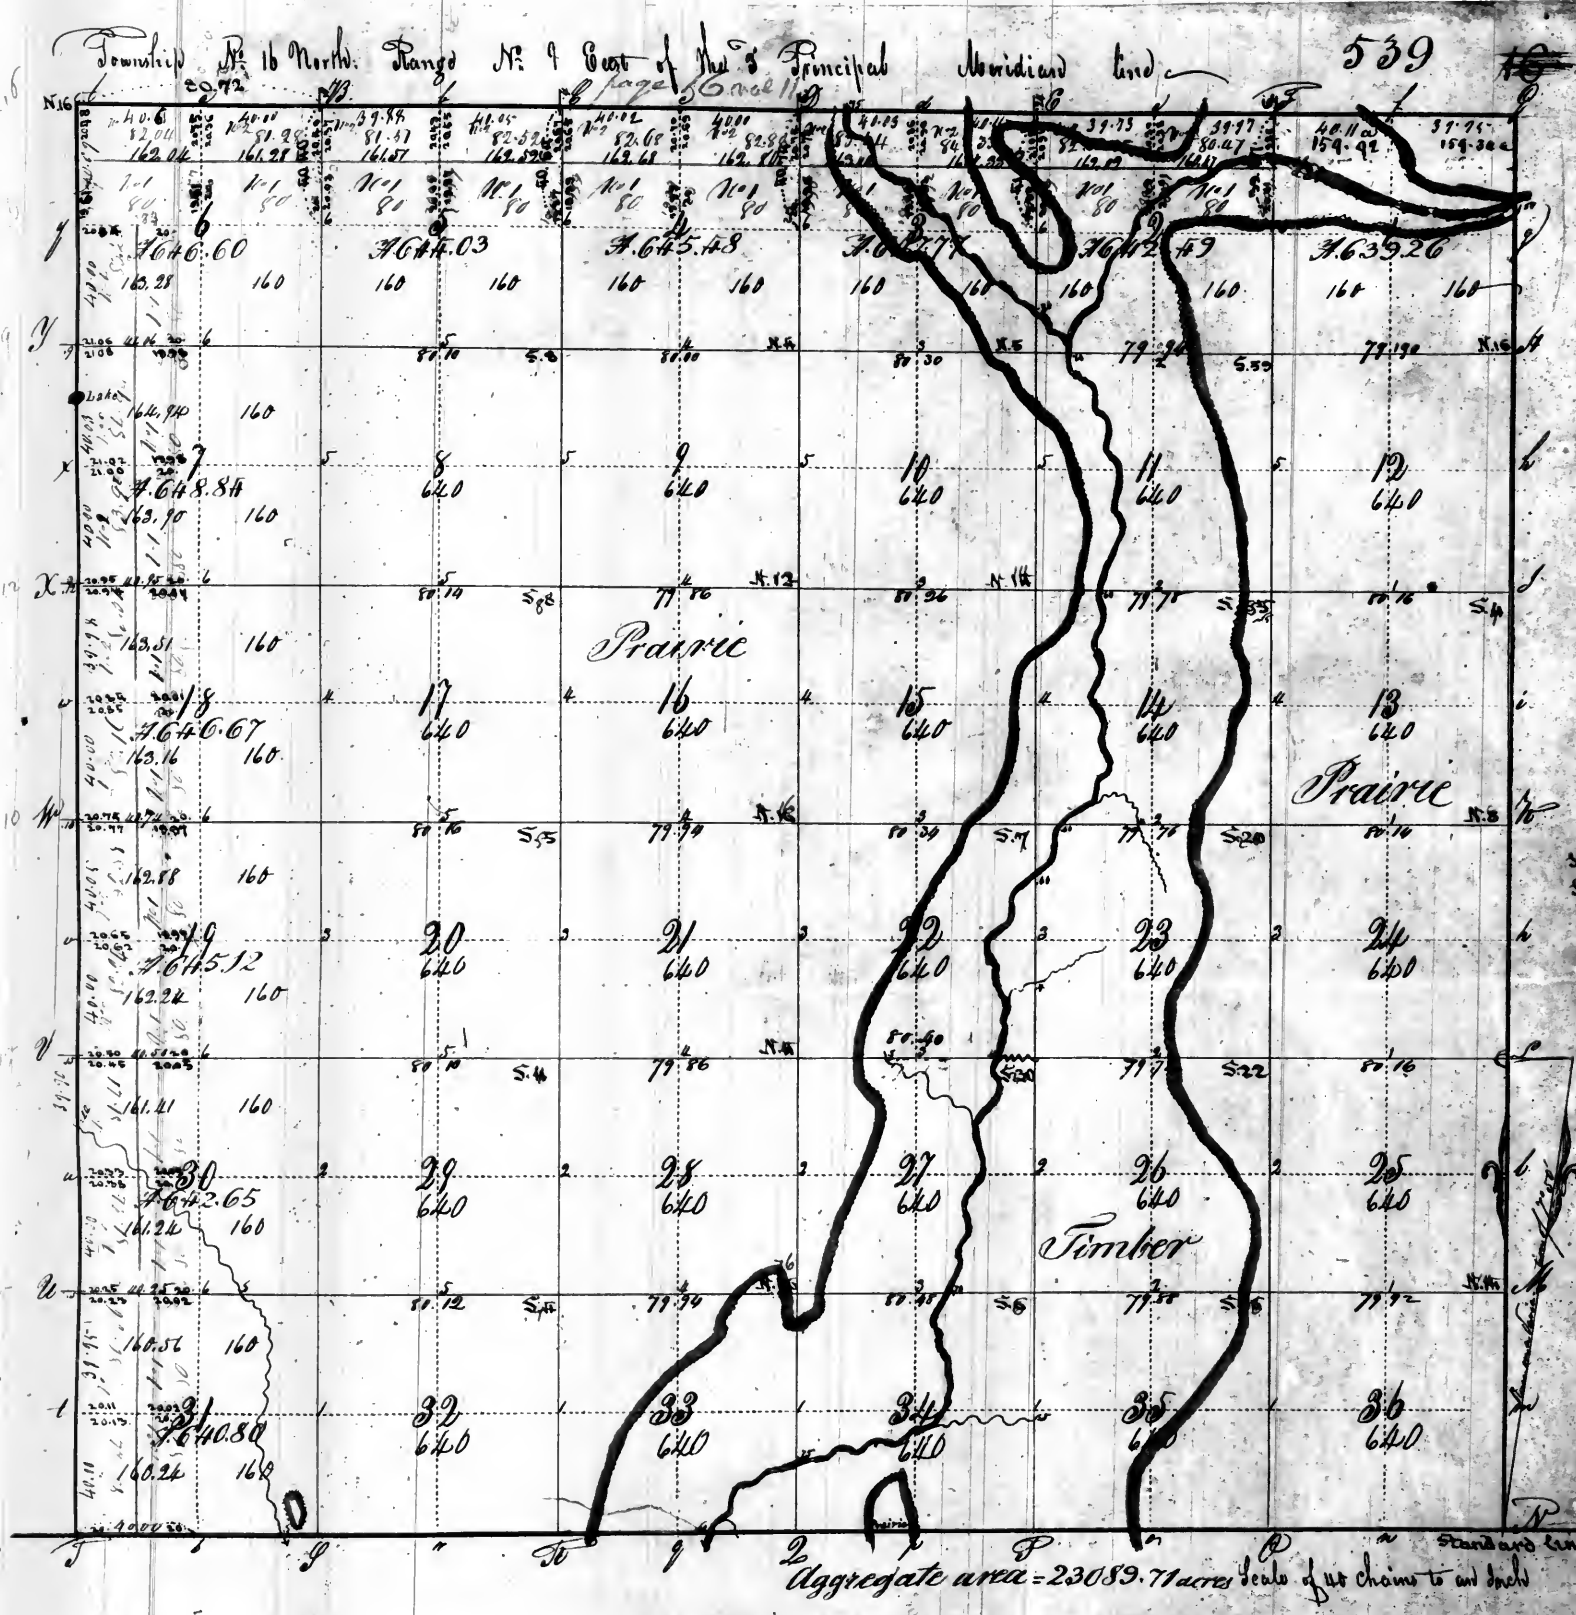

Surveyors Office
St Louis 10th Aug 1821
Plat of the North halves of sections
2, 3 & 5, 46, of the West halves of
Sections 7, 13, 19, 24 & 31, 4 of the 3rd
quarter of Sec 6, - with this day to the
Comptroller of the General Land Office.

Pursuant to a Contract with & instructions from William Keator, Surveyor of the Lands of the United States, in the State of Illinois & Territory of Arkansas, bearing date the 10th day of March 1821, I have administered & laid out & surveyed the above described Township & do hereby certify that it had such Marks & boundaries both Natural & artificial as are represented on said Plat, & described in the field notes made thereof, & returned with this Plat into the Office of the Surveyor of the Lands of the United States for the State & Territory above named.

Certified June 27 1821 Benjamin Franklin McPinger D.S.

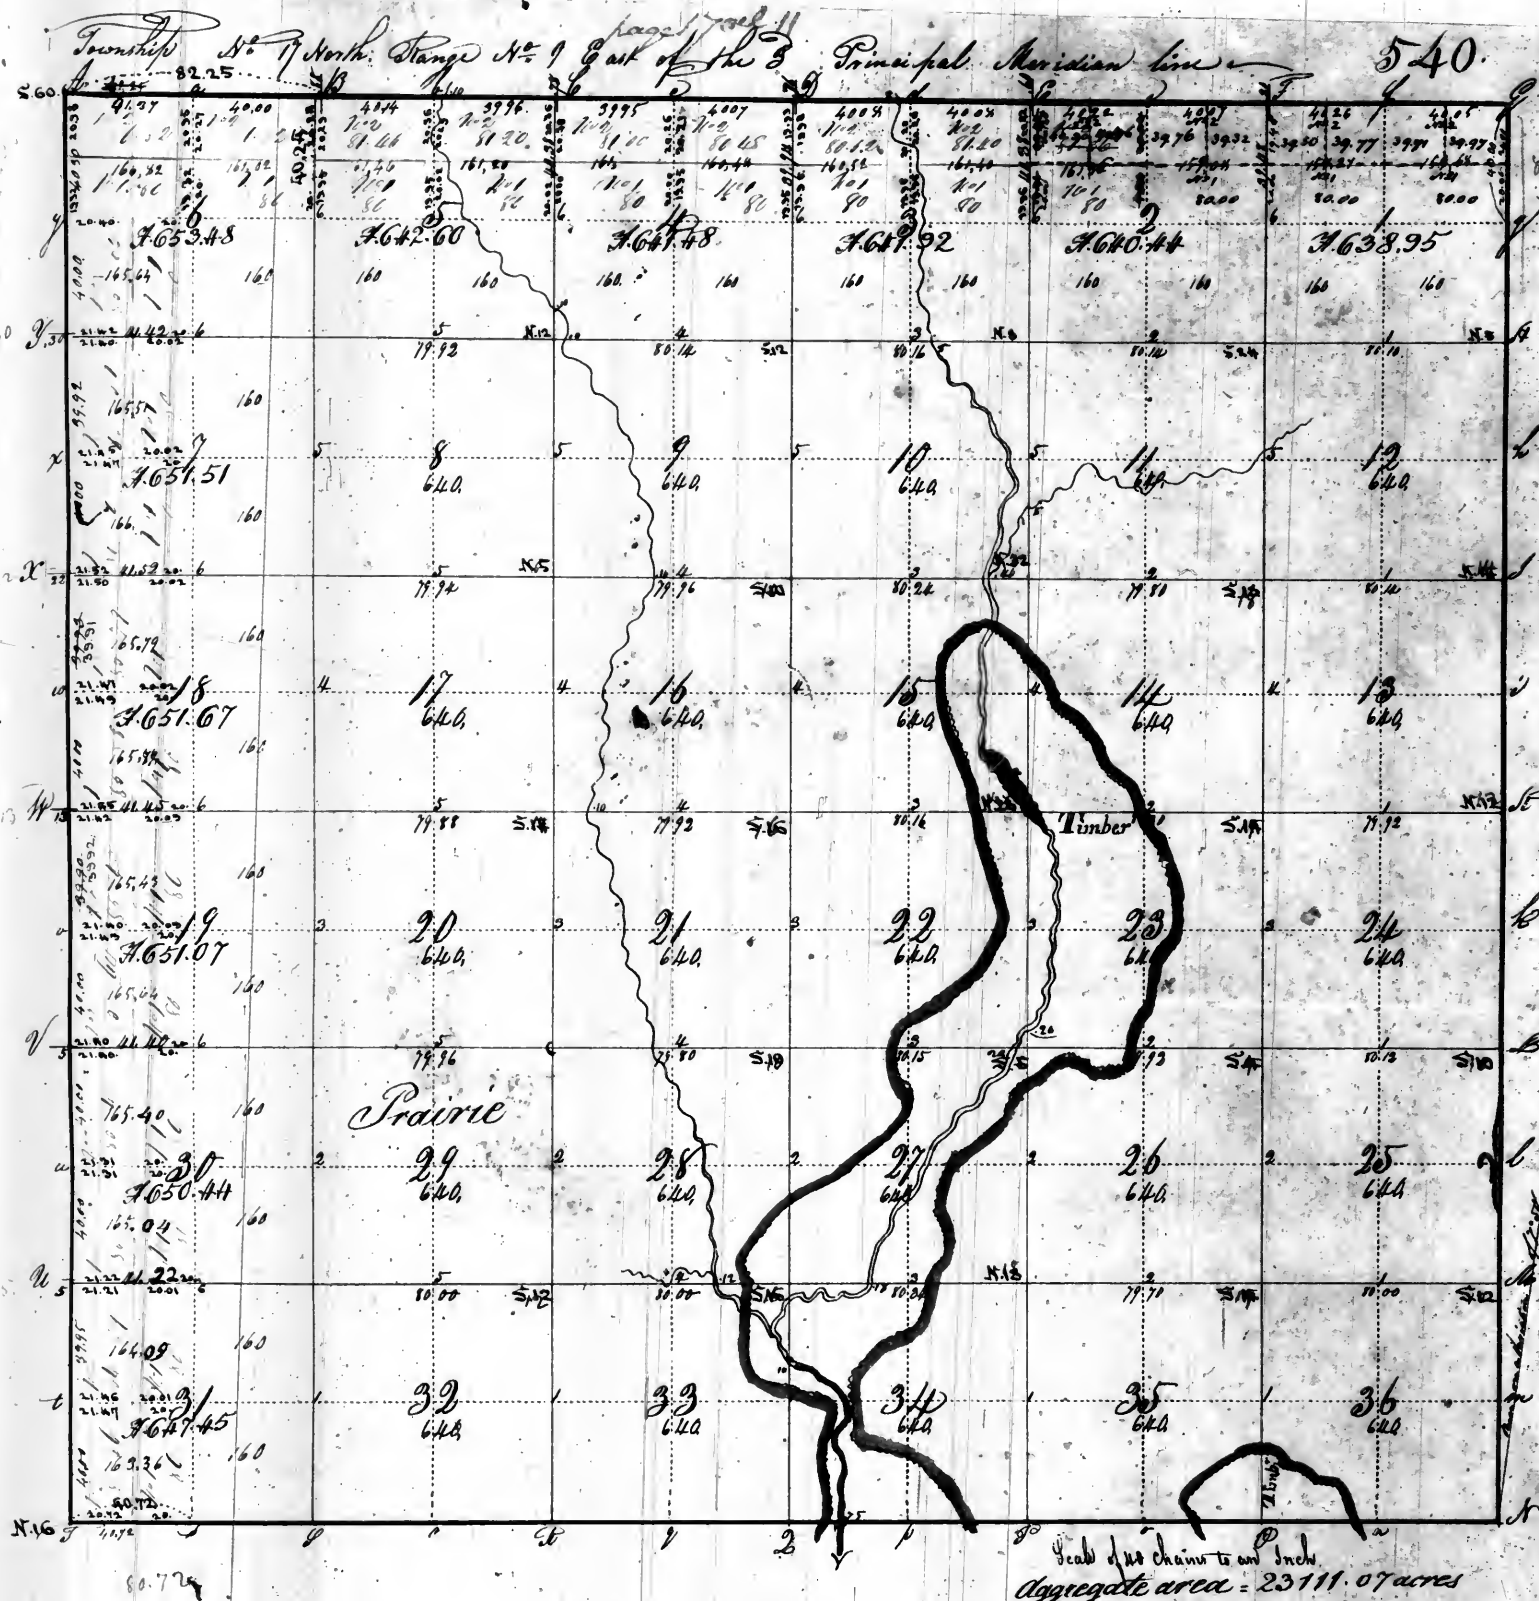


Surveyor's Office
St. Louis June 9th 1842
The North halves of sections 1 & 2
subdivided under the act of Congress
of the 5th of April 1832, and a
plat sent to the Register and another
to the Commissioner of the General
Land Office.

Surveyor's Office
St. Louis 16th Sept. 1842
Plat of the N.W. q. of sec. 2, of the
North halves of sec. 2 & 5, 5 & 6, of the
S.W. q. of sec. 6, and of the West halves
of sec. 7, 10, 13, 30 & 31 and this day
to the Comptroller of the Genl. L. O.

Pursuant to a Contract with & instructions from William Dwyer, Surveyor of the Lands of the United States in the States of Illinois and
Michigan & the Territory of Arkansas, bearing date the 14th day of March 1842, I have admeasured, laid out & surveyed the above described
Township & do hereby certify that it had such Marks & bounds both Natural & artificial as are represented on said Plat & described in
the field Notes made thereof & returned with this Plat into the Office of the Surveyor of the Lands of the United States for the States and
Territory above named.

Certified June 27th 1842 Benjamin Franklin McFingery

80.27
147 W
21.00
80 W
80.46
68 W
80.50
50 W
79.89
55 W

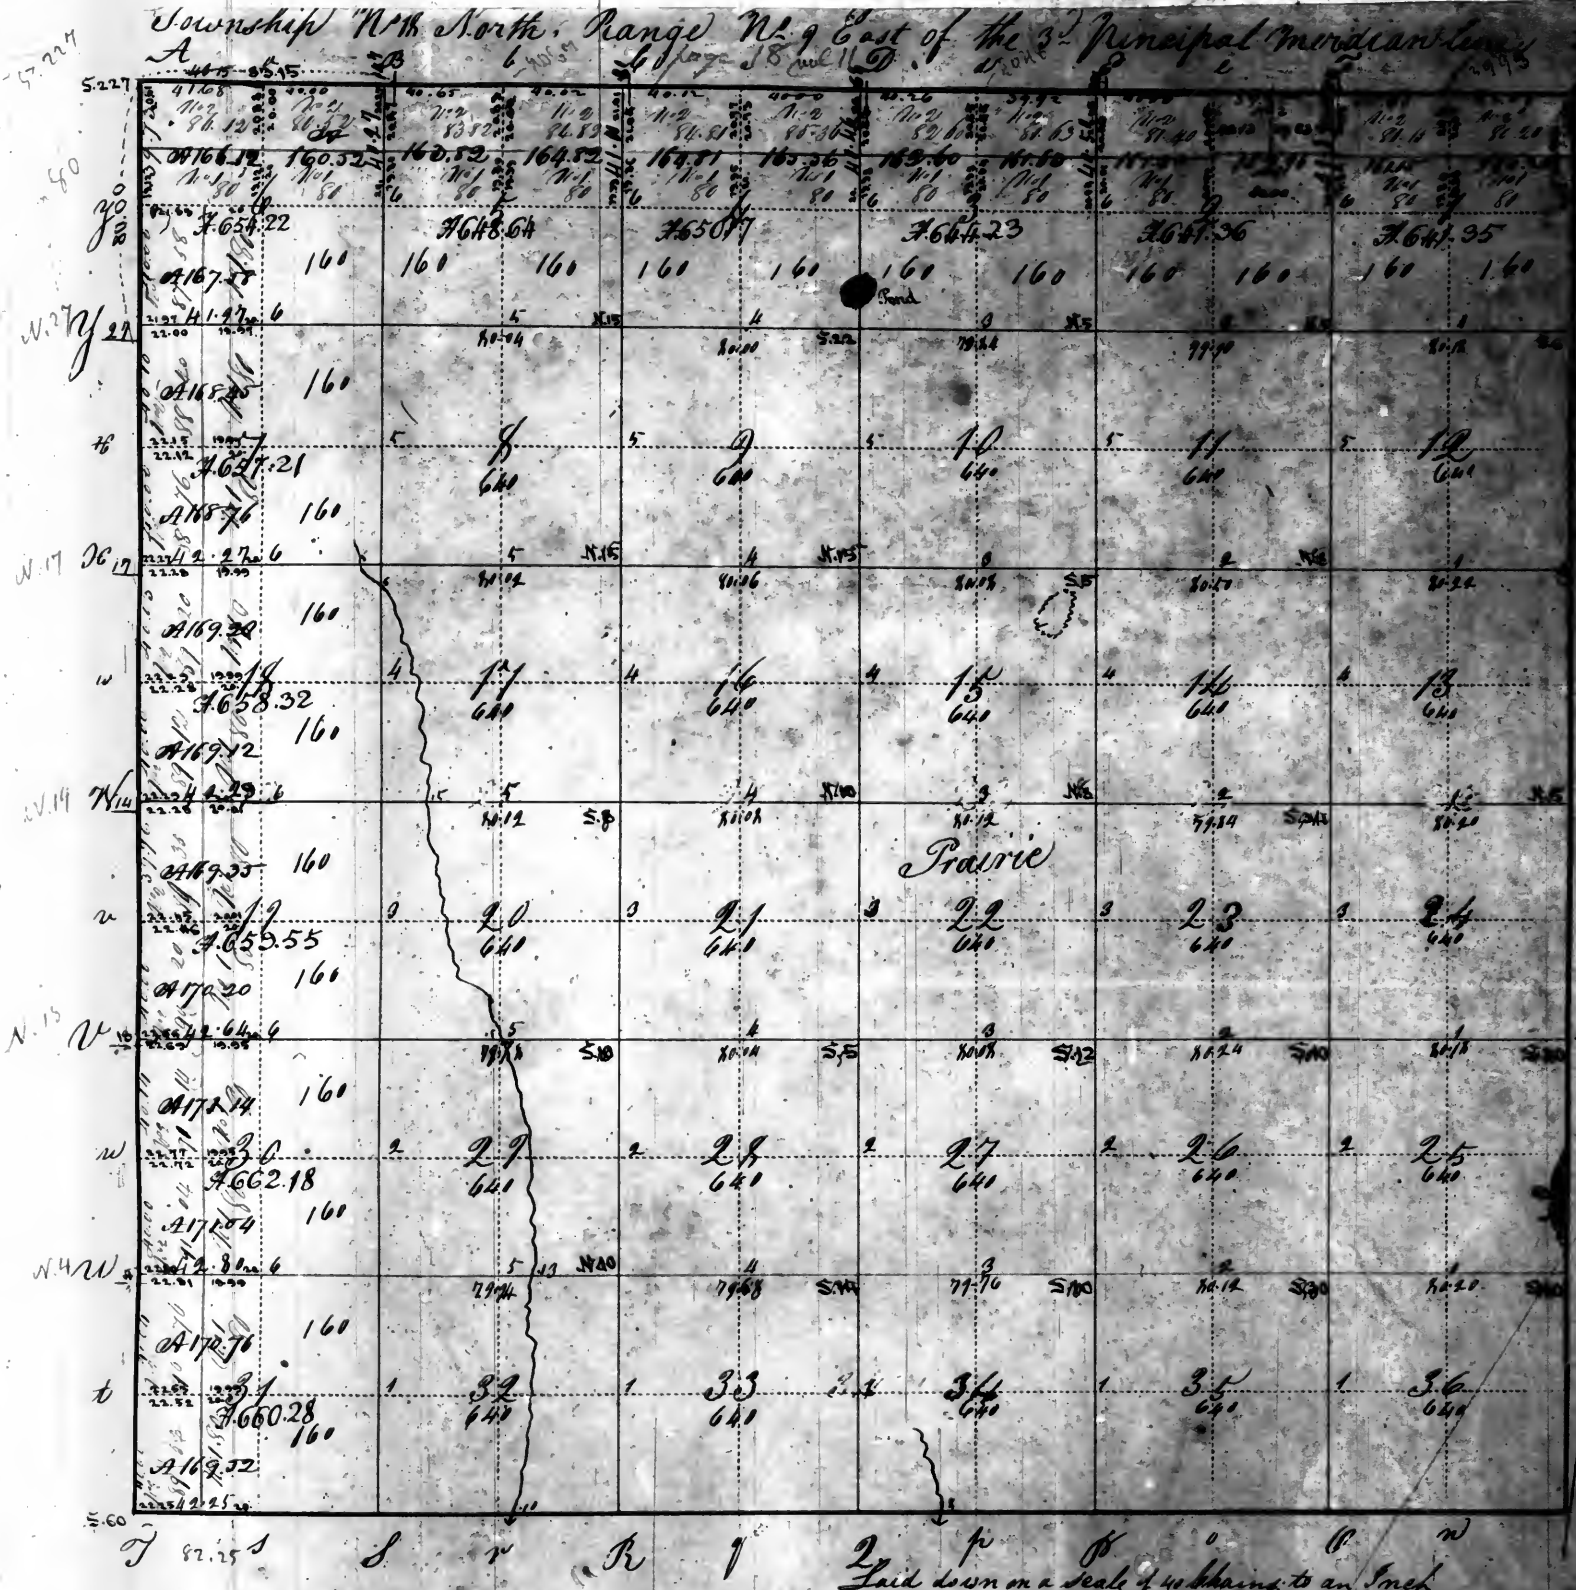


Surveyor's Office
St. Louis, Mo.
of Sec. 2, and of the West halves of Sec.
17, 18, 19, 20, 21, and this day to the Com.
missioner of the Genl. Land Office.


Surveyor's Office
St. Louis, Mo.
Subst. Survey June 27th 1849.
The North East quarter of Section
2, subdivided under the act of
Congress of the 5th of April 1832,
and also the West half of the same
and another to the Commissioner
of the General Land Office.

Pursuant to a contract with, & instructions from William Roster, Surveyor of the Land of the United States in the State of Illinois & Missouri & Arkansas bearing date the 14th day of March 1841, I have administered said land & surveyed the above described Township & do hereby certify that it had such marks both natural & artificial as are represented on said Plat. & described in the field notes made thereof & returned with this Plat into the Office of the Surveyor of the Land of the United States for the State and Territory above written.


Certified June 27th 1841 Benjamin Franklin Messinger D.C.

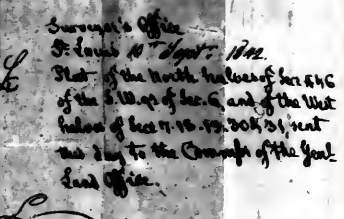

Pursuant to a contract with & instructions from William Hector, Surveyor of the Lands of the United States in the State of Illinois & Indian Territory of Arkansas. bearing date the 10th day of March 1821 I have admeasured laid out & surveyed the above described Township & do hereby certify that it had such Marks both Natural & Artificial as are represented on said Plat & assented in the field Notes Made thereof & returned with this Plat into the Office of the Surveyor of the Lands of the United States for the State and Territory above written.

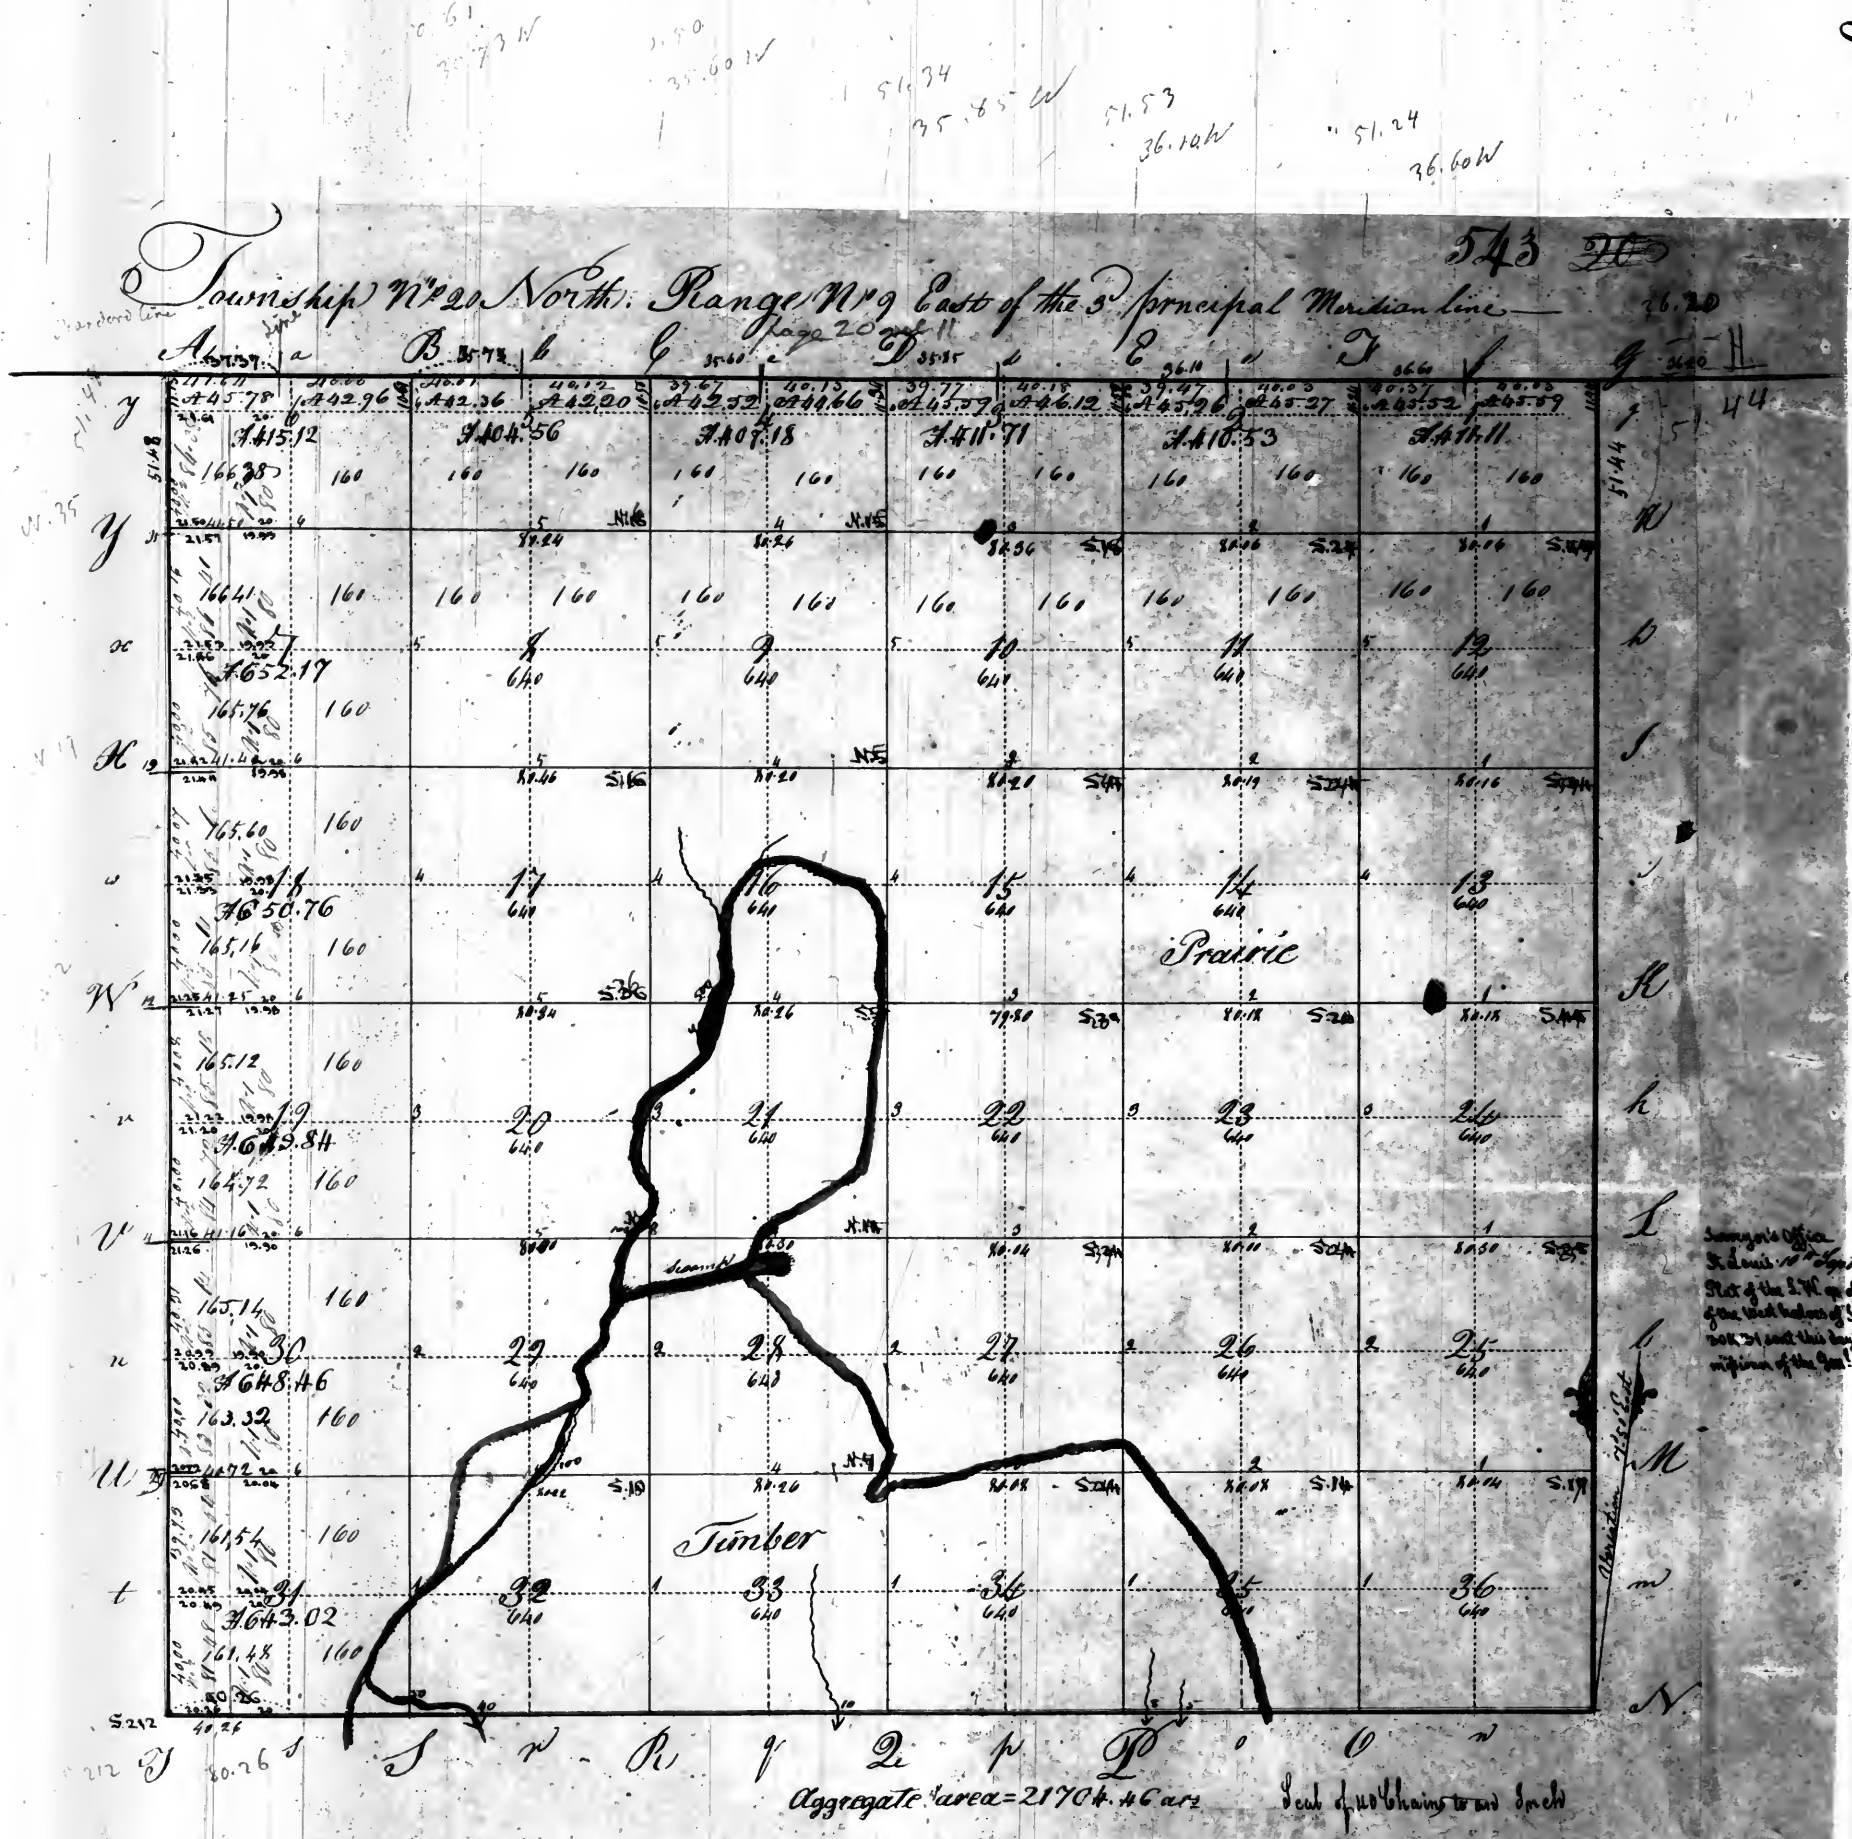

Township 122 North of the Base line Range N. 9 East of the 3 Principal Meridians
Page 22 of 11

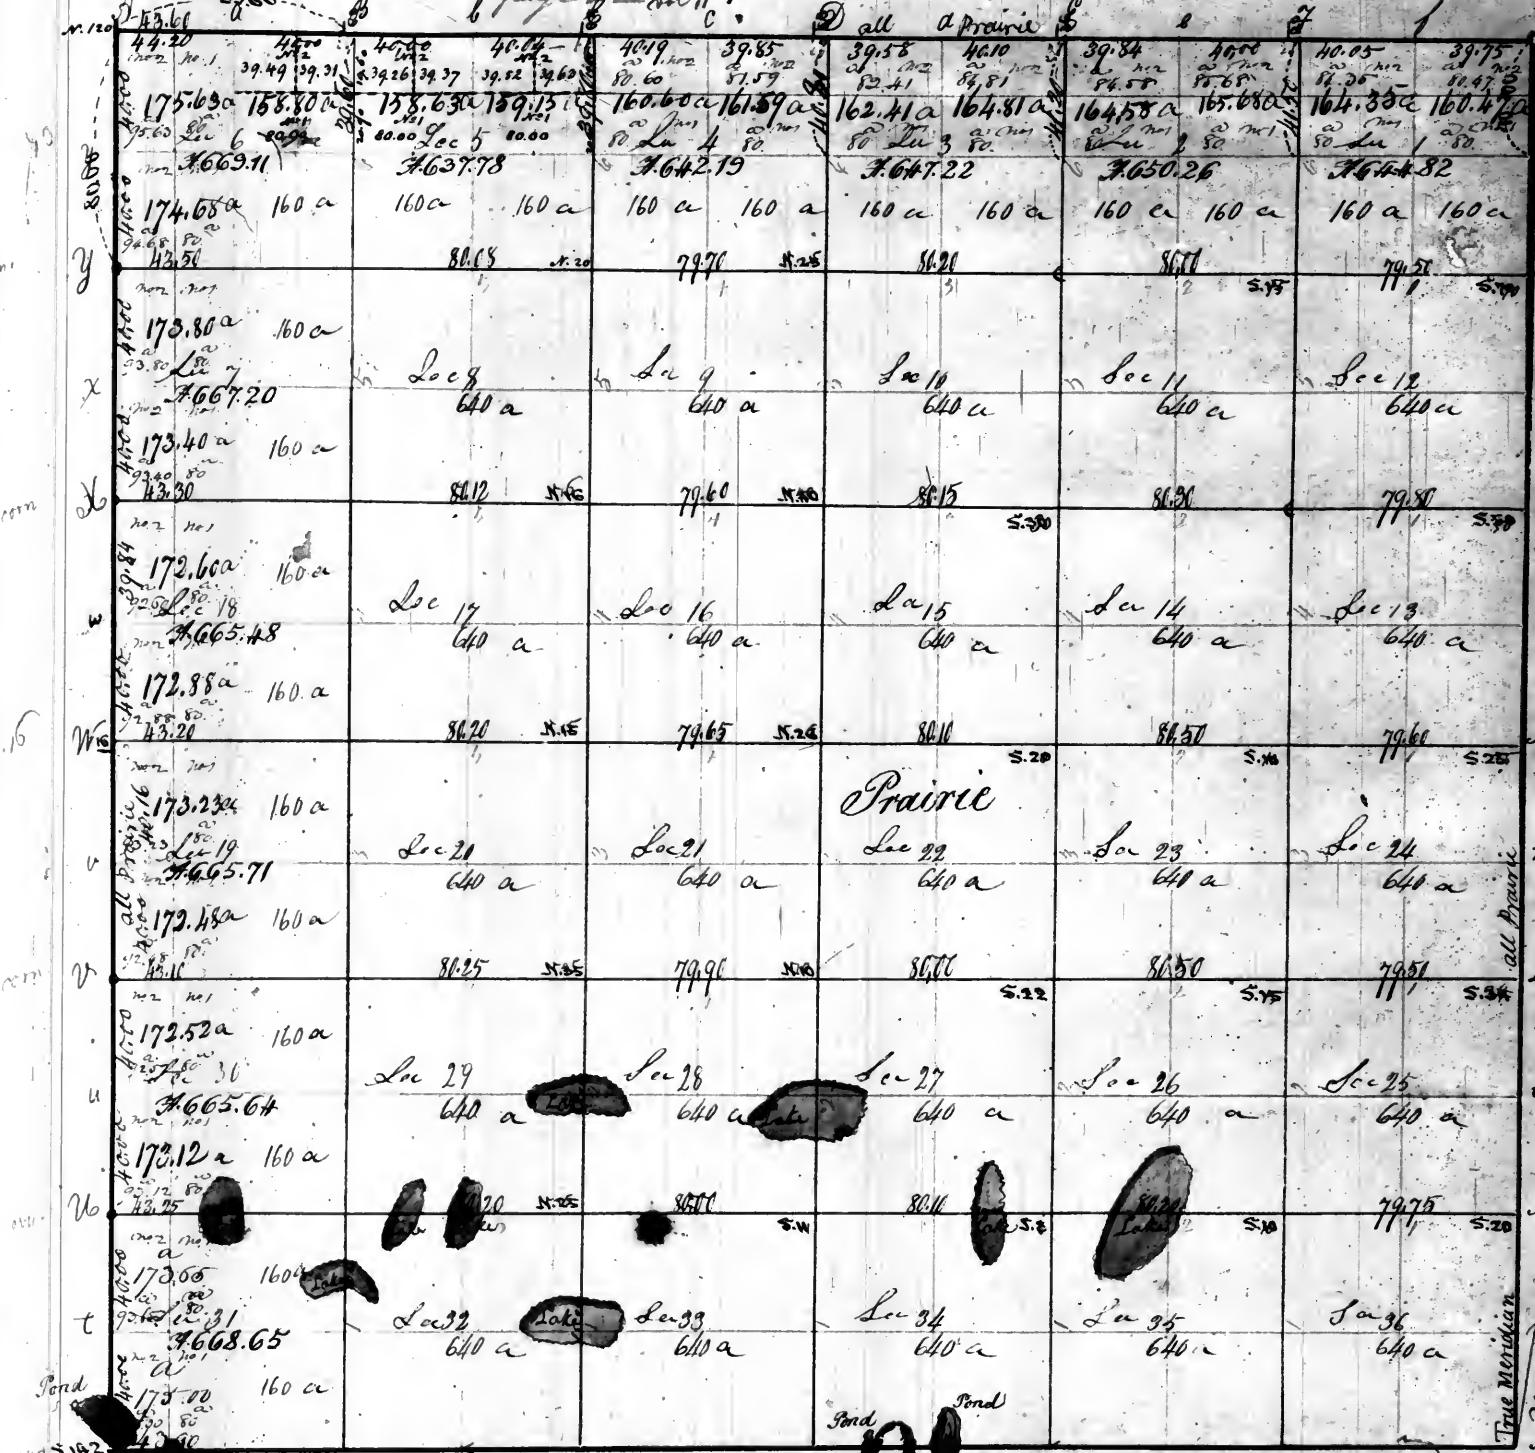

Surveyor's office
Saint Louis June 9th 1849.
The north half of section 5, and the north east quarter
of section 6 subdivided under the act of Congress of the
5th of April 1832, and a plat sent to the Register and
another to the Commissioner of the General Land office.

WARRANT to a contract with & instructions from William Rector surveyor of the lands of the United States in the
States of Illinois & Missouri & Territory of Arkansas, bearing date the 20th day of February 1829, I have admeasured, laid out
& surveyed the above described township & do hereby certify, that it had such marks & bounds both natural & artificial, as are
represented on said plat & described in the field notes made thereof, and returned with this plat into the office of the surveyor
of the lands of the United States for the States of Illinois & Missouri & Territory of Arkansas—


Certified this 12th day of August 1820

C. Moore

Downship N. 23 North of the Base line Range N. 9 East of the 3^d Principal Meridian

23

Surveyor's office
Saint Louis June 9th 1849
The North halves of sections 1, 2, 4 & 5, the North West quarter of section 2, and the Northeast quarter of section 6, subdivided under the act of Congress of the 5th of April 1832, and a plat sent to the Register and another to the Commissioners of the General Land office

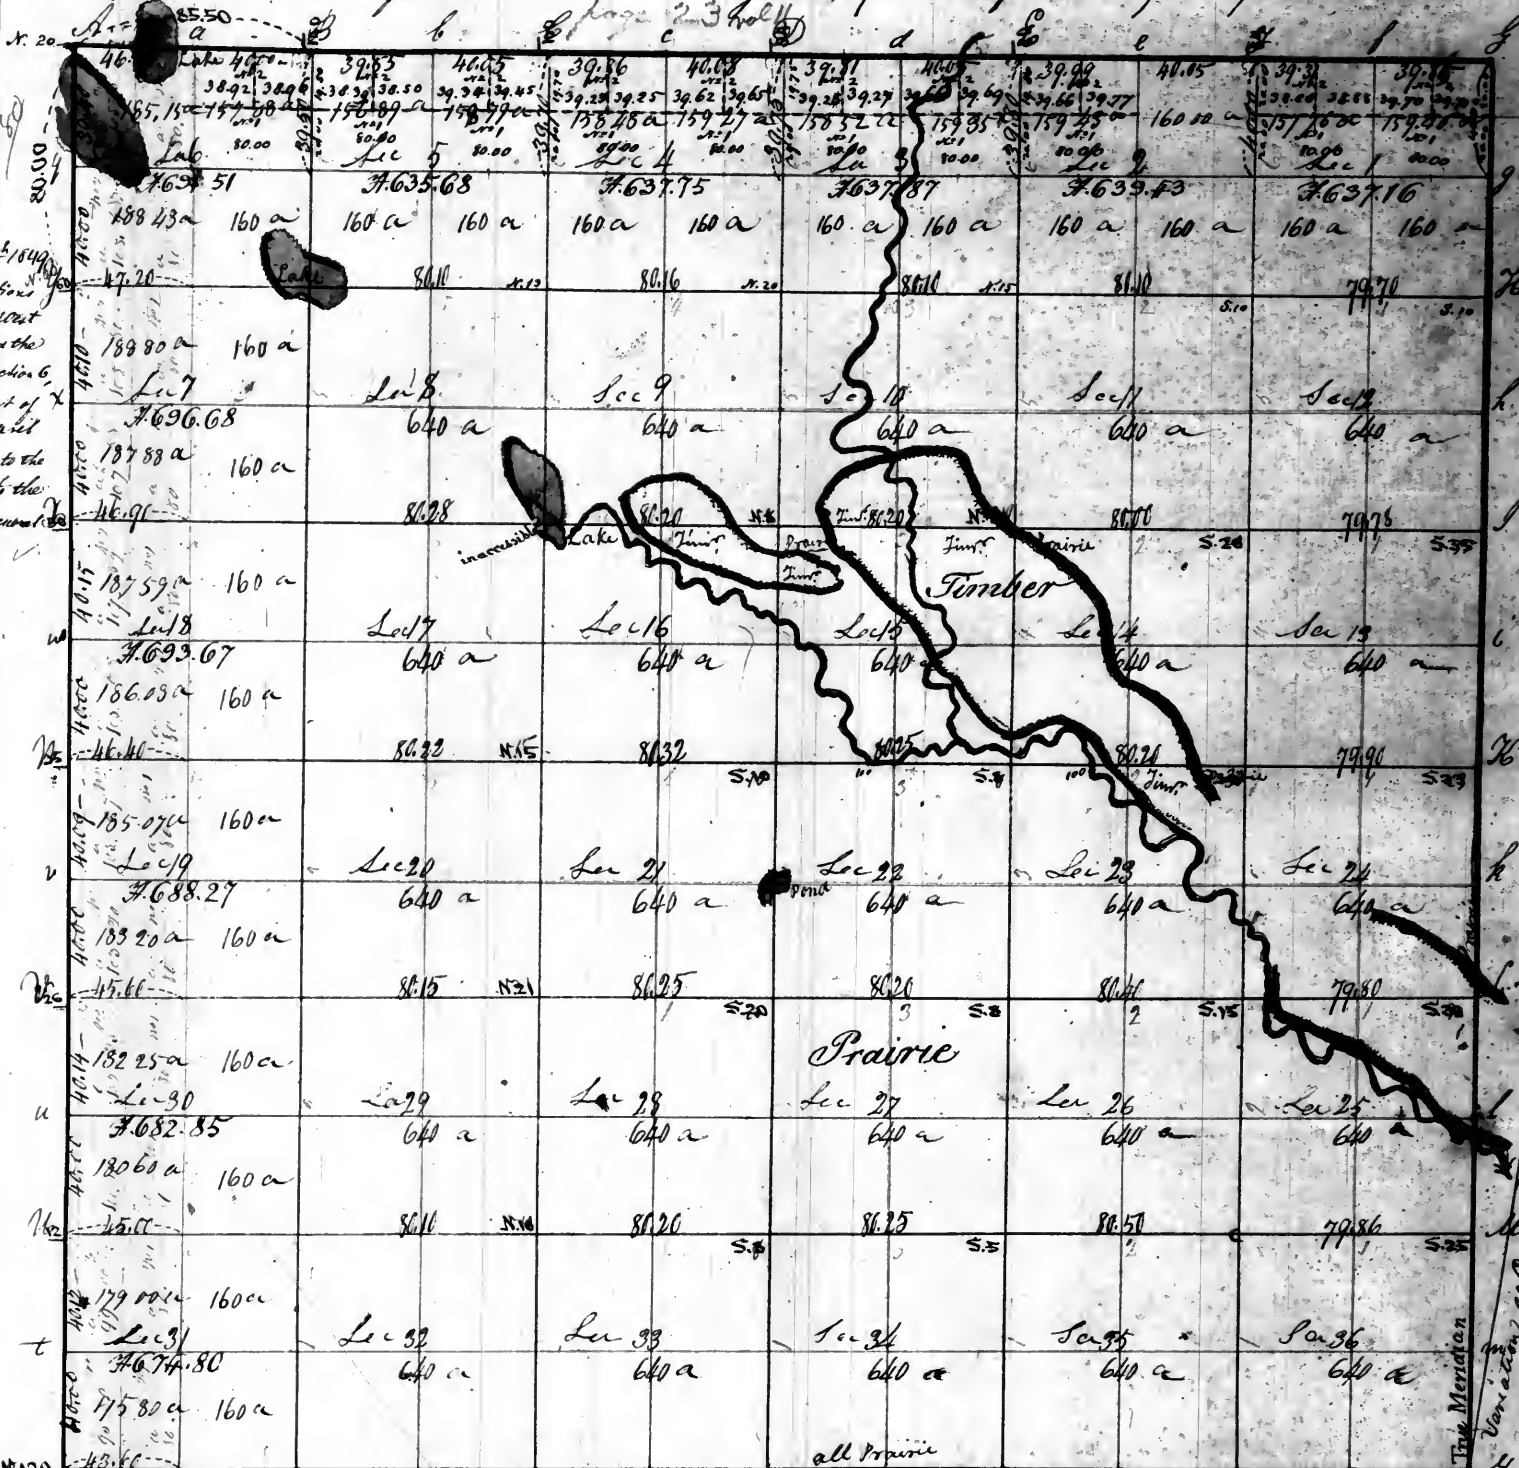


In pursuance to a contract with, & instructions from William Rector, surveyor of the lands of the United States in the States of Illinois and Missouri & Territory of Arkansas, bearing date the 20th day of February 1822, I have, admeasured, laid out & surveyed the above described township and do hereby certify, that it has such marks & bounds both natural & artificial, as are represented on said plat, and described in the field notes made thereof, and returned with this plat into the office of the surveyor of the lands of the United States, for the States of Illinois & Missouri & Territory of Arkansas.

Certified this 12th day of August 1822

Enoch Moody, D.S.

Township N 24 north of the Base line Range N 9 East of the 3^d principal Meridian

547

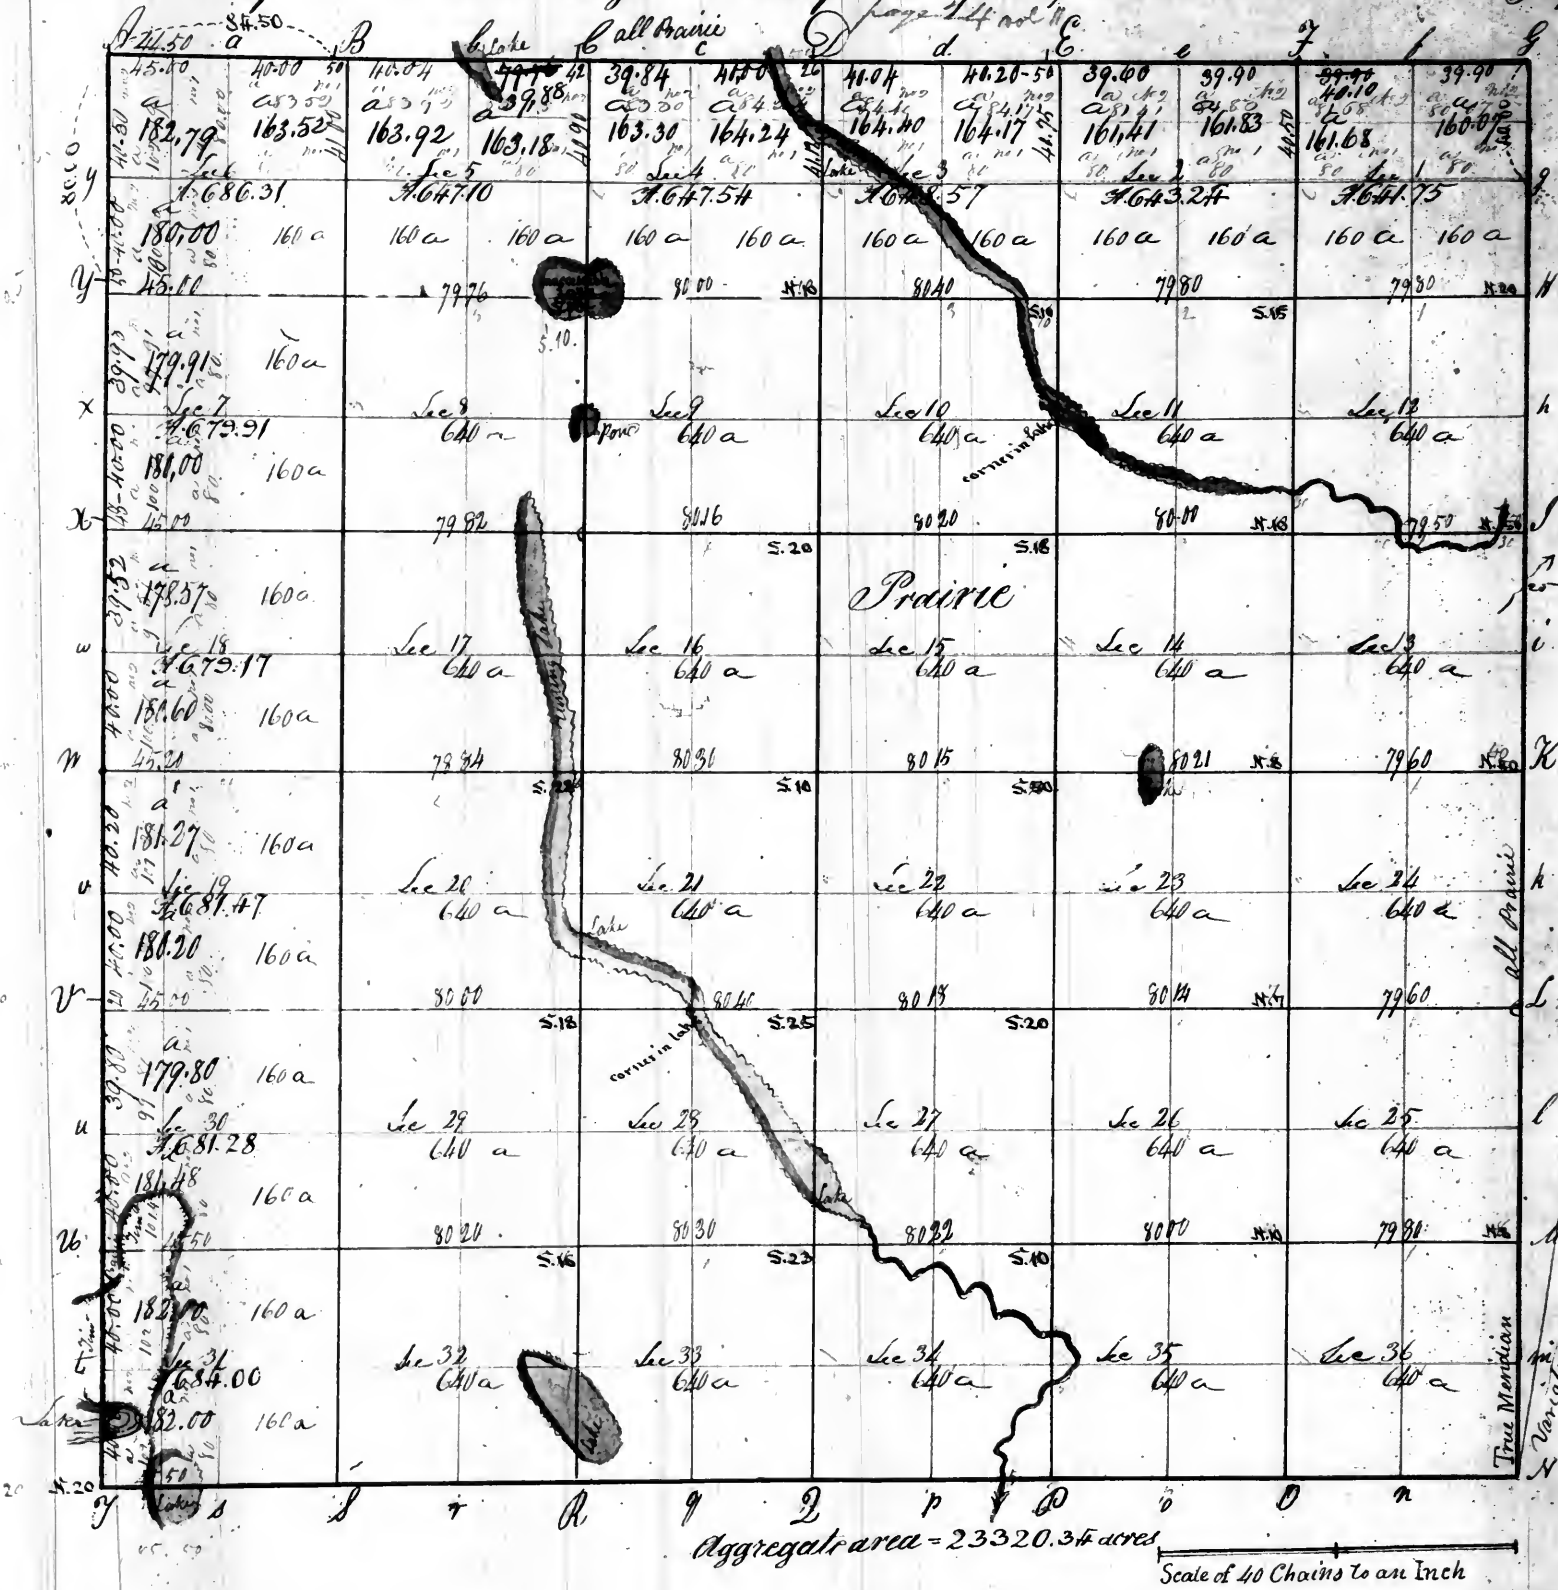


(P)
Pursuant to a contract with, and instructions from William Recker, surveyor of the lands of the United States in the States of Illinois and Missouri and Territory of Arkansas, bearing date the 20th day of February 1822, I have admeasured, laid out and surveyed the above described Township and do hereby certify, that it had such marks and bounds, both natural and artificial, as are represented on said plat, and described in the field notes made hereof, and returned with this plat into the office of the surveyor of the lands of the United States, for the States of Illinois and Missouri and Territory of Arkansas.

Certified this 12th day of August 1822.

Enoch Moore D.S.

Township N^o 25 North of the Base line Range N^o 9 East 3^d Principal Meridian 548.

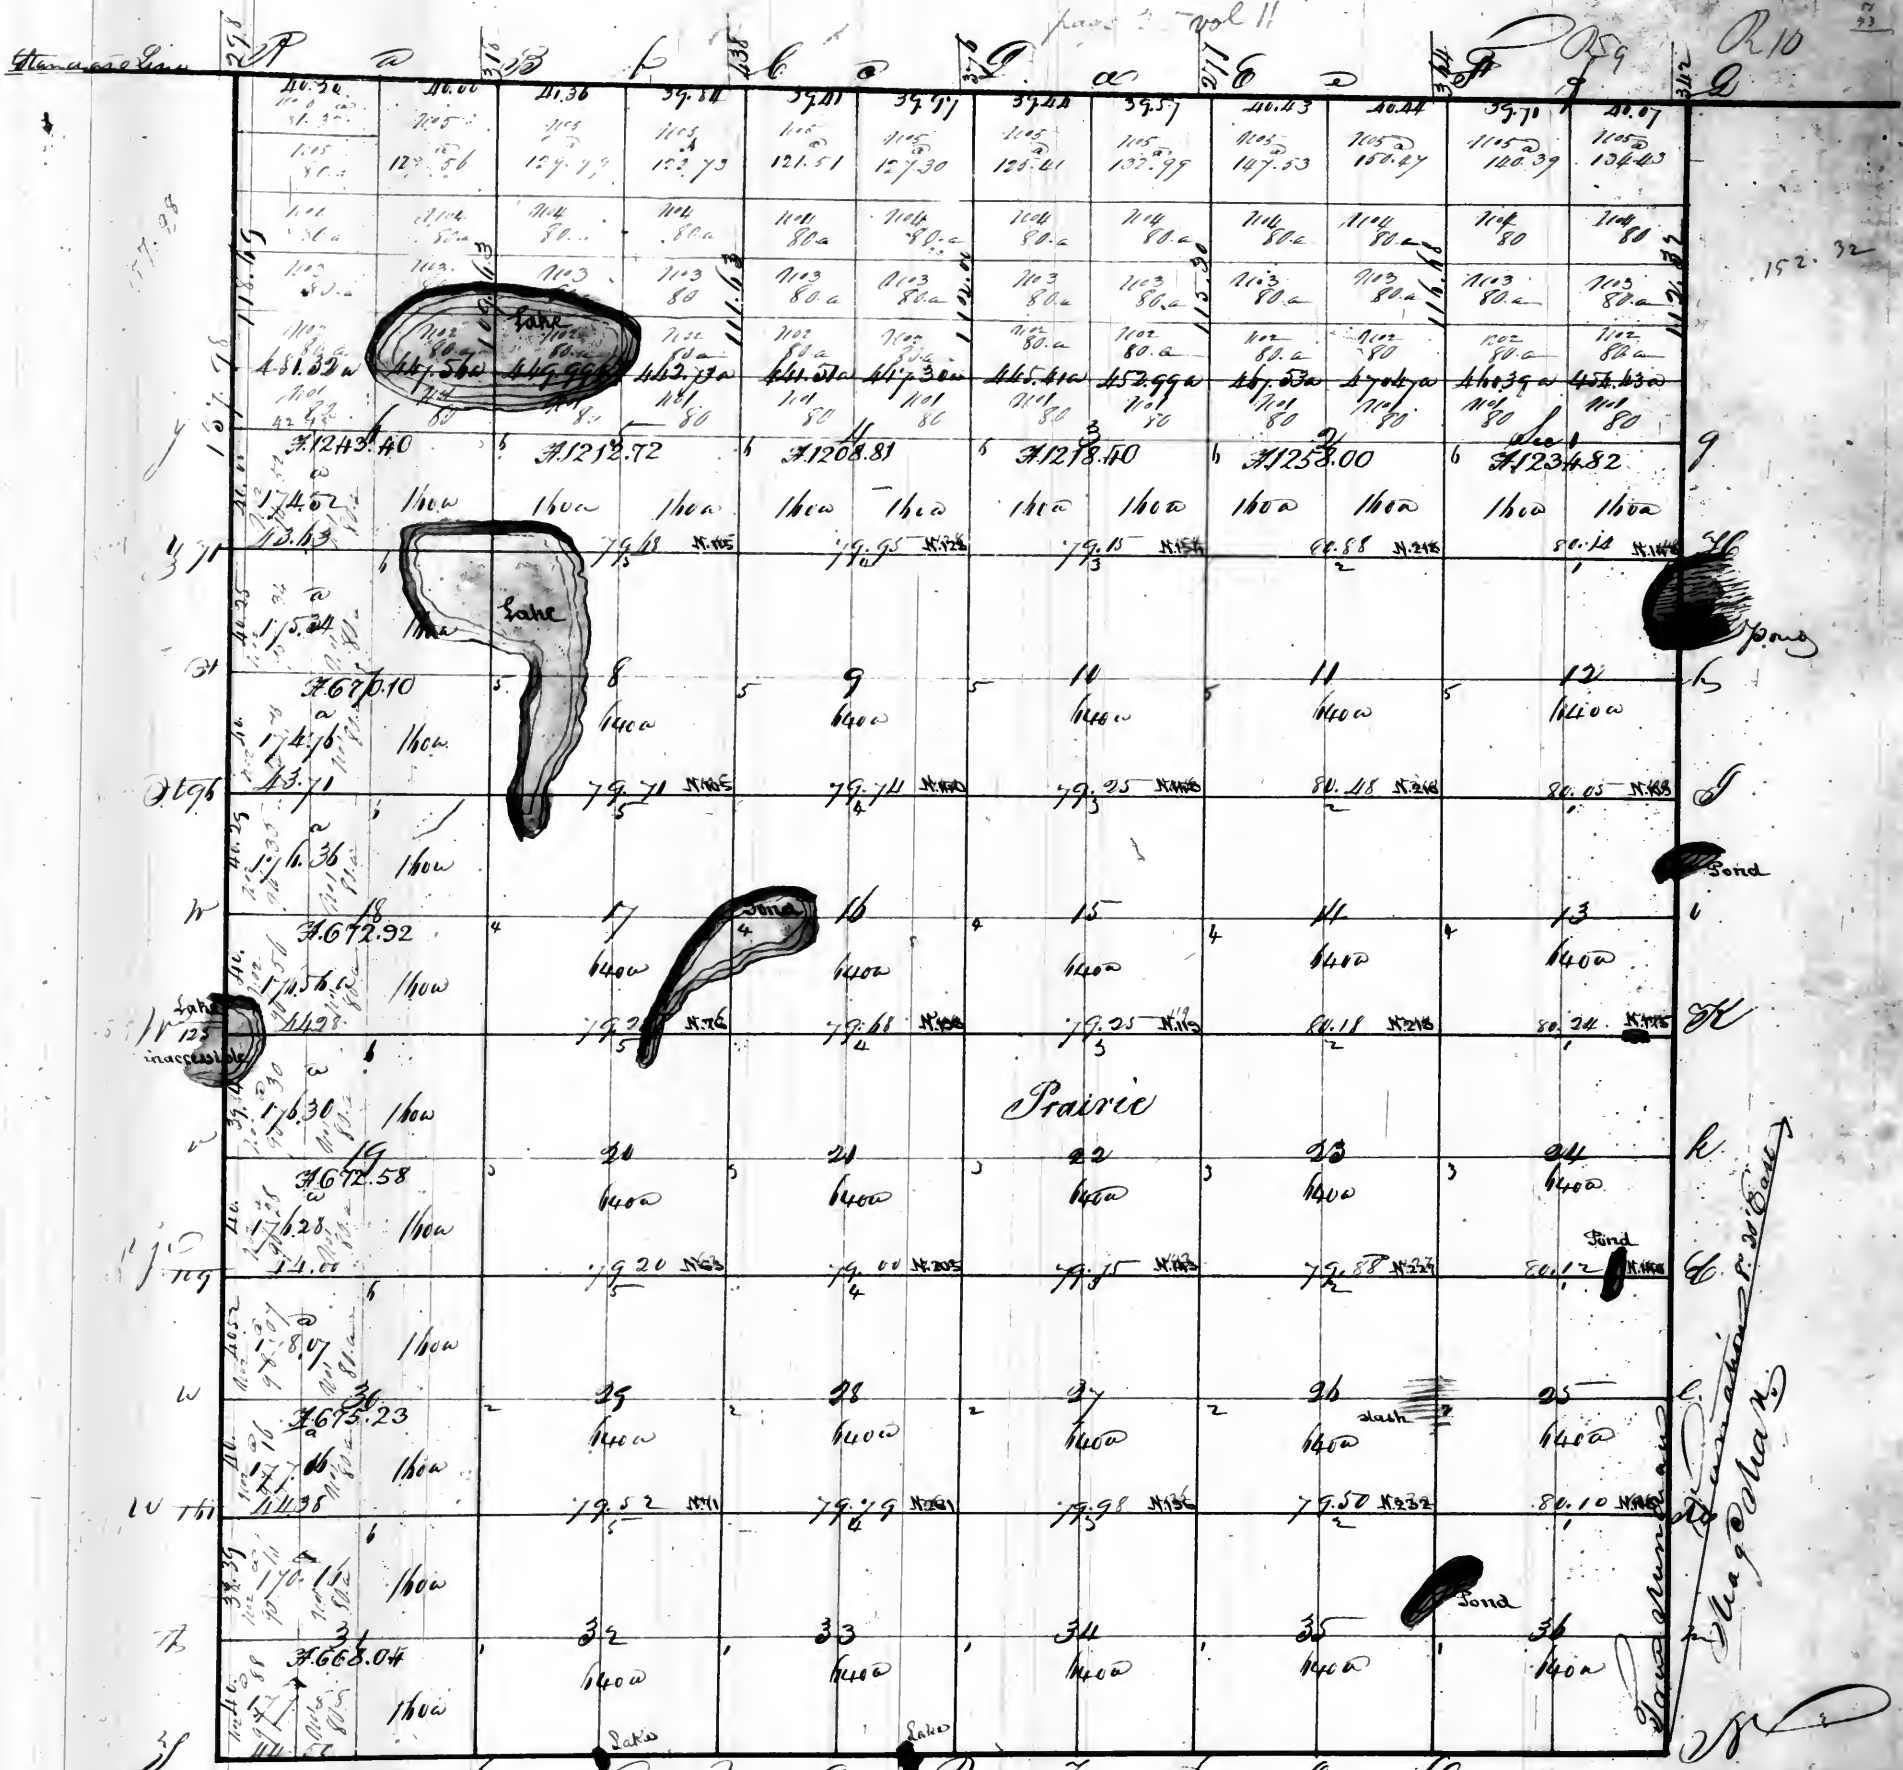

Aggregate area - 26755.02 acres

Scale of 40.0 Chas to an inch

Pursuant to a contract with and instructions from William Butler Surveyor of the Lands of the United States of Illinois and Missouri Territory of Arkansas, bearing date the 9th day of March 1822 - I have examined laid out and surveyed the above described Township of N^o 25 North of the Base line and Range N^o 9 East 3^d Principal Meridian as an important on said plat and describing in the field notes made thereof and returned with this plat into the office of the Surveyor of the Lands of the United States in the State of Illinois & Missouri Territory of Arkansas -


Certified this 18th day of November, 1822

Examined

J. H. Steen Surveyor

principal Meridian

Surveyor's office)
The North West quarter of
section 2 & 7, the North East
quarter of section 3 - the North
half of section 4, and the
South West quarter of section
6, situated under the act
of Congress of the 5th of April
1832, and plat sent to
the Register and another
to the Commissioner of
the General Land office

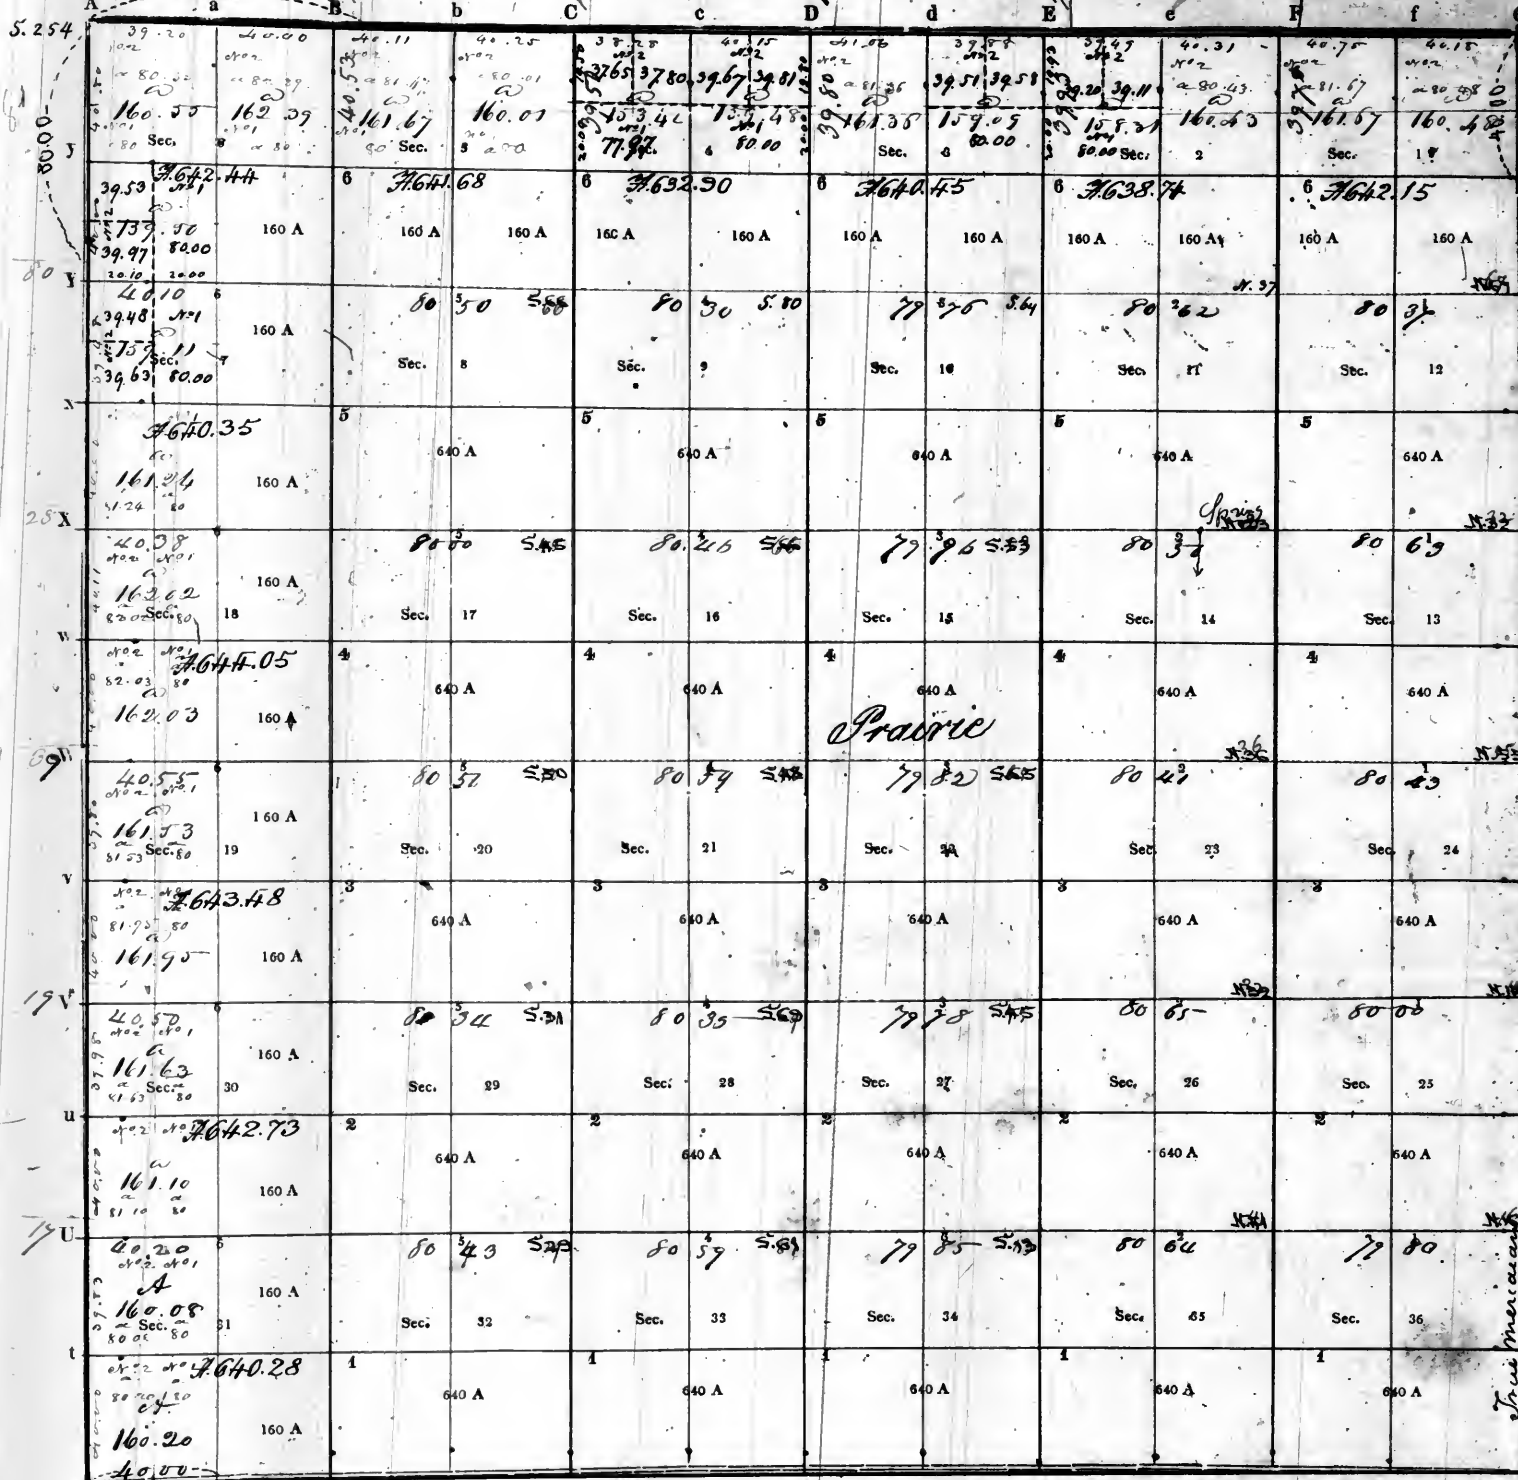

Aggregate area = 23049.25 acres

Scale of 40 Chains to an Inch


PURSUANT to a contract with, and instructions from William Rector, Surveyor of the lands of the United States in the State of Illinois and Territory of Arkansas, bearing date the 15th day of March 1832, we have measured, laid out and surveyed the above described Township; and do hereby certify, that it had such marks and bounds, both natural and artificial, as are represented on said plat, and described in the field notes made thereof, and returned with this plat into the Office of the Surveyor of the Lands of the United States, in the State of Illinois and Territory of Arkansas.

Certified this *Thirteenth* day of *December* 1882

EXAMINED.

Wm Hamilton
Clerk Rector

Township No. 31 North, page 27 vol 11 of the base line, Range No. 9 East of the 3 principal Meridian.

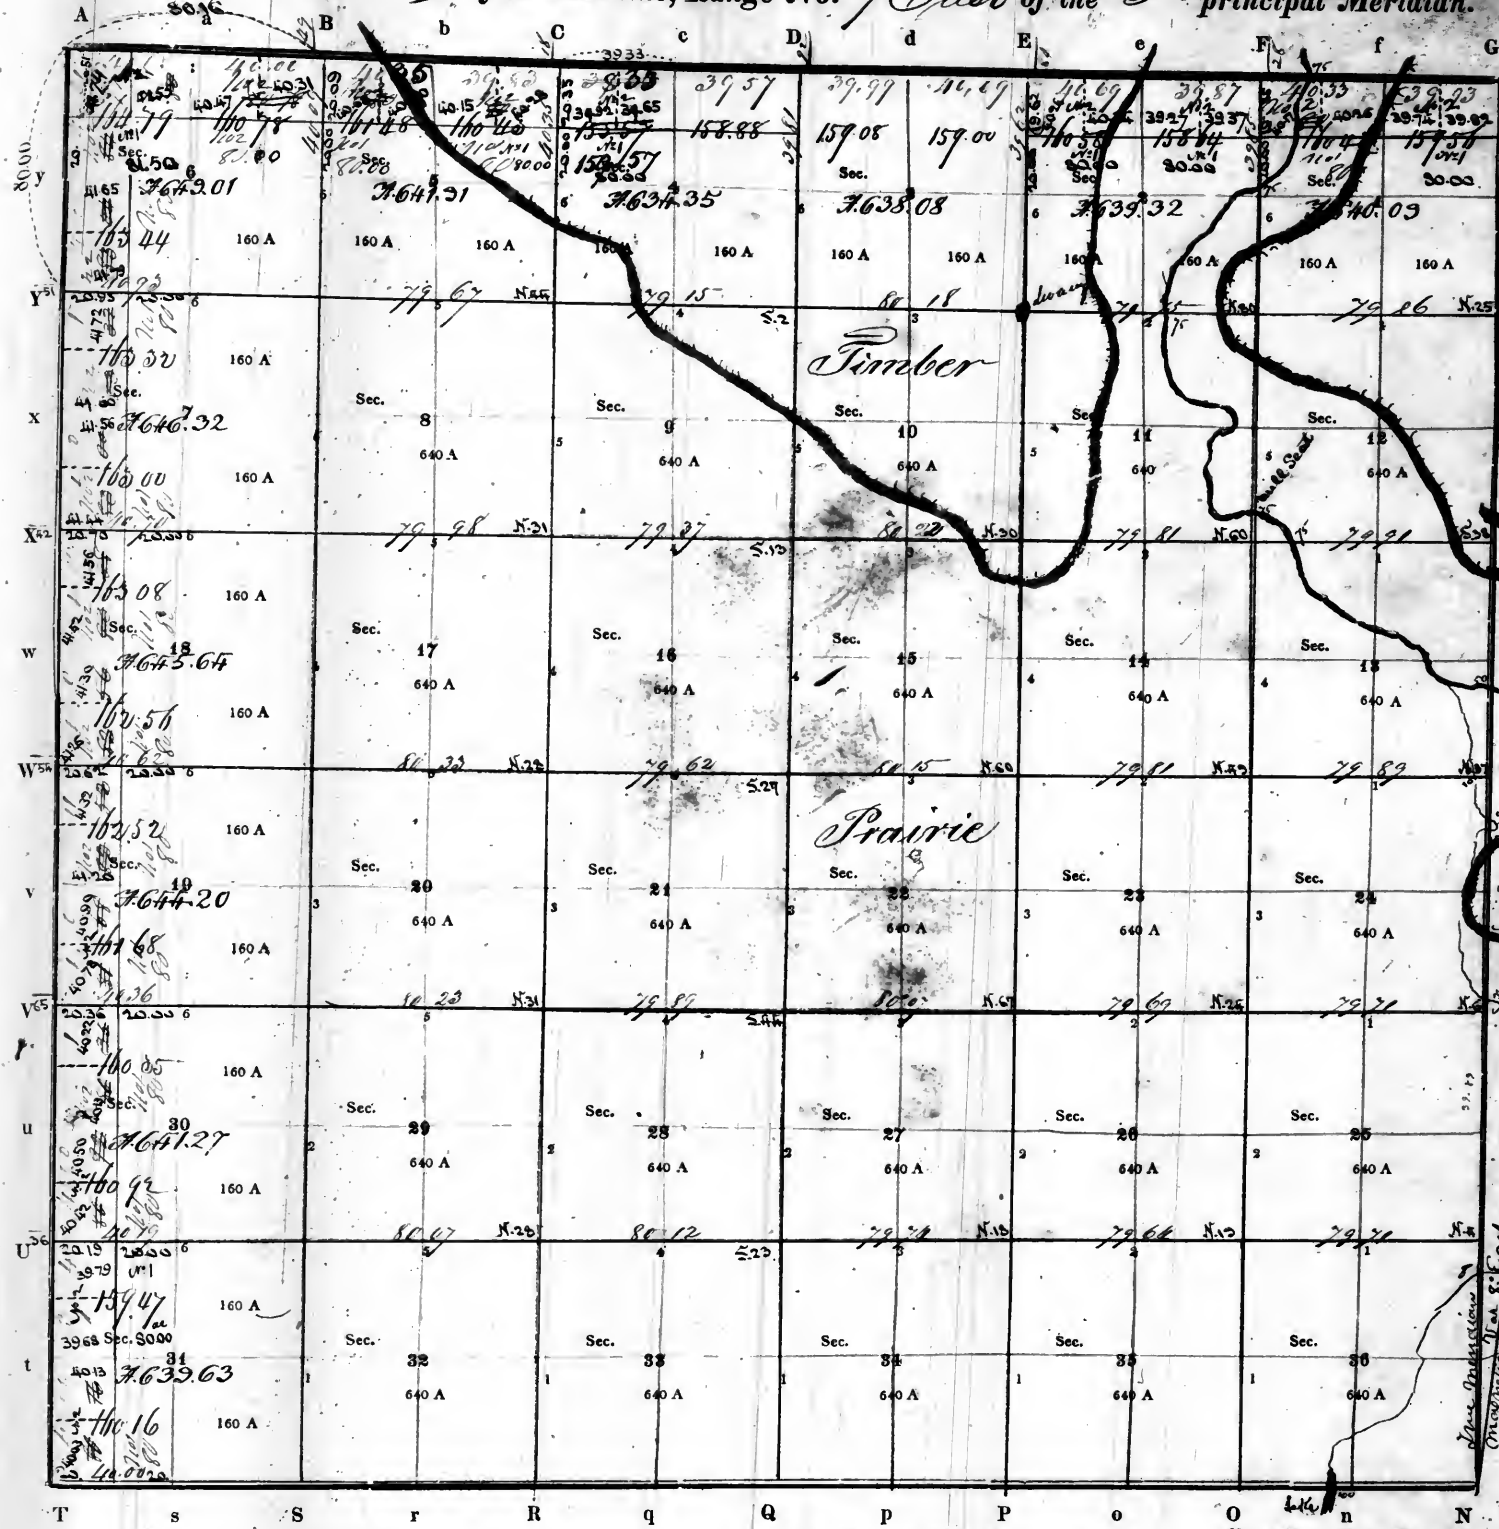

Surveyor's Office, November 1845.
Saint Louis, Mo.
Subscribed under the Act of 1820, ch. 1, Sec. 1, 2, 3, 1000.

Aggregate area - 23059.82 acres

PURSUANT to a contract with, and instructions from WILLIAM RECTOR, Surveyor of the lands of the United States in the States of Illinois, Missouri & Territory of Arkansas bearing date the twentieth day of March 1821


I have admeasured, laid out and surveyed the above described Township; and do hereby certify, that it had such marks and bounds, both natural and artificial, as are represented on said plat, and described in the field notes made thereof, and returned with this plat into the Office of the Surveyor of the lands of the United States, for the States of Illinois, Missouri & Territory of Arkansas

Certified this day of

EXAMINED.

D. SURVEYOR.





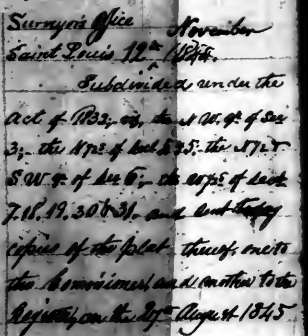

Surveyed by Daniel L. Miller D. Surveyor
June 18 20

See instruction of the
18th of May 1846 to
J. Mathewson to survey
the island on beds 6, 7 & 8
page 29 vol 11

Sketch of the West line Range N. 9 East of 7th Principal Meridian

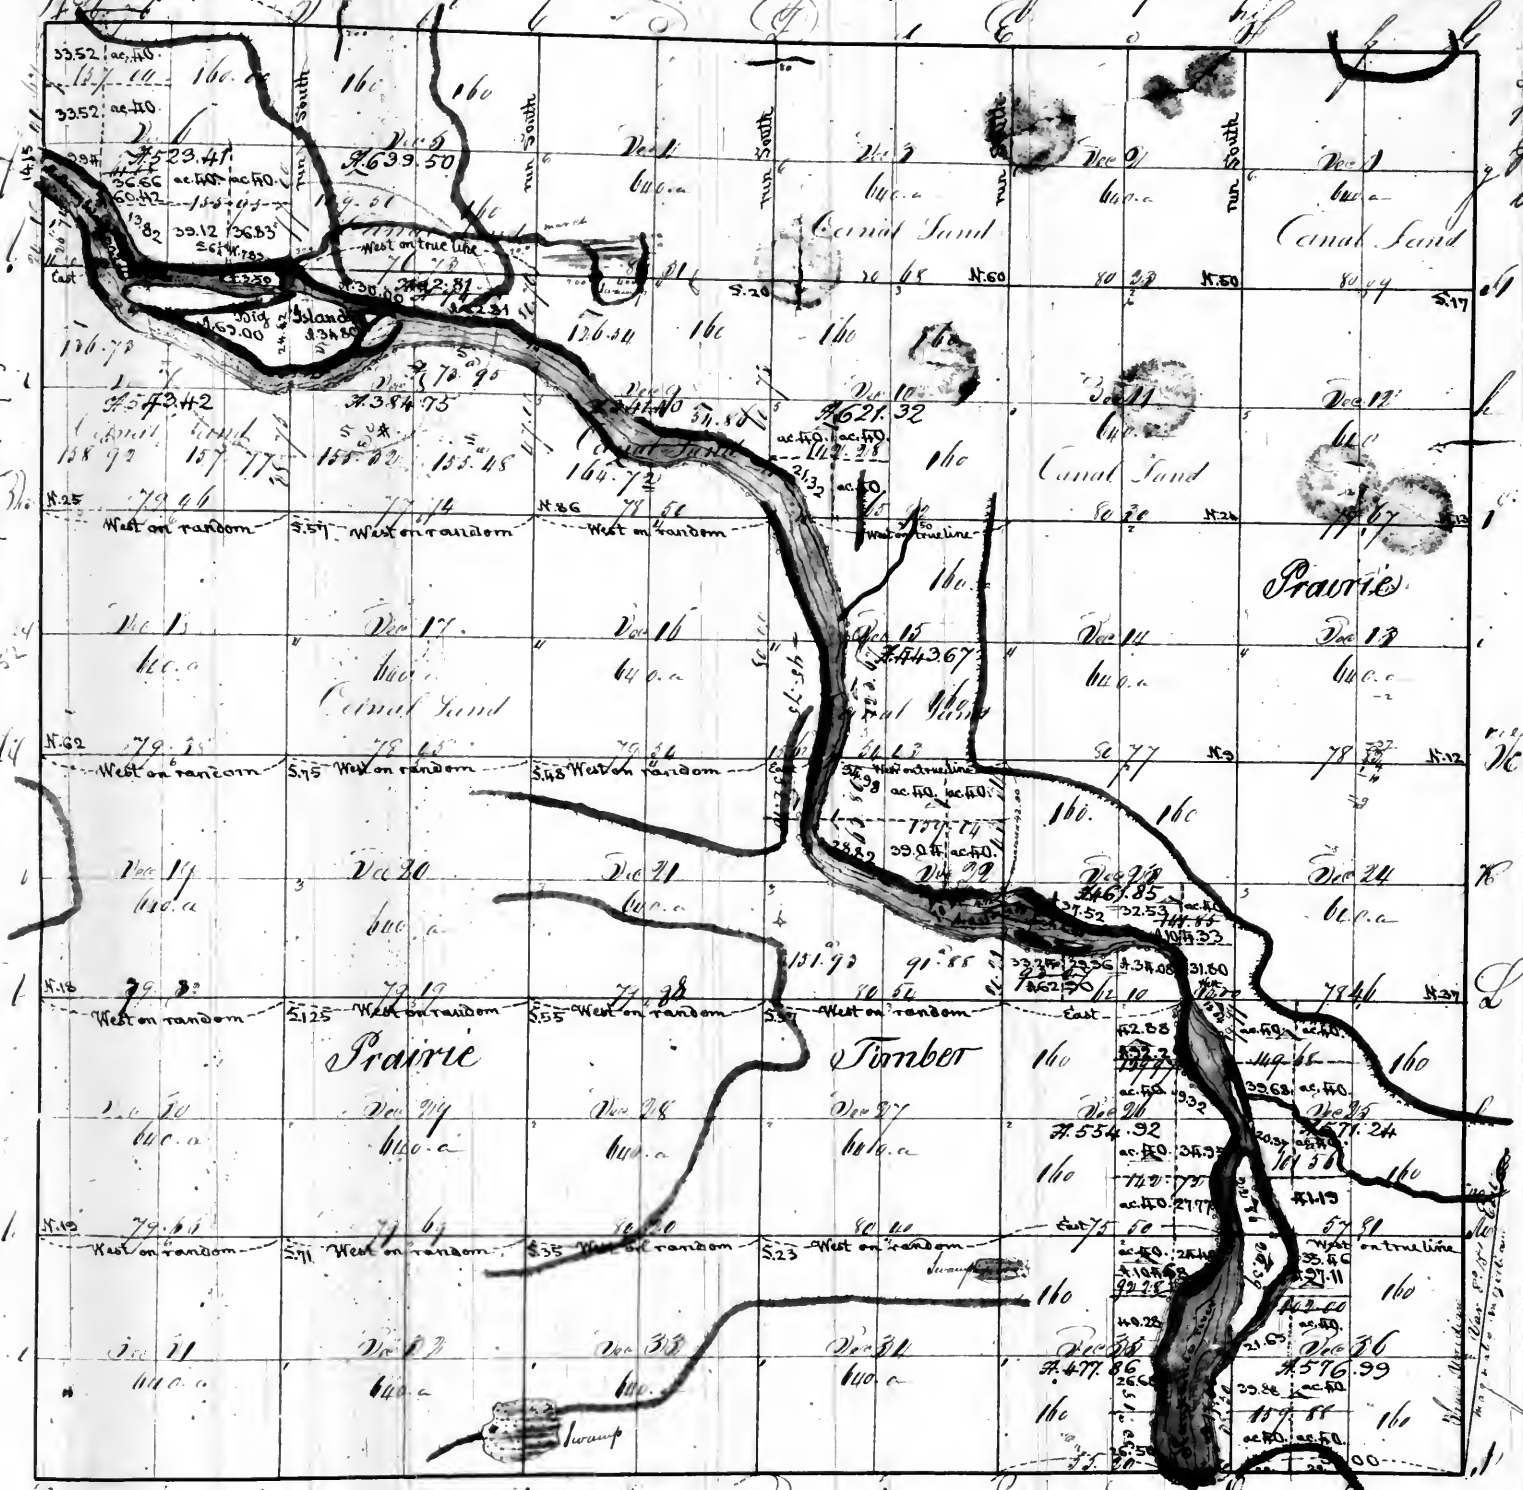

See instruction of the
18th of May 1846 to A.
J. Mathewson to survey
the island on beds 6, 7 & 8

Aggregate area of public land - 22060.16 acres
Estimated area of the river - 1000.00
Total - 23060.16 acres


In witness whereof, with and instructions from William Reiter Surveyor of the lands of the United States in the States of Illinois and Missouri and Territory of Arkansas bearing date the twentieth day of May A.D. 1846, we have advertised laid out and surveyed the above described Township and do hereby certify that it has been marked and bounded both natural and artificial as are represented on said plat and described in the field notes made thereof and returned with this plat into the office of the Surveyor of the Land of the United States in the States of Illinois and Missouri and Territory of Arkansas

Certified this 1st day of November 1846

Attest
Stephen Reiter D. Surveyor

Examined

 page 231 of 11

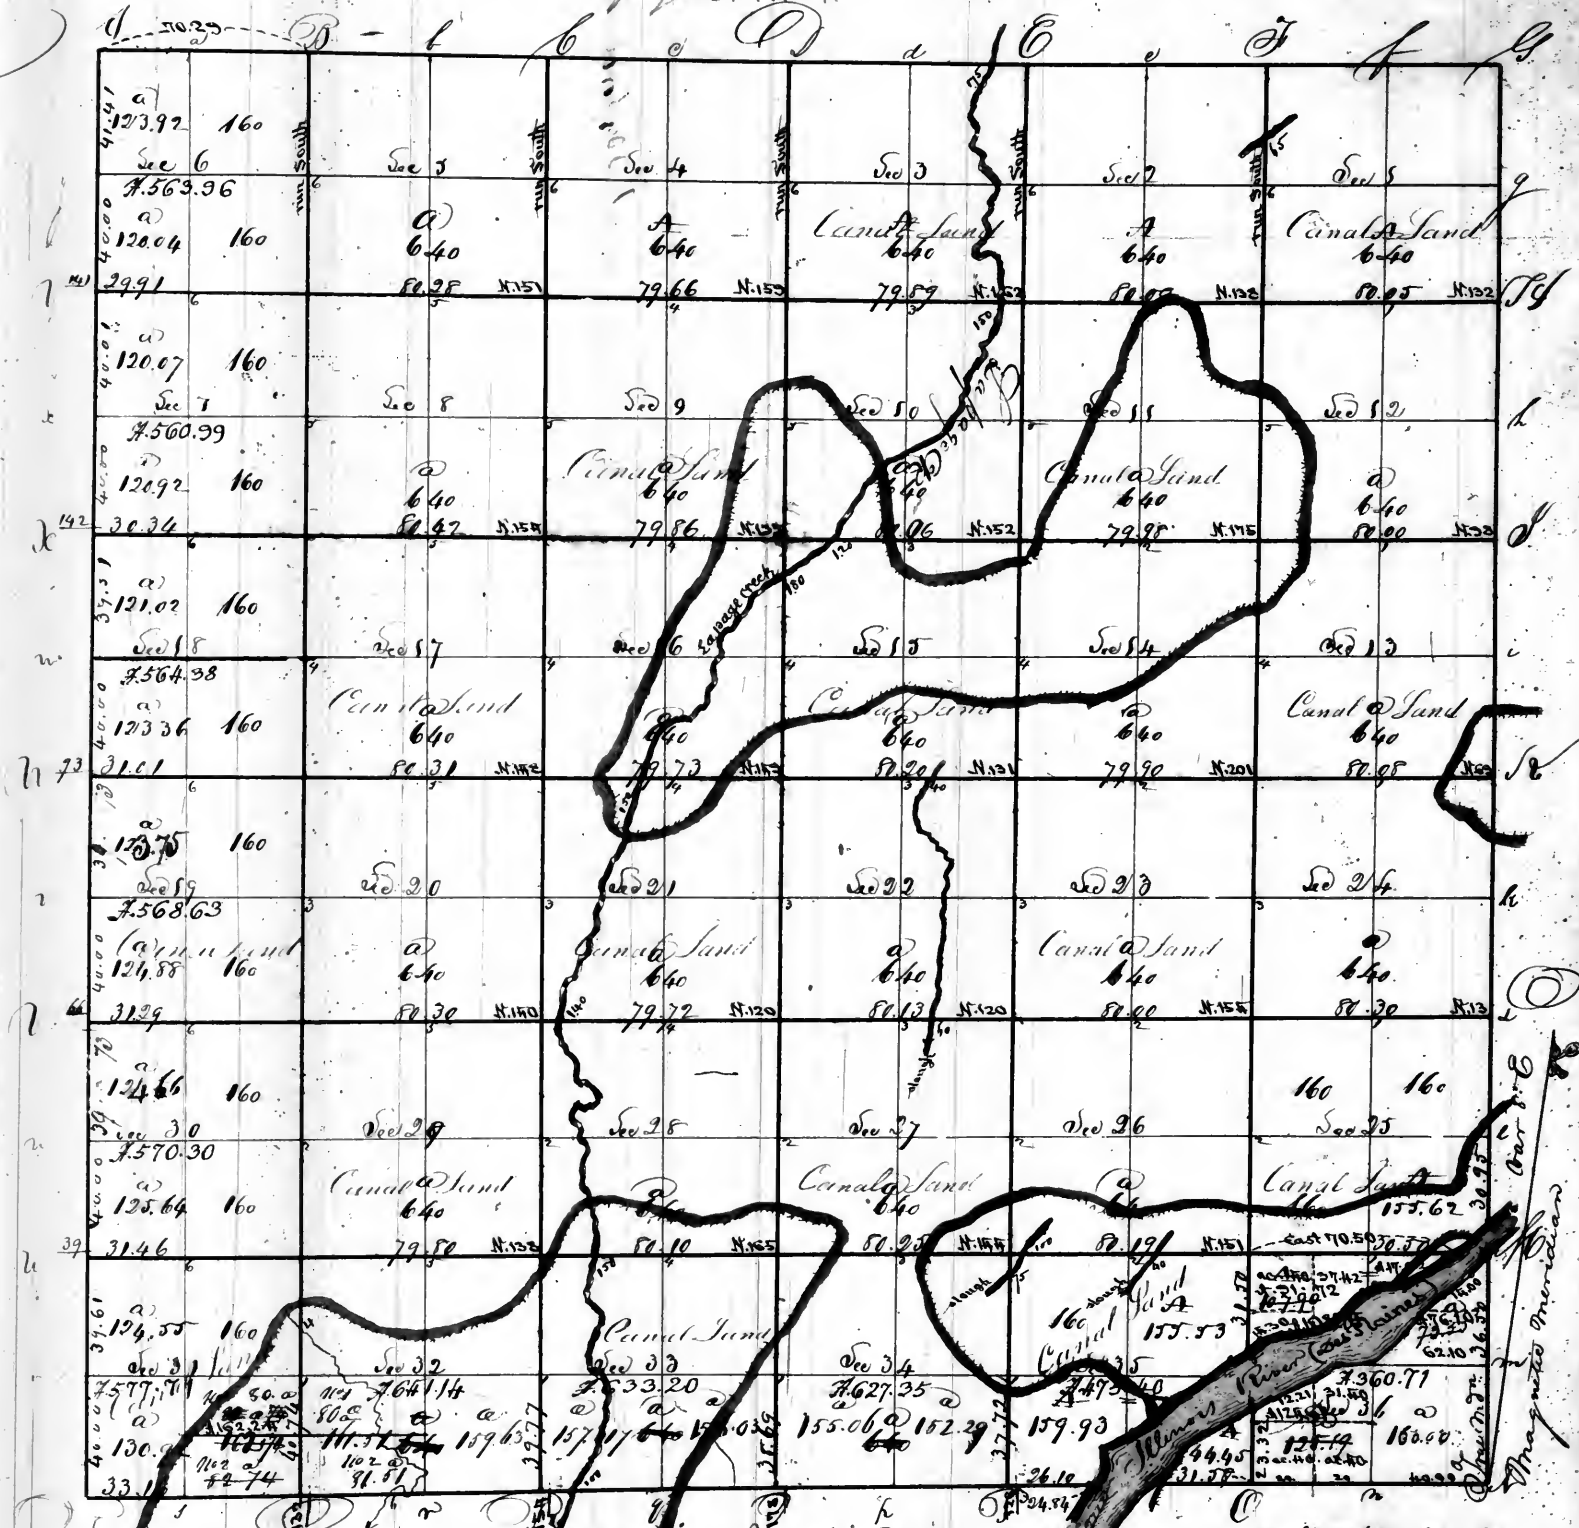


Aggregate area of public land = 22297.02 acres
 estimated area of the river = 320.00
 Total = 22617.02 acres

Scale of 40 Ch to an Inch

In pursuance to a contract with and instructions from William Victor Surveyor of the Lands of the United States in the States of Illinois, Missouri and Territory of Arkansas - bearing date the _____ day of March 1821
 I have admeasured, laid out & surveyed the above described Township, and do hereby certify that it had been marked and bounds both natural and artificial as are represented on said plat and described in the field notes made thereof, and returned with this plat into the Office of the Surveyor of the Lands of the United States for the States of Illinois, Missouri and Territory of Arkansas.
 Witness this _____ day of _____ 1822 by Wm. V. Victor, Surveyor.
 Examined

Township No 26 North of the Base line Range No 9 East of the 2^d Principal Meridian

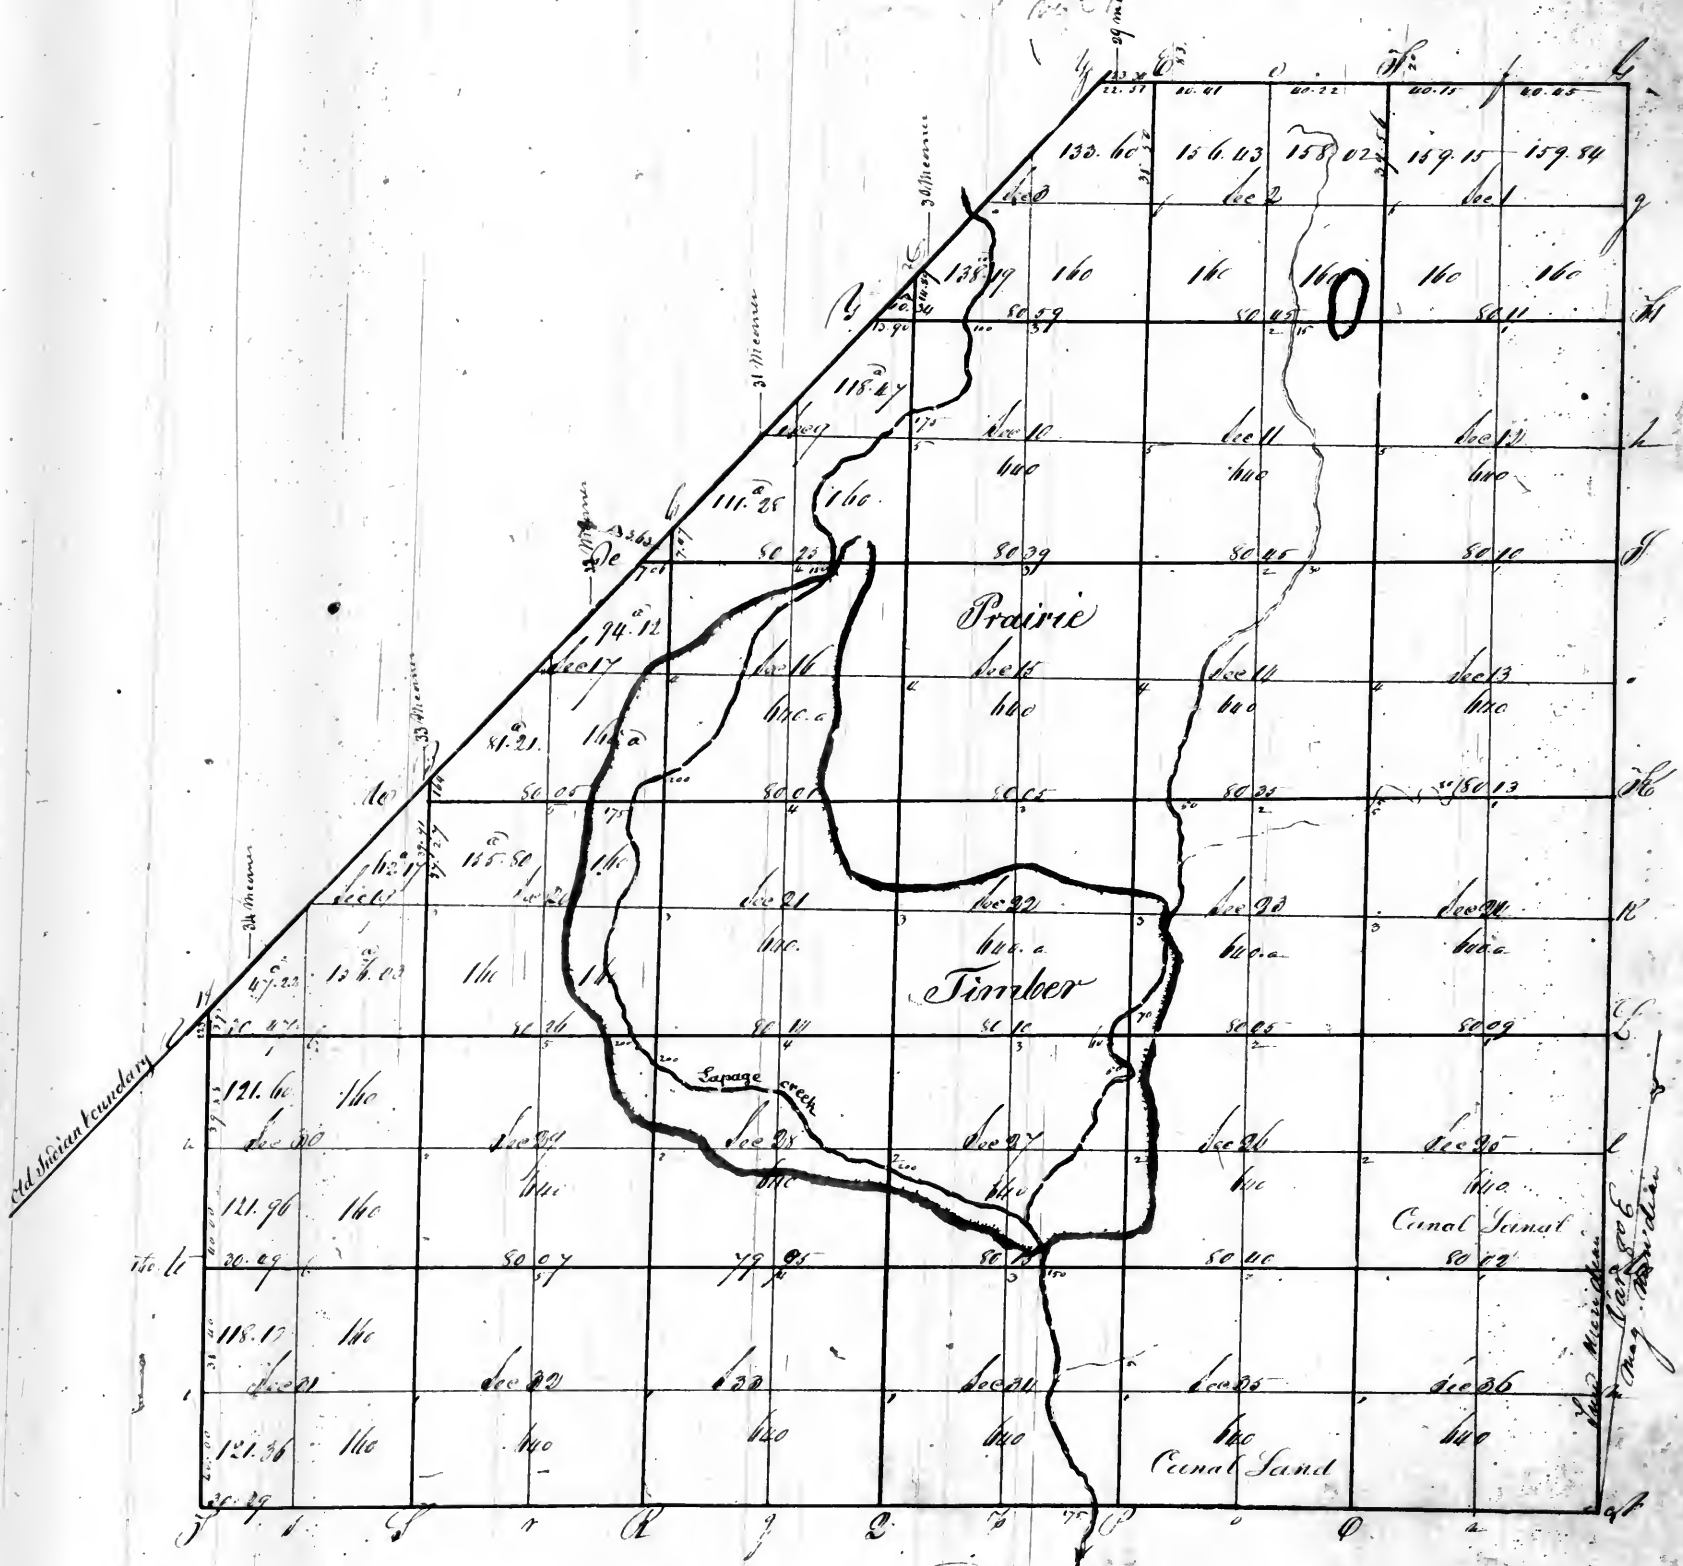


In pursuance to a contract with and instructions from William Porter Surveyor of the lands of the United States in the States of Illinois and Missouri and Territory of Arkansas bearing date the twentieth day of March 1821 I have surveyed and laid out and surveyed the above described Township and do hereby certify that it has been surveyed and bounded both natural and artificial as are represented on this plat and described in the field notes made thereof and returned with this plat into the office of the Surveyor of the lands of the United States in the States of Illinois and Missouri and Territory of Arkansas.

Certified this sixth day of November 1820
Examined

Deputy Surveyor

Township 2 North of the Base, Range No 10 East of the 3rd Principal Meridian
 Page 35 of 40
 551
 28

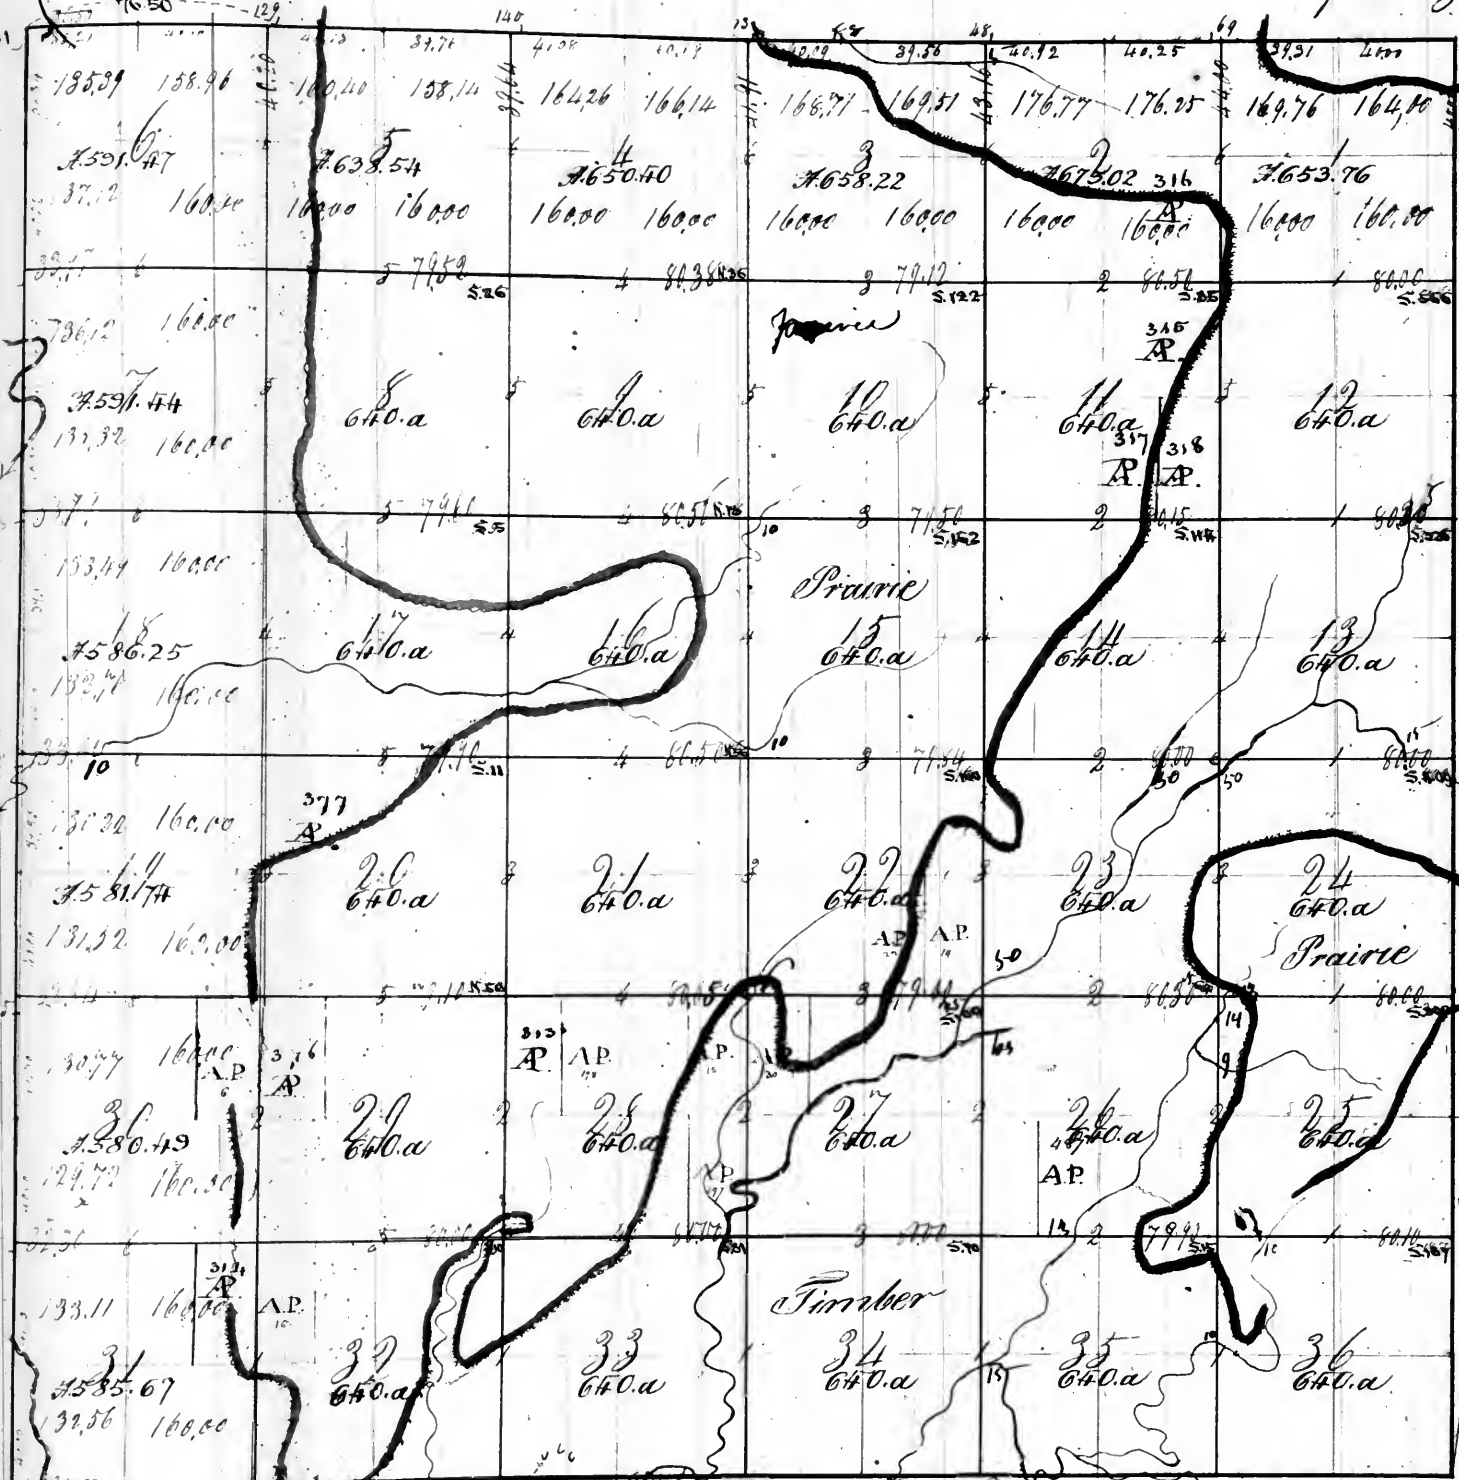


Aggregate area = 22791.00 acres

Pursuant to a contract with, and instructions from William Rector, Surveyor of the lands of the United States, in Illinois and Missouri, bearing date the tenth of November Eighteen hundred and Eighteen, I have admeasured, laid out and surveyed the above described Township, and do hereby certify that it has such marks and bounds as are represented on said Plat, and described in the file notes made thereof, and returned into the office of the surveyor of the lands of the United States for Illinois and Missouri-

James O. Whelan



552

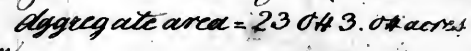

James G. Thomas

83.83
190E

85.00
159E

84.46
7E

83.15
57W

81.82
35W

Township 14 North of the Base line Range 16 E. of the Principal Meridian

553.




Aggregate area- 23103.43 acres



Pursuant to a contract with and instructions from William A. Rector, Surveyor of the lands of the United States in Illinois and Missouri, bearing date the tenth day of November one thousand eight hundred and eighteen I have admeasured laid out and surveyed the above described Township and do hereby certify that it had such marks and bounds as are represented on said Plat, and as described in the Field notes made thereof and returned with this Plat into the Office of the Surveyor of the lands of the United States for Illinois and Missouri.

James D. Thomas



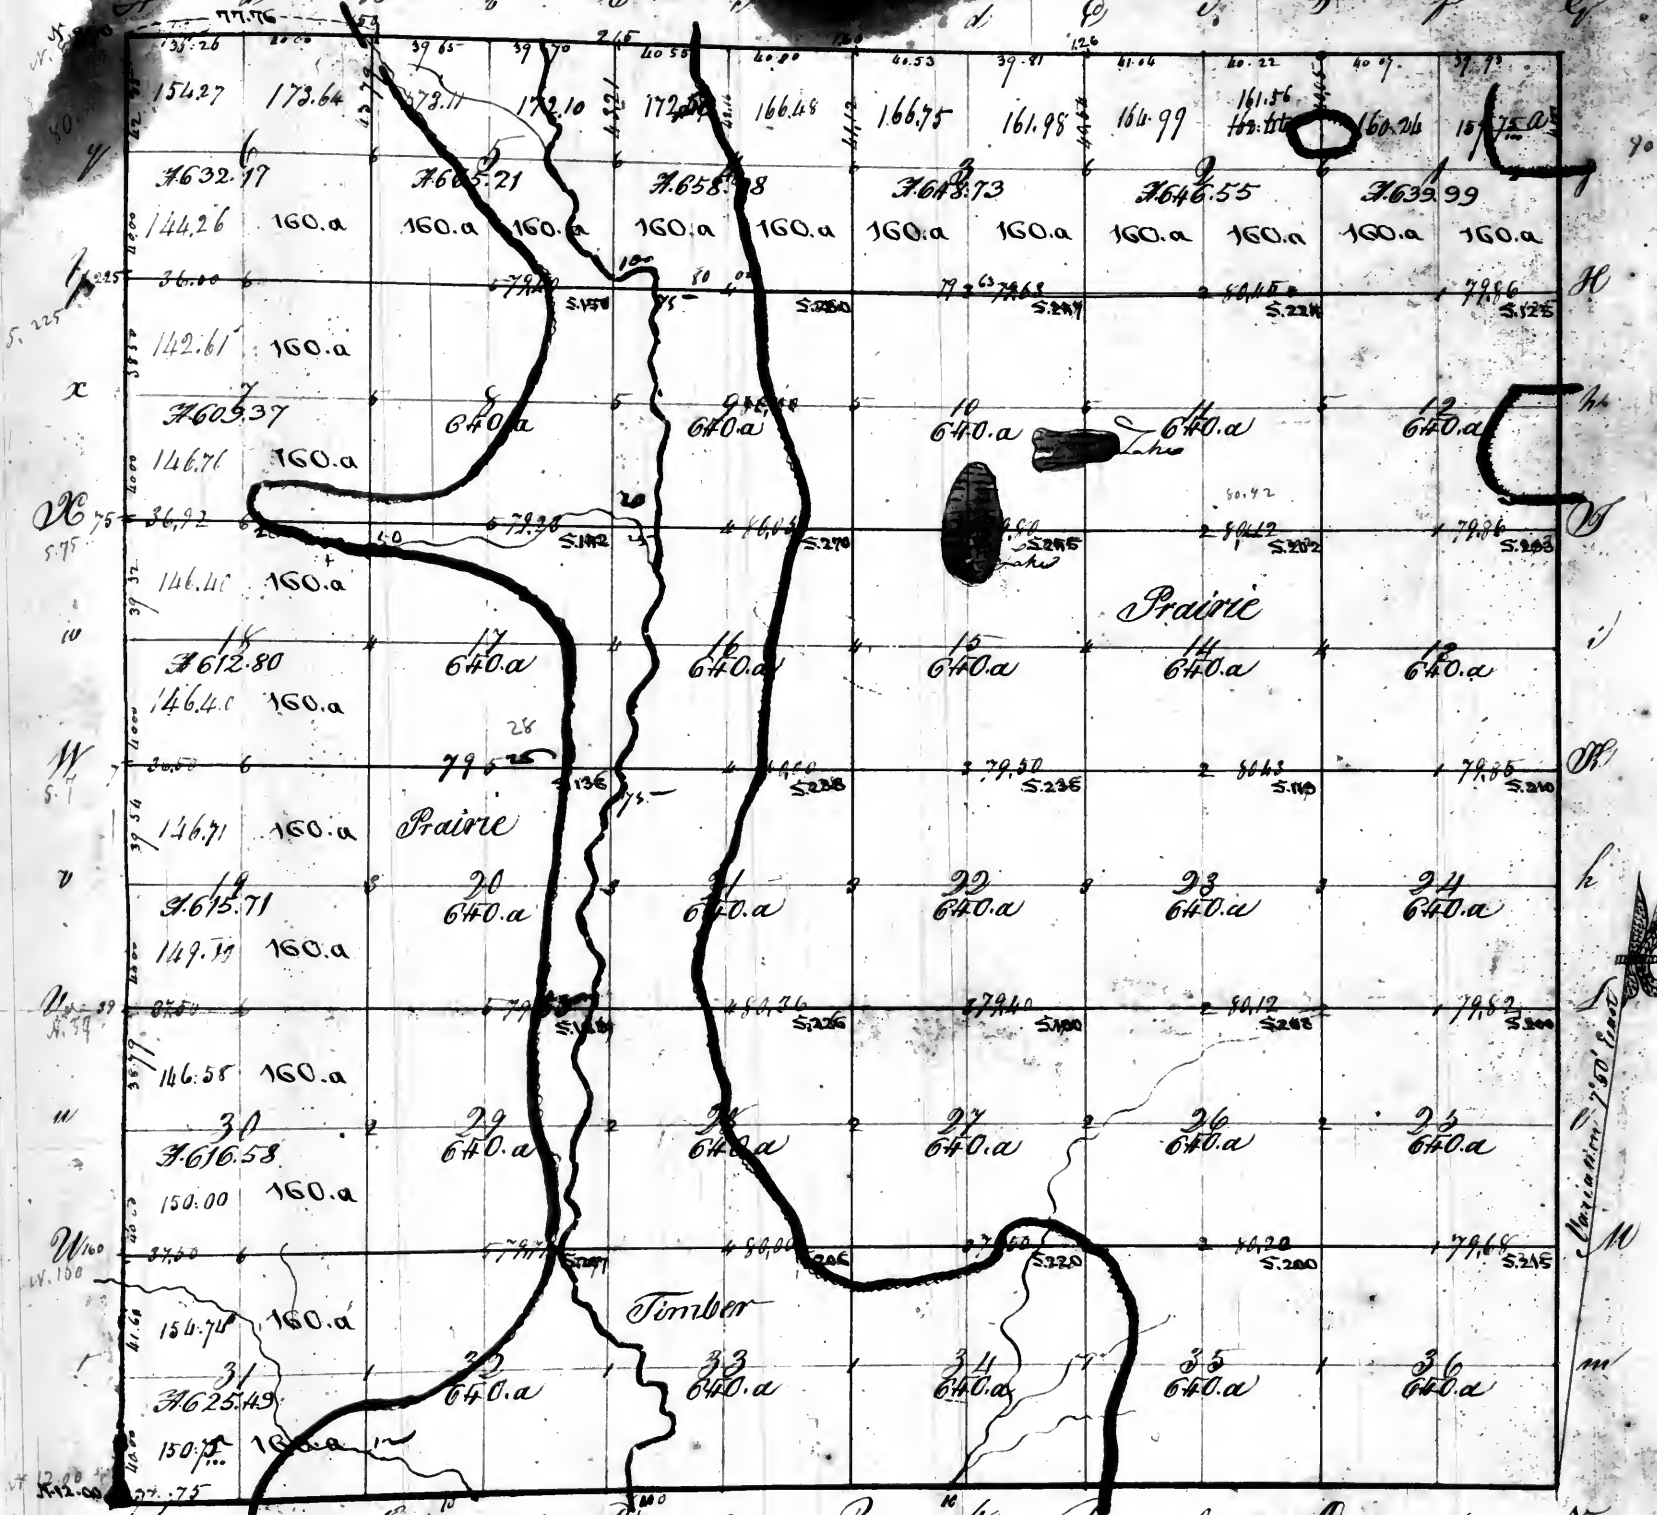

Aggregate area = 22971.58 acres

Pursuant to a contract with and instructions from William Reister
 Surveyor of the Lands of the United States in Illinois and Missouri
 bearing date the tenth of November one thousand eight hundred and
 eighteen I have admeasured laid out and Surveyed the above described Township and do hereby certify that it has
 such marks and bounds as are represented on said Plat and described in the field notes made thereof and returned with
 this Plat into the office of the Surveyor of the Lands of United States for Illinois and Missouri


Scale of 40 Chains to an Inch

20	40	60	80	100	120
----	----	----	----	-----	-----

20	40	60	80	100	120
----	----	----	----	-----	-----

James D Thomas

Township No. *14* North of the base line, Range No. *10* East of the Third principal Meridian.

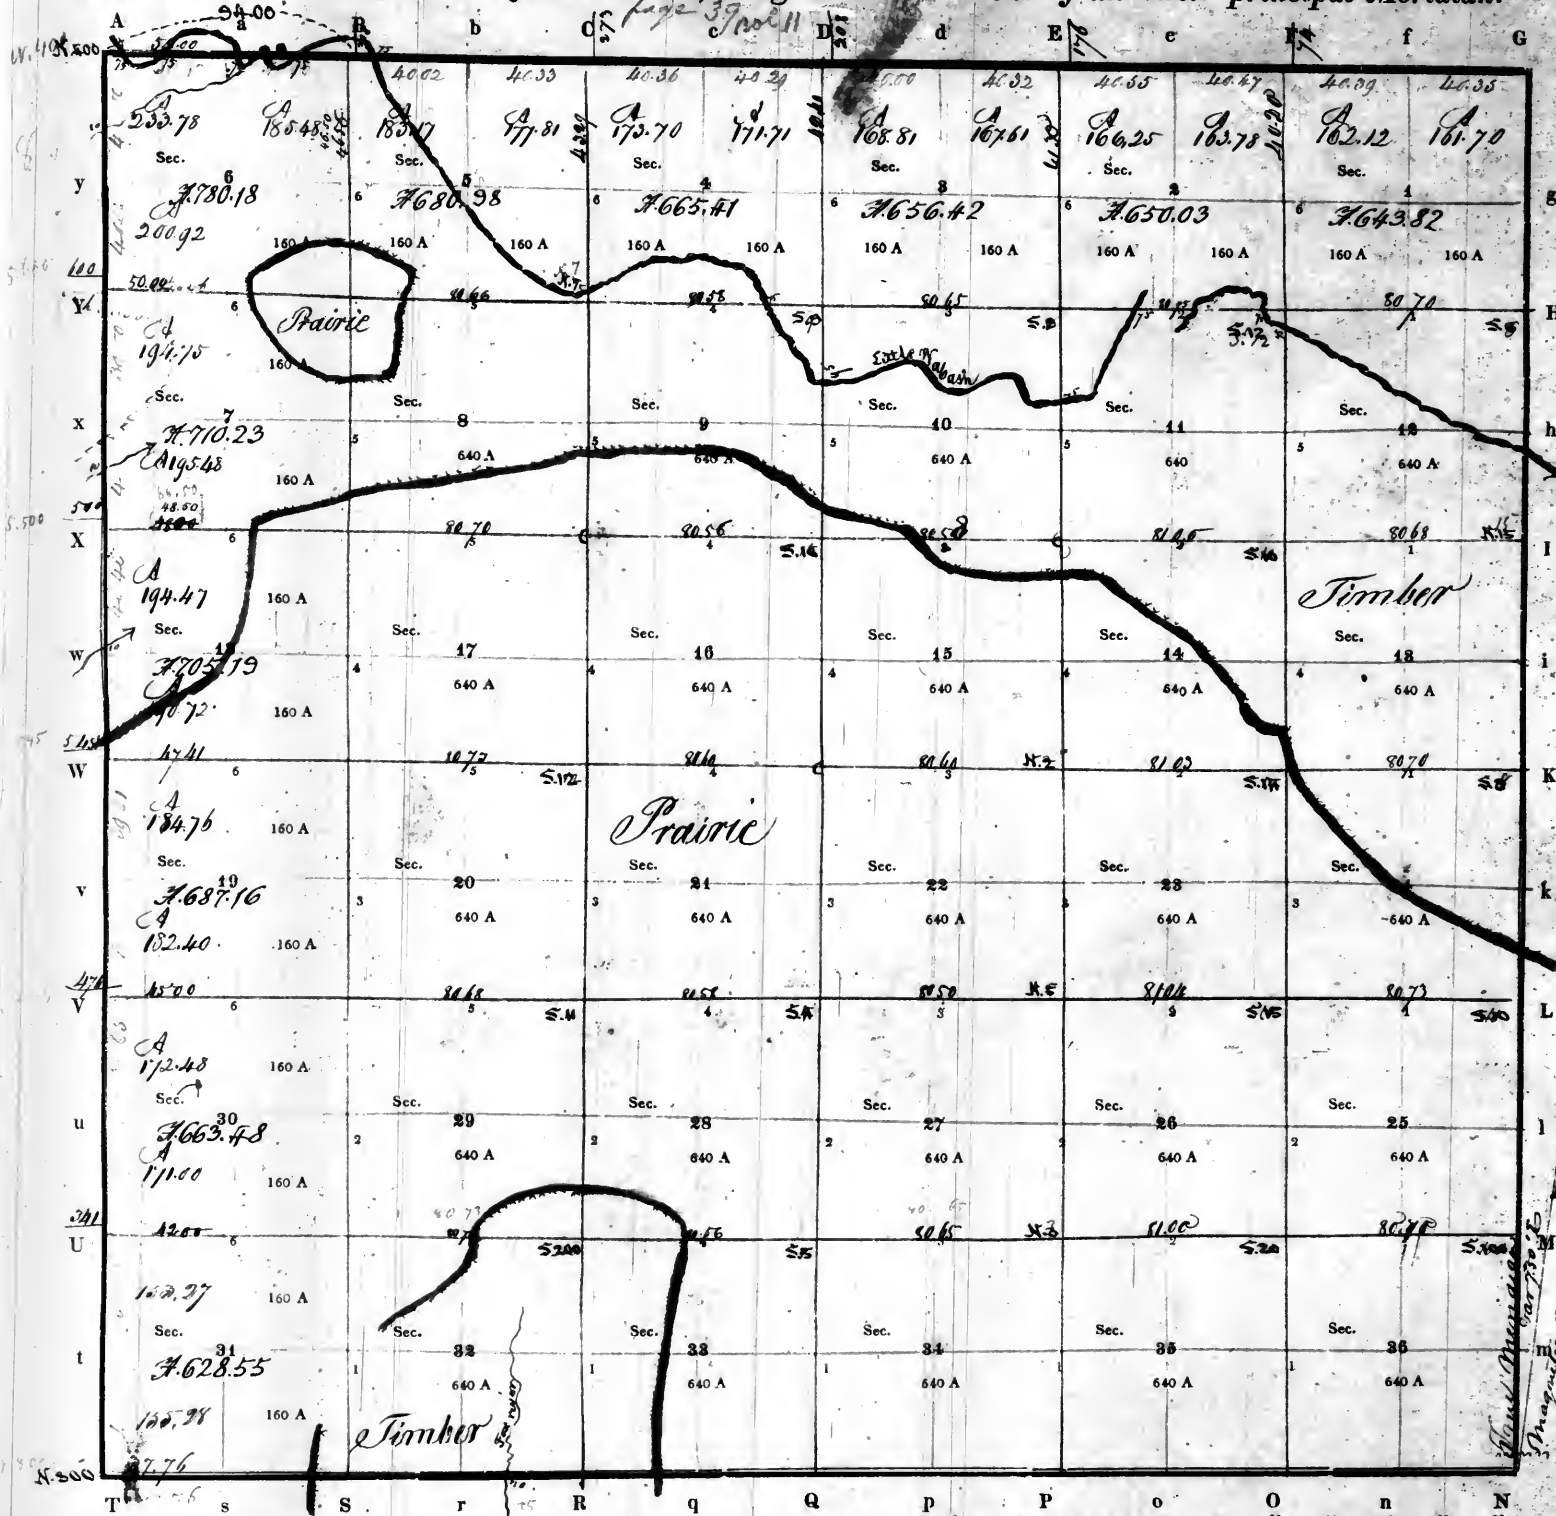

Aggregate area = 23471.45 acres

Scale of 40 Chains to an inch.

PURSUANT to a contract with, and instructions from WILLIAM RECTOR, Surveyor of the lands of the United States in the bearing date the day of


I have measured, laid out and surveyed the above described Township; and do hereby certify, that it had such marks and bounds, both natural and artificial, as are represented on said plat, and described in the field notes made thereof, and returned with this plat into the Office of the Surveyor of the lands of the United States, for the

Certified this day of

EXAMINED.

D. SURVEYOR.

Township No. *Seven North* of the base line, Range No. *Ten East* of the *Third* principal Meridian.

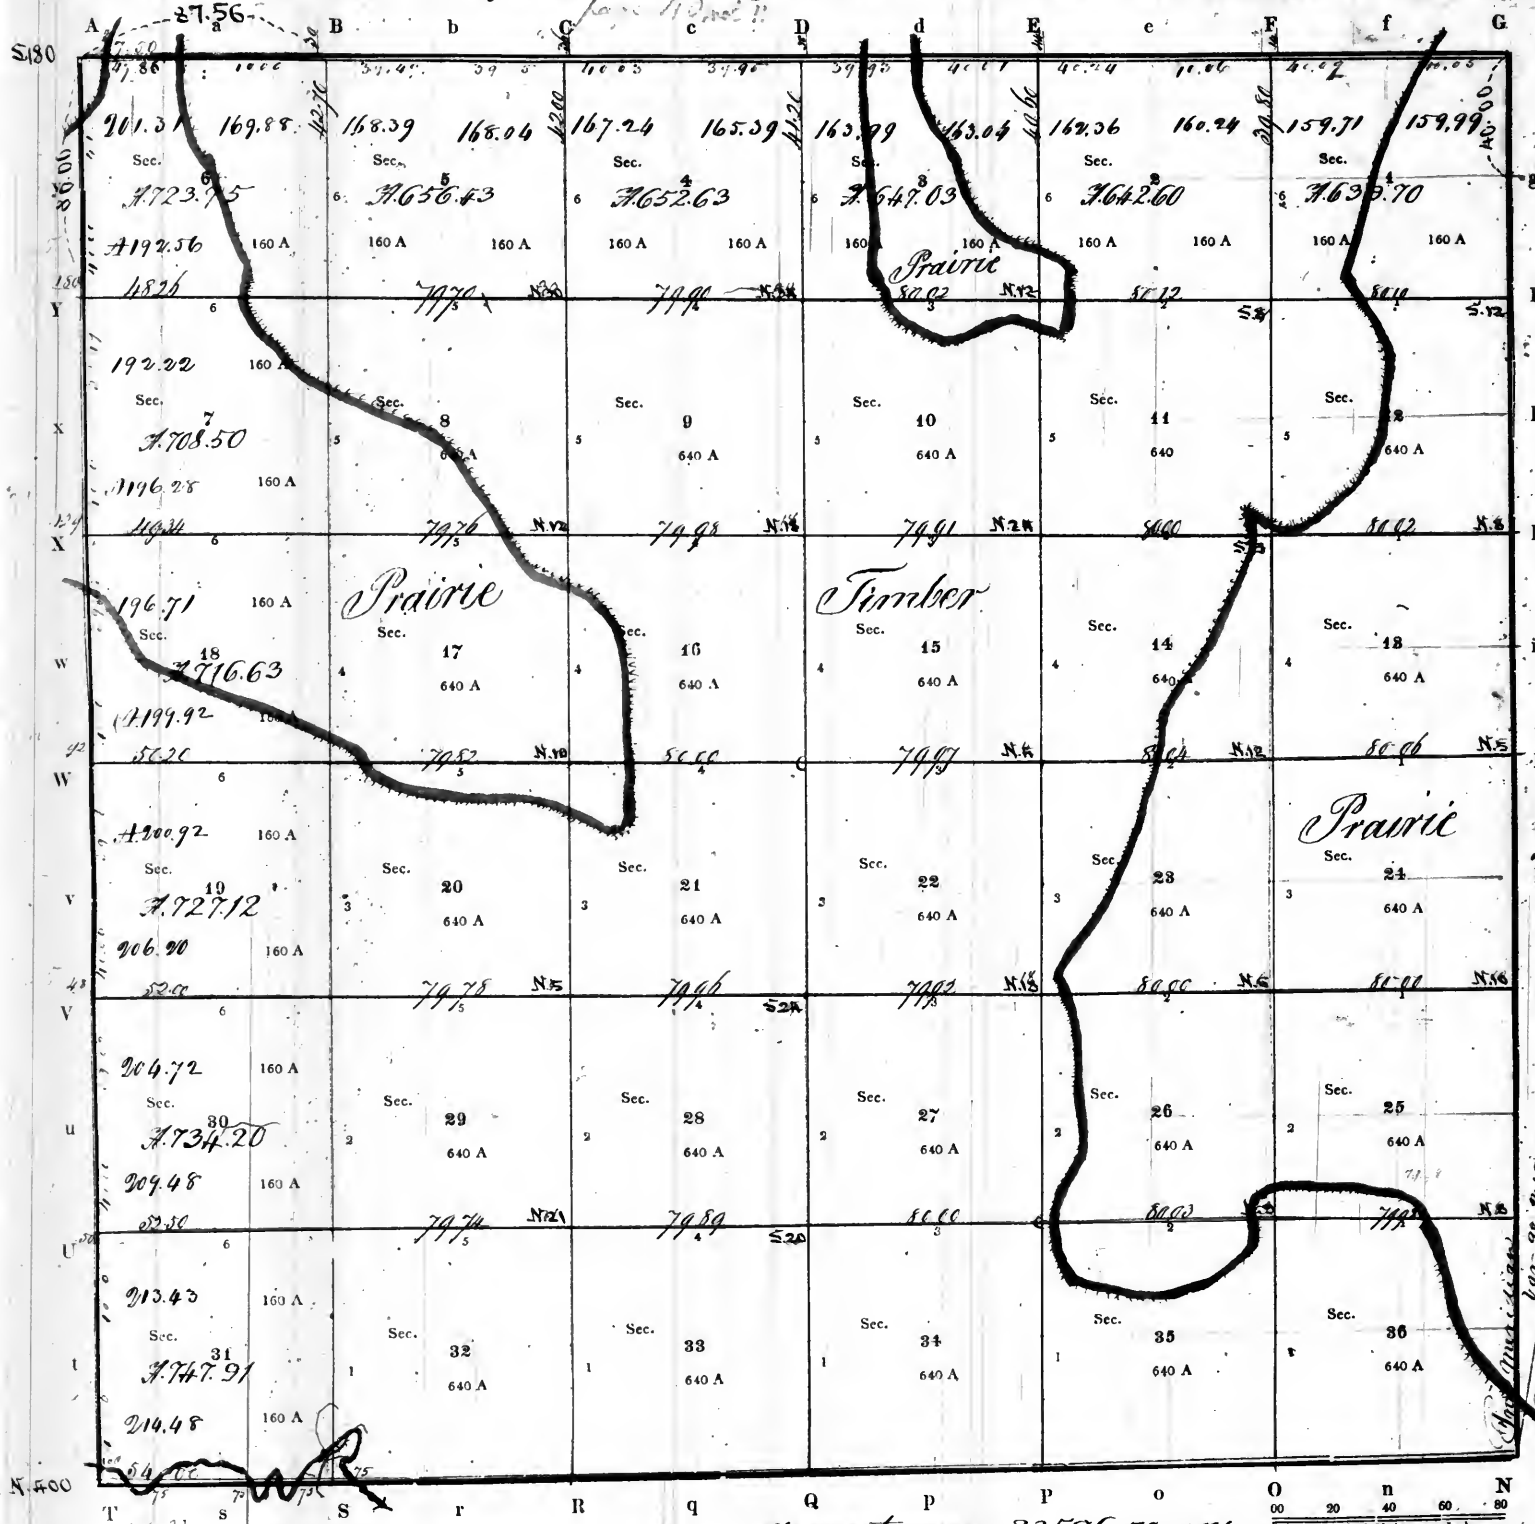

Aggregate area - 23596.50 acres

Scale of 40 Chains to an Inch.

PURSUANT to a contract with, and instructions from WILLIAM RECTOR, Surveyor of the lands of the United States in the State of Illinois, bearing date the _____ day of _____

I have admeasured, laid out and surveyed the above described Township; and do hereby certify, that it had such marks and bounds, both natural and artificial, as are represented on said plat, and described in the field notes made thereof, and returned with this plat into the Office of the Surveyor of the lands of the United States, for the State of Illinois and Territories of Wisconsin and Arkansas


Certified this _____ day of _____

D. SURVEYOR.

EXAMINED.

Filed - 1880

Township No. 8 North of the base line, Range No. 10 East of the third principal Meridian.

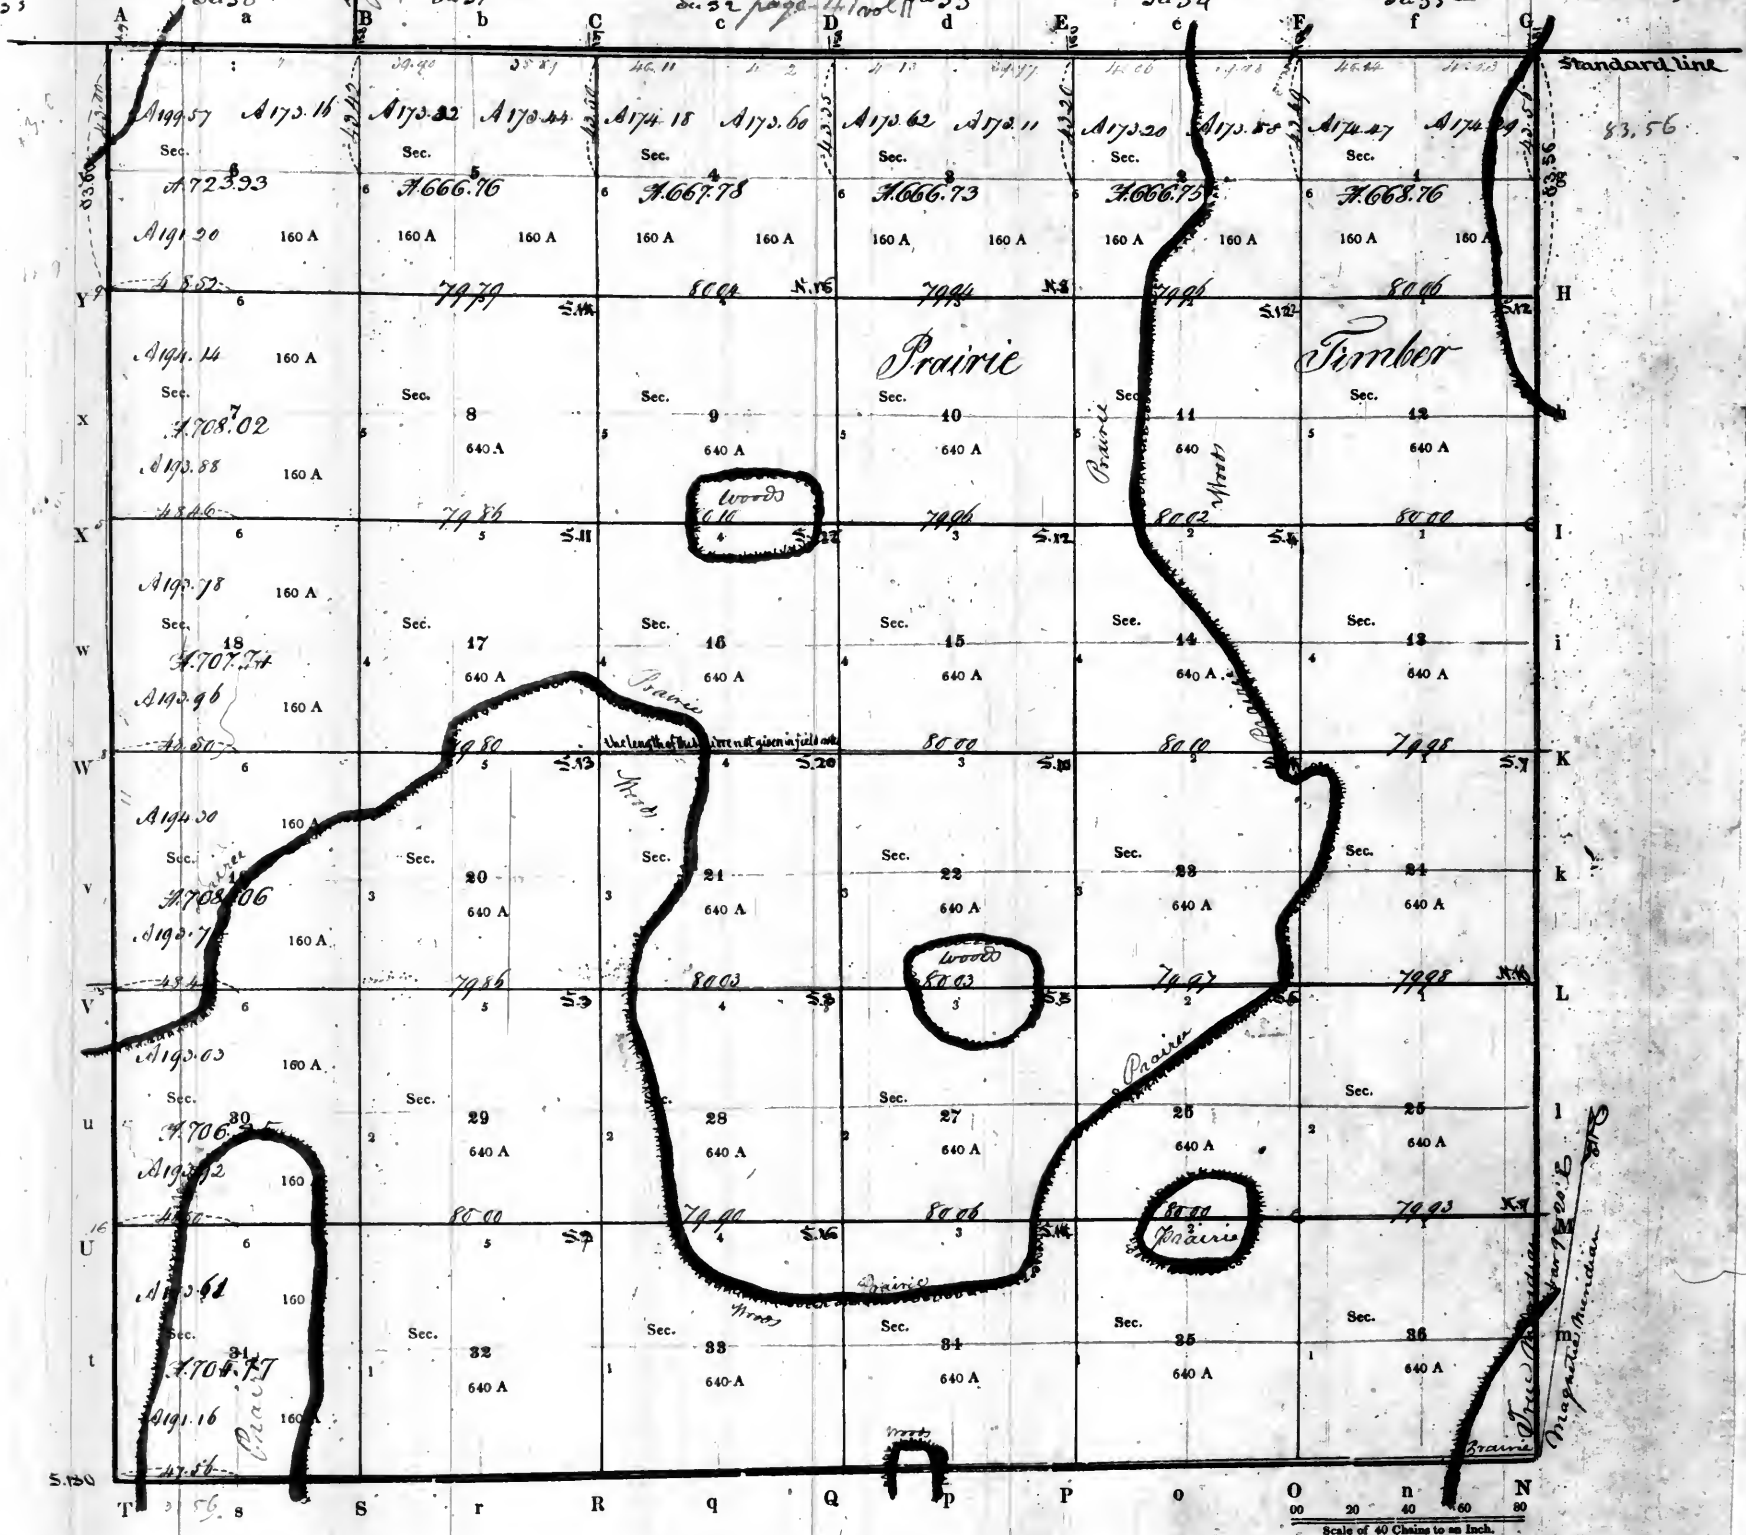

PURSUANT to a contract with, and instructions from WILLIAM RECTOR, Surveyor of the lands of the United States in the State of Illinois and Territories of Missouri and Arkansas bearing date the _____ day of _____

I have admeasured, laid out and surveyed the above described Township; and do hereby certify, that it had such marks and bounds, both natural and artificial, as are represented on said plat, and described in the field notes made thereof, and returned with this plat into the Office of the Surveyor of the lands of the United States, for the State of Illinois and Territories of Missouri and Arkansas


Certified this _____ day of _____

D. SURVEYOR

EXAMINED,

558.

Township No. *Nine North* of the base line, Range No. *Two East* of the *third* principal Meridian.

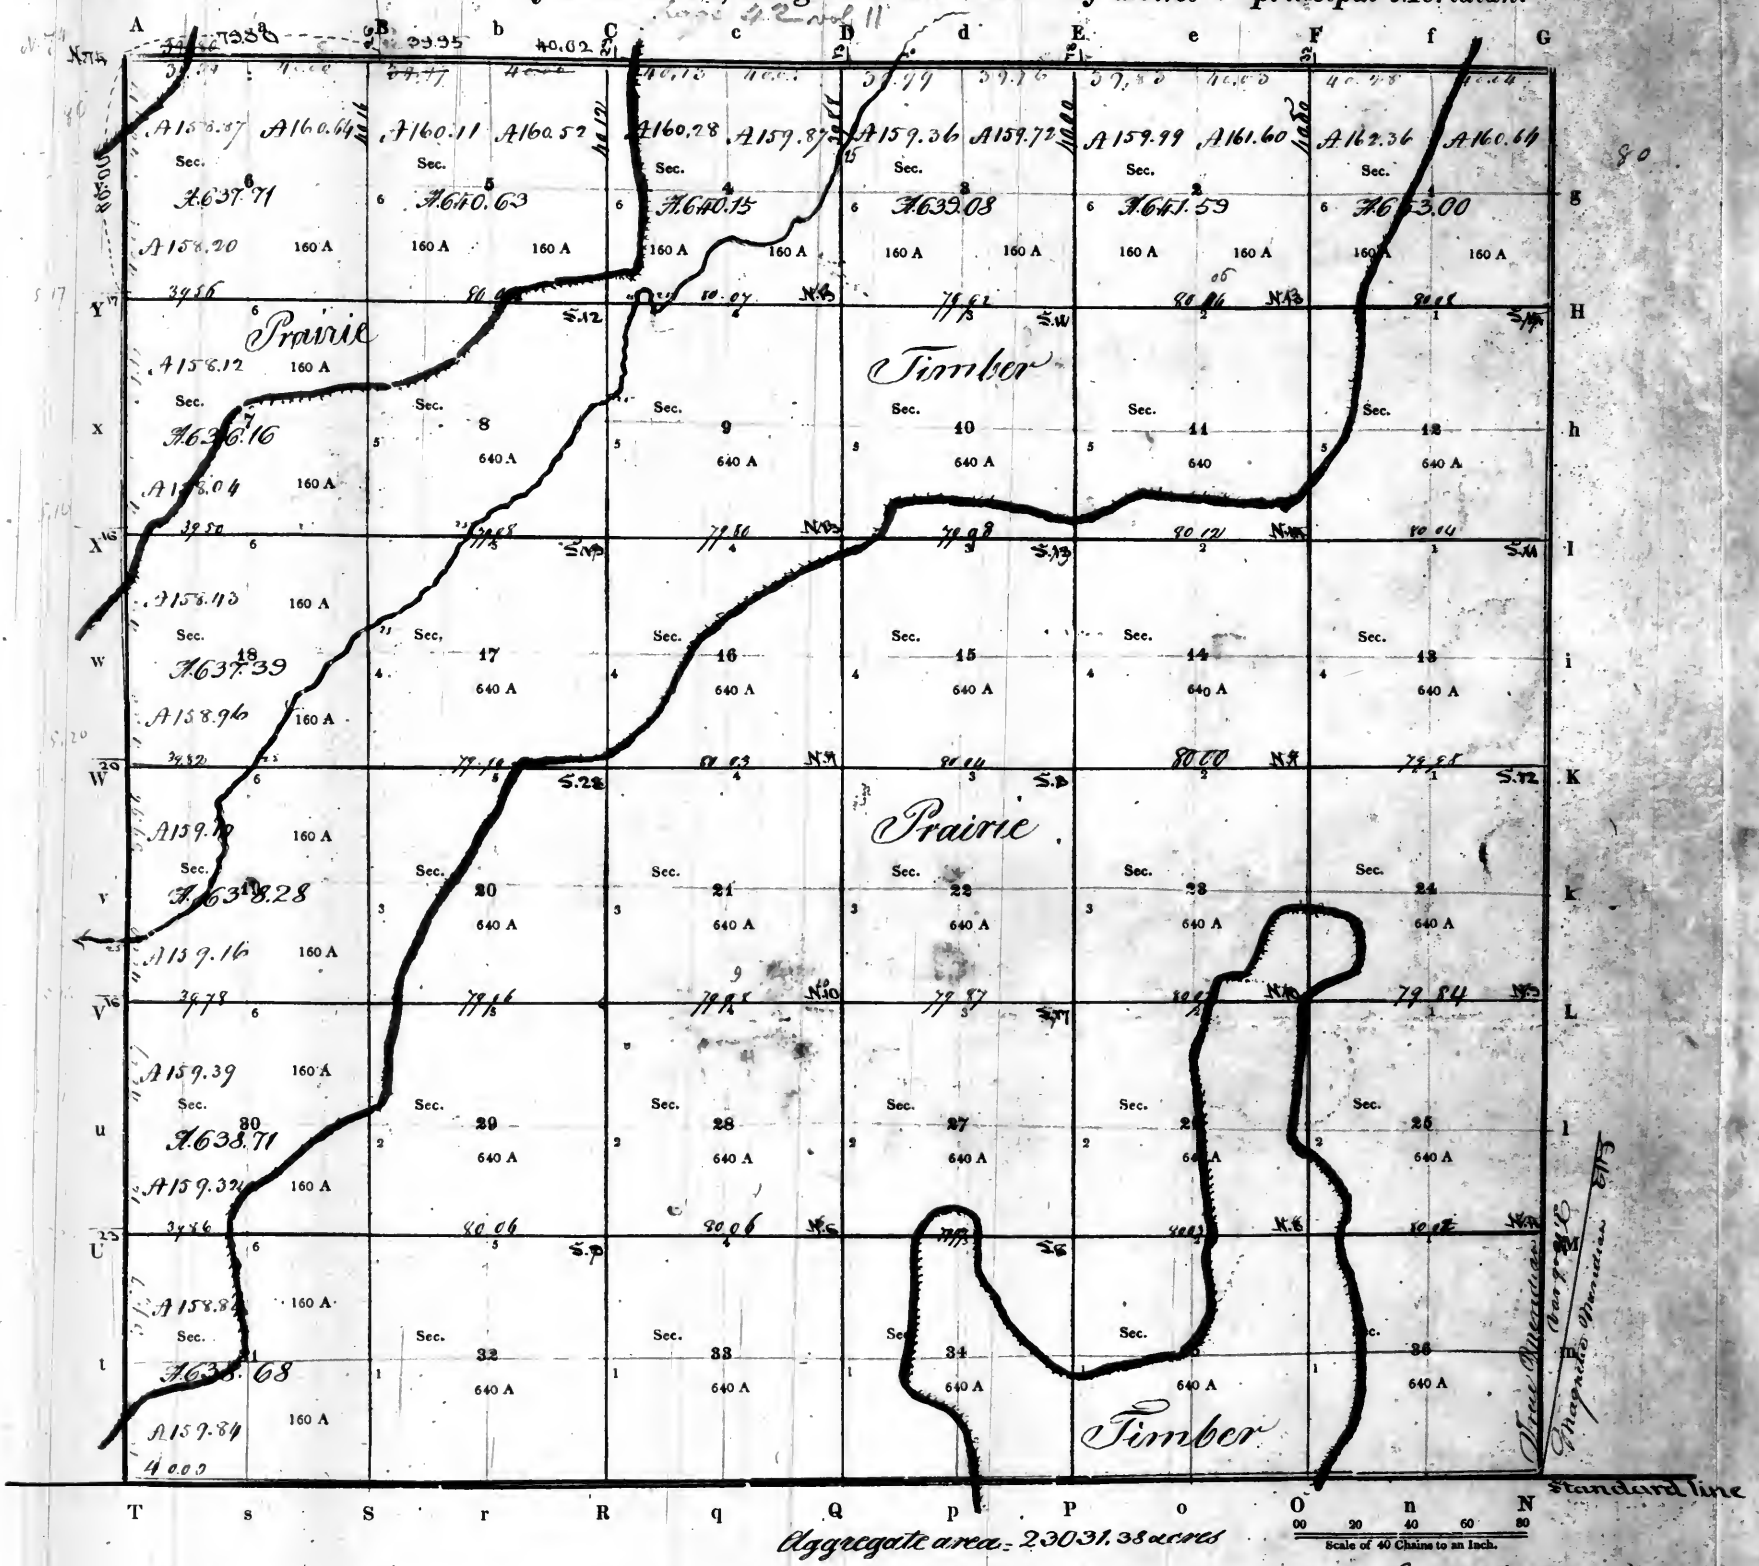

PURSUANT to a contract with, and instructions from WILLIAM RECTOR, Surveyor of the lands of the United States in the *State of Illinois* and *territories of Mississippi and Arkansas* bearing date the _____ day of _____

I have admeasured, laid out and surveyed the above described Township; and do hereby certify, that it had such marks and bounds, both natural and artificial, as are represented on said plat, and described in the field notes made thereof, and returned with this plat into the Office of the Surveyor of the lands of the United States, for the *State of Illinois and territories of Mississippi and Arkansas*

Certified this _____ day of _____


D. SURVEYOR

EXAMINED.

July 1896

559.

Township No. Ten North of the base line, Range No. Ten East of the third principal Meridian.

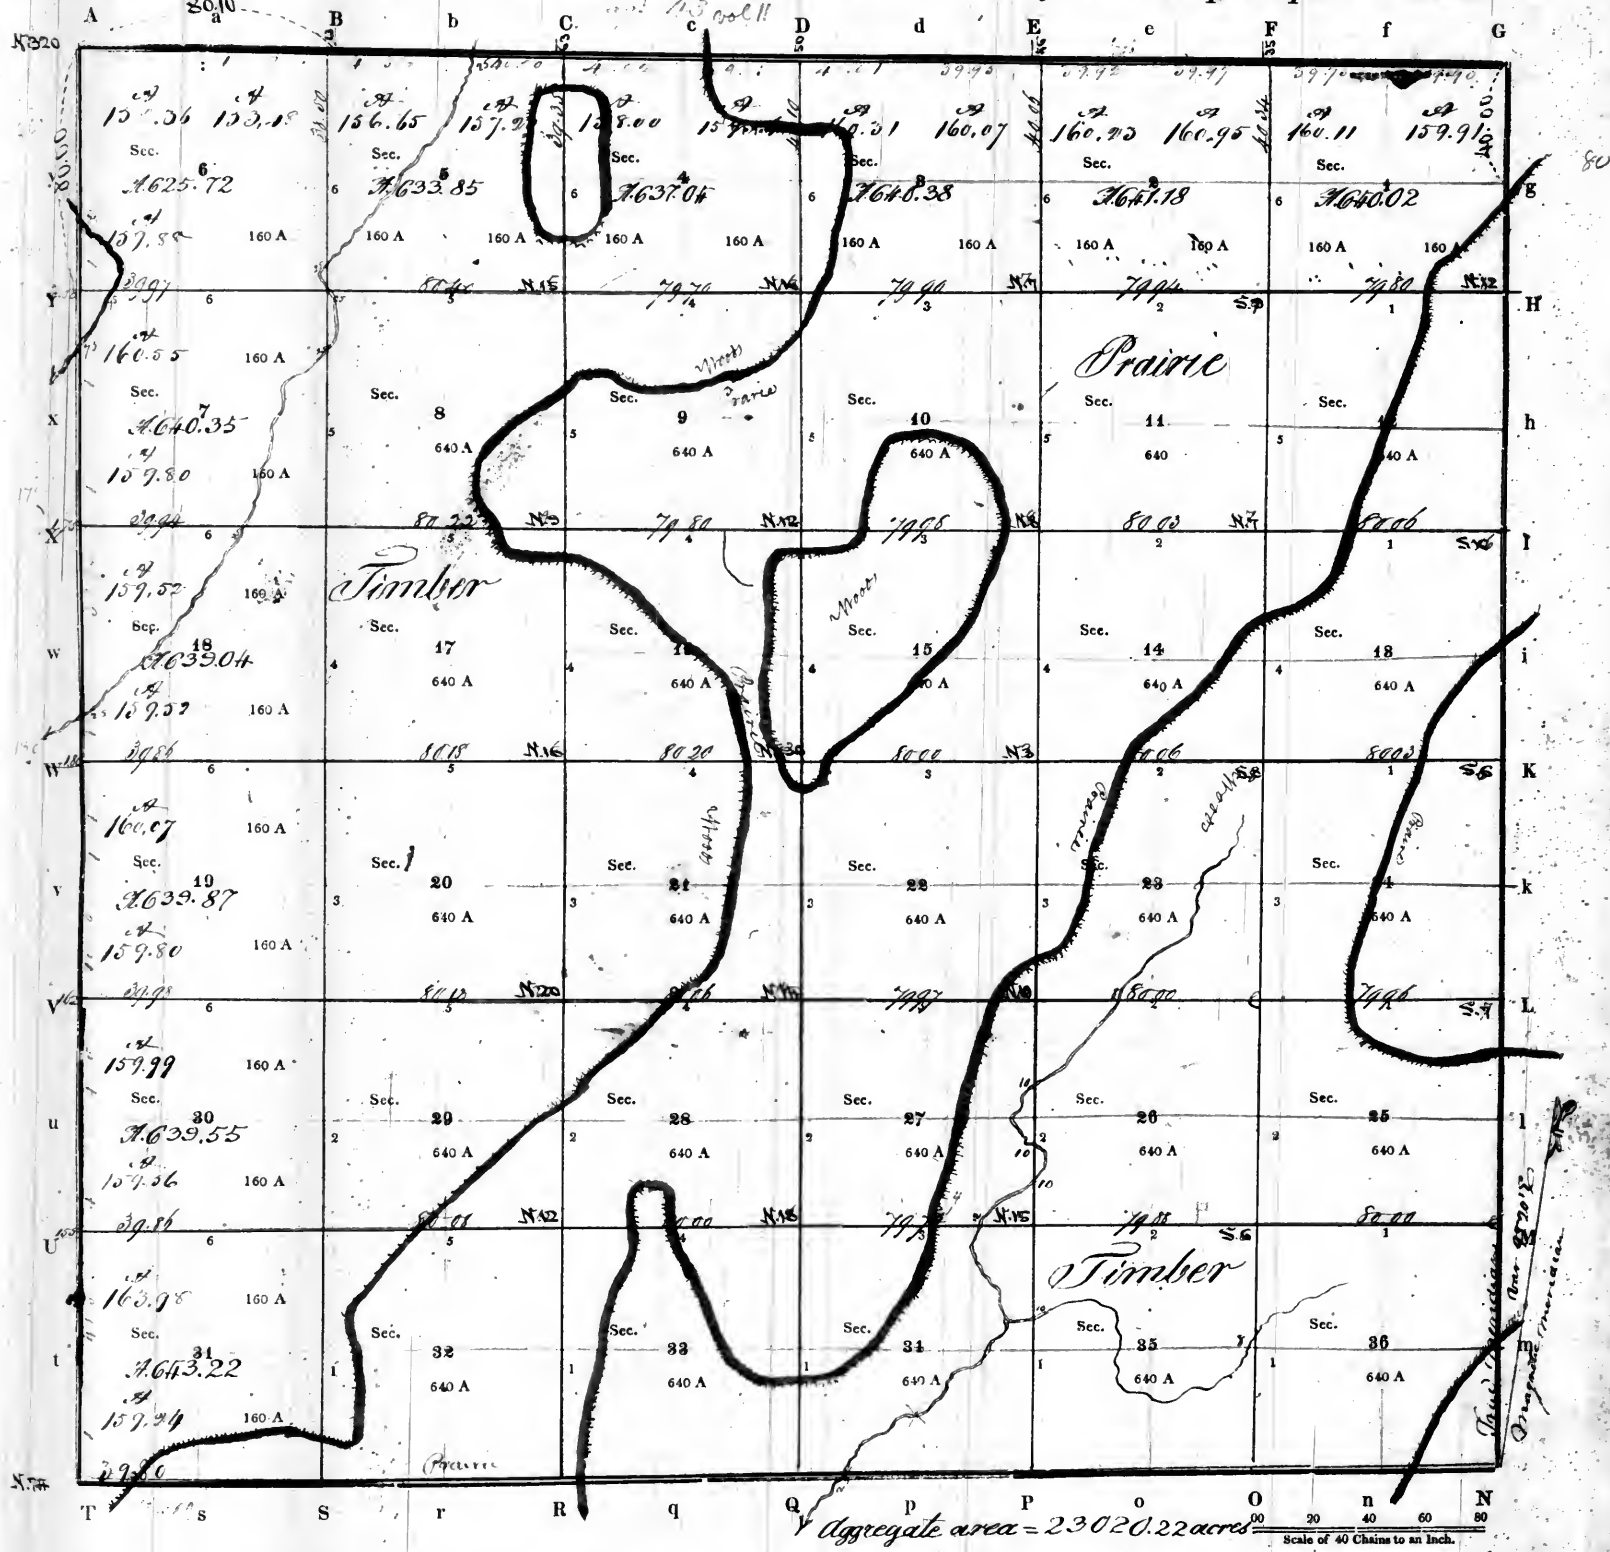

PURSUANT to a contract with, and instructions from WILLIAM RECTOR, Surveyor of the lands of the United States in the State of Illinois, and Territories of Missouri and Arkansas, bearing date the _____ day of _____

I have admeasured, laid out and surveyed the above described Township; and do hereby certify, that it had such marks and bounds, both natural and artificial, as are represented on said plat, and described in the field notes made thereof, and returned with this plat into the Office of the Surveyor of the lands of the United States, for the State of Illinois and Territories of Missouri and Arkansas.


Certified this _____ day of _____

EXAMINED.

Surveyed by *Arthur L. Smith* D. SURVEYOR.
July 1820

Township N. 11 N. of the Base line, Range E. 10 E. of the 3rd Principal Meridian.

Page 44 vol 11

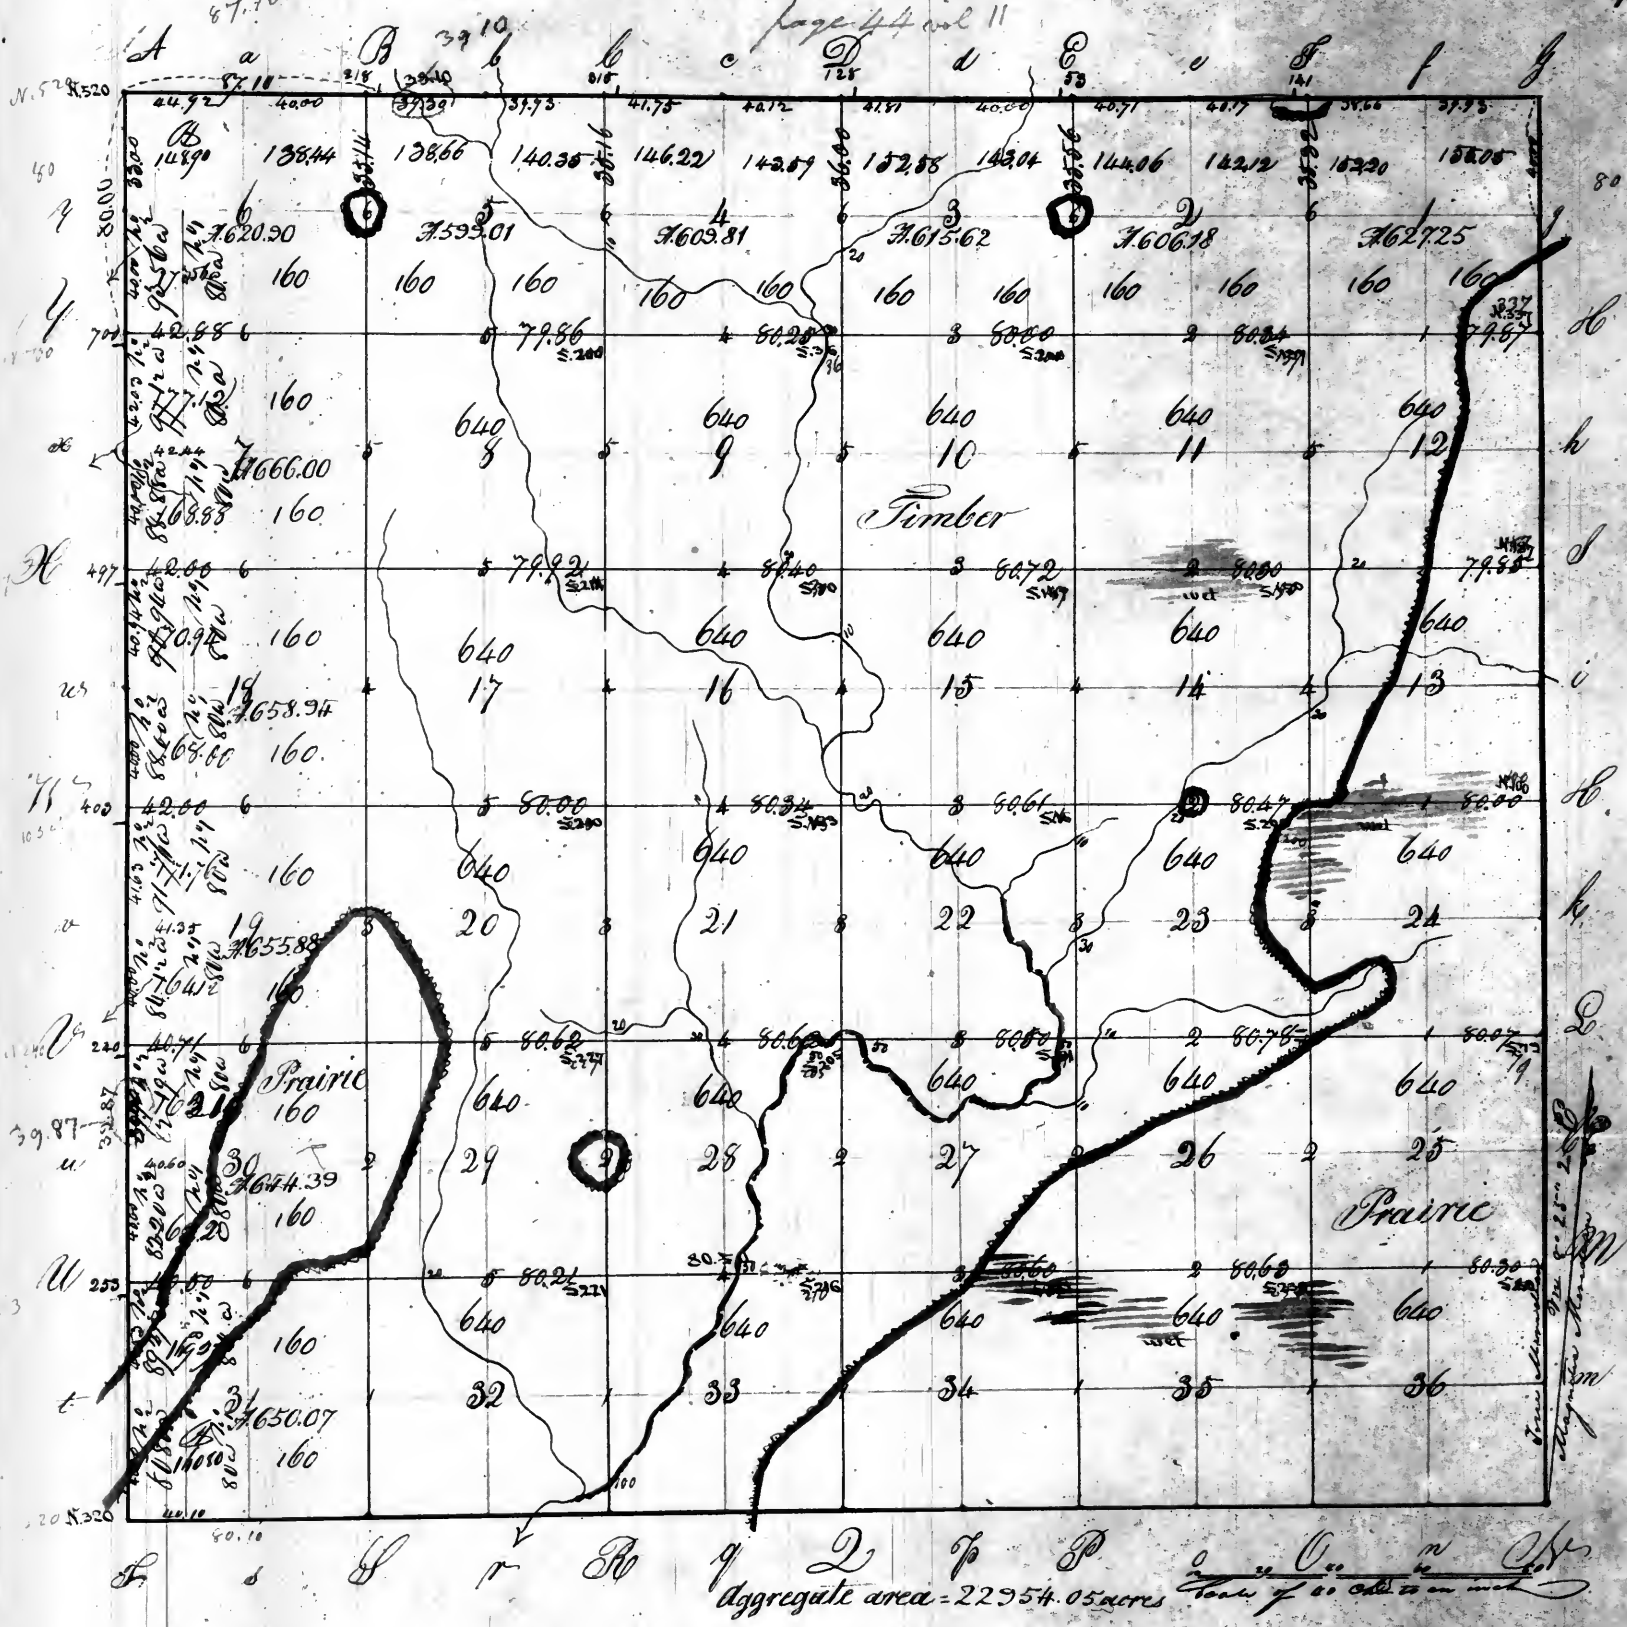

Pursuant to a contract with, and instructions from William Bector, surveyor of the lands of the United States of America, in the States of Illinois and Missouri, and the Territory of Arkansas, bearing date the ninth day of April, in the year of our Lord, one thousand eight hundred and twenty one, I have admeasured, laid out and surveyed the above described township, and do hereby certify, that it had such marks and bounds, both natural and artificial, as are represented on said Plat, and described in the field notes taken thereof, and returned with this Plat into the office of the surveyor of the lands of the United States, for the States of Illinois and Missouri, and for the Territory of Arkansas.

Certified this 28th July 1821

Martin Jones Surveyor

Township No.

North

of the base line, Range No.

10 Ball

principal Meridian

83.30

82.23
5145

79.90
2862

79.34
489

489


80.5
350

35

78. 20

100-200

page 45 vol 1

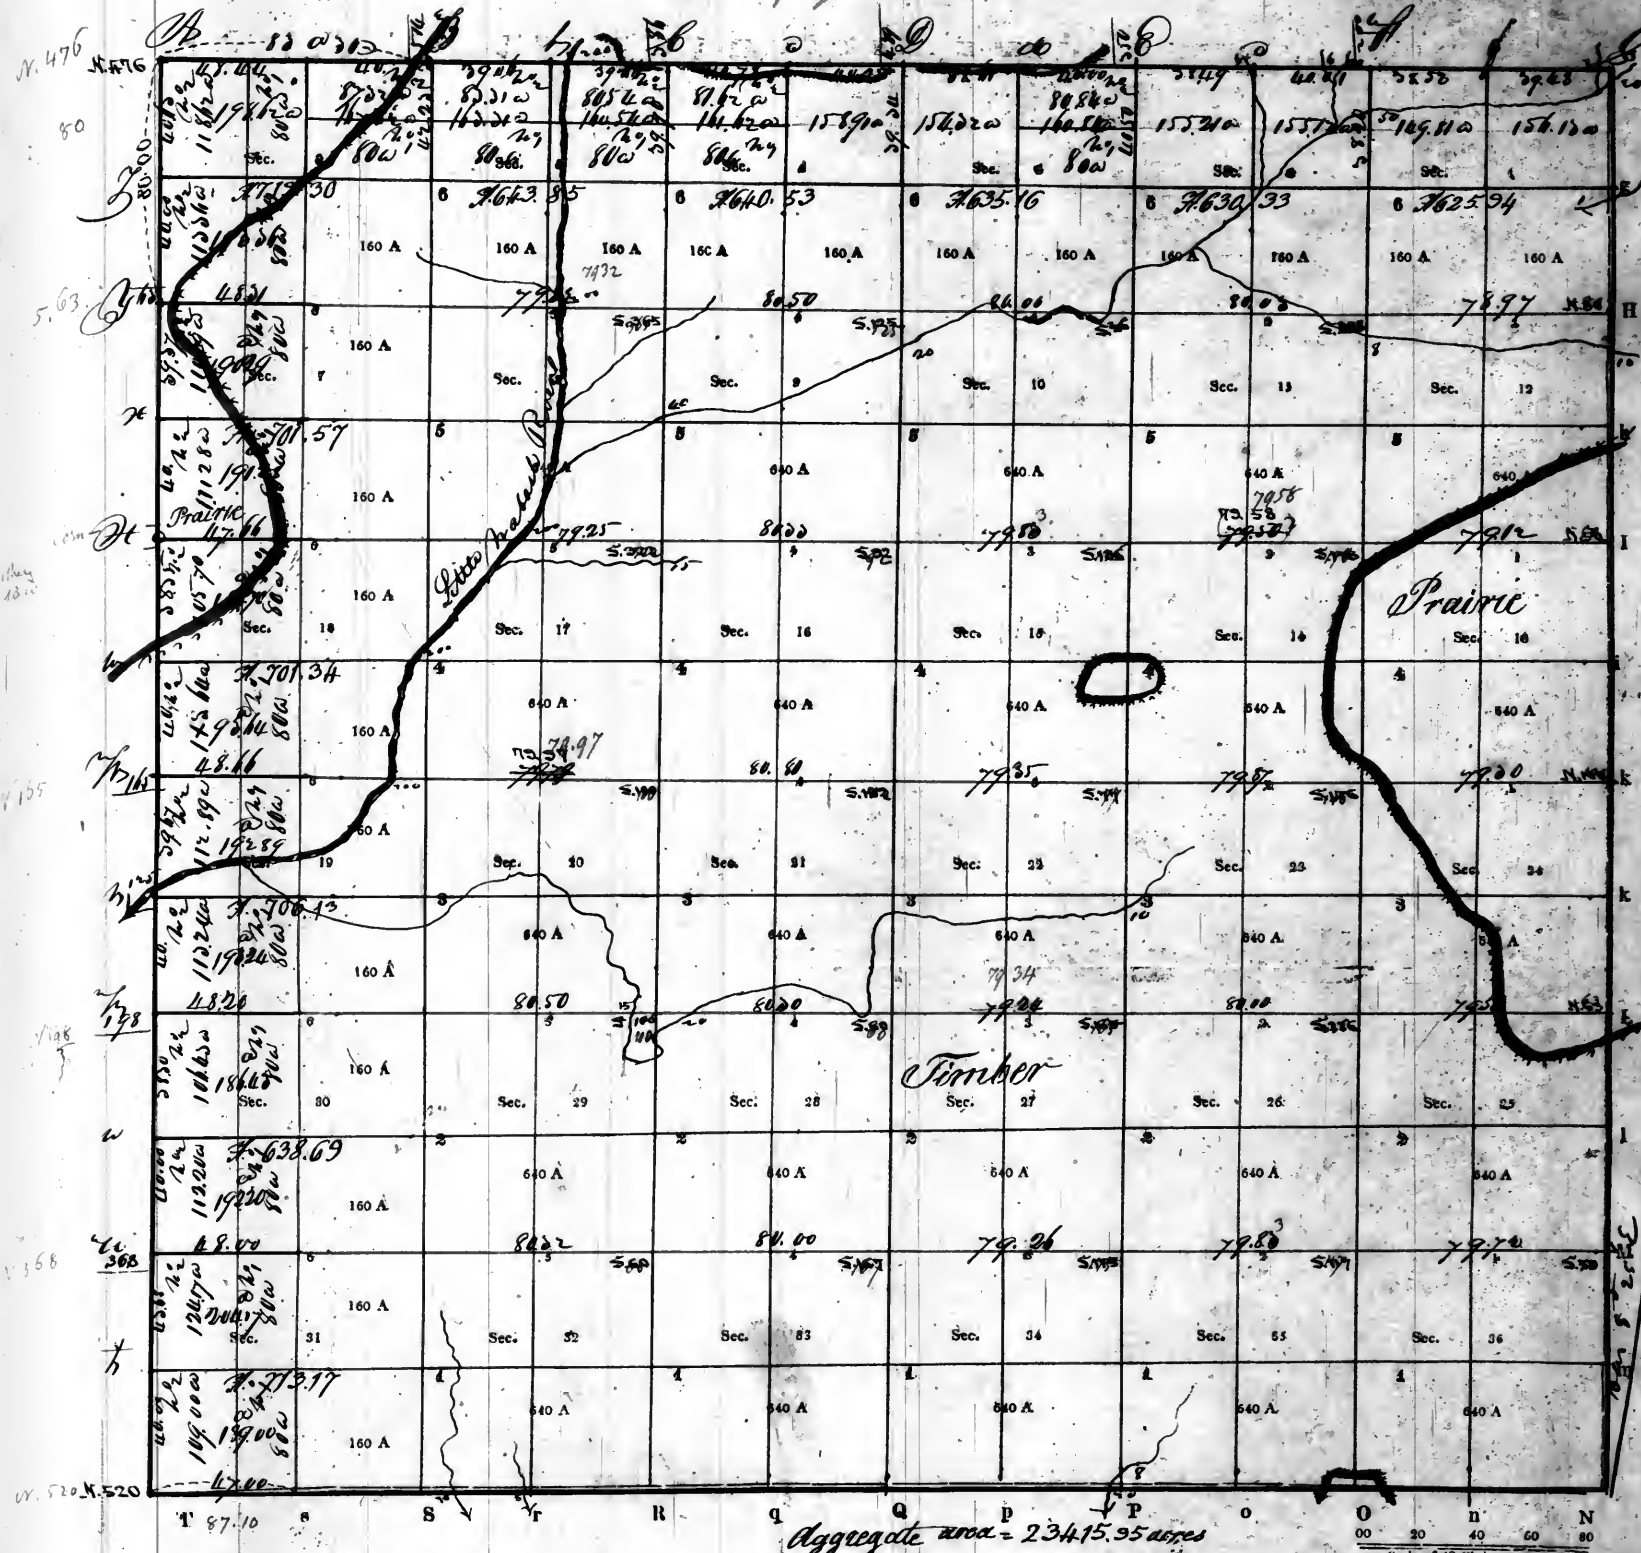


PURSUANT to a contract with, and instructions from William Rector, Surveyor of the lands of the United States in the *State of Illinois and Territory of Arkansas* bearing date the *10th* day of *April* 1821, I have measured, laid out and surveyed the above described Township; and do hereby certify, that it had such marks and bounds, both natural and artificial, as are represented on said plat, and described in the field notes made thereof, and returned with this plat into the Office of the Surveyor of the Lands of the United States, in the *State of Illinois & Territory of Arkansas*

Certified this *28th*
EXAMINED

Martindone D. SURVEYOR.

Township No. 13 N. of the Base line, Range No. 10 E. of the 3rd Principal Meridian.

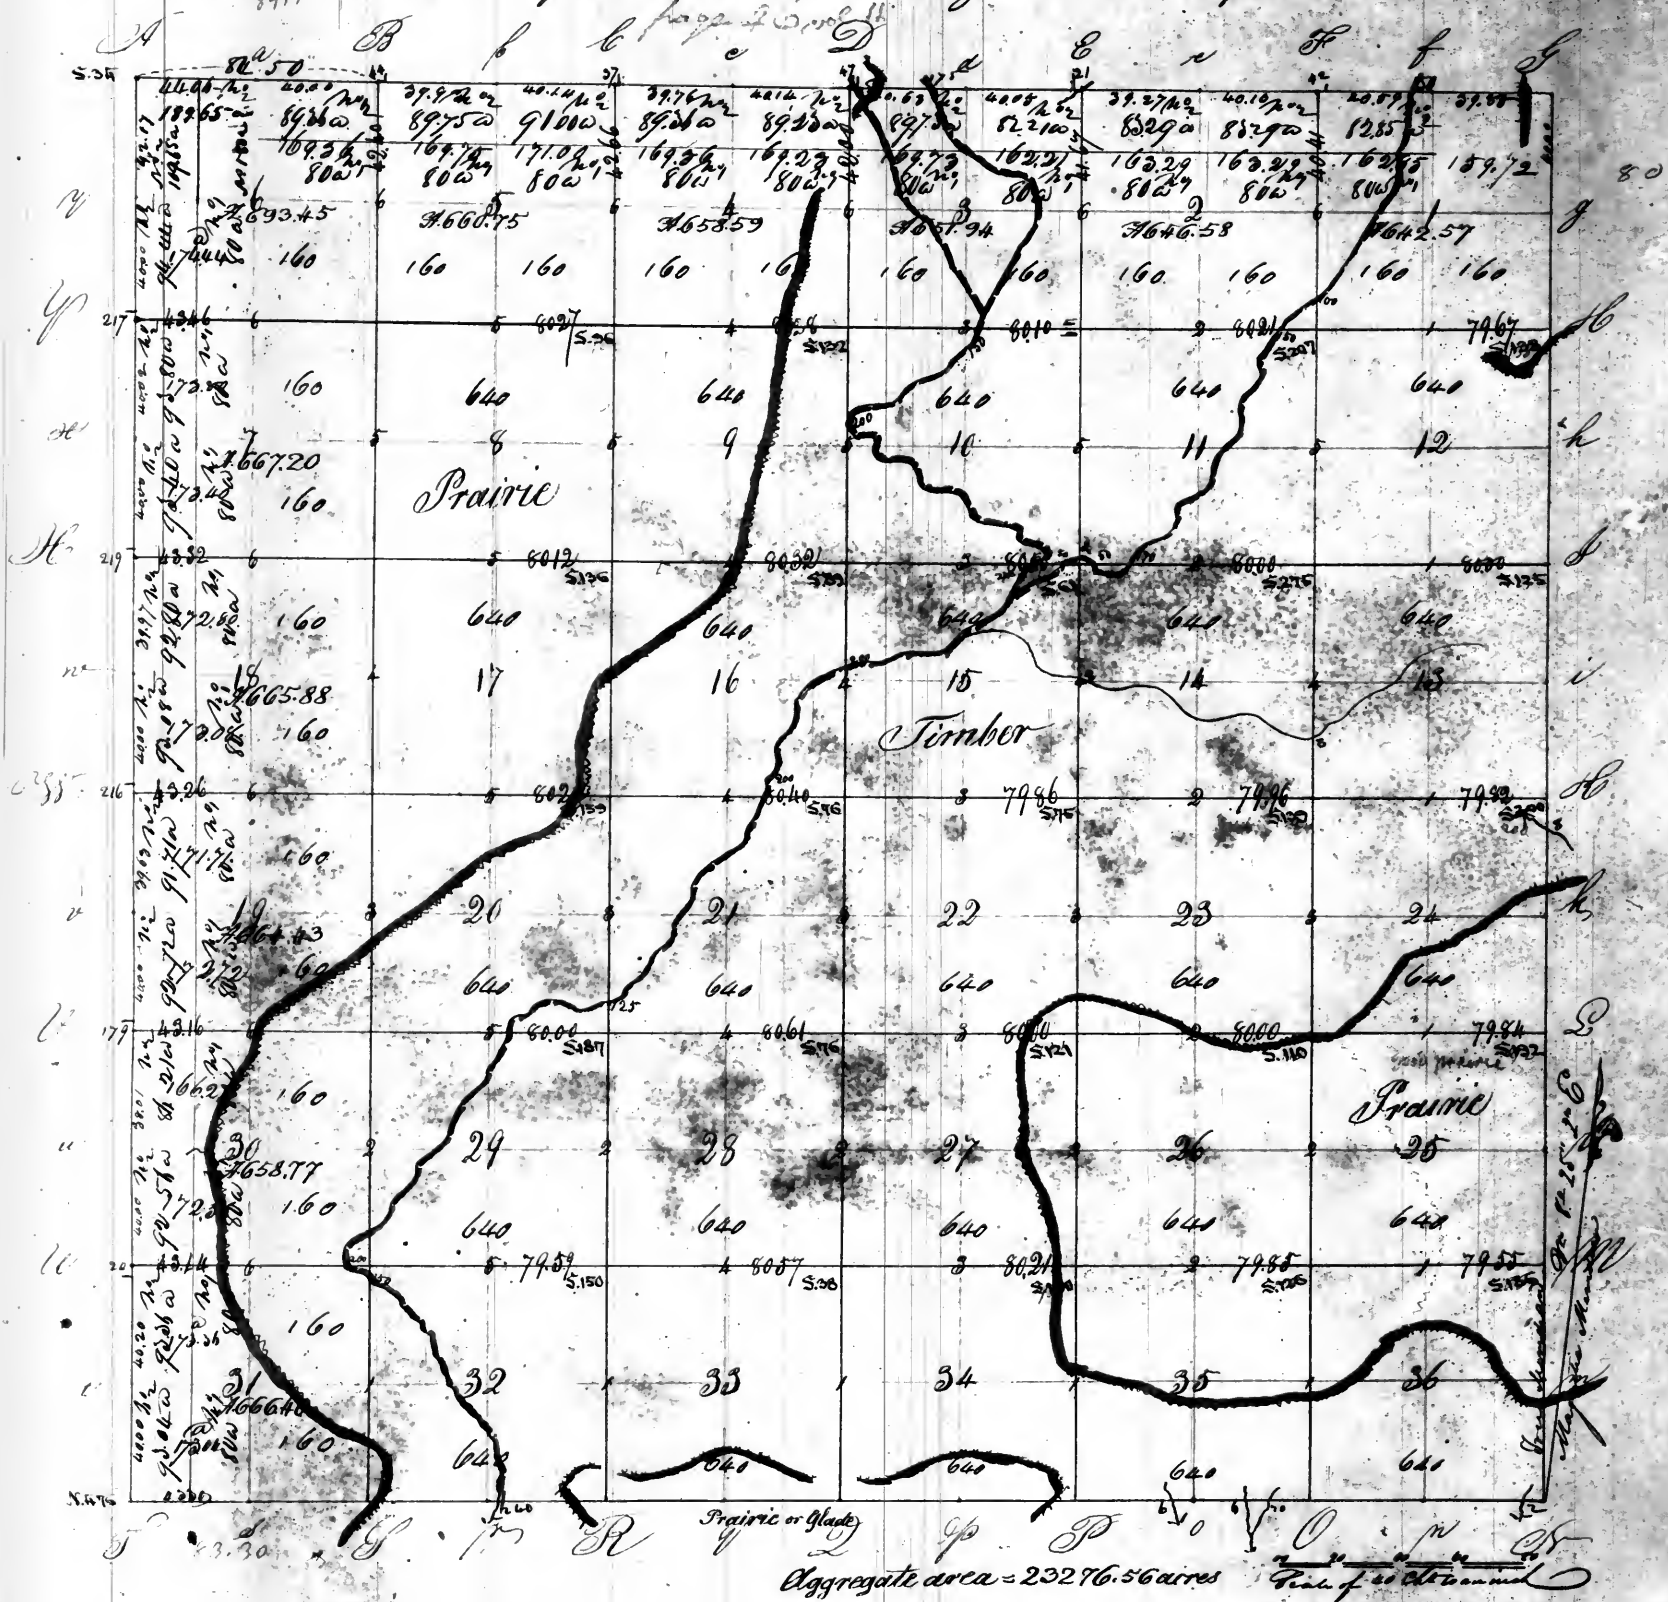


Pursuant to a contract with, and instructions from William Hector surveyor of the lands of the United States, in the State of Illinois and Missouri, bearing date the Ninth of April one thousand eight hundred and twenty one, I have admeasured, laid out and surveyed the above described township; and do hereby certify, that it had such bounds, both natural and artificial, as are represented on said plan, and described in the field notes taken thereof, and returned with this plat into the office of the surveyor of the lands of the United States, for the State of Illinois and Missouri, and for the territory of Arkansas.

Certified this 28th day of July 1821

Martin L. ...

Township No. 14 N. of the Base line, Range No. 10 E. of the 3^d Principal Meridian. 363.


A B C D E F G H

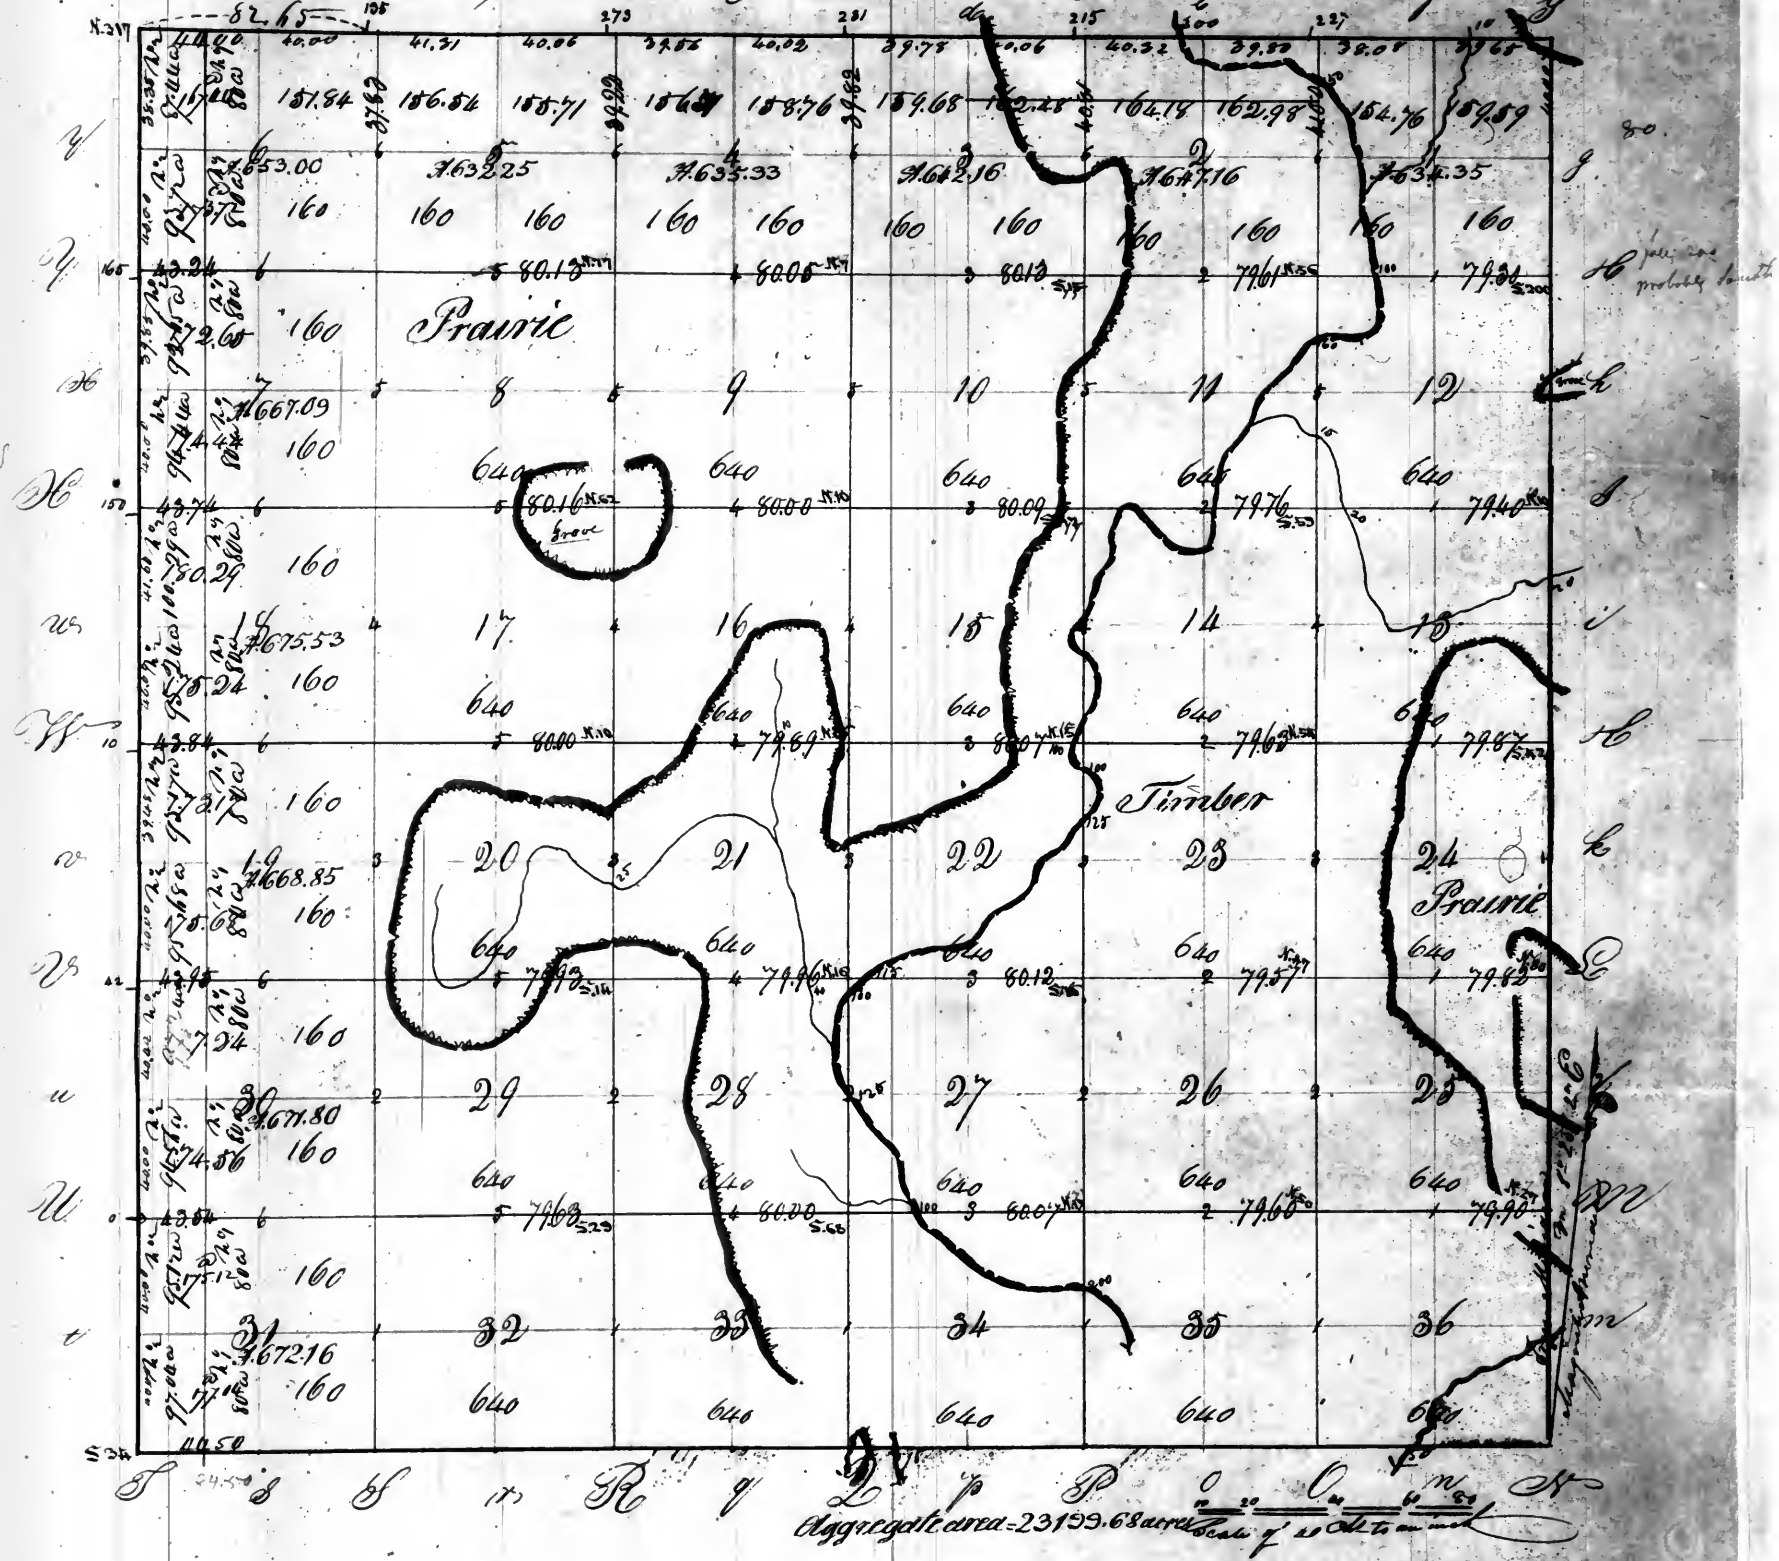

Pursuant to a contract with, and instructions from William Rector, surveyor of the lands of the United States, in the State of Illinois and Missouri, and in the territory of Arkansas, bearing date the Ninth of April one thousand eight hundred and twenty one, I have admeasured laid out and surveyed the above described township, and do hereby certify, that it had such marks and bounds, both natural and artificial, as are represented on said plat, and described in the field notes taken thereof and returned with this Plat into the office of the surveyor of the lands of the United States, for the State of Illinois and Missouri, and for the territory of Arkansas.

Certified this 28th day of July 1821

Section 15 North of the Base Line Range 10 West of the 3rd Principal Meridian

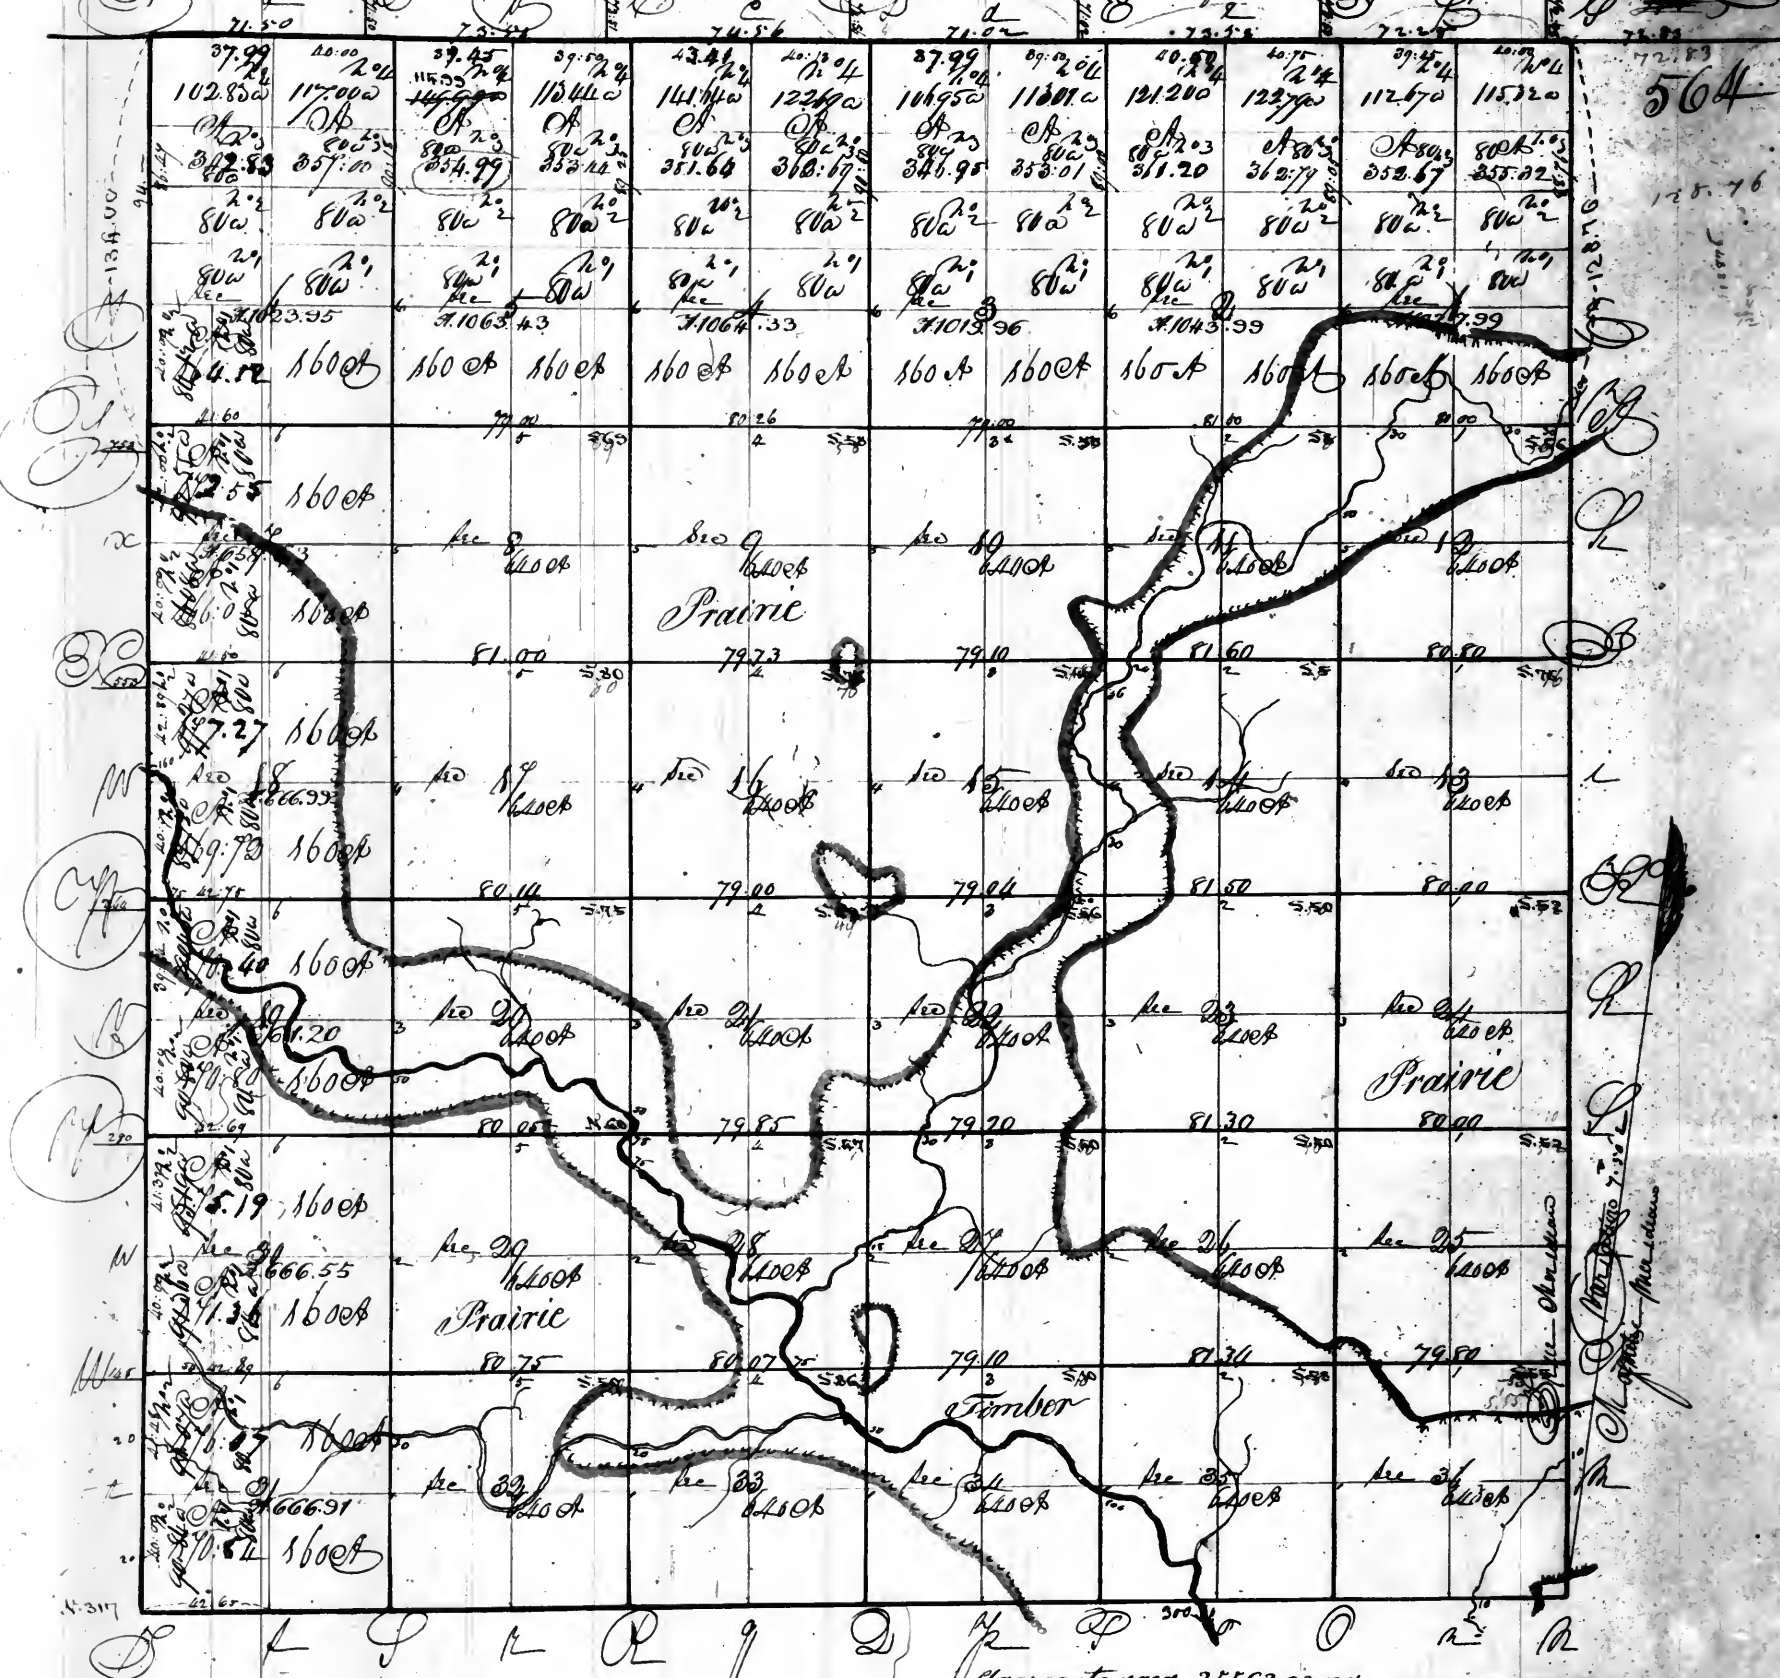

Aggregate area: 25563.93 acres


Less of the claim to an inch





565

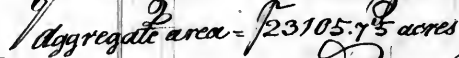


Pursuant to a contract with and instructions from William Reister, Surveyor of the lands of the United States in the States of Illinois and Missouri and Territory of Arkansas bearing date the 10 day of March 1821. I have examined the said and survey of the above entitled Township and do hereby certify that it had such bounds and marks both natural and artificial as are represented on the said plat and as entered in the field notes made and returned thereof into the Office of the Surveyor of the lands of the United States for the States of Illinois and Missouri and Territory of Arkansas bearing date the 11 day of December 1821.

Jacob Judy Esq.

80.53
36.5

Township No. 17 North of the Base Line Range No. 10 East of the 13 Principal Meridian #55
A. a B b c d Page 50 of 54 C. e Pr p

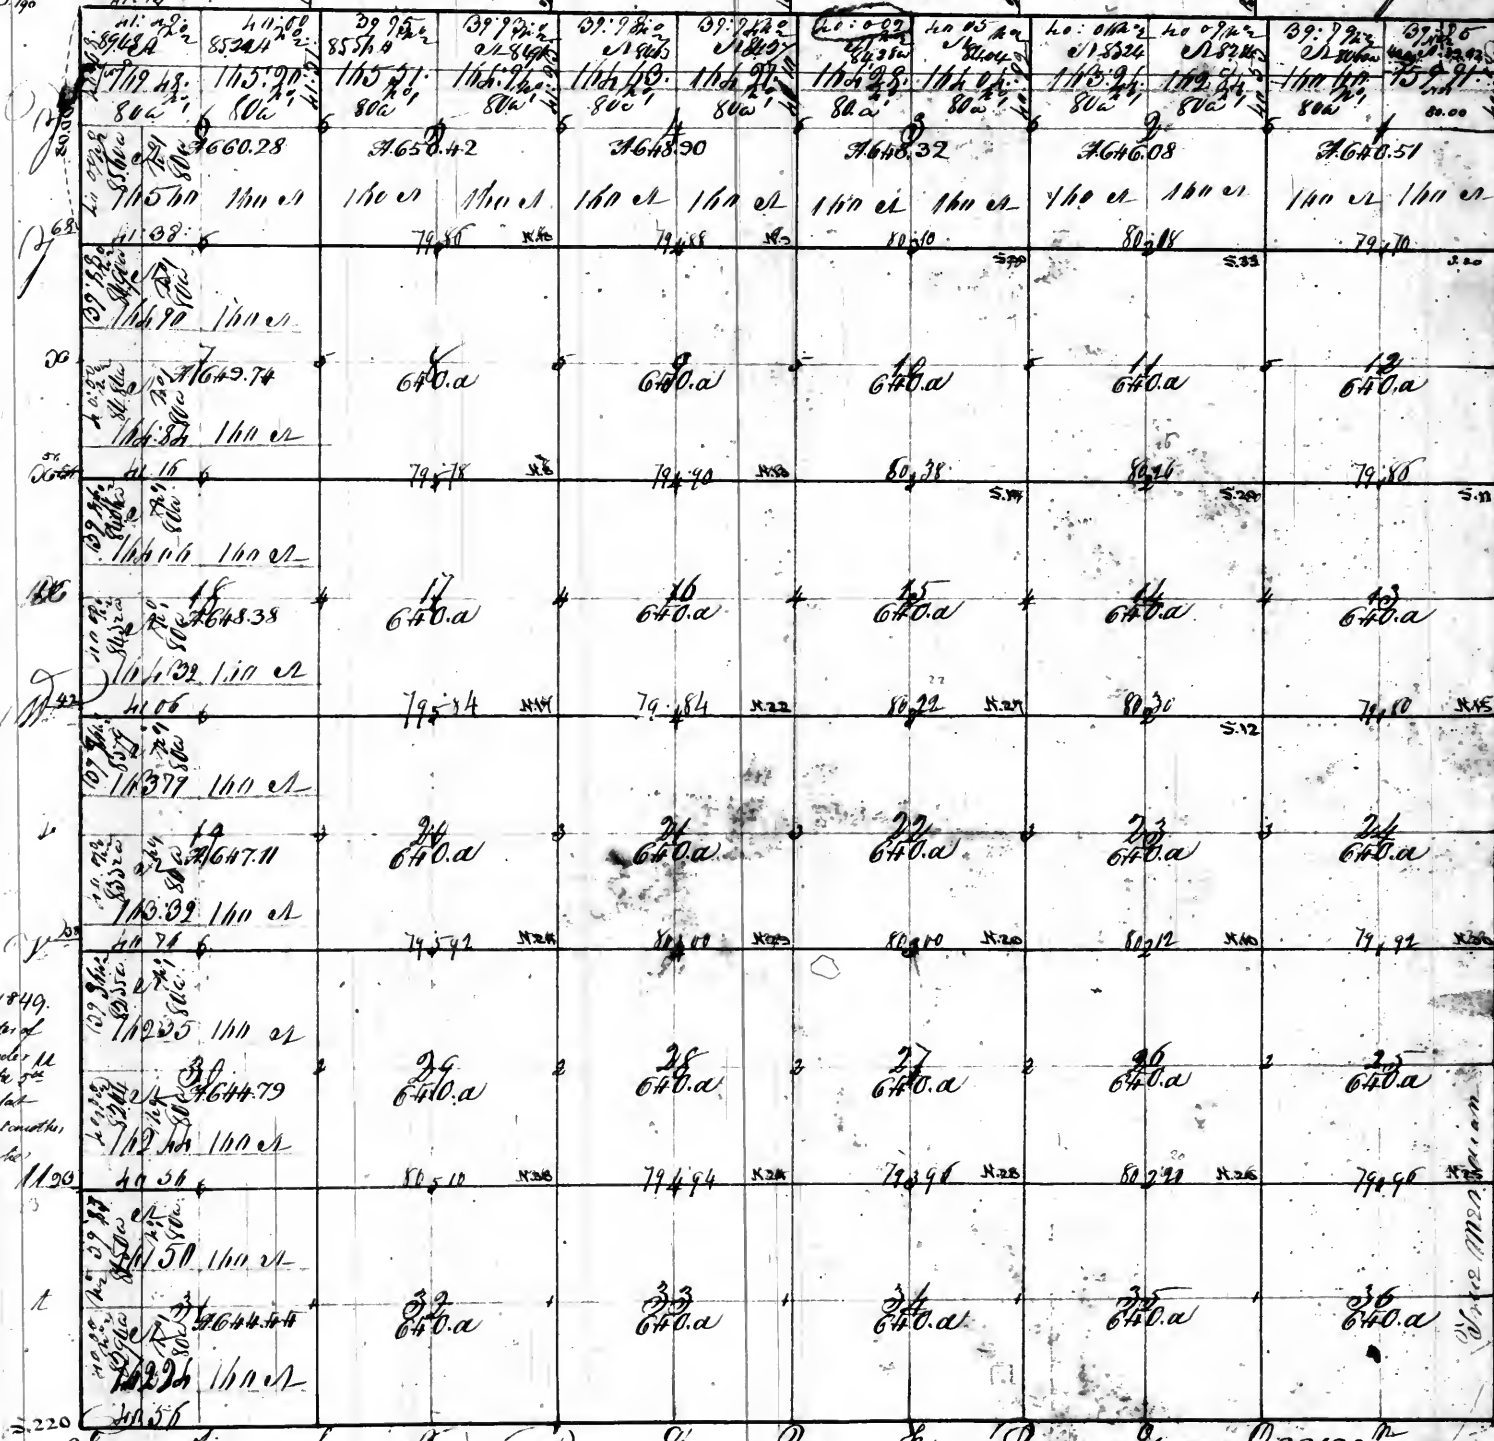


Surveyor's Office)
Saint Louis June 9th 1849.
The North East quarter of
section 1 subdivided under
the act of Congress of the 9th
of April 1832, and a plat
sent to the Register & returned
to the Commissioner of the
General Land office. 1112

Pursuant to contract with and instructions from William Hector
 Surveyor of the lands of the United States in the State of Illinois, and
 Surveyed the above Described Township and do hereby certify that it had such boundaries both
 Natural and Artificial as are represented on said plat and as described in the field notes
 made hereof and returned ^{with the map} into the Office of the Surveyor of the lands of the United States for the State

Jacob Guich D. Supt.

f. ~~##~~ g.

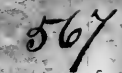


Prairie

Scale of 40 chains to an inch.

Jacob Guay Dwyer

83.72 81.61 81.24 81.08 80.70 80.50
63.6 26.2 44.2 35.8

Worship No. 19 north of the Base Line Range No. 16 East of the 3rd Principal Meridian
Page 52 vol 11

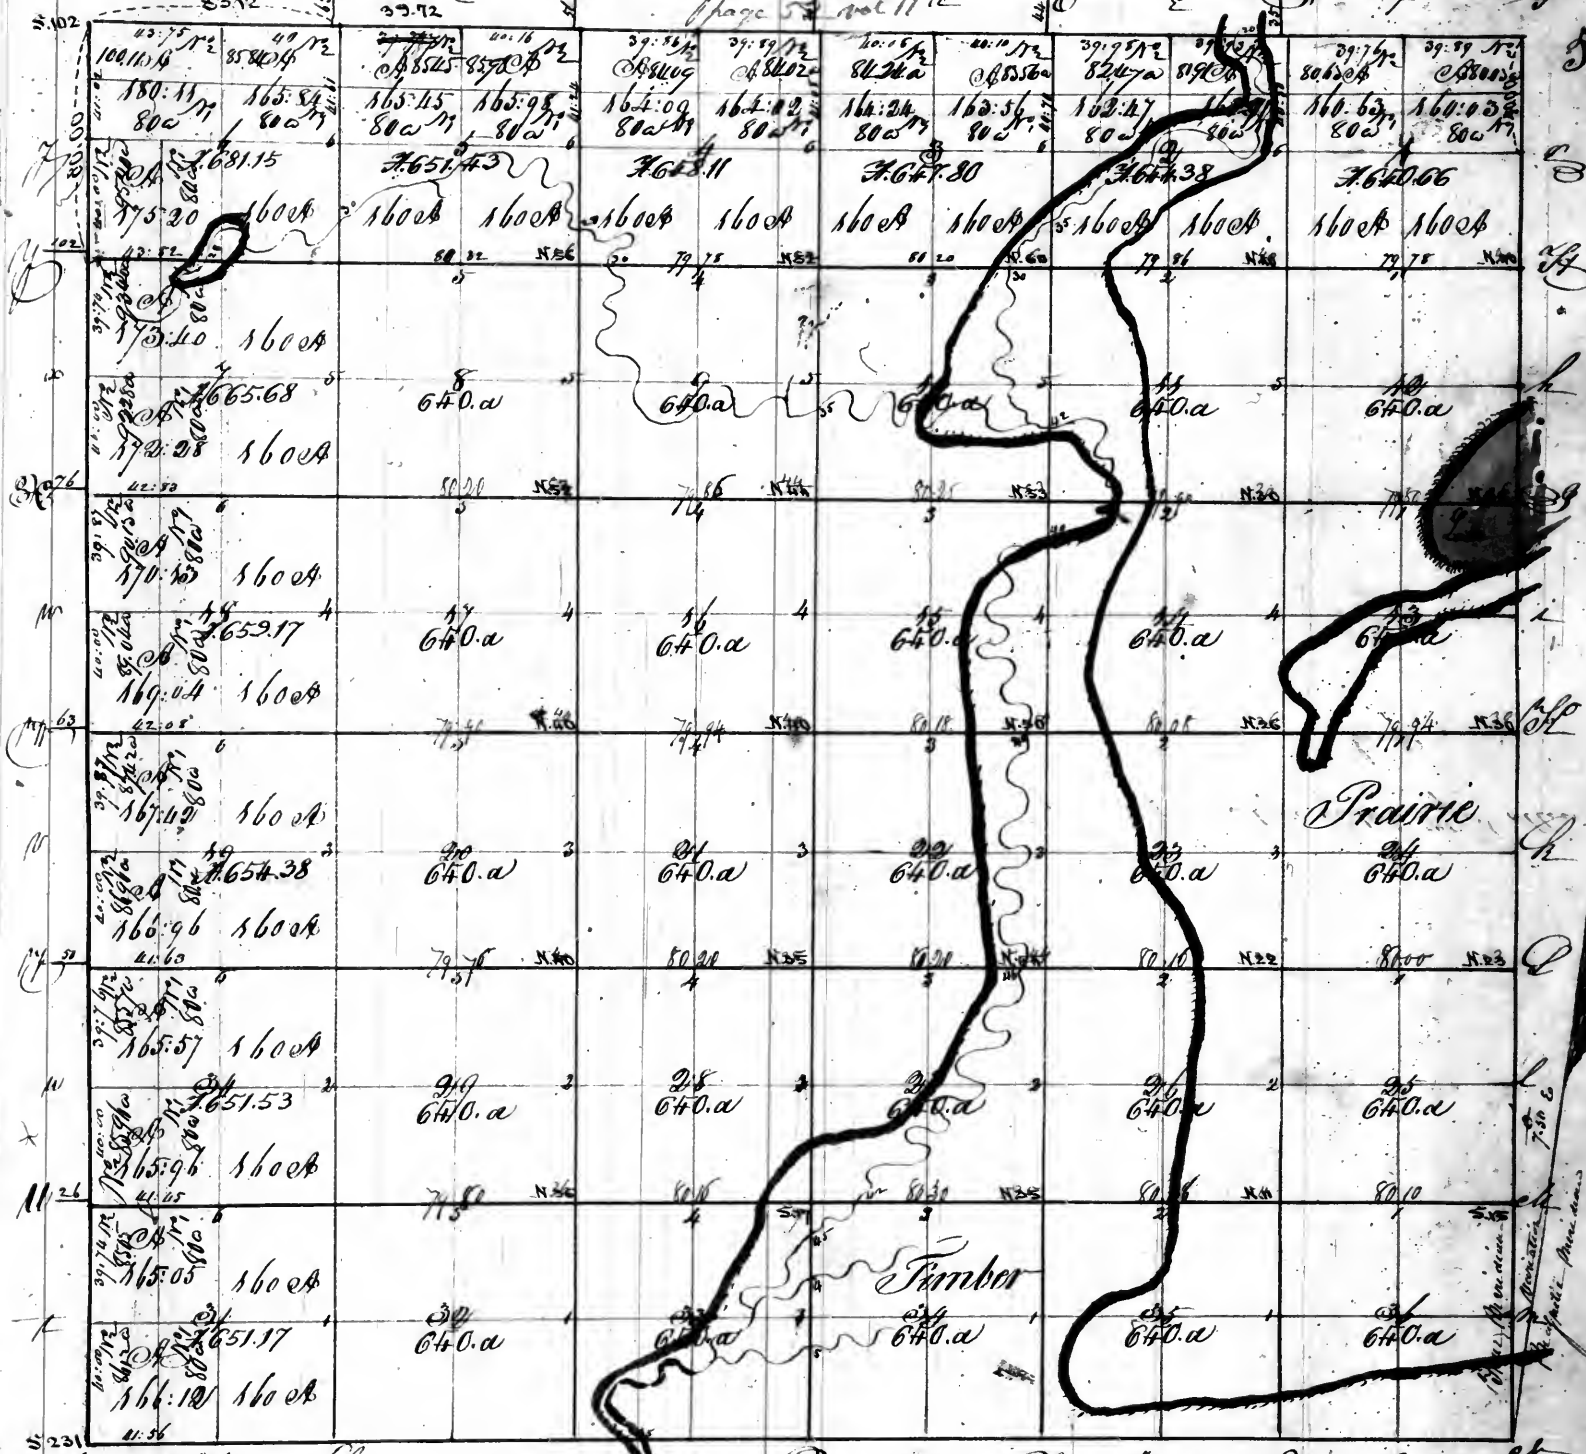


Aggregate area 23155.66 acres

Witness to a contract with and instructions from William Hector
Surveyor of the lands of the united states in the states of Illinois and
Missouri and Territory of Arkansas bearing date the 13th day of March 1821. Where we measured laid out and
surveyed the above described Township and do hereby certify that it has such marks and boundaries
natural and artificial as are represented in said plat and described in the field notes made and taken
into the Office of the Surveyor of the lands of the united states for the states of Illinois and Missouri
and Territory of Arkansas certified this 11th day of December 1821.


Just J. J. Deloy

Township No. 20 North of the Base Line Range No. 10 East of the 3rd Principal Meridian
Page 53 vol 11

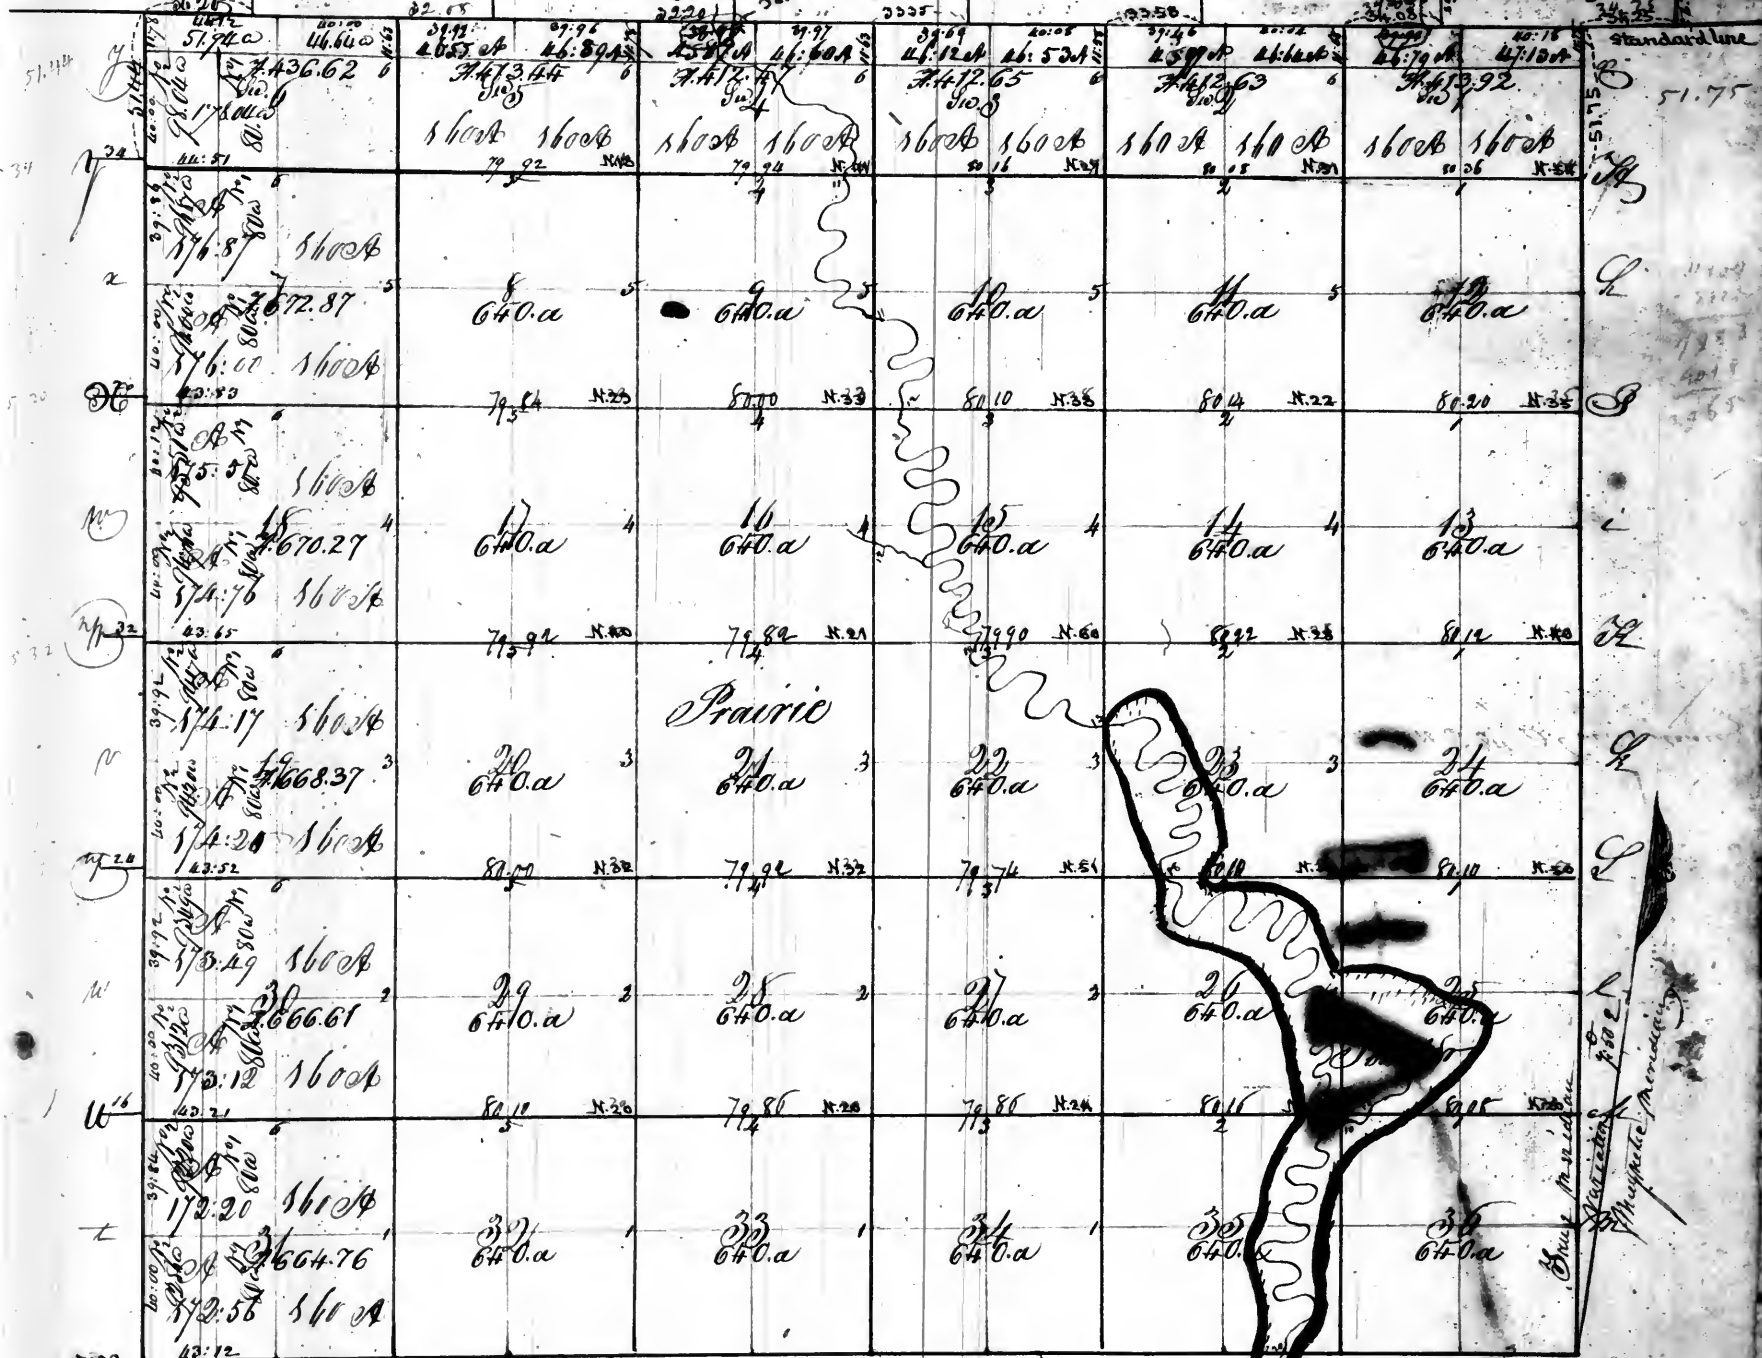

Aggregate area = 2,184.67 acres
Pursuant to a contract with and instructions from William Dwyer Surveyor of the Land Office of the United States in the State of Illinois and Missouri and Territory of Arkansas bearing date the 10th day of March 1821 I have been employed to lay out and survey the above described Township and as hereby certify that it has such marks and bounds both natural and artificial as are represented on said plat and ascertained in said field notes made and returned with this plat into the office of the Surveyor of the Land Office of the United States for the State of Illinois and Missouri and Territory of Arkansas certified this 10th day of December 1821.
Jacob Judy Surveyor

Township N. 22 North of the Base line, Range N. 10 East of the 3^d principal Meridian

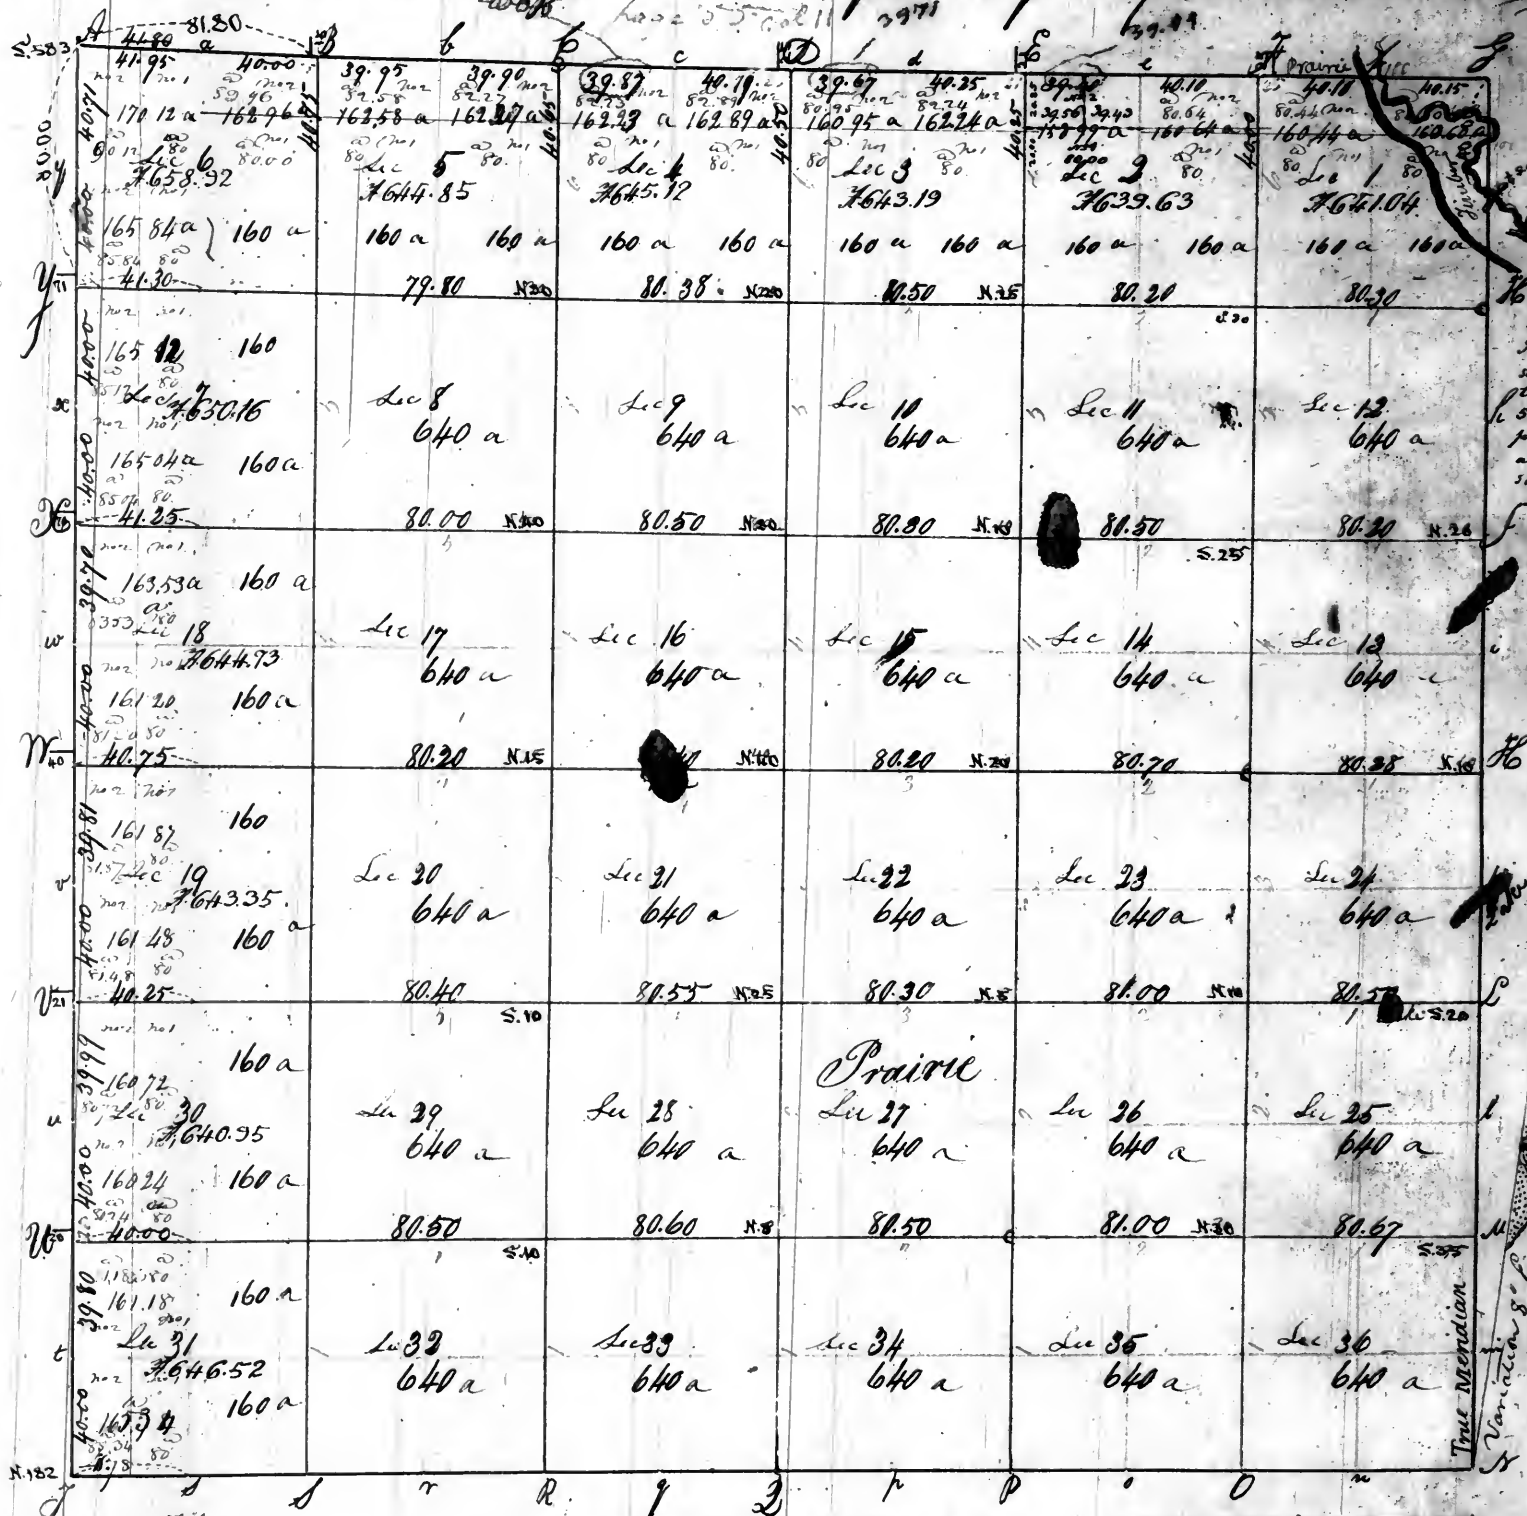


Surveyor's office
Saint Louis June 9th 1822
The North West quarter of
section 2, on which is located
the act of Congress of the
5th of April 1820, and a
plat sent to the Register
and another to the Commis-
sioner of the General
Land Office.

I am in a contract with & instructions from William Reister surveyor of the lands of the United States in the states of Illinois & Missouri & Territory of Arkansas bearing date the 20th day of February 1822, I have measured, laid out & surveyed the above described township & do hereby certify that it has such marks & bounds both natural & artificial as are represented on said plat & described in the field notes made thereof & returned with this plat into the office of the surveyor of the lands of the United States for the states of Illinois & Missouri & territory of Arkansas —

Certified this 12th day of August 1822 —

Enoch Moore D. S.

Township N° 23 North of the Base line, Range N° 10 East of the 3^d principal Meridian.

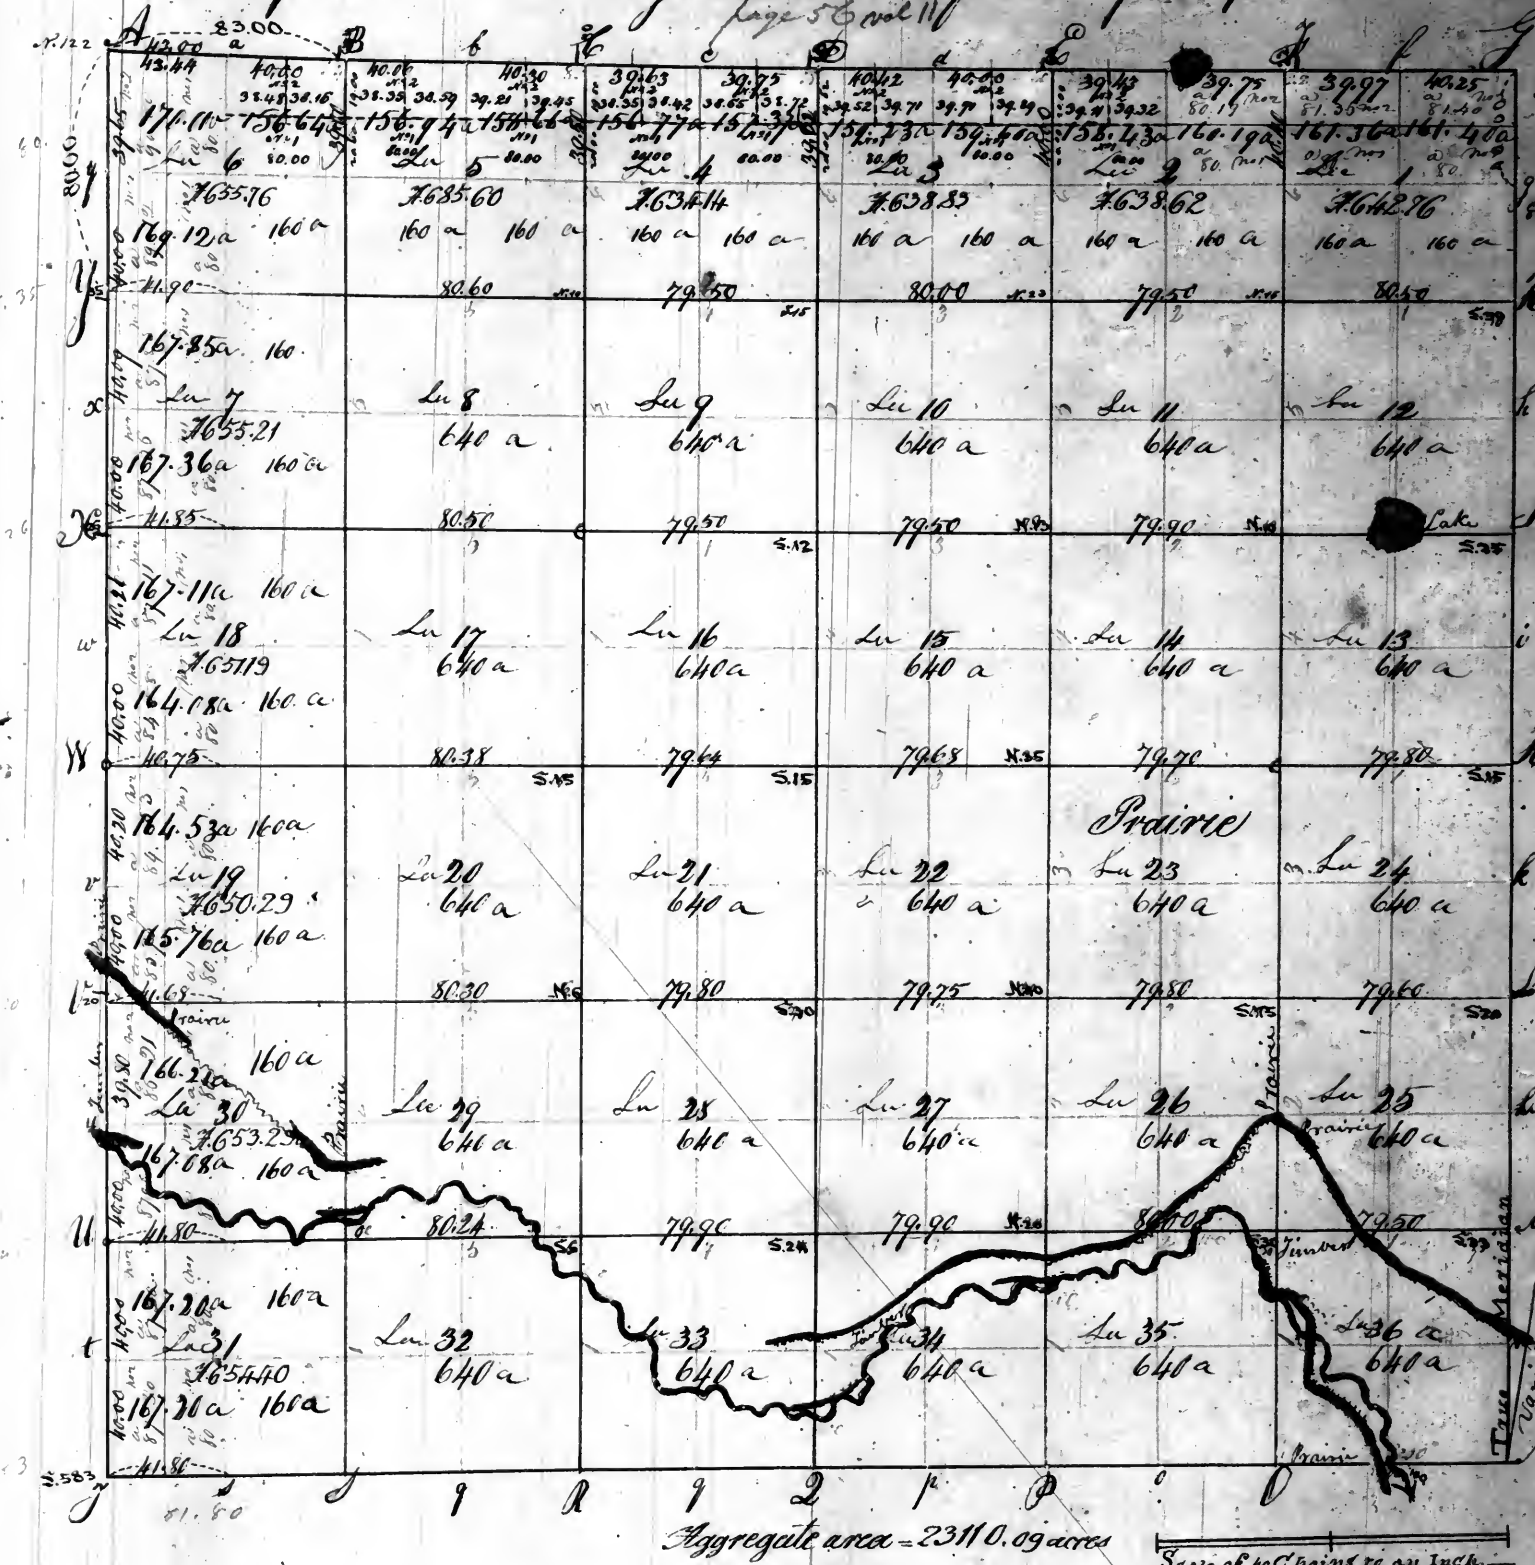


Surveyor's office
Saint Louis June 9th 1849.
This North West quarter
of section 2, the North half
of sections 3, 4, 5 and the
North East quarter of section
6, situated under the
act of Congress of the 5th
of April 1820 and a
plot sent to the Register
and another to the Com-
missioner of the General
Land office.

In pursuance to a contract with & instructions from William Reister surveyor of the lands of the United States for the States of
Illinois & Missouri & Territory of Arkansas, bearing date the 20th day of February 1822, I have measured, laid out and
surveyed the above described township & do hereby certify, that it had such marks & bounds both natural & artificial, as are
represented on said plat, & described in the field notes made thereof, and returned with this plat into this office of the
surveyor of the lands of the United States for the States of Illinois & Missouri & Territory of Arkansas —
Certified this 12th day of August 1822.

Enoch Moore D^y

Township N^o 24 North of the Base line Range N^o 10 East of the 3^d Principal Meridian

575

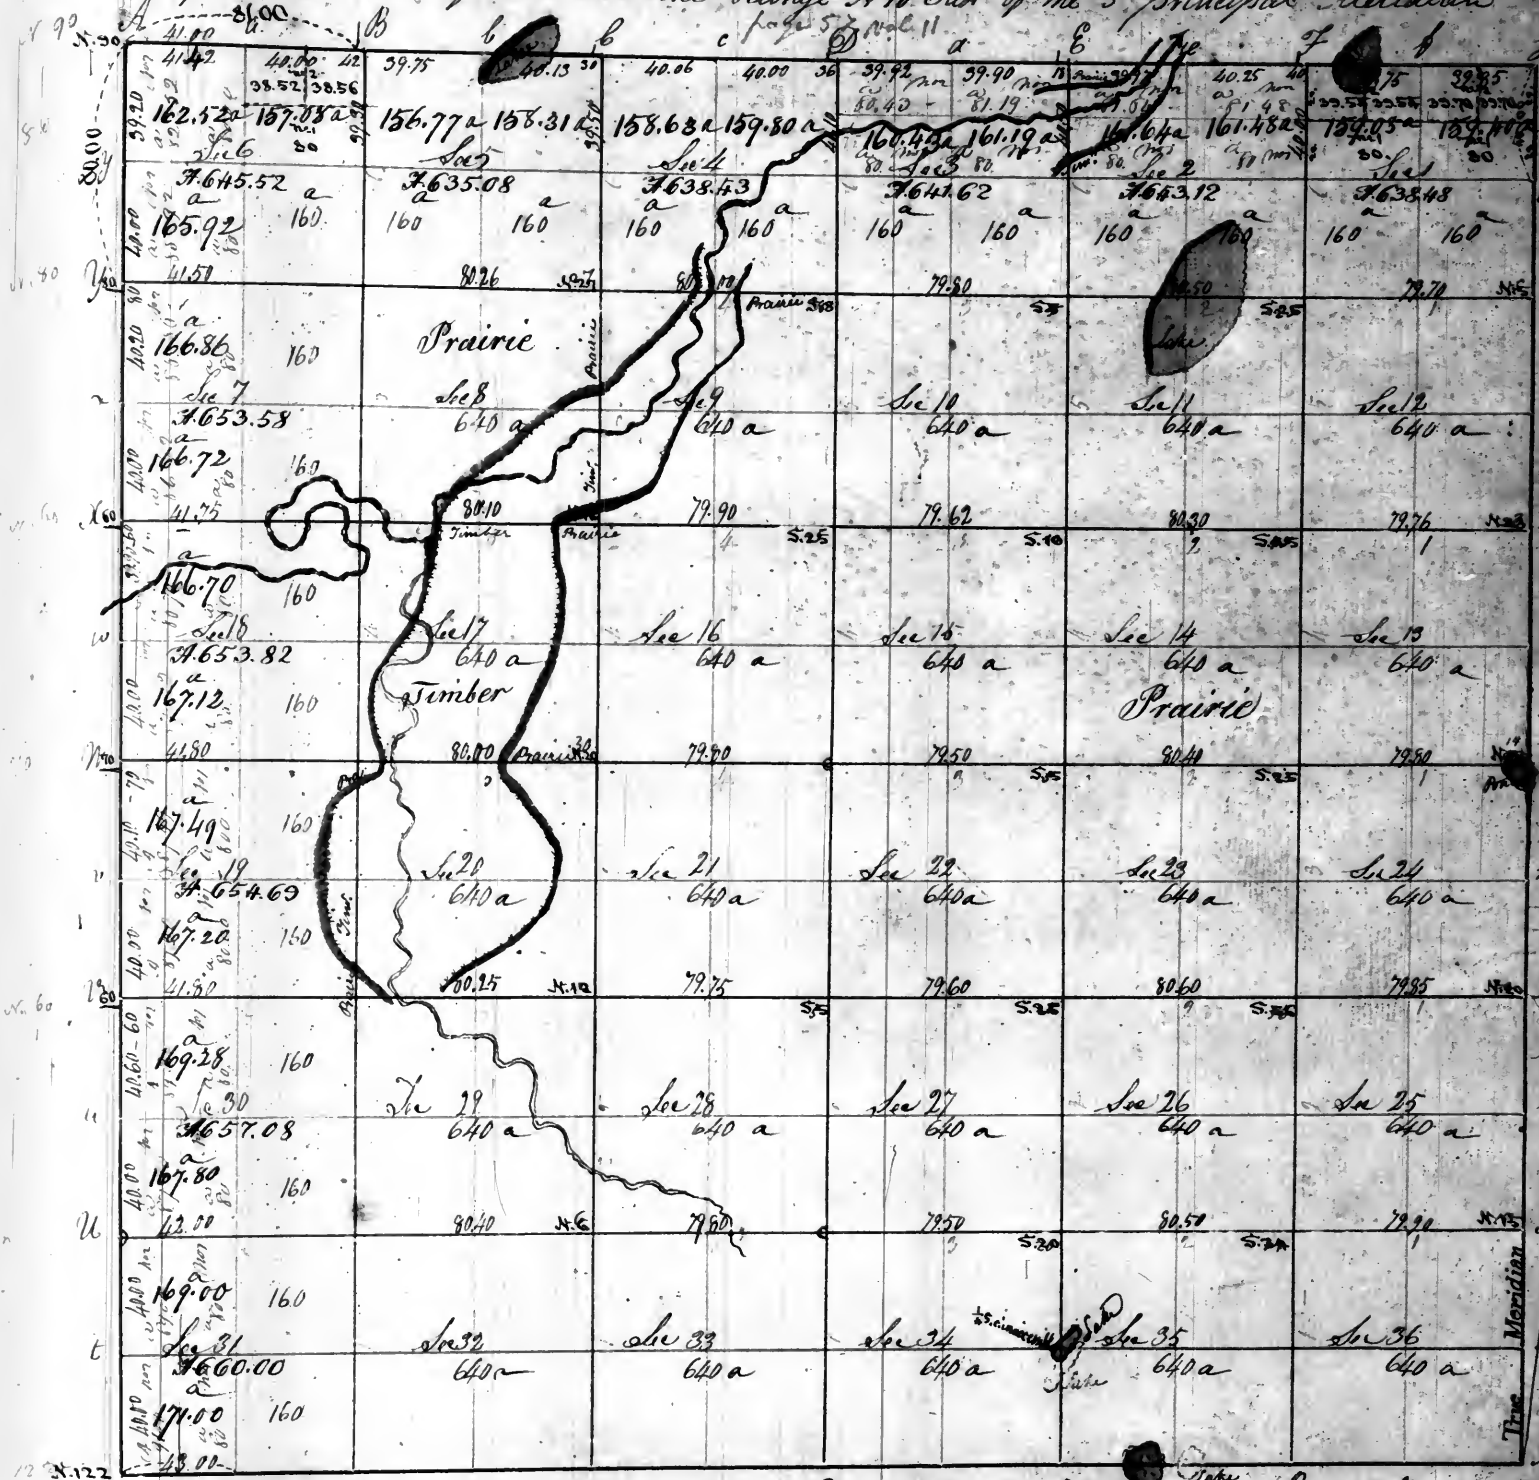

Surveyor's Office
St. Louis, July 30, 1847
Subdivided the North half Sec. 1
of the N. E. q. Sec. 6 and sent a
copy to the Register & another
copy to the Comm'r of the Genl
Land Office.

Aggregate area = 23121.42 acs


Scale of 40 Chains to an Inch

Pursuant to a contract with & instructions from William Pector, surveyor of the lands of the United States in the states of Illinois & Missouri & Territory of Arkansas, bearing date the 12th day of February 1822, I have as measured laid out & surveyed the above described Township and do hereby certify, that it has such marks & bounds both natural & artificial, as are represented on said plat, & described in the field notes made thereof, and returned with this plat into the office of the surveyor of the lands for the states of Illinois & Missouri & Territory of Arkansas—

Certified this 12th day of August 1822—

Crook & Co.

Township N^o 25 North of the Bow line Range N^o 10 East 3^d Principal Meridians
 155 164 15 16 17 
 155 164 15 16 17 

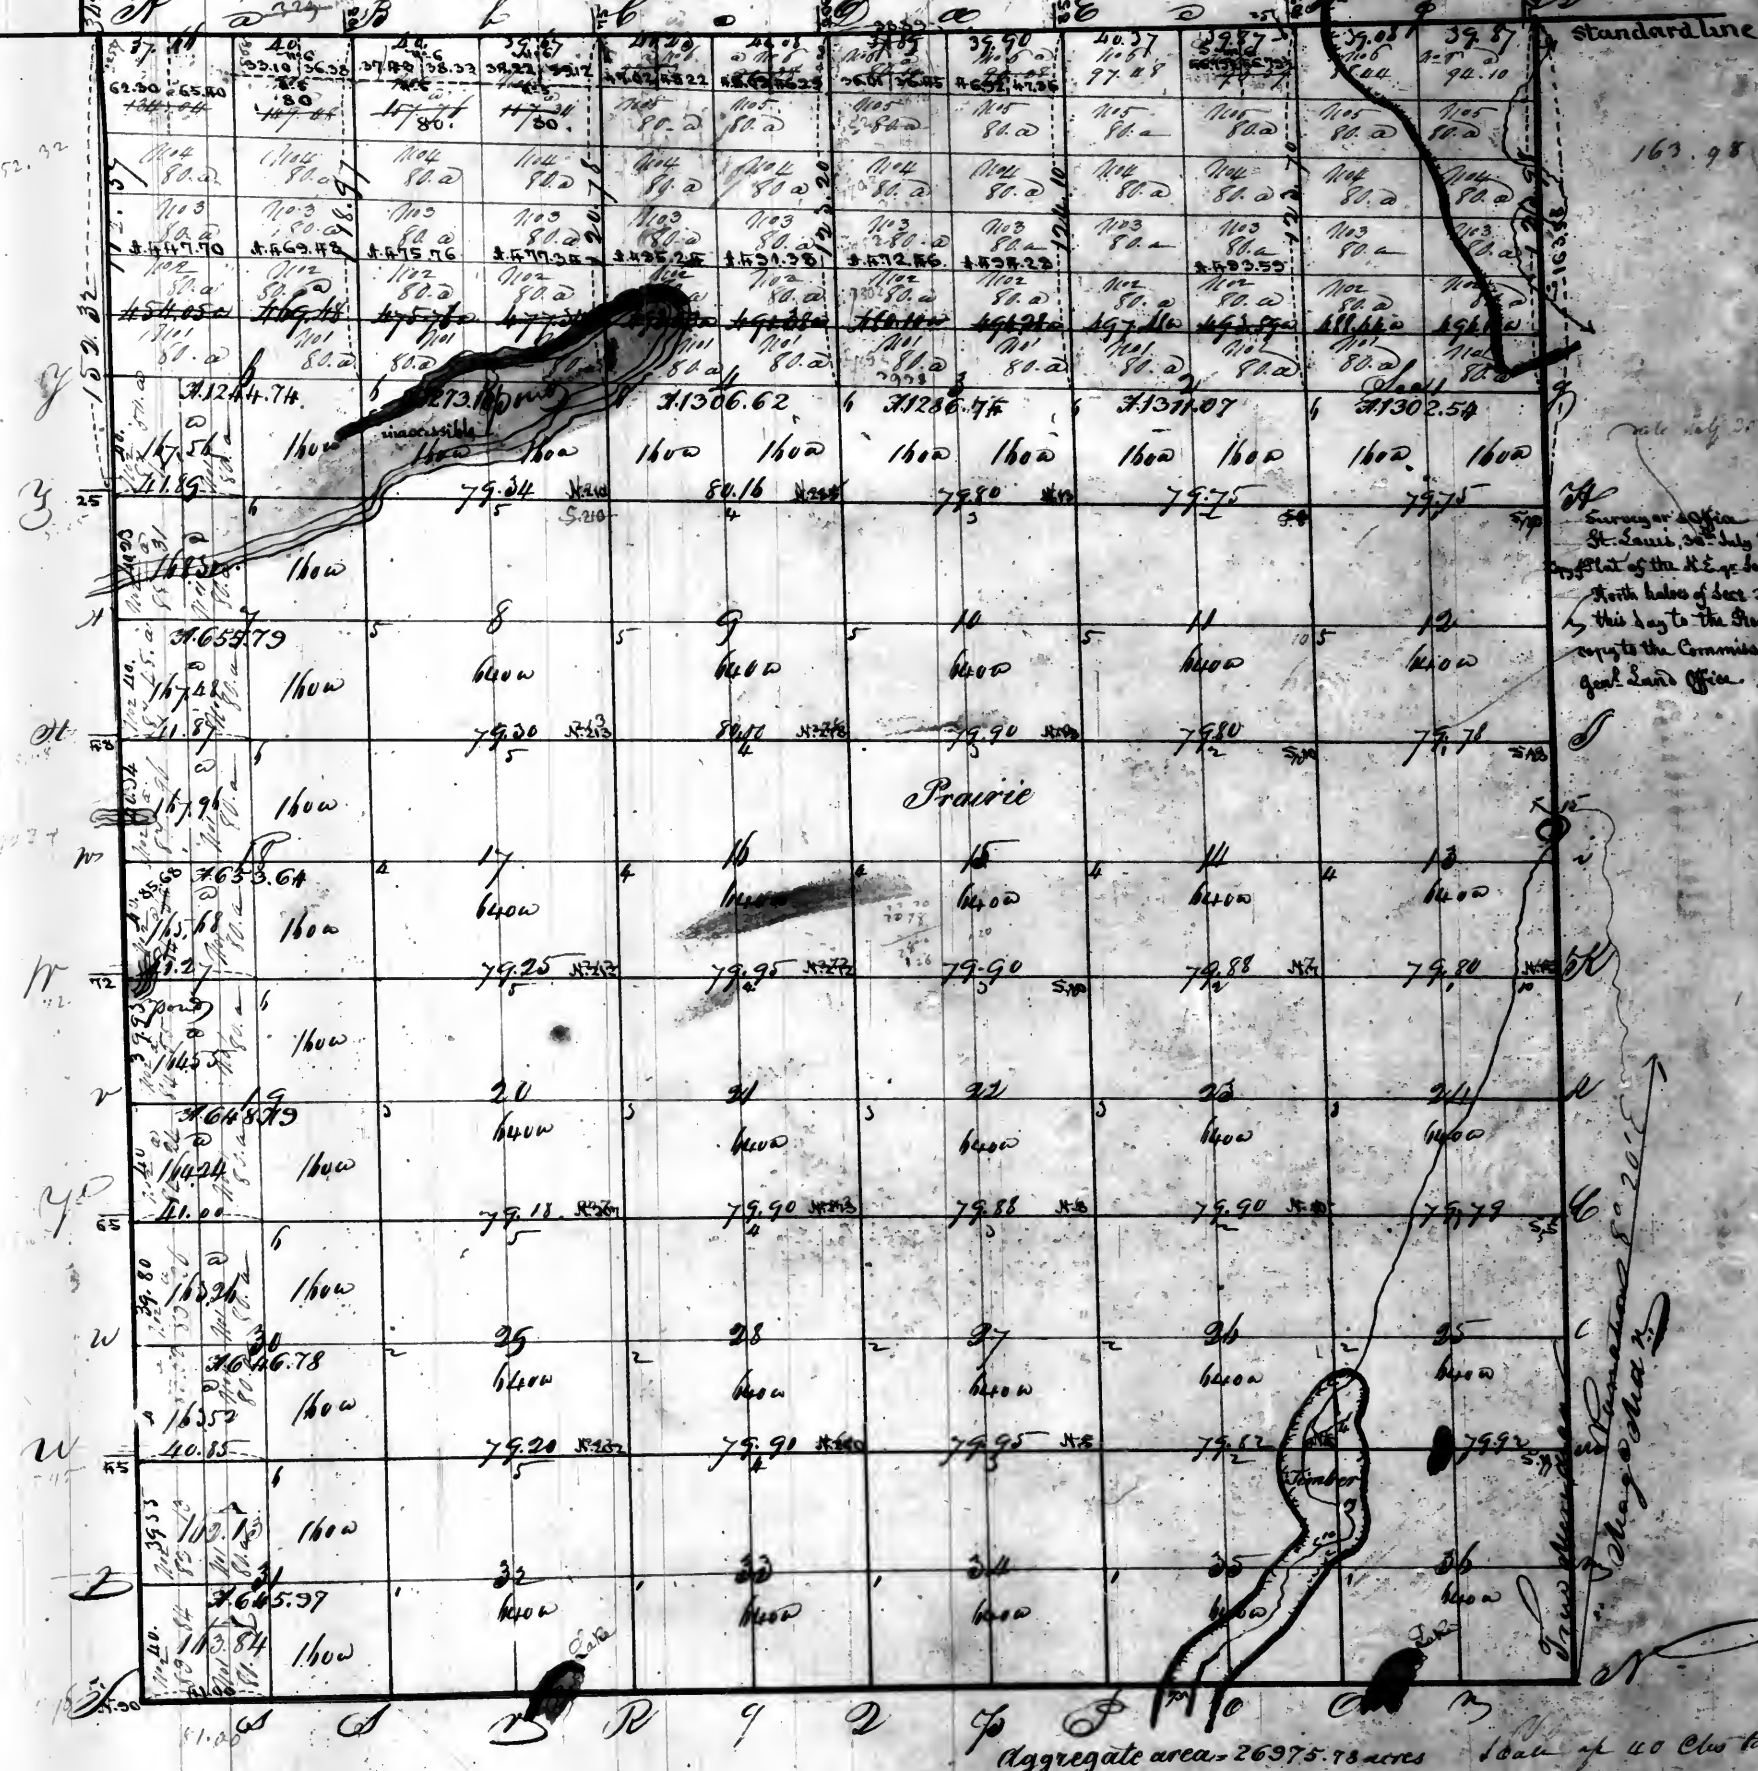

Aggregate area - 26375.78 acres Scale of 40 Chs to an inch

Pursuant to a contract with and instructions from William Reister Surveyor of the Lands of the United States in the State of Illinois & Missouri & Territory of Arkansas bearing date the 9th day of March 1832 - I have admeasured laid out & surveyed the above described Township & do hereby certify that its ~~land~~ ^{land} marks and bounds both natural & artificial as are represented on said plat and described in the field notes made thereof and returned with this plat into the office of the Surveyor of the Lands of the United States of Illinois & Missouri & Territory of Arkansas.

~~Certified~~ this ^{18th} Day of November, 1822
Examined


Fifteen *Surveyors*

Township No. 26 North

of the base line, Range No. 10 East

of the 2d principal Meridian.

Surveyor's office
Saint Louis, Mo. 9th 1849
The Northwest quarter of
sections 3, 4, 5, the north east
quarter of section 6, the
west halves of sections 6, 7,
18, 19, 20, and the south
west quarter of section 31
subdivided under the act
of Congress of the 5th of
April 1832, and a plat
sent to the Register and
another to the Commissioner
of the General Land Office.

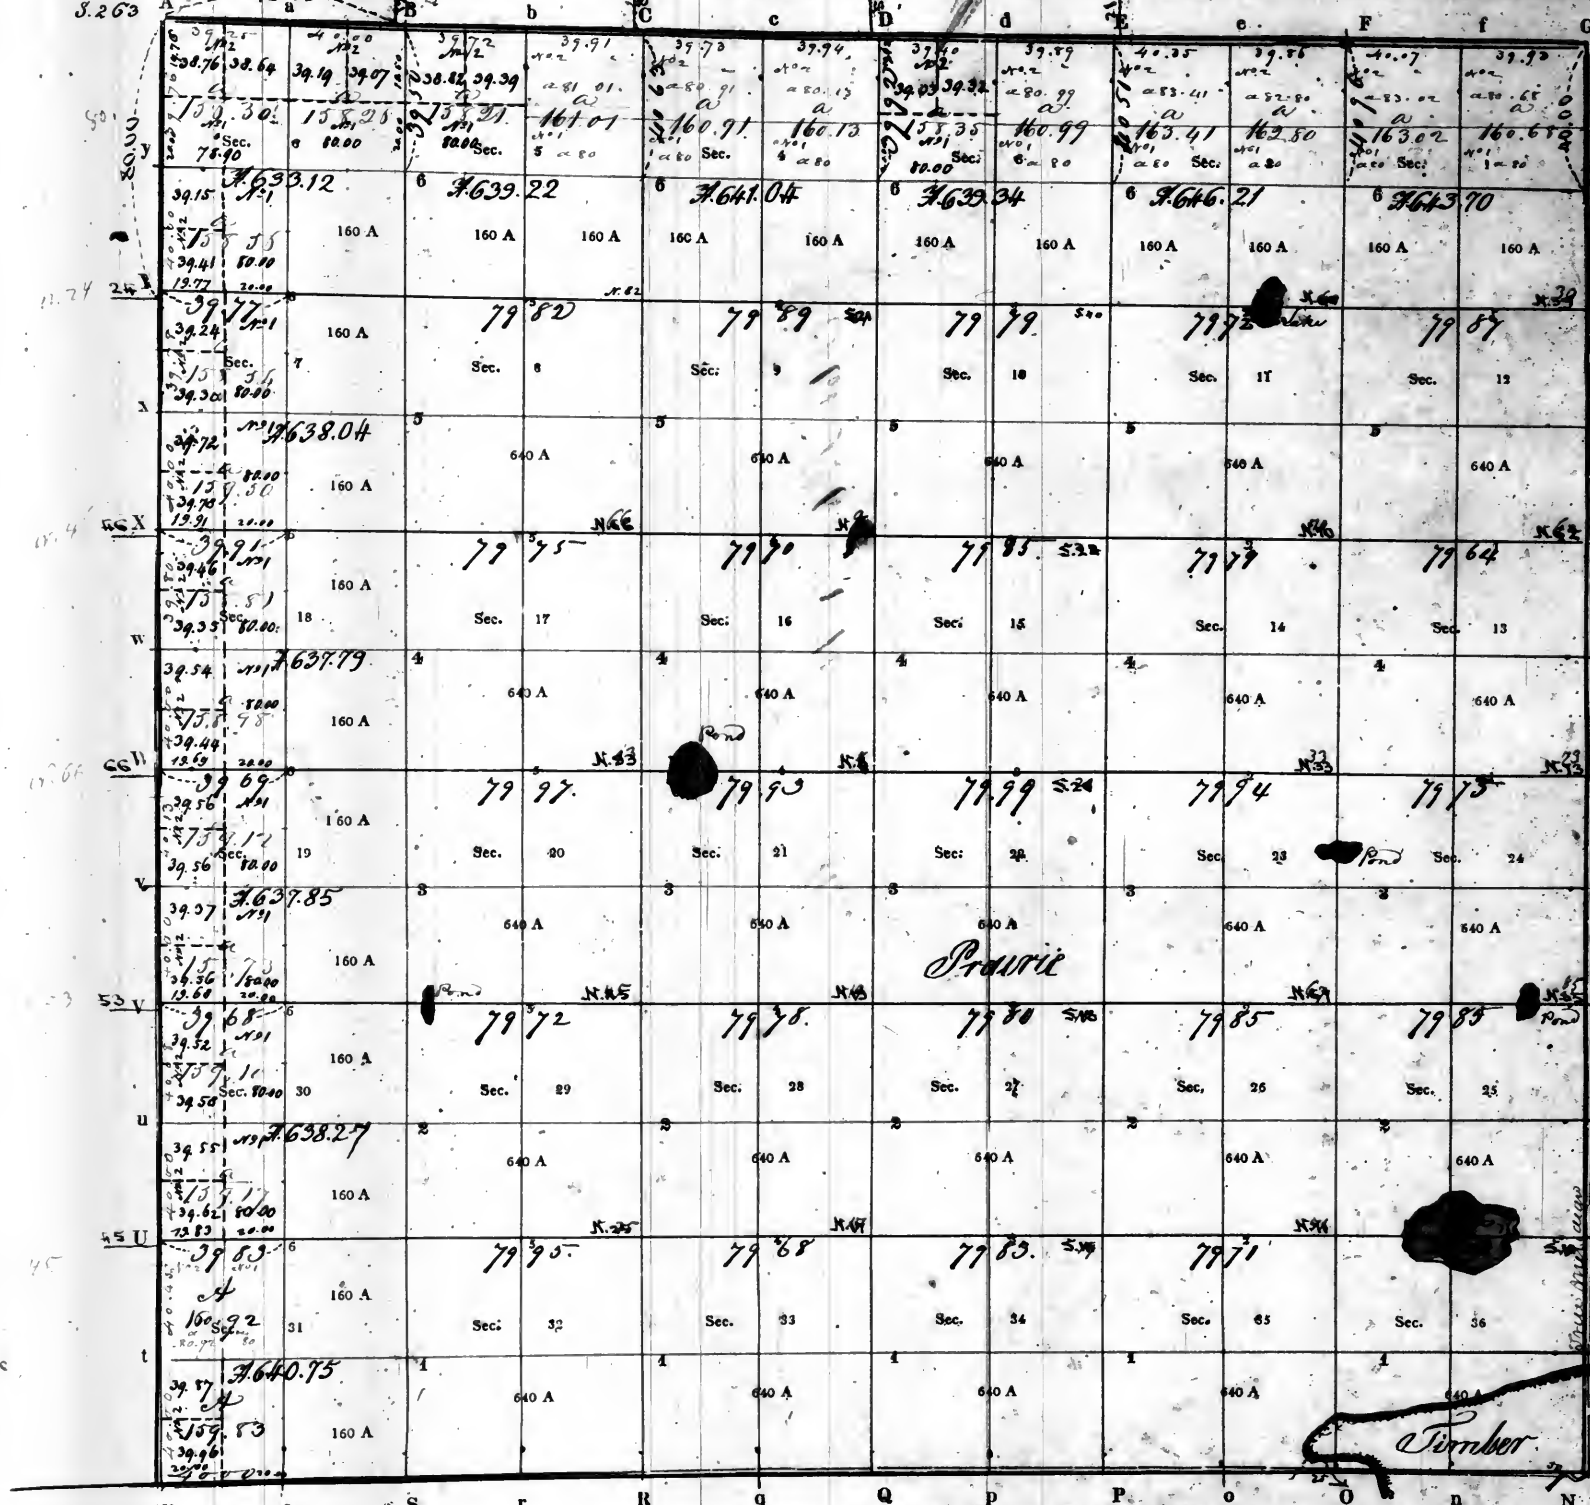

Aggregate area = 23035.33 acres


PURSUANT to a contract with, and instructions from William Rector, Surveyor of the lands of the United States in the State of Illinois and Territory of Arkansas, bearing date the 14th day of March 1832, we have measured, laid out and surveyed the above described Township; and do hereby certify, that it had such marks and bounds, both natural and artificial, as are represented on said plat, and described in the field notes made thereof, and returned with this plat into the Office of the Surveyor of the Lands of the United States, in the State of Illinois and Territory of Arkansas.

Certified this 14th day of December 1832

Wm Hamilton
Elias Rector
D. SURVEYOR.

Township No. 34 North of the base line, Range No. 10 East of the 2nd principal Meridian.

Page 61 vol 11

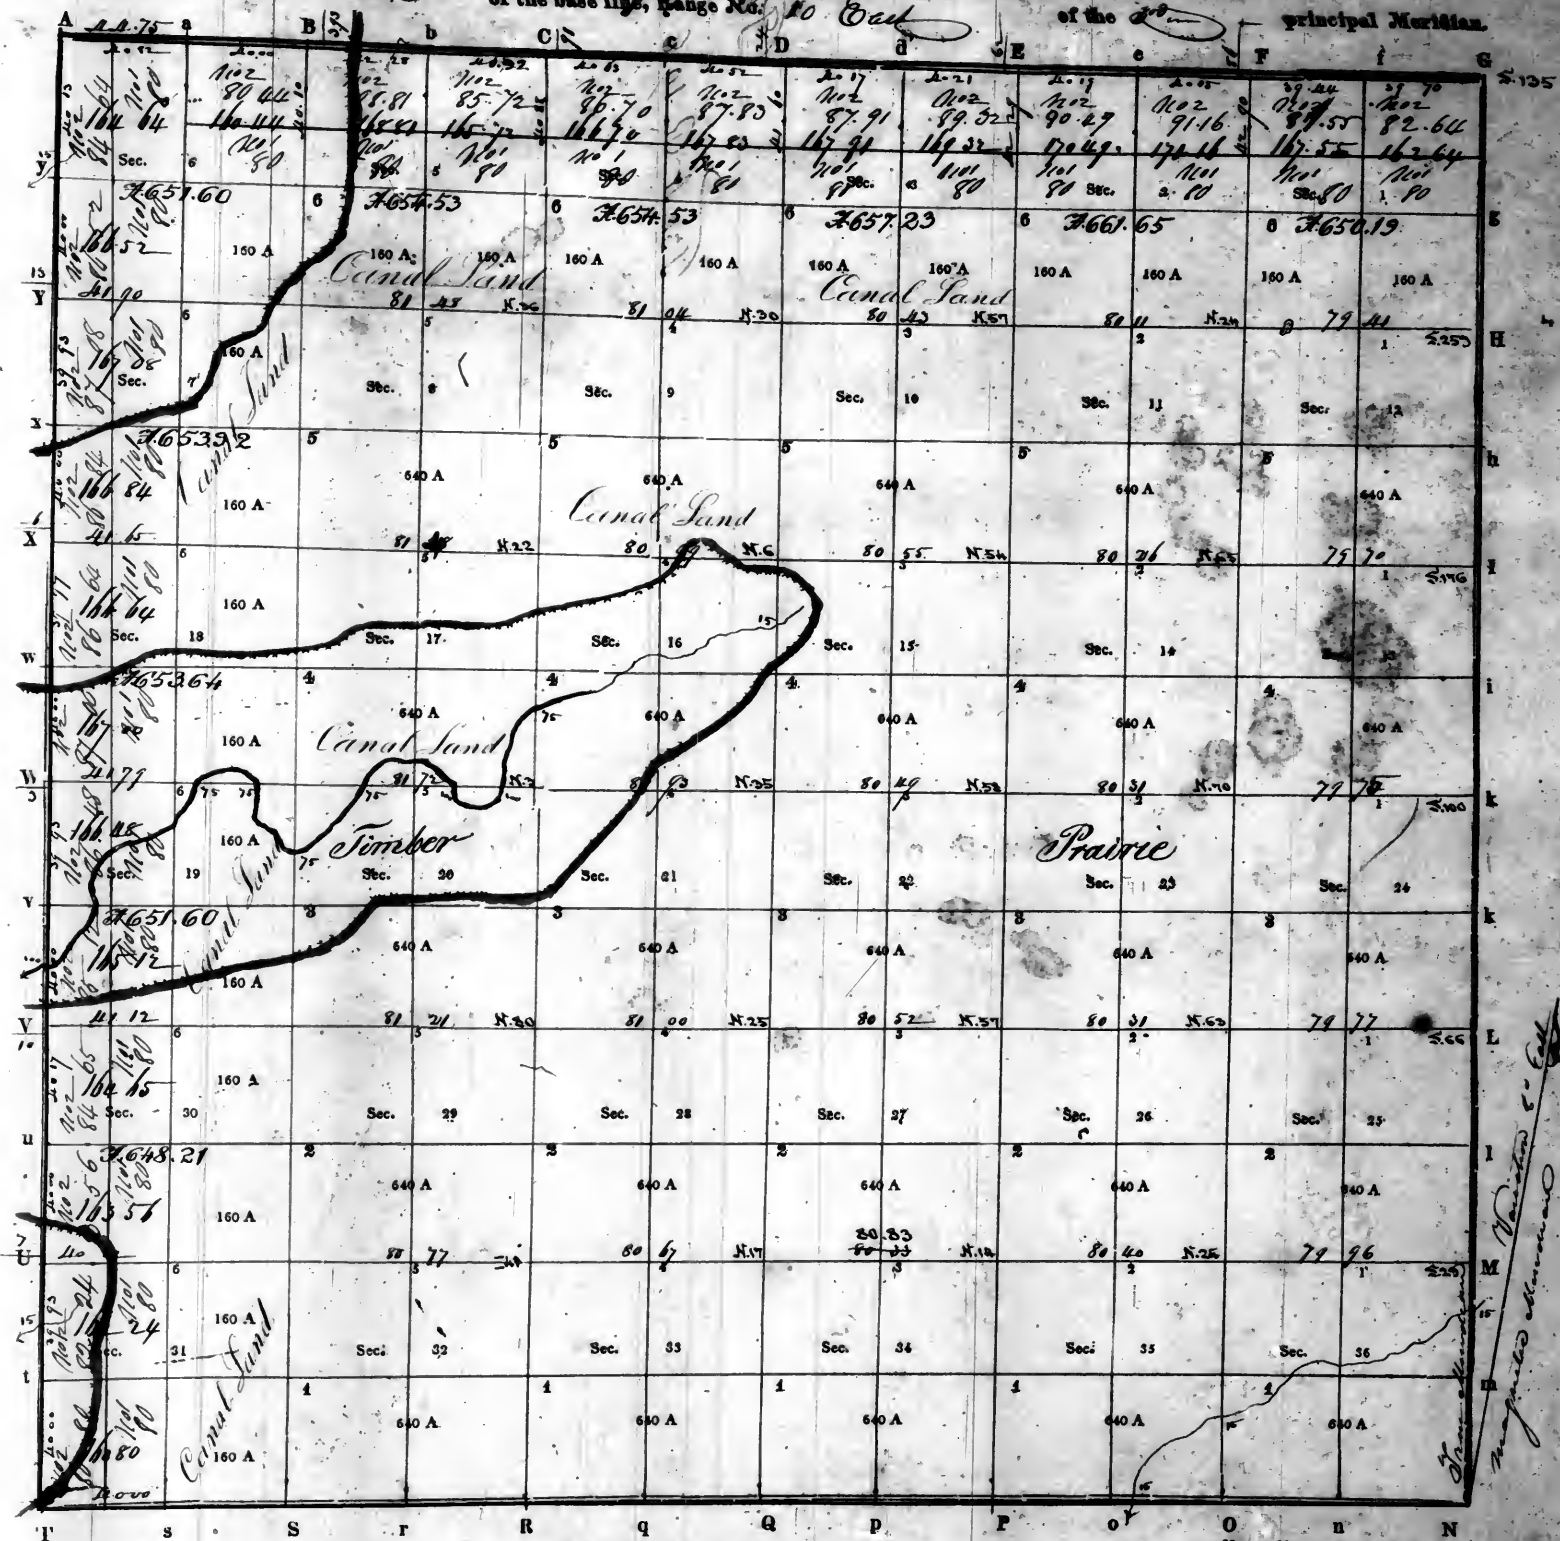

Aggregate area = 23180.14 acres


PURSUANT to a contract with, and instructions from William Rector, Surveyor of the lands of the United States in the State of Illinois, Illinois and Secretary of Arkansas, bearing date the twenty day of March 1827, I have measured, laid out and surveyed the above described Township; and do hereby certify, that it had such marks and bounds, both natural and artificial, as are represented on said plat, and described in the field notes made thereof, and returned with this plat into the Office of the Surveyor of the Lands of the United States, in the State of Illinois and Territory of Arkansas.

EXAMINED.


D. SURVEYOR.

See Vol 29 p 9

T. 35. V. 12. 10. E. of the 3rd pt. in Moore

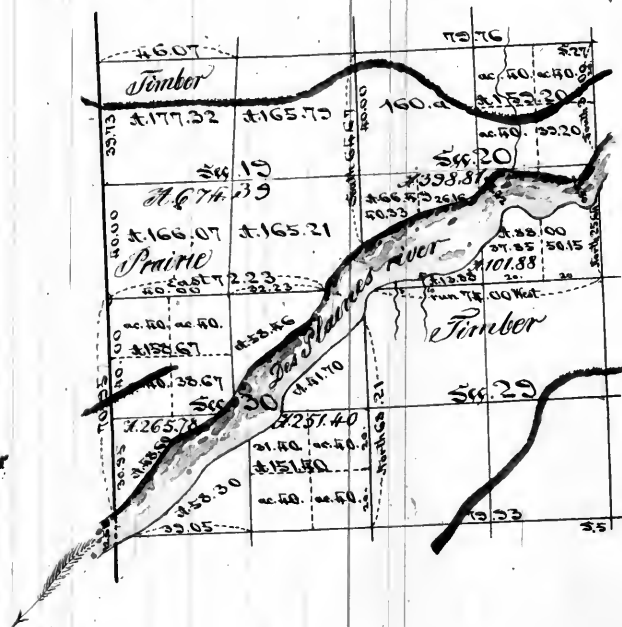

page 62 vol 11

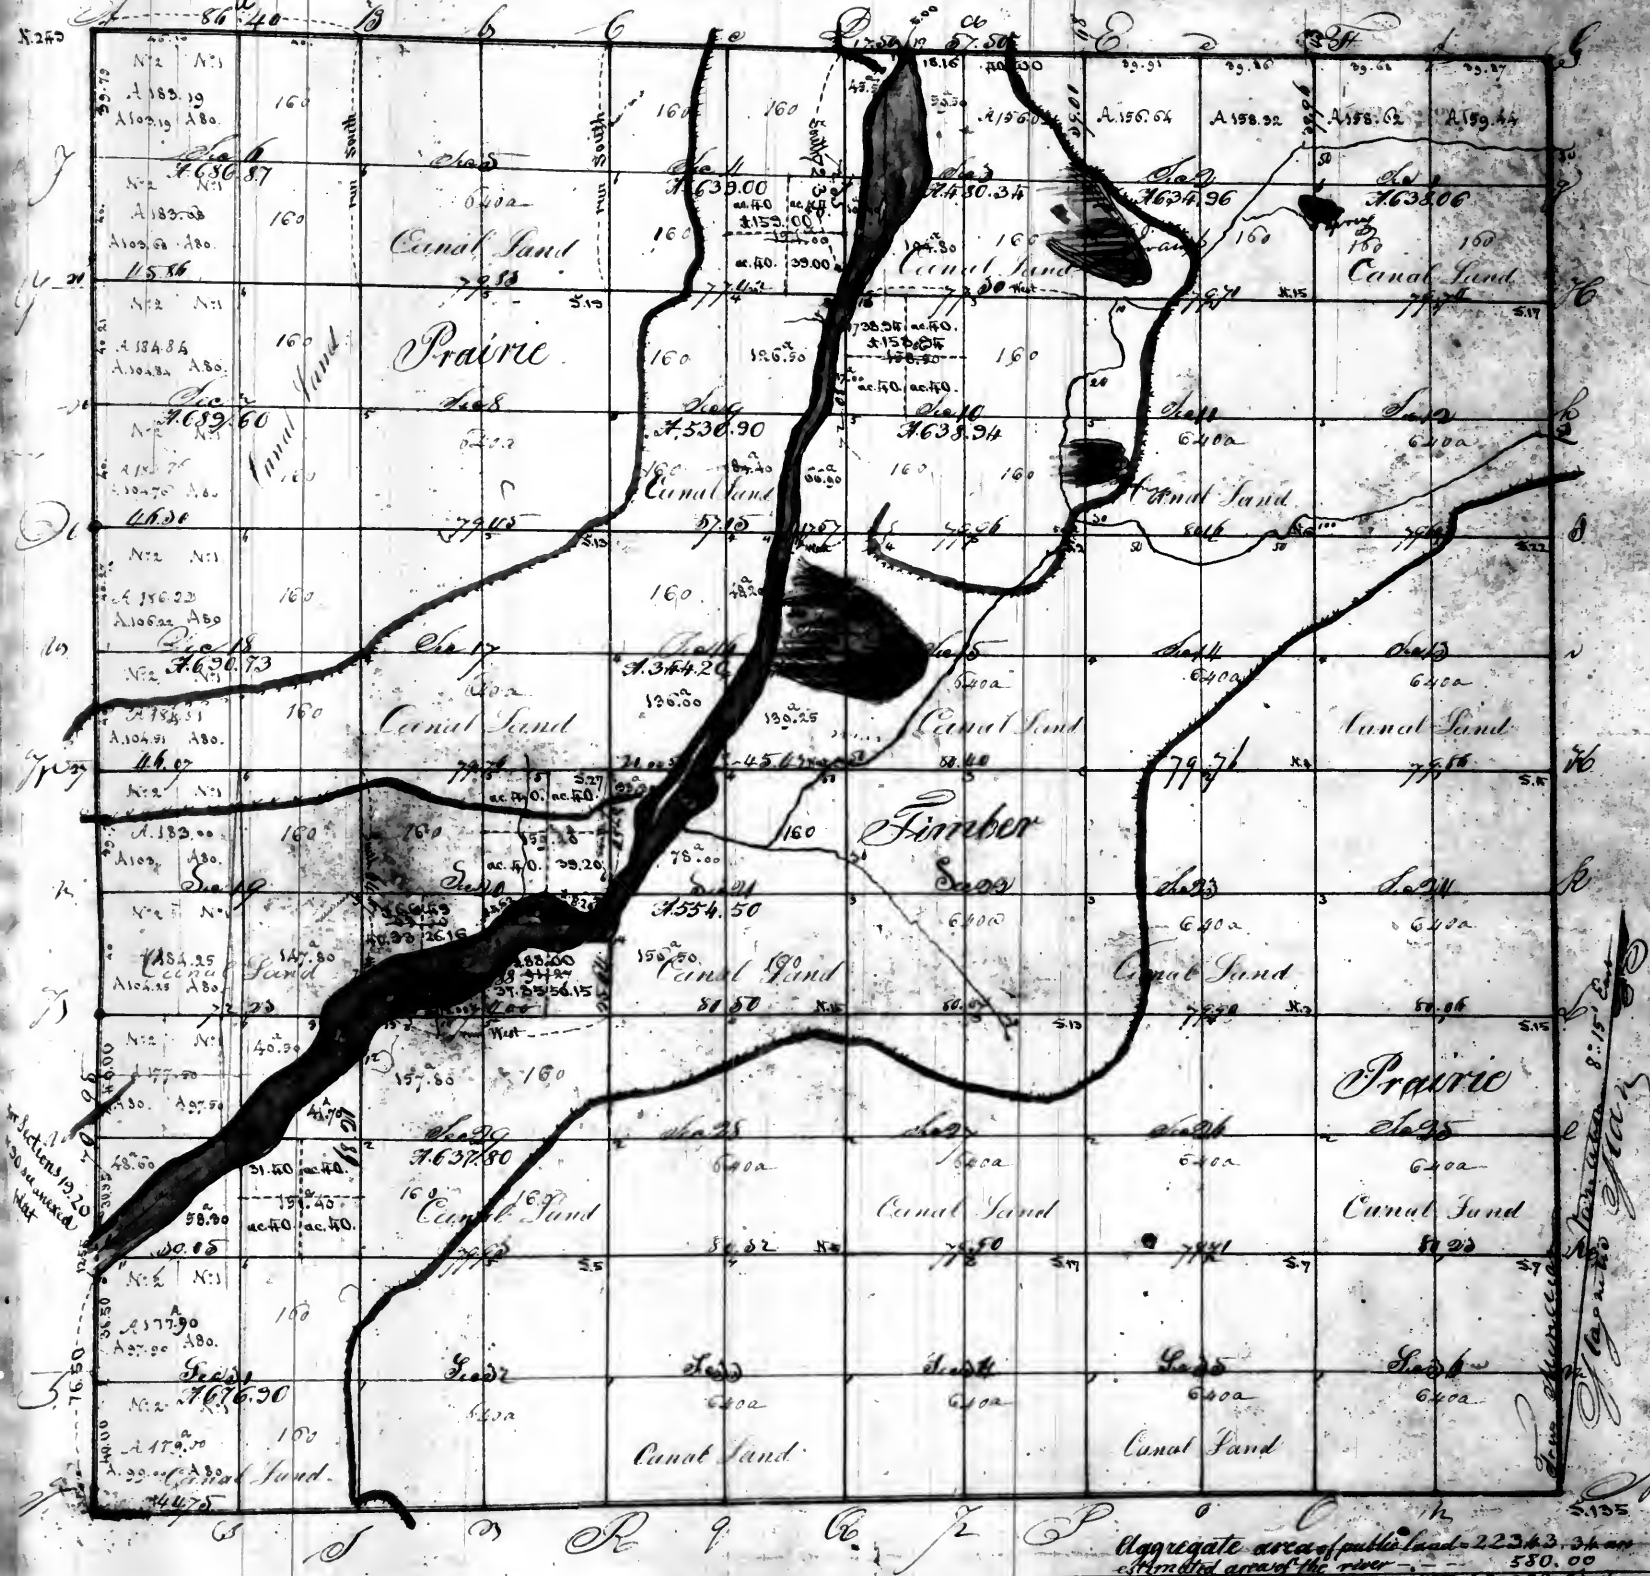


Aggregate area of public land 22343.34 ac.
 Estimated amount of the same 580.00

Pursuant to a contract with and instructions from William Rector Sheriff of the State of Illinois & of the Territory of Arkansas bearing date the 20th day of March 1831. We have examined the said land and survey and the above described Township and hereby certify that it is such as is shown and bounded both natural and artificial as are represented on said plat and as shown in the field notes made thereof and returned with this plat into the Office of the Surveyor of the Land of the United States in the State of Illinois & of the Territory of Arkansas. Witness my hand and seal this first November 1832.

Vol 29 p 10

Wm Rector
 Stephen Rector

page 62 vol 11

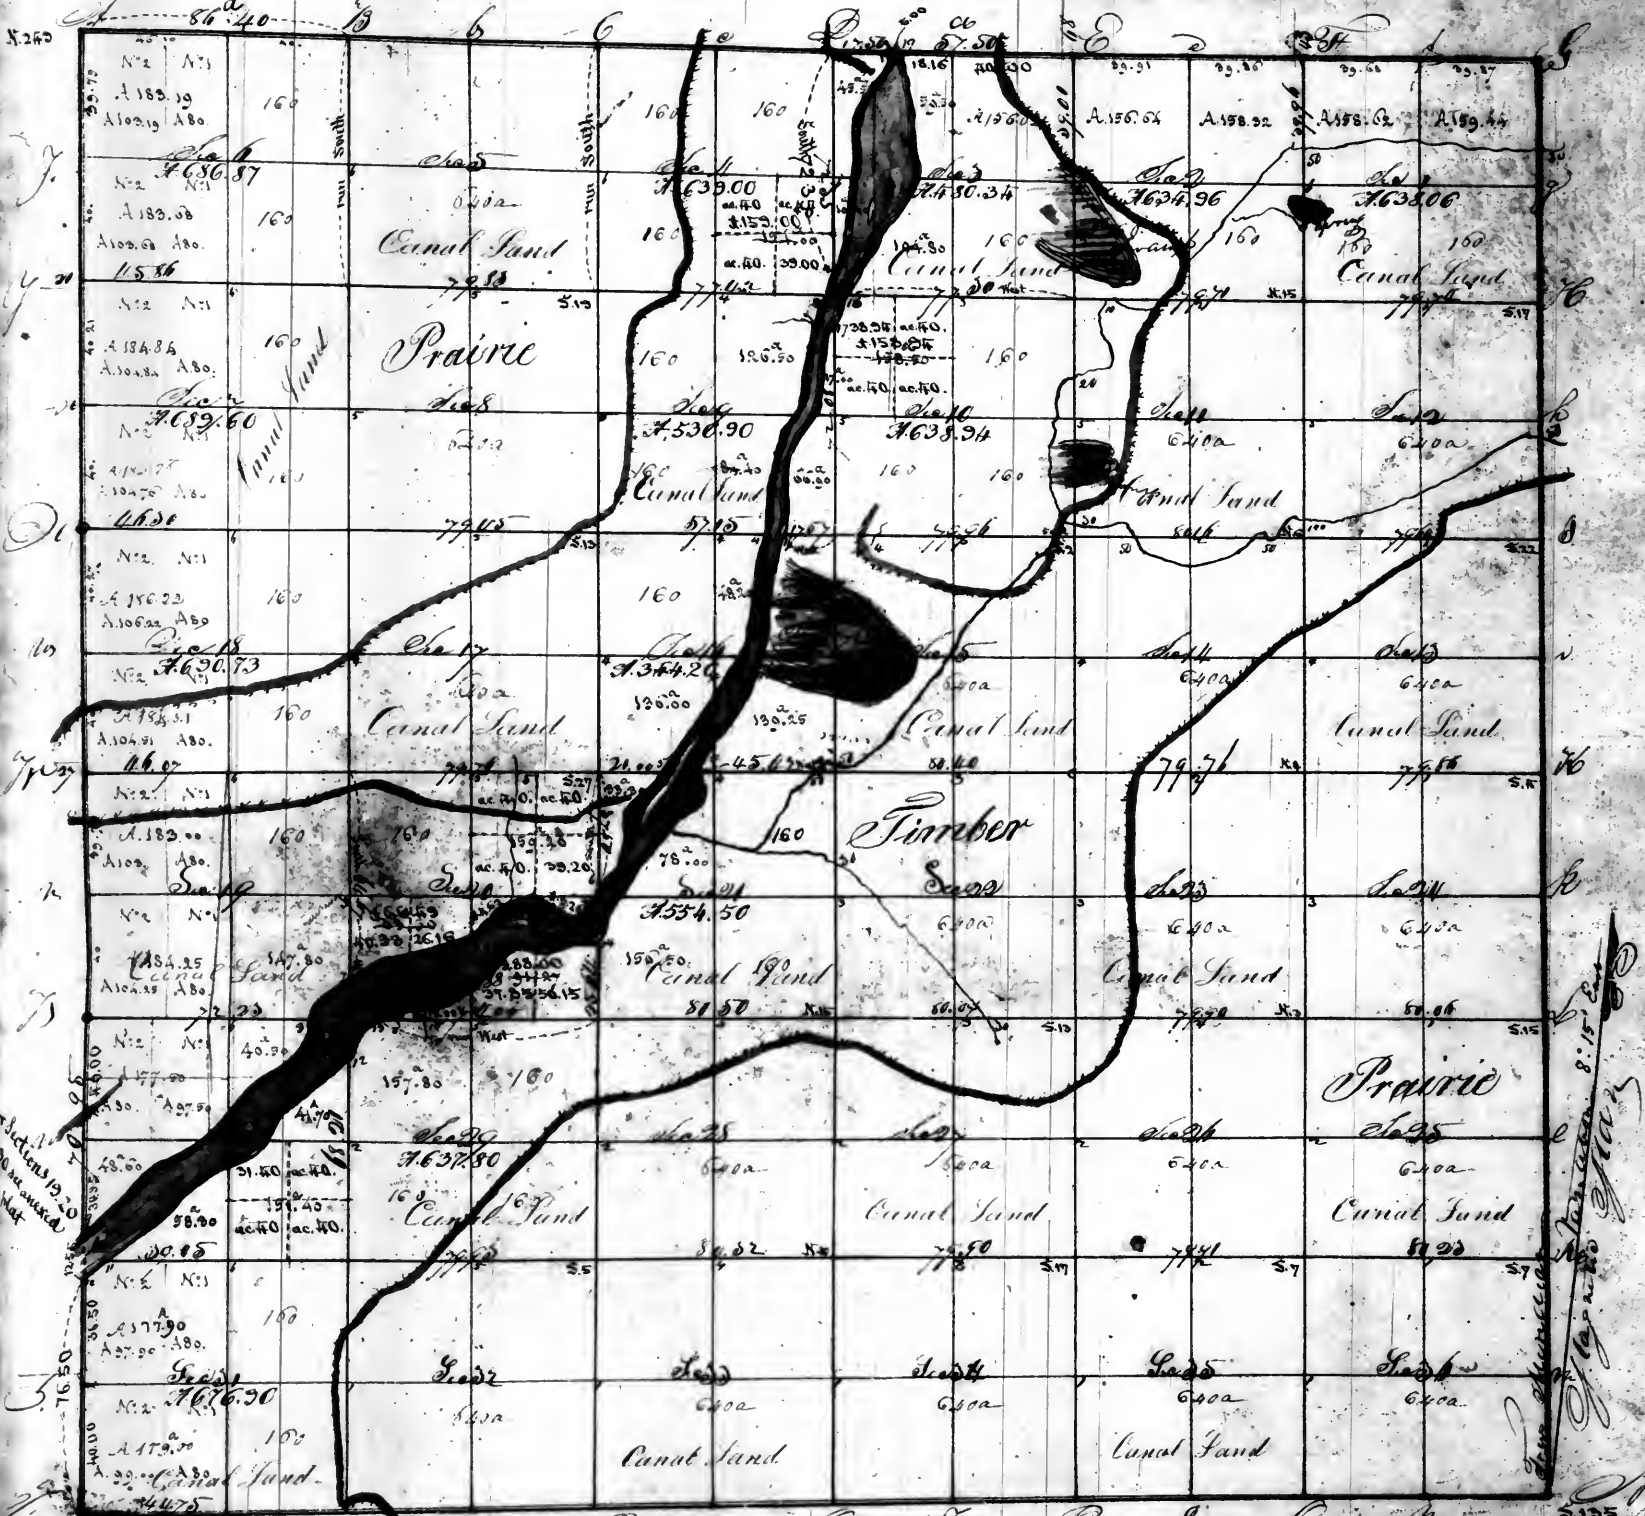




Examined


 Admitted area of the river 580.00

Vol 29 p 10

W. C. Rector
 Stephen Rector

Township 27 North of the Base line Range 10 East of the 3rd Principal Meridian

Vol 25 p 12

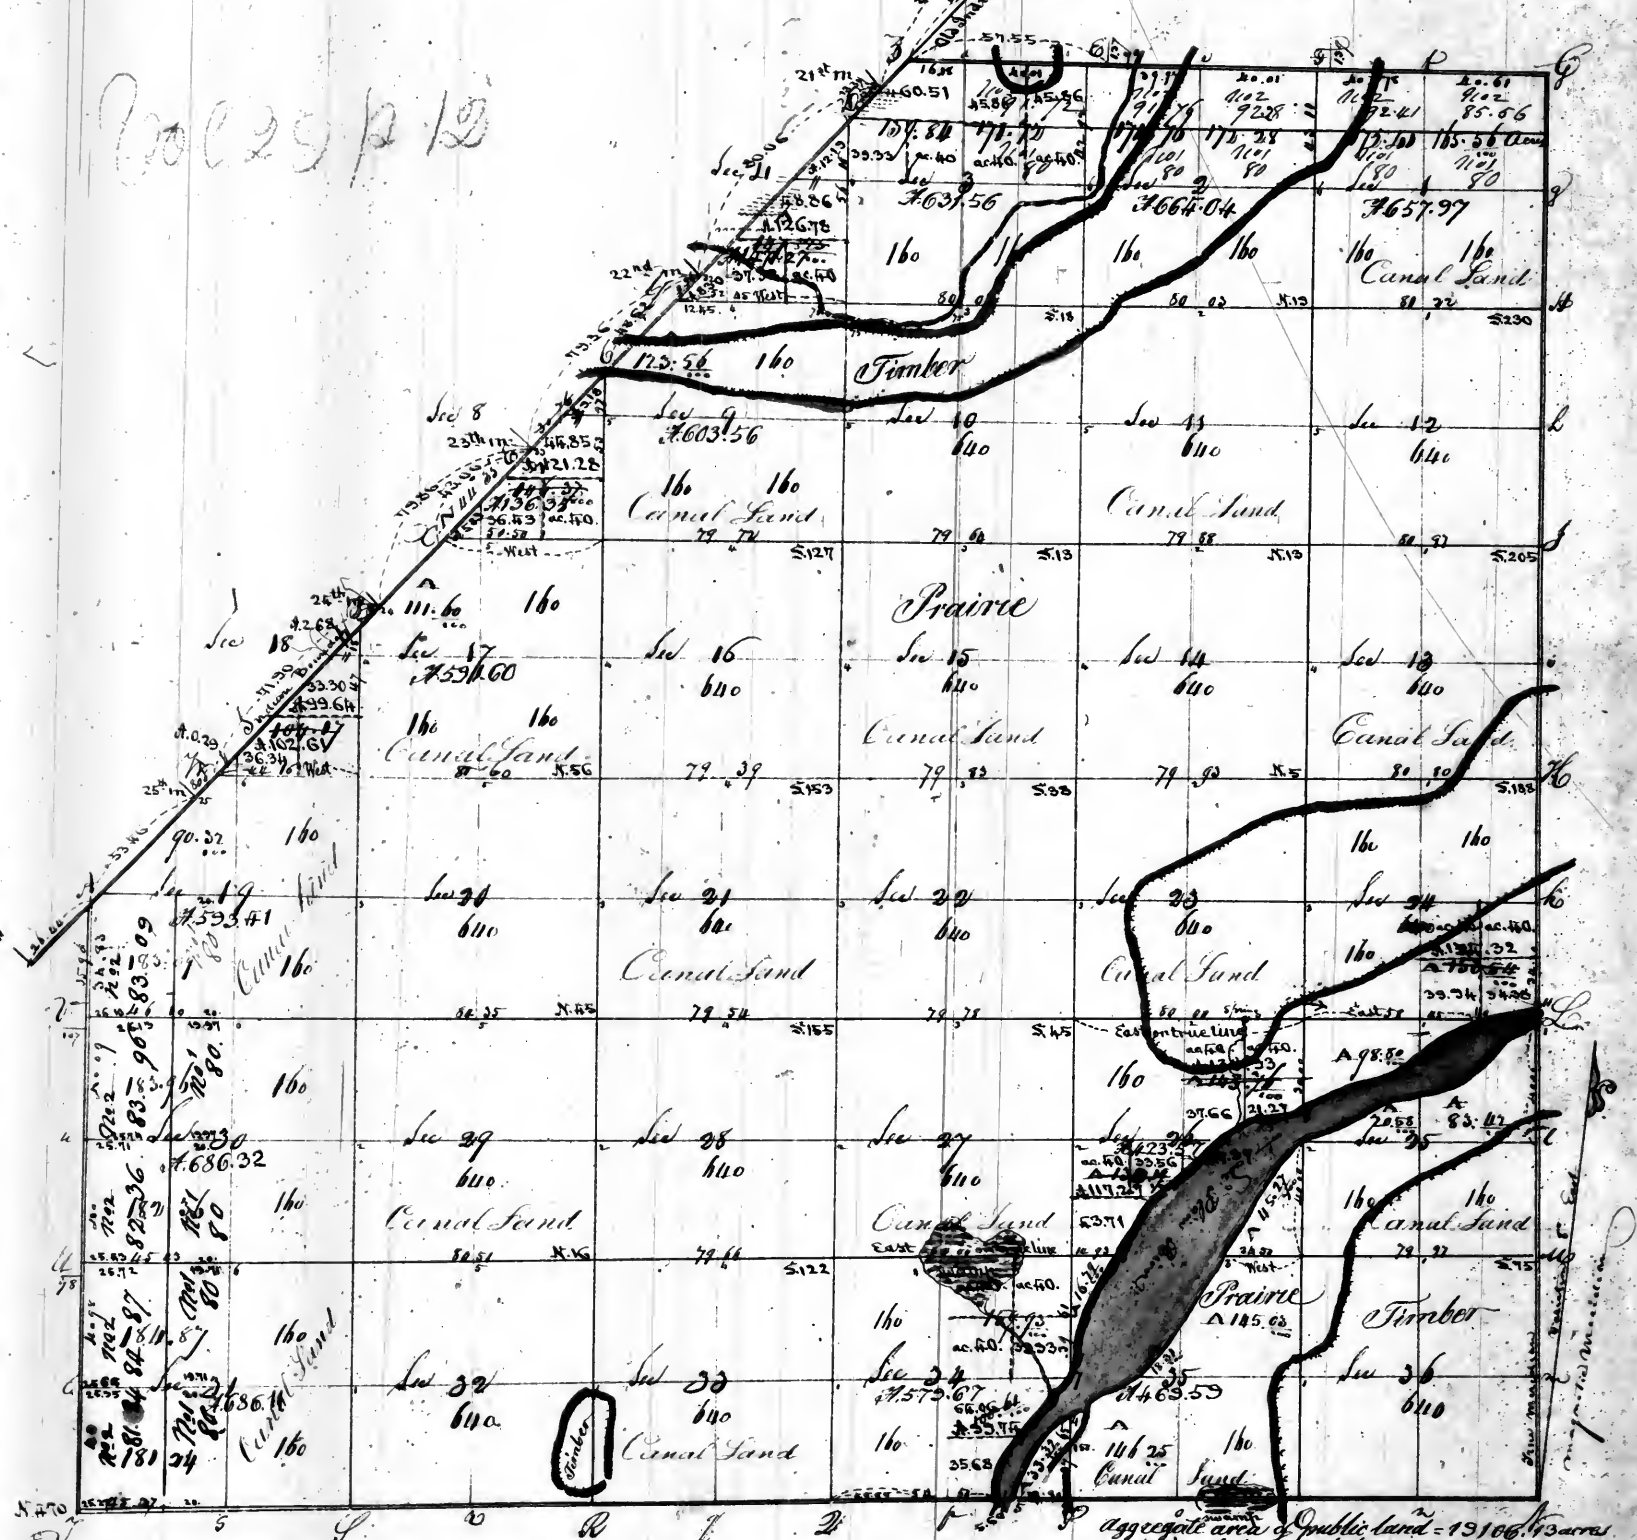


aggregate area of public land = 19106.13 acres
estimated area of the river = 475.00 ~
Total = 19581.13 acres

Pursuant to a Contract with and instructions from William P. Smith Surveyor of the Lands of the United States for the State of Illinois, Missouri and Territory of Arkansas bearing date the 30 day of March 1820 I have advanced and laid out and surveyed the above described Township and as here by Certified that it had been marked and bounded both natural and artificial as an representation on said Plot and deposited in the field and made change and returned with this Plot into the Office of the Surveyor of the Lands of the United States for the State of Illinois, Missouri and Territory of Arkansas.

761.

page 65 Vol 11

Township N. 38 Arch of the Bear Run Range or 10 East of the 3rd for map a Meridian

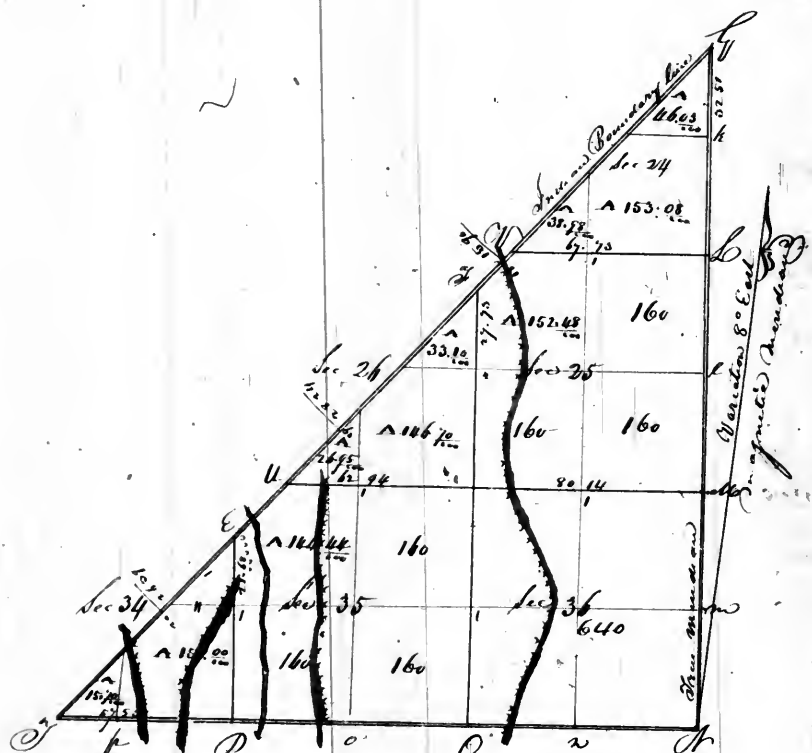

for new plat } See Vol 29 p 14
x for areas

VOL

14




aggregate area - 2986.23 acres


aggregate area - 2580.23 acres



October 29th April 1815

D. Sullivan Thayer

Sectional Township No. 3 North of the Base line Range No. 11 East of the third Principal Meridian
 page 68 vol 11

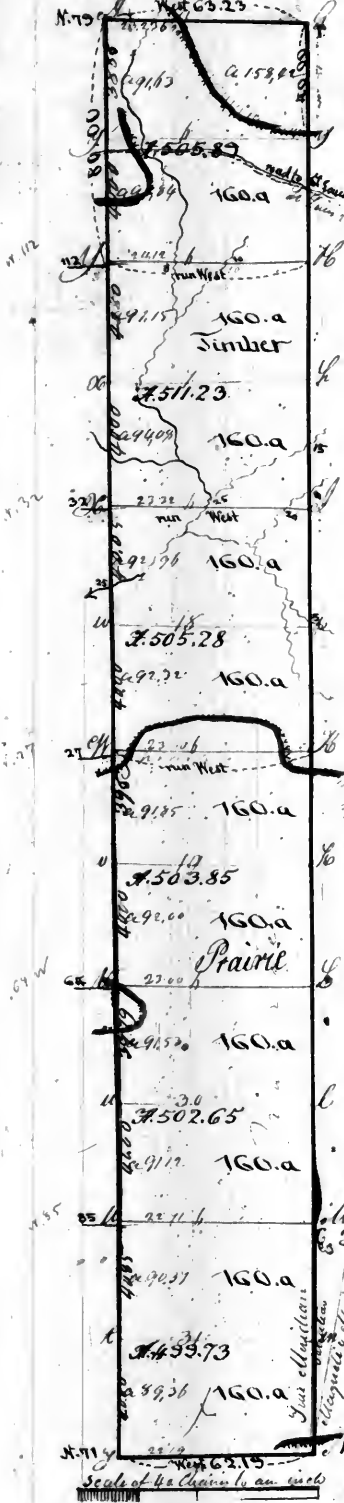

Aggregate area - 3028.63 acres

Pursuant to a Contract with and instruction from William Foster Surveyor of the Survey of the United States for the Surveyor of Illinois and adjacent bearing date the day of the above described fractional Township and do hereby certify that a copy of such map and survey with minutes and certificate as are represented in said Contract description in this field note were through and returned with this plat into the office of the Surveyor of the Survey of the United States for the Surveyor of Illinois and adjacent

Certified April 29th 1819

D. Sullivan Surveyor



Bearing by ^{Crump's} ^{Link}
 Post then ^{this} ^{has} ^{dit} Qualip R
 from Bearing by ^{Crump's} ^{Link}
 47. then ^{this} ^{has} ^{dit}

579

G B Cole 18 N 13 1/2 E 222
 do 11 N 64 1/2 E 325
 of Post in Missouri

H Post in Missouri Hot gently rolling Hotsy Post in Missouri the same as last
 E rate prairie

L B Cole 12 N 64 1/2 E 53

I Post in Missouri line prairie E rate H B Post in Missouri the same as last
 L B Cole 12 N 3 1/2 E 500

K Post in Missouri E rate prairie H B Post in Missouri E rate prairie

L B Cole 6 S 10 E 194

L Nickay 10 S 84 1/2 E 20 H to L broken Cole L to U 6 W Cole 18 S 26 E 34
 do 12 N 62 1/2 E 21 Lund do 10 N 54 1/2 E 38
 L Nickay 8 S 14 E 33
 do 14 N 40 1/2 E 32

M B Cole 20 S 47 E 110 H to L to half line M to U 19 Cole 24 N 26 1/2 E 80
 do 24 N 11 E 17 Lund prairie E rate do 30 S 46 1/2 E 70
 in Post in Missouri into Lund's river Cole's line
 in E 2000

N Post in Missouri N to J North
 S B Cole 8 N 76 1/2 E 139
 do 6 N 11 E 181
 J Post in Missouri N to 16 Lund
 do E rate and
 broken

U B Cole 20 N 35 E 46 H to U good land
 do 18 S 39 E 72 Lund E rate
 U Timber Oak heavy

V B Cole 12 N 53 E 75 H to V part prairie
 do 20 S 28 E 111 river and prairie
 lowland E rate

W Post in Missouri W to H level
 W to P rate
 prairie

X Post in Missouri X to Y the
 same

Y Post in Missouri Y to A the
 same as last

Land line heavy prairie
 A Post in Missouri H to G land E rate prairie gently
 rolling


Aggregate area = 3067.02 acres

Pursuant to a Contract with and Instructions from William Peter Surveyor of the Lands of the United States for the District of Illinois and Illinois bearing date the day of _____ 1863, I have such maps and books both natural and artificial as are represented on said Plat quod described in the field notes made thereof and returned with the plat into the office of the Surveyor of the Lands of the United States for the District of Illinois and Illinois.

Artificia Apr 29th 1819

D. Sullivan Surveyor


584
au
②

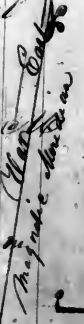

A. Suringer

Township 17 North of the Range 11 East of 3 Principal Meridian.
 page 72 vol 11

582

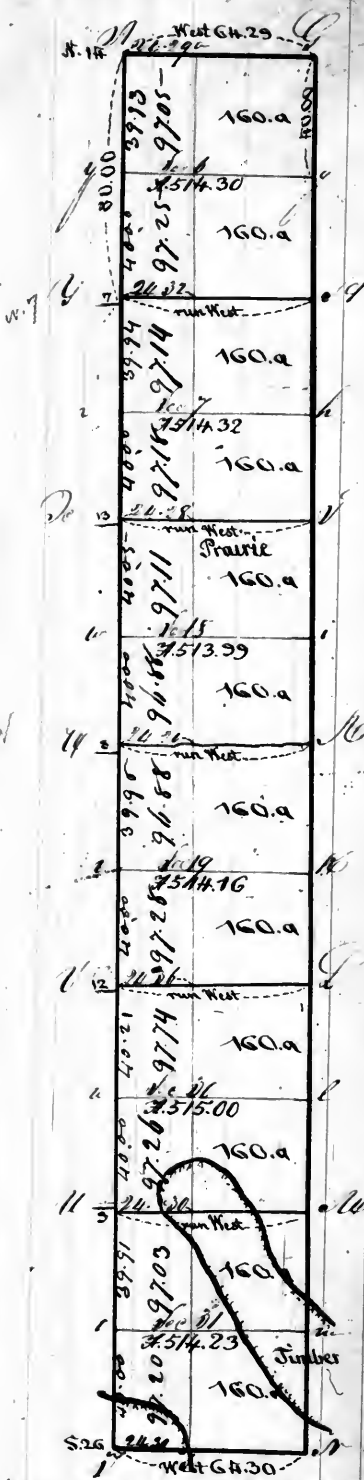


Scale of 40 Chords in Ch.
 Aggregate area - 3085.98 acs.

Herewith to a Contract with an authorization from William H. H. Surveyor of the Land
 of the United States in the State of Illinois and Territories of Missouri and Arkansas
 bearing date the day of
 Surveyor the above described Township and do hereby certify that it has
 been marked and bounded, both natural and artificial, as are represented on
 said plat, and described in the field notes made therefor, and returned with the
 plat into the Office of the Surveyor of the Land of the United States for the
 State of Illinois and Territories of Missouri and Arkansas
 On this day of

Examined

D. Surveyor
 October 1820.

Township 11:8 North of the Base Line Range N:11 East of 70:00 W.
 page 73 of 11

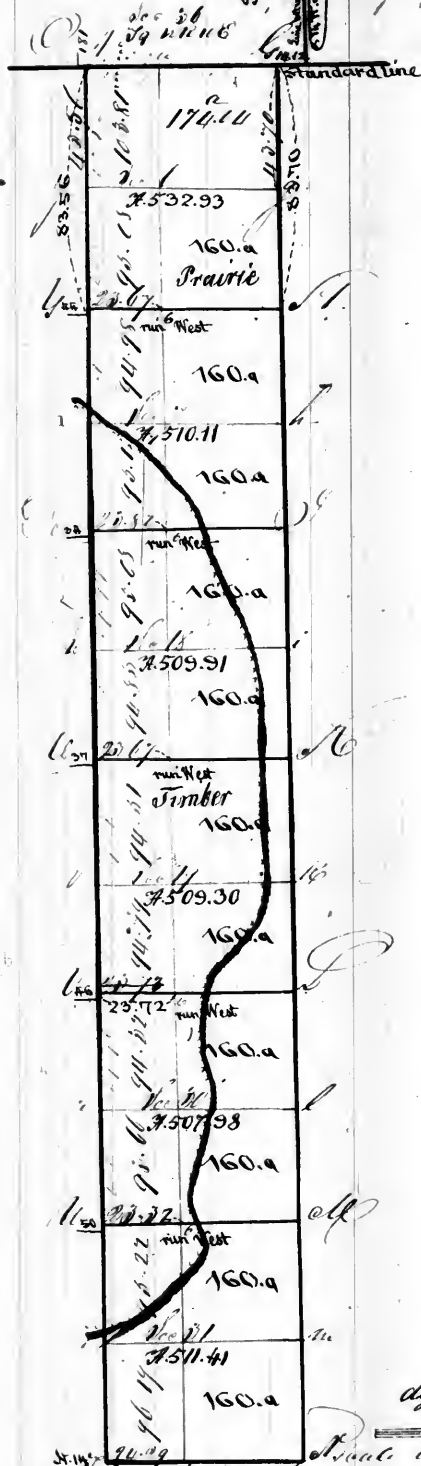

aggregate area = 3081.64 acres


Pursuant to a Contract with and instruction from William Hester Surveyor of
 the lands of the United States in the State of Illinois and Territories of Wisconsin
 and Arkansas bearing date the 1st day of May 1854 I have examined
 said land and have found the above described 70.00 square rods and do hereby
 certify that it has been marked and bounded by natural and artificial as the
 corners in said State and Territory in the field notes made by me and by
 with this plat into the State of the survey of the lands of the United States for
 the State of Illinois and Territories of Wisconsin and Arkansas
 Witness my hand and seal this 1st day of

Examined

D. Surveyor

Page 4 of 11

~~61~~
~~584~~

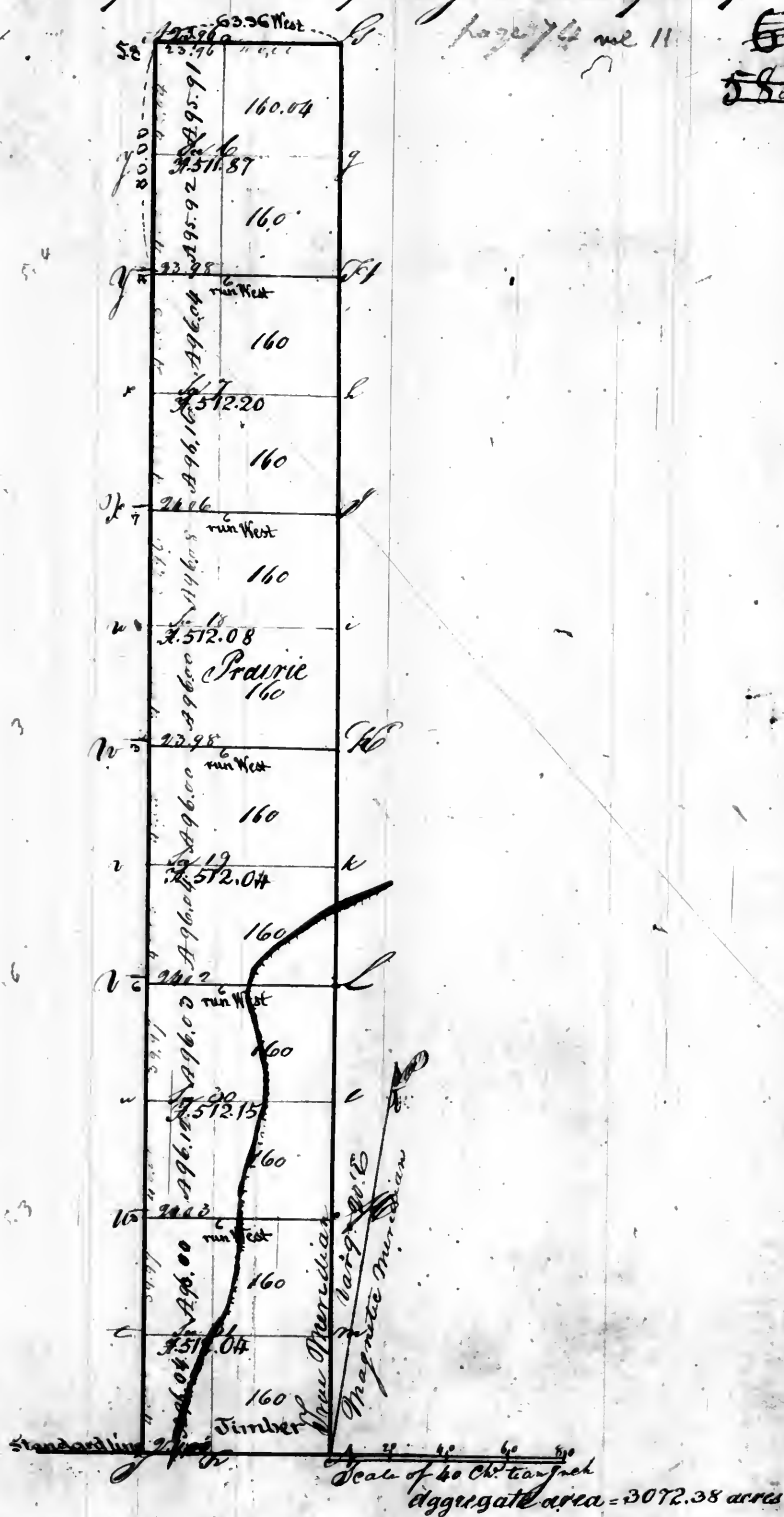


Pursuant to a contract with and instructions from William Parker Surveyor of the Lands of the United States
in the face of Messrs and Secretaries of Josephine District bearing date the day of

I have administered laid out and surveyed the above described Township and do hereby certify that it had such metes and bounds both natural and artificial as are represented on said Plat and described in the field notes made thereof and returned with the plat into the Office of the Surveyor of the lands of the United States for the State of Illinois Territory of Mississippi, Arkansas &c
 26th Feby 1854 day of

July 1826

The township No. 10. North of the Base line of Range No. 11. East of the 5th Meridian
page 75 vol. 11

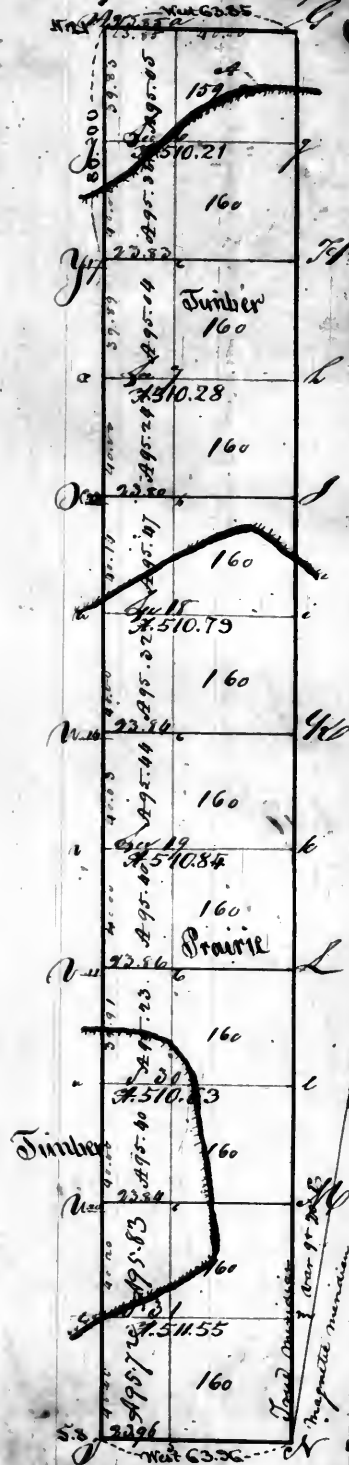


aggregate area = 3064.30 acs

Pursuant to a contract with and instructions from William B. Potter, Surveyor of the lands of the United States in the State of Illinois and Territories of Wisconsin & Arkansas bearing date the _____ day of _____
I have measured laid out and surveyed the above described Township and do hereby certify that the boundaries and bounds both natural and artificial as are represented on said plat and described in the field notes made thereof and returned with this Plat into the Office of the Surveyor of the lands of the United States for the State of Illinois & Territories of Wisconsin & Arkansas
Witness my hand and seal this _____ day of _____ 1820

T^h North Range 11 East of the 3rd principal Meridian.

page 76 vol 11

586

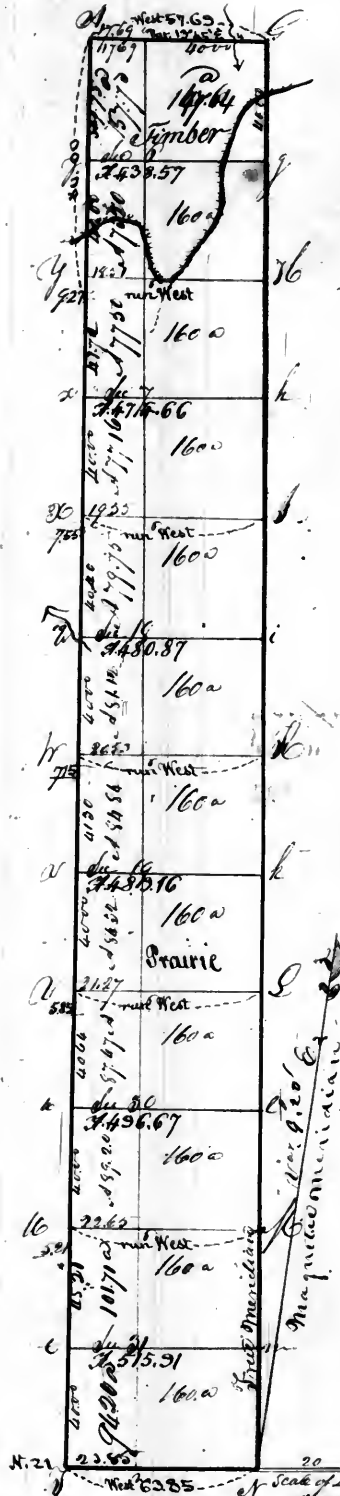

Pursuant to a contract with and instructions from William Bester Surveyor of the Lands of the United States in the States of Illinois and Missouri and Territory of Arkansas bearing date the 7th day of January 1821 I have admeasured laid out and surveyed the above described Township; and do hereby certify that it has such marks and bounds both natural and artificial as are represented on said plat and described in the field notes made thereof and returned with this plat into the office of the Surveyor of the Lands of the United States for the States of Illinois and Missouri and Territory of Arkansas.

Certified this 14th day of September 1821

Examined

W^m Bester Surveyor

Tract Township N 13 North

of Range 11 East 30th Meridian
page 7 of vol 11



Aggregate area = 2255.51 acres

Pursuant to a contract with and instructions from William Rector Surveyor of the Lands of the United States in the States of Illinois & Missouri & Territory of Arkansas bearing date the ninth day of April 1824 I have accompanied and surveyed the above tract Township & hereby certify that it had such marks & bounds both natural and artificial as are represented on said plat & described in the field notes made thereof & returned with this plat into the office of the Surveyor of the Lands of the United States in the States of Illinois & Missouri & Territory of Arkansas

Certified 28th day of July 1821


Martin Jones, D. S.

Examined

589 66

Township N. 12 East of the Pawnee Range N. 11 East of the 3rd Principal Meridian

P. Page 79 vol 11

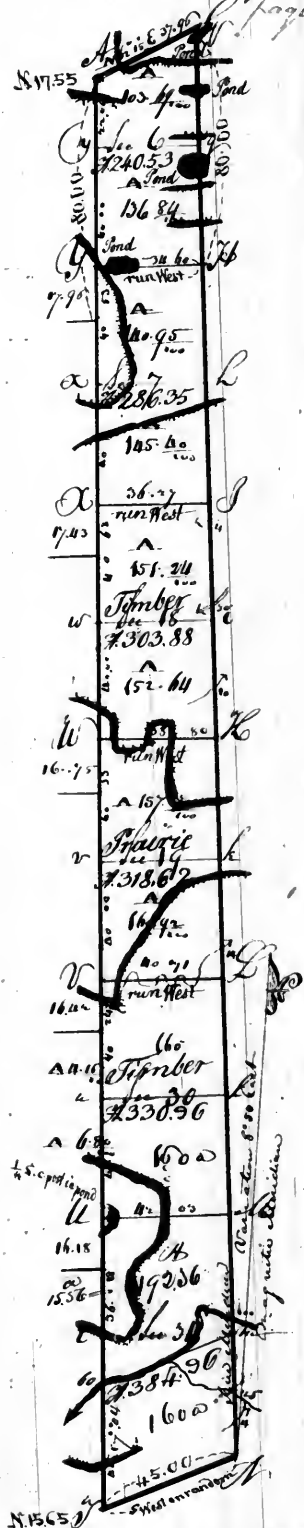


Aggregate area = 2255.51 acres

Proceeded to a point to rest wells and over land survey from
 for US No. of Illinois etc. farm and District of Illinois was bearing this the day of April 1821 I have advised
 more and not and surveyed the above the survey as Township and no survey. Entire that it has been
 tracks and. Corners both natural and artificial as are represented on said plat and are entered in
 the General note made thereof and returned with this plat into the office of the Surveyor of
 the lands of US under the Act for the State of Illinois of 1820 and Survey of it thereon

Edmund D. Brayer

Township No. 16 N. & E. of the Principal Meridian
Page 81 of 11.


68
591.

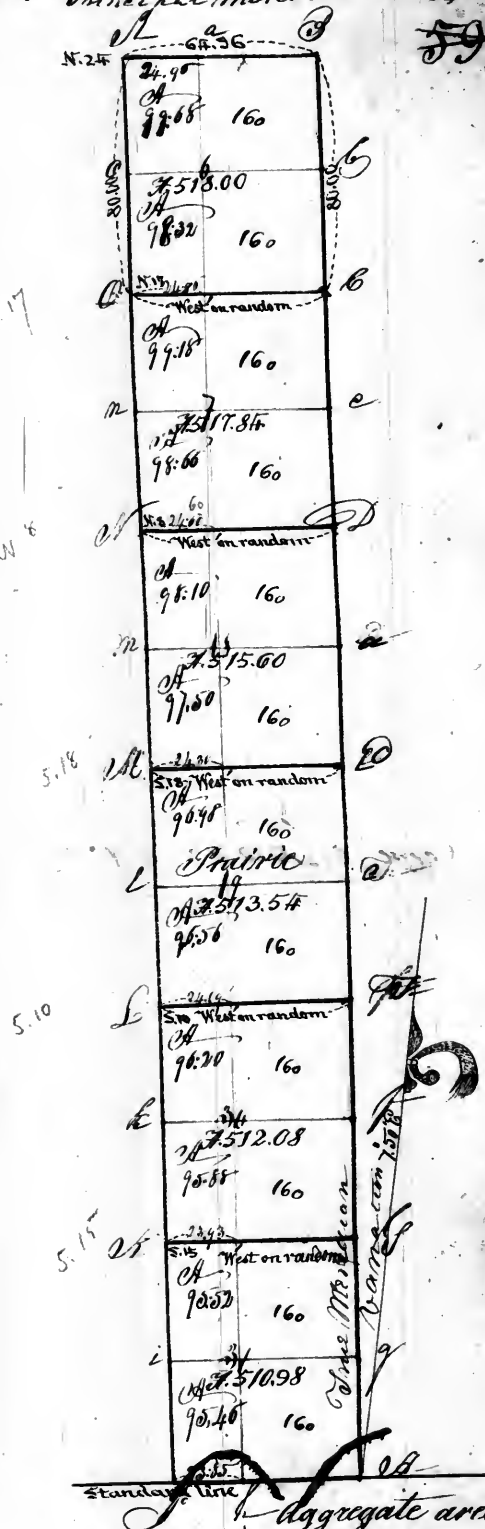

Pursuant to a contract with and instructions from State of the Chicago and West
Michigan. Director, Surveyor of the lands of the United States in the State of Illinois
and Missouri and Territory of Arkansas bearing date the 10 day of March 1821 I have
examined the Plat and survey the above described Township and
do hereby certify that it has such marks and bounds as are represented on
said plat and are entered in the field notes near thereof and returned with the
plat into the Office of the Surveyor of the lands of the United States for the State
of Illinois and Missouri and Territory of Arkansas as certified the 11th day of June 1821
Jas. J. J. J.

Tract township No. 17 N. R. 11. E. of the 2d Principal Meridian
page 82 vol 11

592

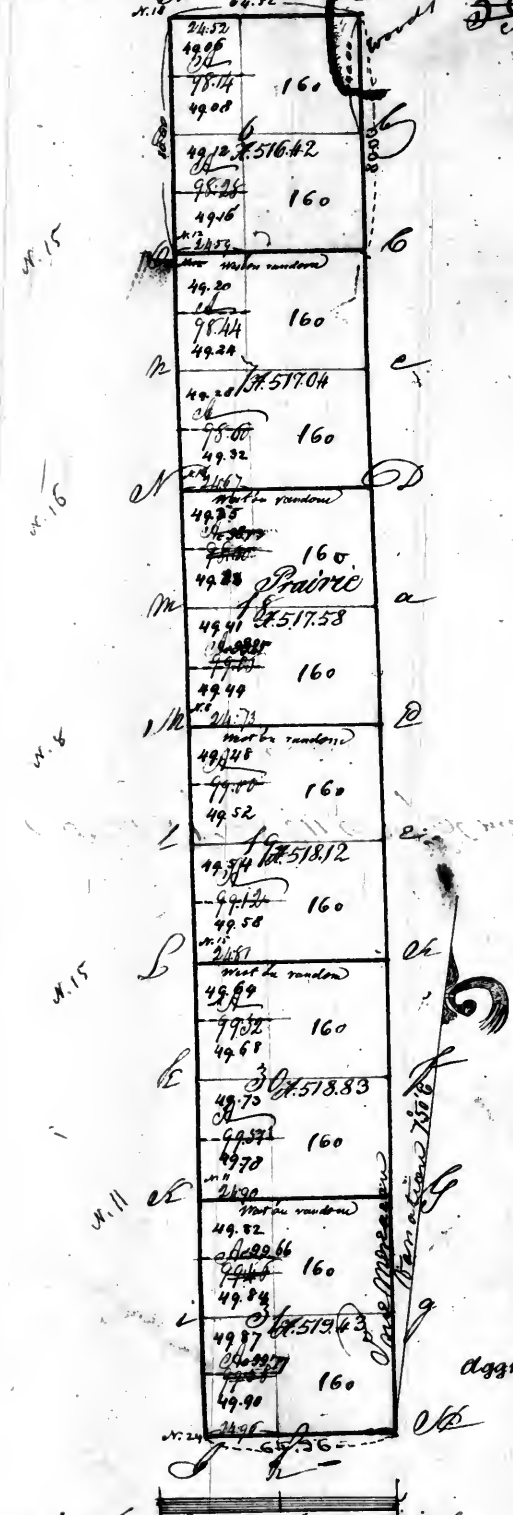


Surveyor's office
Saint Louis June 9th 1849.
The west halves of sections 6, 7, 11, 19, 30 & 31
subdivided under the act of Congress of the 6th of
April 1832, and a plat sent to the Register
and another to the Commissioner of the
General Land office.

aggregate area = 3107.42 acres

Pursuant to a contract with and instructions from State of the Missouri to and such
William Dooley Surveyor of the lands of the United States in the State of Illinois
and Missouri (and Territory) of Arkansas bearing date the 10 day of March
1831. I have measured &c. &c. and survey the above described fractional
Township and do hereby certify that it had such marks and bounds both
natural and artificial as are represented on said plat and as shown in the
field notes made and returned thereof with this plat and returned into the office
of the Surveyor of the lands of the United States for the State of Illinois and
and Missouri and Territory Arkansas certified the 11 day of December 1831.
J. H. Smith

Tract township N. 18. N. R. 11. E. of the 10th Principal Meridian page 83 vol 11 70 59

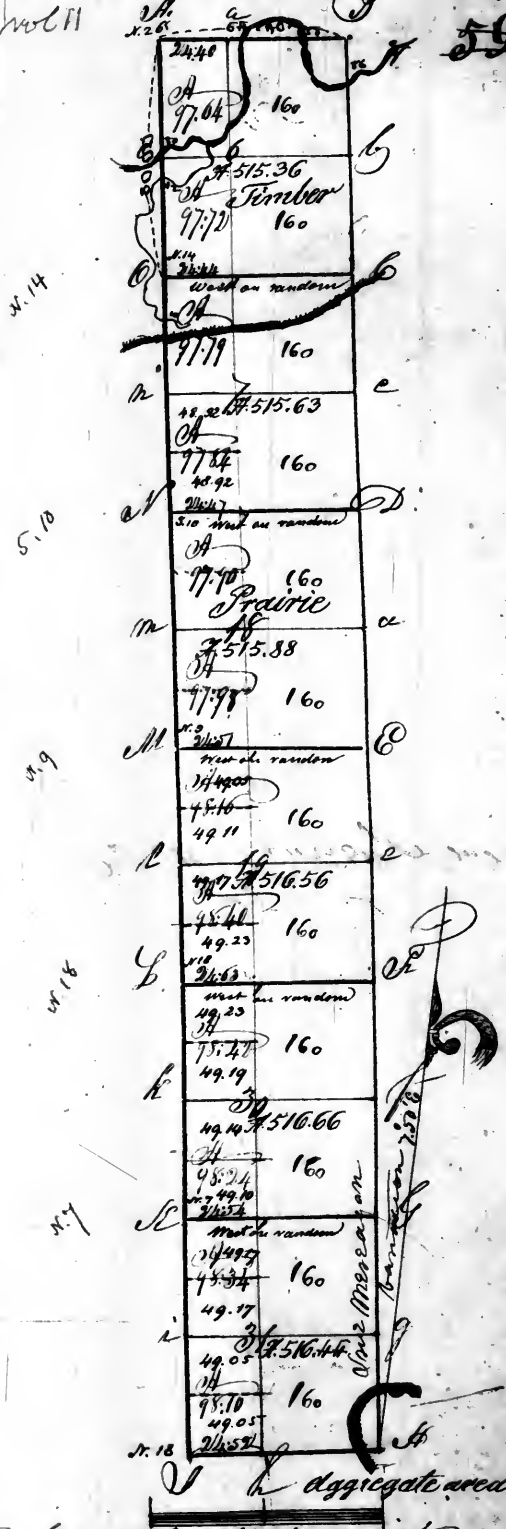

Surveyor's office
 Saint Louis June 5th 1849.
 The South west quarter of section 7, and the west
 halves of sections 19, 30 & 31, subdivided under the
 act of Congress of the 5th of April 1832, and a
 plat sent to the Register and another to the
 Commissioner of the General Land office

Pursuant to a contract with and instructions from
 William B. Rector Surveyor of the lands of the United States in the State of Missouri
 and Missouri and Territory of Arkansas bearing date the 10 day of March 1841.
 I have measured said land and a survey of the above described tract of land
 and as hereby certified that it is in fact such lands and borders both natural and artificial
 as are represented on said plat and ascribed in the field notes made and
 returned to the office of the Surveyor of the lands of the United States for the State of Missouri and Territory of Arkansas
 on the 11th day of December 1841.
 Jacob G. D. Dwyer


Aggregate area = 3086.53 acres



Pursuant to a contract made and instructions from State of Kentucky
 William Rector, Surveyor of the lands of the United States in the State of Illinois and
 Missouri and Territory of Arkansas bearing date the 13 day of March 1831. Charles mean
 laid out and surveyed the above described tract. Variation thereof and as hereby certified
 that it had such marks and bounds as are ^{well known and established} represented on said plat and are marked in the
 field notes made and returned thereof into the office of the Surveyor of the lands of
 the United States for the State of Illinois and Missouri and Territory of Arkansas
 Certified this day of December 1831.

Surveyor's Office
St. Louis, May 19th 1832
Subdivided the 2nd of the West halves of Sec. 36, Twp. 2
S. N. of R. 13, the S. 1/2 of Sec. 15, & the S. 1/2 of Sec. 2
under the Act of Congress of the 5th of April 1832, and
sent W. G. Sec. 18 & 20, and the S. 1/2 of Sec. 19,
etc. according to previous sales (made) & thereupon
I sent a copy to the Register & another copy to
the Commissioner of the Land Office
3088. 56.42

Practic township N. 20. E. R. 12. S. Principal Meridian
page 85 of 11

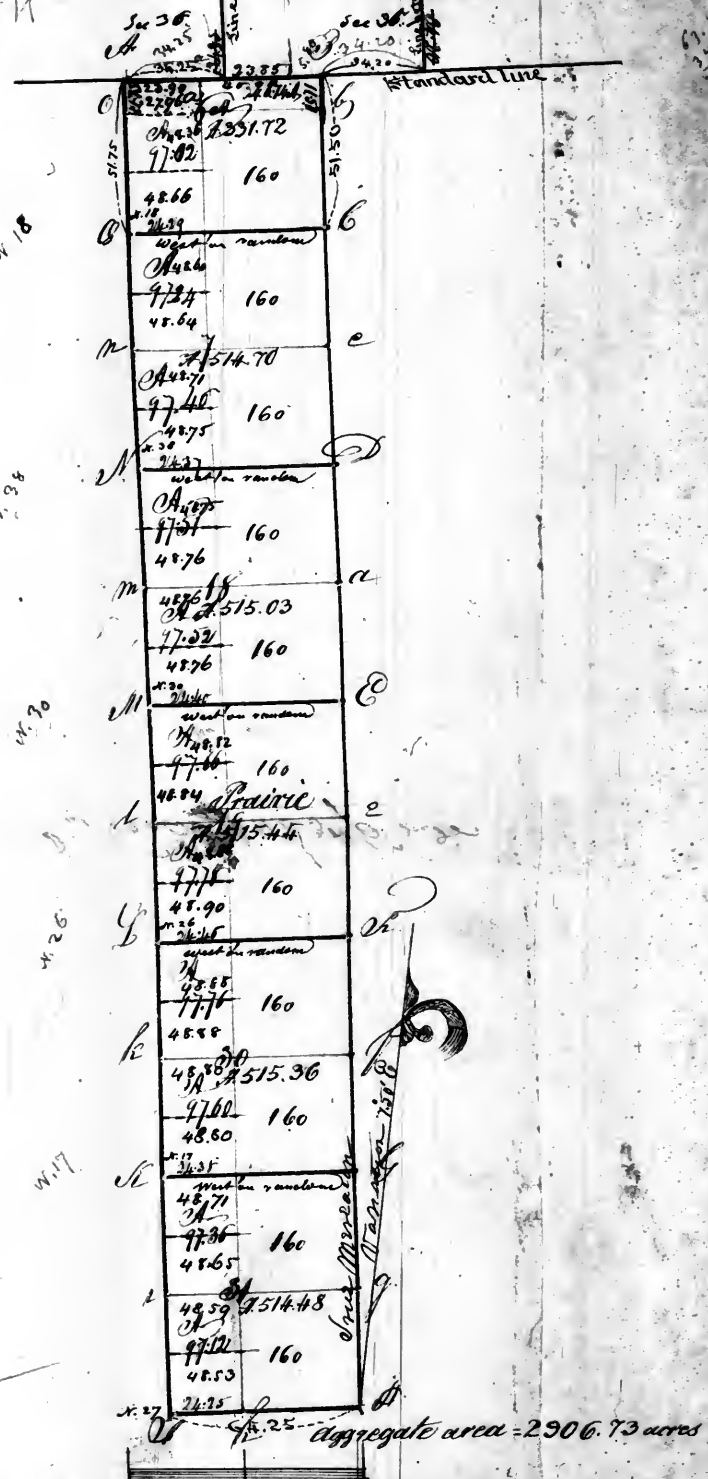


Surveyor's office
Saint Louis June 9th 1849.
The South west quarter of section 6 and the west halves
of sections 7, 16, 19, 30 & 31, subdivided under the act of
Congress of the 5th of April 1832, and a plat sent
to the Register and another to the Commissioners of the
General Land office.

Pursuant to a contract with and instructions from Seal of the Chain to survey
William Beeson Surveyor of the lands of the United States in the State of Illinois and
a Missouri and Territory of Arkansas (bearing) dated the 13 day of March 1831 I then
accompanied him and surveyor the above described section in Townships
and as hereby certifying that it had such marks and bound both Missouri and
Arkansas as are represented on said plat and as marked in the field from the
line of and returned with the plat into the office of the Surveyor of the lands of the
United States for the State of Illinois and Missouri and Territory of Arkansas
I signed this 11th day of December 1831

Jacob Judy Surveyor


Tract Township N. W. A. R. N. C. of the 3 Principal Meridian
 page 86 vol 11

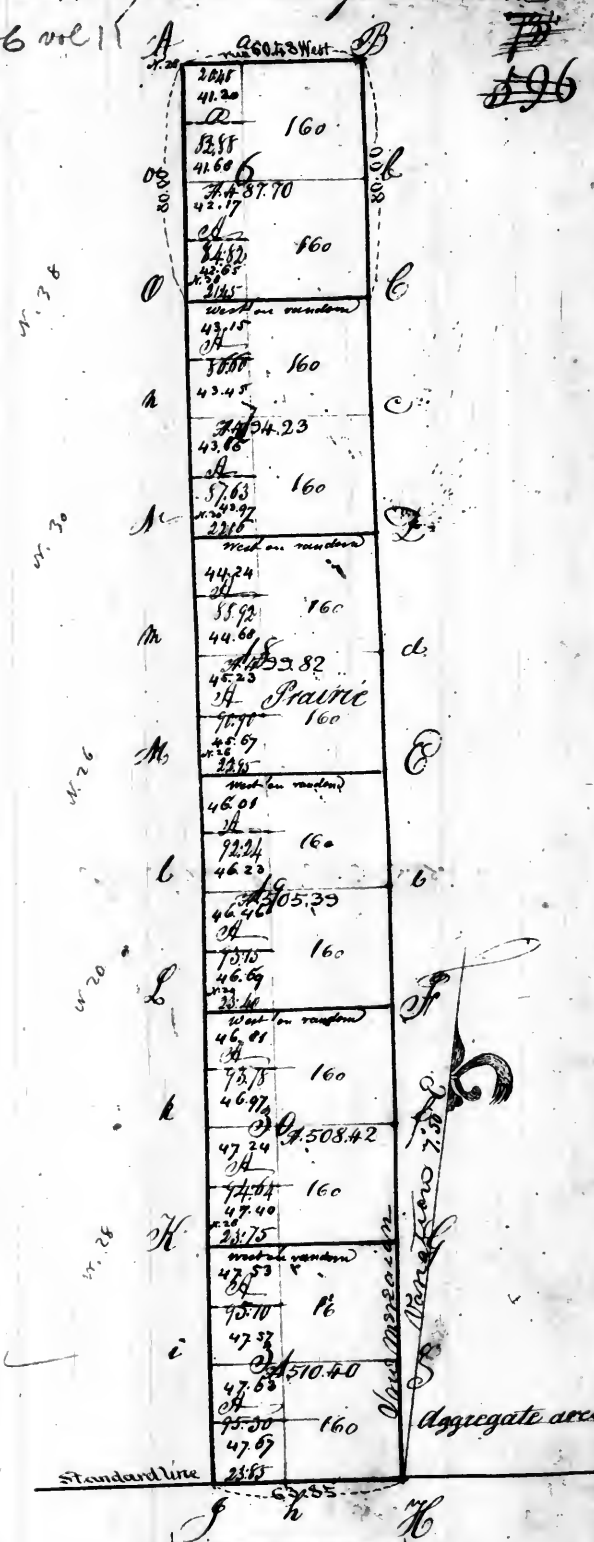

Surveyor's office
 Saint Louis June 9th 1849
 The West halves of sections 6, 7, 18, 19, 30 & 31
 re-surveyed under the act of Congress of the 5th
 of April 1832, and a plat sent to the Register
 and another to the Commissioner of the General
 Land office.

Pursuant to the contract made and instructions from
 William. Butler Surveyor of the lands of the United States in the State of Illinois
 and Territory of Arkansas bearing date the 15th of March 1841. I have examined
 said plat and survey of the above described land Township and Range
 certify that it has such marks and bounds both natural and artificial as are
 represented on said plat and as shown in the field notes made then of and returned
 with this plat was the office of the Surveyor of the lands of the United States
 for the State of Illinois and Territory of Arkansas created this 1st day of June 1849
 Jacob G. Dyer

Tract Township No 22 North Range 14 East of the 3rd Principal Meridian
 page 87 vol 1

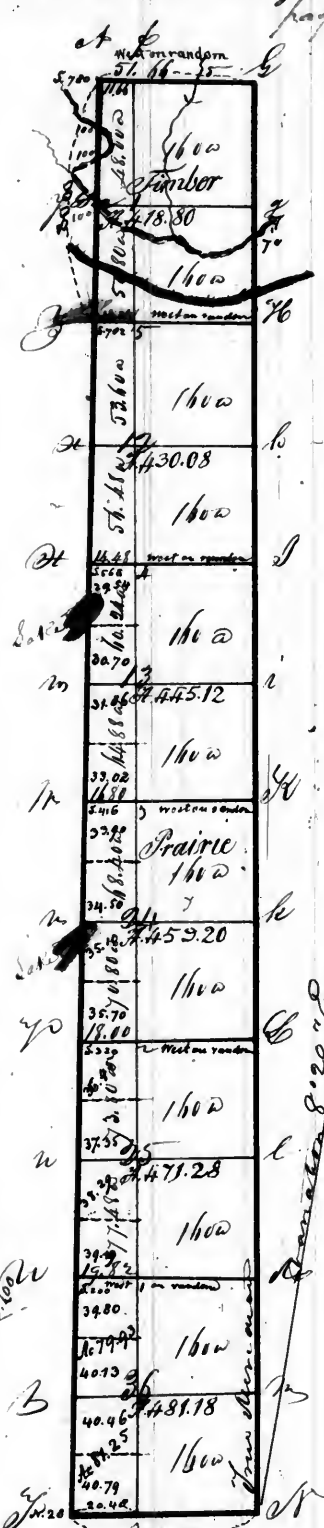

Surveyor's office
 Saint Louis June 9th 1849.
 The west halves of sections
 13, 24, 25 & 36, subdivided
 under the act of Congress of the
 5th of April 1832, and a plat
 sent to the Register and another
 to the Commissioner of the
 General Land office.


Aggregate area = 2705.66 acres
 Scale of 40 Chs to an inch

This is a contract with all information from the survey of the lands of the United States in the State of Illinois
 Certified this 18th day of November 1849

John A. Thompson

See New plat

Tras. Township N^o 24 North Range N^o 11 East 3rd principal meridian
page 89 vol 11

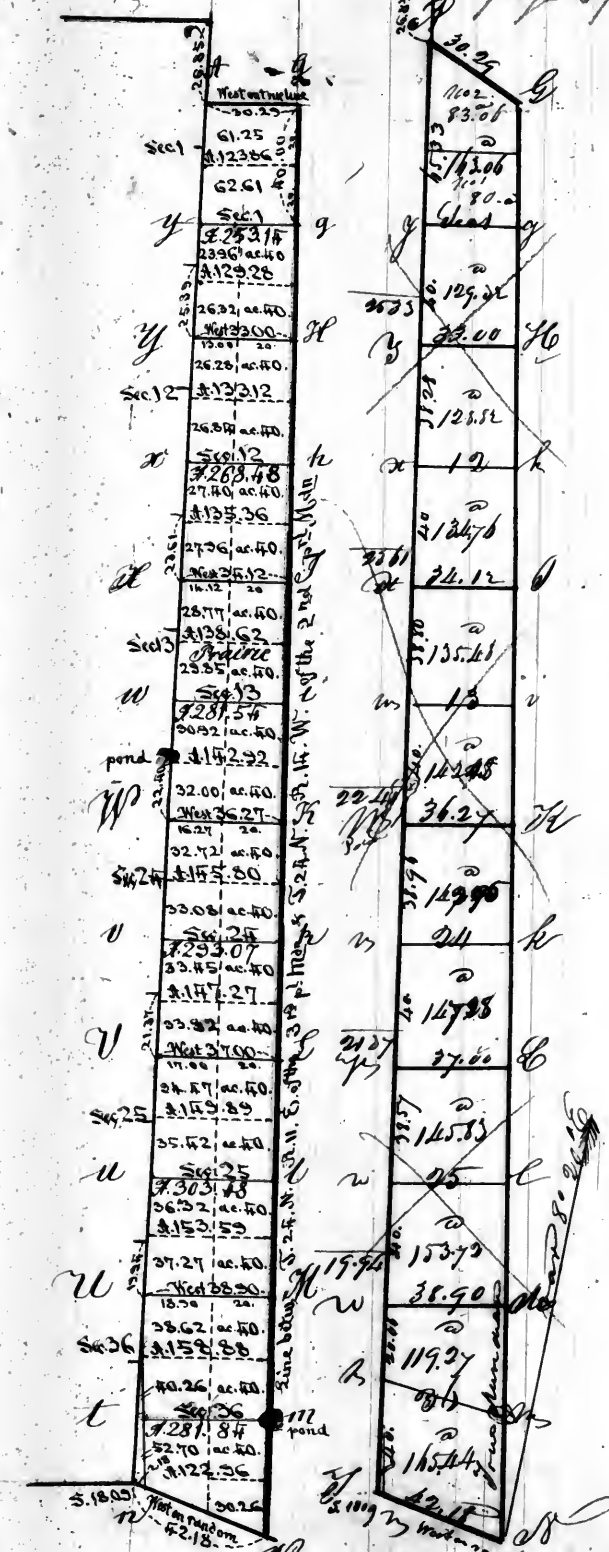

Aggregate area 1681.55 acres

Leave of each to each

Pursuant to a contract with and intention from William Reister Surveyor of the Lands of the US in the State of Illinois
Superiority of the State of Illinois being due this 18th day of March 1882. I have a damming land, and am surveying them
on and to be ascertained in the field notes, made there and entered with this plat into the office of the Surveyor of
Certified this 18th day of November 1882

Colleen A. Surveyor

New plat made

See new plat

Tract through N. 25 North Range N. 71 East 30 1/2 degrees
 Standard line
 page 90 m. 11



Aggregate area - 1844.78 acres


Scale of 40 chs to an inch

Whereas, to a contract with and instructions from William Richardson of the State of Illinois and
 the Surveyor of the Illinois Survey of the 9th day of March 1822. I have administered, signed, & surveyed the above
 described Township & my hereby certify that it has been surveyed and found to be correct and as the same
 on said plat and according with the field notes made therefor and returned with this plat into the office of the Surveyor of the
 Certified this 18 day of November 1822

John DeLaney

New plat
 made

601. 75

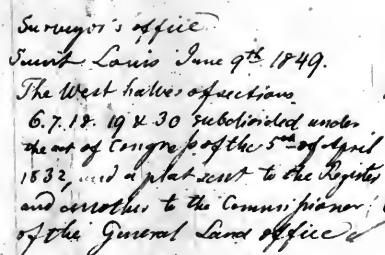


Aggregate area = 2993.49 ac.

Completed this Anna day of December 1822

To Mr Hamilton
Elias Rector

See new plat in Vol. 29: pag. 32

Township No. 34 N of the base line, Range No. 11 E of the 3^d principal Meridian.
(North West of old Indian boundary line)
East on this line True line

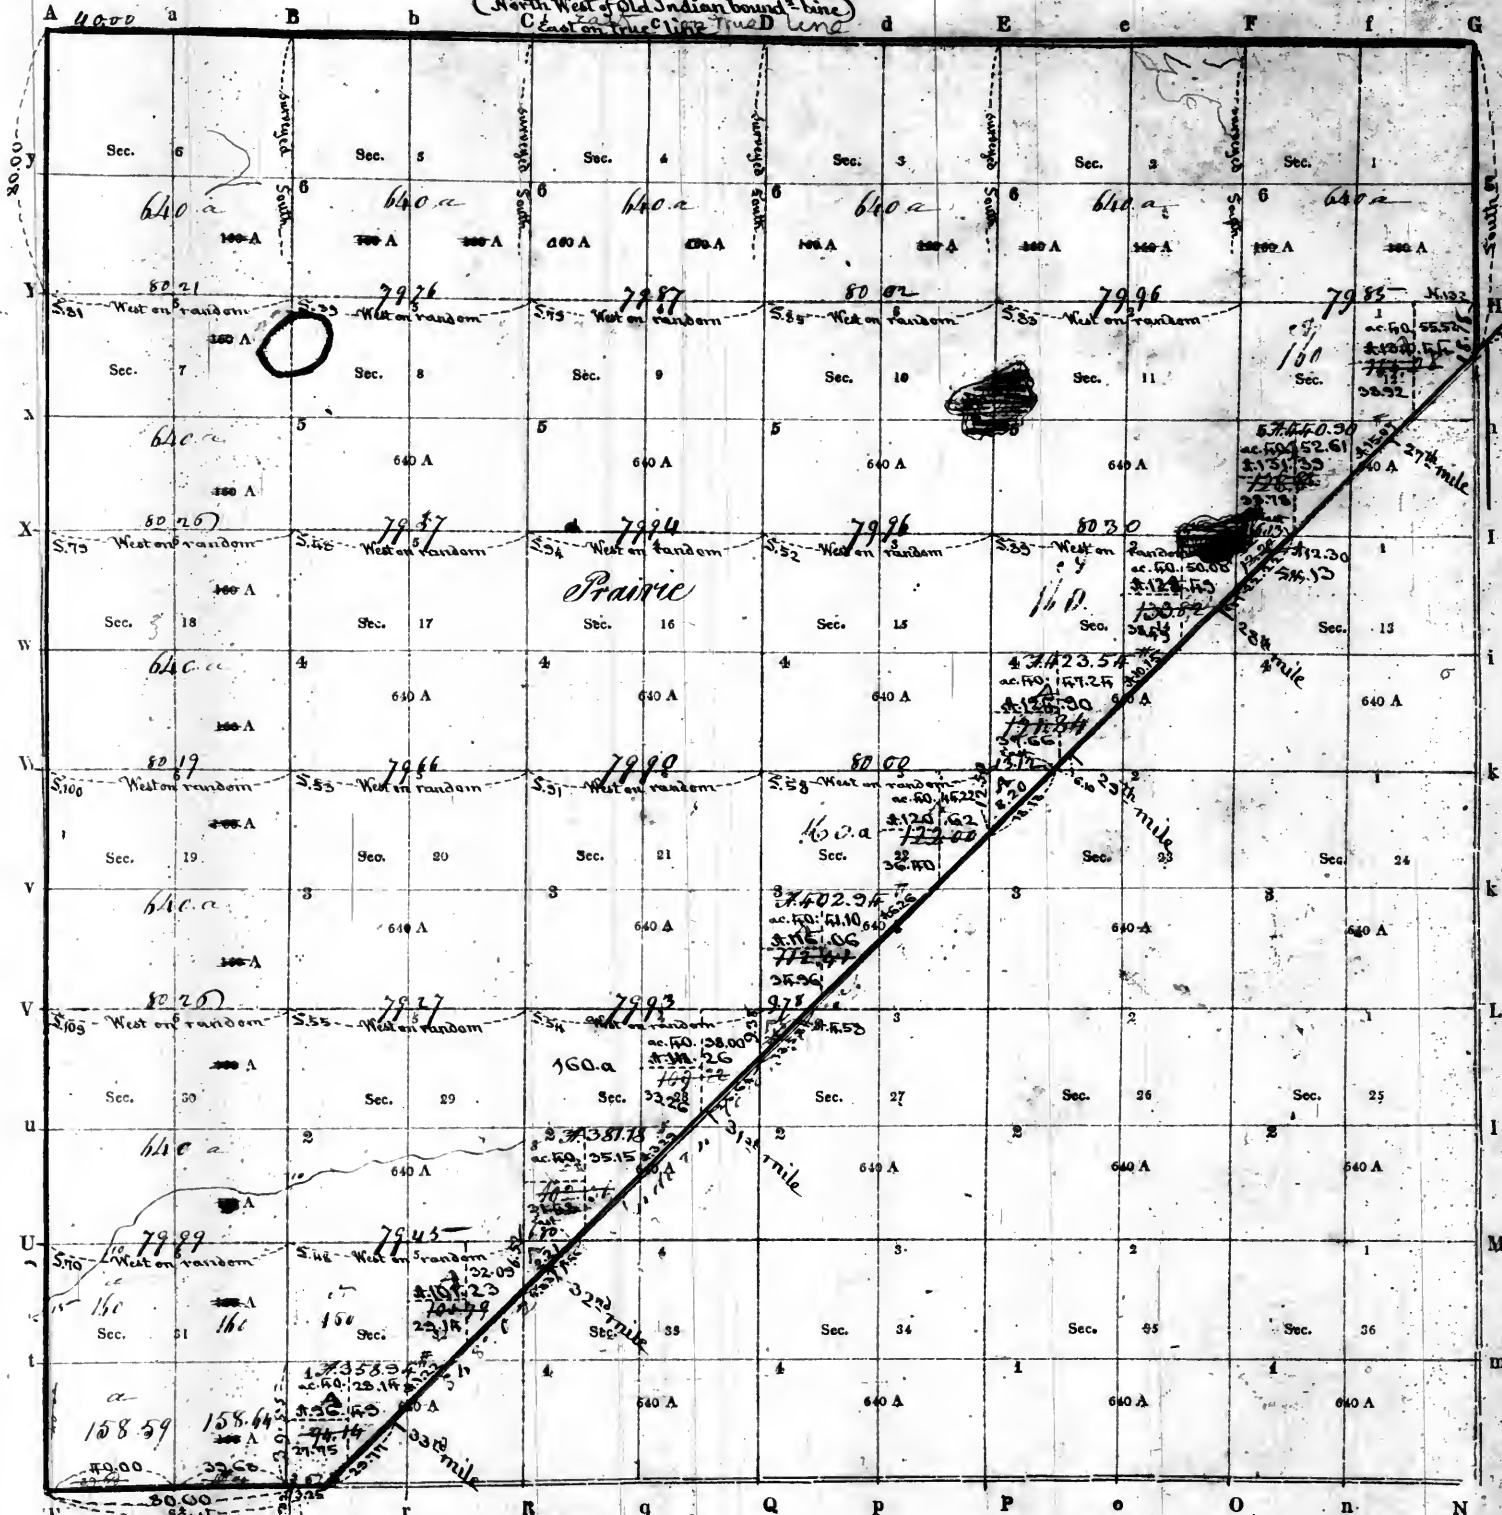

Aggregate area = 15447.50 acres.

PURSUANT to a contract with, and instructions from William Rector, Surveyor of the lands of the United States in the State of Illinois and Missouri, and Territory of Arkansas, bearing date the twentieth day of March 1881, we have measured, laid out and surveyed the above described Township; and do hereby certify, that it had such marks and bounds, both natural and artificial, as are represented on said plat, and described in the field notes made thereof, and returned with this plat into the Office of the Surveyor of the Lands of the United States, in the State of Illinois and Missouri, and Territory of Arkansas.

Certified this 1st day of November 1882

EXAMINED.

Wm. Rector, SURVEYOR
Stephen Rector

Scale of 40 Chains to an Inch.


Certified this _____ day of _____
EXAMINED.

D. SURVEYOR.

Township No. 36 *North*

of the base line, Range No. 11 *East*

of the 3rd principal Meridian.

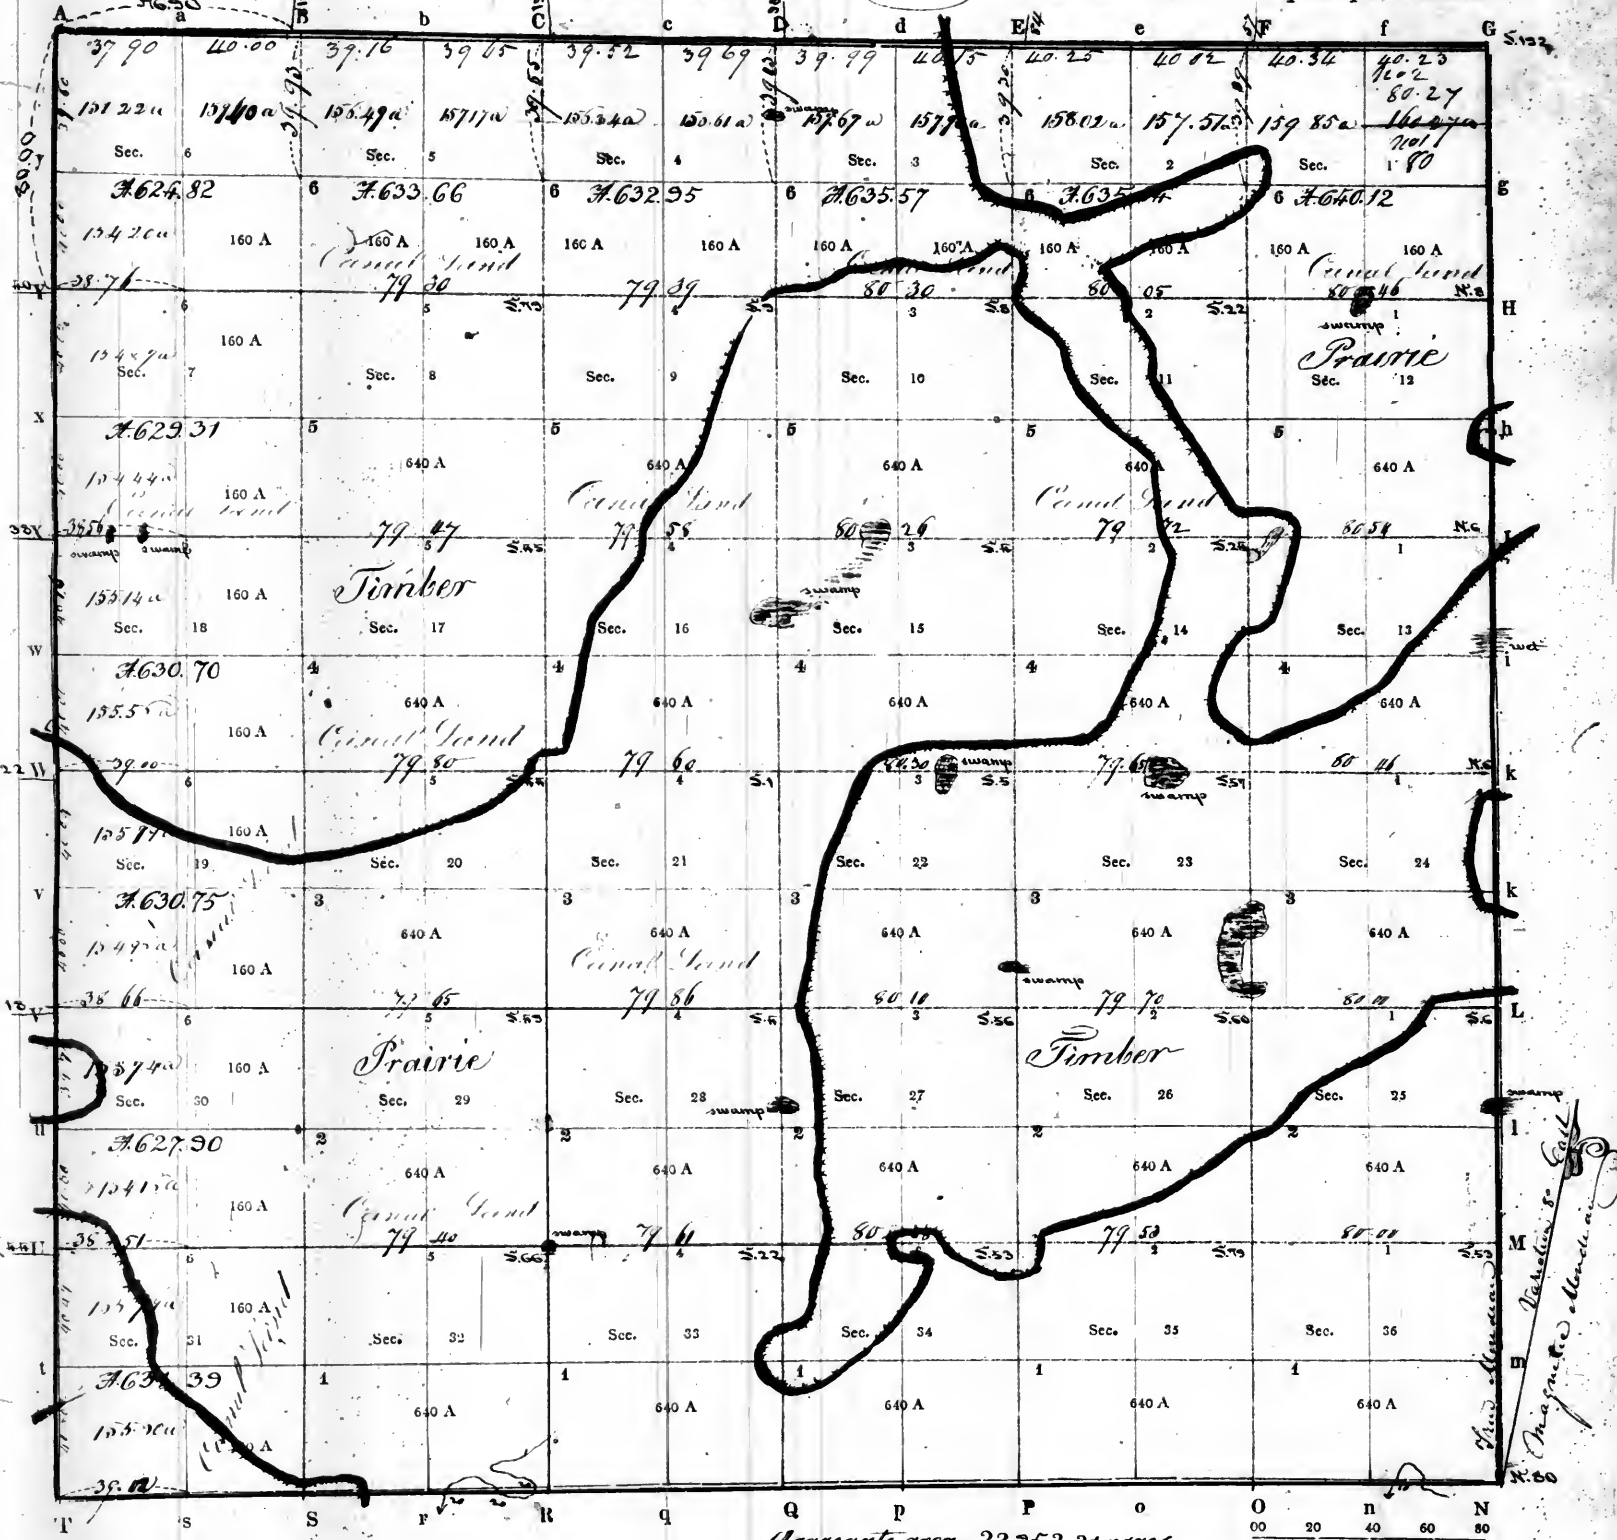


PURSUANT to a contract with, and instructions from William Rector, Surveyor of the lands of the United States in the *State of Illinois, Missouri and Kentucky of Arkansas*, bearing date the *18th* day of *April* 1827, we have admeasured, laid out and surveyed the above described Township; and do hereby certify, that it had such marks and bounds, both natural and artificial, as are represented on said plat, and described in the field notes made thereof, and returned with this plat into the Office of the Surveyor of the Lands of the United States, in the *State of Illinois, Missouri and Kentucky of Arkansas*.

Certified this *18th* day of *April* 1827

EXAMINED.

D. SURVEYOR.

Township N. 37 North of the Base Line Range N. 11 East of 3rd Principal Meridian

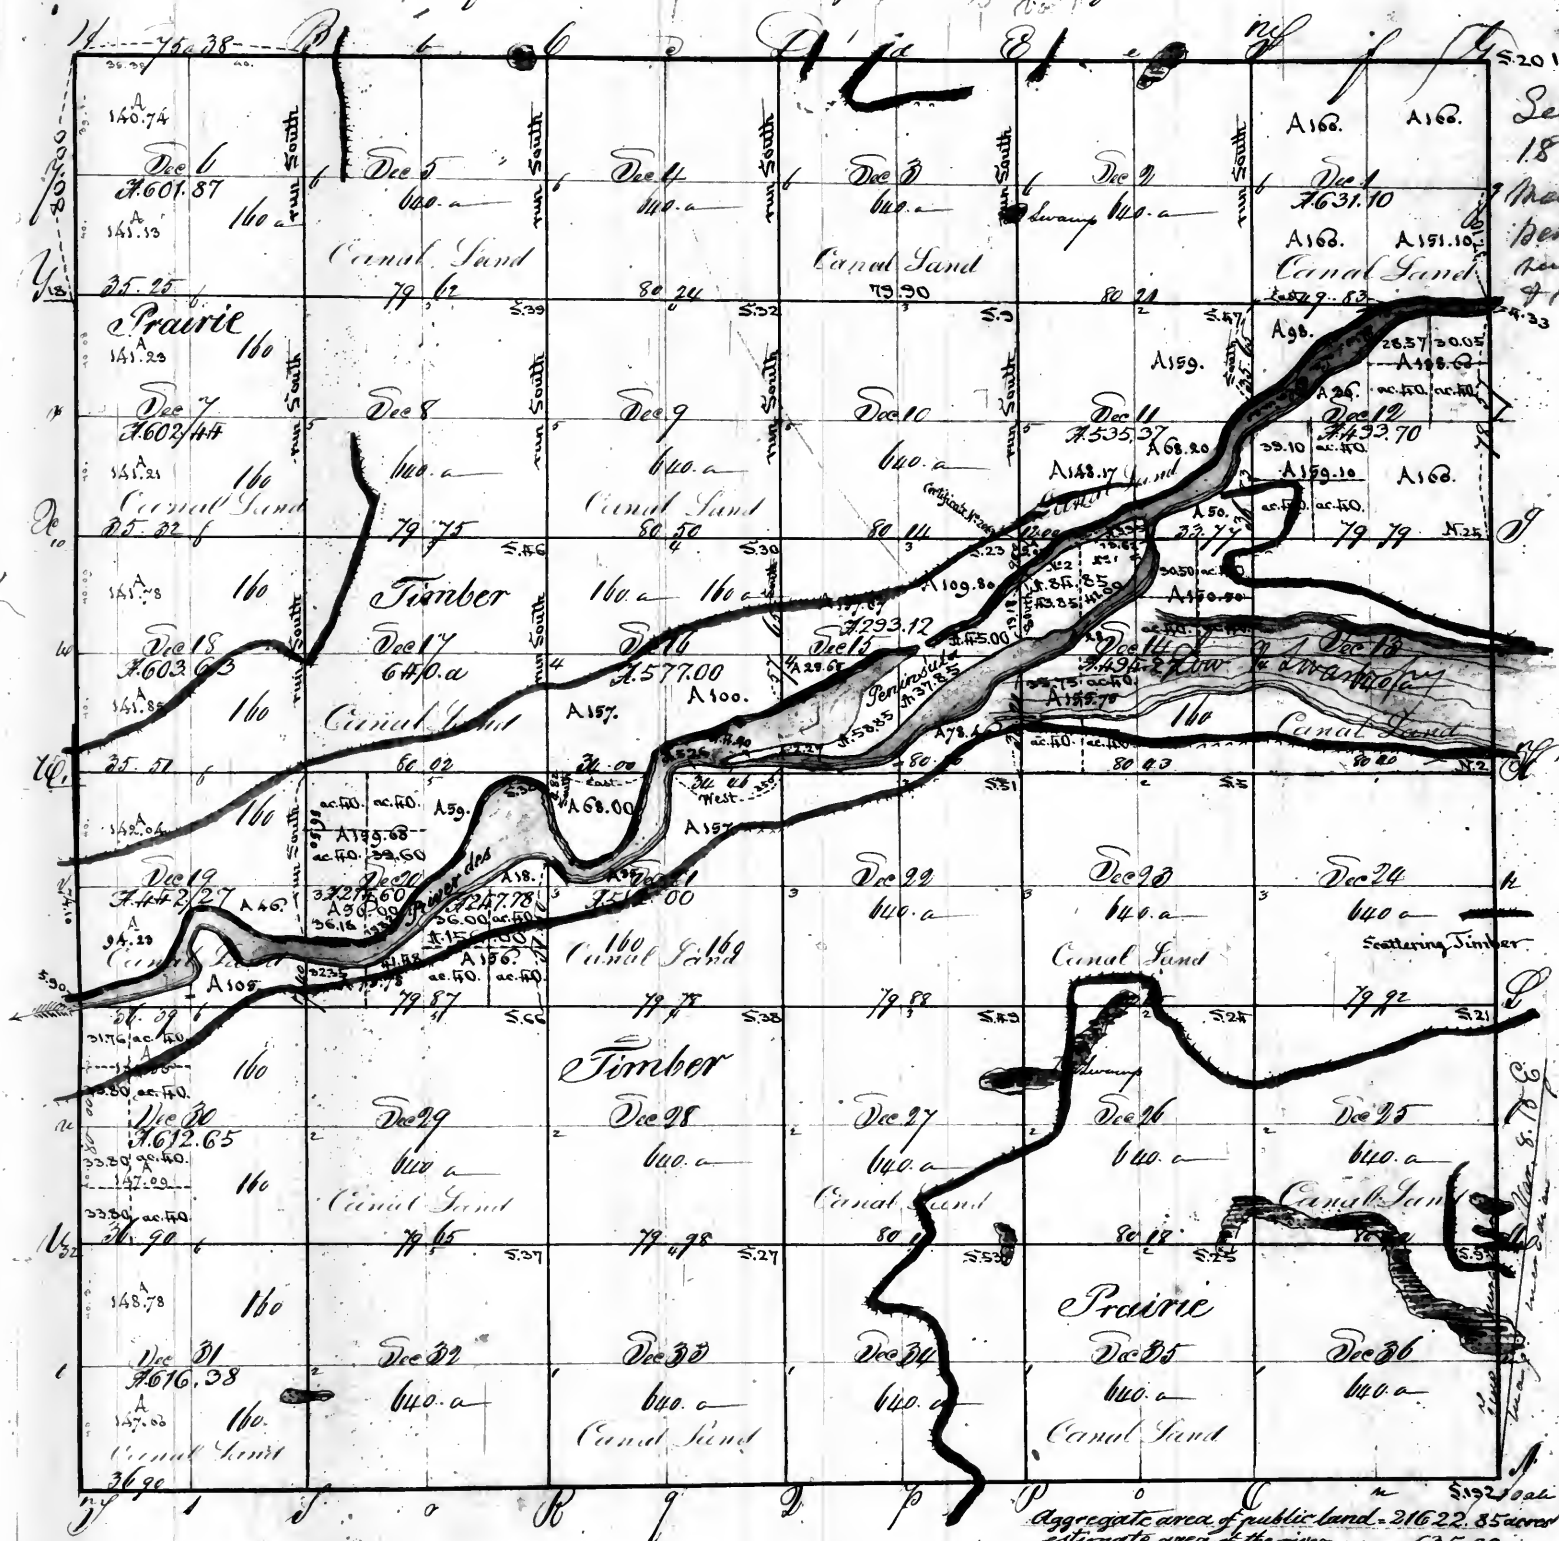

See instructions of the
18th of May 1846. to A. J.
Mathewson, to survey a
peninsula north of the
River in Section 11 16. 17

Aggregate area of public land - 21622.85 acres
estimated area of the river - 635.00 -
Total - 22257.85 acres

Pursuant to a contract with and instructions from William Rector Surveyor of the lands of the United States in the States of Missouri and Illinois and Territory of Arkansas bearing date the twentieth day of March 1824 we have examined laid out and surveyed the above described Township and do hereby certify that it has been marked and bounded both natural and artificial as are referred to on said plat and described in the field notes made thereof and returned with this plat into the office of the Surveyor of the lands of the United States in the States of Missouri and Illinois and Territory of Arkansas


Certified this 10th day of Novr 1824.

Examined

S. Rector
Stephen Rector

D. Surveyor

Tract Township N. 38 North of the Base line Range N. 11 East of 3^d Principal Meridian
 page 96 vol 11

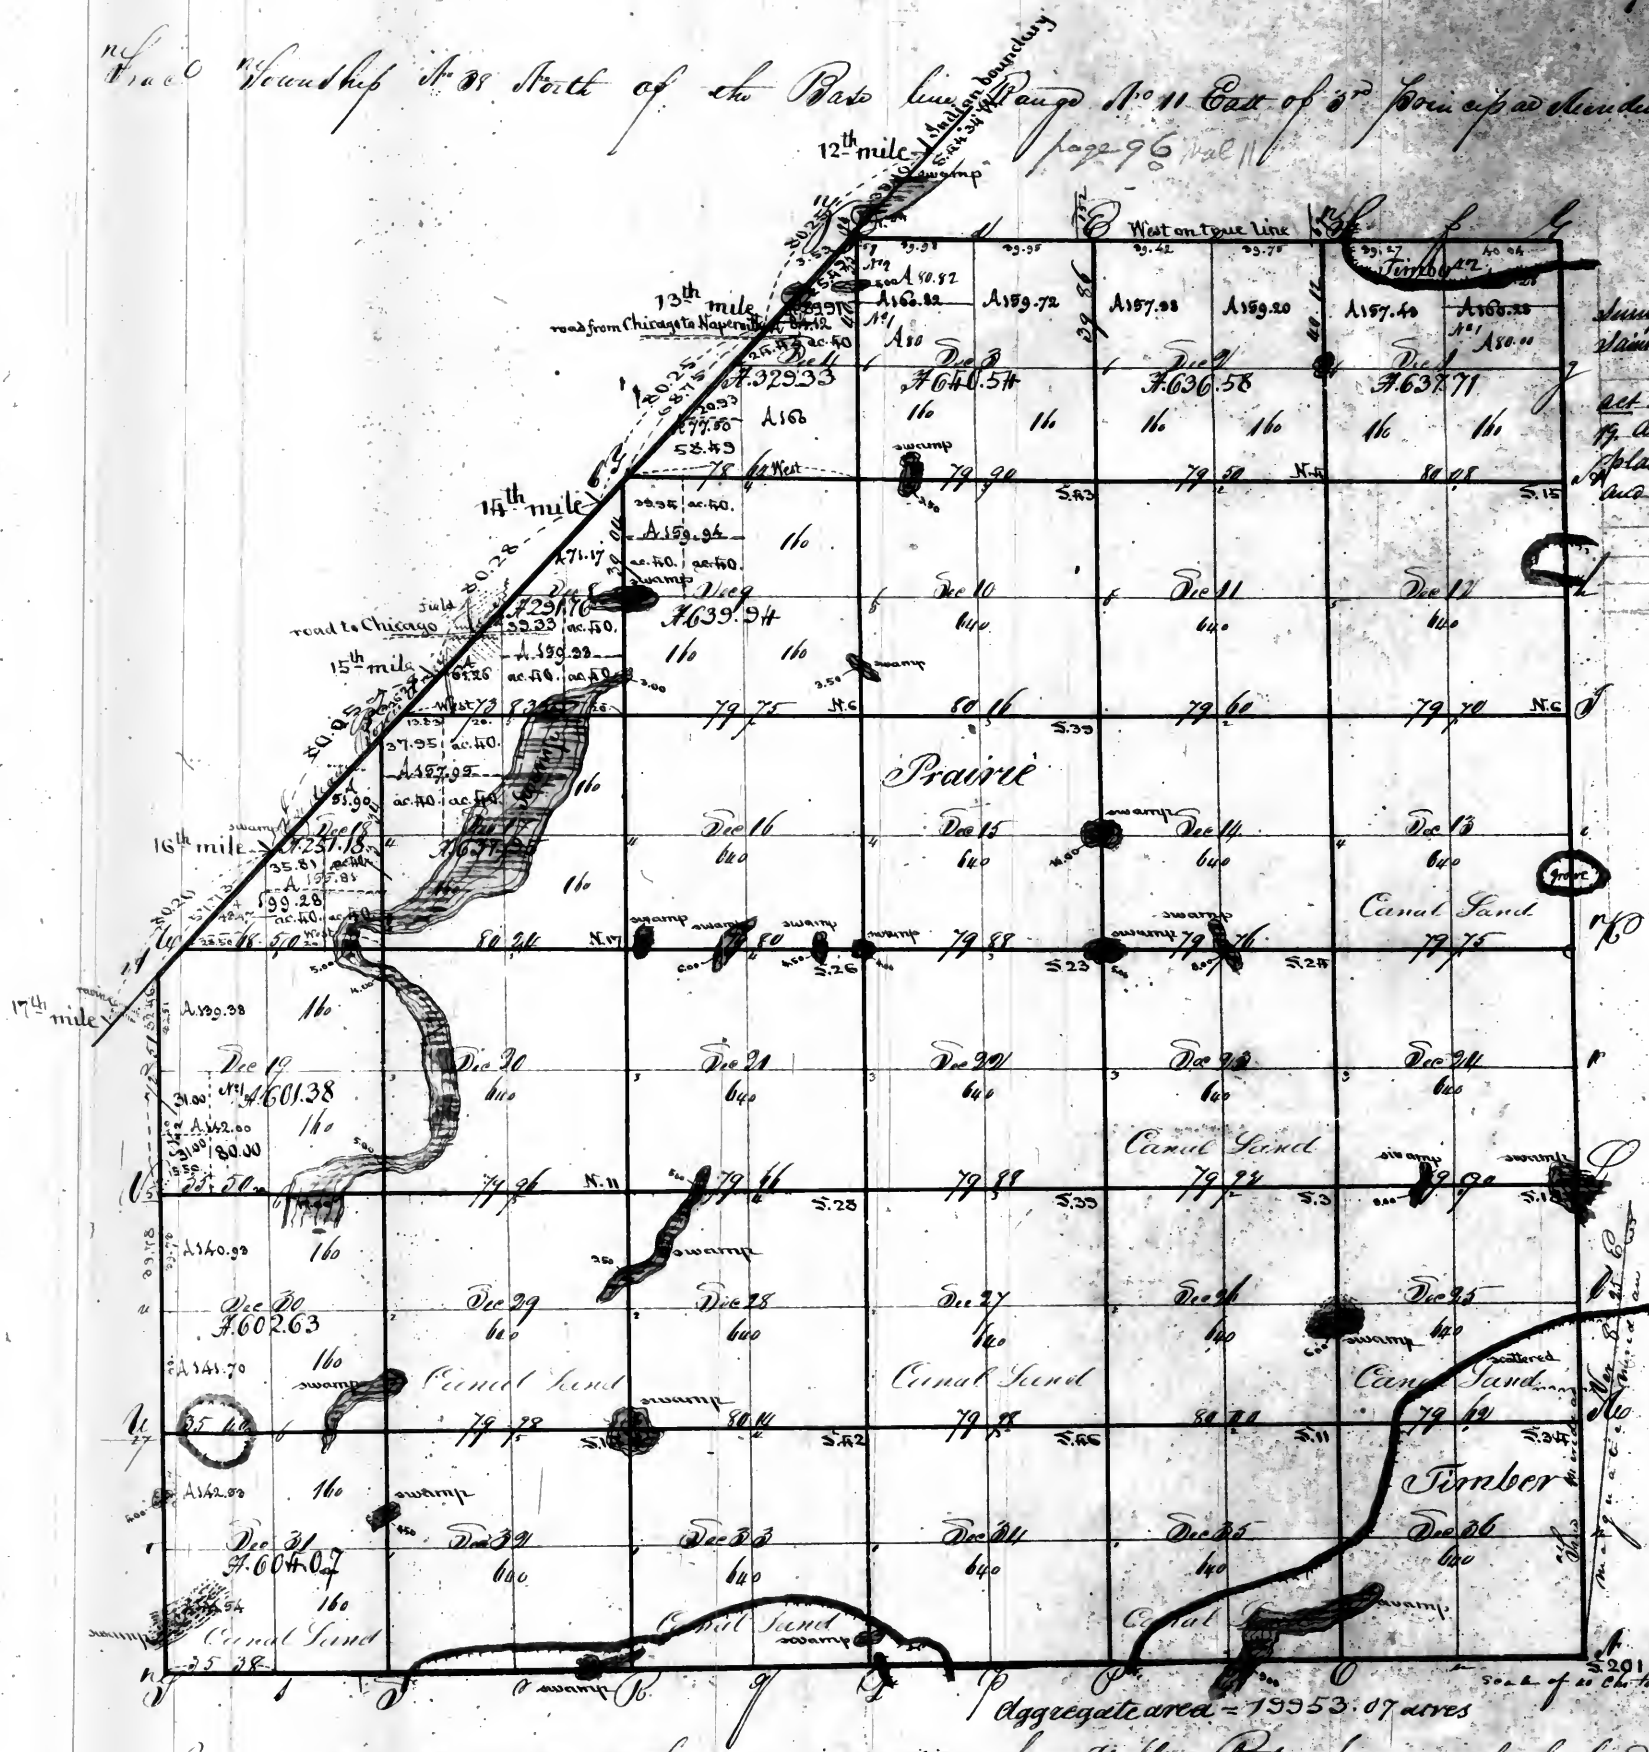


Surveyor's Office
 Saint Louis Mo.
 Subdivided under the
 act 1132, by the N. 38 of the
 19, and sent today copies of the
 plat thereof one to the Register
 and another to the Commissioner


Pursuant to a contract with and instructions from William Root Surveyor of the lands of the
 United States in the States of Missouri and Illinois and Territory of Arkansas bearing date the
 twenty-fifth day of March 1861 We have advised and laid out and surveyed the above descri-
 bed Tract Township and do hereby Certify that it has been made and bounds both natural
 and artificial as are represented on said plat and described in the field notes made thereof
 and returned with this plat into the office of the Surveyor of the lands of the United States in the
 States of Missouri and Illinois and Territory of Arkansas
 Certified this _____ day of _____
 Examined _____
 D. Enos

767

Tract Township N° 29 North of the Base line Range 11 E. 3rd P. W.
page 97 vol 11

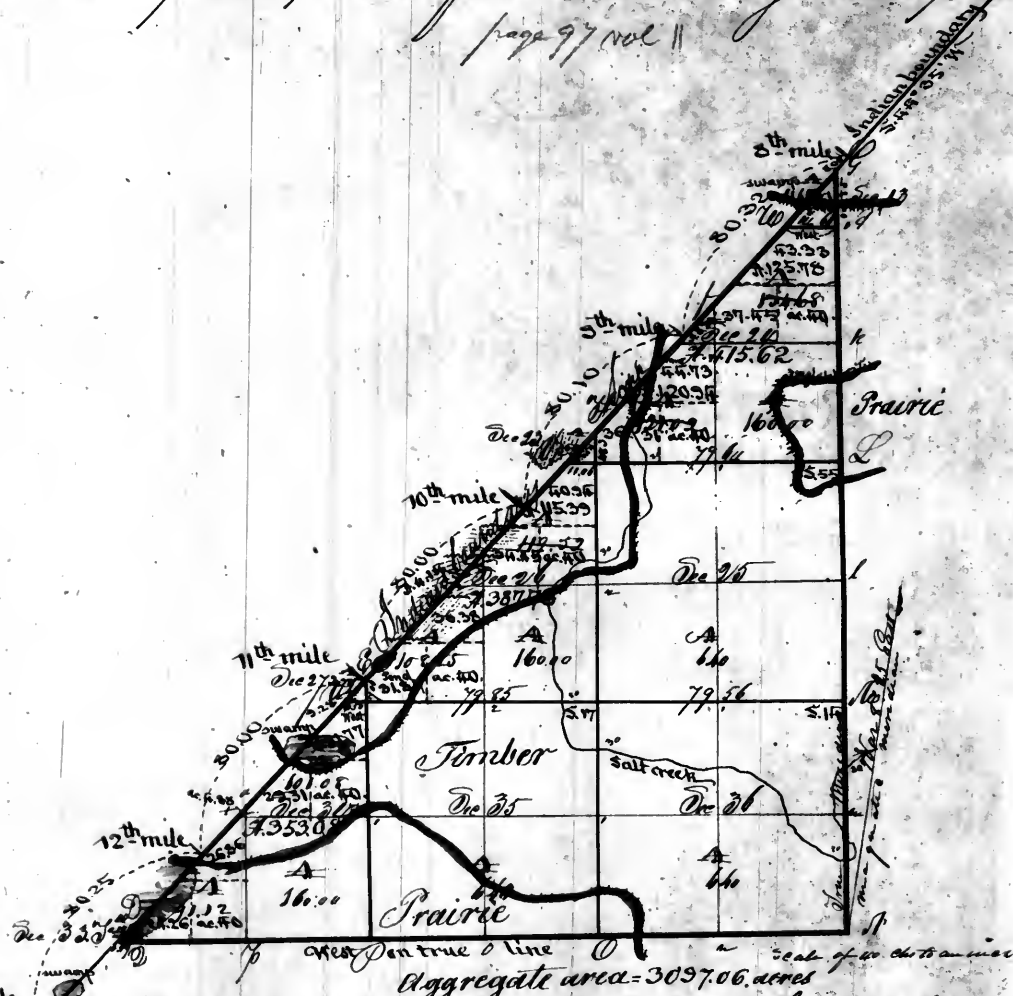

Purdu and is a contract with and instructions from William
Rector Surveyor of the lands of the United States in the States
of Missouri and Illinois and Territory of Arkansas bearing date the
twentieth day of March 1821. We have examined said plat and find
= Verified the above described Tract Township and do hereby Certify
that it has been marked and bounded both natural and artificial
= as an represented on said plat and described in the
field notes made thereof and returned with this plat into the
office of the Surveyor of the lands of the United States in the
States of Missouri and Illinois and Territory of Arkansas
On this first day of Nov 1820
Examined
The Rector D. Surveyor
Stephen Thaler

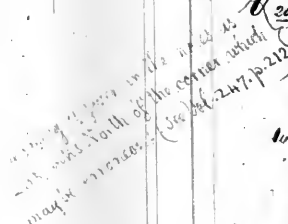


27th mile
 Assistant to a contract with and Instructions from William Rector, Surveyor of the Lands of the United States in the
 States of Illinois, Missouri and Territory of Arkansas, bearing date the twentieth day of March 1821 - - - - -
 We have administered laid out and Surveyed the above described fractional Townships and do hereby certify that it had such
 marks and bounds both natural and artificial as are represented in said Plat and described in the field notes made thereof
 and returned with this plat into the office of the Surveyor of the Lands of the United States in the States of Illinois, Missouri
 and Territory of Arkansas.
 Certified this
 Examined

page 77 vol 11

4
0
80
72 80
70 1684

Surveyor's Office November
Saint Louis 12th 1846.
Sub divided under the
Act of 1832; viz. the N.W. q. of
Sec 16. Two ~~ten~~ copies of
the plat thereof, one to the Reg-
istr. and the other to the Comr., on the
27th of August 1845.

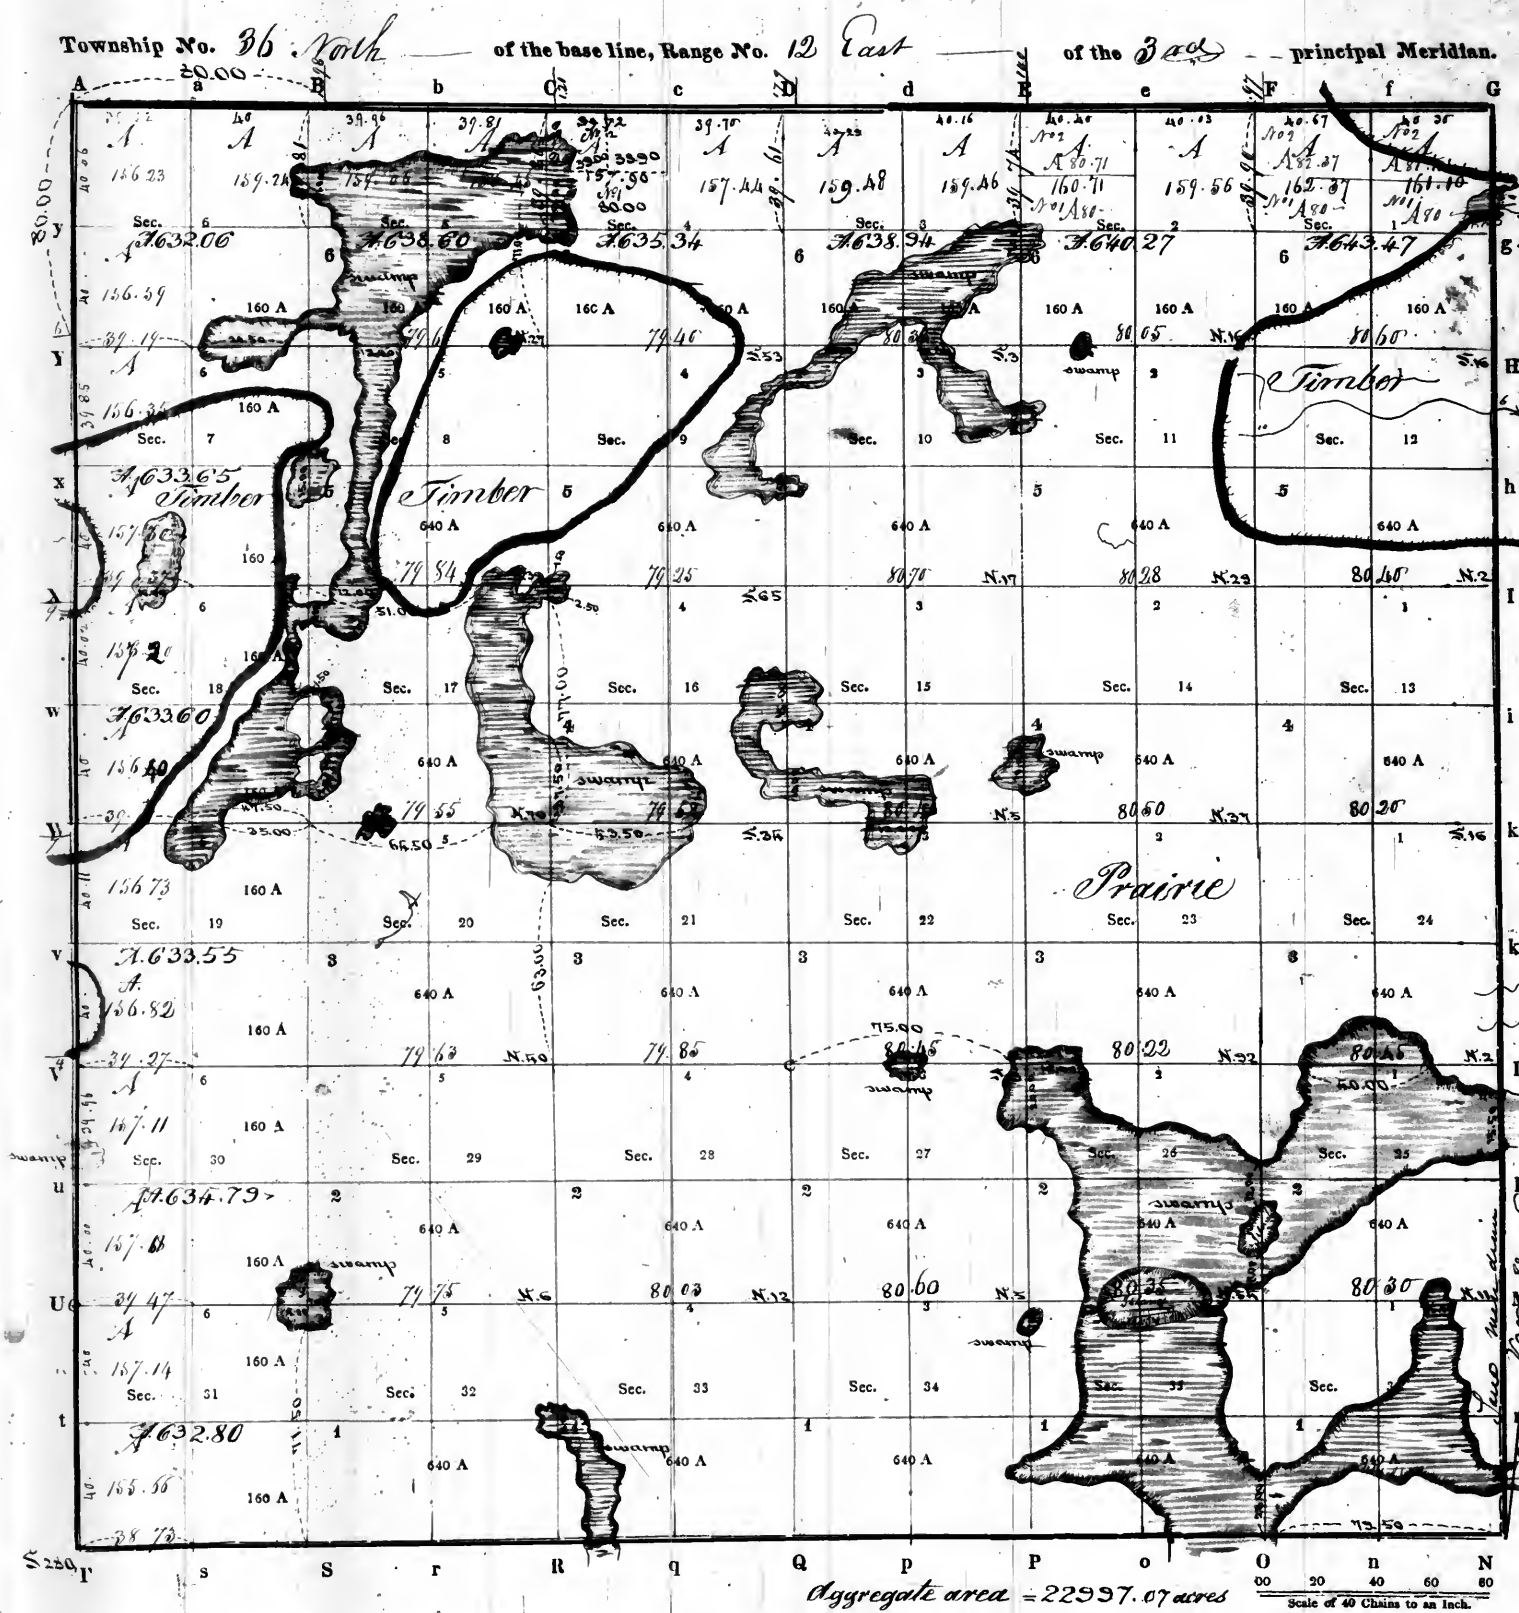


PURSUANT to a contract with, and instructions from **William Rector**, Surveyor of the lands of the United States in the *State of Illinois Missouri*
and Territory of Arkansas bearing date the *twentieth* day of *March* 182*1*
 102 have a measure laid out and surveyed the above described Township; and do hereby certify, that it had such marks and bounds, both natural and artificial,
 as are represented on said plat, and described in the field notes made thereof, and returned with this plat into the Office of the Surveyor of the Lands of the
 United States, in the *State of Illinois Missouri and Territory of Arkansas*

Certified this day of 182*1*

EXAMINED.

D. SURVEYOR.

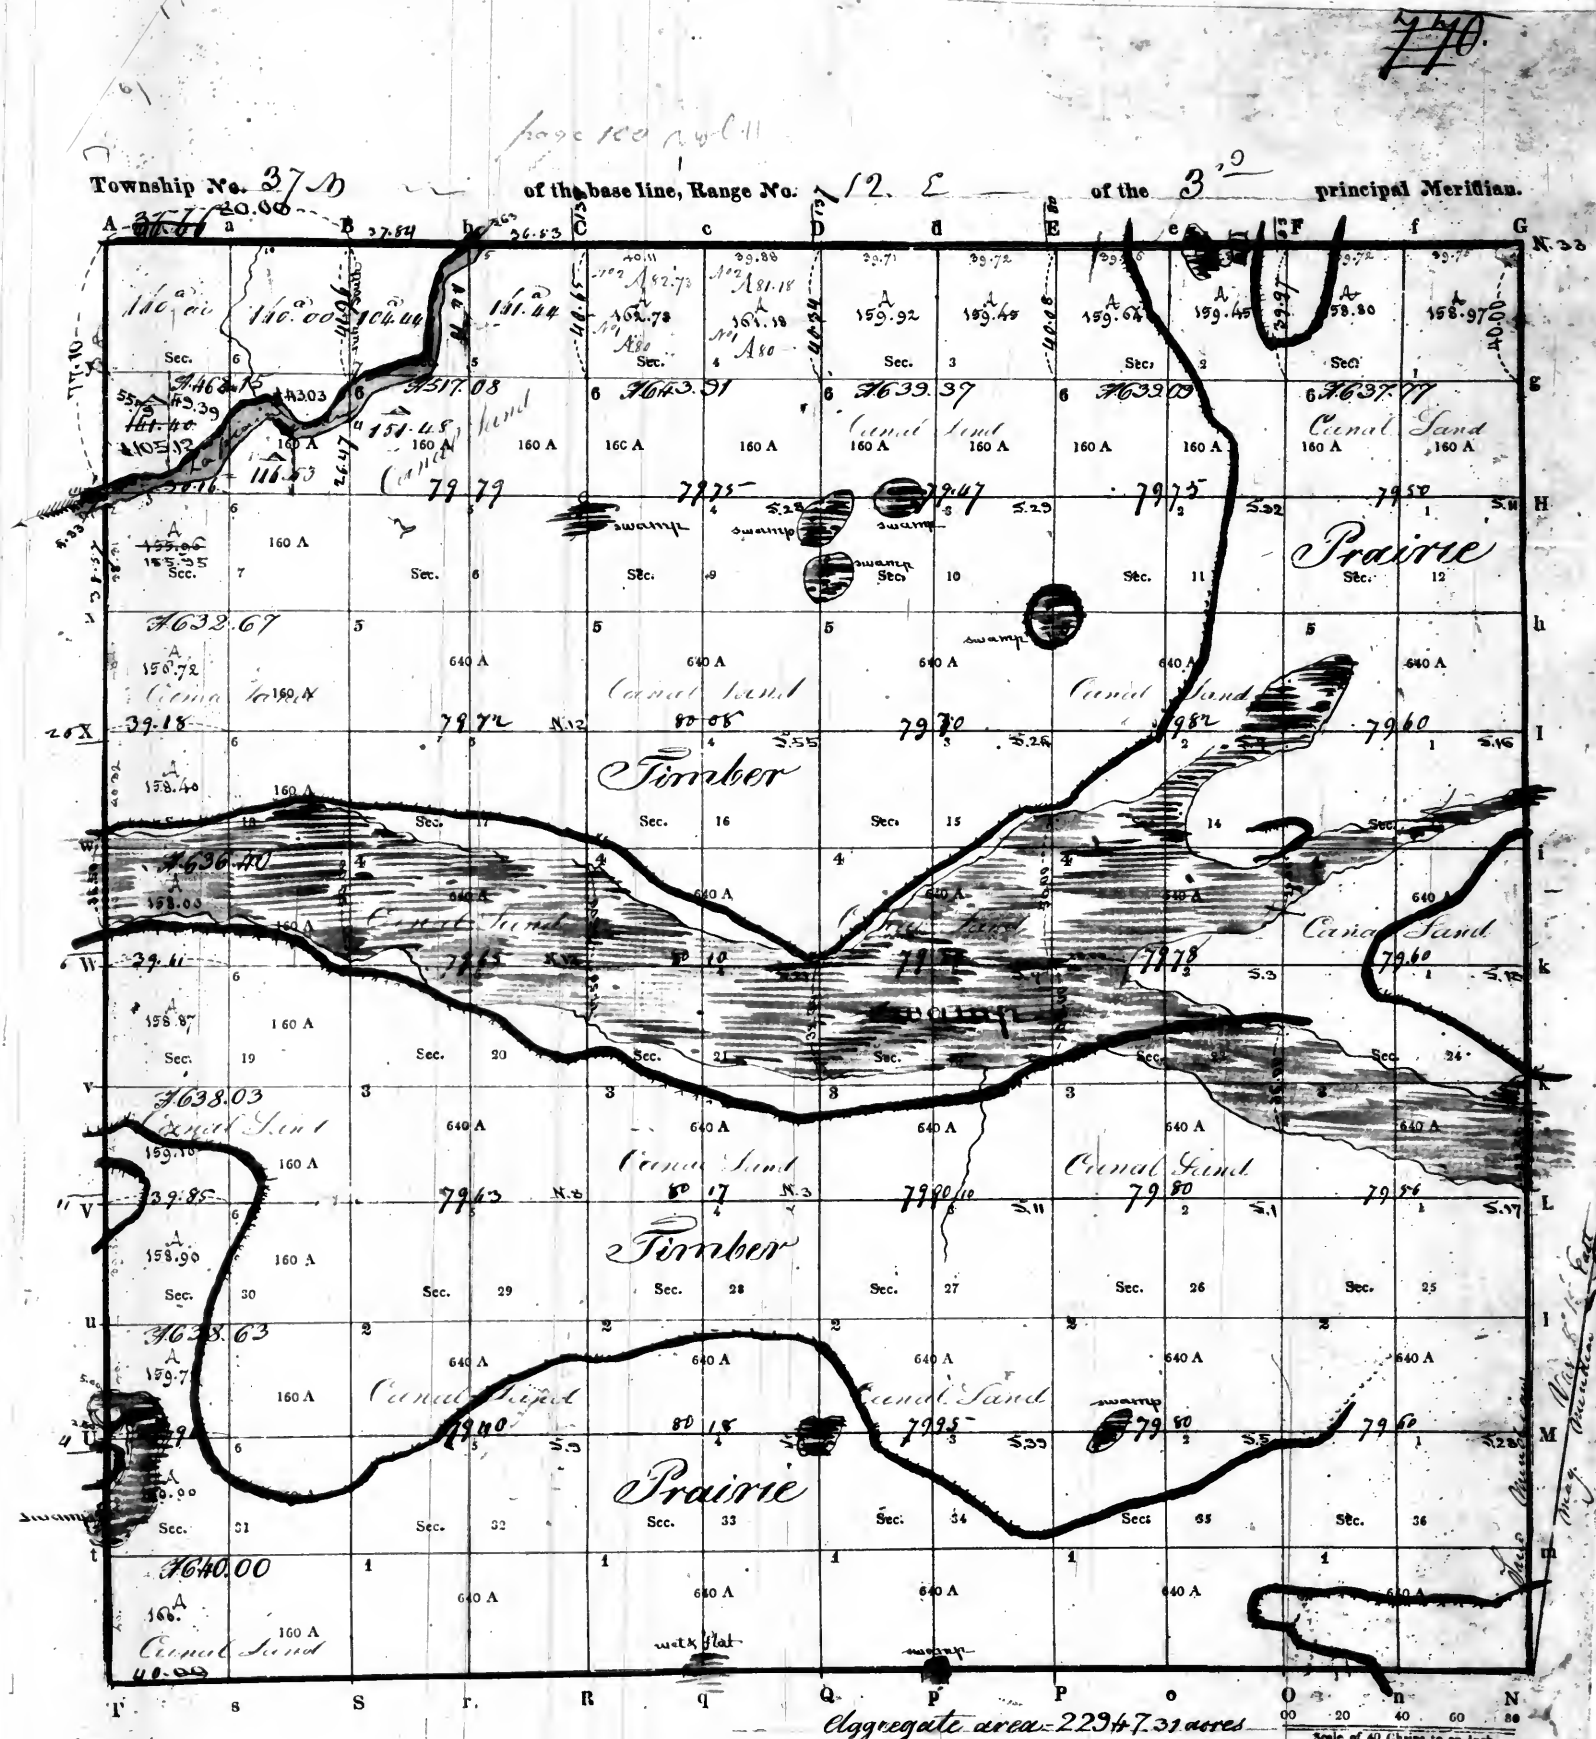

PURSUANT to a contract with, and instructions from William Rector, Surveyor of the lands of the United States in the State of Wisconsin and Territory of Arkansas, bearing date the *Twenty* day of *March* 1821, I have measured, laid out and surveyed the above described Township; and do hereby certify, that it had such marks and bounds, both natural and artificial, as are represented on said plat, and described in the field notes made thereof, and returned with this plat into the Office of the Surveyor of the Lands of the United States, in the States of Illinois and Wisconsin and Territory of Arkansas.


Certified this *1st* day of *November* 1822

EXAMINED.

Wm Rector
SURVEYOR.

Sectionship N 38 North of the White Sulphur Range N 12 East of T. Principal Meridian

page 101

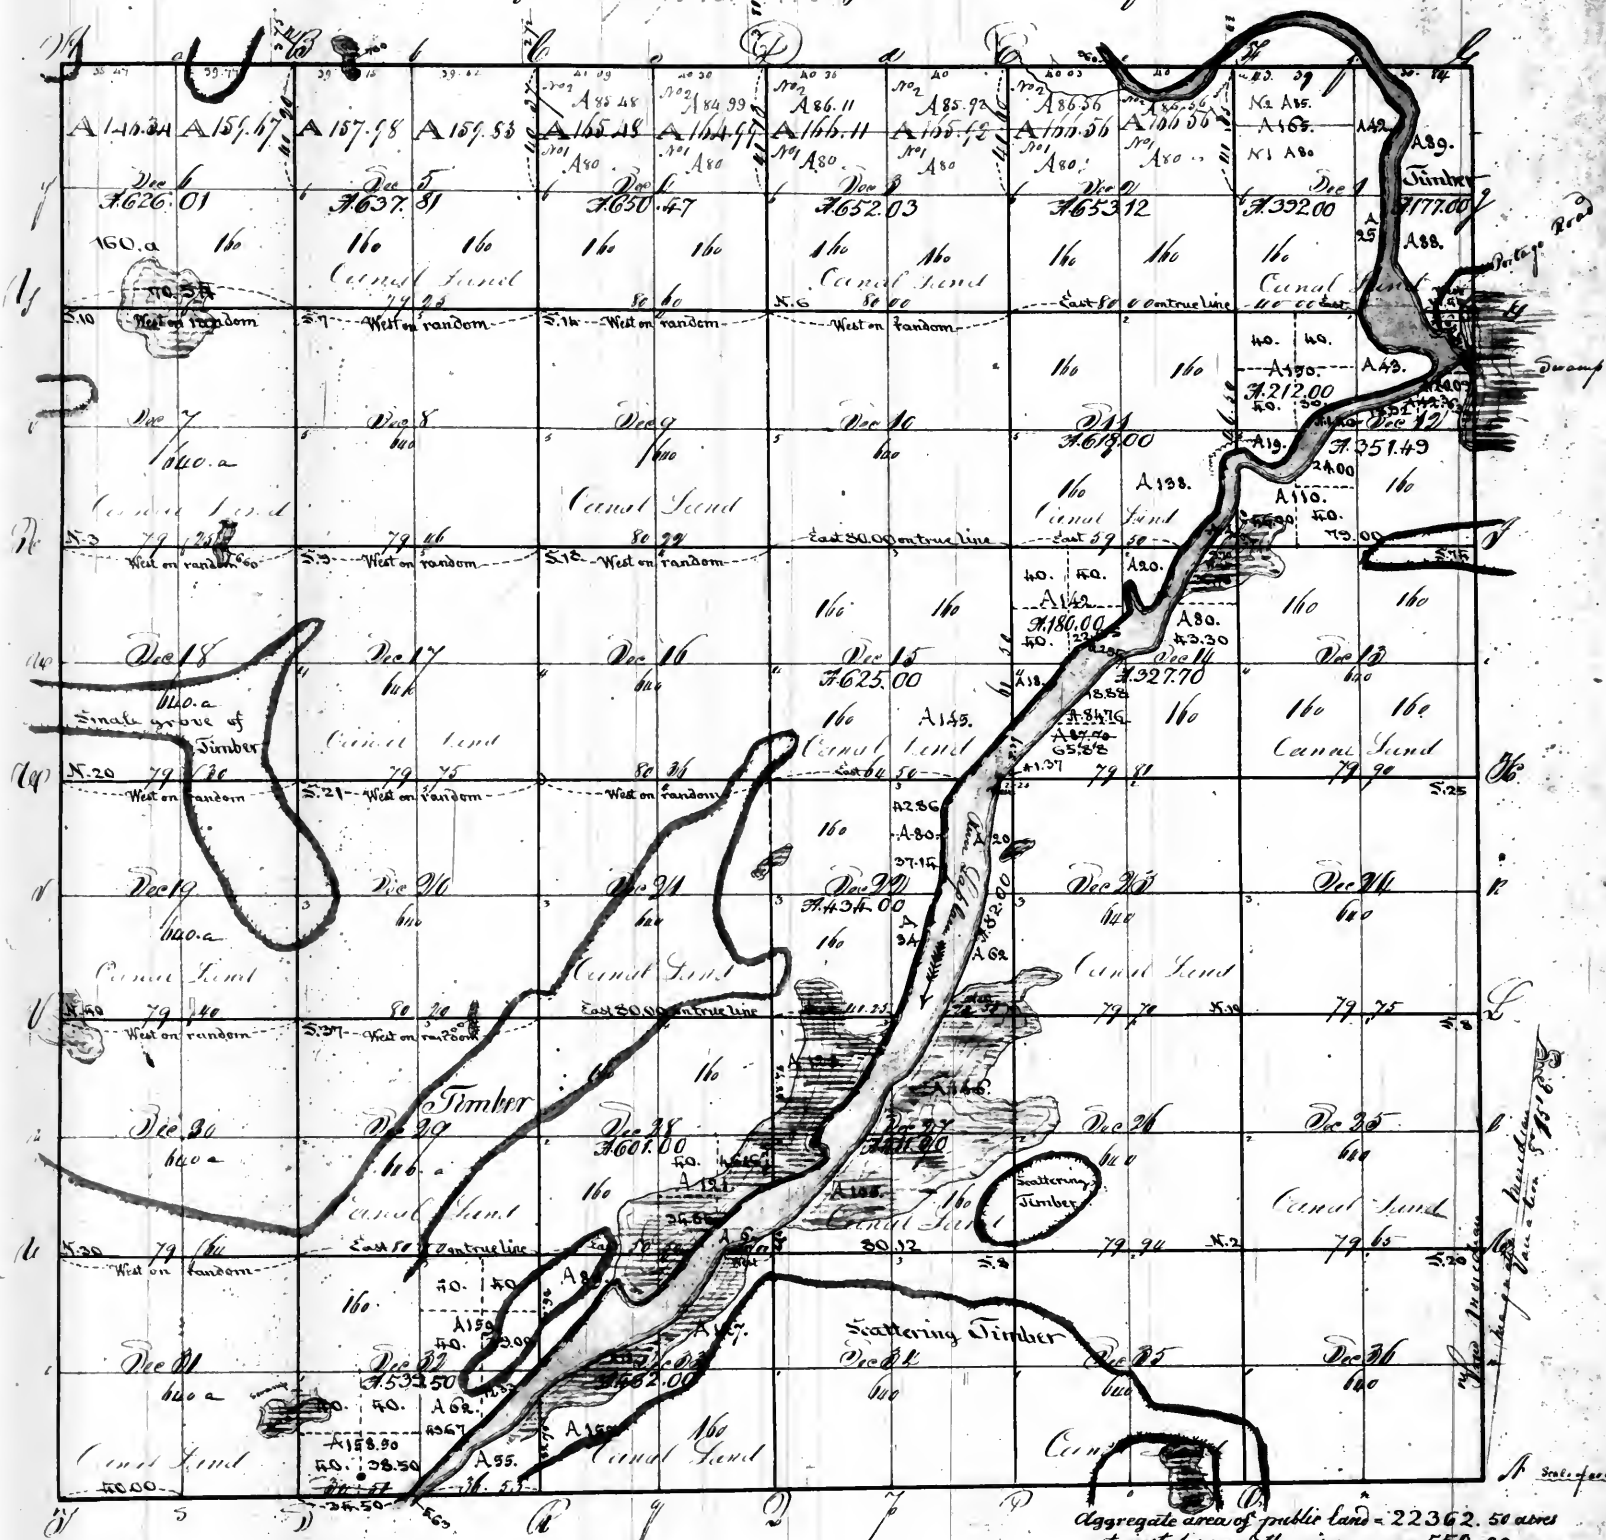

Aggregate area of public land = 22362.50 acres
estimated area of the river = 550.00 --


Total = 22912.50 acres

Pursuant to a contract with and instructions from William Foster Surveyor of the lands of the United States in the States of Missouri and Illinois and Territory of Arkansas bearing date the twenty-sixth day of March 1822 We have adorned laid out and surveyed the above described Township and do hereby certify that it had such marks and bounds both natural and artificial as are represented on said Plat and described in the field notes made thereof and returned with this Plat into the Office of the Surveyor of the lands of the United States in the States of Missouri and Illinois and Territory of Arkansas


Certified this 1st day of Nov 1822.
 Examined

The C. Victor
Stephen Victor *D. Sawyer*

Fract. 7. 4000 of Bar line Range. 122 of 3rd for Mon

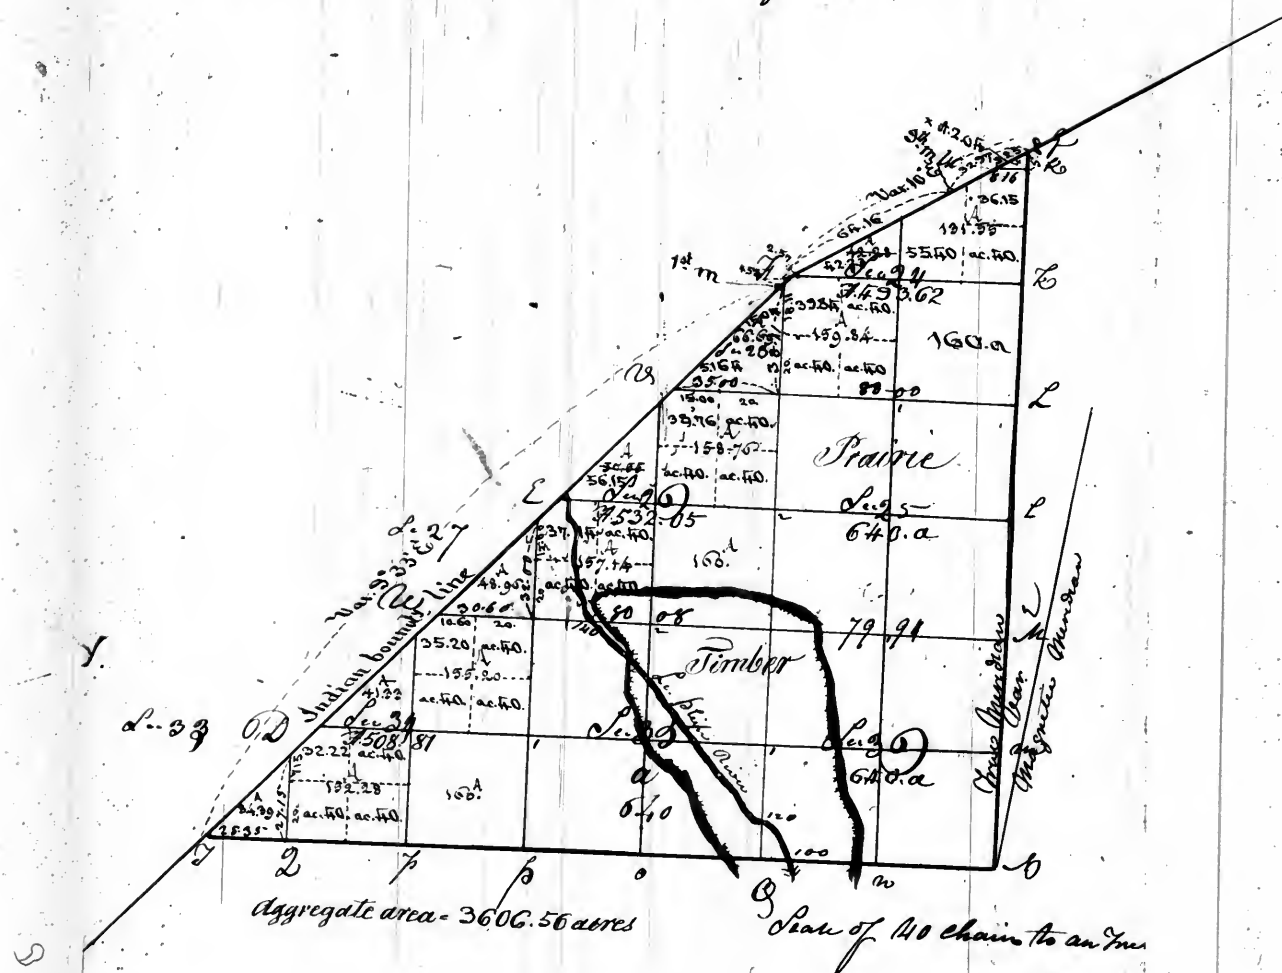

Traverse No. 936 North of the Tan line Range N. 13 East of the 3^d principal meridian
(North West of the Old Indian boundary line)
page 104 vol 11

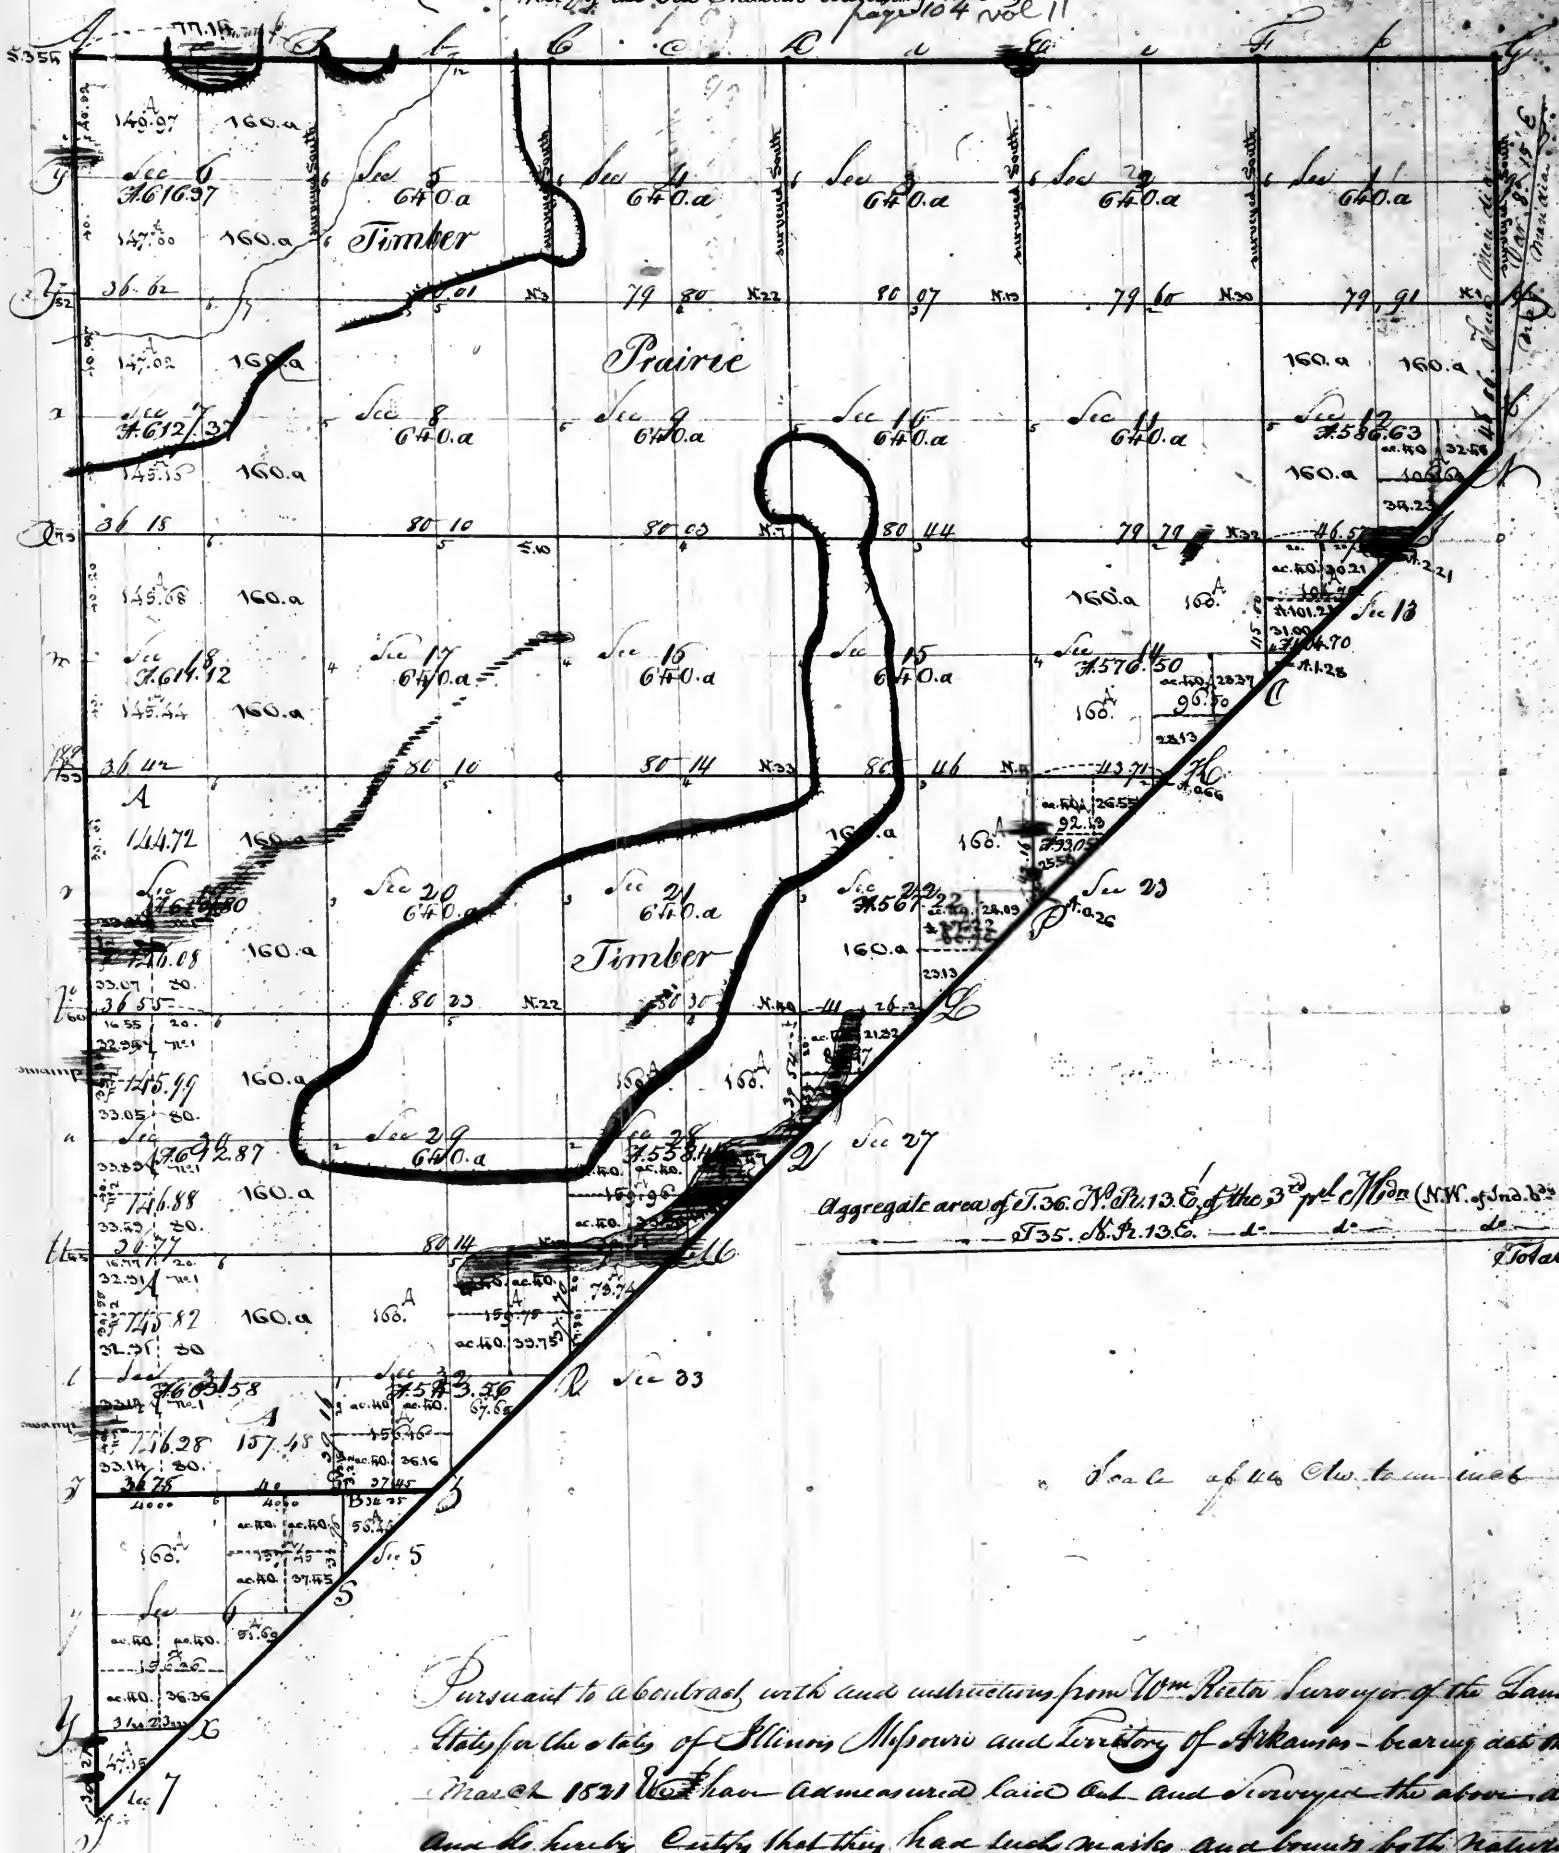


Aggregate area of T. 36. N. 13. E. of the 3^d p. m. (N.W. of Ind. b. line) = 16453.30 ac.
 T. 35. N. 13. E. " " " = 629.03 "
 Total = 17082.33 acres

Scale of 46 Ch. to an inch

Pursuant to a contract with and instructions from Wm. Rector Surveyor of the Lands of the United States for the States of Illinois, Missouri and Territory of Arkansas - bearing date the 20th day of March 1831 We have - as measured laid out and surveyed the above described boundary and do hereby certify that they have such marks and bounds both natural and artificial as are represented on said plat and describing in the field notes (inclosed therewith) and returned with this plat into the Office of the Surveyor of the Lands of the United States for the States of Illinois, Missouri and Territory of Arkansas -
 Certified this 1st day Nov 1832

Wm. Rector
 Stephen Rector Surveyor

775

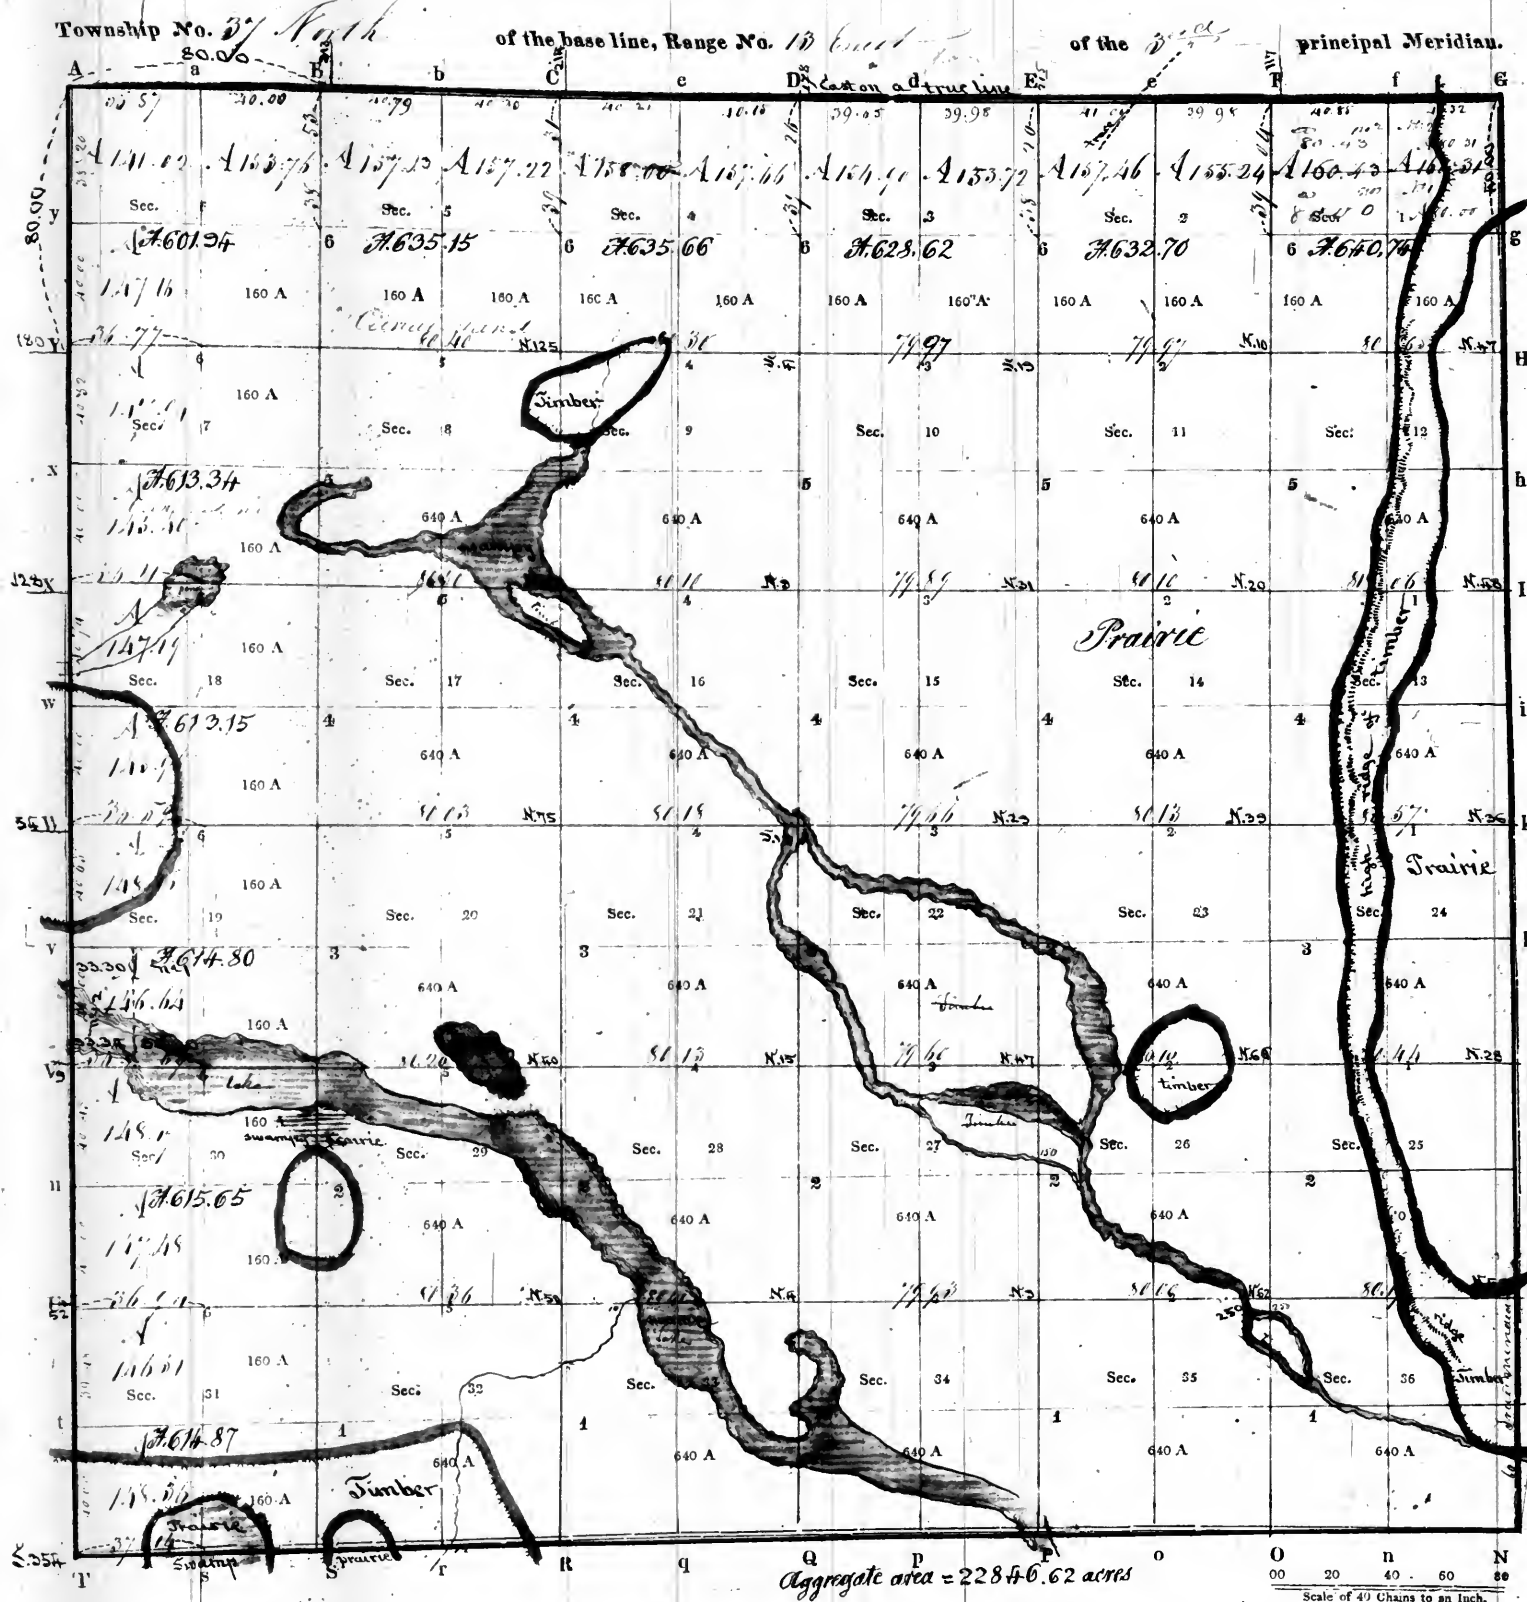


PURSUANT to a contract with, and instructions from William Rector, Surveyor of the lands of the United States in the State of Illinois, bearing date the twentieth day of March 1881, I have admeasured, laid out and surveyed the above described Township; and do hereby certify, that it had such marks and bounds, both natural and artificial, as are represented on said plat, and described in the field notes made thereof, and returned with this plat into the Office of the Surveyor of the Lands of the United States, in the State of Illinois.

Certified this _____ day of _____ 1882

EXAMINED.

D. SURVEYOR.

Township No. *D 2 North* of the base line, Range No. *13 East* of the *3rd* principal Meridian.

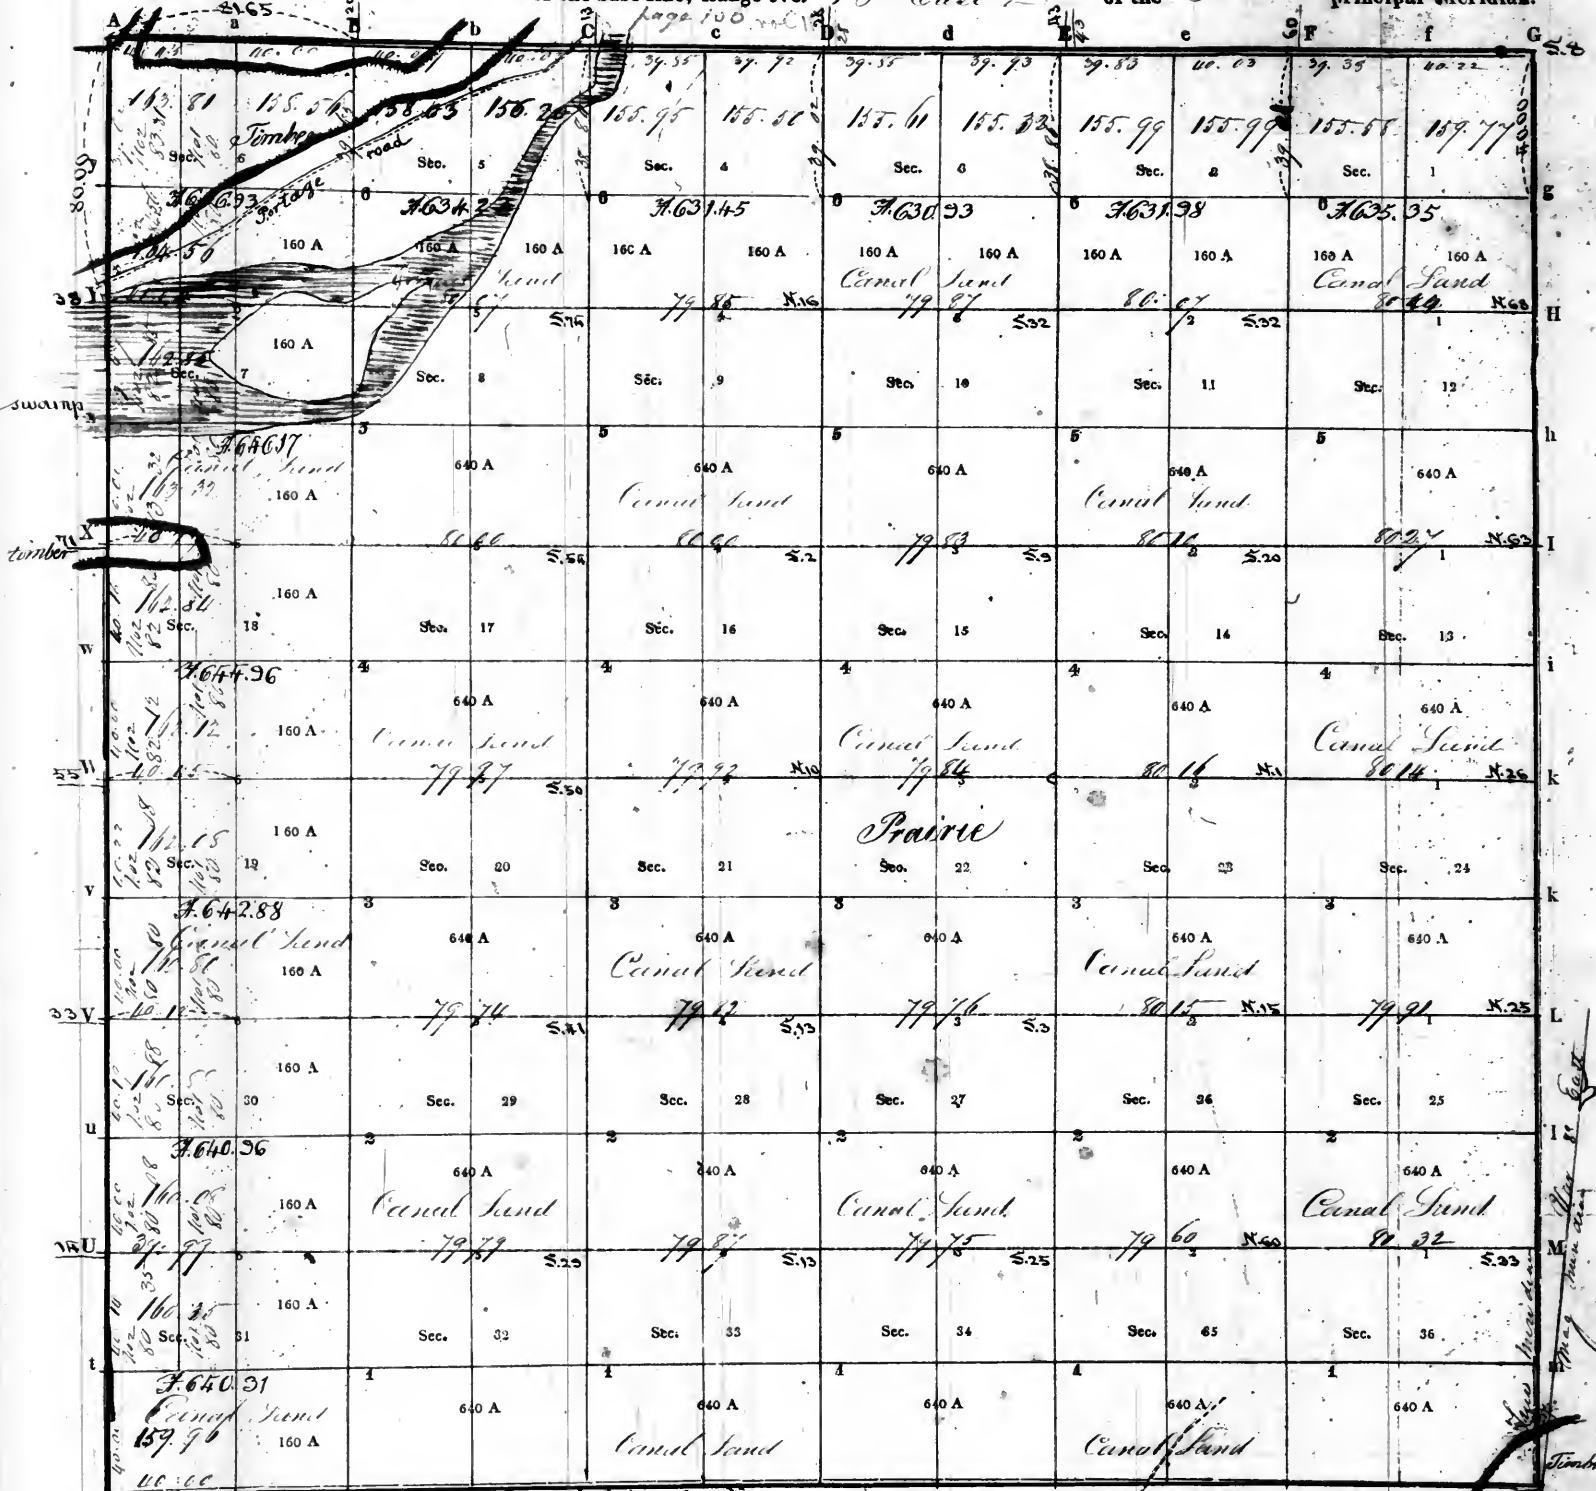

Aggregate area - 23026.15 acres

Scale of 40 Chains to an inch.

PURSUANT to a contract with, and instructions from William Reector, Surveyor of the lands of the United States in the *State of Illinois and Territory of Arkansas* bearing date the *fourteenth* day of *March* 182*7* I have measured, laid out and surveyed the above described Township; and do hereby certify, that it had such marks and bounds, both natural and artificial, as are represented on said plat, and described in the field notes made thereof, and returned with this plat into the Office of the Surveyor of the Lands of the United States, in the *State of Illinois and Territory of Arkansas*


Certified this *1827* day of *March*

1827

D. SURVEYOR.

EXAMINED.


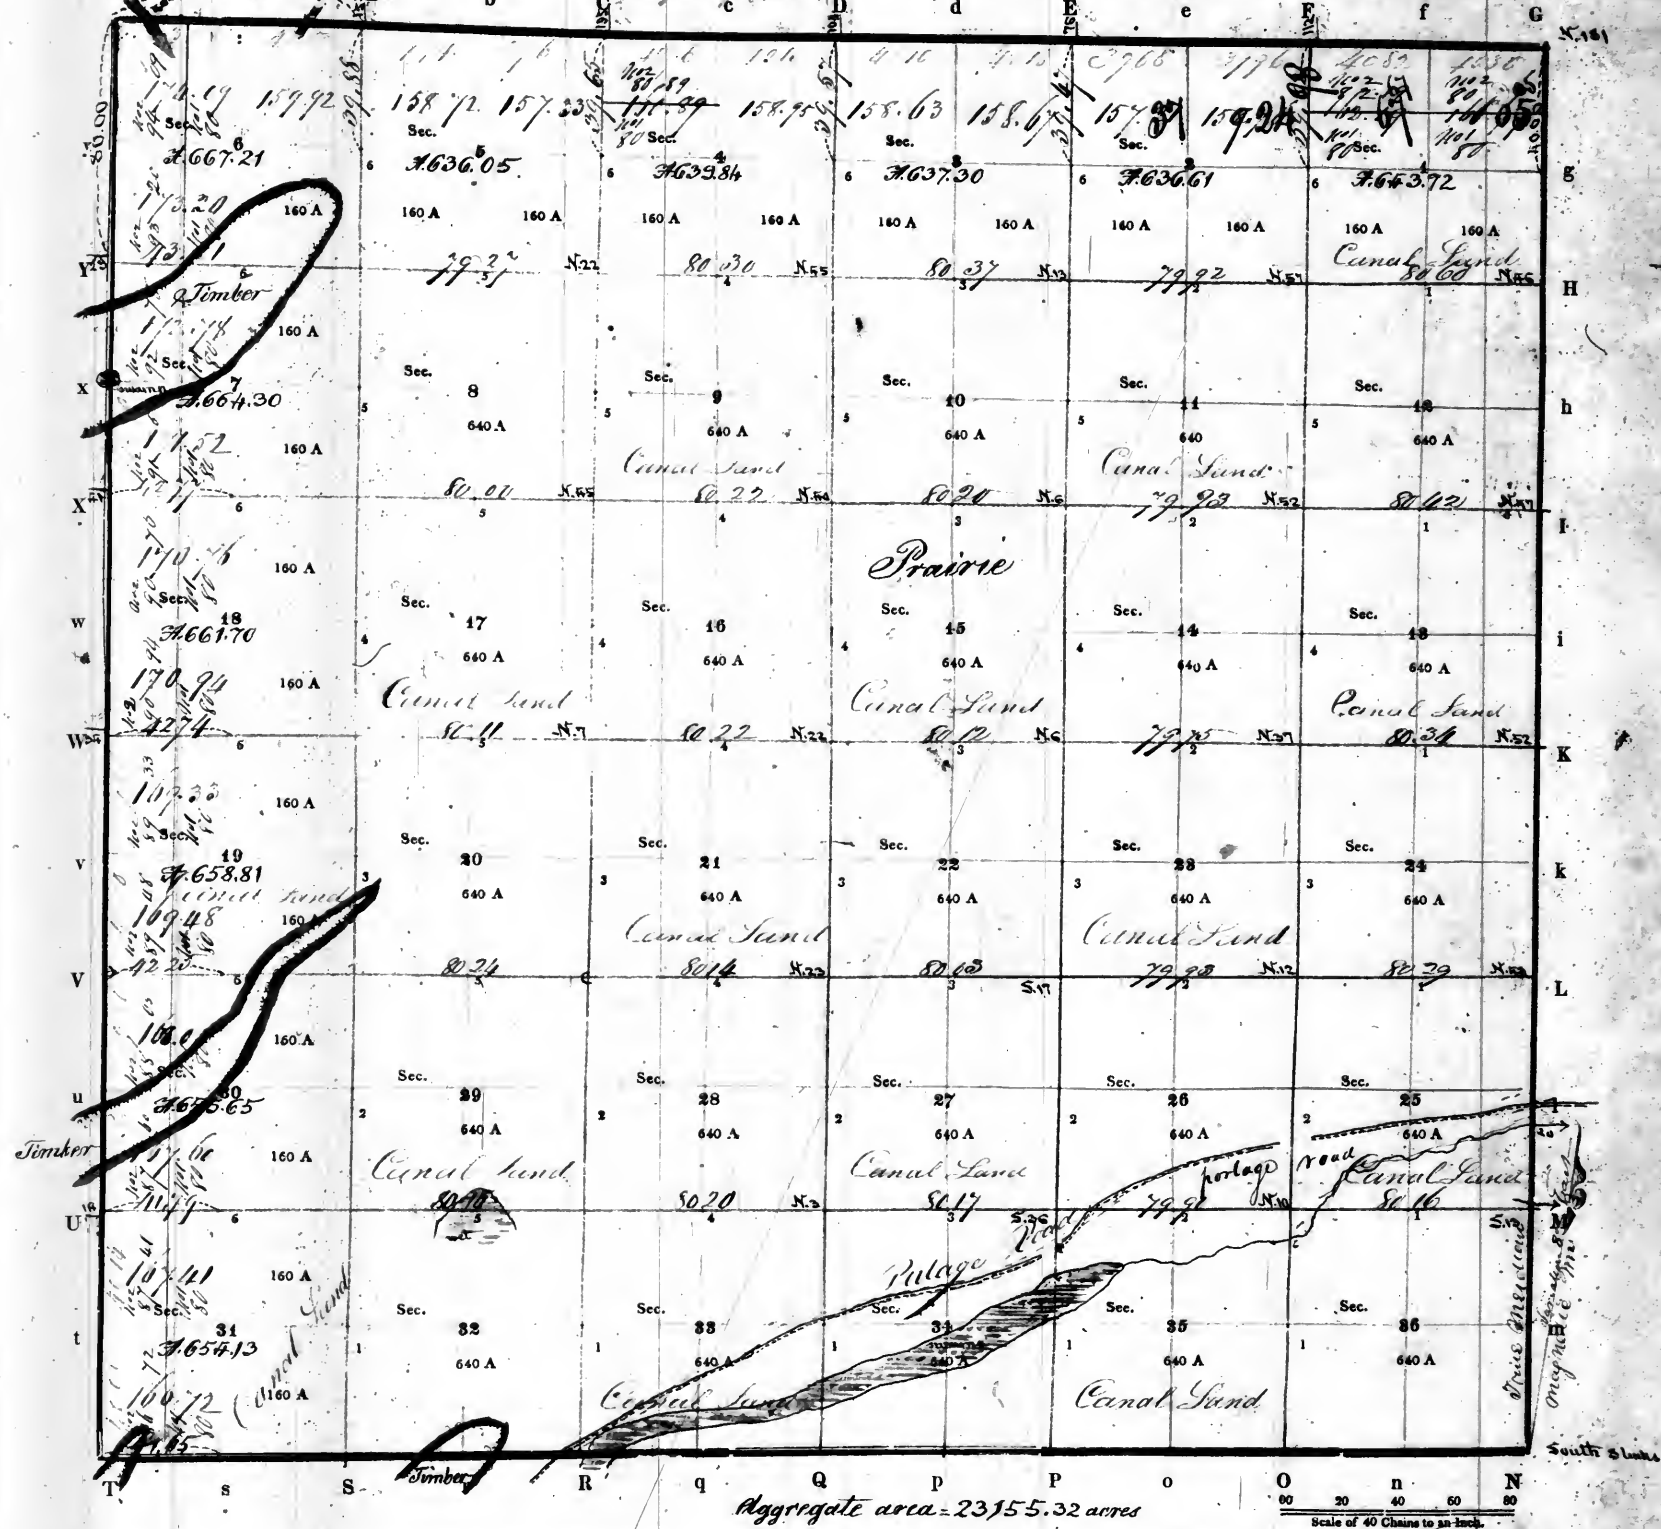

PURSUANT to a contract with, and instructions from WILLIAM RECTOR, Surveyor of the lands of the United States in the *State of Missouri*, Secretary of Wisconsin, bearing date the *twentieth* day of *March* 18*81*

I have admeasured, laid out and surveyed the above described Township; and do hereby certify, that it had such marks and bounds, both natural and artificial, as are represented on said plat, and described in the field notes made thereof, and returned with this plat into the Office of the Surveyor of the lands of the United States, for the *State of Missouri*, Secretary of Wisconsin

Certified this _____ day of _____


EXAMINED.

D. SURVEYOR

Township N. 40. 41 south of the Base line Range N. 13 East of the 3rd Principal Meridian
pages 108 and 11

Aggregate area of T. 40. N. 13 E. of the 3^d 1st Mer. (South of Old Ind. B. line) = 18777.31 acres
" " " T. 41. N. 13 E. " " " = 319.16 "

Total = 18096.47 acres

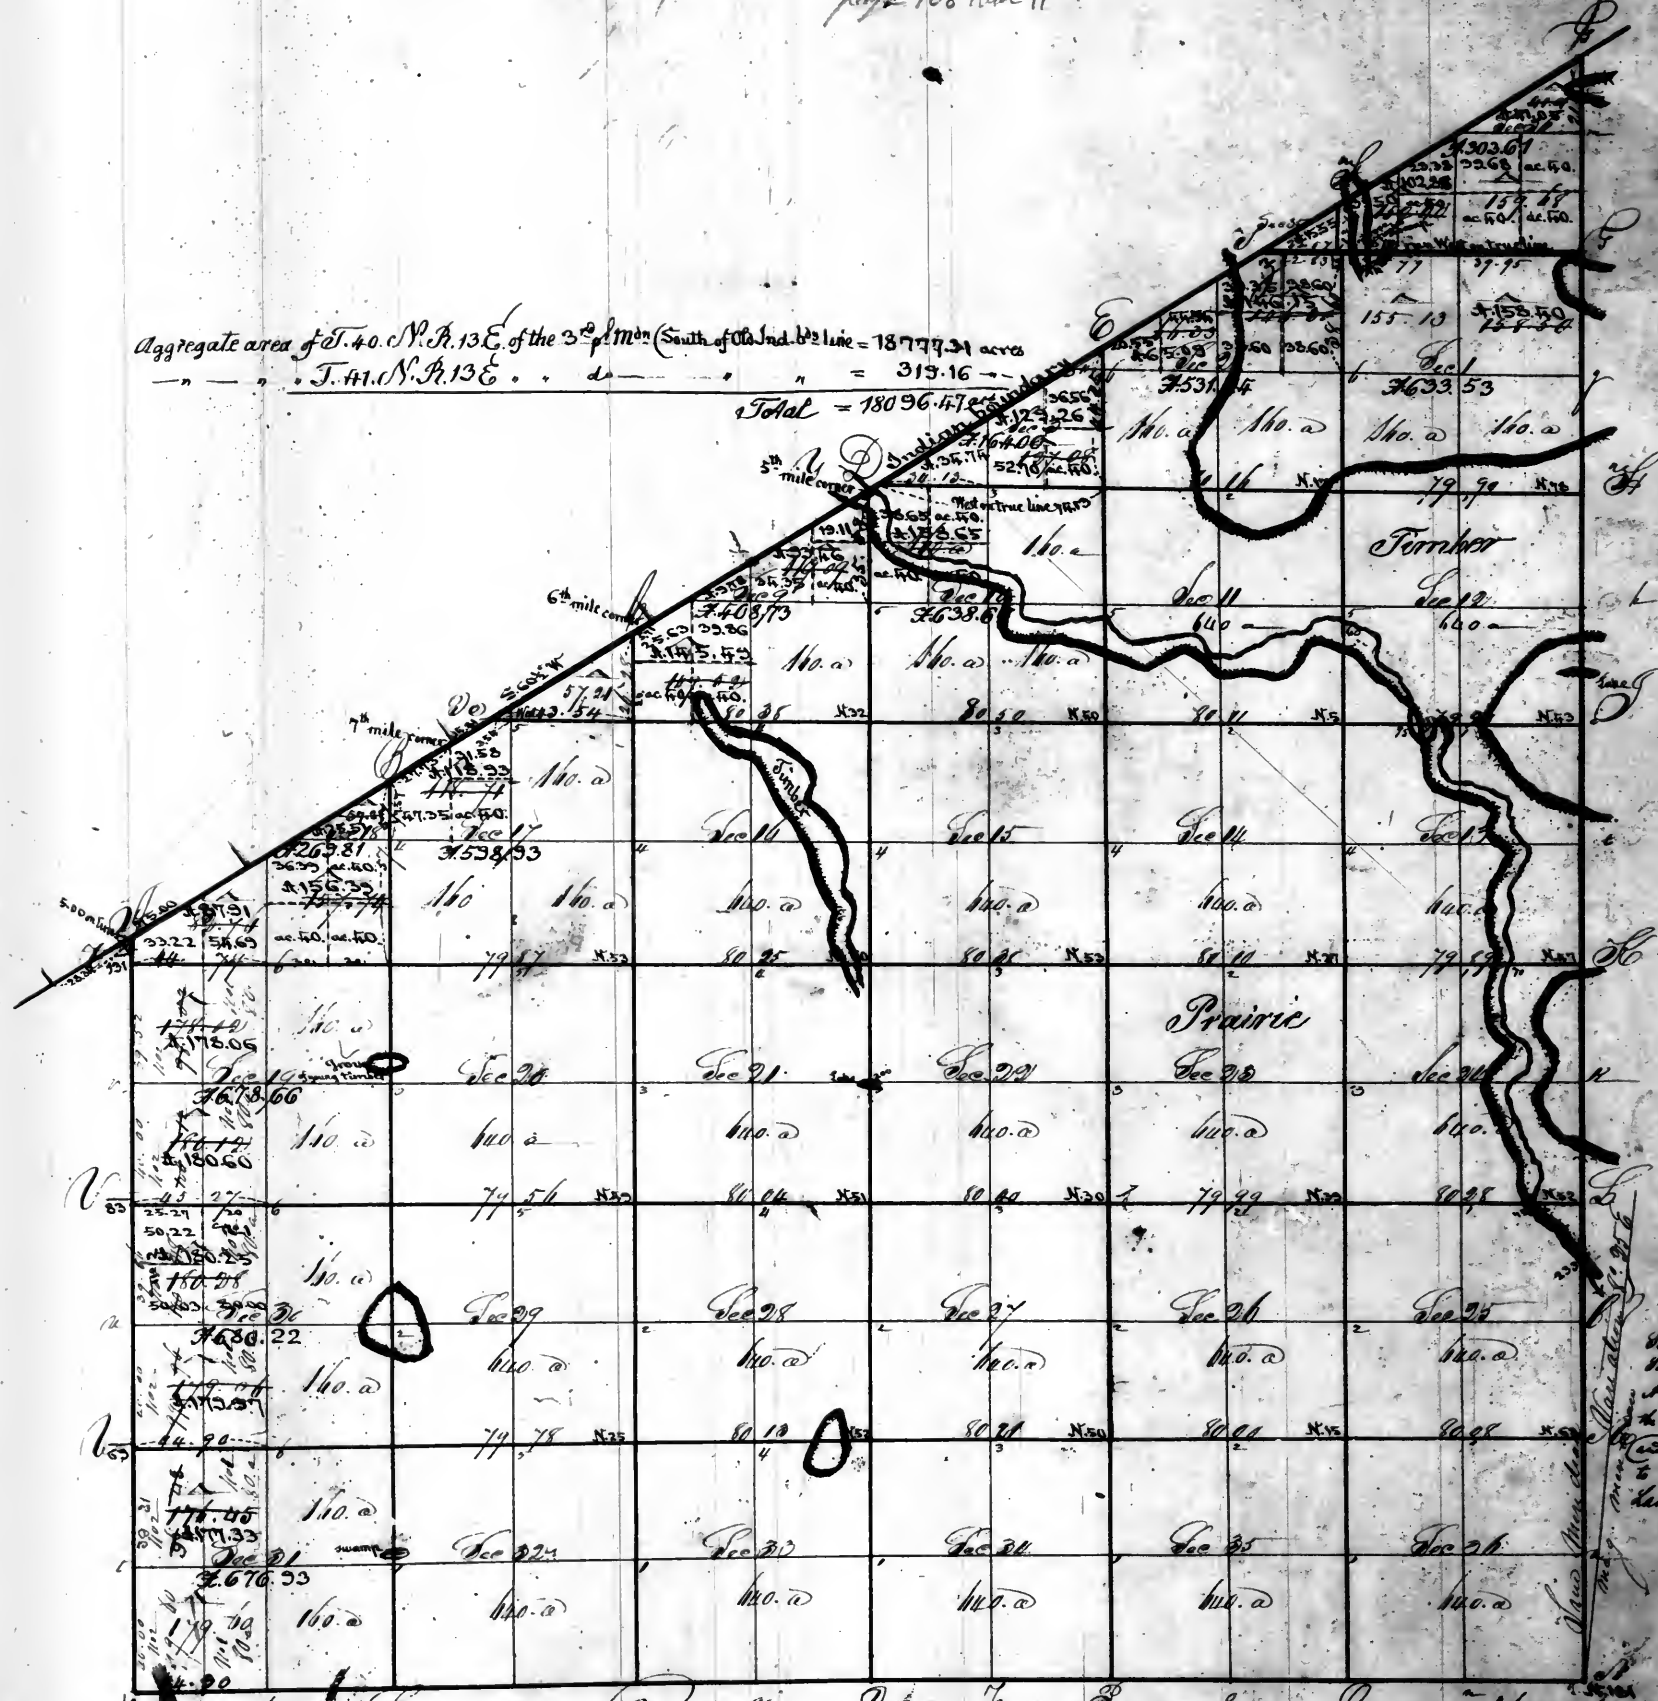




surveyed said lot and surveyed the above described fractional township and do hereby certify that it has been
surveyed both natural and artificial as are represented on said plat and described in the field notes made
thereof and returned with this plat into the office of the Surveyor of the lands of the United States in the
States of Illinois and Missouri and Territory of Arkansas
Certified this day of
Examined
Deputy Surveyor

45

Box 109 Vol. 11

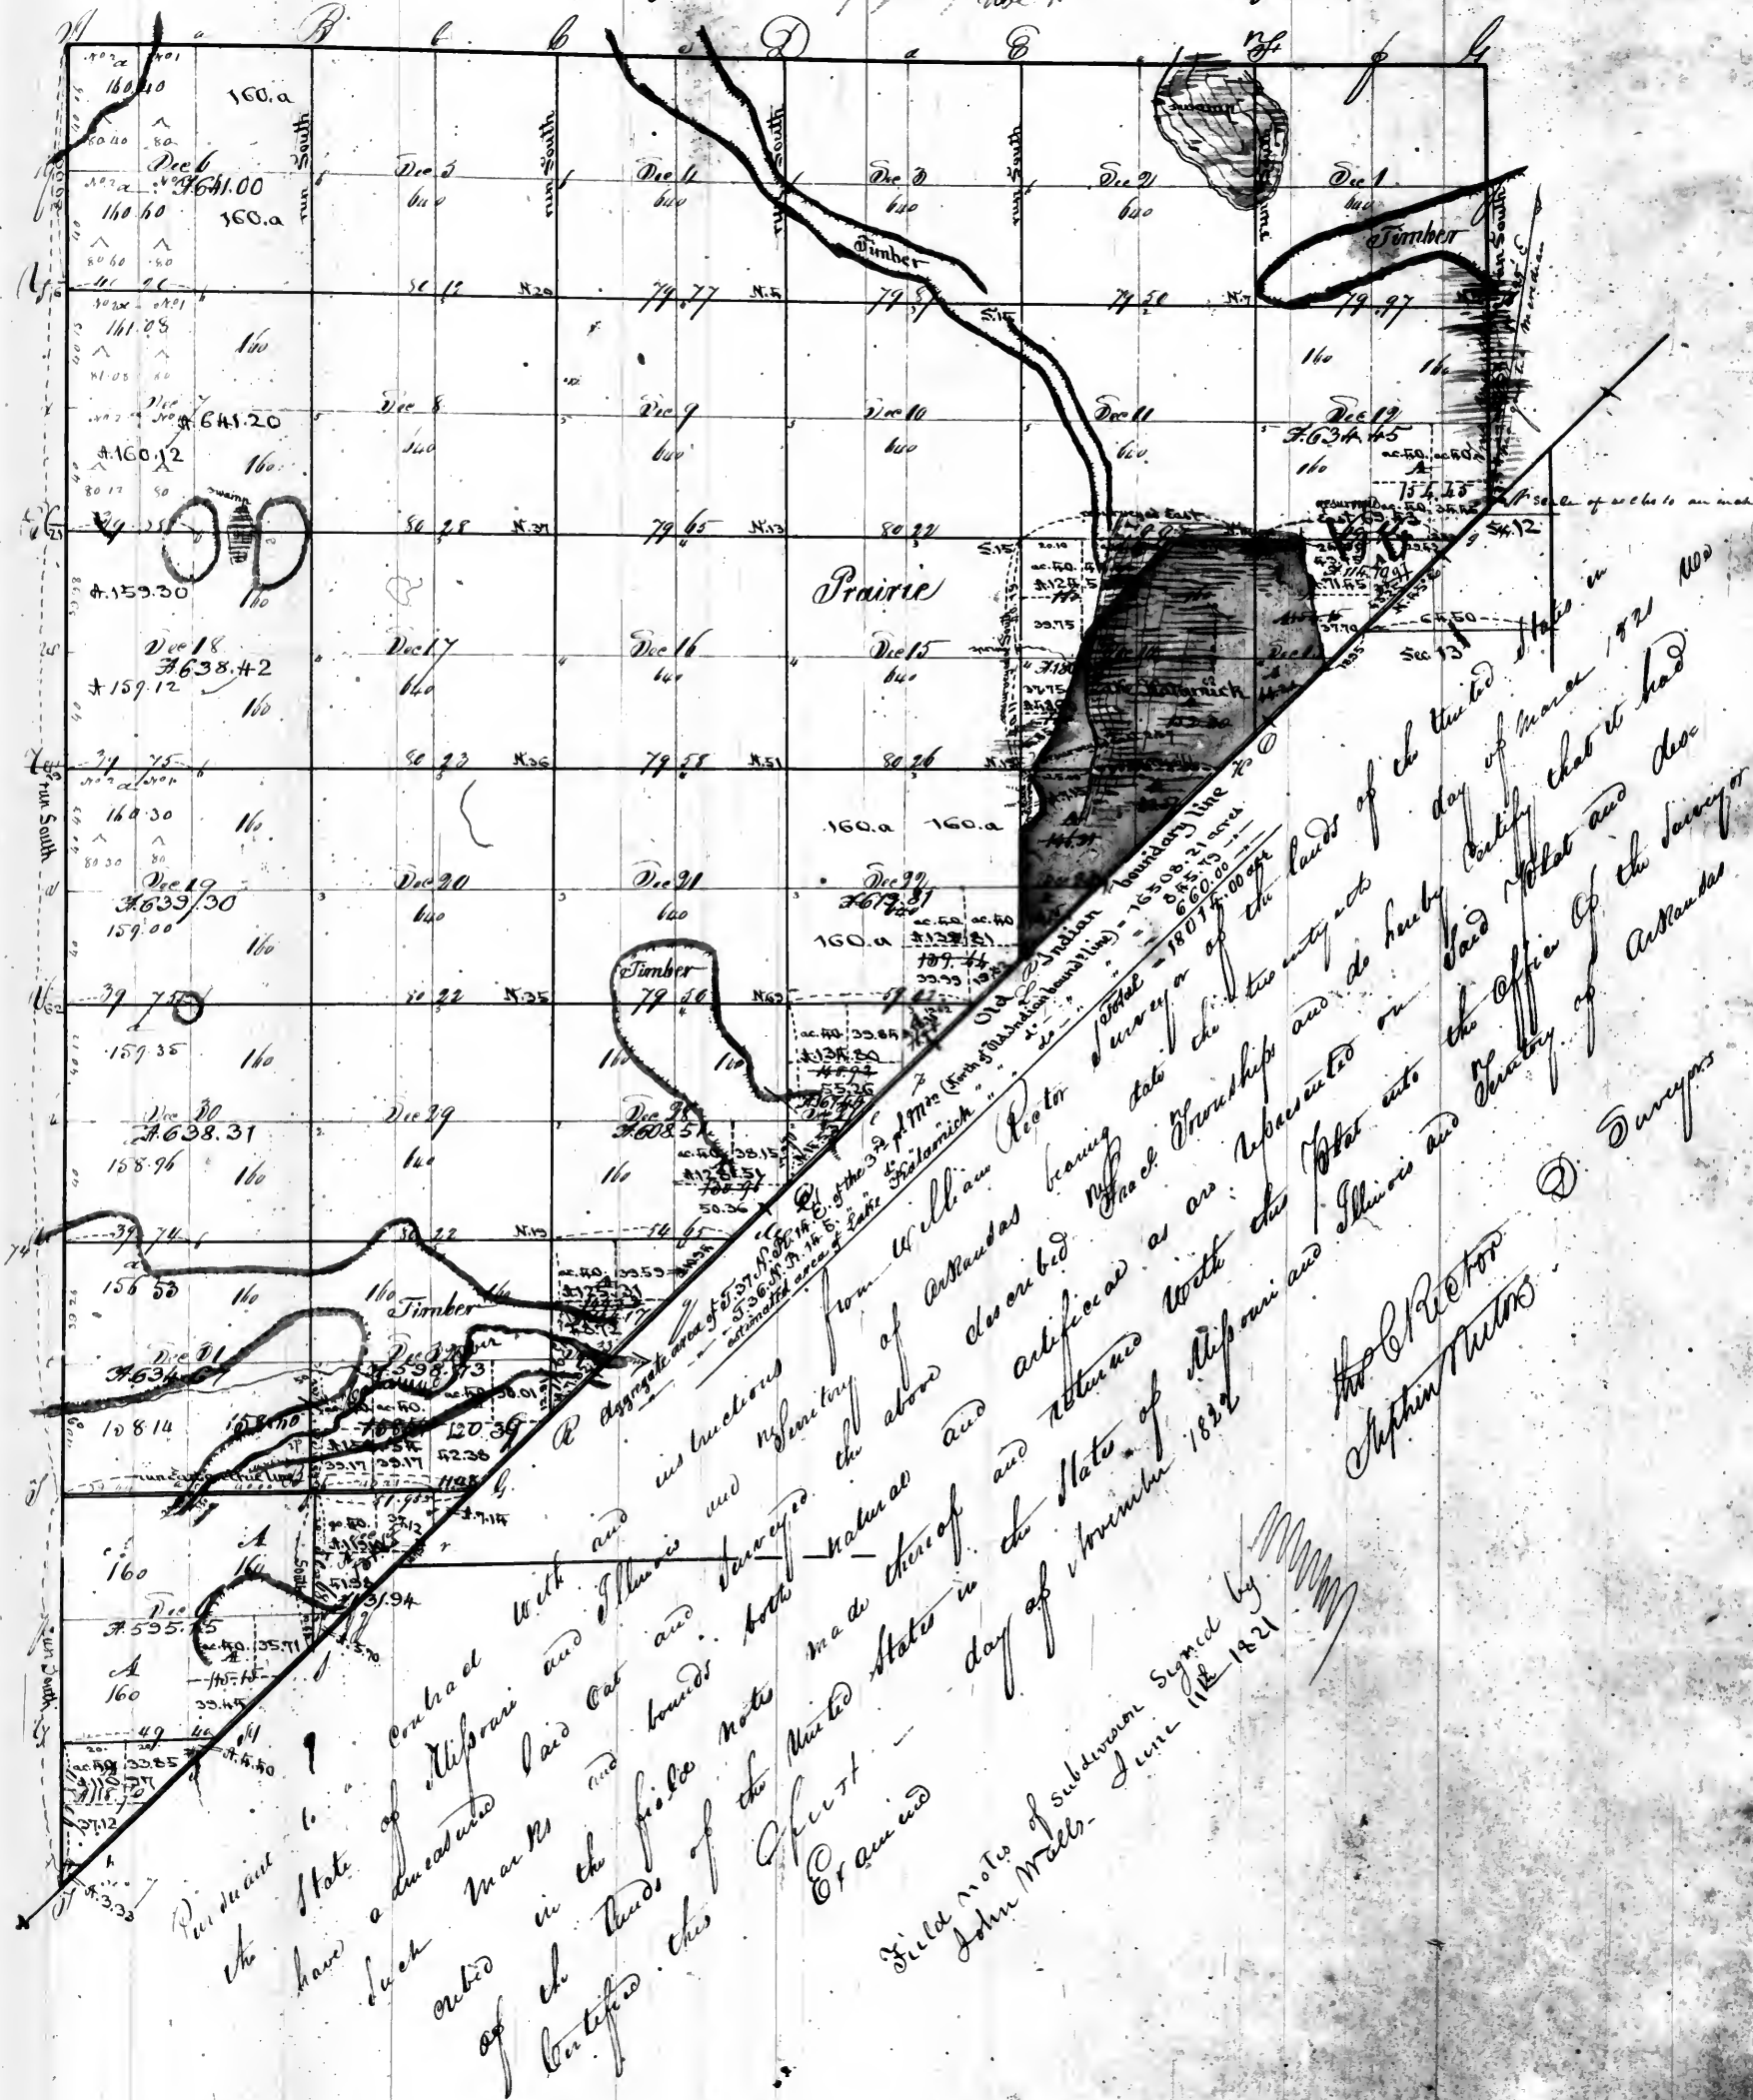

78
 Township 25 North of the North Line Range 14 East of 3rd Principal Meridian
 Page 112 of 11

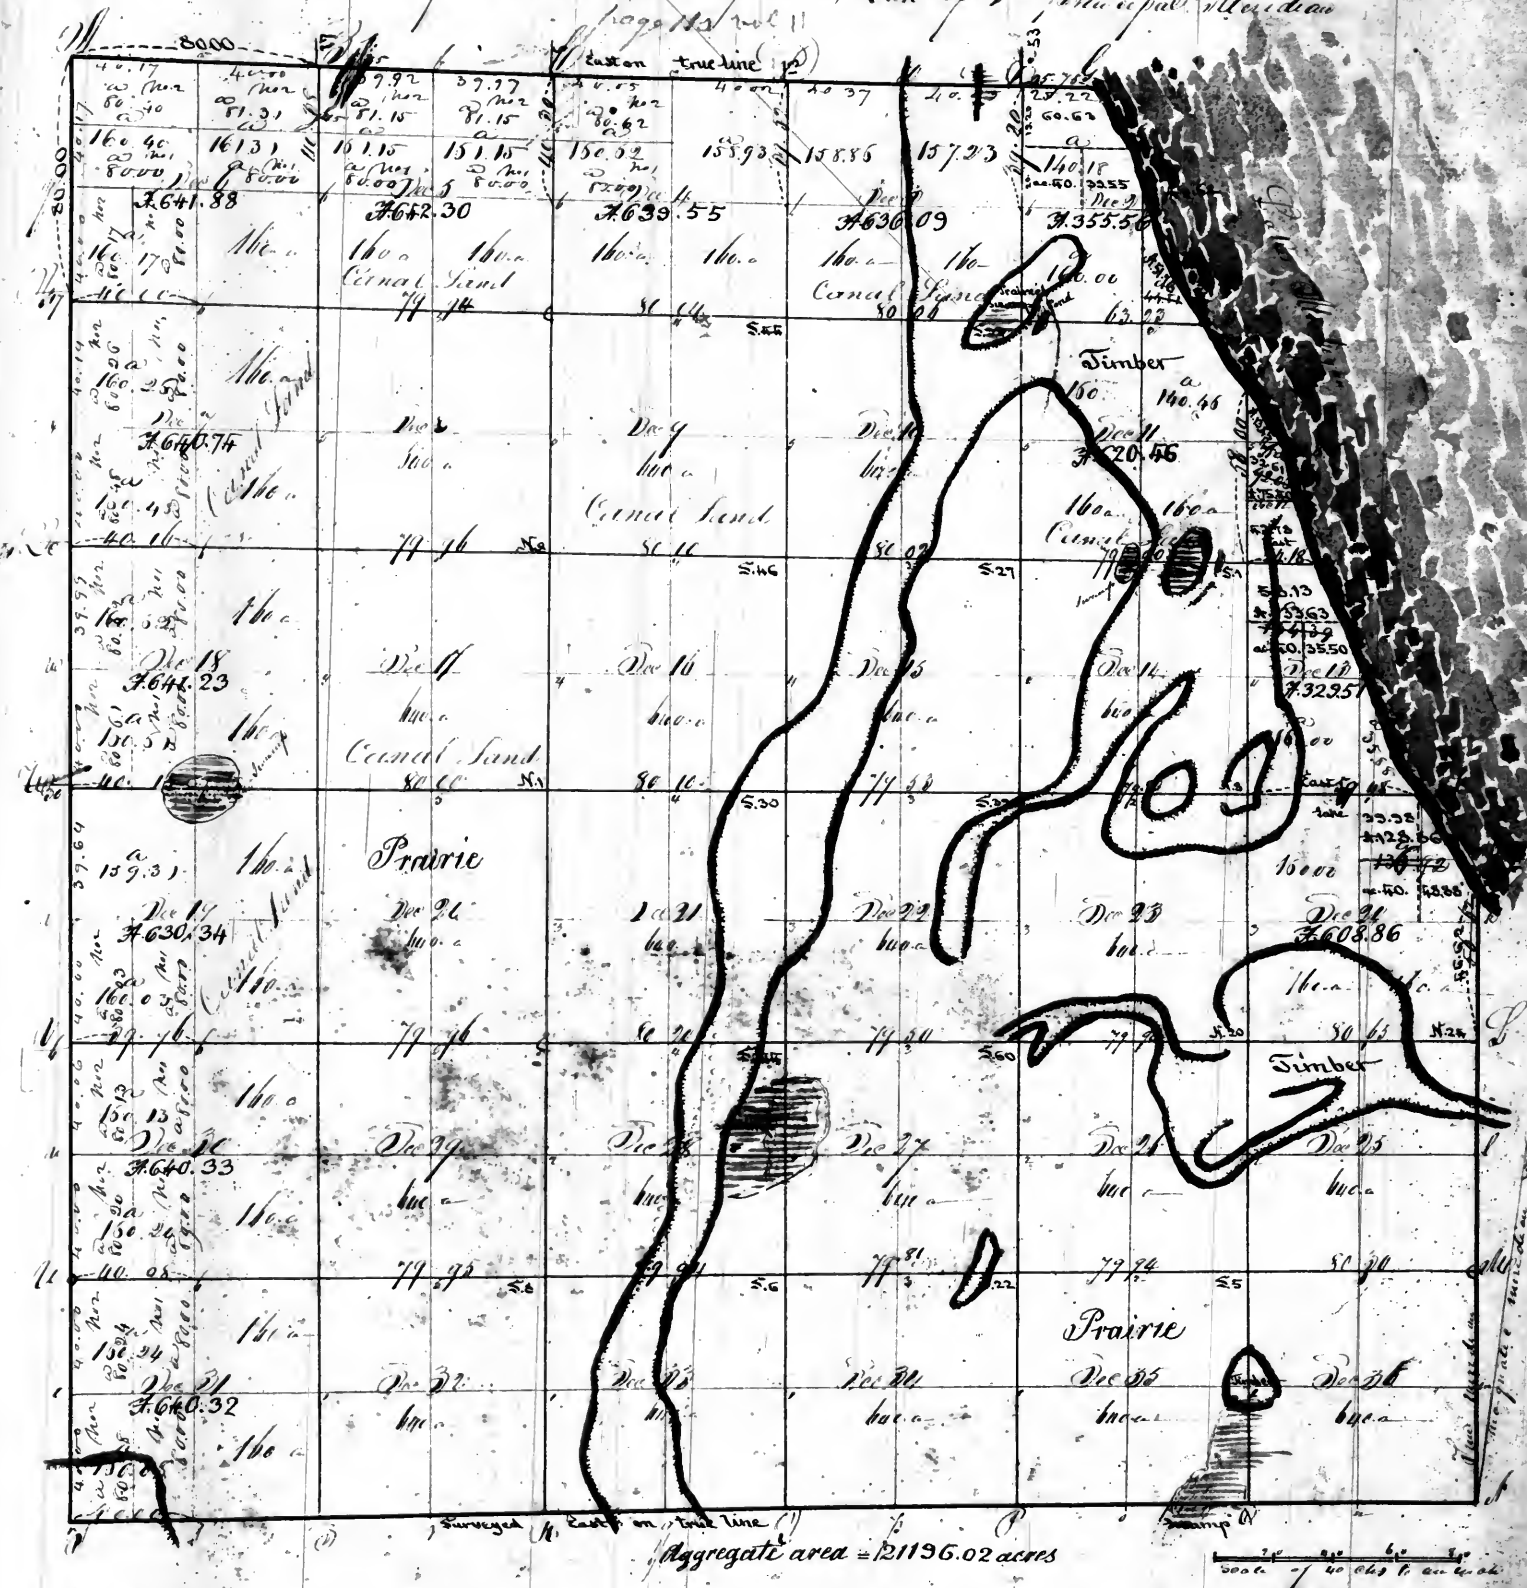

In pursuance to a contract with and instructions from William Victor Surveyor of the lands of the United States in the States of Missouri and Illinois and Territory of Arkansas bearing date the twentieth day of March 1821 We have advanced laid out and surveyed the above described Township and do hereby certify that it has been marked and bounded by natural and artificial as are represented on said plat and described in the notes made thereof and returned with this plat into the office of the Surveyor of the Lands of the United States in the States of Missouri and Illinois and Territory of Arkansas

Certified this . day of


Examined

D. Quincy





Plat of fractional Section 15 and that part of fractional section 10 which lies South of the Chicago river in Township 35 North Range 14 East of the 3^d principal Meridian showing the said fractions as surveyed in June 1821 according to the field notes of the survey then on file in this Office and according to the Plat of the Township authorized from said notes and approved by William H. Ralston Surveyor of public lands on the 16th of March 1831 (where 27 Acres in Fractional Section 10 and 116 acres in addition to each of said fractional sections according to notes of survey on file in this Office surveyed by Edward B. Talcott Esq. Surveyor to be the original field notes of the survey of the said two adjoining fractional sections 10 & 15 Township 35 North Range 14 East of the 3^d principal Meridian as executed by him in the month of February 1826 and confirmed with and instructions from Elias A. Langham Surveyor of the lands of the United States in Illinois & Missouri bearing date the 3^d of February 1826. The addition to fractional section 10 contains 26.77 acres and is bounded North by the South line of the improvements of the Chicago harbor, West by the fraction as surveyed in 1821, North by the line between sections 10 & 15 extended East 4 chains 74 links from the corner established in 1821, N. 17 chains and 20 links East of the corner to sections 3, 10, 15 & 16, and East by the shore of Lake Michigan as defined by Deputy Surveyor Talcott. The addition to fractional section 15 contains 11.67 acres and is bounded West by the fraction as surveyed in 1821, North by the line between sections 10 & 15 extended East 4 chains 74 links as above stated, and East & South by the shore of Lake Michigan as defined by Deputy Surveyor Talcott.

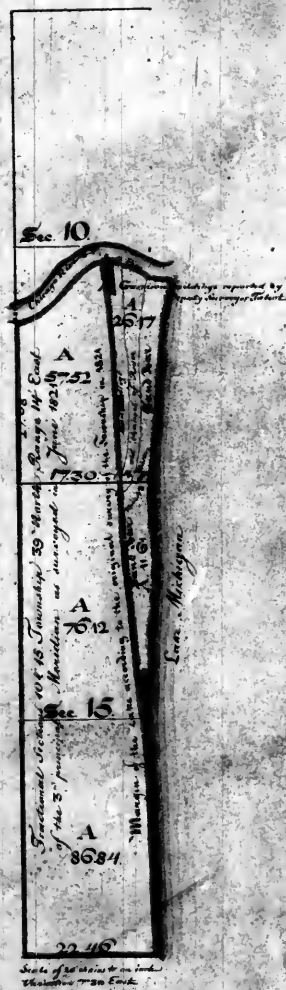

Surveyors Office
St Louis 21st of January 1837

The foregoing Plat of fractional section 15 and that part of fractional section 10 which lies South of the Chicago river in Township 35 North Range 14 East of the 3^d principal Meridian is shown conformable to the field notes of the survey and the Plat designated above and on file in this Office. That certain the contract and returns referred to by Mr. Talcott, are on file in this Office.

David H. M. M. M.

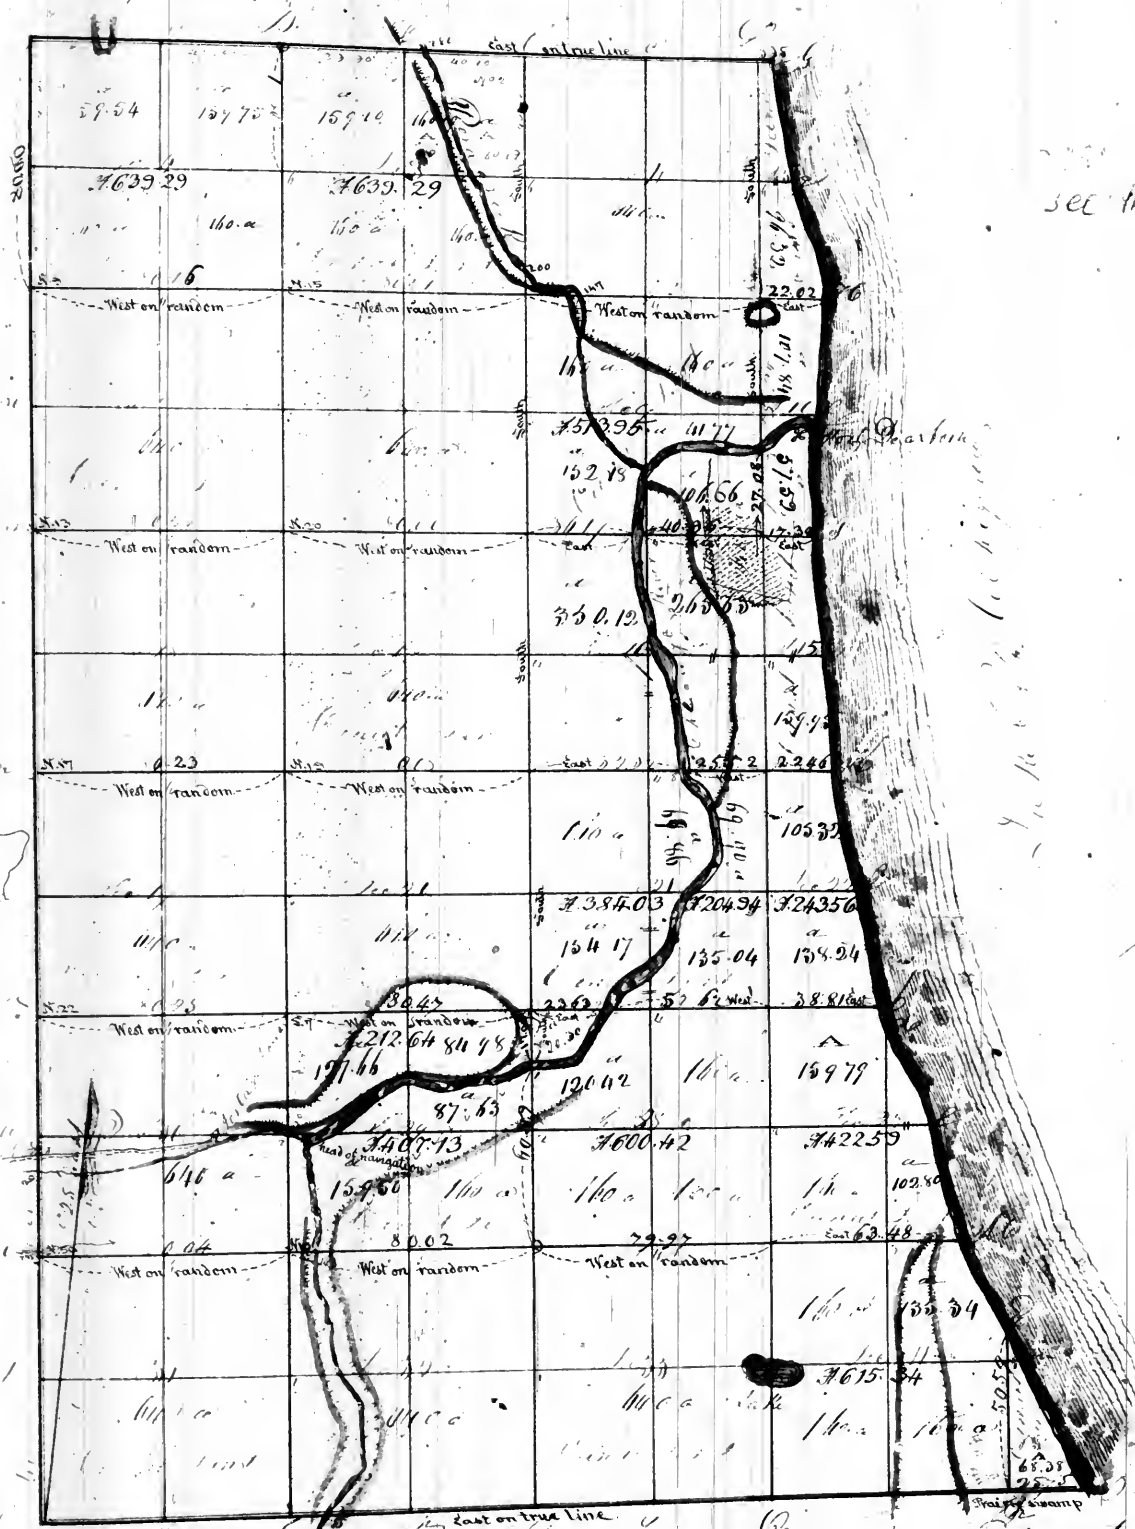

page and in this Township
see the following list on page 47.

Aggregate area = 13176.38 acres

[illegible]

Mr. C. Victor
Stephen Victor Attorney

139.81 159.43 159.43 159.81 160 a 160 a

Sec 6 A. 639.24 160 a 160 a

80.16 80.31 80.31 80.31 80.31 80.31

Sec 7 640 a




























LAKE MICHIGAN

14th of August 1852

J. H. R.

None of the said notes state at what Variations were executed nor do the notes of the extension refer the survey thereof to any principal map. Book 146 is without signature 147 is signed, is written on the first page. Book 751 is ^{not} signed.

The meanders of Lake Michigan along at the Corner to Tract^d sections 10 7 15 and side of Tract^d section 10"

"North 2. West 1
 "S. 4 W
 "S. 5 1/2 W
 "To the mouth of the Chicago River"
 "Thence across mouth of Chicago River"
 "North 29. East
 "North 10 E -
 "North 4 West
 "North 14 West


Fractⁿ Section 3 & 10 The meanders of Chicago on the south side of said river at its mouth (any other connection between the said meander Lake) and were run. Thence up said river according to the notes is considered as high up as across the river due North $2^{\circ} 25'$ Thence down to the mouth of Chicago River on the north side between the said meanders of the Chicago and

In the construction of this plat and return of fractⁿ Section 10 the meanders of the south considered as having commenced at the (of the Lake) is called, the mouth of Chicago & 39 & 4.47 chs mentioned above is supposed upper point of the mouth of the Chicago is taken as the point to which the meanders of the Chicago close, as stated above.

As the meanders of the Chicago are taken forks in the S.W. quarter of section 29, set down in the said quarter includes line north of said river, as well as the


Surveyor's Office St Louis 4 of May 1836
The true area of the St lot 14
is 57⁵/₈ acres, the quantity (75.69 acres)
erroneous is this day crossed over with.

Geo. E. Vinton
 Stephen Vinton
 Deputy Surveyors.

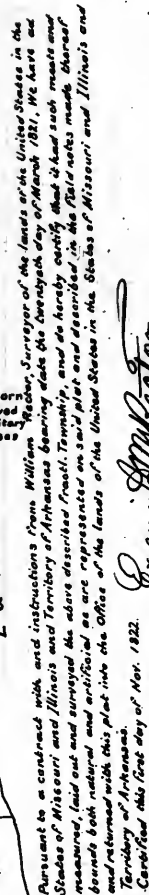

Ex amin. Director

fractional township 39 North of the base line, Range 14 East of the 3^d principal Meridian.
 Except that part of Section 16, which lies on the left or West side of the Chicago River.

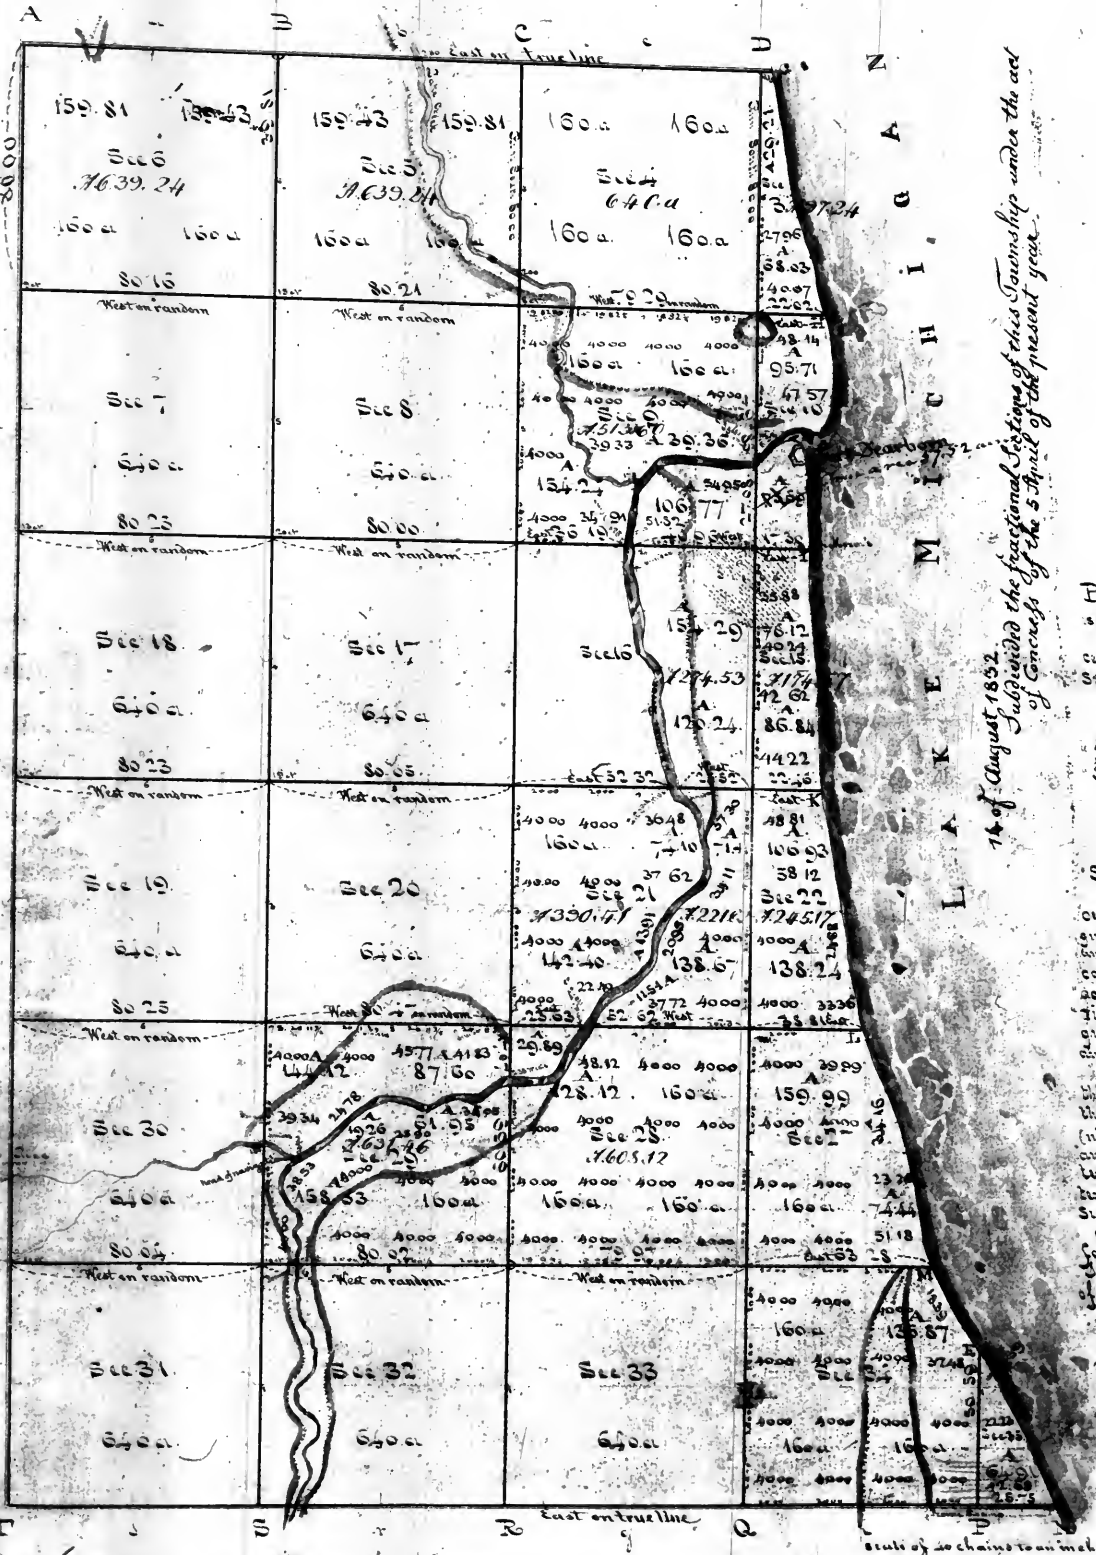

14 of August 1852. Subdivided the fractional sections of this Township under the act of Congress of the 5 April of the present year.

The Notes used in the Construction of this plat are contained in the field books numbered as follows: viz of the South Range in Book 146, West of North 34, Book 147, Subdivision and Meanders in Book 781.

None of said notes state at what Variation the Surveys were executed. Nor do the Notes of the Exterior boundaries refer the Survey to any principal Meridian.

Book 146 is without Signature, 147 is not signed. The name "John Wells" is written on the first page, Book 781 is signed John Wells. The meanders of Lake Michigan, along page Section 10, commence at the corner of West Section 10, 15, and run thence along the East side of East Section 10.

Section 10 West 11.50"
 of 1/4 W 3.20"
 of 1/4 W 11.80"

to the mouth of the Chicago River.

thence, across the mouth of Chicago River.

North 20 East 1.11"

North 10 E 1.05"

North 1 W 10.00"

North 14 West 10.133. the corner of East

Section 30. The meanders of the Chicago river, were commenced "on the South side of said river, at its mouth" but the notes go on and say "connection between said meanders and the meanders of the Lake" and then say "thence up said river to the fork in Section 29, where, according to the notes is 'collected as high up as it is navigable' thence across the river due North 22' thence down the North side of said river to the mouth of Chicago river on the North side" but the field books give no connection between the said meanders of the Chicago and the meanders of the Lake.

In the Construction of this plat and in determining the area of the tract of East Section 10, the meanders of the South bank of the Chicago are considered as having commenced at the point where (in the meanders of the Lake) is called "the mouth of Chicago River" and the connection of the said meanders above, is supposed to terminate at the upper point of the mouth of the Chicago, and said termination is taken as the point, to which the meanders of the West side of the Chicago close, as stated above.

As the meanders of the Chicago are taken no farther than the fork in the S.W. quarter of Section 29, the area (155.53 acres) set down in said papers includes the East thereof, which lies West of said river, as well as that which lies to the South.

Wm. M. Rice
 Surveyor, after it was 4 of May 1851
 The true area of the 1/4 of Sec. 10 (155.53 acres) is 67.27 acres
 the quantity (155.53 acres) formerly set down being erroneous in the
 survey and over with said
Wm. M. Rice
Surveyor

Surveyors Office
 St. Louis 16th March 1851
 The above plat, of 1/4 Sec. 10, R. 14 East, W. 39 North, of the
 notes as explained in the above marginal remarks, of the
 Survey, of said Township, contained in field books, numbered
 respectively 146, 147 and 781, are filed in this Office.
 Wm. M. Rice
 Surveyor.

L. 277978

2 Inc.

DEPARTMENT OF THE INTERIOR

GENERAL LAND OFFICE

WASHINGTON November 2, 1912.

ADDRESS ONLY THE
COMMISSIONER OF THE GENERAL LAND OFFICEAs to plat.The Auditor of State,
Springfield, Ill.

Sir:

I am sending you under separate cover, a copy of plat of T. 39 N., R. 14 E., 3rd Prin. Mer., of which the original appears to be no longer on file. Please compare with the copy in your office, and return with a certificate, placed directly upon the sheet, so that it may be bound with other plats, in lieu of an original. Thanking you for the favor, I inclose frank and franked envelope.

Very respectfully,

H. F. Brown
Assistant Commissioner.

11/11/JTS

DEPARTMENT OF THE INTERIOR,
GENERAL LAND OFFICE.


The Commissioner of the General Land Office.

WASHINGTON,

D. C.

RETURN REPLY ENVELOPE.
This envelope can be used only for reply to official communications. The address must not be changed.

ref. Section Township N 37 408 & R 15 East of 3rd Principal Meridian
 1892 114 Vol 11

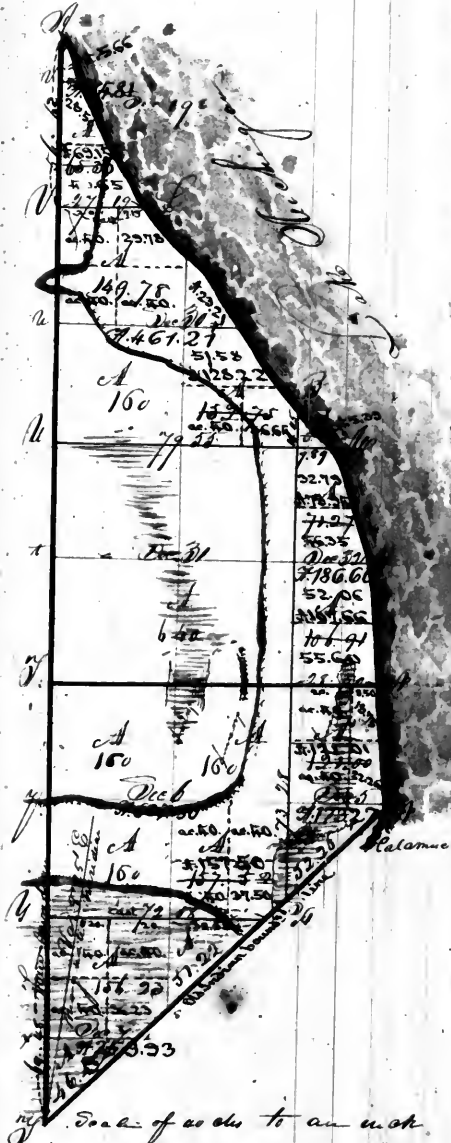

Aggregate area of S. 33. N. 37. 15 E. of the 5th pl. etc. - 1368.01 ac
 -- S. 37. N. 37. 15 E. -- 1064.40 --
 (North of 1850. land line)
 Total - 2432.41 ac




Accepted
 Examined

D. D. Dwyer

783

Township 39 North of the baseline, Range 14 East of the 3rd principal Meridian.

That part of Section 16 which lies on the left or west side of the Chicago River.

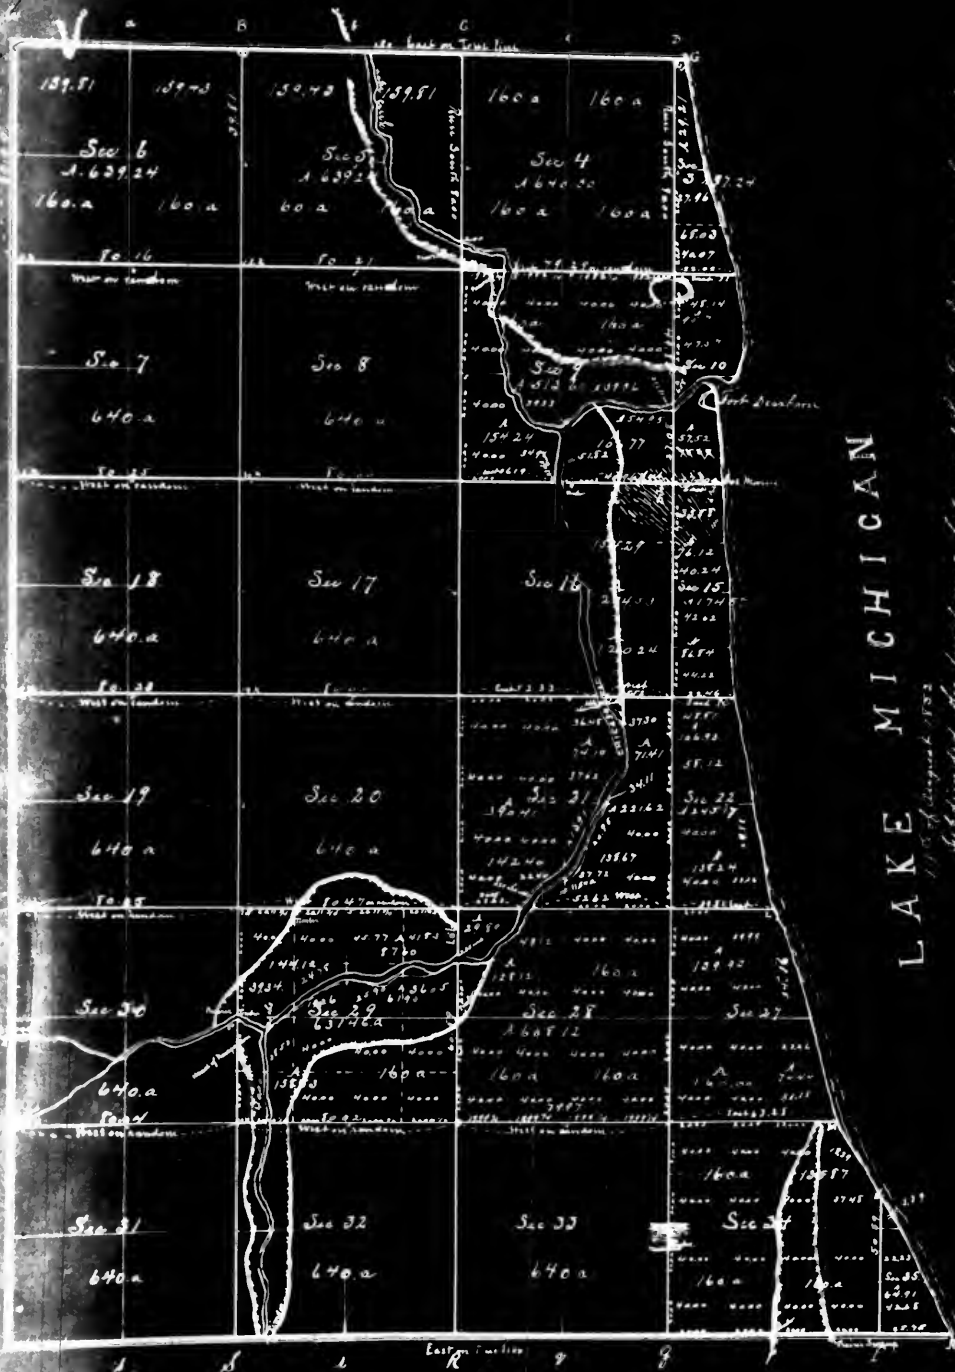

The notes used in the construction of this plan are contained in the following:

of the South Bend, in Book 46
West North West Book 10
Subdivision & Measure in

Book No. 75

Some of the said notes state at what variation the Survey were executed and do the notes of the exploration boundaries refer the survey thereof to any principal meridian.

Book 46 is without exception 147th signed, the name "John Hall" is written on the first page, Book 75 is signed "John Hall".

The measure of Lake Michigan along track Section 10 commencing at the corner of Tract Sections 16 & 15 and run thence along the east side of Tract Section 10

North 2 West 45th

North 4 West 52th

North 5 West 57th

To the mouth of the Chicago River

Thence across mouth of Chicago River

North 29 East 44th

North 10 E - 14th

North 4 West 20th

North 4 West 20th To the corner of

Tract Sections 34 & 10

The measure of Chicago River water commencing on the South side of said river at its mouth (but the notes do not say any other connection between the said measure and the measure of the Lake) and water, run thence up said river to the fork in Sect 29 which according to the notes is commencing as high up as it is shown on the survey. The river runs North 2nd 21st Thence down the North side of said river to the mouth of Chicago River on the North side but the notes give no connection between the said measure of the Chicago and the measure of the Lake.

In the construction of this plat and estimate the area of the tract of fract Section 10 the measure of the South Bank of the Chicago are considered as having commenced at the point which on the measure of the Lake is called the mouth of Chicago River and the course 29 E 44th the mentioned above is supposed to terminate at the upper bank of the mouth of the Chicago and said termination is taken as the point to which the measure of the North side of the Chicago close, as stated above.

In the measure of the Chicago are taken no farther than the fork in the SE quarter of Section 29. The area 10000 acres set down on the said quarter includes the part there, which lies north of said river as well as that which lies to the South of the River.

Surveyor's Office at St. Louis - of May 1836

The true area of the SE 1/4 of Sec 10 (S of Chicago River) is 57th acres. The quantity (10000 acres) formerly set therein being erroneous in that day crossed over with error.

E. R. 10. 10. 11

Surveyor's Office

St. Louis 16 March 1831

above plat of fractth Sup. R. 14 East is conformable with the notes

contained in the above margins remarks of the survey of said Township contained in field

numbers respectively 146-147 and 751 on file in this Office


W. H. Rec

do April 1831

VOL 15

Record

2

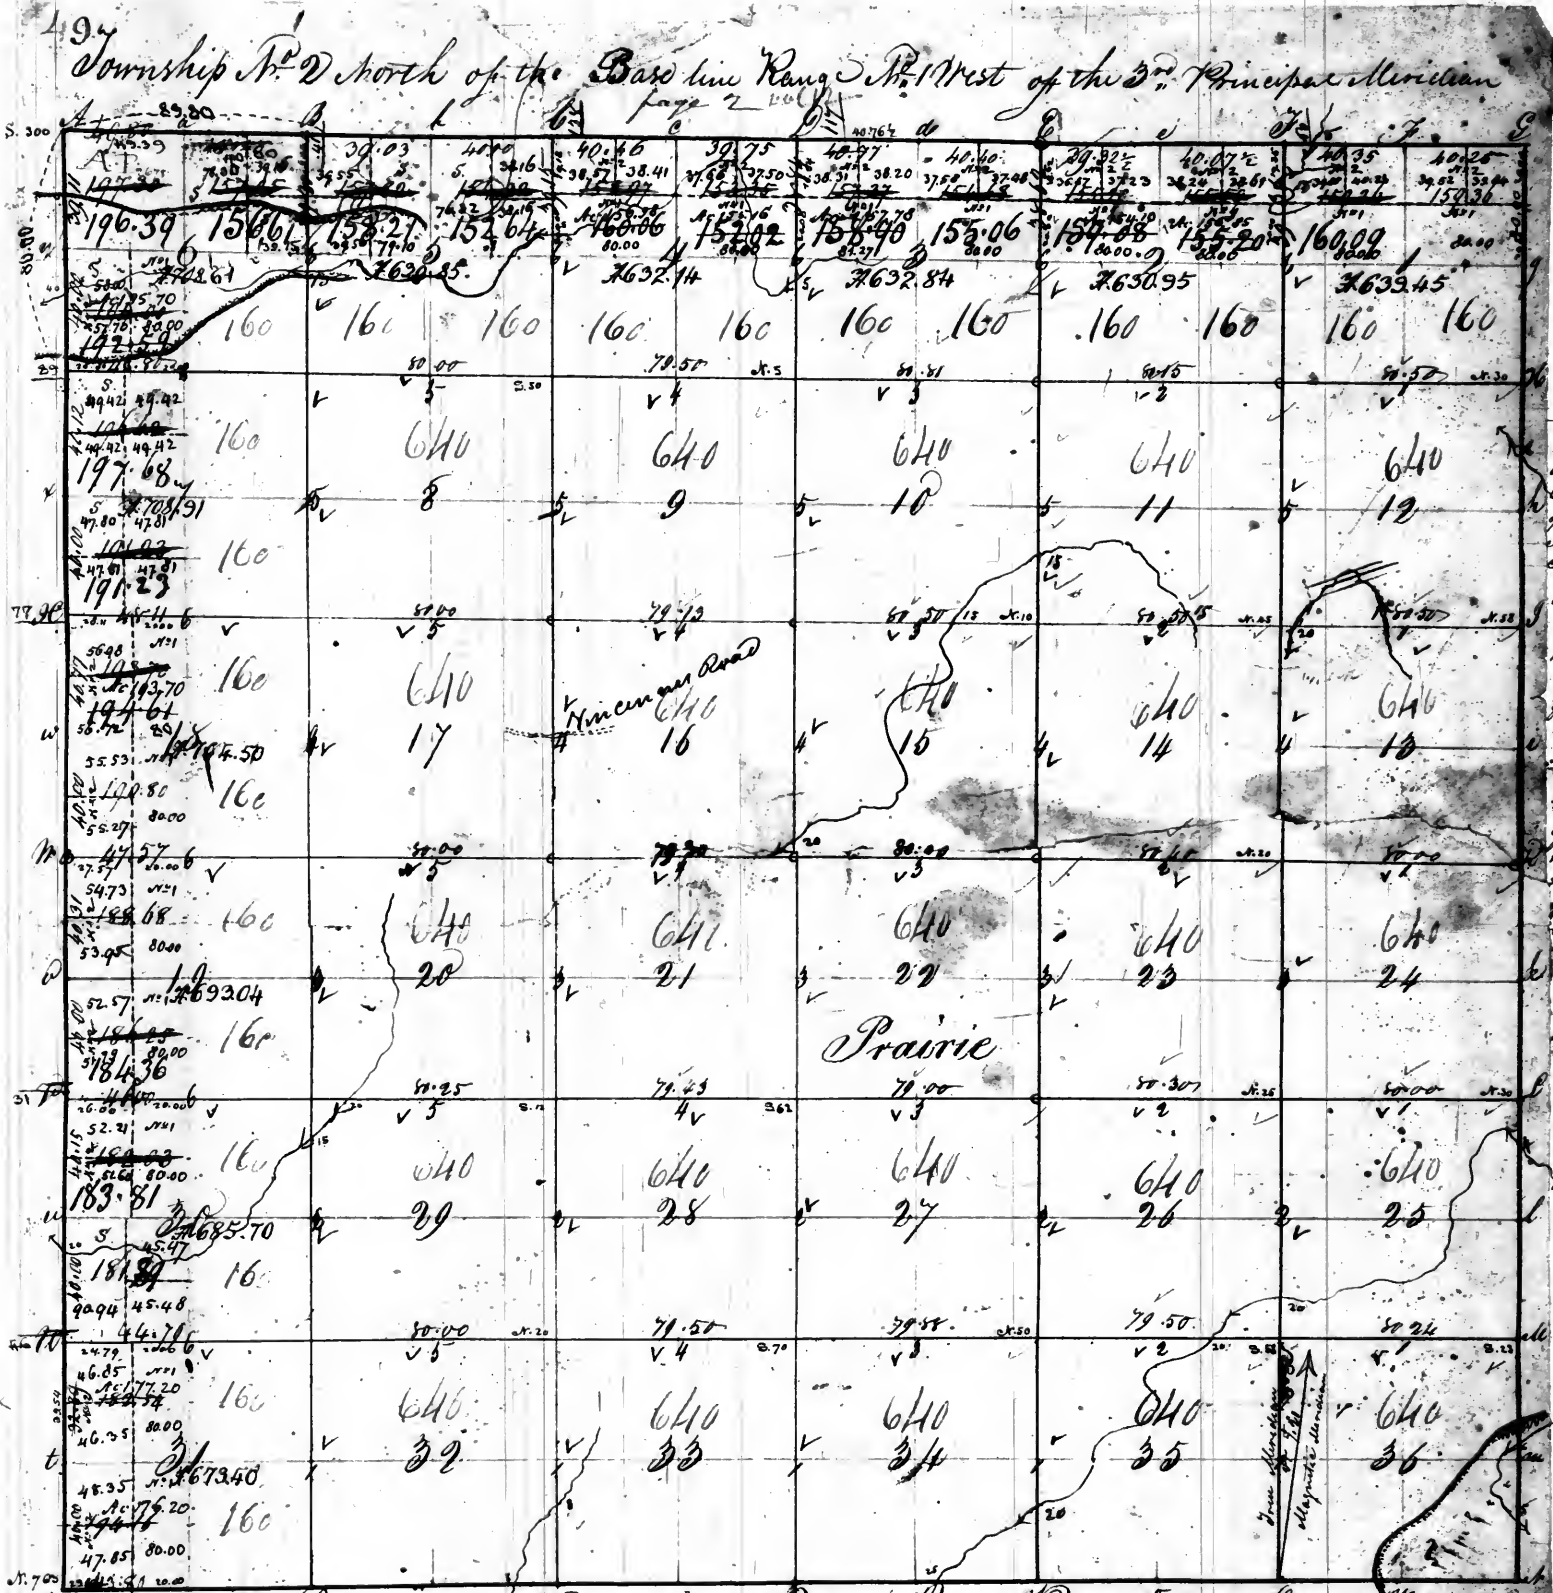

Pursuant to a contract with and Instructions from Josiah Meigs Esq. Surveyor General of the United States bearing date the 6th day of June A.D. 1814, I have as directed laid out and surveyed the above described boundary and do hereby certify it has such marks and bounds, both natural and artificial, as are represented on said plat, also described in the Field Notes made thereof & returned with the plat into the Surveyor General's Office.


Certified this 20th day of April A.D. 1815

Surveyors Office
St. Louis

The lines of the above plat of Town. 2 N. of the Base line in Range 1 West of the 3^d Principal Meridian have been examined by the notes of the Survey thereof referred to in the margin and corrected conformably therewith.

Record

148 Township No. 3 North Range No. 1 West of the 3rd Principal Meridian

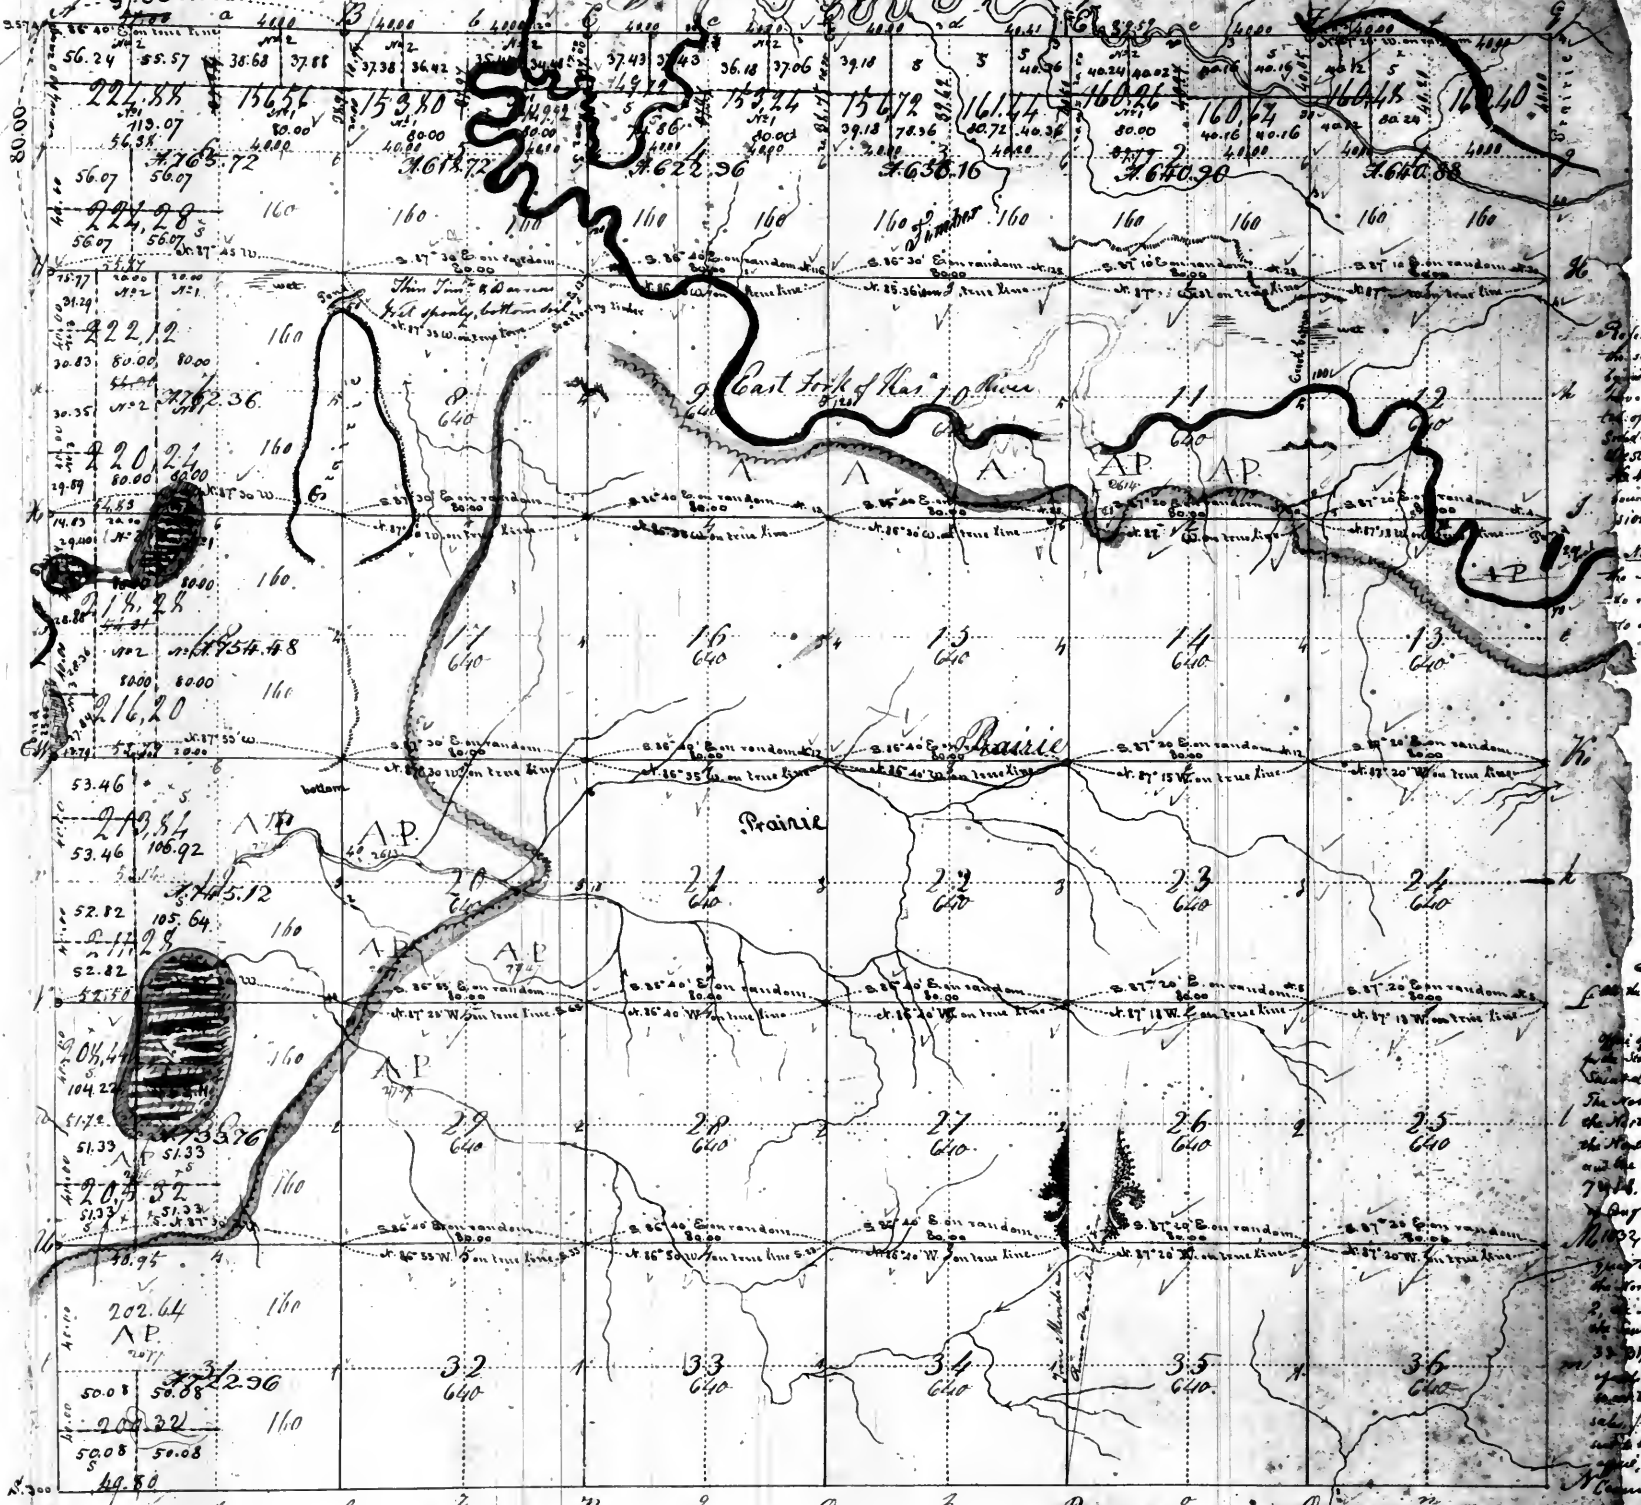



Aggregate area = 23646.02 acres


Pursuant to a Contract with and Instructions from Josiah Meigs Surveyor General of the United States bearing date the 20th September 1816 - I have examined and surveyed the above described Township and do hereby certify that it has such Marks and bounds both natural and artificial as are represented on said Plat and described in the field notes hereunto returned with the Plat in to the Office of the Surveyor General this 20th day of June 1816

J. Meigs Surveyor General


Surveyors Office
St Louis 9th of December 1841


Plan showing the legal subdivisions of the areas of the N.W. and S.W. quarters of each of the sections 6, 7, 18 & 19 of Township 4 North of the base line, Range 1 West of the 3rd principal Meridian.

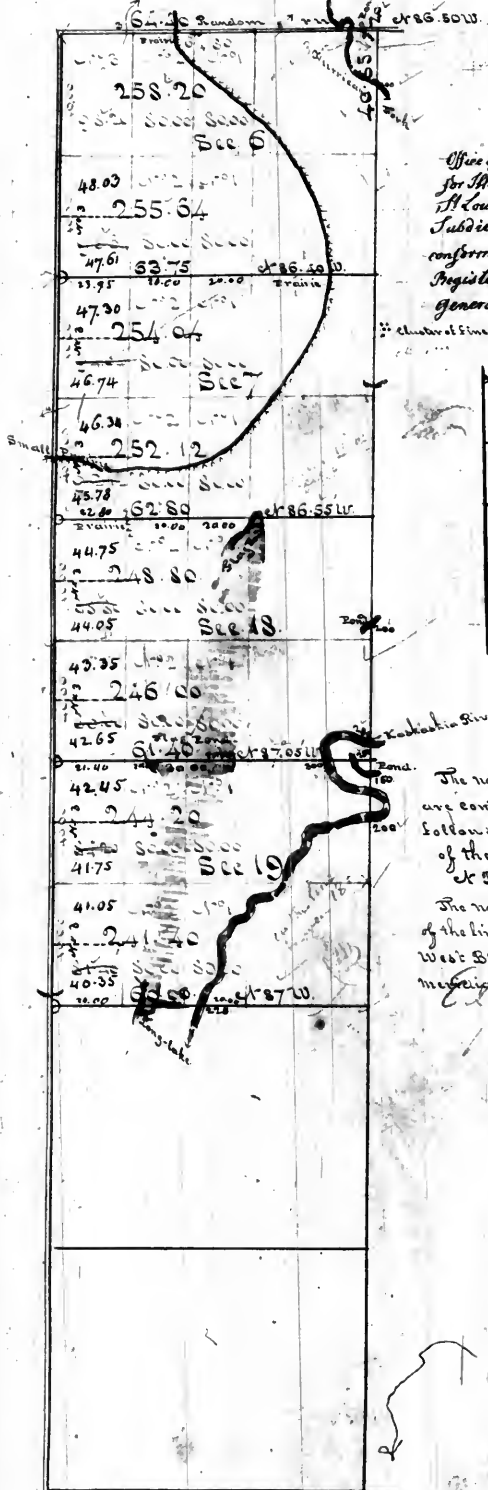

Office of the Surveyor General
for Missouri
St. Louis 27th January 1857
Subdivided this day the N. Map of Sec. 7, so as to
conform to previous sales, and sent a copy to the
Register and another copy to the Comptroller of the
General Land Office.

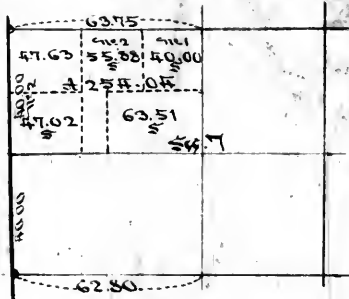


The notes used in the construction of this plan
are contained in the field books numbered as
follows viz
of the W. B. in book 42
of the S. B. in book 47

The notes do not state at what variation any
of the lines were surveyed, nor do those of the
West B. refer the surveys to any principal
meridian.

Wm. H. Rice
11th Feb 1857

Surveyor General
St. Louis July 20th 1857
Exam'd - *Wm. H. Rice*
St. of Pub. Ls.

Recorded

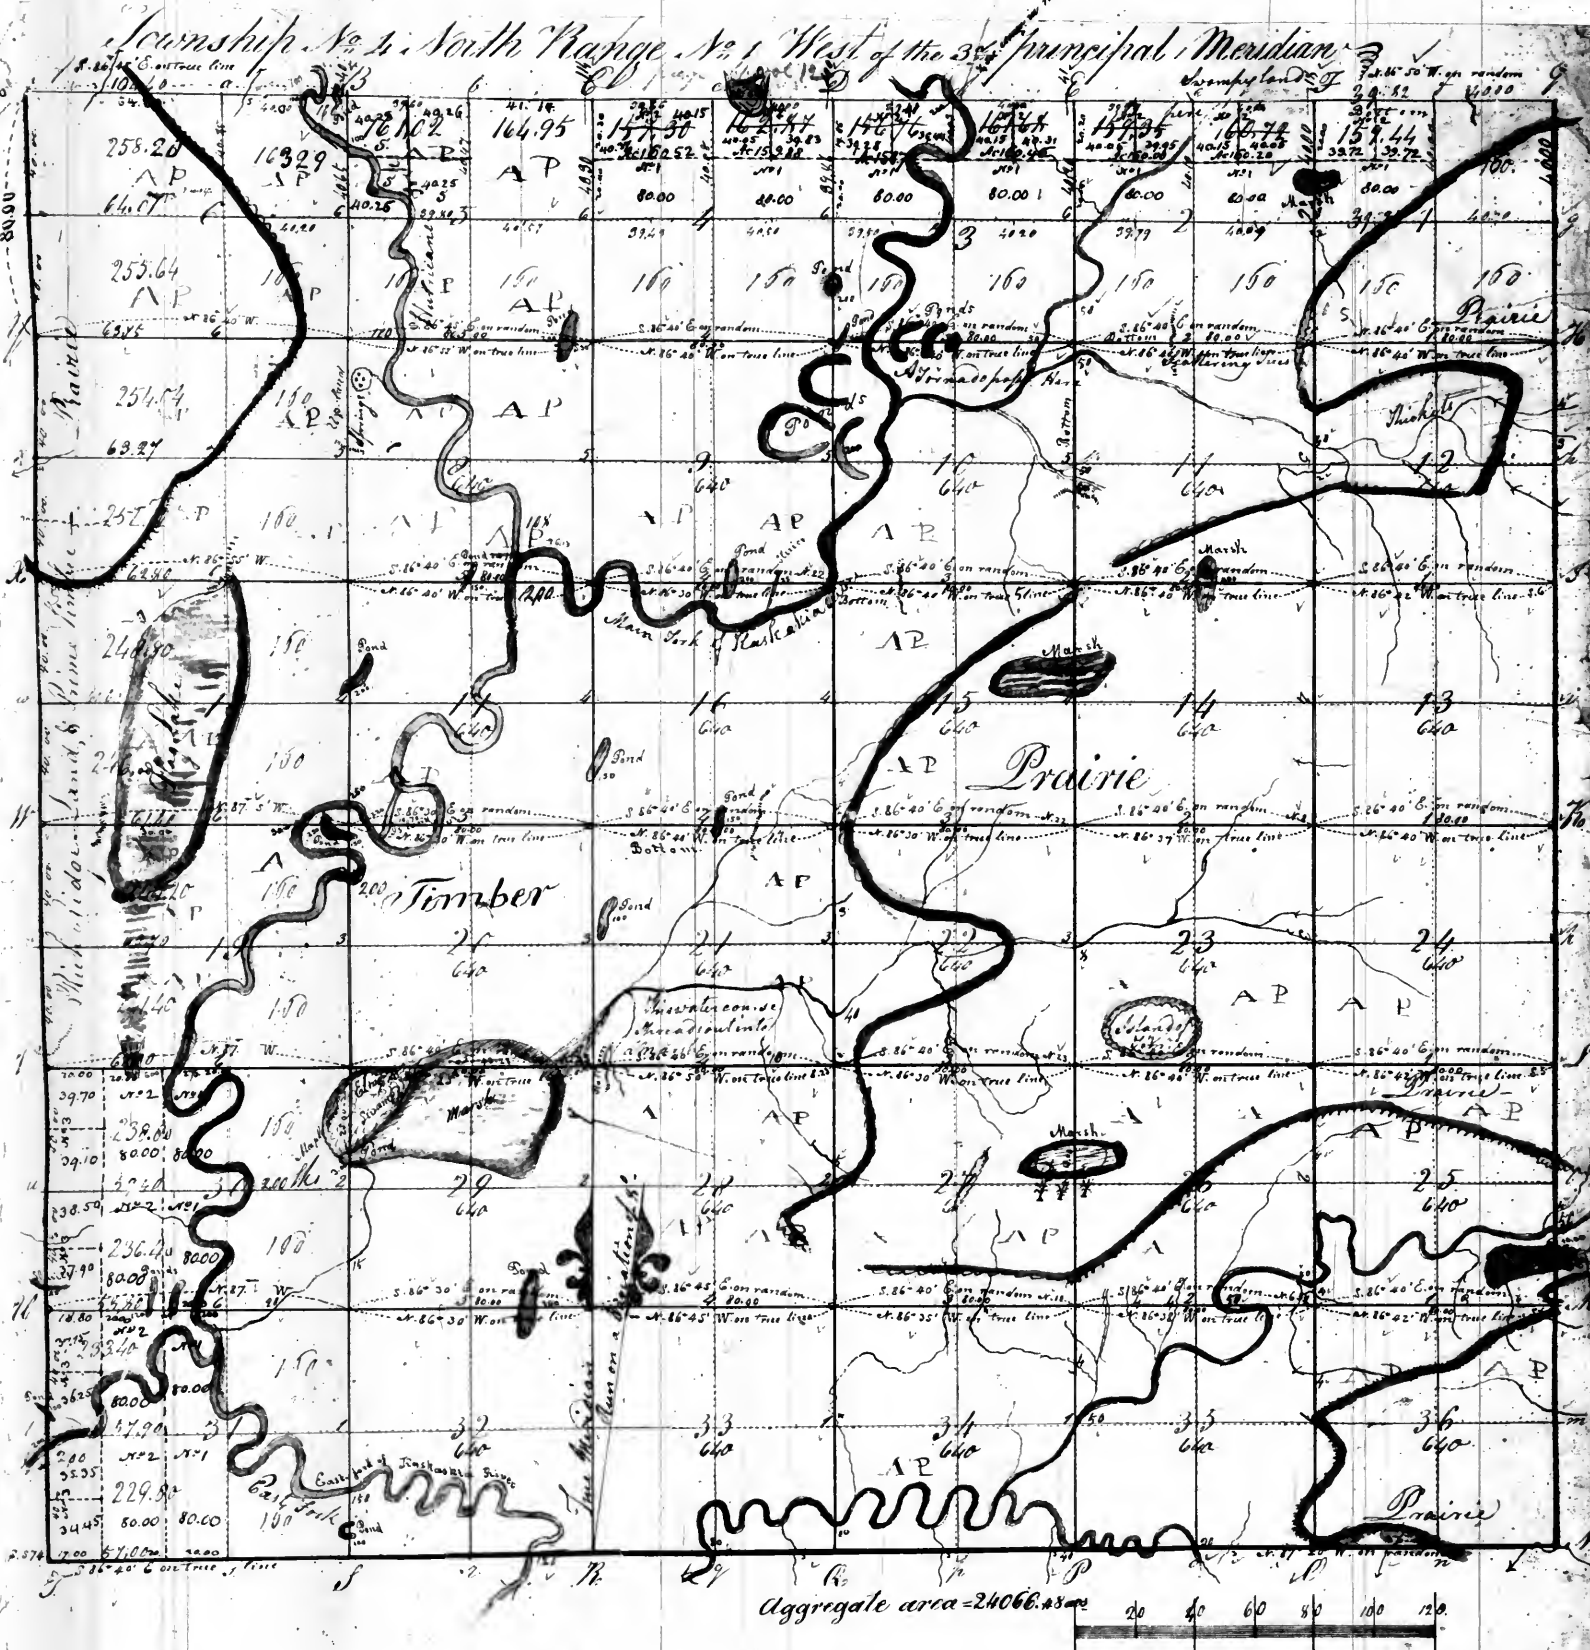

Reference to the fieldnotes of the survey of this Township by which the lines of this plat have been examined and corrected: of the South boundary in Subd. lot at 41 - of the West boundary in Subd. lot at 42 - of the North & East boundaries and of the Subdiv. line in Subd. lot at 47.

Navigation
West boundary 8° 45' East.
All the other lines 8° East.

Office of the Surveyor General for the State of Illinois, and District of Saint Louis, July 19th 1858.
The North West quarter of section 1, the North halves of sections 2, 3 & 4, the South East quarter of section 5, and the East halves of sections 6, 7, 8, 9, 10, 11, 12, 13, 14, 15, 16, 17, 18, 19, 20 & 21, subdivided under the act of Congress of the 5th of April 1820, also the North East quarter of section 6, subdivided so as to conform to previous subdivisions, and a plat sent to the Register and an other to the Commissioner of the General Land Office.
Done at St. Louis, Mo.
J. M. Spinger, Deputy Surveyor.

Pursuant to a Contract with and Instructions from Josiah Meigs Surveyor General of the United States bearing date the 20th of September 1814 I have admeasured laid out and surveyed the above described Township and do hereby certify that it had such Markers and boundaries both natural & Artificial as are represented in the Plat and described in the field notes taken there of and admitted with the Plat into the ~~Surveyors Office~~ Office of the Surveyor of the Lands of the United States in the Territories of the Missouri and Illinois.


J. M. Spinger, Deputy Surveyor

Surveyors Office
St. Louis 9th of December 1841

The lines of the above plat of Township No. 1 North of the base line in Range 1 West of the 3rd Principal Meridian are strictly conformable to the field notes of the survey thereof on file in this office, which have been examined and approved. The west boundary 6 miles, was surveyed in February 1816 - the South boundary 6 miles and 1/2 chains, and the east boundary 6 miles, were surveyed in March 1816 - the north boundary 6 miles 24.40 chains, and the subdivision lines were surveyed in April 1816, by John Meringer, under contract of the 20th of September 1814.

Jos. C. Brown
Surveyor of the public land for the State of Illinois

Plat showing the legal subdivision of the areas of the N.W. and S.W. quarters of each of the sections 6, 7, 18, 19, 30 & 31 of Township 5 North of the base line, Range 1 West of the 3rd principal meridian.

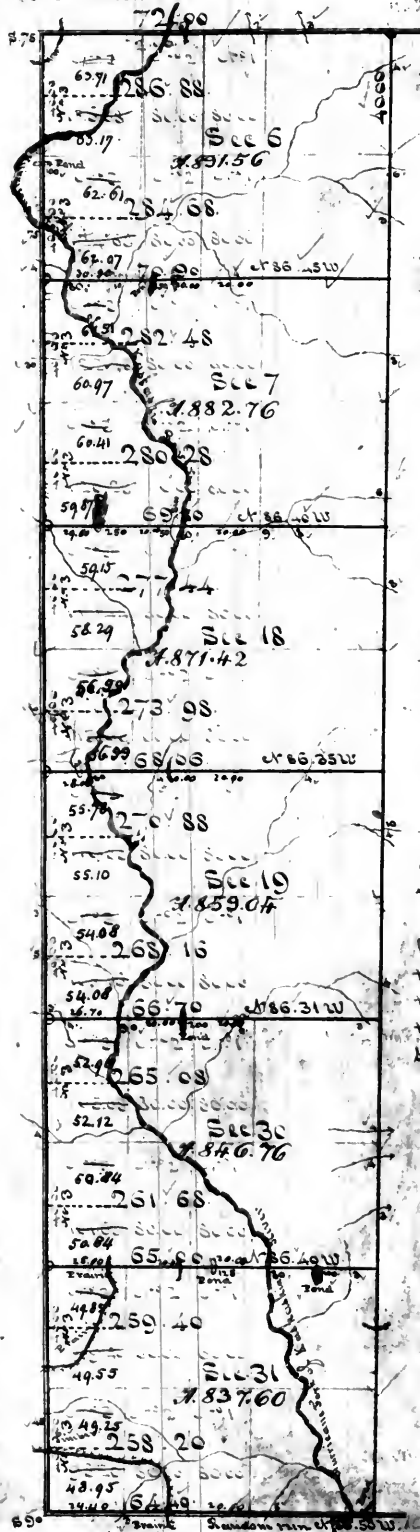

30th July 1831.

A duplicate of this plat was this day sent to the Register of the Land Office, at Edwardsville.

The notes used in the construction of this plat are contained in the field books numbered as follows

of the S. B. & in book No 47

W. B. & in book No 41.

N. B. & Sub division in book No 46

The field notes do not state at what variation the lines were surveyed, nor do those of the West B. & refer the survey to any principal meridian.

According to the field notes, the Random line on the S. B. & of section 31 intersected the Range line at 104.40 chains - the quarter section corner was established on the true line at 64.40 chains, and the corner to sections 31 & 32 at 104.00 chains.

W. M. Rice

Sur. of Pub. Lds

Surveyor's Office
St. Louis 18th July 1831

sent to the Commissioner of

the Genl. Land Office enclosing the plat of sections 6, 7, 18, 19, 30 & 31

Silas Reed

Surveyor of the public lands -
St. Louis of Illinois & Missouri


Exam'd
11th July 1831
W. M. Rice

Surveyor's Office
St. Louis 30th July 1831



W. M. Rice

1341K150, —

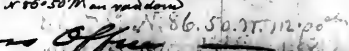


Wm. Bee

Examined
11/16/88

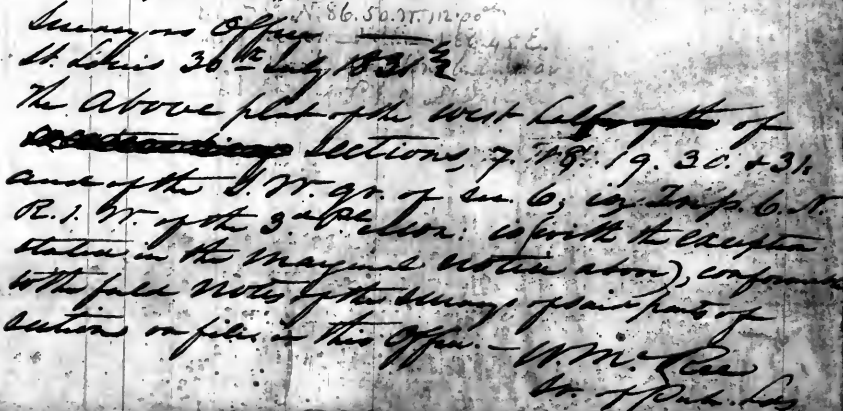

Recorded 784

Township No 6 North of the Base line, Range No 1 West of the 3rd Principal Meridian
page 6 of 12

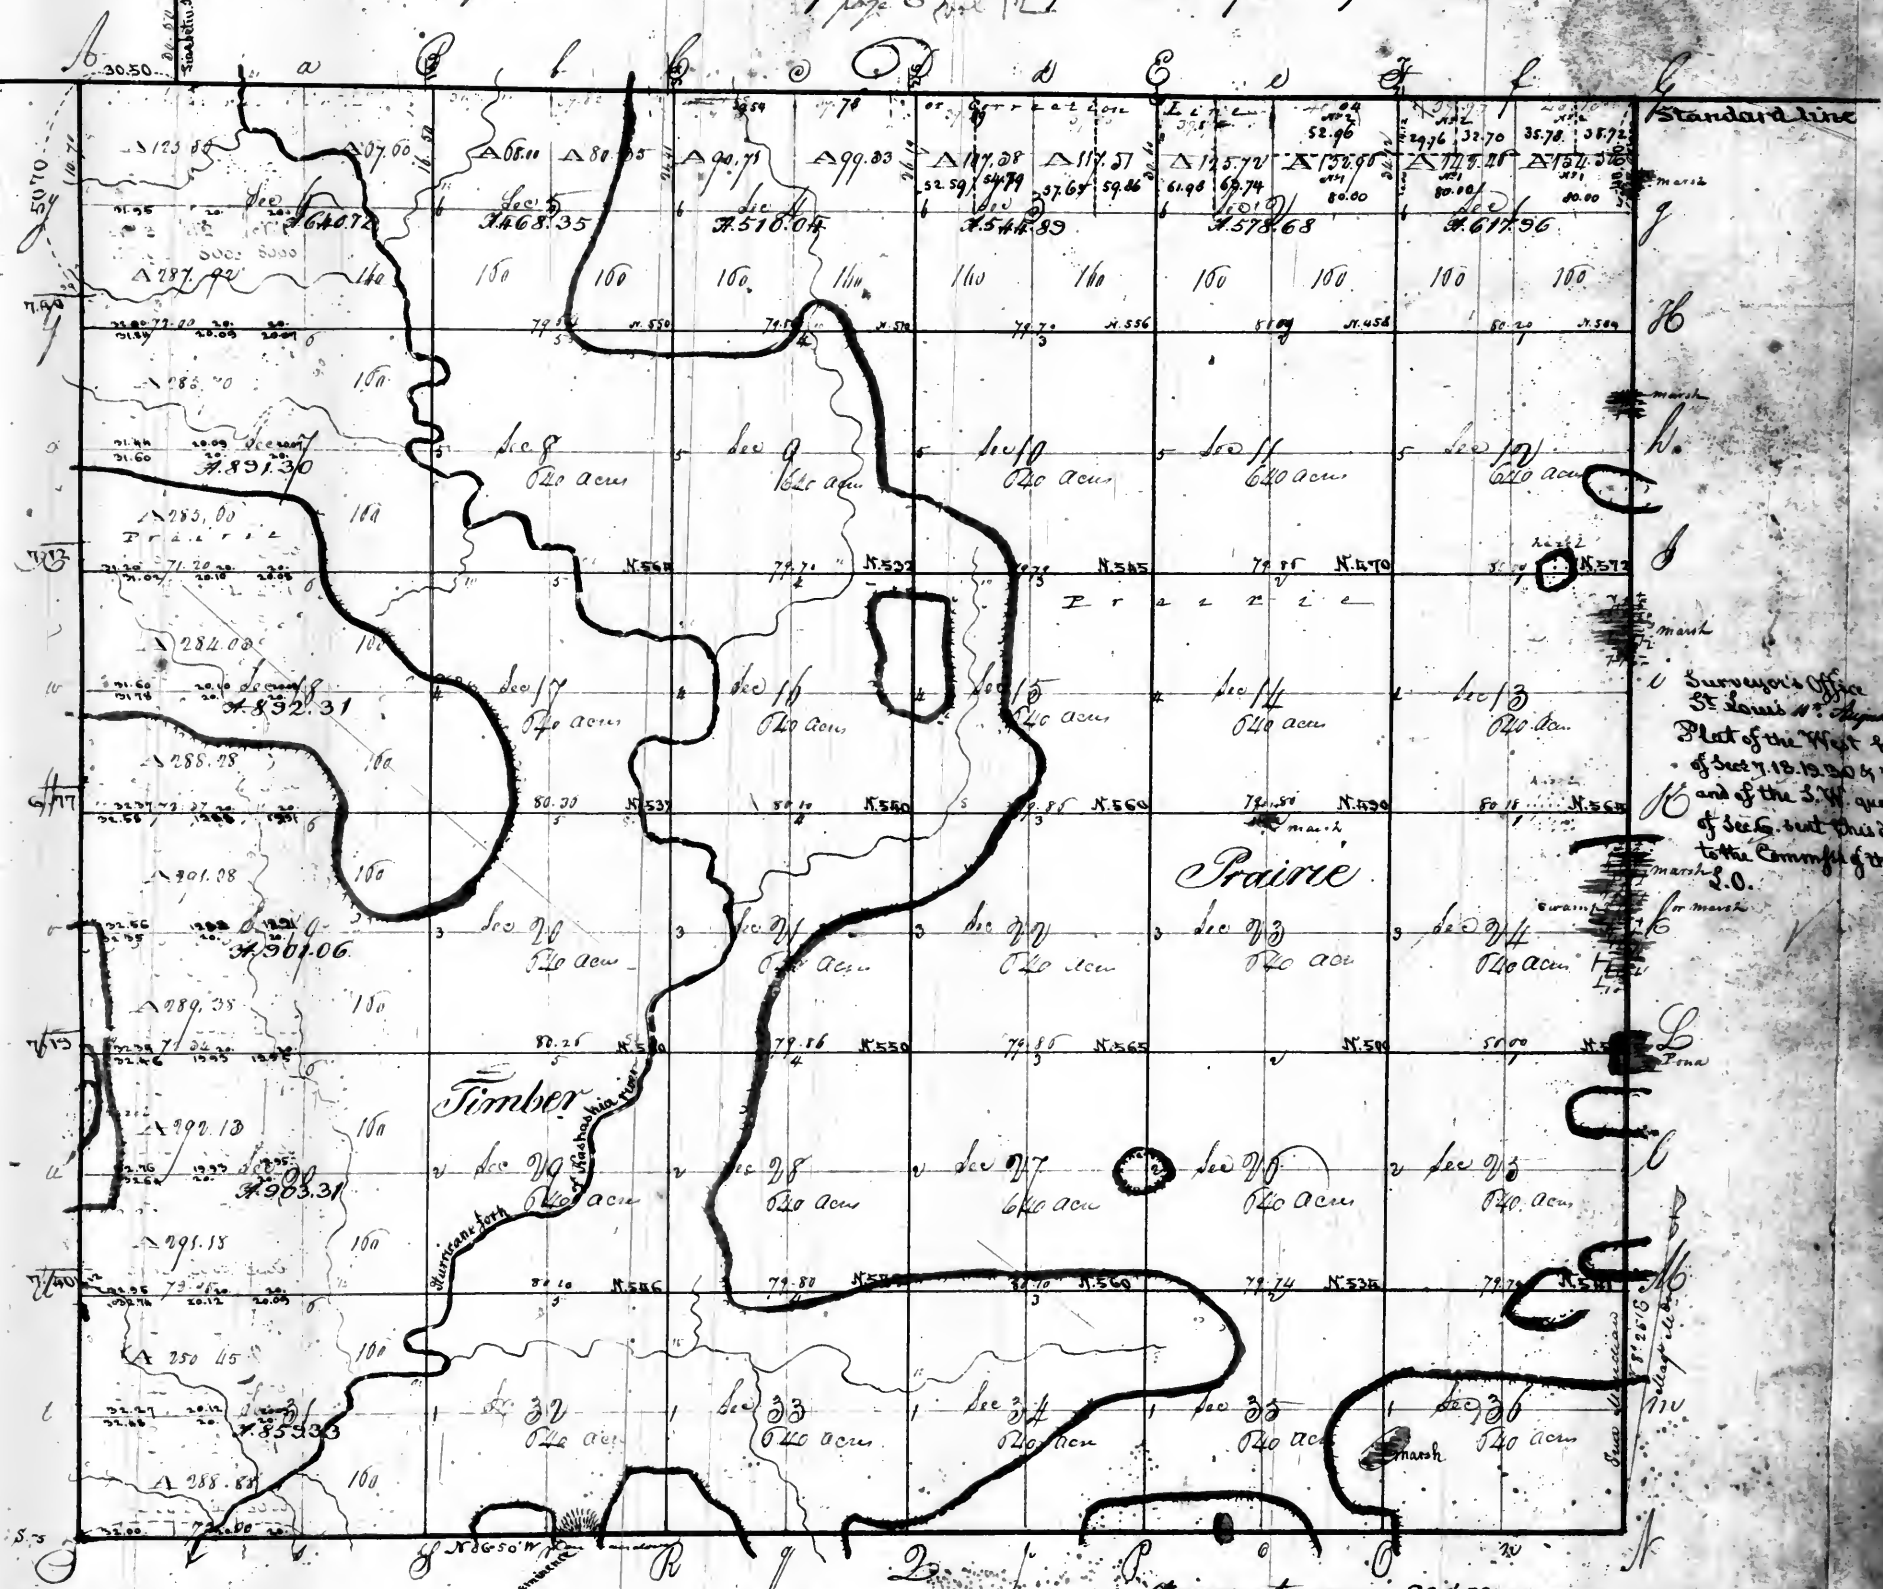


Surveyor's Office
St Louis Mo August 1842
Plat of the West half
and of the S.W. quarter
of Sec 6, east this day
to the Commf of the
S.O.

Office of the Surveyor General
for the States of Illinois and Missouri
Saint Louis July 19th 1850

act of Congress of the 5th of April 1832 and a plat sent
to the Register and another to the Commissions of the
General Land office same day

Aggregate area = 23807.55 acres
Surveyed by Joseph Barton & Charles Powell Dec 1818
291 18

Recorded

Township N. 7 North of the Base line, Range N. 1 West of the 3rd principal Meridian
page 7 vol 12

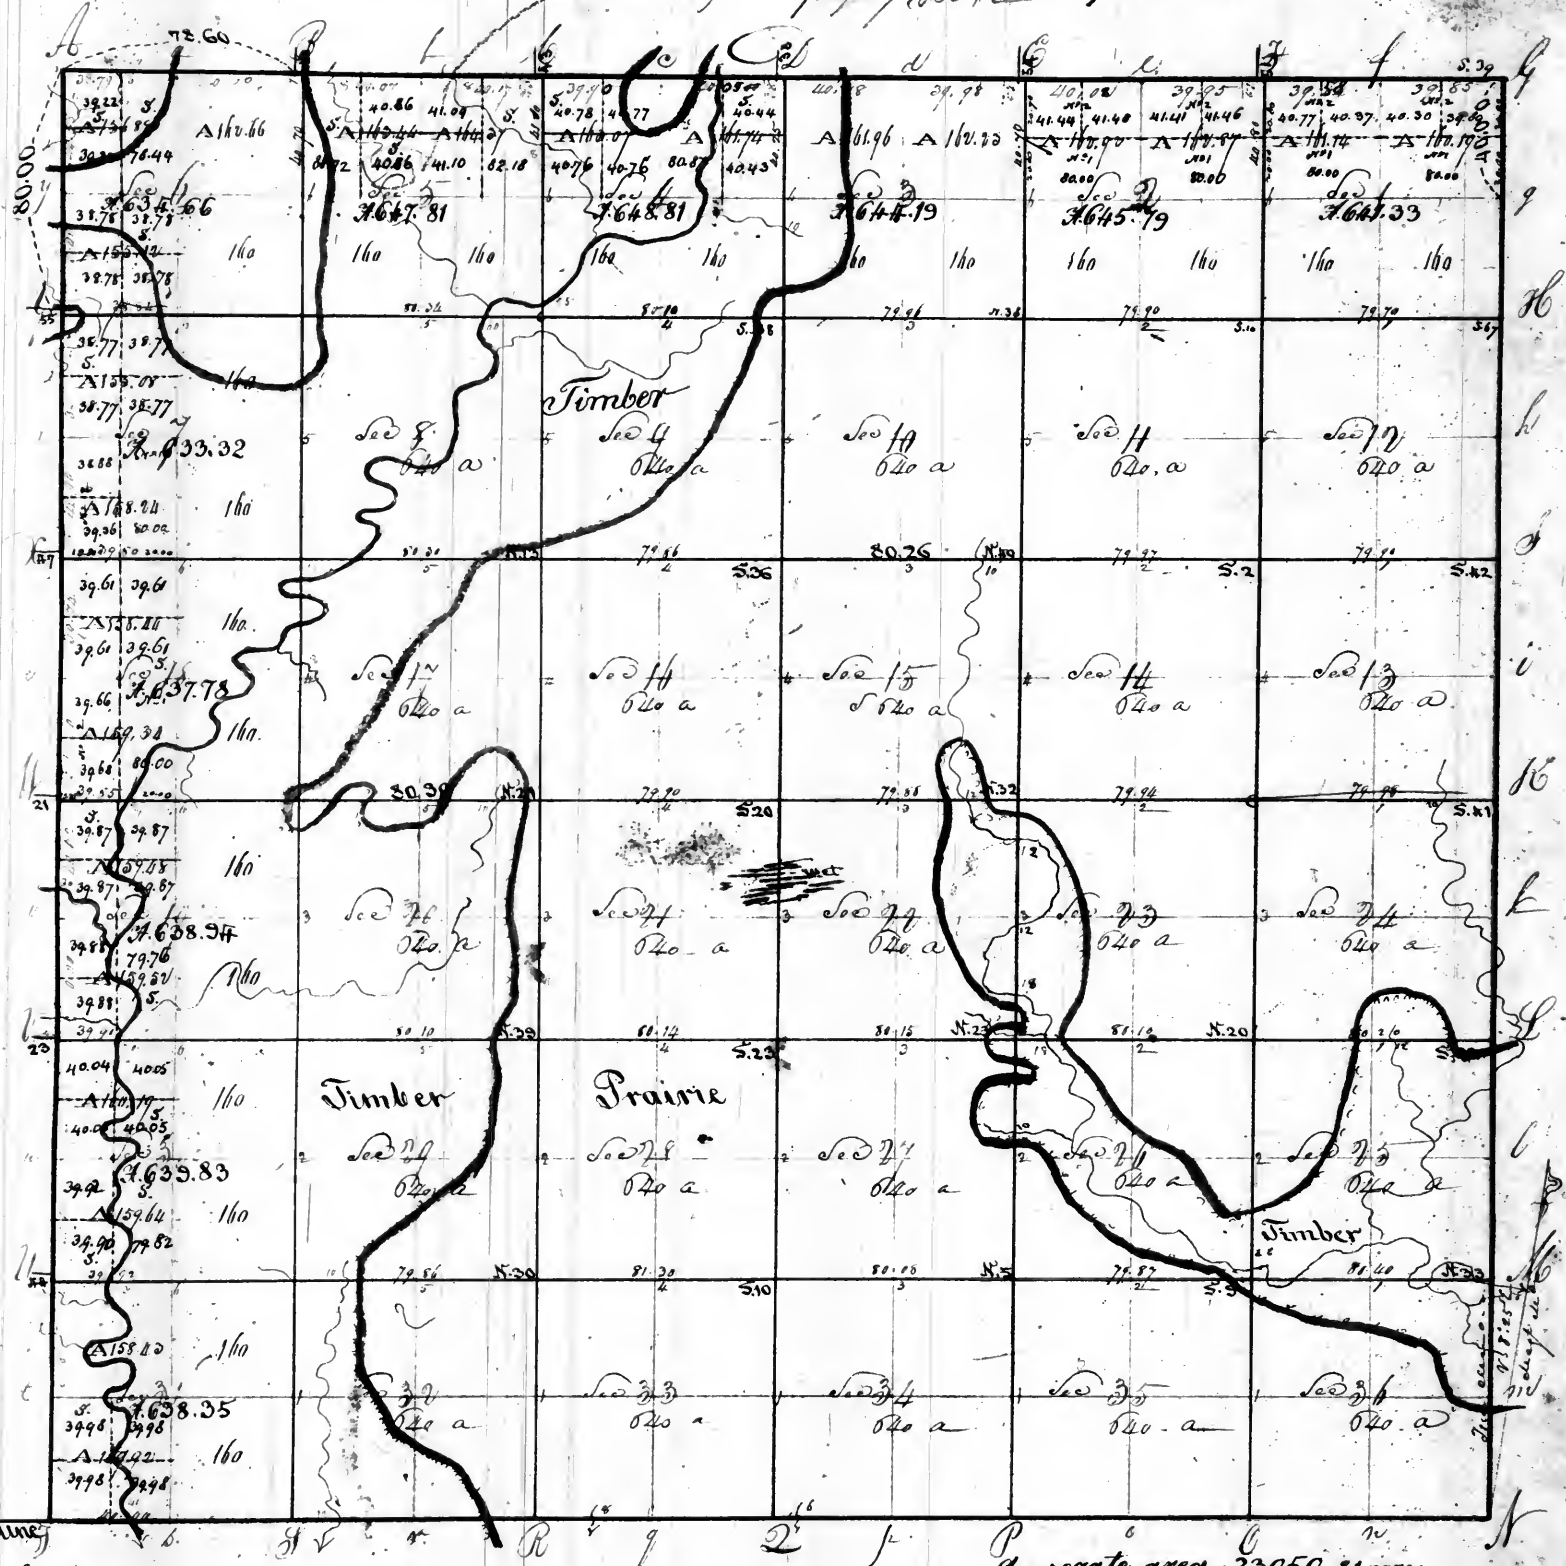


Office of the Surveyor General
for the State of Illinois and Missouri
Saint Louis July 19th 1850
The North halves of sections 1 & 2, and the South west quarter
of sections 7 & 18, subdivided under the act of Congress of the 5th of
April 1832 - also the North halves of sections 4 & 5, the West
halves of sections 6, 19 & 30, the North west quarter of sections
7 & 18, and the South west quarter of section 31, subdivided
as to conform to previous sales, marked &c, and a plat
sent to the Register, and another to the Commissioner of the
General Land Office. Same day
Note. The North half of sections 1, 2, 4, 5 & West half of Sec 6 sent to
Register and com^d July 1st 1850.

Aggregate area - 23050.31 acres
Surveyed by Joseph Barton & Charles Powell Esqs
June & July 1850

Sec 1-2-4-5
Sec 6 sent July 11

Recorded

Township No. 8 North of the Base line, Range No. 1 West of the 3^d Principal Meridian
page 8 and 12

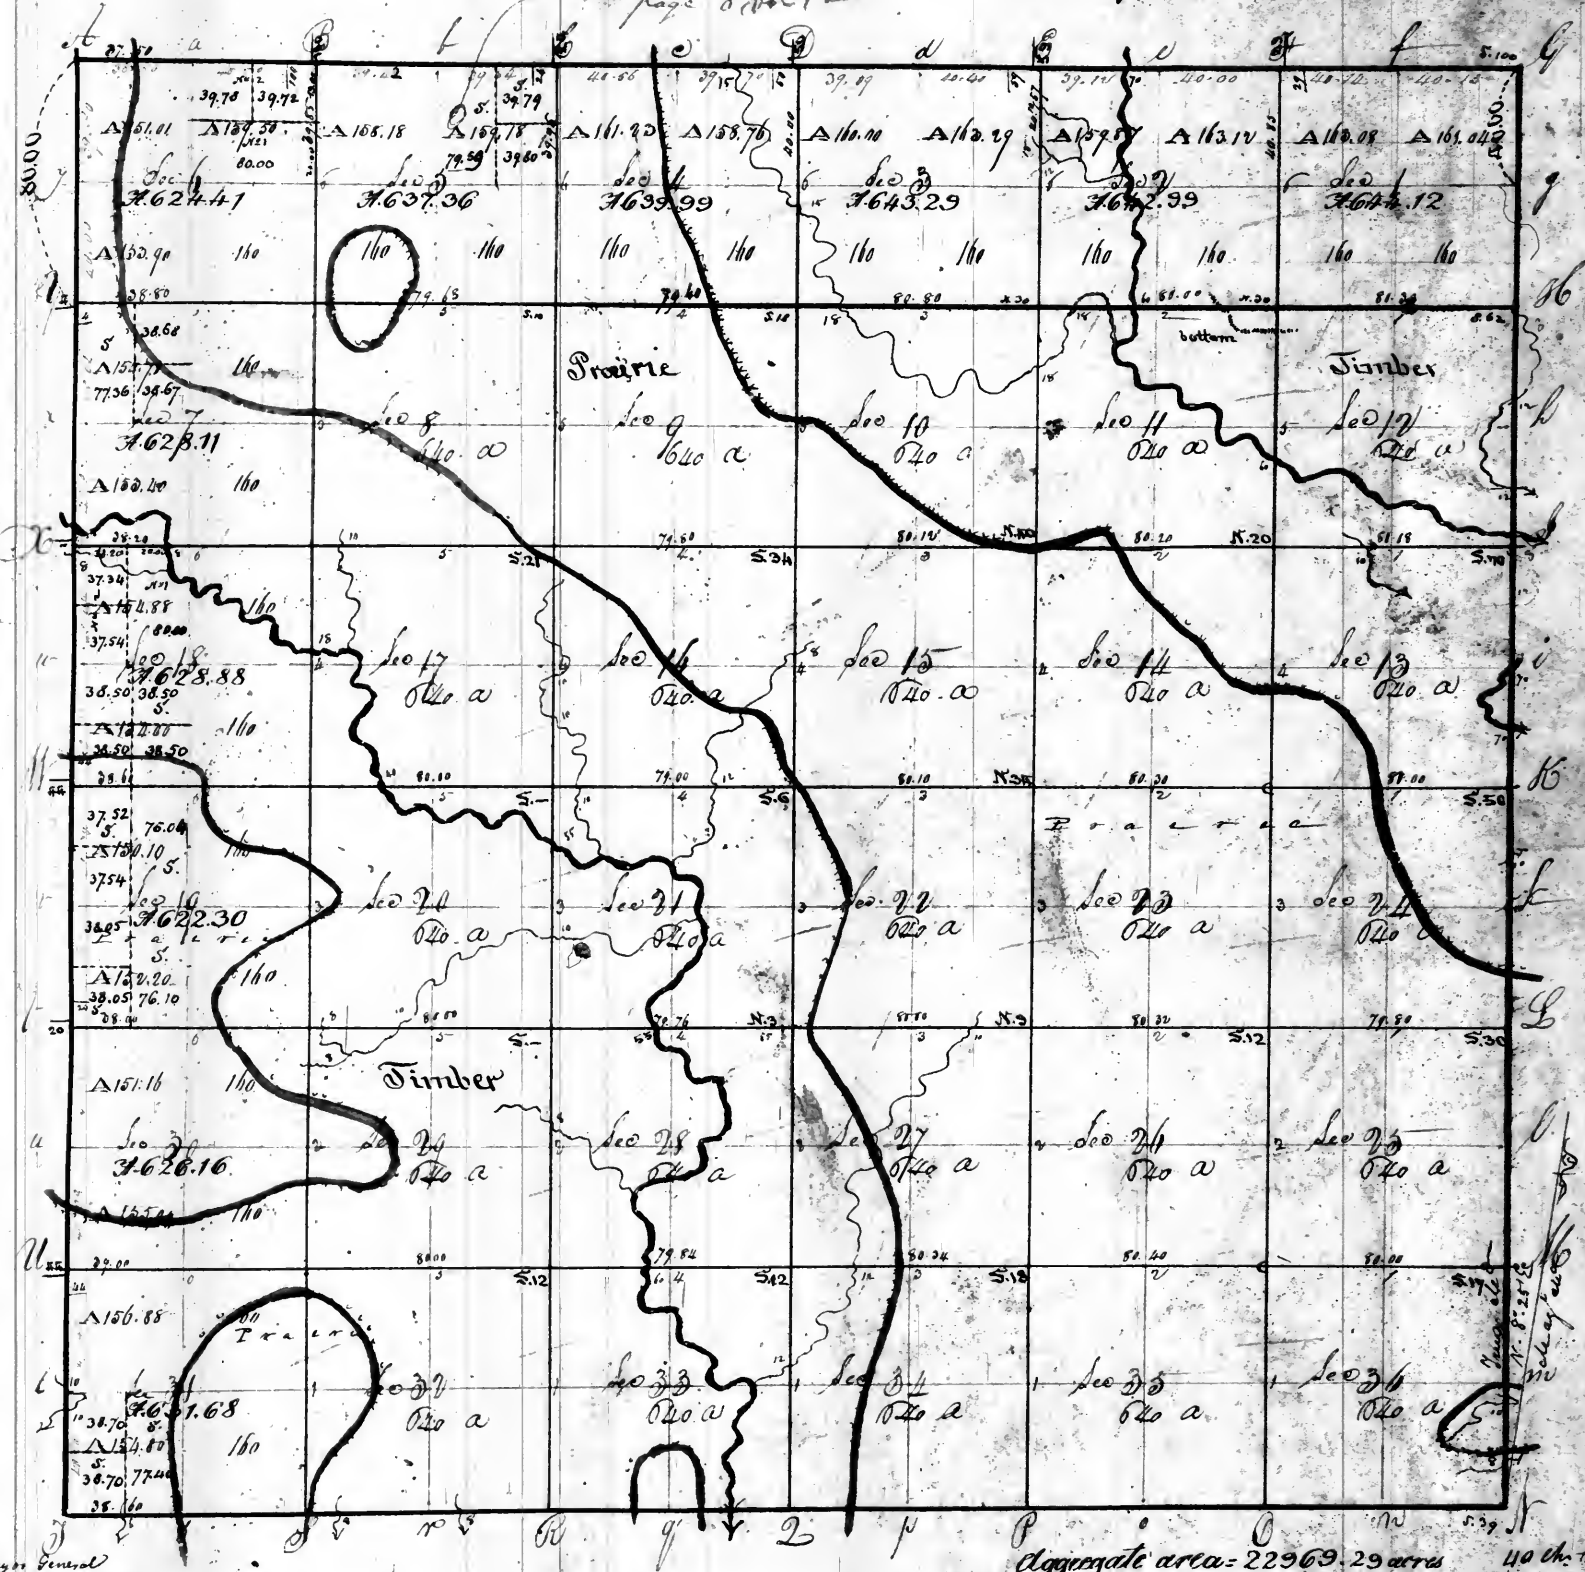


Office of the Surveyor General
for the State of Illinois and Wisconsin
Saint Louis July 11th 1850
The North east quarter of section 6, the North east
quarter of section 18, subdivided under the act of Congress
of the 5th of April 1832, also, the North east quarter
of section 5, the North east quarter of section 7, the South
east quarter of sections 18 & 31, and the west half of section
19, subdivided so as to conform to previous sales (marked),
and a plat sent to the Register, and another to the Com-
missioners of the General Land Office.

Aggregate area = 22969.29 acres 110 ch. to an Inch

Surveyed by Joseph Barton and Charles Powell D^r
June 1848

Recorded

Township N^o 9 North of the Base line, Range N^o 1 West of the 3rd principal Meridian
Page 9 vol 12

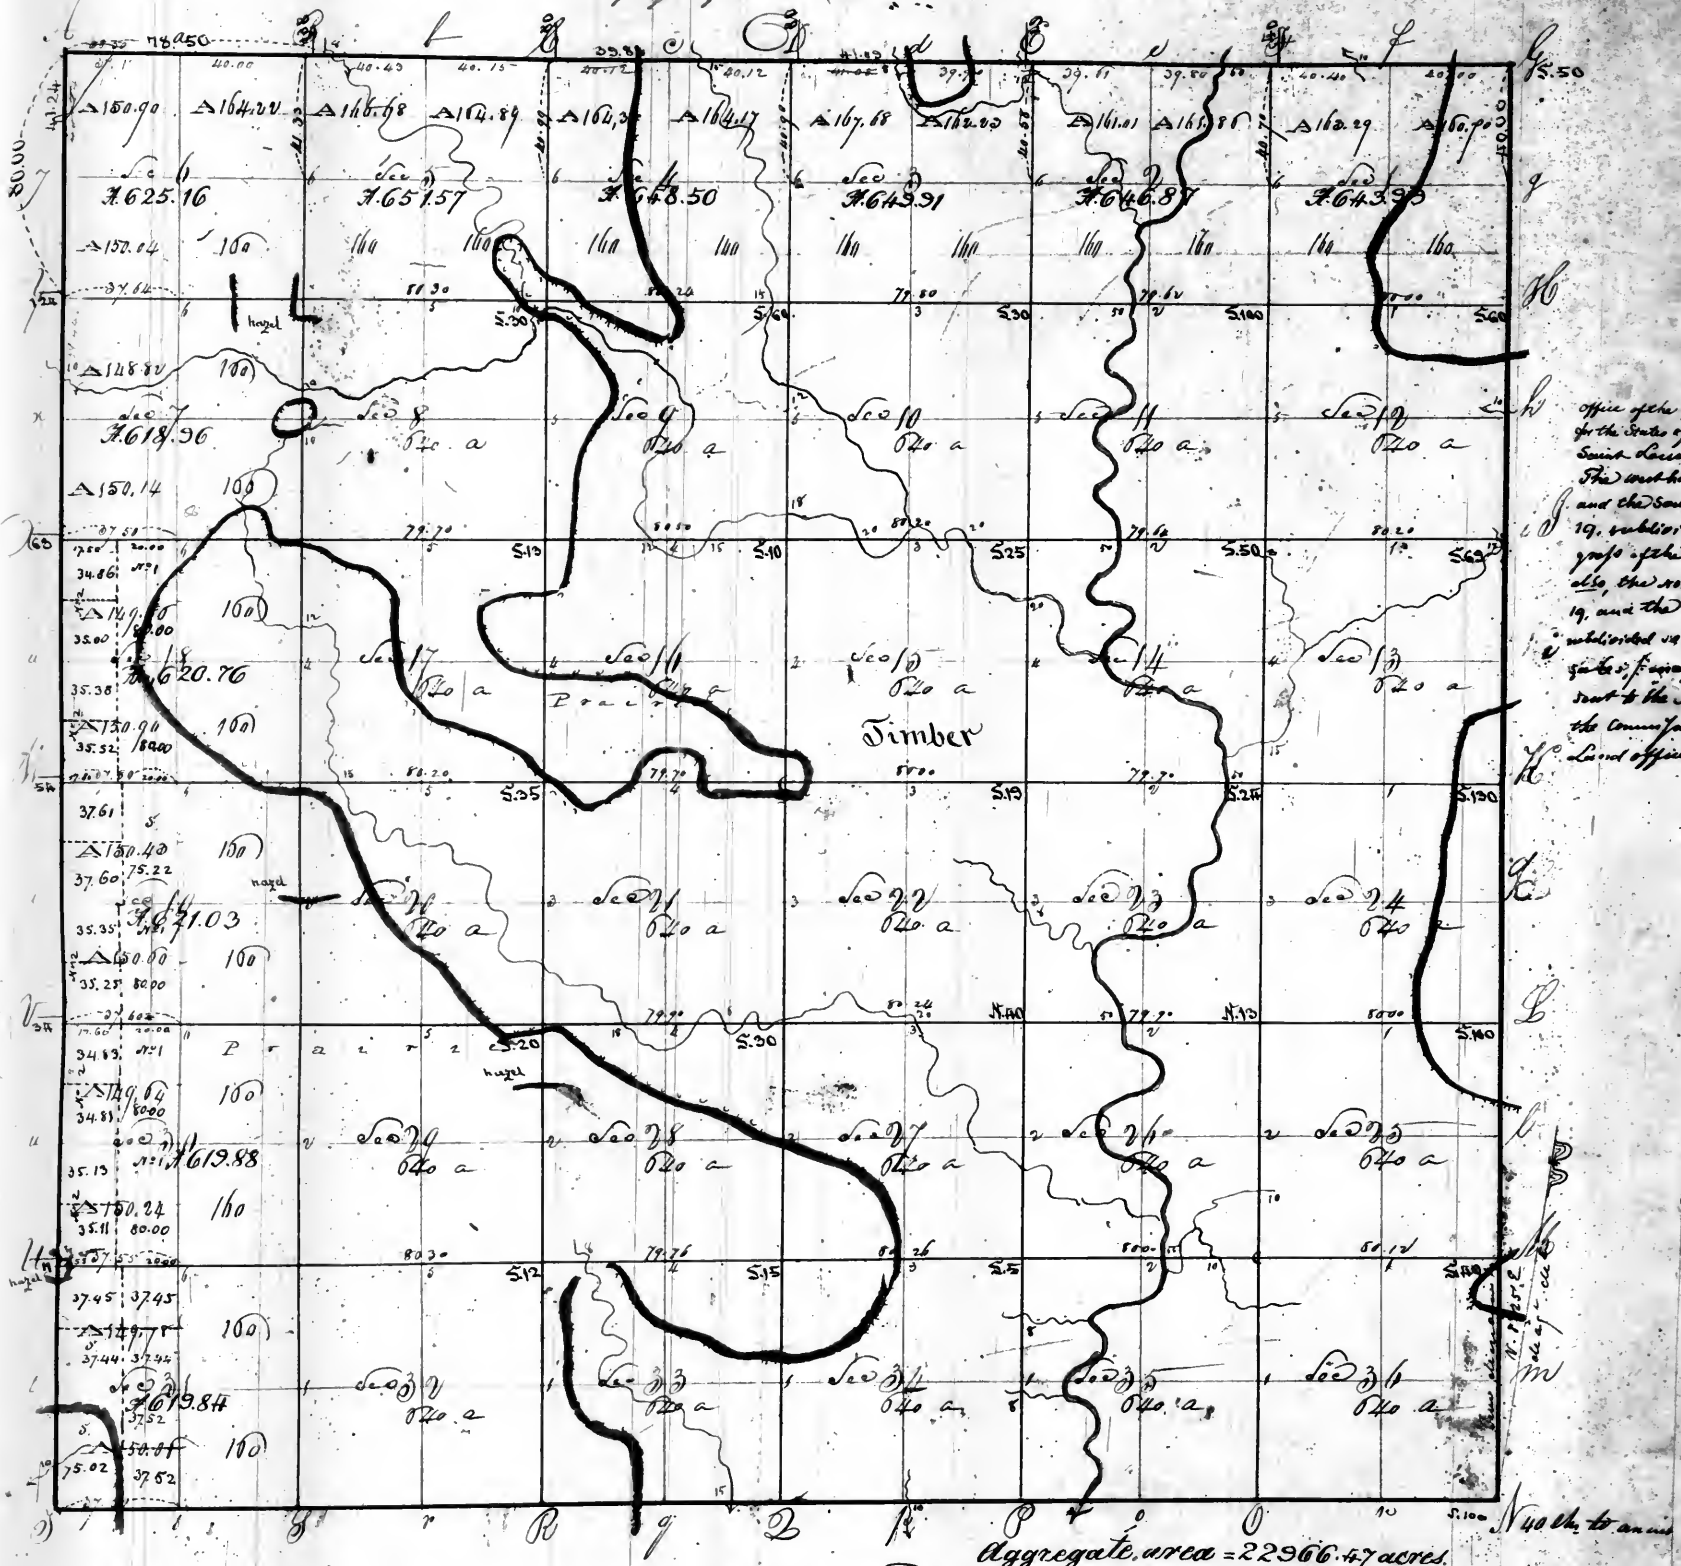

Office of the Surveyor General
for the State of Illinois and Missouri
Saint Louis July 19th 1850
The within, sections 18 & 20
and the south west quarter of section
19, subdivided under the act of Congress
of the 5th of April 1850, and
also the north west quarter of section
19, and the west half of section 31,
subdivided as set forth a. c. to provide
for the same, and a plat
sent to the Register, and another to
the Commissioner of the General
Land Office, St. Louis, Mo.


Aggregate area = 22966.47 acres

Surveyed by Joseph Barton & Charles Edwards
June 1850

Record

Township N. 10 North of the Base line, Range N. 1 West of the 3rd Principal Meridian

Page 10 of 12

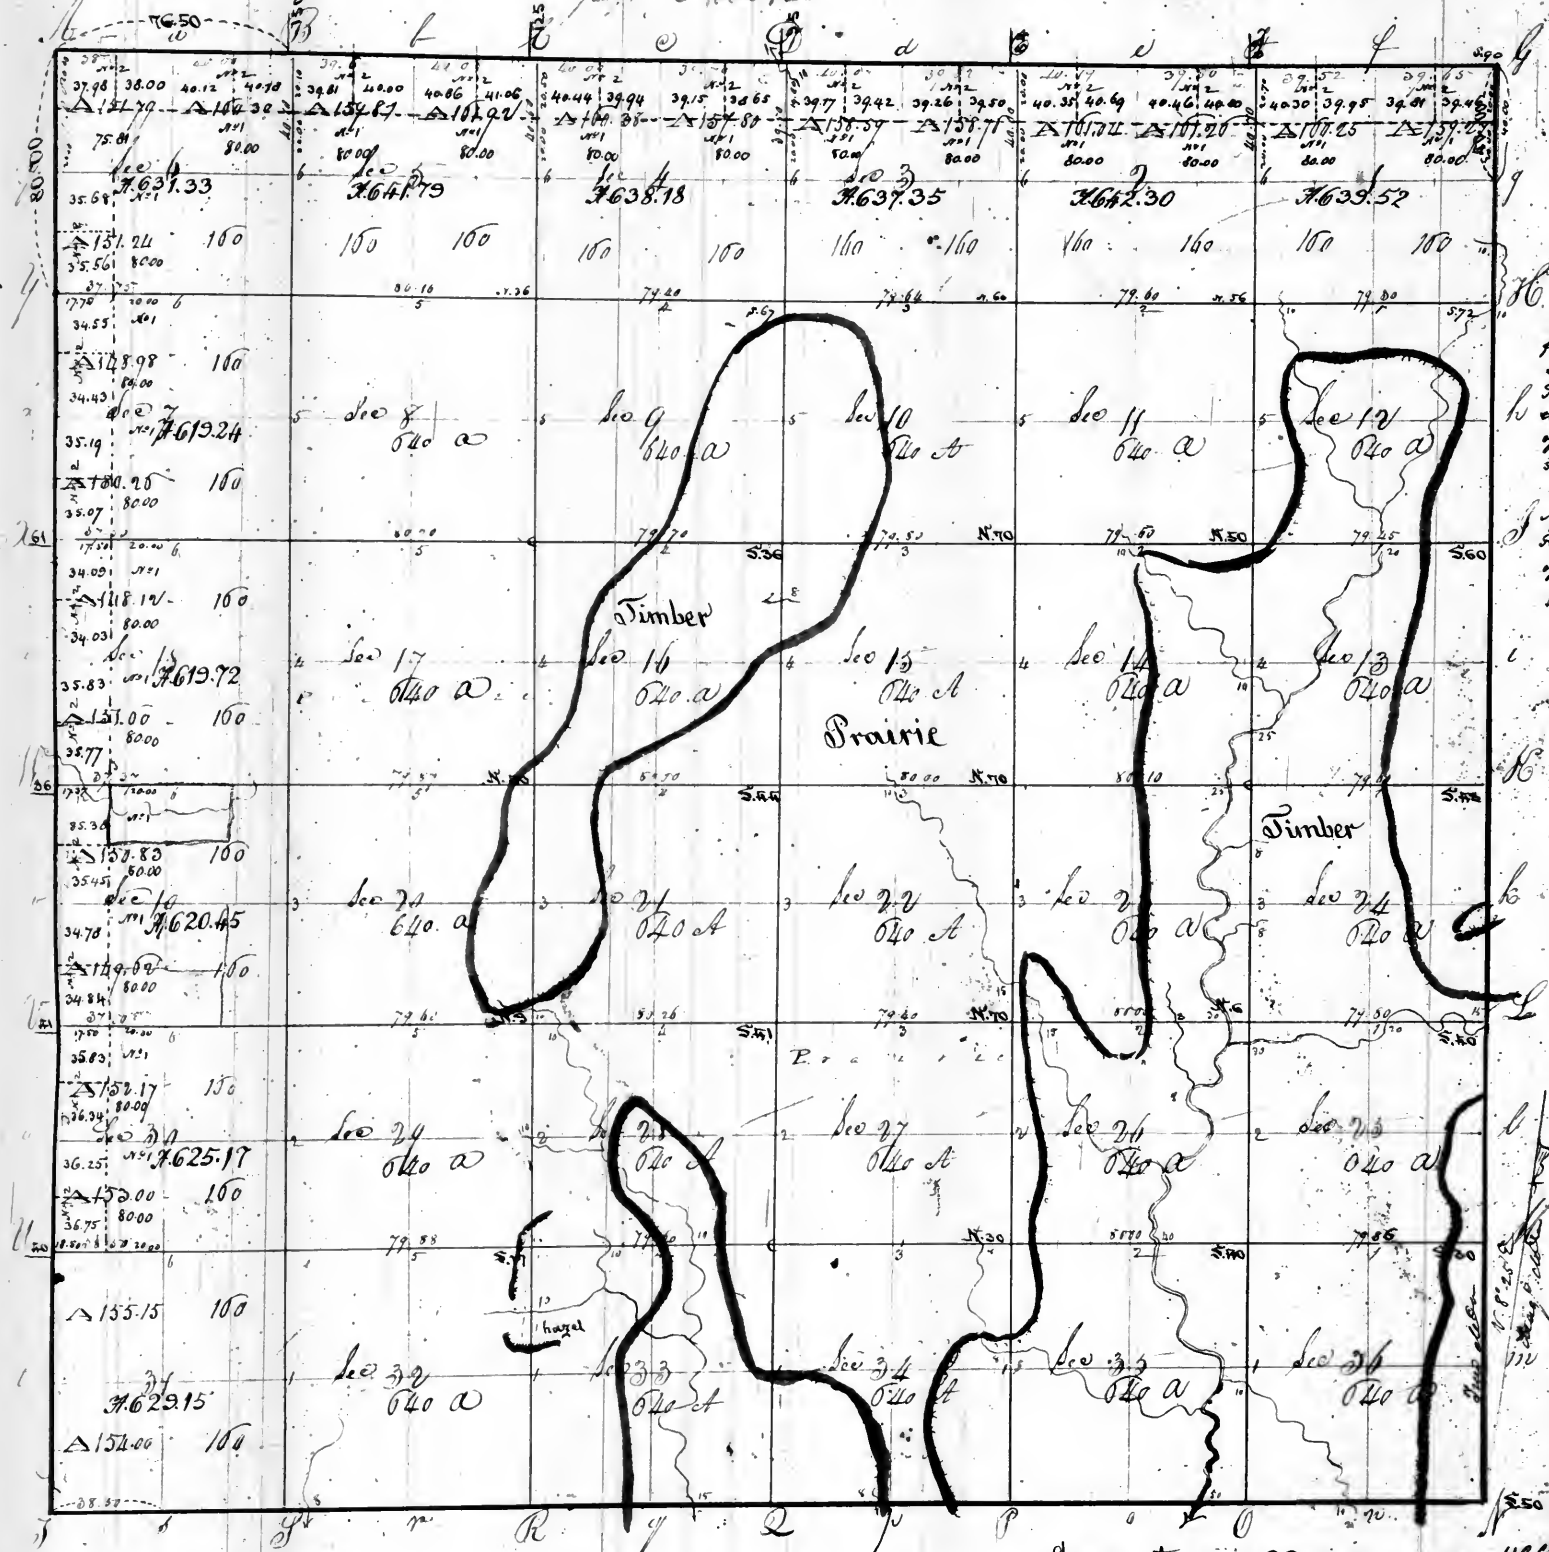

Office of the Surveyor General
for the State of Illinois and Arkansas
Saint Louis, July 19th 1850
and a plot sent to the Register, and another to the Com. of the General Land Office.


Aggregate area = 22944.20 acres 40 ch to an in

Surveyed by Joseph Burton & Charles Ponder D.
May & June 1818

11

Recorded 789

Township 8° 11' North of the Base Line Range No 1 West of the 3rd principal Meridian
page 11, vol 12

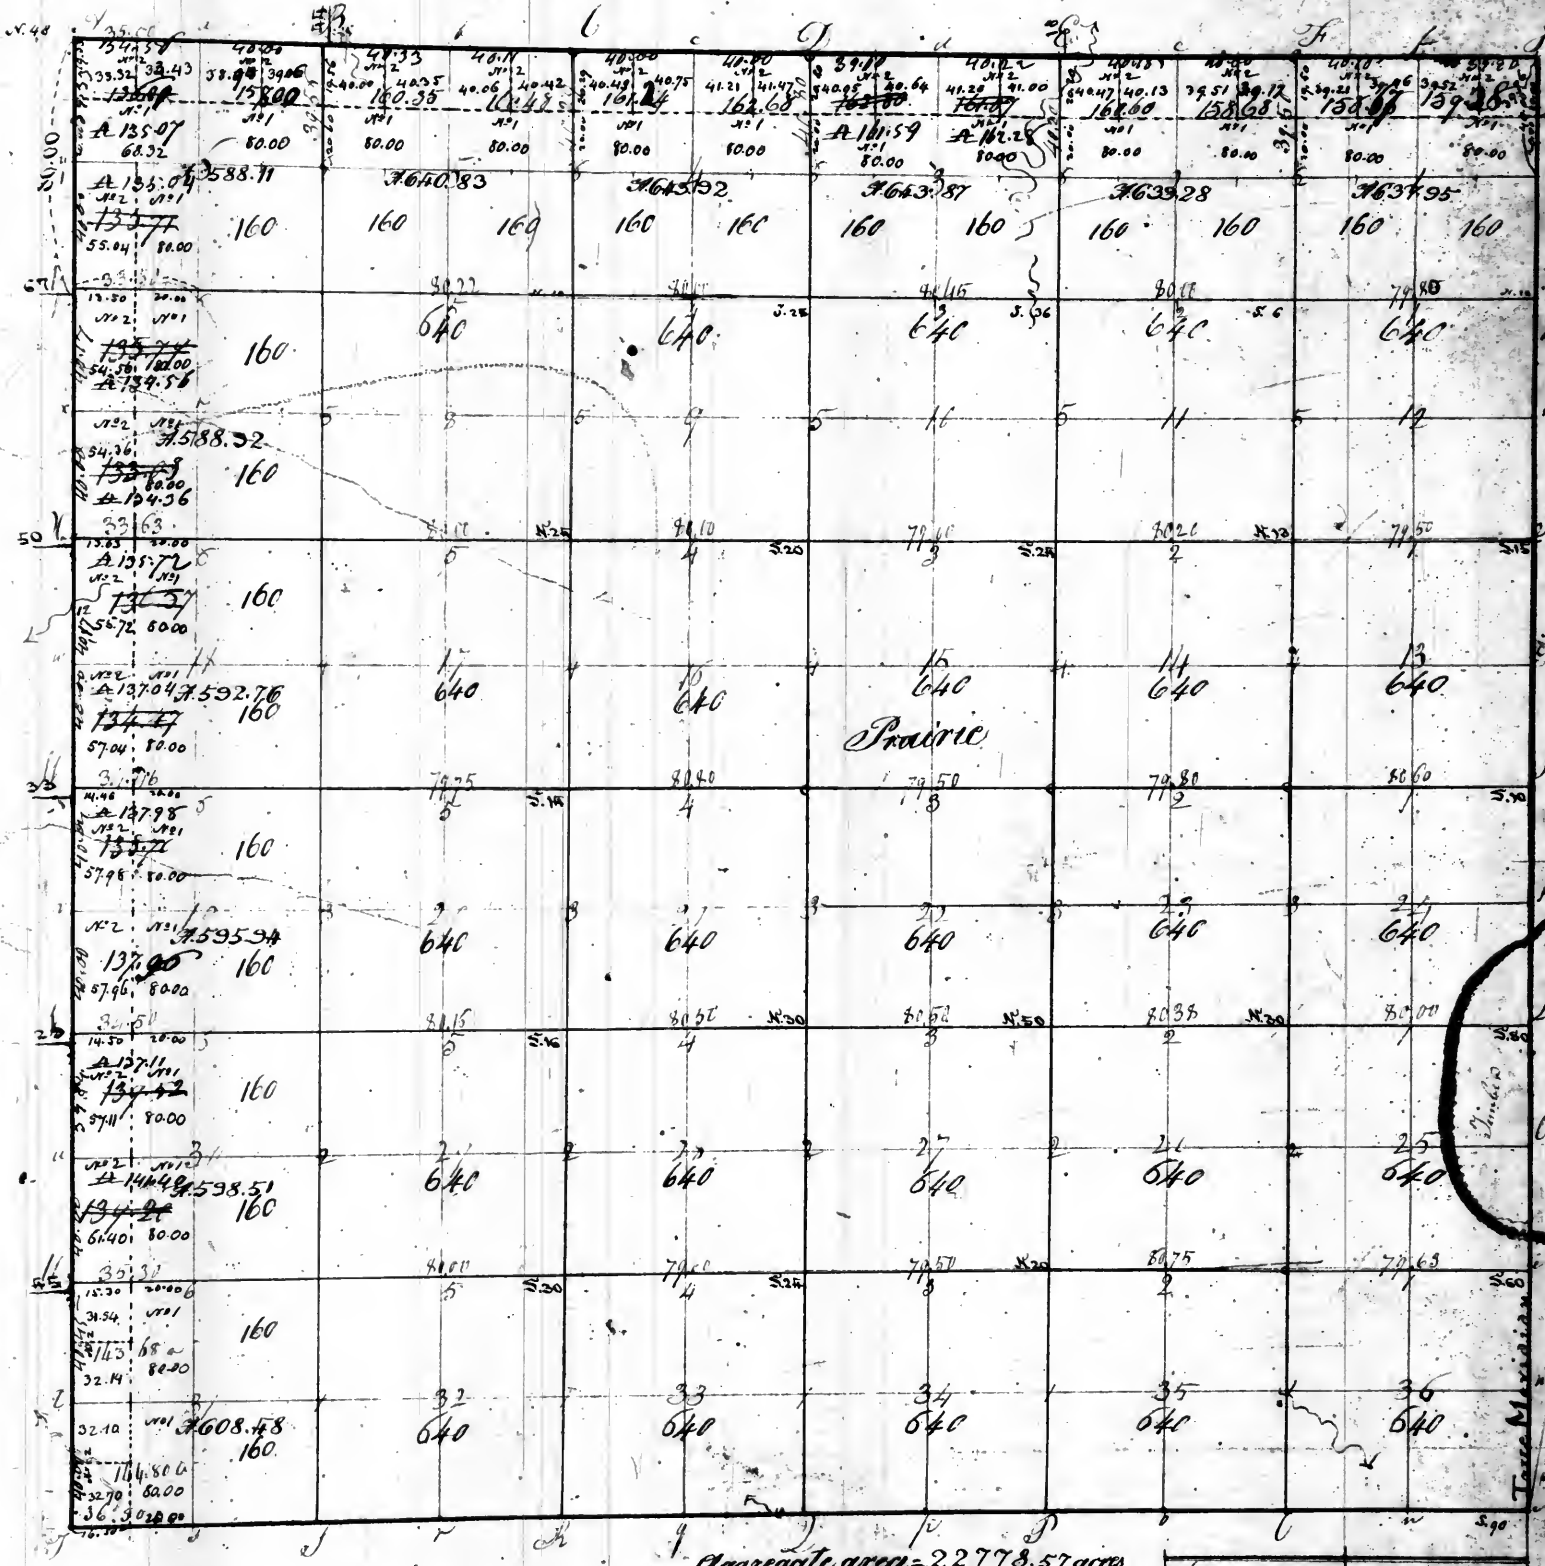

Office of the Surveyor General
for the State of Missouri
St. Louis July 19th 1850
The North half of section
12 3 4 5 6 7 8 9 10 11 12
and the South east quarter
of section 6 and the West
half of section 7 10 11 12
30 31 32 33 34 35 36 37 38 39 40 41 42
the act of Congress of the
5th of April 1832 and a
plat to the Register
another to the Commis-
sioner of the General Land
Office

Aggregate area = 22778.57 acres


Scale of 40 Chains to an Inch

I am in full compliance with the instructions from William H. Rector Surveyor of the Land of the United States in the
Territory of Illinois and Missouri bearing date the 29th day of October 1818 I have admeasured laid out and surveyed
the above named Township and do hereby certify that it had such marks and bounds both natural and
artificial as are mentioned in said plat and described in the field notes made thereof and returned with the
return into the Office of the Surveyor of the Land of the United States for the Territory of Illinois and Missouri
Certified the 13th day of January 1819

Enoch Moore

790

page 12 vol 12

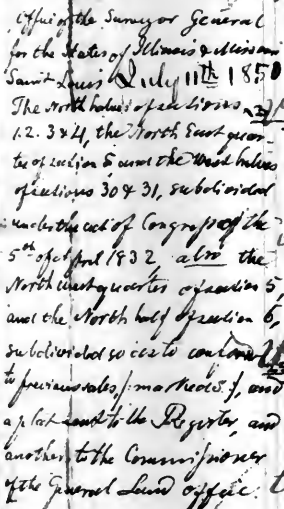


Aggregate area = 2275 Acres

Scale of 40 Chains to an Inch.

Certified this 25th day of January 1819. —

Enoch Moore D.S.

Township No. 14 North of the base line, Range No. 1 West of the 3^d principal Meridian.

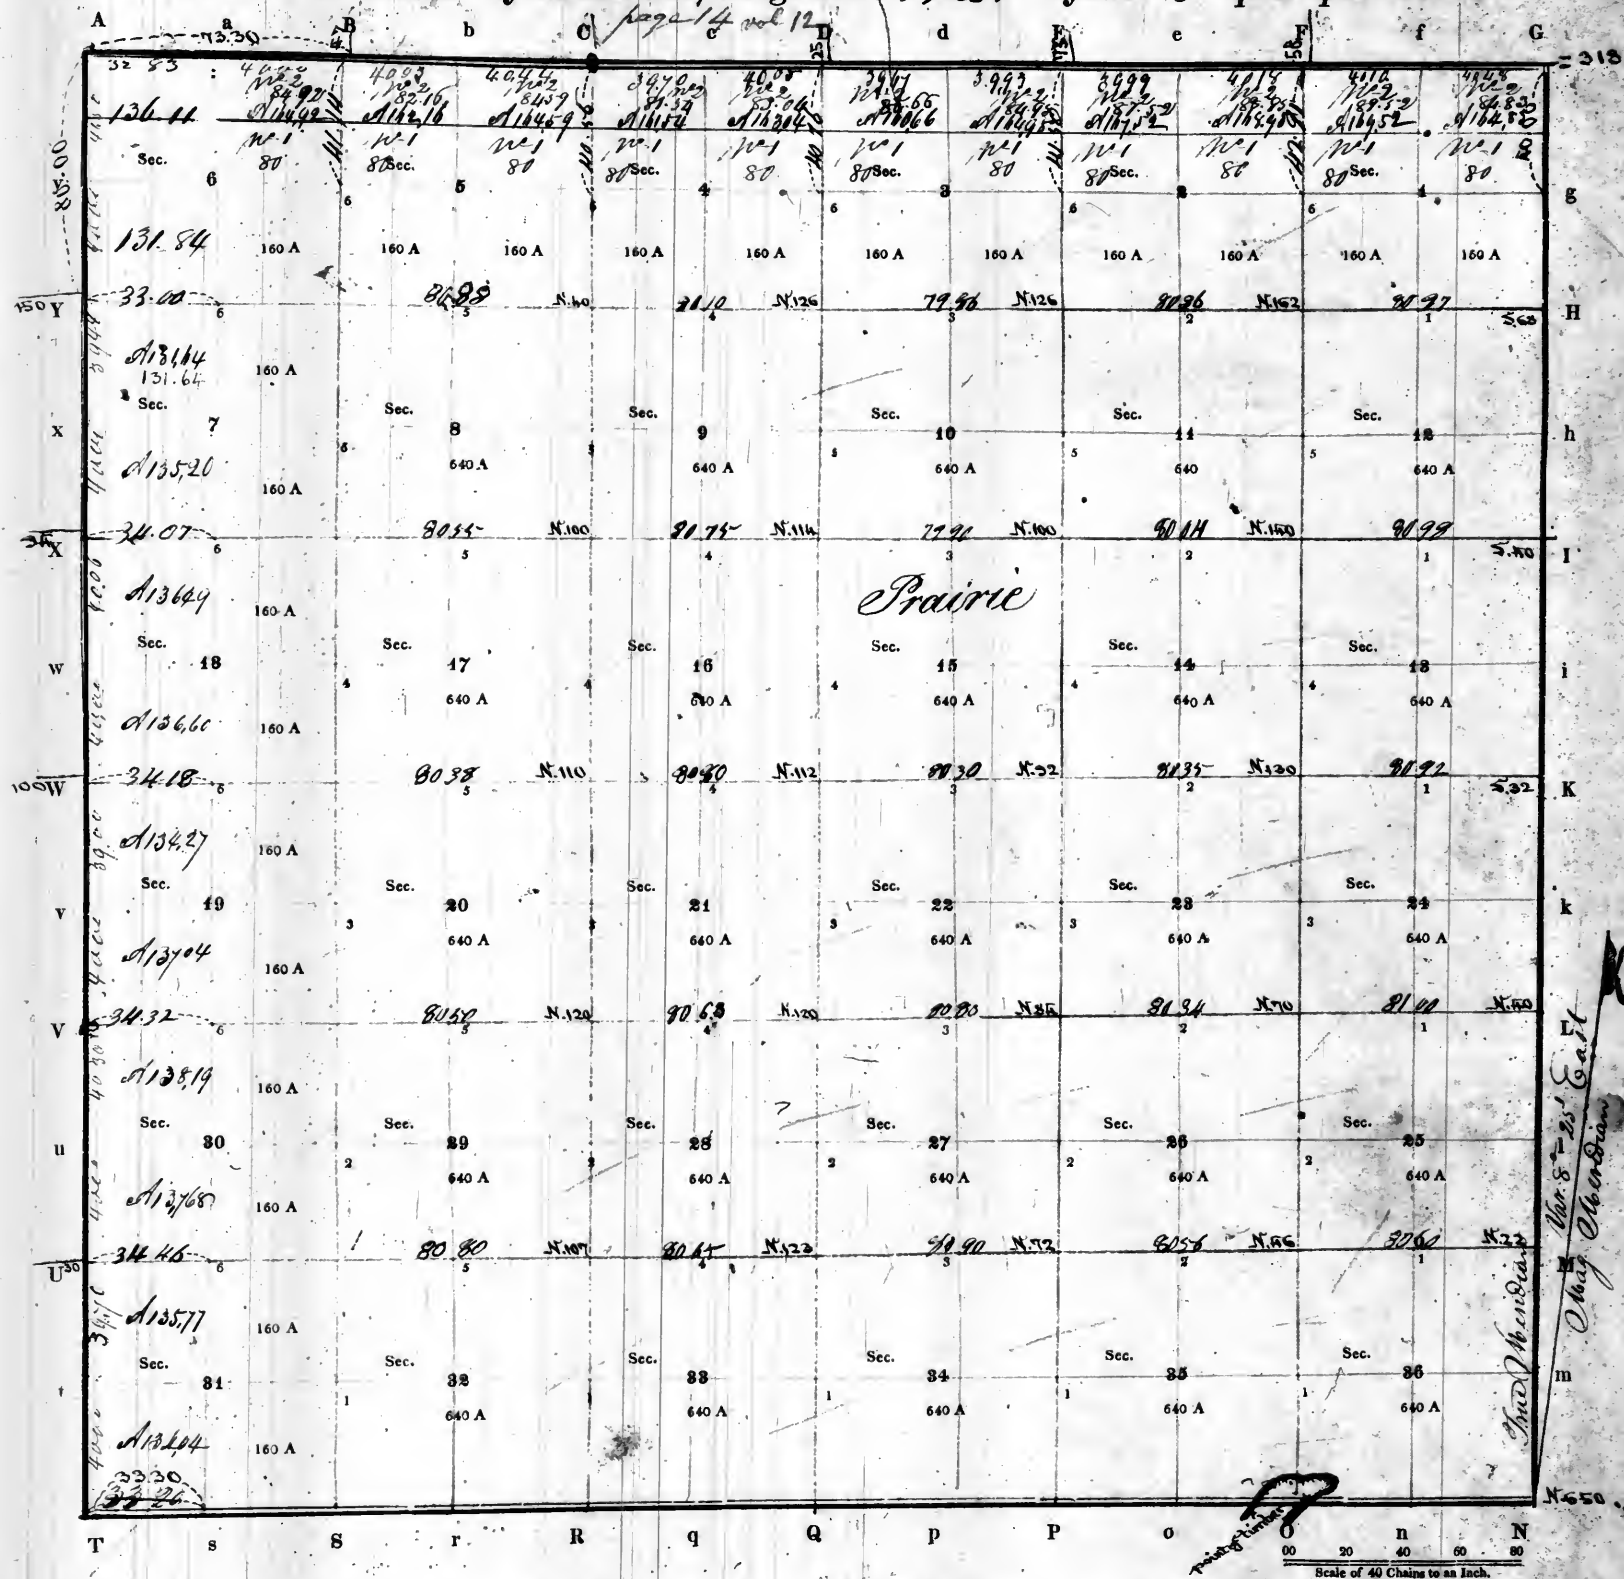

Nov. 8th = 25th East
May Meridian

$$\begin{array}{r} 53 \\ 12 \\ \hline 106 \\ 53 \\ \hline 636 \end{array}$$

PURSUANT to a contract with, and instructions from WILLIAM RECTOR, Surveyor of the lands of the United States in the *States of Illinois and Territory of Arkansas* bearing date the *nineteenth* day of *February* 182*1*

I have admeasured, laid out and surveyed the above described Township; and do hereby certify, that it had such marks and bounds, both natural and artificial, as are represented on said plat, and described in the field notes made thereof, and returned with this plat into the Office of the Surveyor of the lands of the United States, for the *States of Illinois and Territory of Arkansas*

Certified this *twelfth* day of *July* 18*91*


Will K. Richter D. SURVEYOR

EXAMINED.

Record 793

15

Township No. 10 North of the base line, Range No. 1 West of the 3rd principal Meridian.

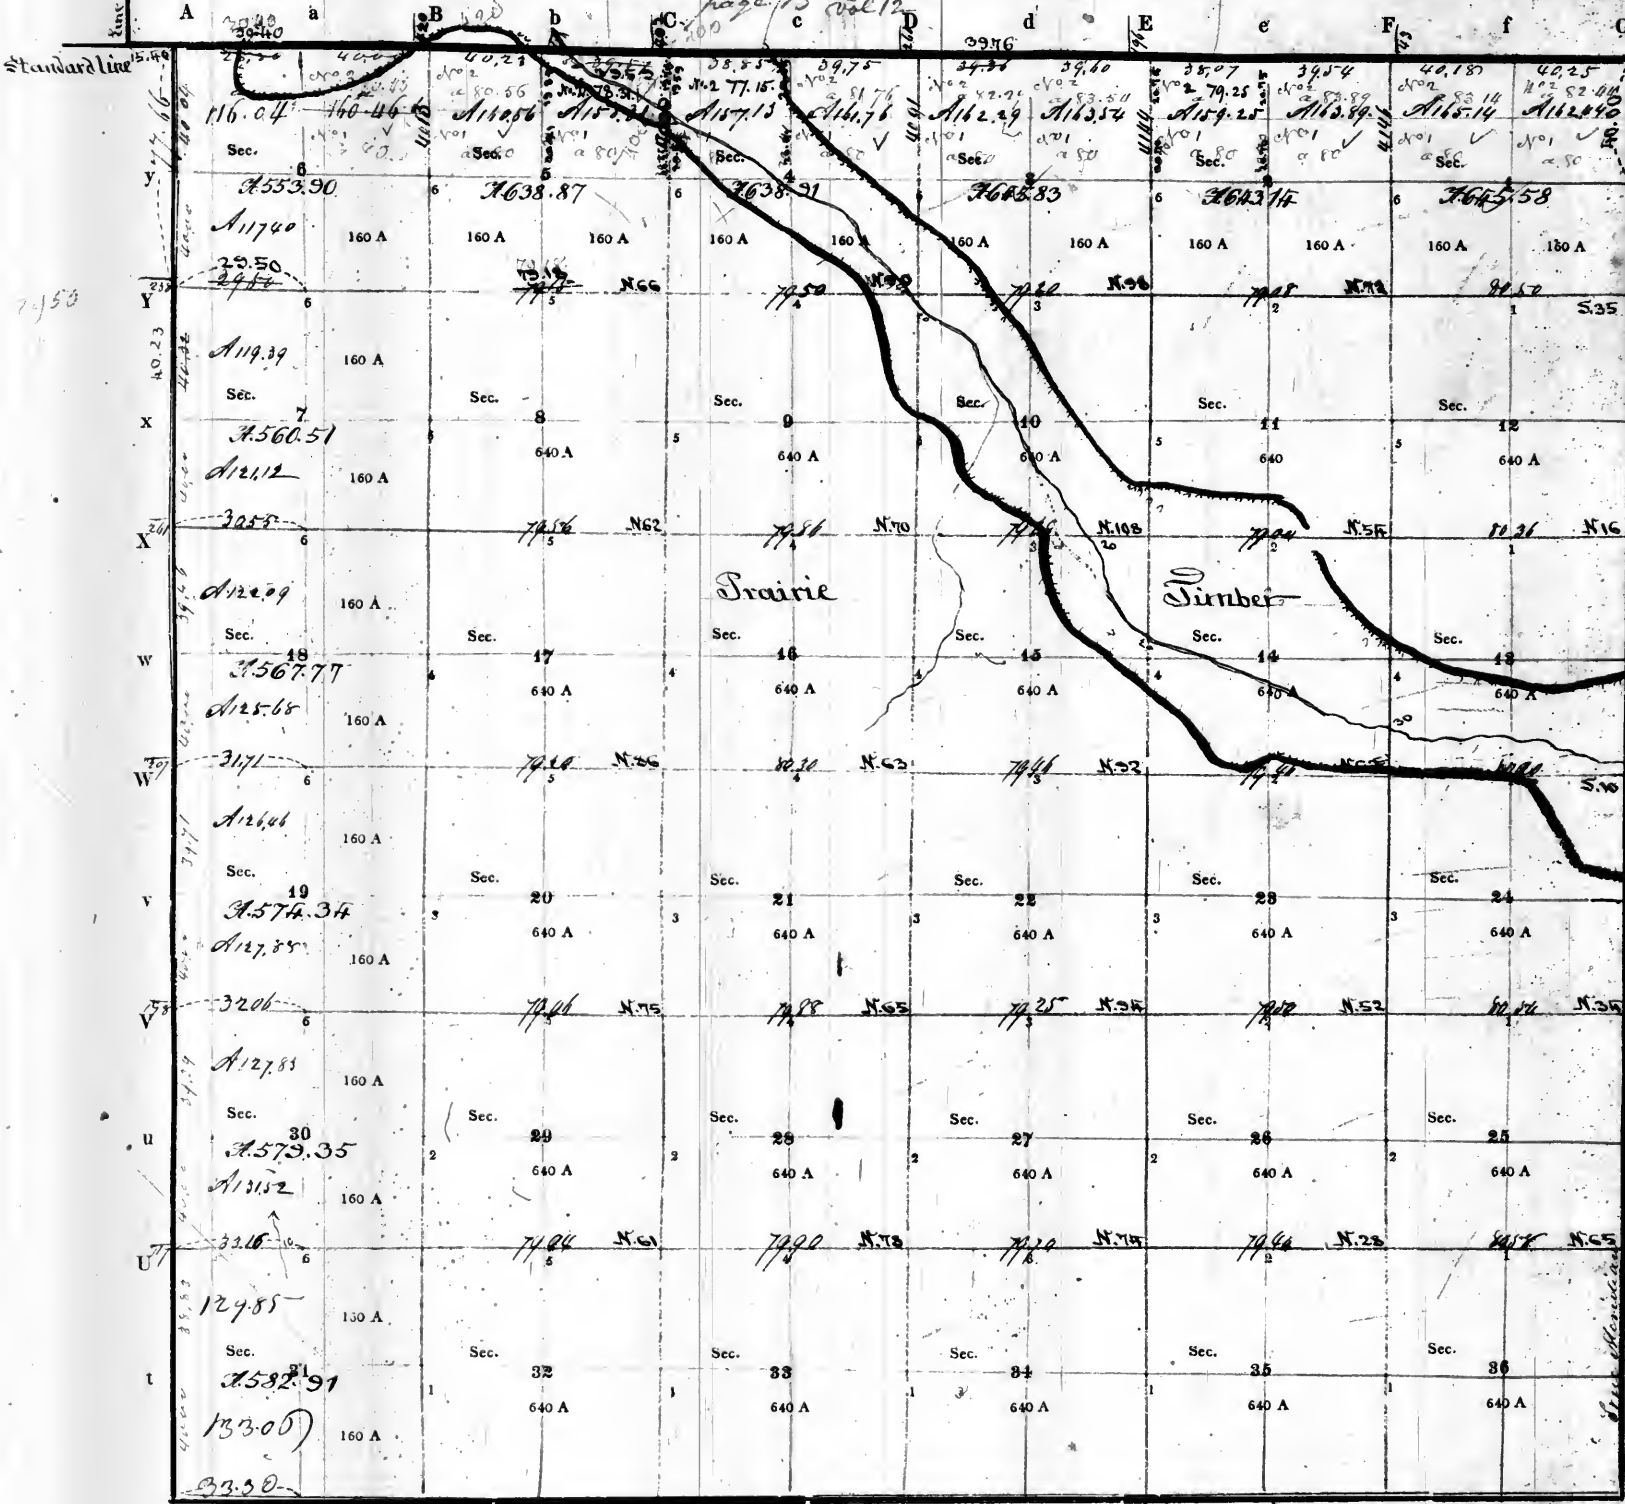

Aggregate area = 22631.11 acres

St. Louis 23 November 1849.
Sent this day a copy of plat of
the N. W. 1/4 of Sec. 6 to the
Com. of the Genl. Land Office
as per his letter of 31 Oct. 1849
or another copy was sent to
the Register on the same day

Surveyor's Office
St. Louis 10th August 1842.
Plat of the N. W. 1/4 of Sec. 24 and
of the S. E. 1/4 of Sec. 5, sent this day
to the Com. of the Genl. L.O.

See also plat of Sec. 6

PURSUANT to a contract with, and instructions from WILLIAM RECTOR, Surveyor of the lands of the United States in the States of Illinois and Wisconsin and Territory of Arkansas bearing date the nineteenth day of February 1821

I have admeasured, laid out and surveyed the above described Township; and do hereby certify, that it had such marks and bounds, both natural and artificial, as are represented on said plat, and described in the field notes made thereof, and returned with this plat into the Office of the Surveyor of the lands of the United States, for the States of Illinois and Wisconsin and Territory of Arkansas

Certified this Twelfth day of July 1821


William Rector
D. SURVEYOR

EXAMINED.

T

794
Record

Township No. 16 North of the base line, Range No. 1 West of the *Fourth* principal Meridian.

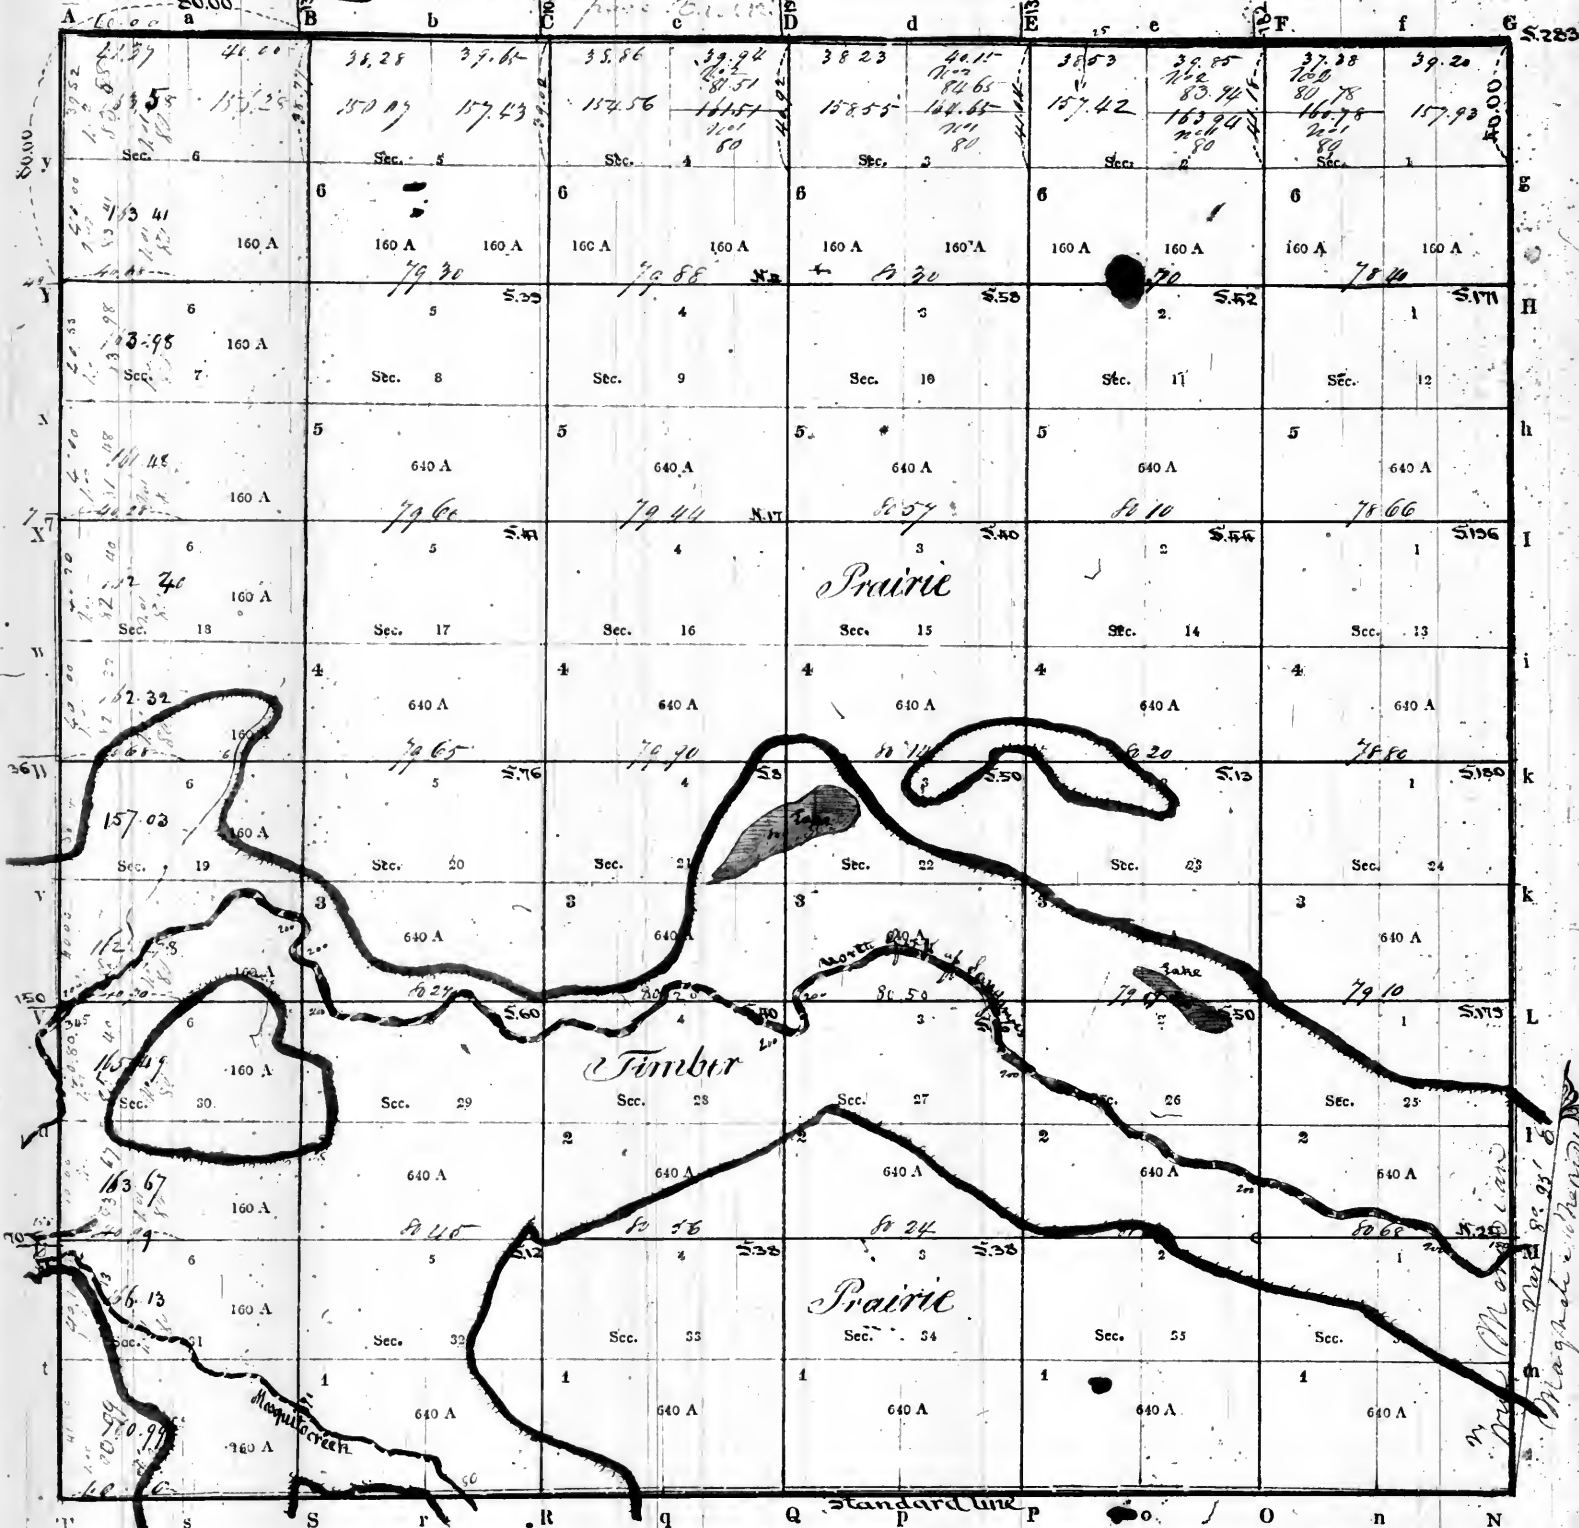

PURSUANT to a contract with, and instructions from William Rector, Surveyor of the lands of the United States in the State of Illinois and Secretary of Arkansas, bearing date the *fifth* day of *April* 1821, I have measured, laid out and surveyed the above described Township; and do hereby certify, that it had such marks and bounds, both natural and artificial, as are represented on said plat, and described in the field notes made thereof, and returned with this plat into the Office of the Surveyor of the Lands of the United States, in the State of Illinois and Secretary of Arkansas.

Certified this *Twentieth* day of *December* 1821
EXAMINED.


A. V. Vaughan D. SURVEYOR.

Township 17 North of the base line, Range 1 West of the 3rd principal Meridian, except sections 1, 2, 3, 7 which are omitted on account of the survey of the lines between Sec 1, 12, 16, 37 being incomplete.

Recorded

17

3802
4658
7460
3490

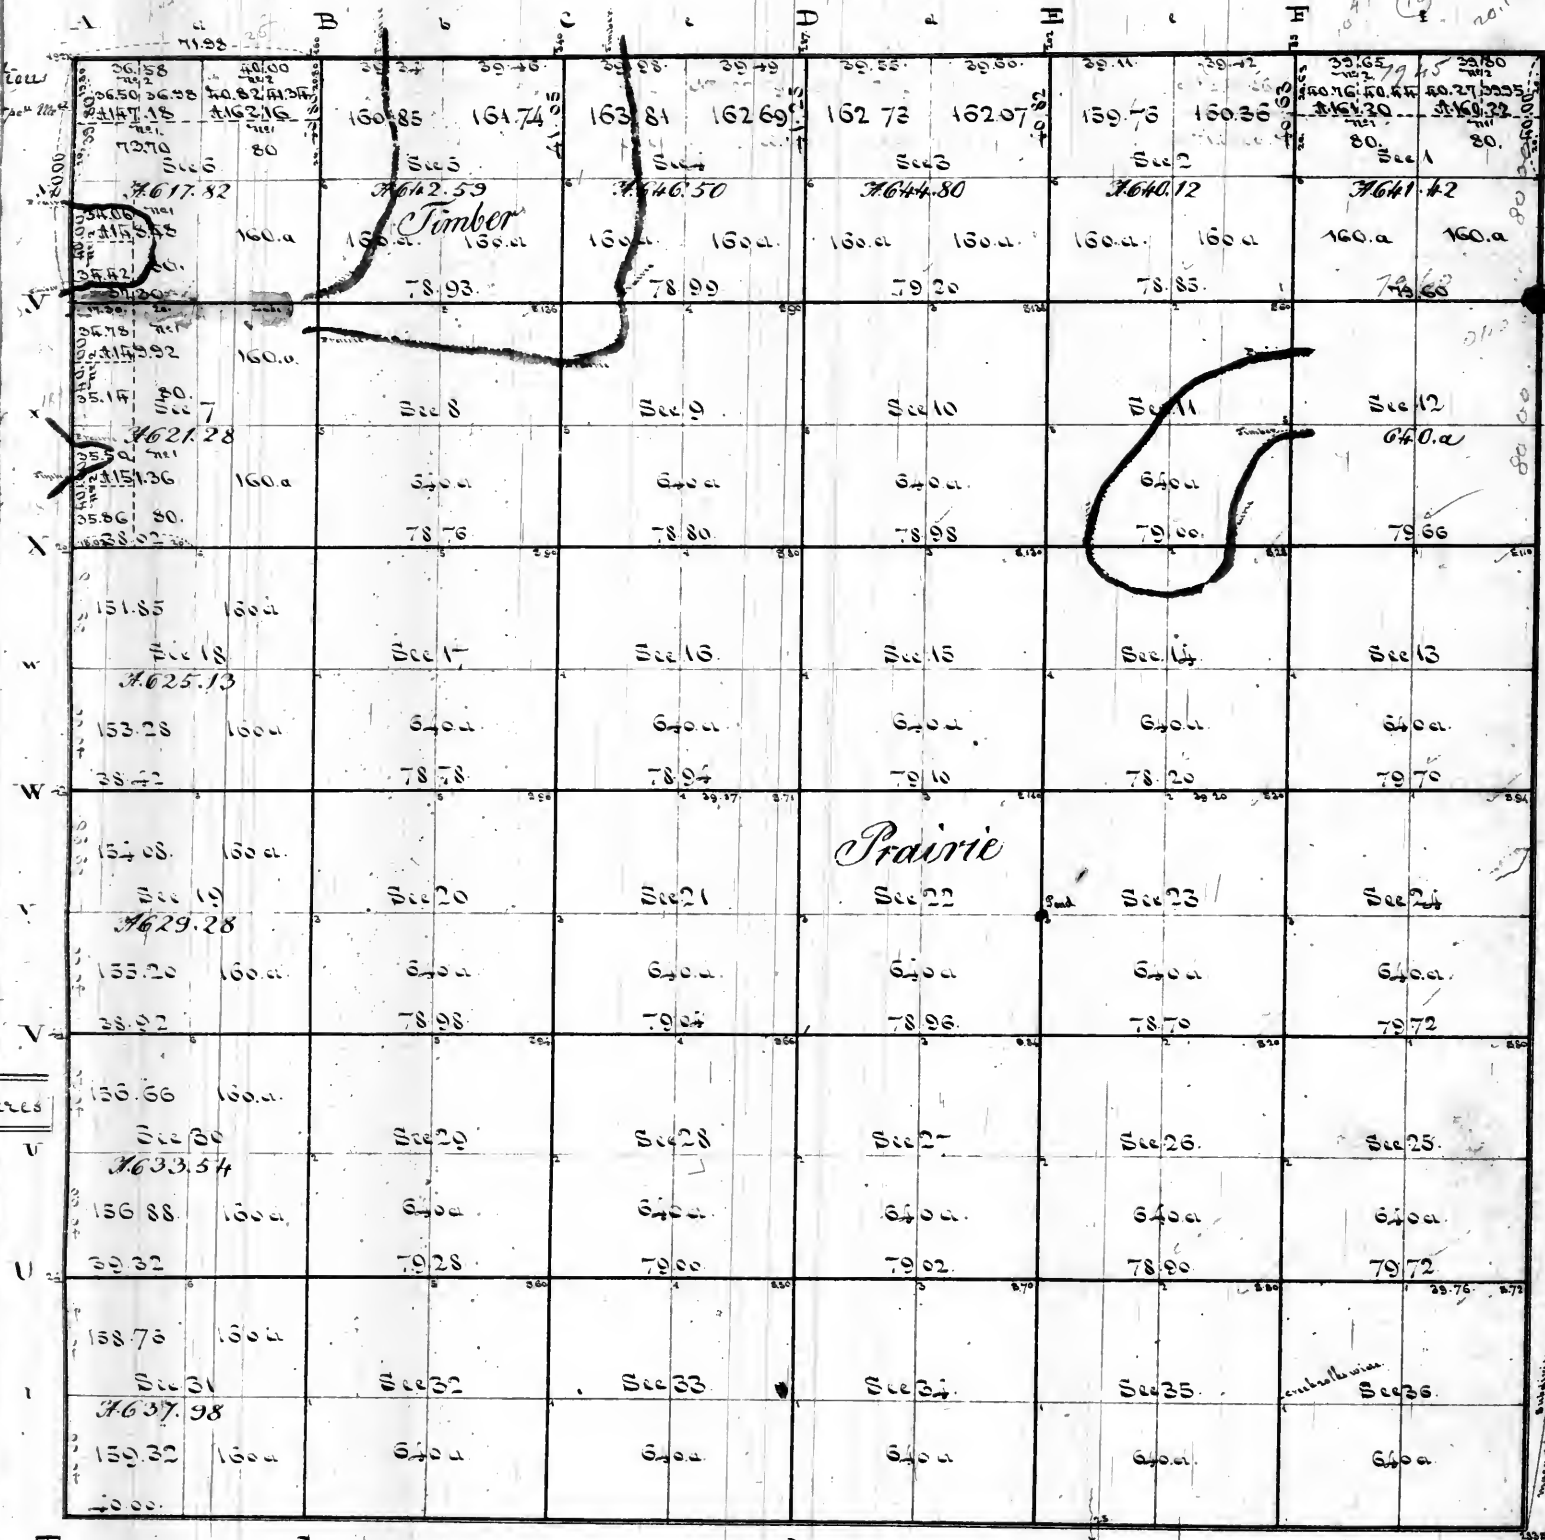

Surveyor's Office
St. Louis, Dec 24th 1837
Note - The areas of Sections 1, 12, 6, 37 of T. 17. N. 1. W. 3. M. were this day calculated by the following data - viz:
The line between Sections 1 & 12 according to the field notes thereof, was run East on a random, 74.00 ch to an inaccessible stake after which it seems that the Dep^y Surveyor ran West on a true line, and at 33.50 a post was set in a mound for a section corner at about the average distance - therefore the double of 33.50 = 67.00 is assumed as the length of the line between said Secs 1 & 12 and the calculation of the areas are made as though the true line was run parallel to the true line between Sections 12 & 13 -
The assumed length of the line between Sections 6 & 7 is the average between the length of the North boundary of Section 6 and the line between Sections 7 & 13 = 17.30 chains, and the calculations of the areas made though the line between Sections 6 & 7 was parallel to the line between Sections 6 & 13.
H. R. Lamm
i Comp^d Surveyor of public Lands in the States of Illinois & Missouri
The field notes, used in the construction of this plat, were in books numbered as follows: viz -
of the S. 34th in book of 191
S. 34th in book of 193
of S. 34th in book of 198
W. 34th in book of 199
K subdivision in book of 198

St. Louis Dec 24th 1837
Sent this day a copy of Sec 1, 12, 6, 37 & of the marginal note, to the Register & another copy to the Comm^r of the genl Land office.


Surveyors Office
St. Louis, July 1st 1834

The above Plat of Township 17 North of the base line, Range 1 West of the 3rd principal Meridian, is conformable to the field notes of the survey thereof on file in this Office.

E. J. Linham

U. S. Land Office

Township N. 17 North of the Base line, Range N. 1 West of the 3^d Principal Meridian
 page 17 vol 12

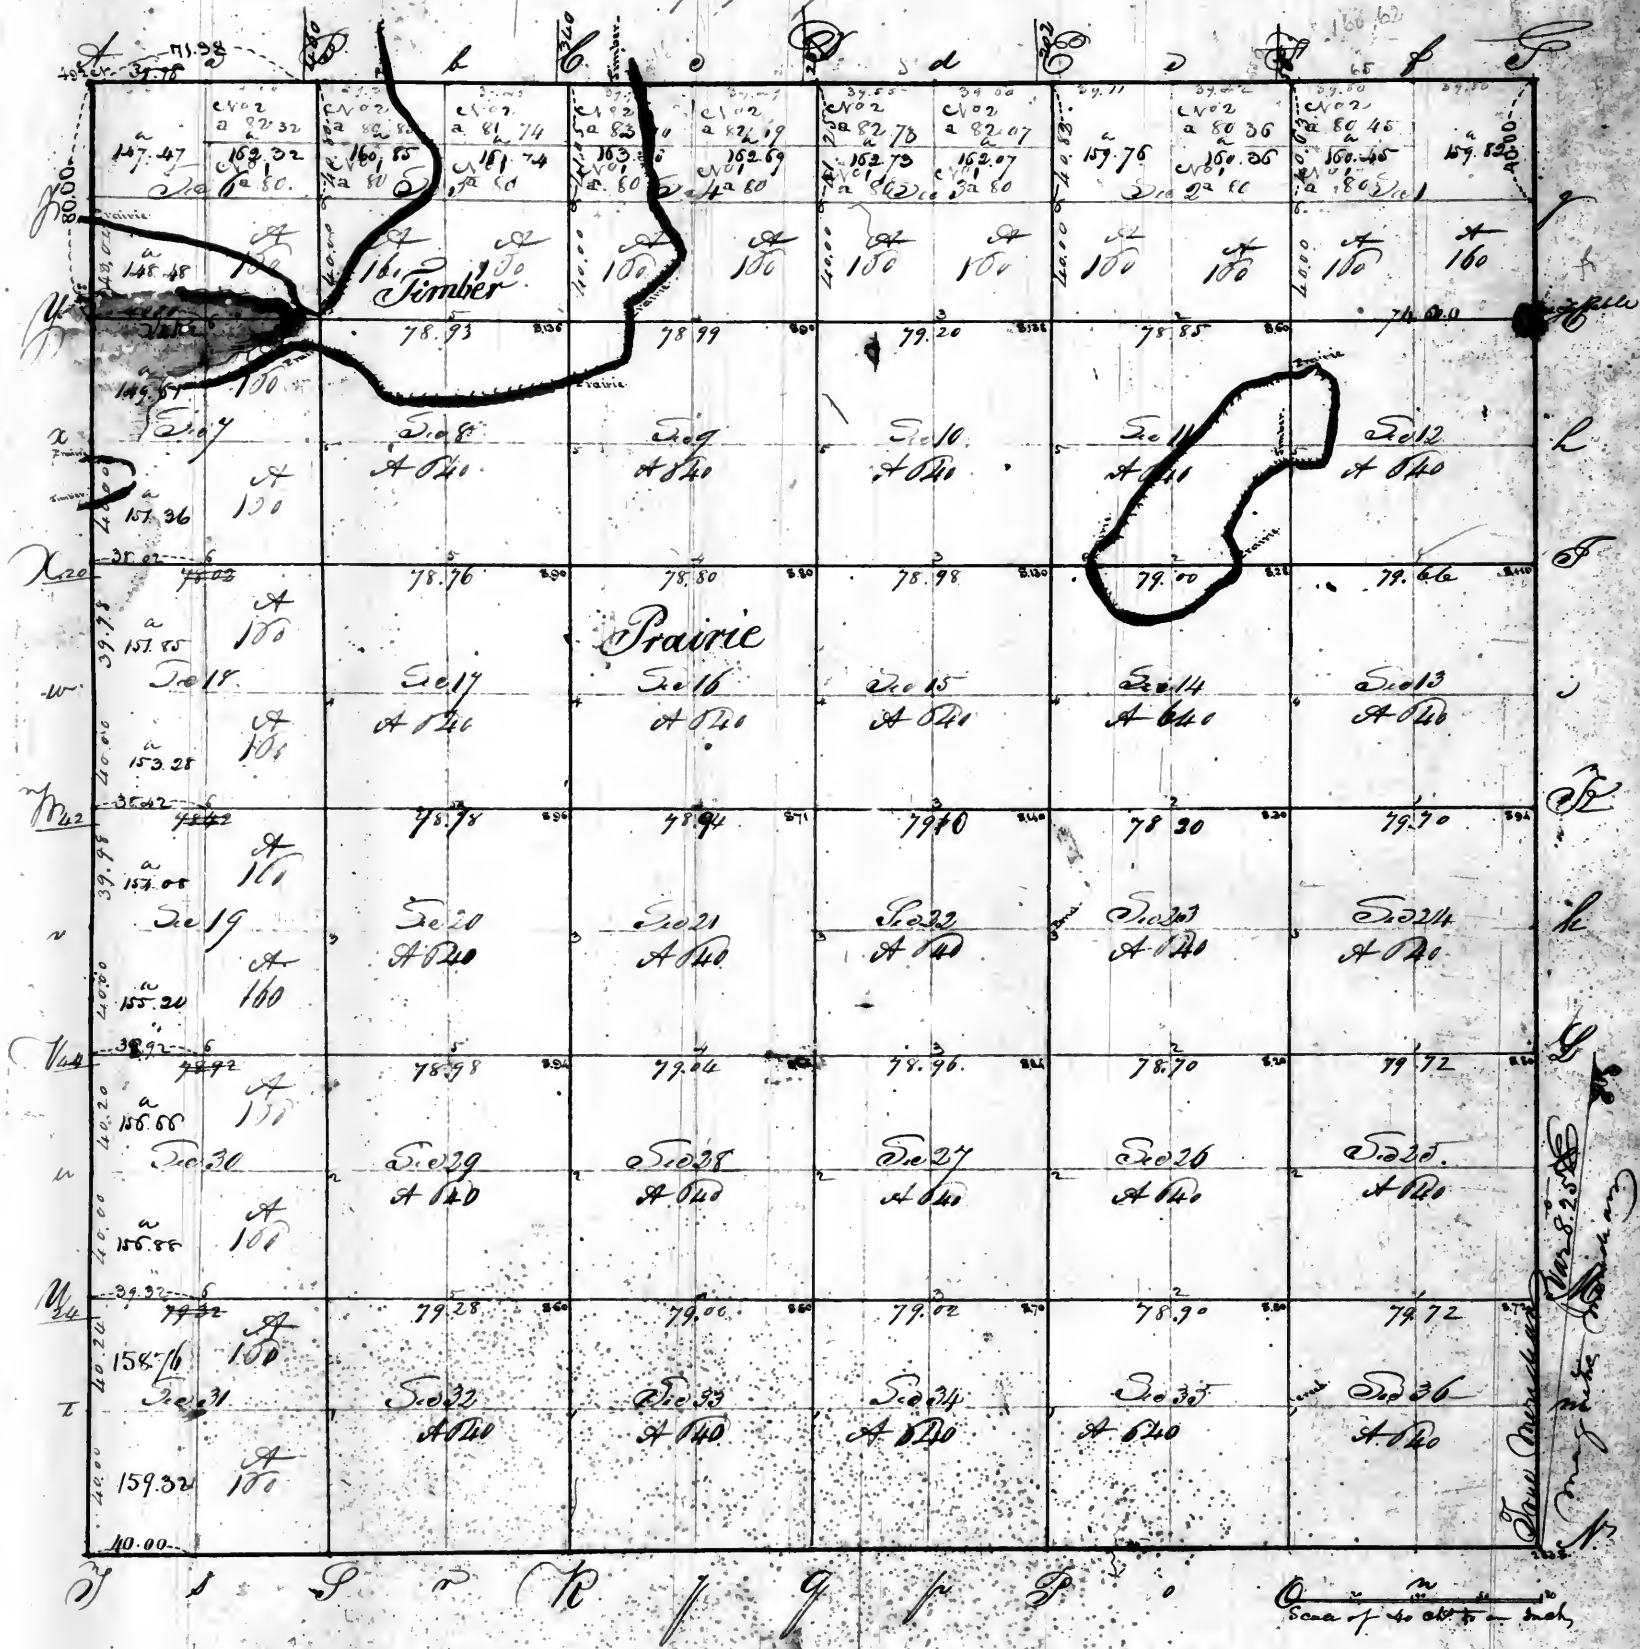


Pursuant to a contract with and instructions from William H. Smith, Surveyor of the Land of the United States in the States of Illinois and Missouri and the Territory of Arkansas bearing date the 15th day of June 1823 I have administered land out and surveyed the above described Township and do hereby certify that it has been marked and bounded both natural and artificial as are represented on said plat and described in the fields noted made thereof and returned with this plat into the office of the Surveyor of the Land of the United States in the State of Illinois and Missouri and the Territory of Arkansas. Certified the thirtieth day of October 1824.

Wm. H. Smith Surveyor

Gray Hamilton

Record

Township no 19 north of the Base line Range no 1 West of the 3rd Meridian
page 19 vol 12

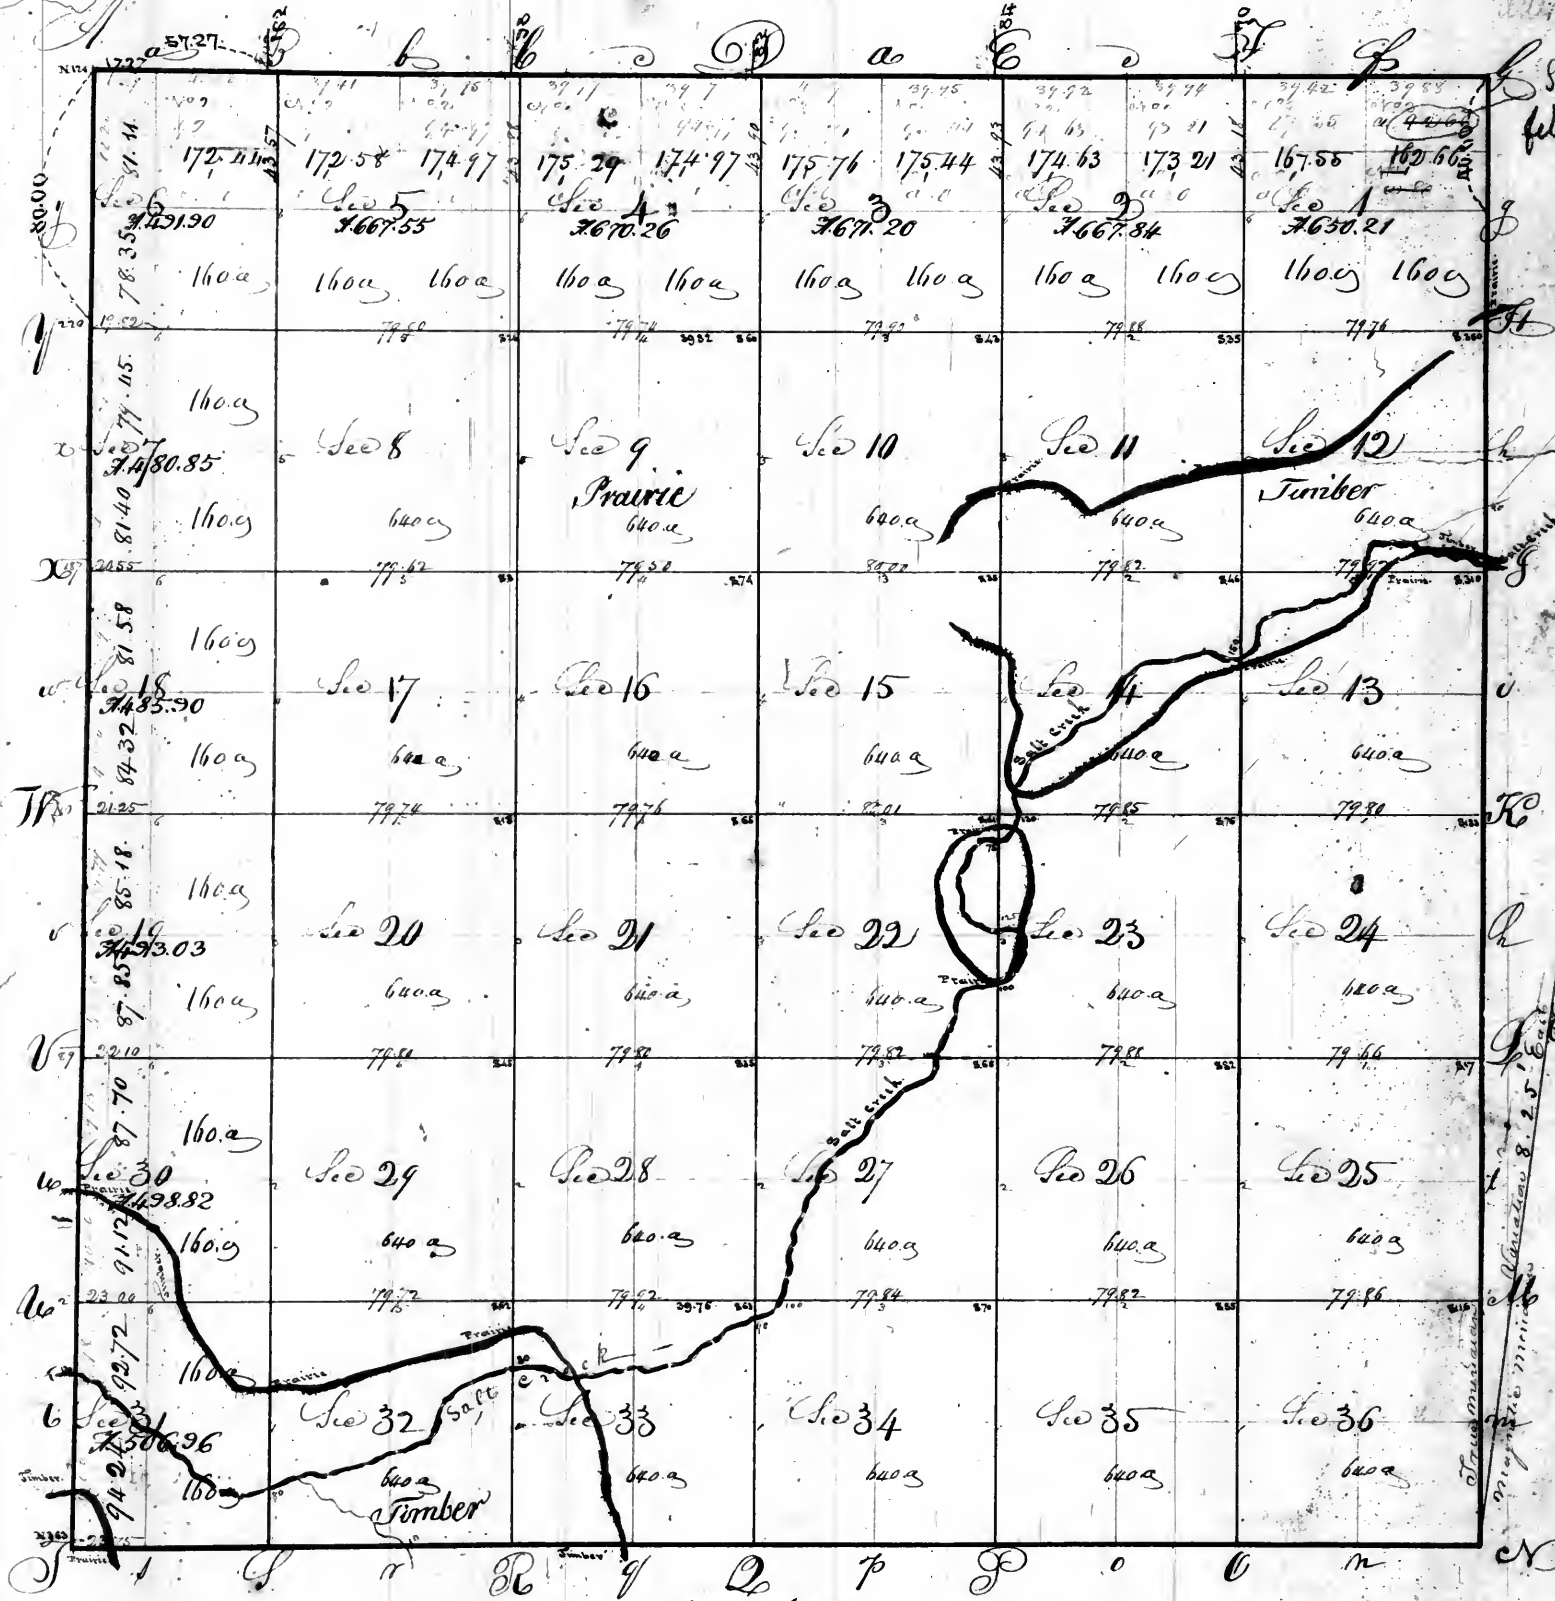

Aggregate area = 22384.52 acs.

Scale 40 chains to an inch

Pursuant to a contract with and instructions from William Reeler Surveyor of the Lands of the United States in the States of Illinois and Missouri and Territory of Arkansas bearing date the 12th day of June 1823 I have administered laid out and surveyed the above described Township and do hereby certify that it has such marks and bounds both natural and artificial as are represented on said plat and described in the field notes made thereof and returned with this plat into the office of the Surveyor of the Lands of the United States in the States of Illinois and Missouri and Territory of Arkansas
Certified this the 11th day of October 1824

Wm. Hamilton

Township N^o 20 North of the Base line Range N^o 1 West of the 3rd P^{me} M^{ts}

page 20 of 12

Standard line

Section 1, 2, 3, 4, 5, 6

Timber


Prairie

Section 1, 2, 3, 4, 5, 6

Aggregate area = 22153.13 acres

Pursuant to a contract with and instructions from William Rector Surveyor of the Land
of the United States in the State of Illinois and Mississippi and Territory of Arkansas
bearing date the 12th day of June 1823 I have examined said plat and surveyed
the above described Township and do hereby certify that it has such marks and
boundaries both natural and artificial as are represented on said plat and described
in the field notes made thereof and returned with this plat into the office of the
Surveyor of the Land of the United States in the State of Illinois and Mississippi Territory
of Arkansas
Certified the thirtieth day of October 1824

Mrs Hammett



Township No 21 North of the Base line Range No 5 West of the 3^d Principal Meridian

Prairie

Timber

Note at the Corner of Sections 28, 29, 30 & 31 set post only.

Aggregate area = 23099.64 acres

Pursuant to a contract with and instructions from William Bector, surveyor of the lands of the United States in the States of Illinois & Missouri & Territory of Arkansas bearing date the fourteenth day of June 1823 I have admeasured laid out and surveyed the above described Township and do hereby certify that it had such marks and bounds both natural and artificial as are represented on said plat and described in the field notes made thereof and returned with the plat into the office of the Surveyor of the lands of the United in the States of Illinois and Missouri and Territory of Arkansas


Certified this 28th day of October 1823. D. W. January, D. Surveyor


D. W. January D. Survego
 Expended by H. Rawls D. Survego

Recorded

Township N°22 North of the Base line Range N°5 West of the 3rd principal Meridian
page 22 vol 12

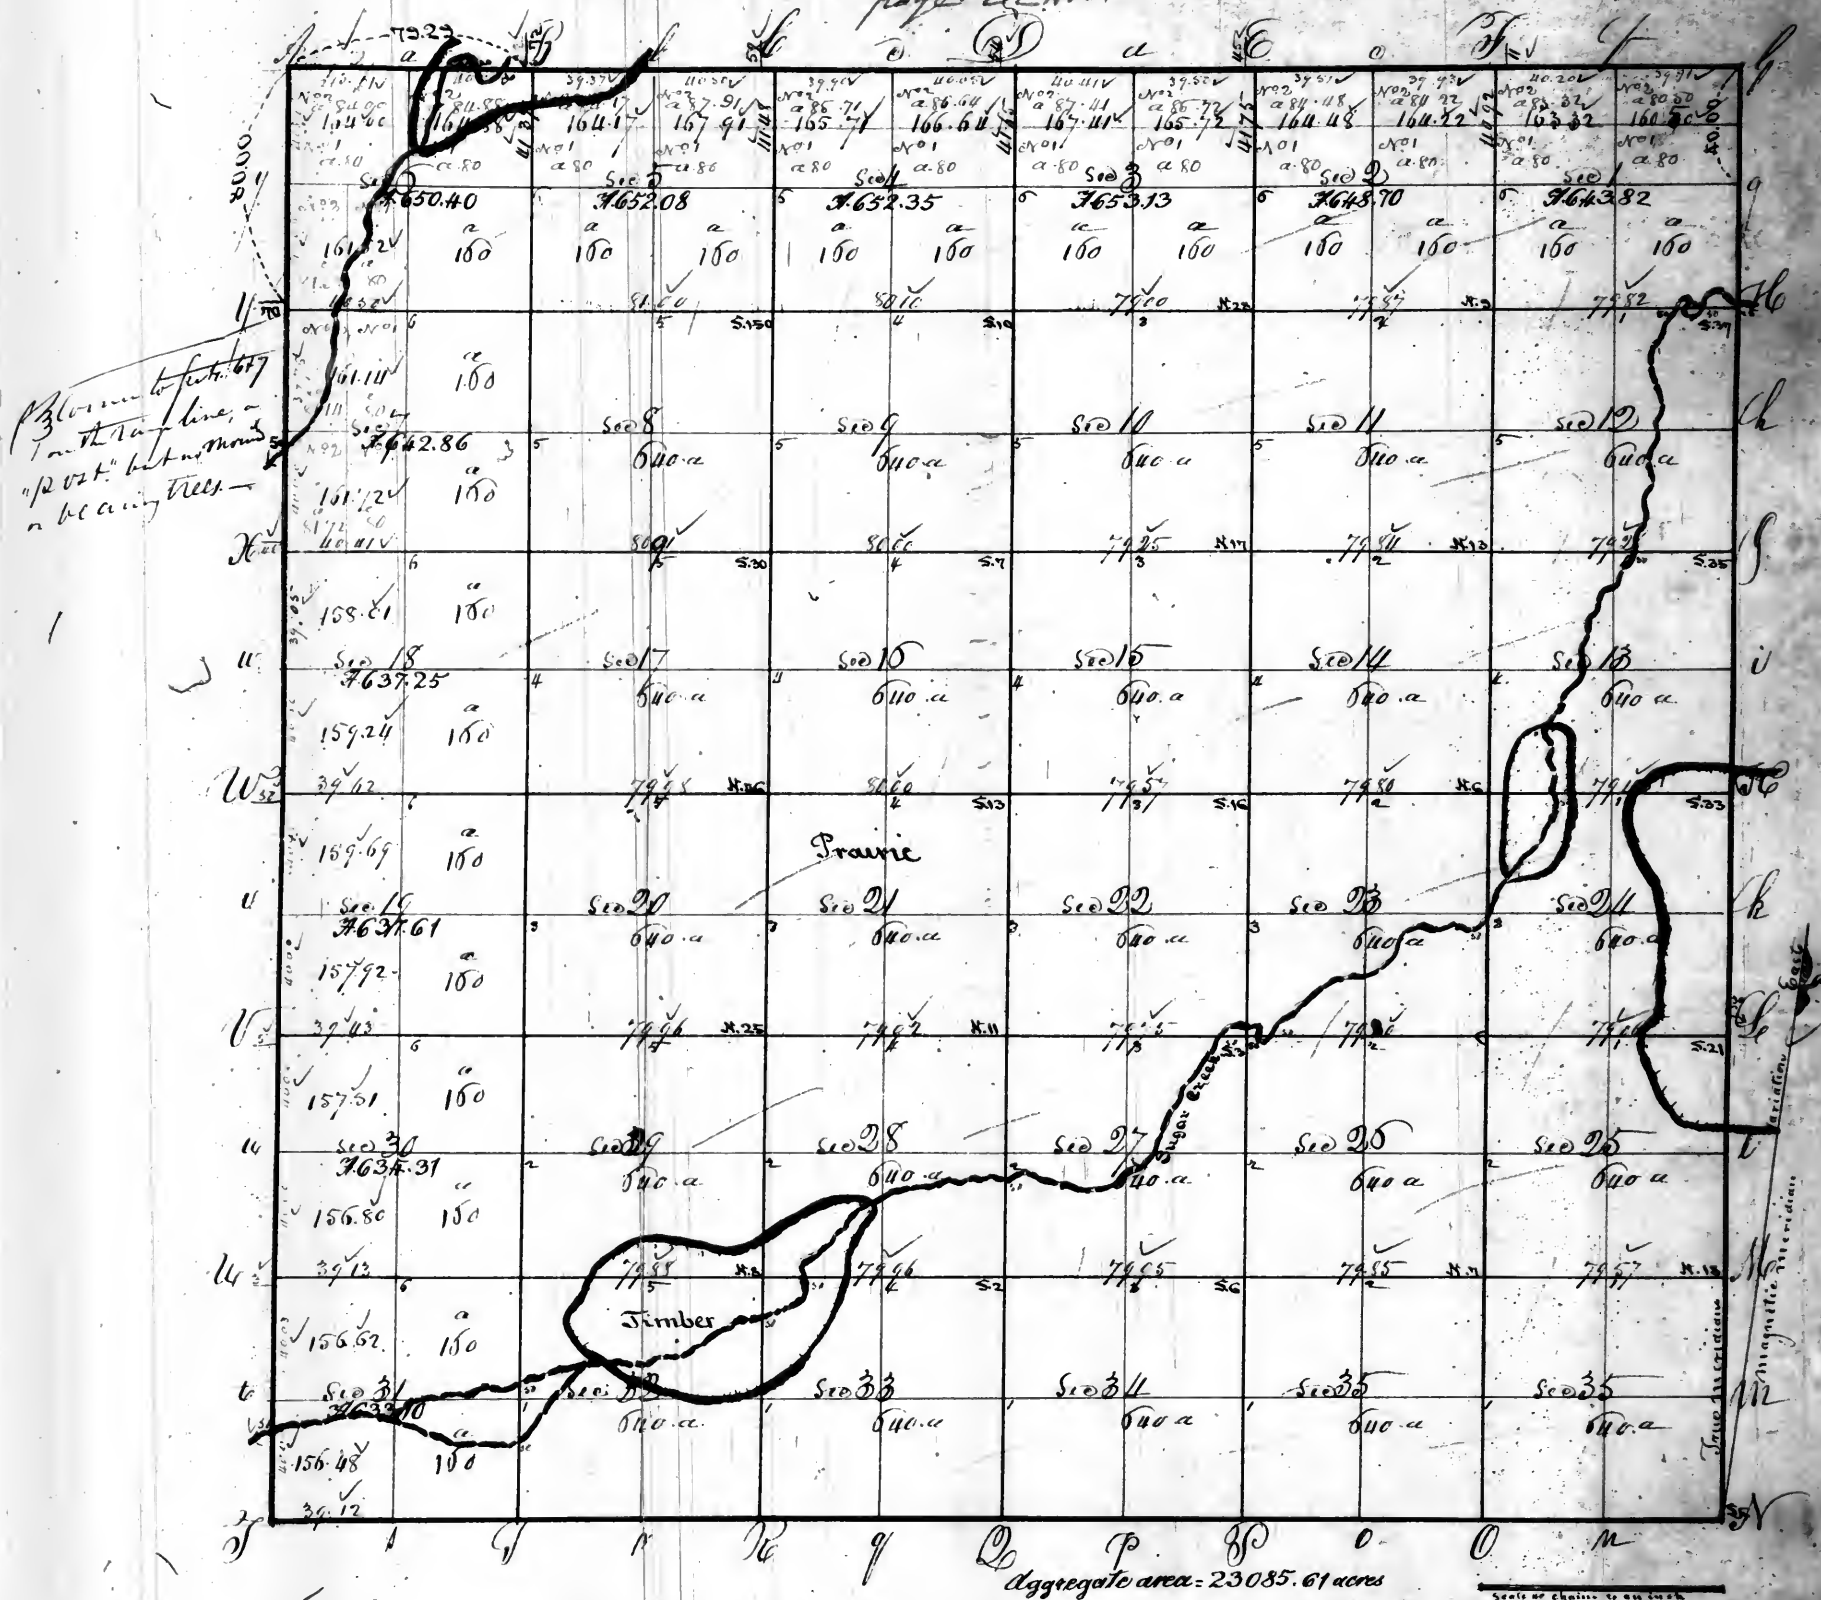

Pursuant to a contract with and instructions from William Reitor Surveyor of the Land of the United States in the State of Illinois and Territory of Arkansas bearing date the 14th day of June 1823 have administered laid out and surveyed the above described Township and do hereby certify that it has such marks and boundary both natural and artificial as are represented on said plat and described in the field notes made thereof and returned with this plat into the office of the Surveyor of the Land of the United States in the State of Illinois and Territory of Arkansas

Certified this 28th day of October 1823


Examined 1827
Wm. Reitor

D. W. January D. Surveyor
Assisted W. Rawls D. Surveyor

Record

Township N^o 23 North of the Base line Range N^o 5 West of the 3^d Principal Meridian

Page 23 vol 12

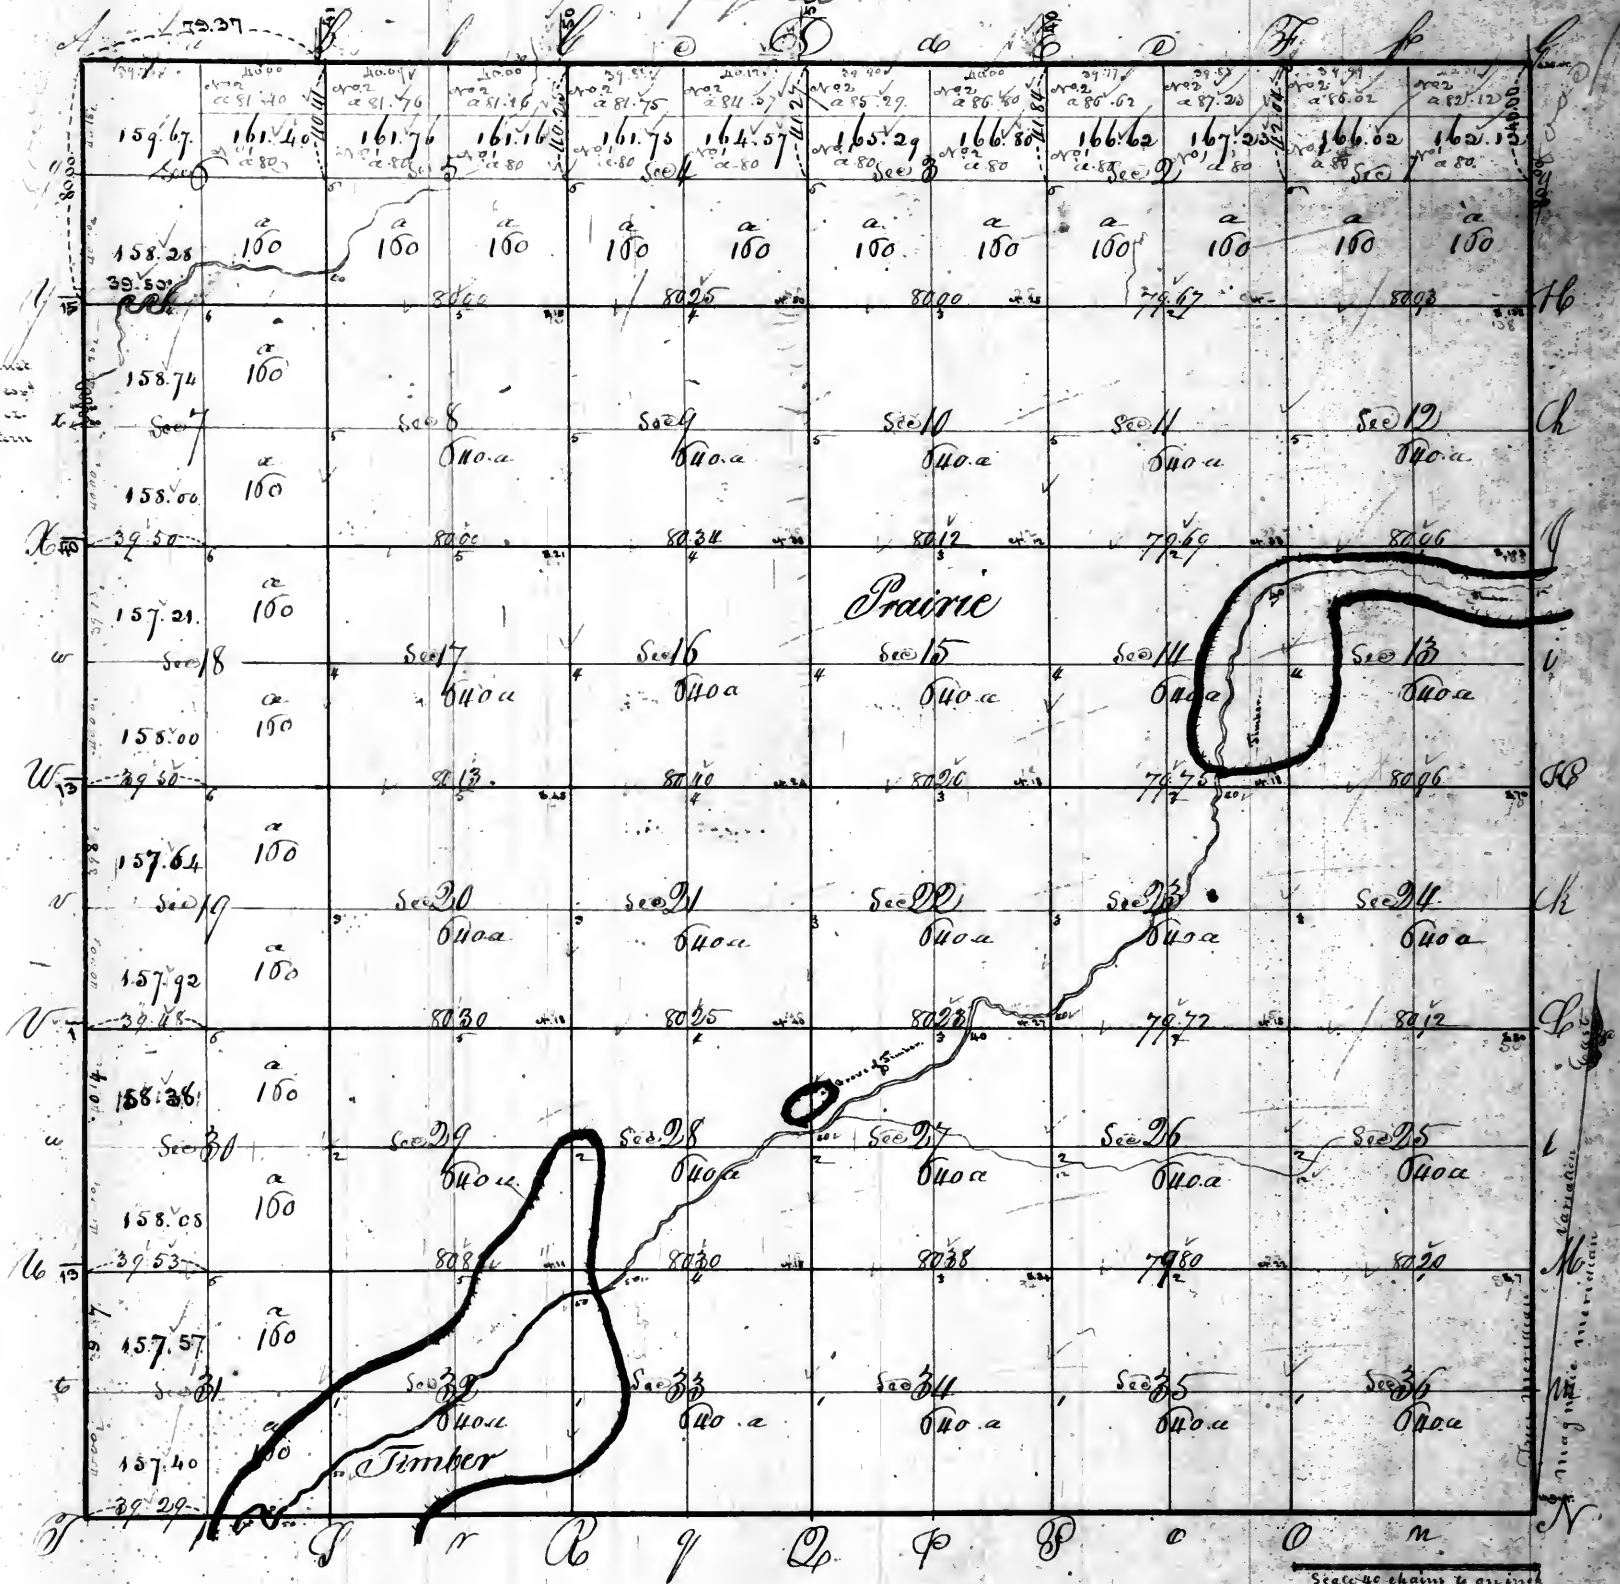

Pursuant to a contract with and instruction from William Reitor Surveyor of the Land of the United States in the State of Illinois and Wisconsin and Territory of Arkansas bearing date 14th day of June 1823 I have admeasured laid out and surveyed the above described Township and do hereby certify that it has such marks and bounes both natural and artificial as are represented on said plat and described in the field notes made thereof and returned with this plat into the office of the Surveyor of the Land of the United States in the State of Illinois and Wisconsin and Territory of Arkansas.


Certified this 28th day of October 1823

P. W. January D. Surveyor
 Off. Secy. J. R. Smith D. Surveyor

Records

Township No 24 North of the Base line Range No 1 West of the 3^d Principal Meridian

page 24 vol 12

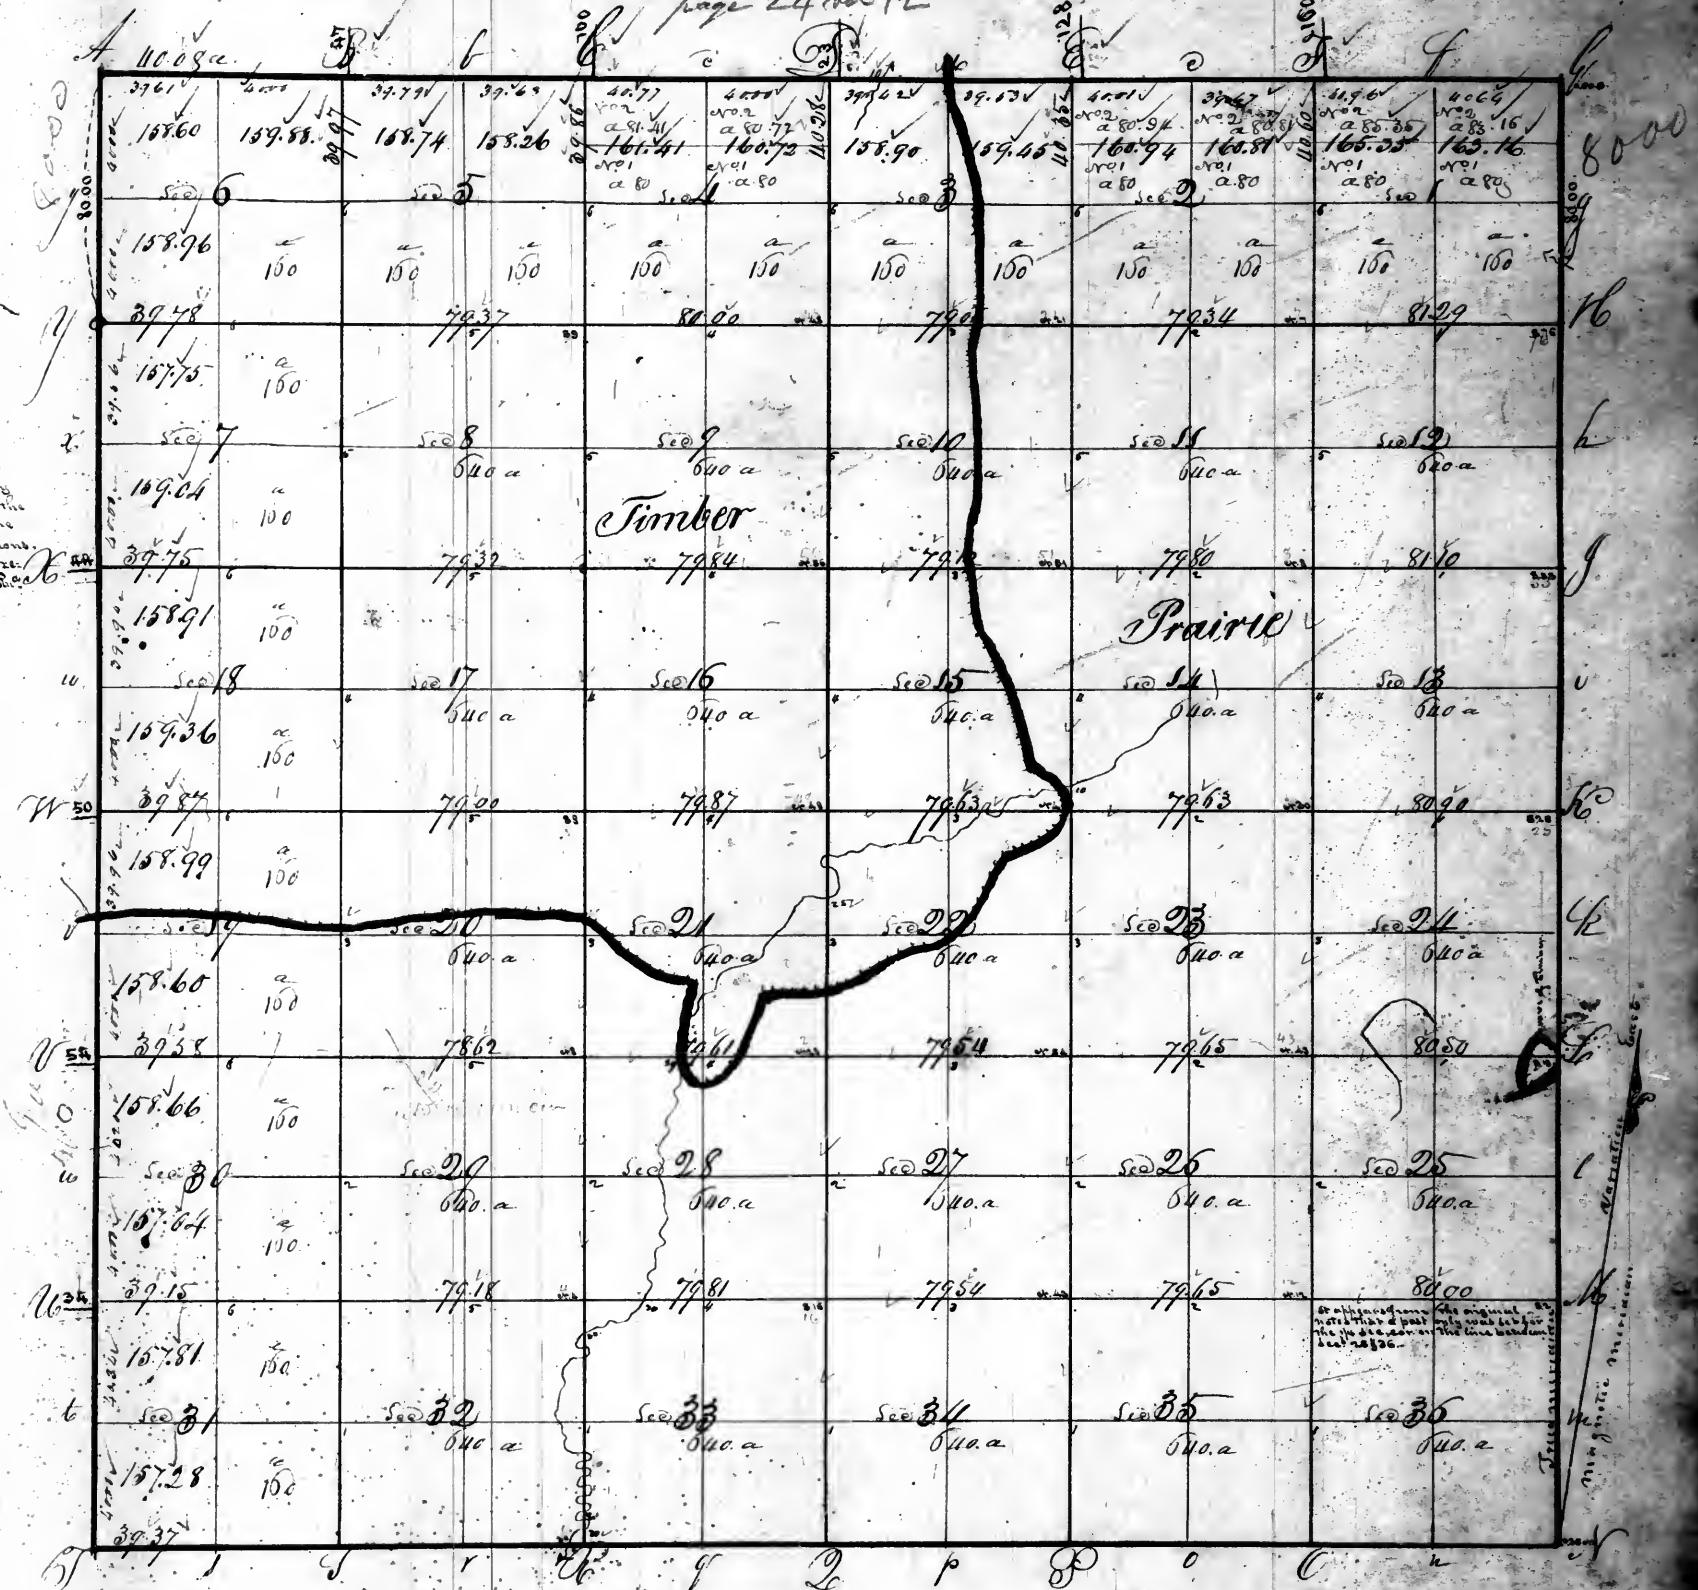



Pursuant to a contract with and instruction from William D. Surveyor of the Lands of the United States in the State of Illinois and Territory of Arkansas bearing date the fourteenth day of June 1823 I have administered and surveyed the above described Township and do hereby certify that it had such marks and boundaries both natural and artificial as are represented on said plat and described in the field notes made thereof and returned with this plat into the Office of the Surveyor of the Lands of the United States in the State of Illinois and Territory of Arkansas

certified this 25th day of October 1823

P. H. January D. Surveyor
Assisted by H. Rawls D. Surveyor

Recorded

Township N 25 North of the Base line Range N 1 West of the 3^d principal meridian
page 25 vol 12

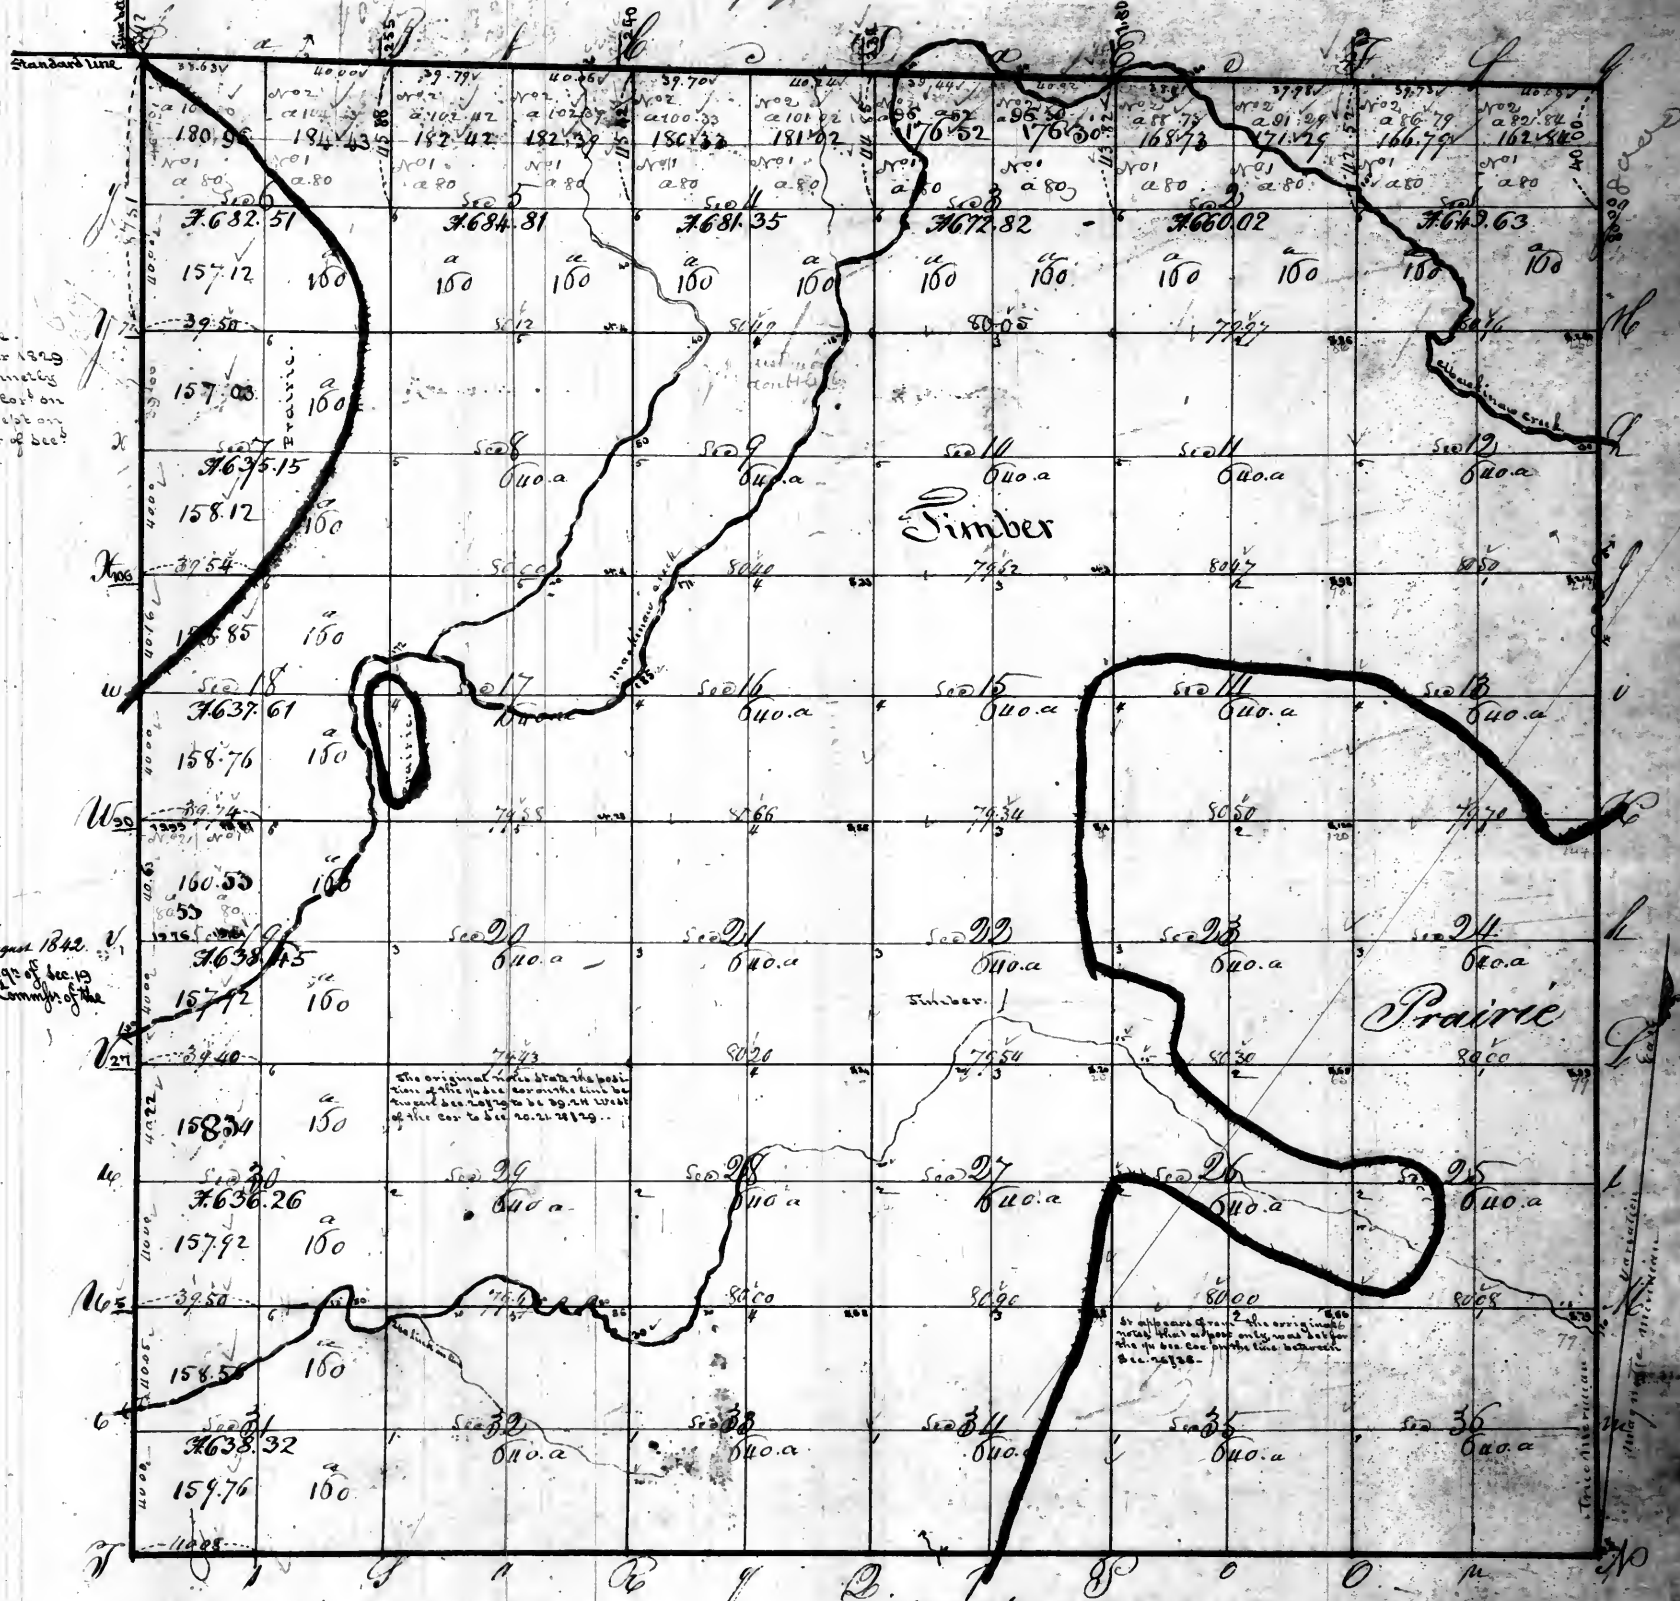

Aggregate area = 23216.93 acres

Pursuant to a contract with and instructing from William Peter Surveyor of the Land of the United States in the State of Illinois and Missouri and Territory of Arkansas bearing date the fourteenth day of June 1823 have administered said land and surveyed the above described Township and do hereby certify that it is such marks and boundry both natural and artificial as are represented on said plat and ascertained in the field noty made thereof in returnes with this plat into the office of the Surveyor of the Land of the United States in the State of Illinois and Missouri and Territory of Arkansas
Certified this 28th day of October

P. W. January D. Surveyor
Attested by H. K. Kelsch D. Surveyor

1823

Surveyors Office.
St. Louis 7th September 1823
The original notes do not distinctly
show the position of the 14 sec. east on
east and west lines, except on
lines between the Western tier of sec.
on the line between sec. 20 & 29.

Surveyors Office
St. Louis 10th August 1842.
Plat of the NW 1/4 of sec. 19
sent this day to the Commr. of the
Gen. & O.


The original notes state the position
of the 14 sec. east on the line between


Recorded

Page 26 vol 12

Township No. 26 North of the base line, Range No. 12 East of the Third Principal Meridian.

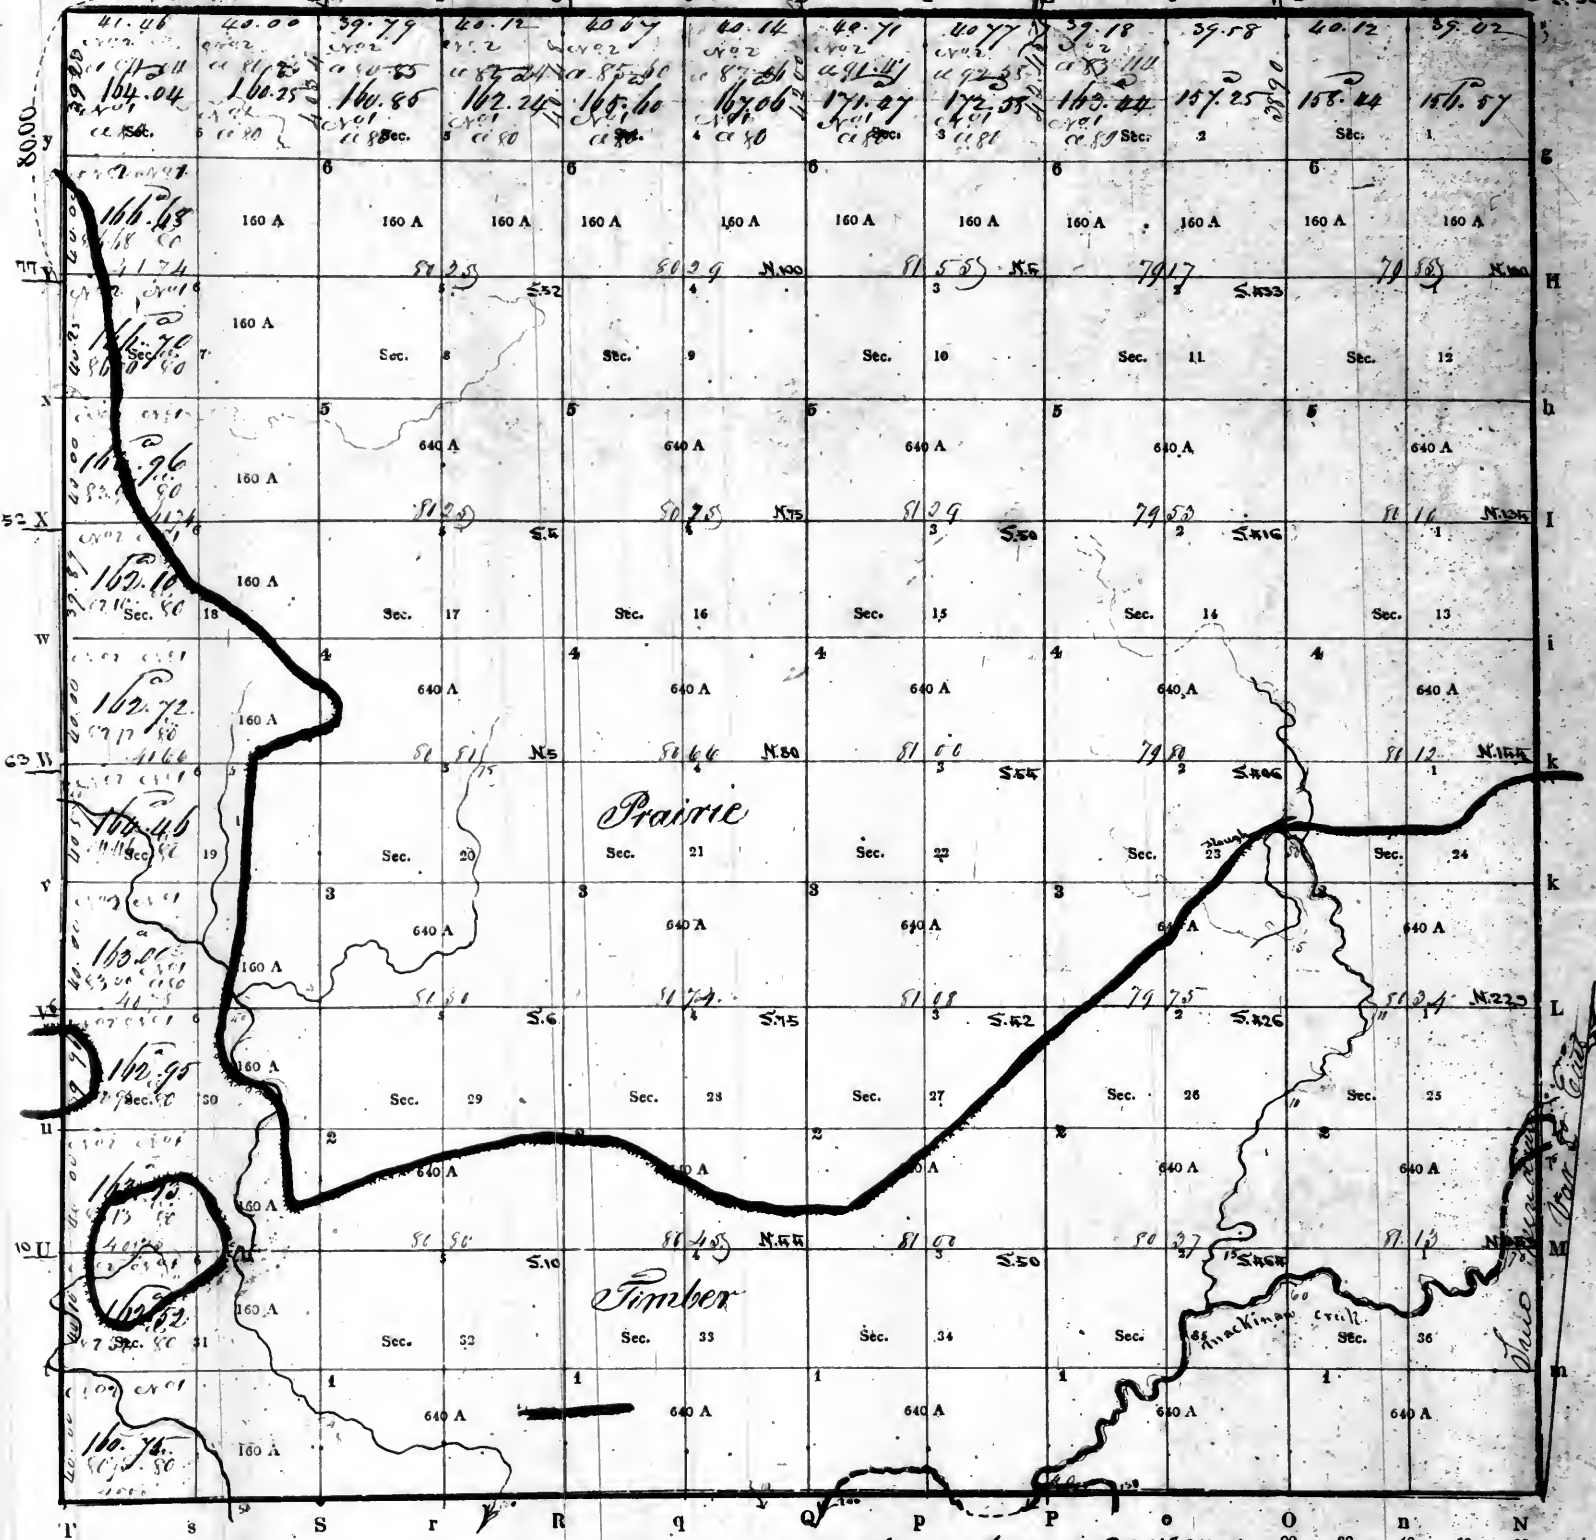

Aggregate area = 23118.75 ac

PURSUANT to a contract with, and instructions from William Rector, Surveyor of the lands of the United States in the bearing date the 15th day of June 1883 I have, admeasured, laid out and surveyed the above described Township; 

Certified this 19th day of March 1885

EXAMINED.


Wm. Clark

William M. D. SURVEYOR.

Recorded

page 27 vol 12

Township No. 27 North of the base line, Range No. 12 East of the third principal Meridian.

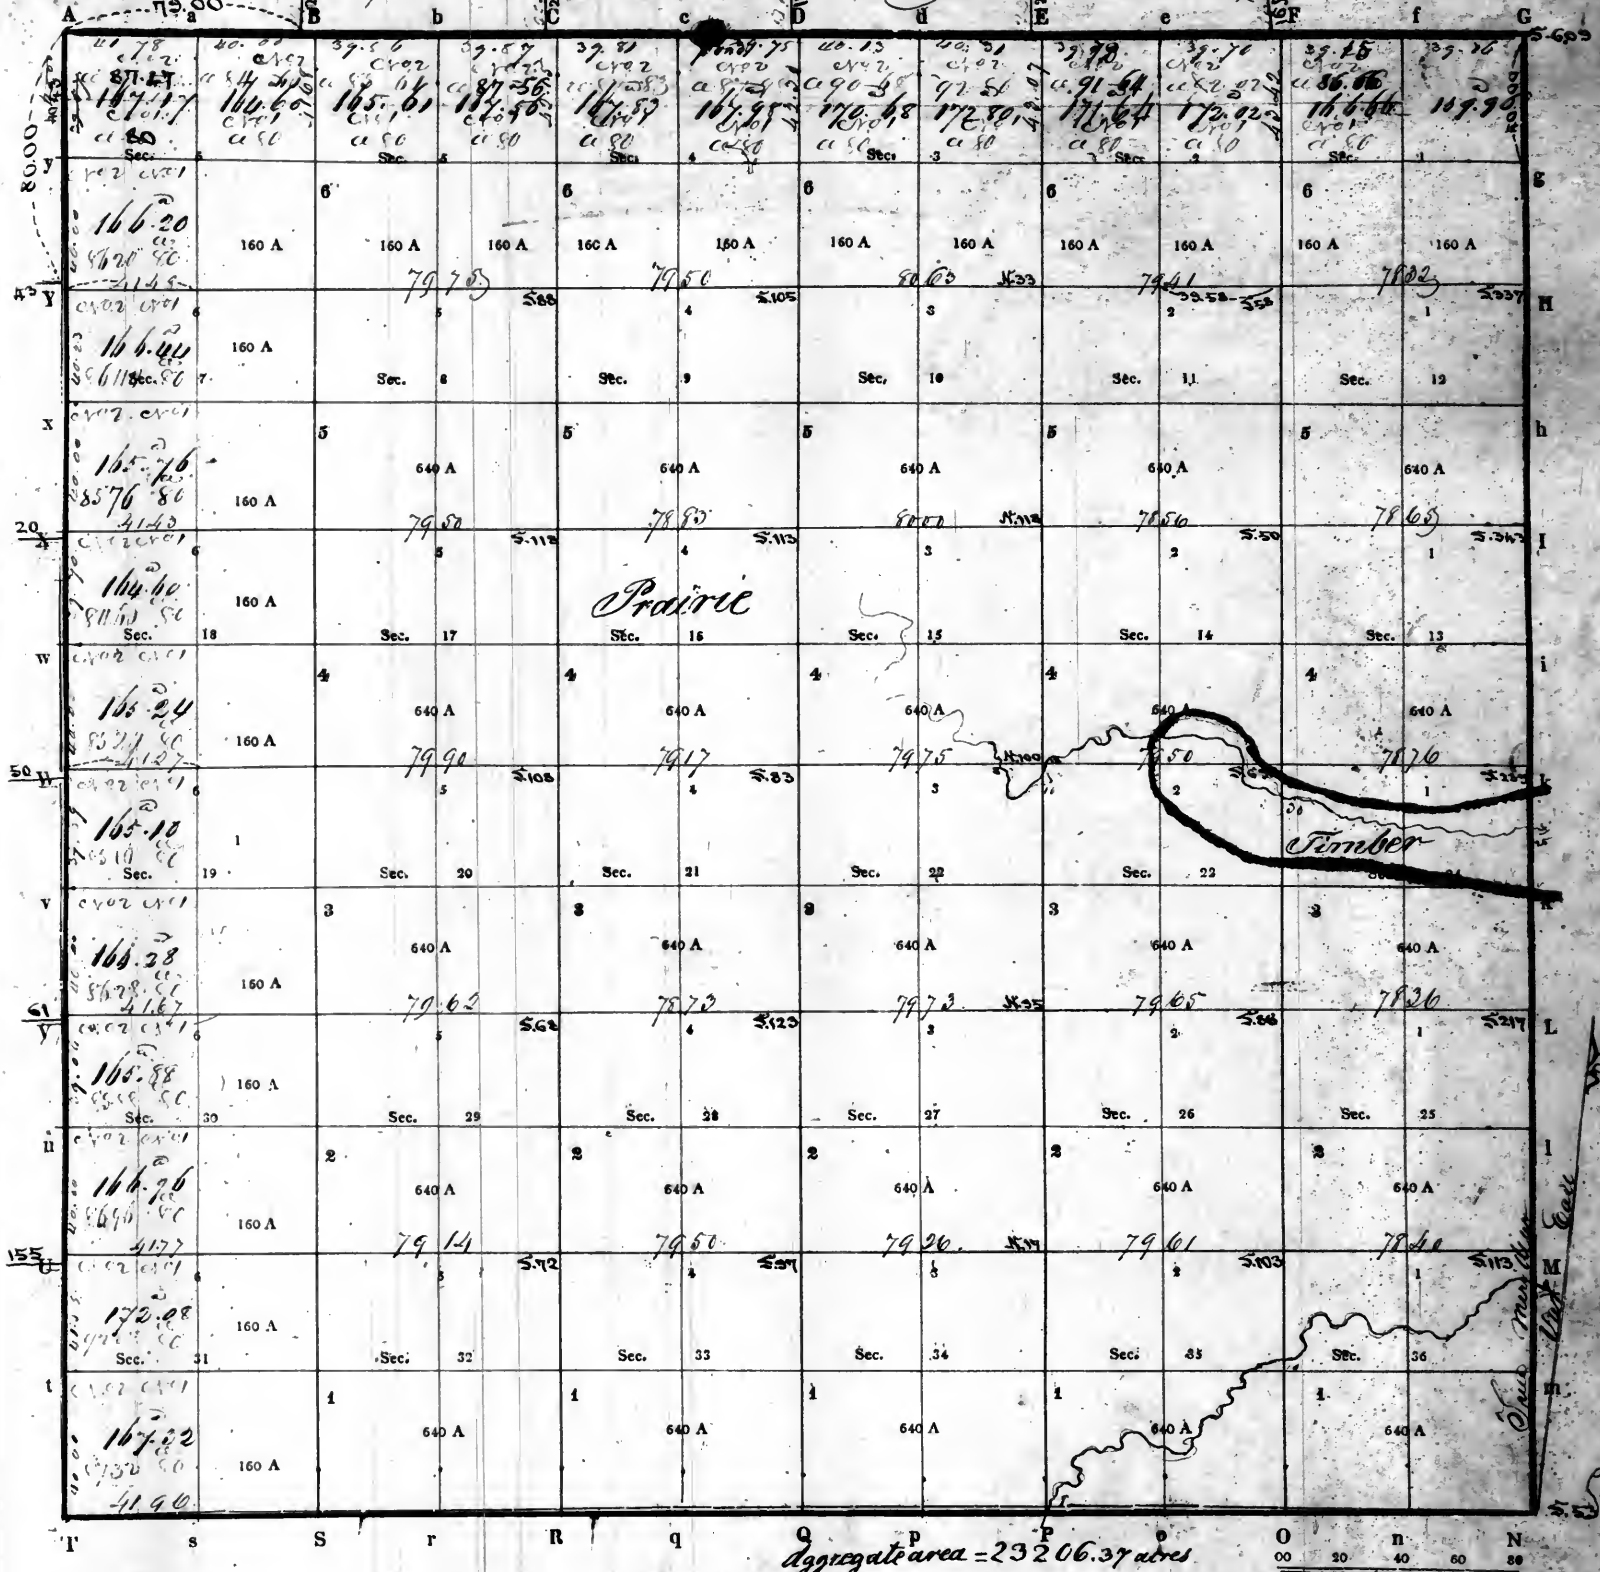

PURSUANT to a contract with, and instructions from William Reector, Surveyor of the lands of the United States in the State of Illinois and Missouri, bearing date the 15th day of June 1883, I have measured, laid out and surveyed the above described Township; and do hereby certify, that it had such marks and bounds, both natural and artificial, as are represented on said plat, and described in the field notes made thereof, and returned with this plat into the Office of the Surveyor of the Lands of the United States, in the State and Territory aforesaid.

Certified this 19 day of March 1885
EXAMINED.


Handwritten signature: H. Clark

Handwritten signature: W. M. Williams
D. SURVEYOR.

Recorded

Page 28 Vol 12

Township No. *Eight* of the base line, Range No. *one West* of the *third* principal Meridian.

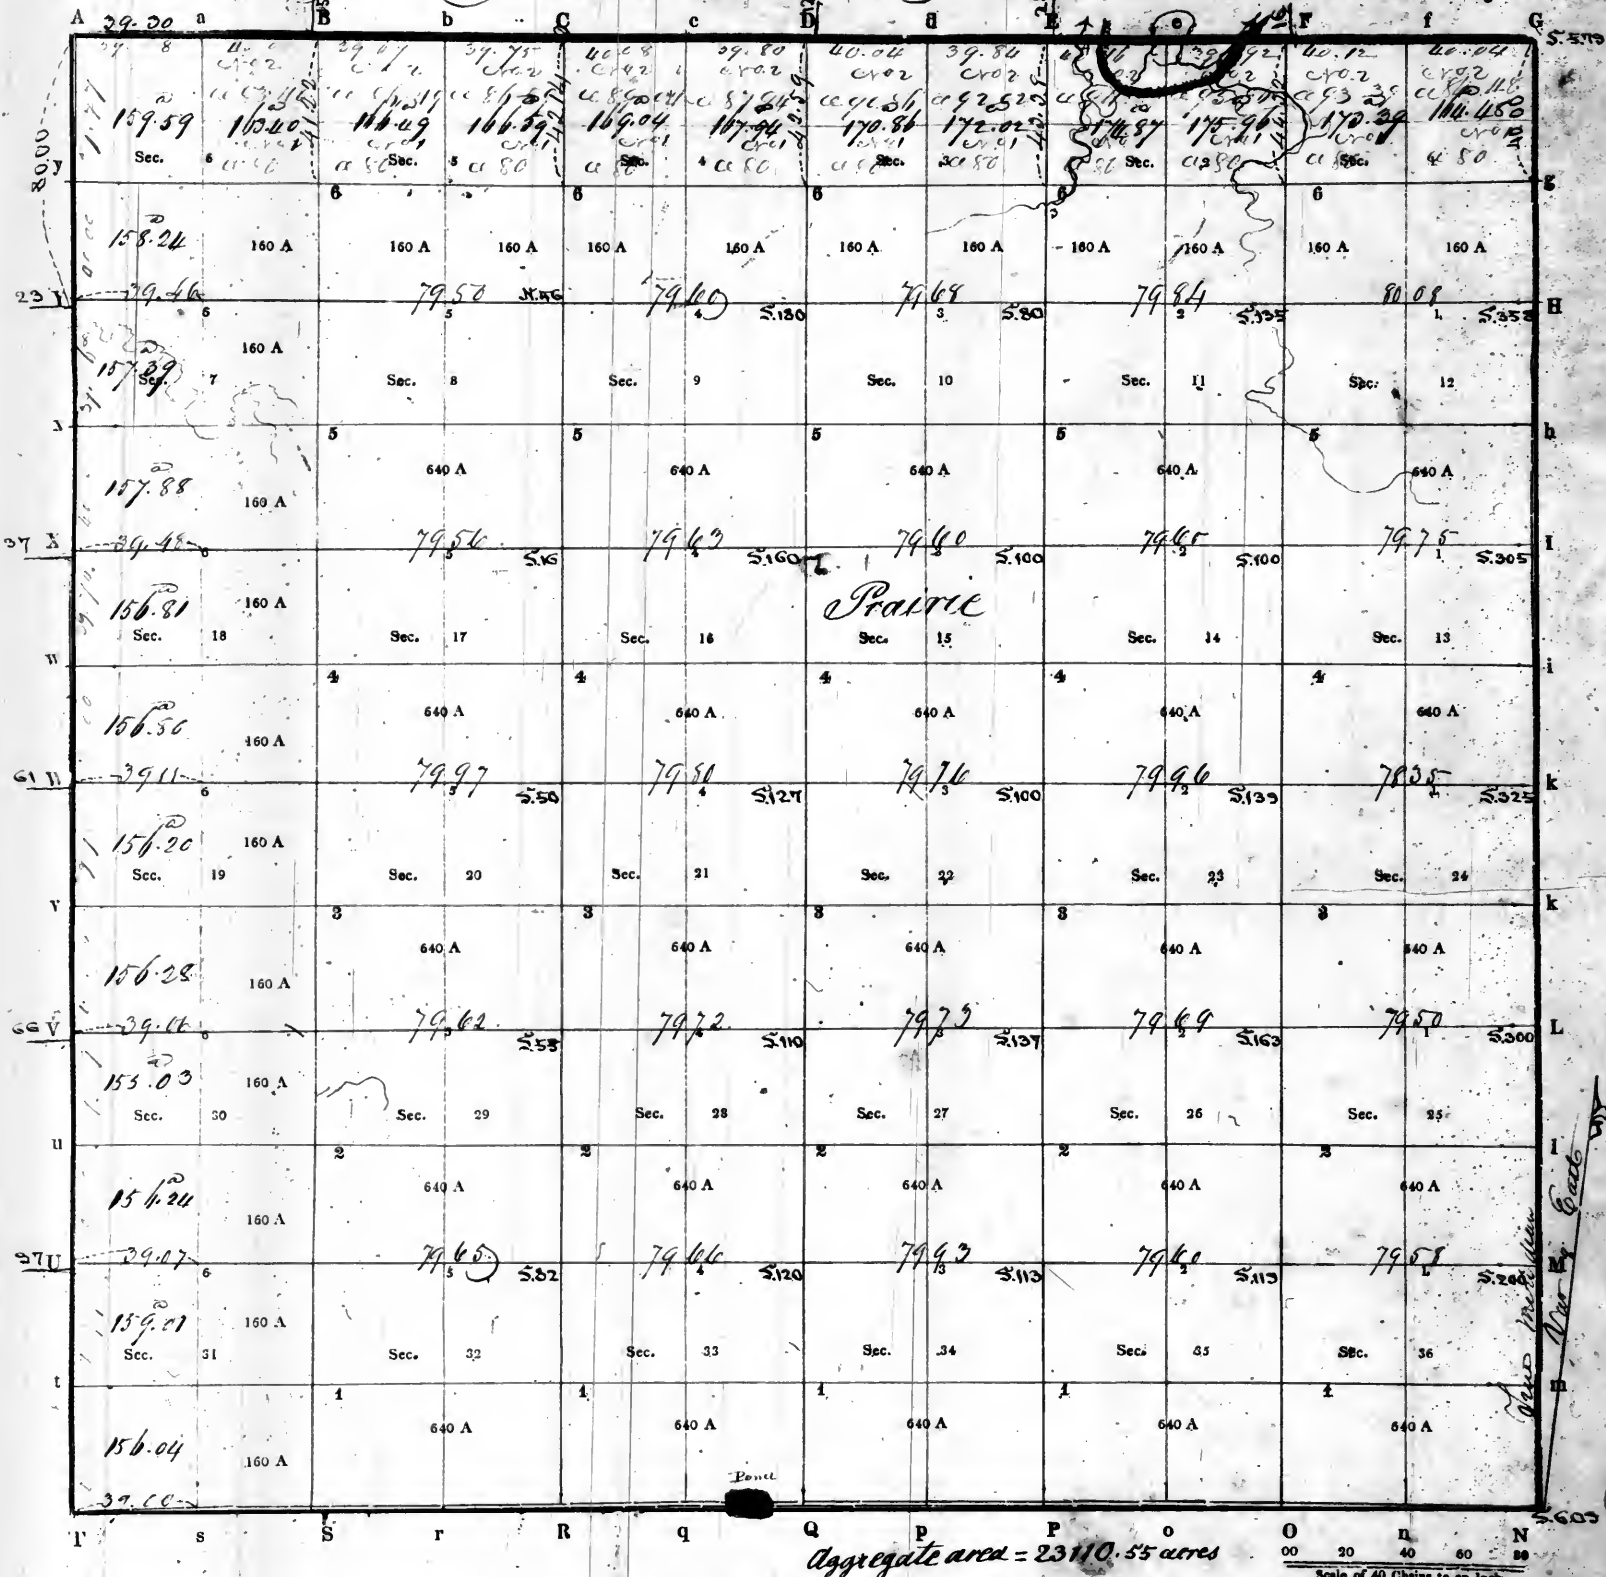

PURSUANT to a contract with, and instructions from William Rector, Surveyor of the lands of the United States in the State of Illinois, I have measured, laid out and surveyed the above described Township; and do hereby certify, that it had such marks and bounds, both natural and artificial, as are represented on said plat, and described in the field notes made thereof, and returned with this plat into the Office of the Surveyor of the Lands of the United States, in the State of Illinois and Territory of Arkansas.

Certified this 19 day of March 1855

EXAMINED.


Wm. Clark

William Williams, D. SURVEYOR.

Records

page 29 vol 12

Township No. *Twenty Nine* of the base line, Range No. *one* of the *third* principal Meridian.

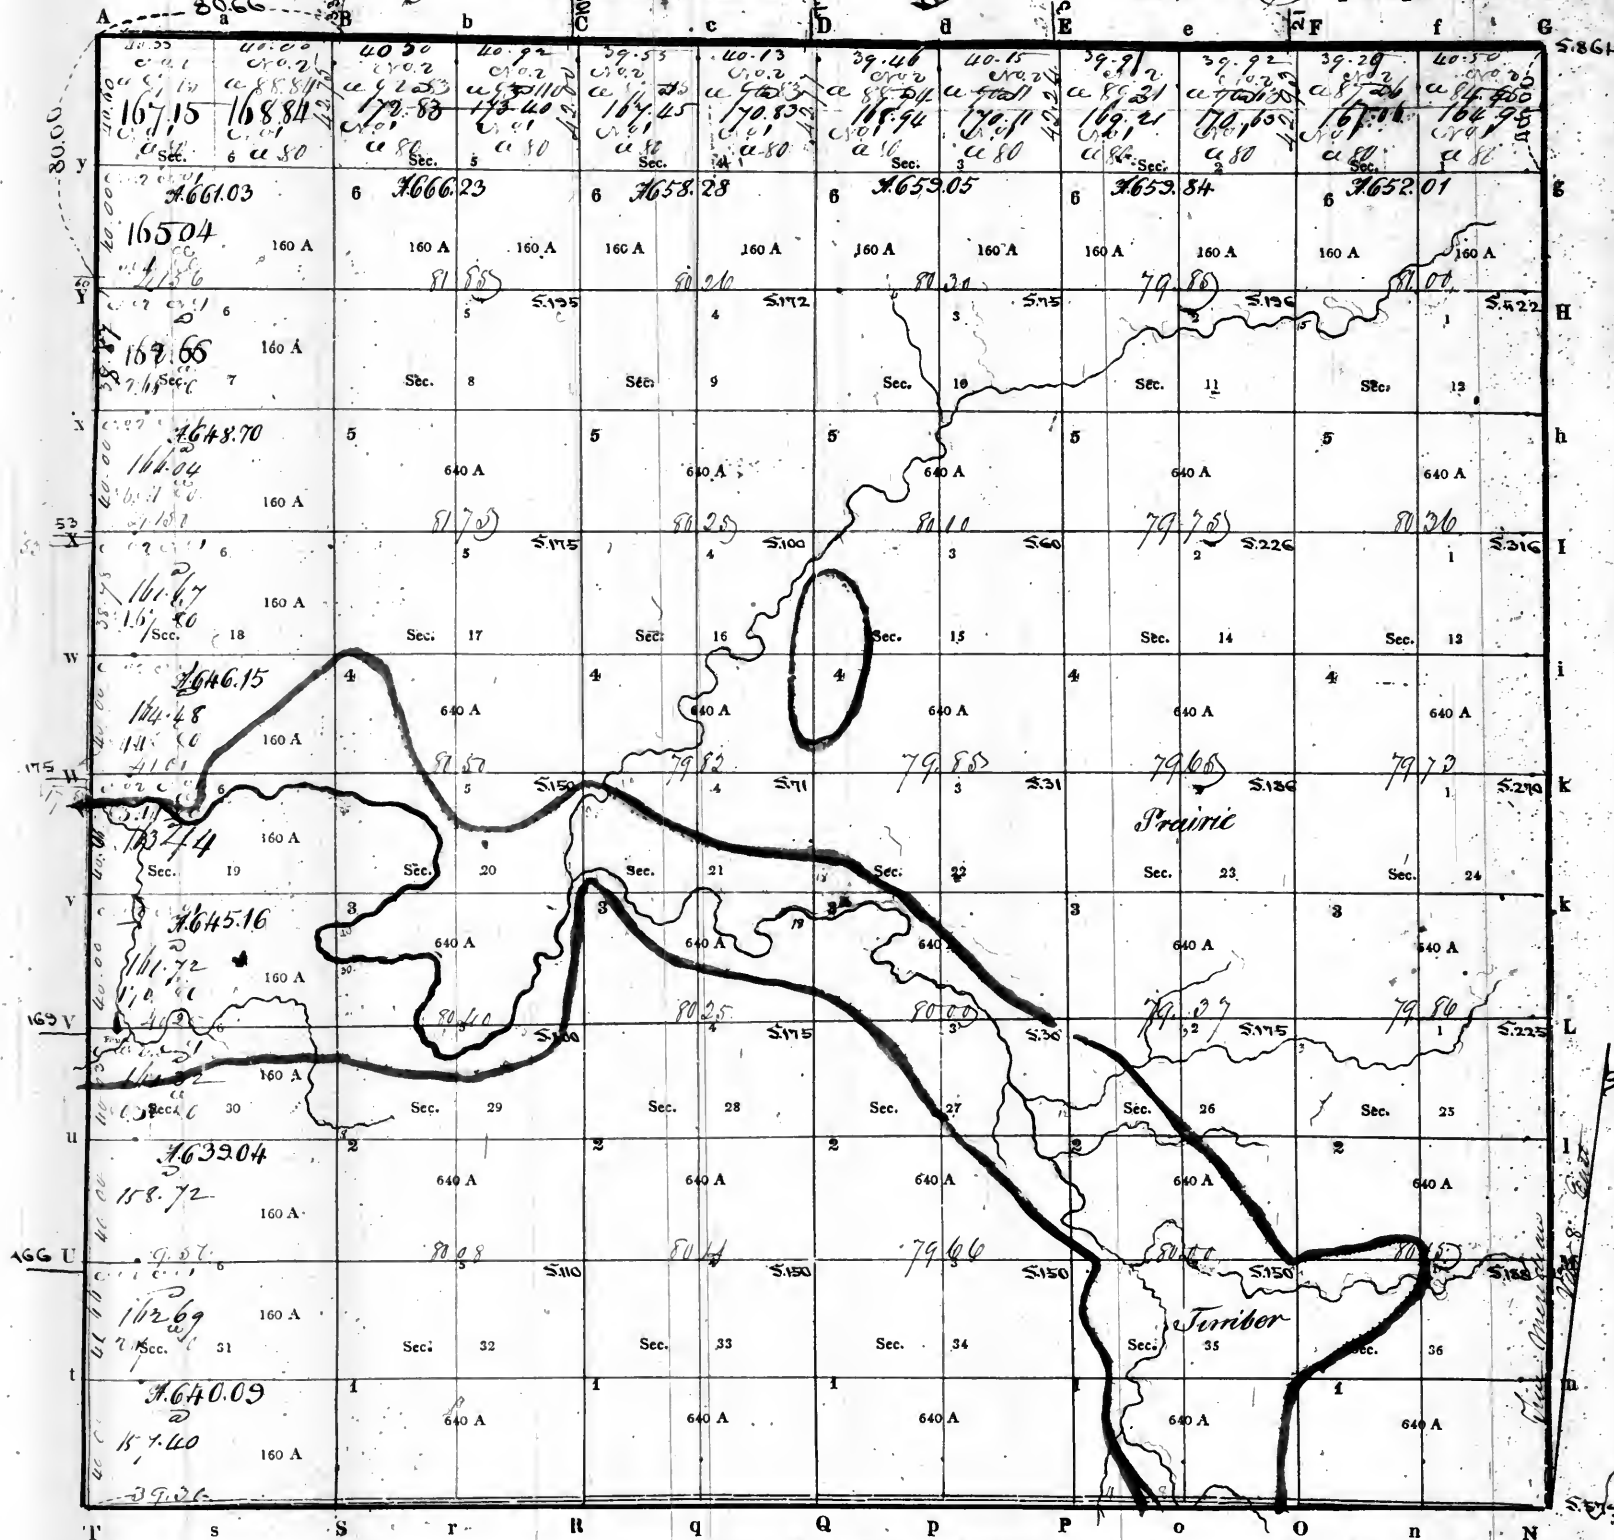

aggregate area = 23175.58 acres.

PURSUANT to a contract with, and instructions from William Rector, Surveyor of the lands of the United States in the State of Illinois and Territory of Arkansas, bearing date the *15th* day of *June* 1883, I have measured, laid out and surveyed the above described Township; and do hereby certify, that it had such marks and bounds, both natural and artificial, as are represented on said plat, and described in the field notes made thereof, and returned with this plat into the Office of the Surveyor of the Lands of the United States, in the State of Illinois and Territory of Arkansas.

Certified this *19th* day of *March* 1883


EXAMINED.

Wm. Clark

William M. D. SURVEYOR.

Record

Townships N 30 North of the Base line Range N 4 West of the 8th Principal Meridian
page 30 and 17

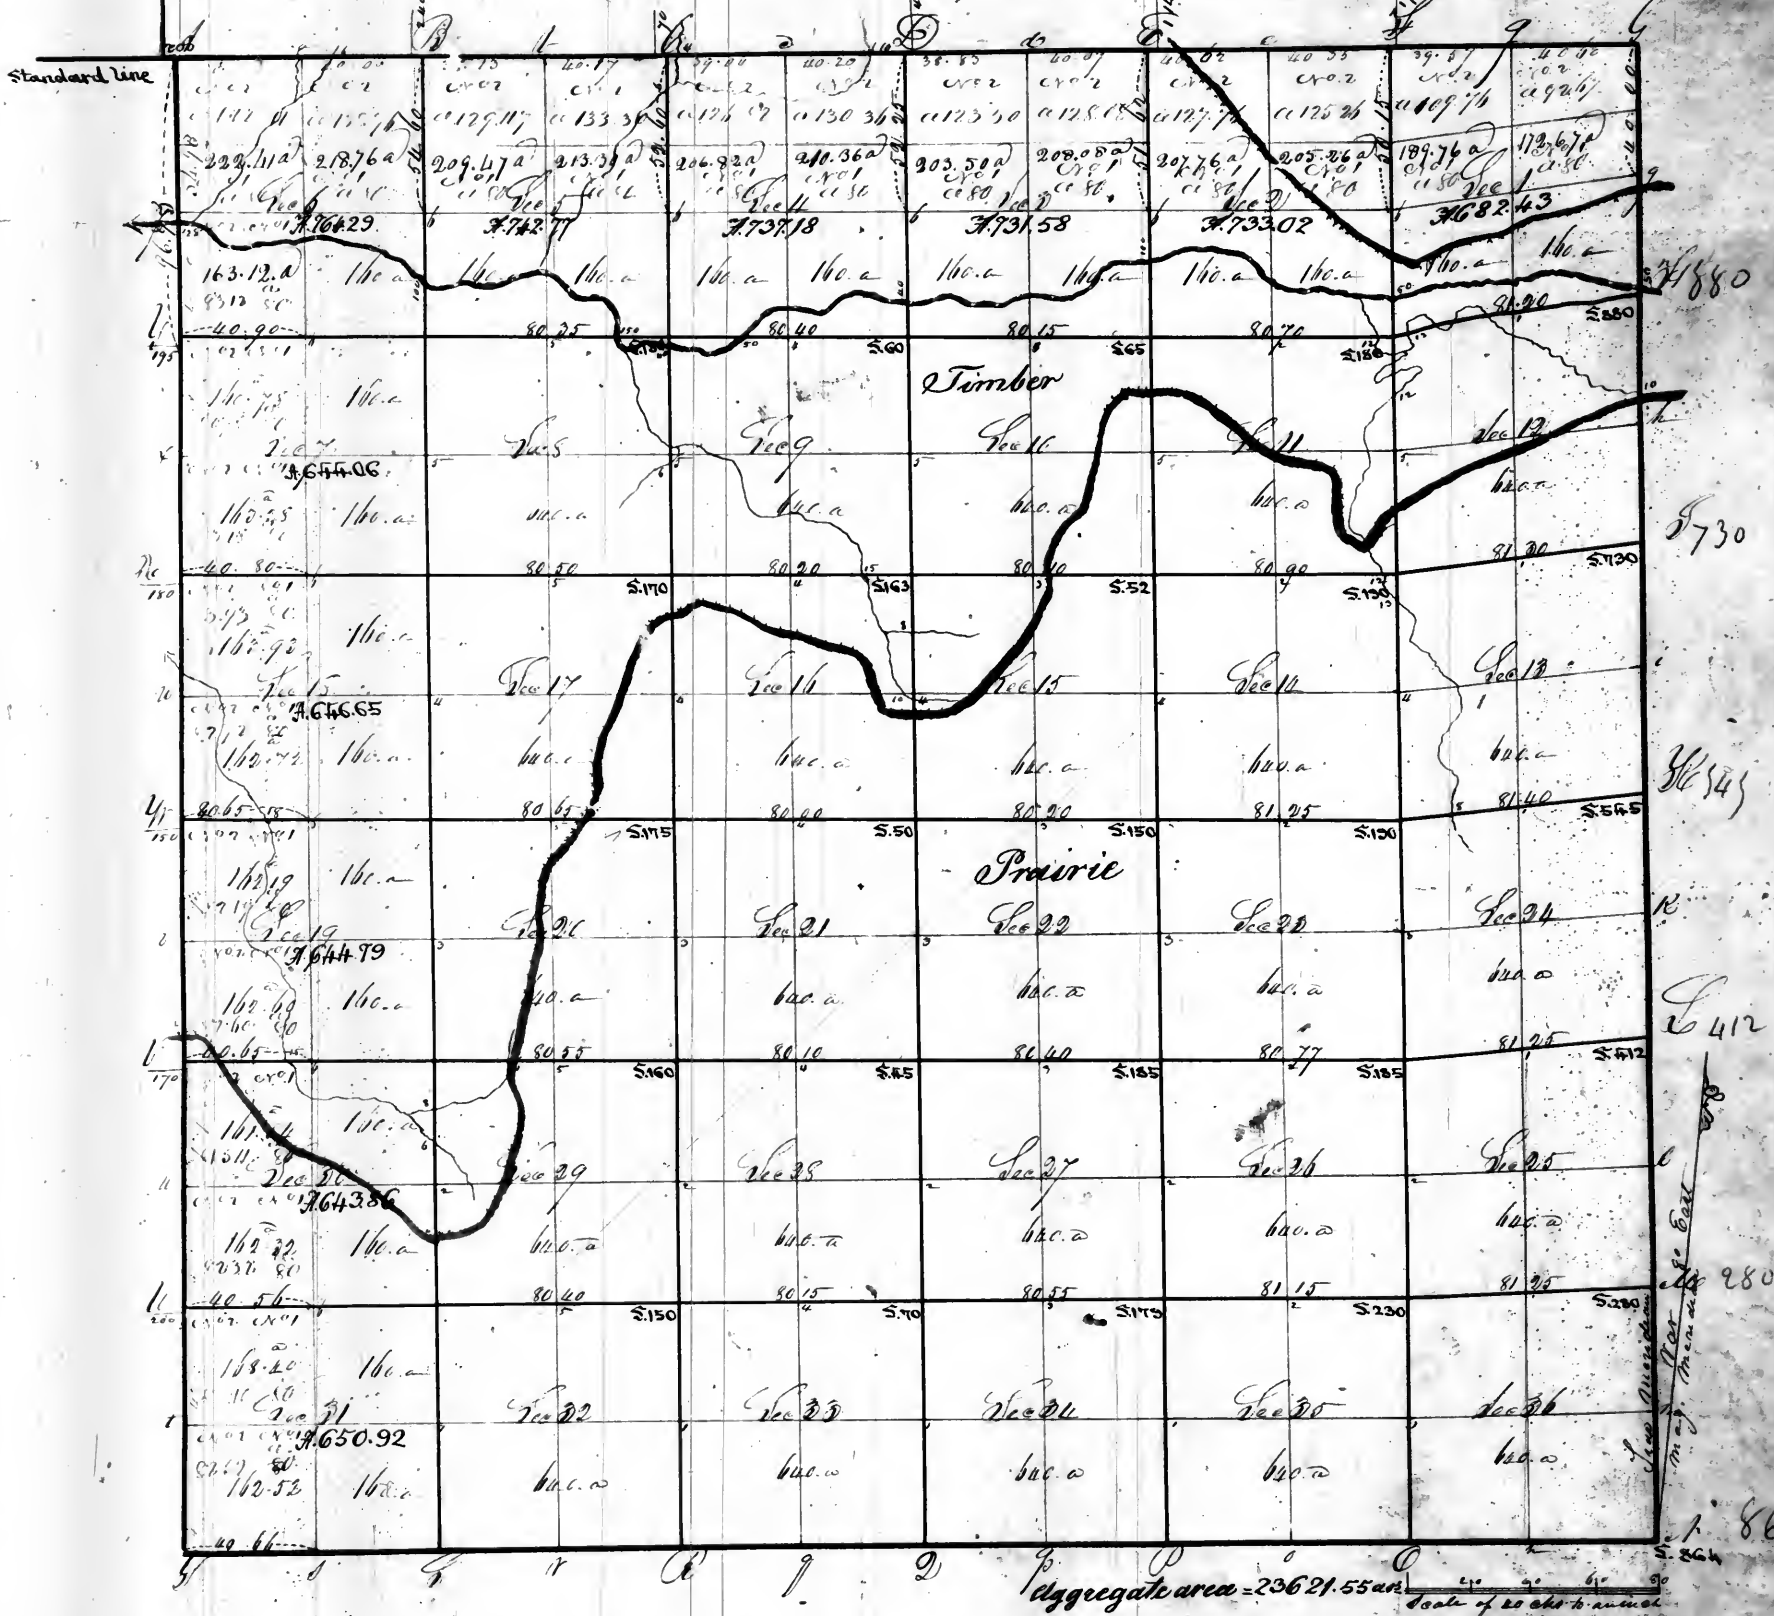

In pursuance to a Contract with and instructions from William Peter Surveyor of the lands of the United States in the State of Illinois and Missouri and Territory of Arkansas bearing date the 15th day of June 1823 I have (with the assistance of Daniel Murphy D.C.) advertised and laid out and surveyed the above described Township and do hereby certify that it has been marked and bounded both natural and artificial as are represented on said plat and described in the field notes made thereof and returned with this plat into the office of the Surveyor of the lands of the United States in the State of Illinois and Missouri and Territory of Arkansas


Witnessed this 19th day of March 1825-

Wm Clark

William William Deputy Surveyor

page 3/val 12

Township No. 34 North of the base line, Range No. 1 West of the 3d principal Meridian.

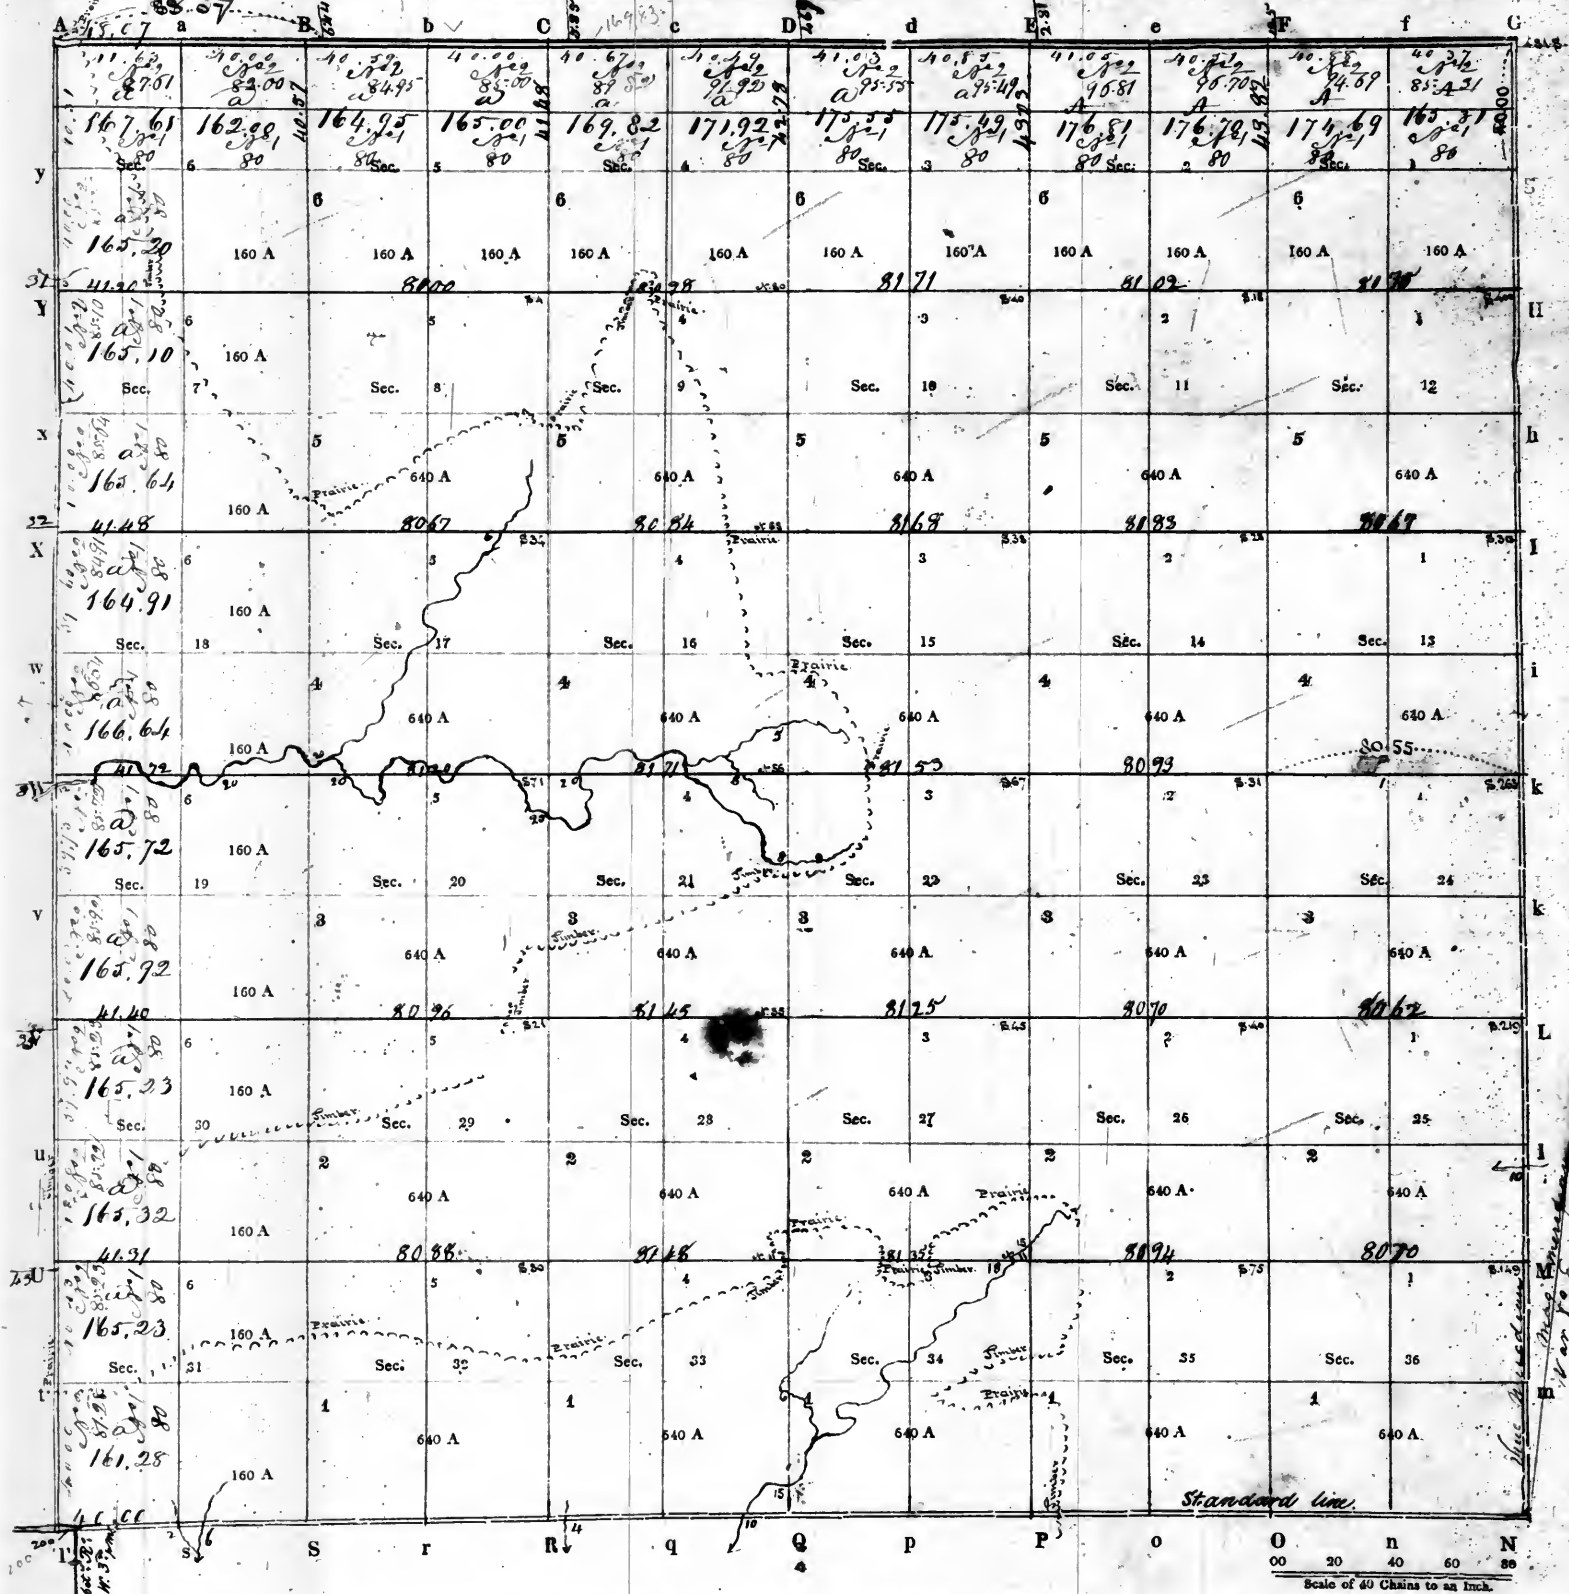

PURSUANT to a contract with, and instructions from William Rector, Surveyor of the lands of the United States in the States of Illinois and Missouri and Territory of Arkansas, bearing date the 20 March day of 1821, I have measured, laid out and surveyed the above described Township; and do hereby certify, that it had such marks and bounds, both natural and artificial, as are represented on said plat, and described in the field notes made thereof, and returned with this plat into the Office of the Surveyor of the Lands of the United States, in the States of Illinois and Missouri and Territory of Arkansas.

Certified this day of 1821


EXAMINED.

Surveyed by Nelson Pappas - SURVEYOR.

October 1821

3

Page 32 vol 12
No. 2 One West

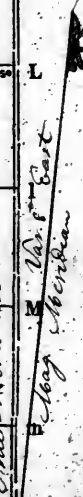


0 20 40 60 80
Scale of 40 Chains to an Inch

State of Illinois and
day of March — 1881

182

Surveyed by Nelson Pepper D. SURVEYOR

Sectional Township N. 33 North of the Base line Range N. 1 West of 3^d Principal Meridian
page 33 vol 12

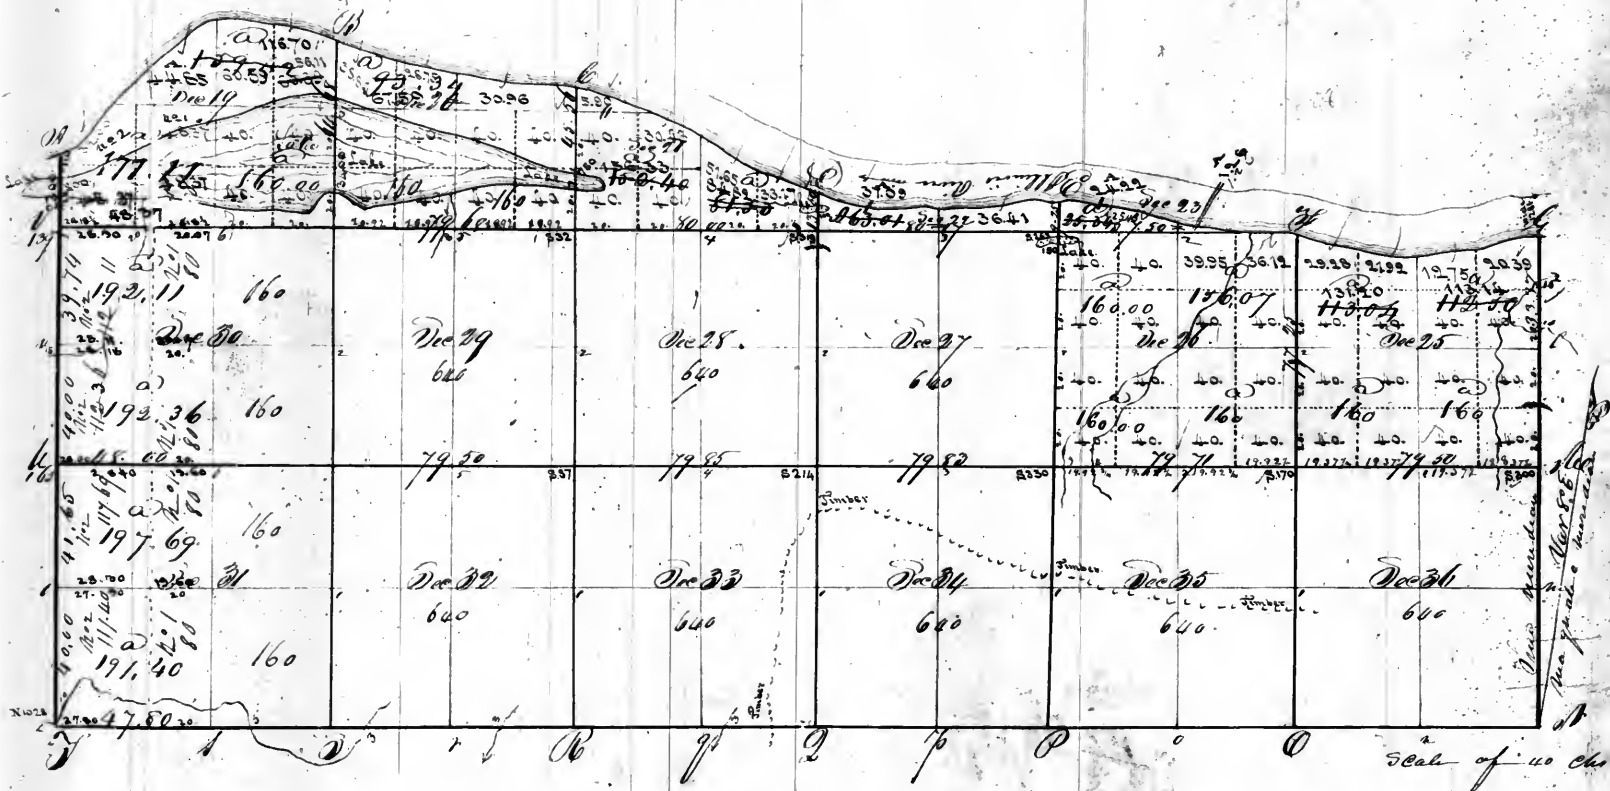

7332218
6062417
443

Pursuant to a Contract with and instructions from William Pickett Surveyor of the lands of the United States in the States of Missouri and Illinois and Territory of Arkansas bearing date the twentieth day of March 1821/60. I have administered laid out and surveyed the above described Township and do hereby Certify that it had such marks and bounds both natural and artificial as are represented on said and described in the field notes made thereof and returned with this plat into the Office of the Surveyor of the lands of the United States in the States of Missouri and Illinois and Territory of Arkansas


Certified this day of

Examined

Surveyed by Meldon Peppas D. Survey
November 1821

Record

45 Township N. 1 North of the Base line Range 2 West of the 3^d Principal Meridian

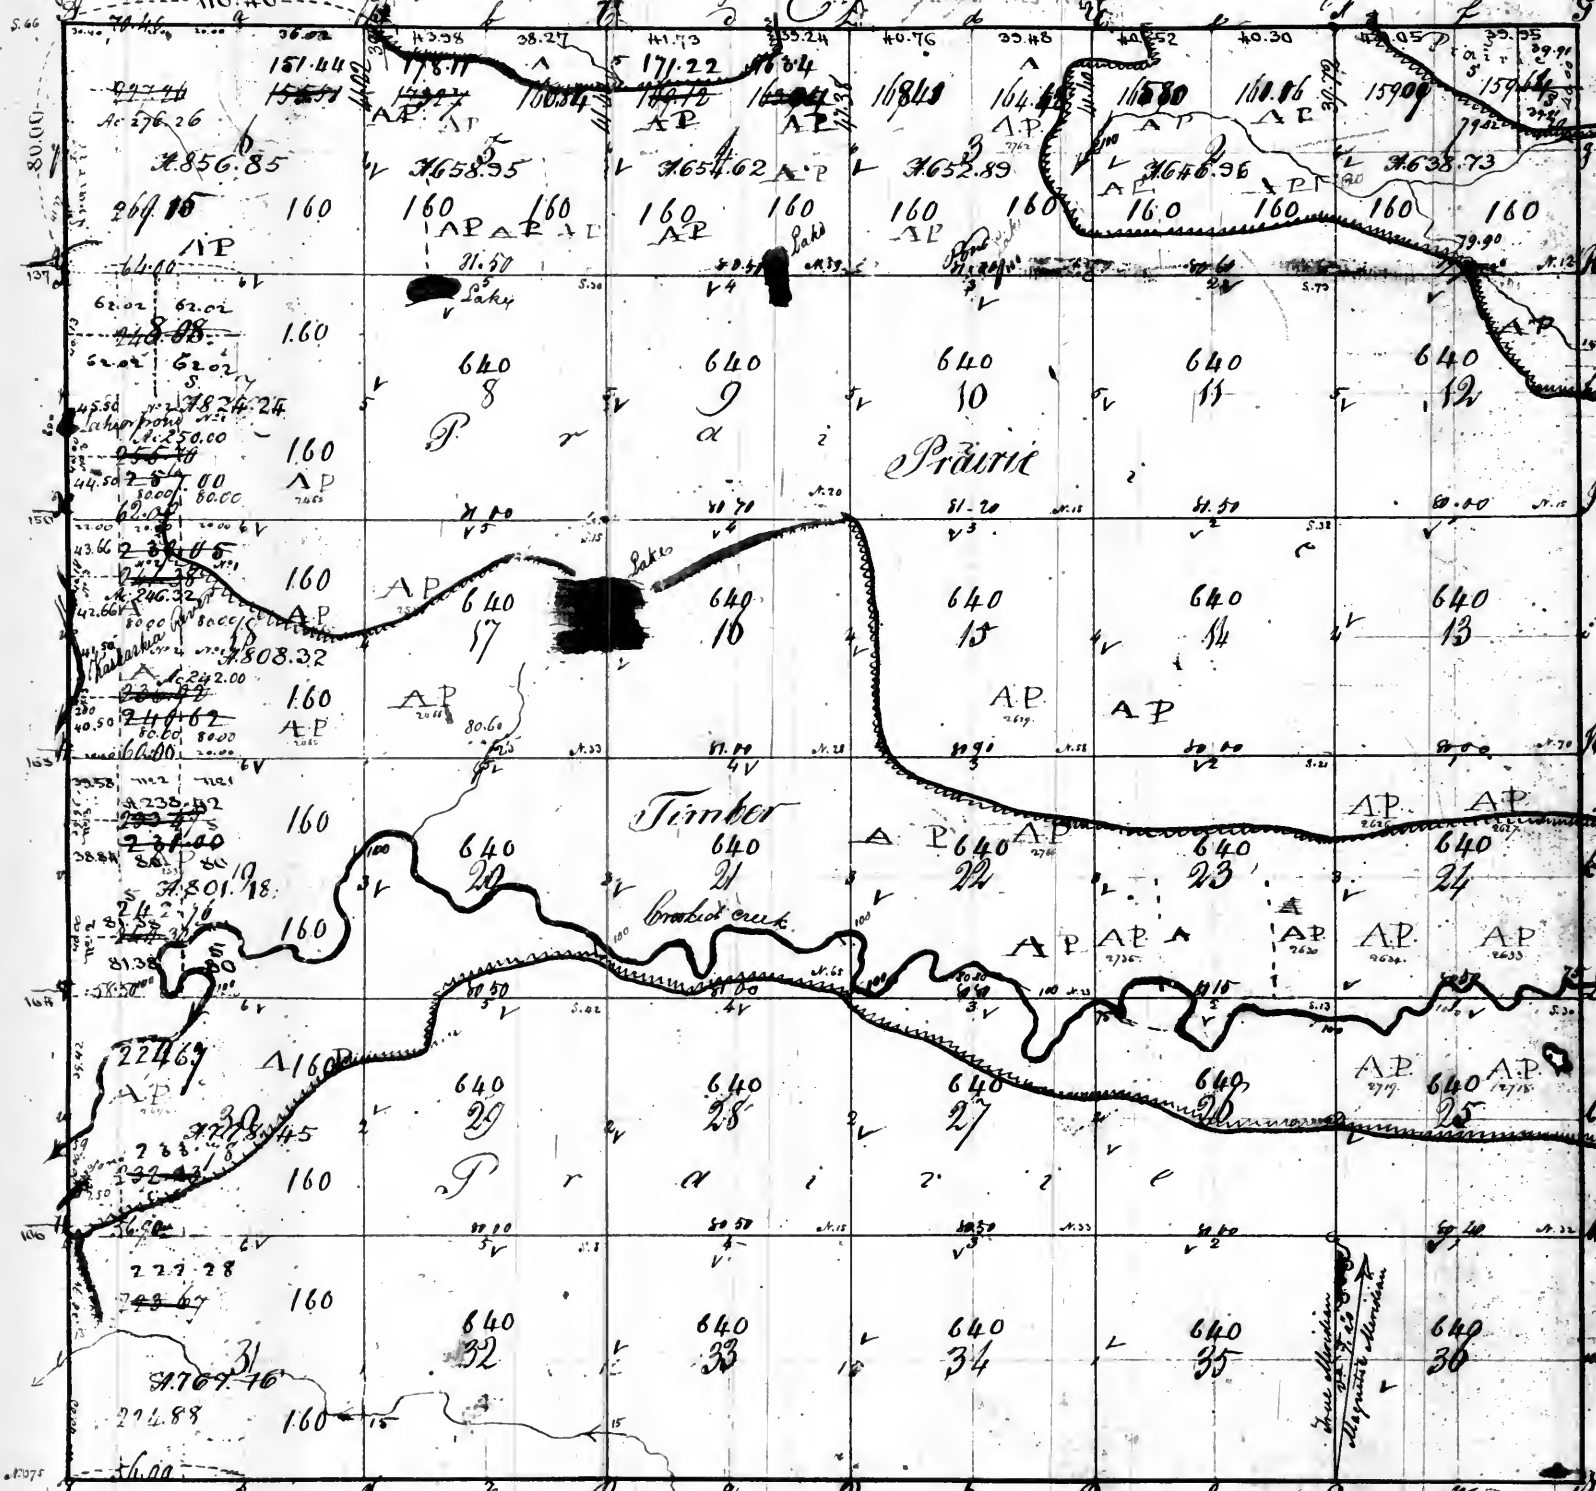

Reference to the field notes of the survey of this town, which the lines of this plat have been examined and corrected, of the South boundary in Sublot 12 of the West boundary in Sublot 40, of the North and East boundaries and Sublot 12 in Sublot 45.



Pursuant to a contract, with and instructions from Josiah M. Smith, Esq. Surveyor General of the State of Missouri, bearing date the 8th day of June 1854, I have advanced laid out and surveyed, the above described Township, and do hereby certify, that it had such marks, and bounds, both natural and artificial as are represented on said plat, & described, in the field notes made thereof, & returned, with the plat into the Surveyor General's Office

Certified this 20th day of April A.D. 1855

Surveyor's Office
St. Louis

The lines of the above plat of Town 1 North of the base line in Range 2 West of the 3^d principal Meridian have been examined by the notes of the survey thereof referred to in the margin and corrected conformably therewith.

Township No 3 North Range 2 West of the 3rd Principal Meridian

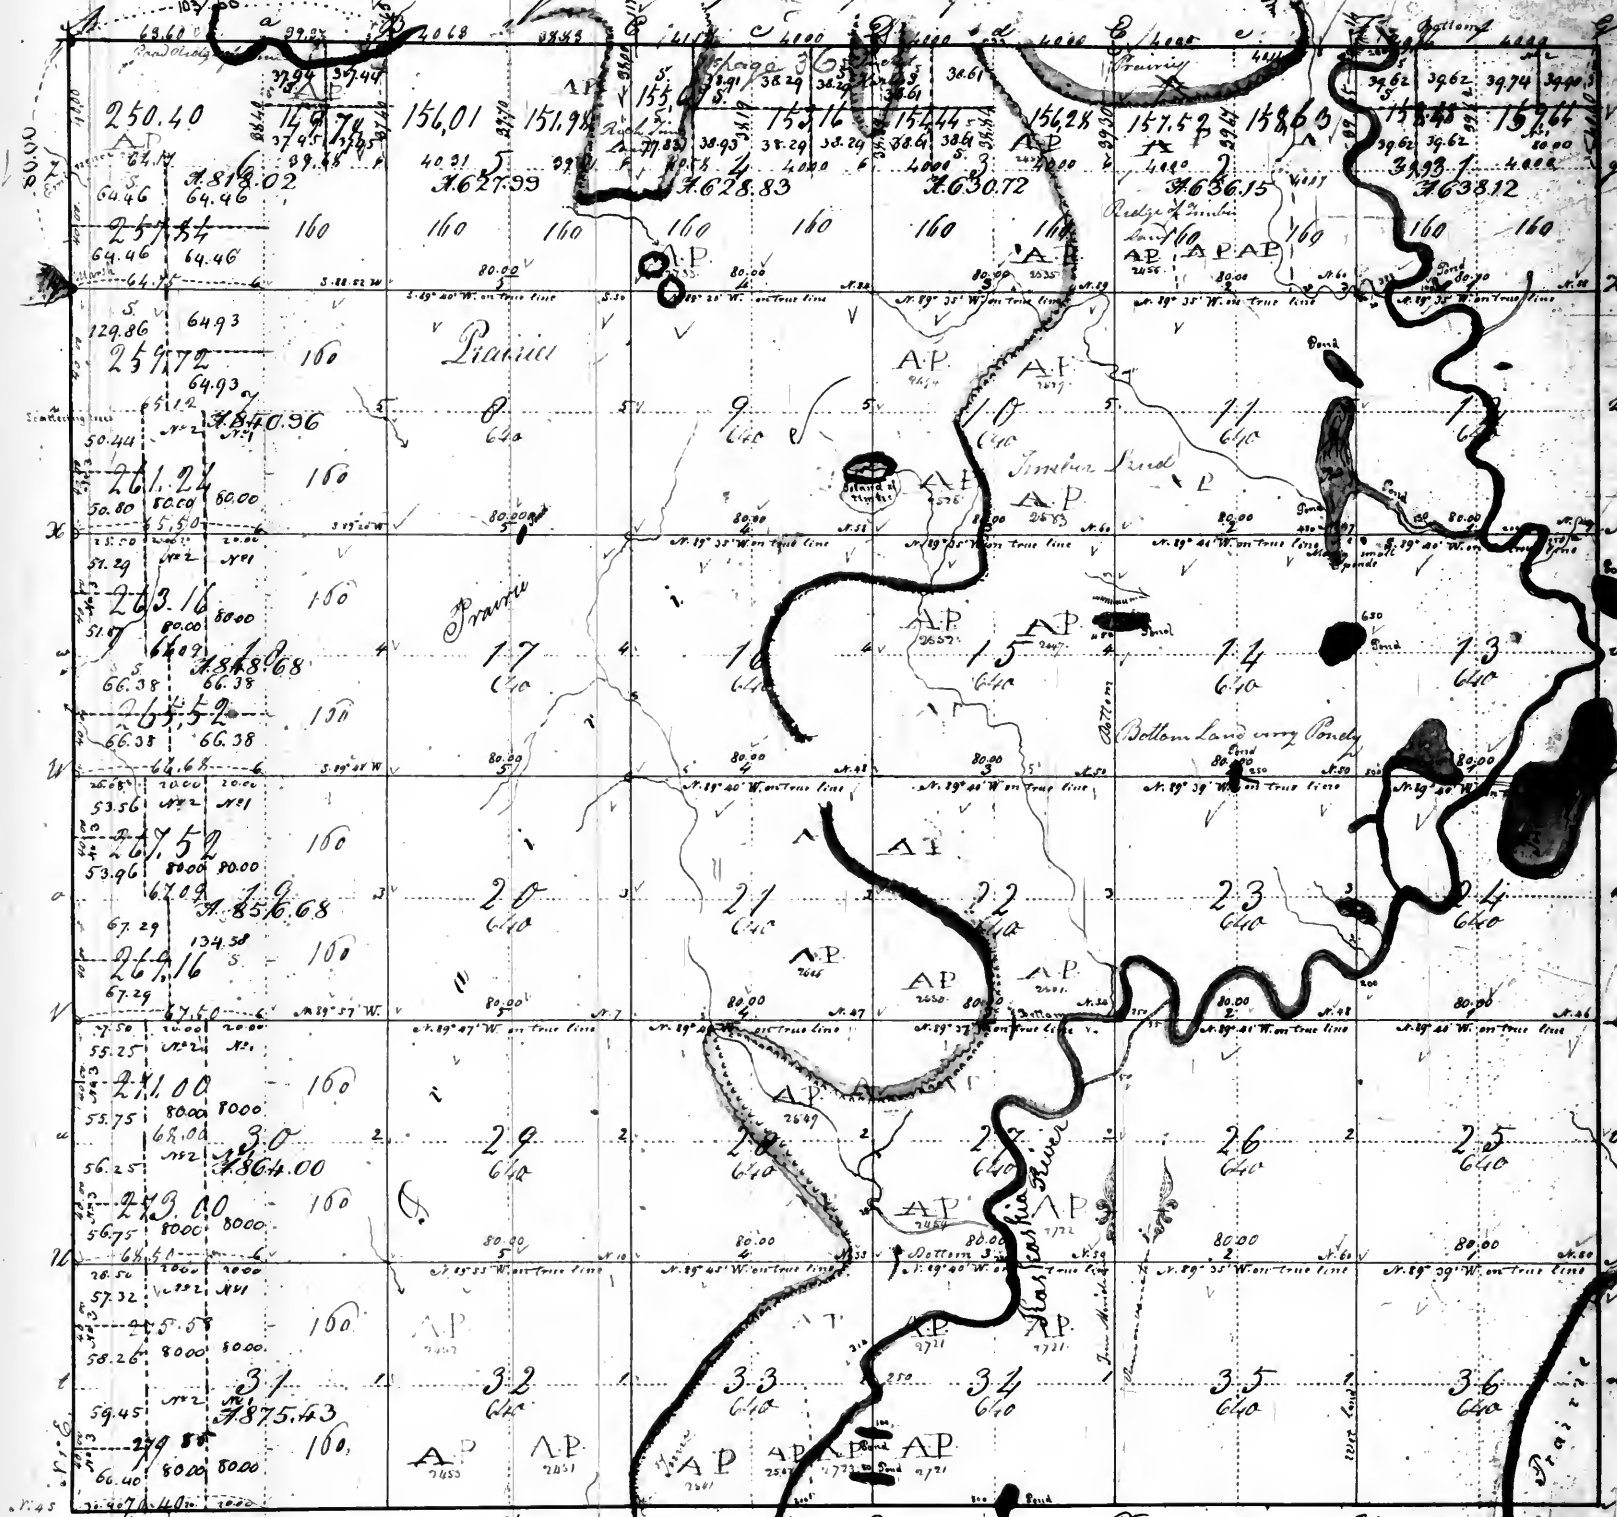

Reference to the field notes of the Survey of this Township by which the lines of this plat have been examined and corrected of the West boundary on field book 48 of the North boundary in field book 49 of the East and North boundaries and field notes in field book 48 -

Note: The true line between Sec. 12 & 13 is stated on the field notes thereof to have been run S. 29° 40' W. although the falling of the random line between said Sections was 2.49 links from the Sec. corner on Range line.

The field notes of the survey of this Township are not referring to a meridian.

Variation, +20' East North & West, and 8' West all the other lines 8' East.

Office of the Surveyor General for the State of Missouri, Saint Louis July 18th 1857

The North East quarter of section 4, the South West quarter of section 7, the North West quarter of section 10 & 19, and the West half of sections 30 & 31, subdivided under the act of Congress of the 5th of August 1832, - all the North West quarter of sections 1, 3 & 7, the South half of section 14, the North East quarter of section 6, and the South East quarter of sections 6, 18 & 19, which were sold to conform to measures under laws, 51, and a plan of the Register and under the Commission of the General Land Office same day.

Aggregate area = 24265.58 acres

Pursuant to a Contract with and instructions from Josiah Meigs Surveyor General of the United States bearing date the 20th day of September 1841, I have examined laid out and surveyed the above described Township and do hereby certify that it had such marks and bounds both natural and Artificial as are represented on said Plat and described on the field notes taken thereof and returned into the Plat into the Surveyor General's Office - Certified the 20th day of June 1846



J. Meisinger, Deputy Surveyor

Surveyor's Office
St. Louis 9th of December 1841.

The lines of the above plat of Township 3 North of the base line in Range 2 West of the 3rd principal Meridian, are exactly conformable to the field notes of the survey thereof on file in this office, which have been examined and approved. The south boundary 6 miles 30.40 chains, was surveyed in February, 1815, by John Milton Moore, under the Contract of William Rector and Elias Rector of the 6th June 1814 - The west boundary 6 miles, was surveyed in March 1815 - The east boundary 6 miles - the north boundary 6 miles and 20 chains - and the subdivision lines were surveyed in February 1816, all by John Meisinger, under contract of the 20th September 1814

Jos. C. Brown
Surveyor of the public lands for
the District of Missouri

Record

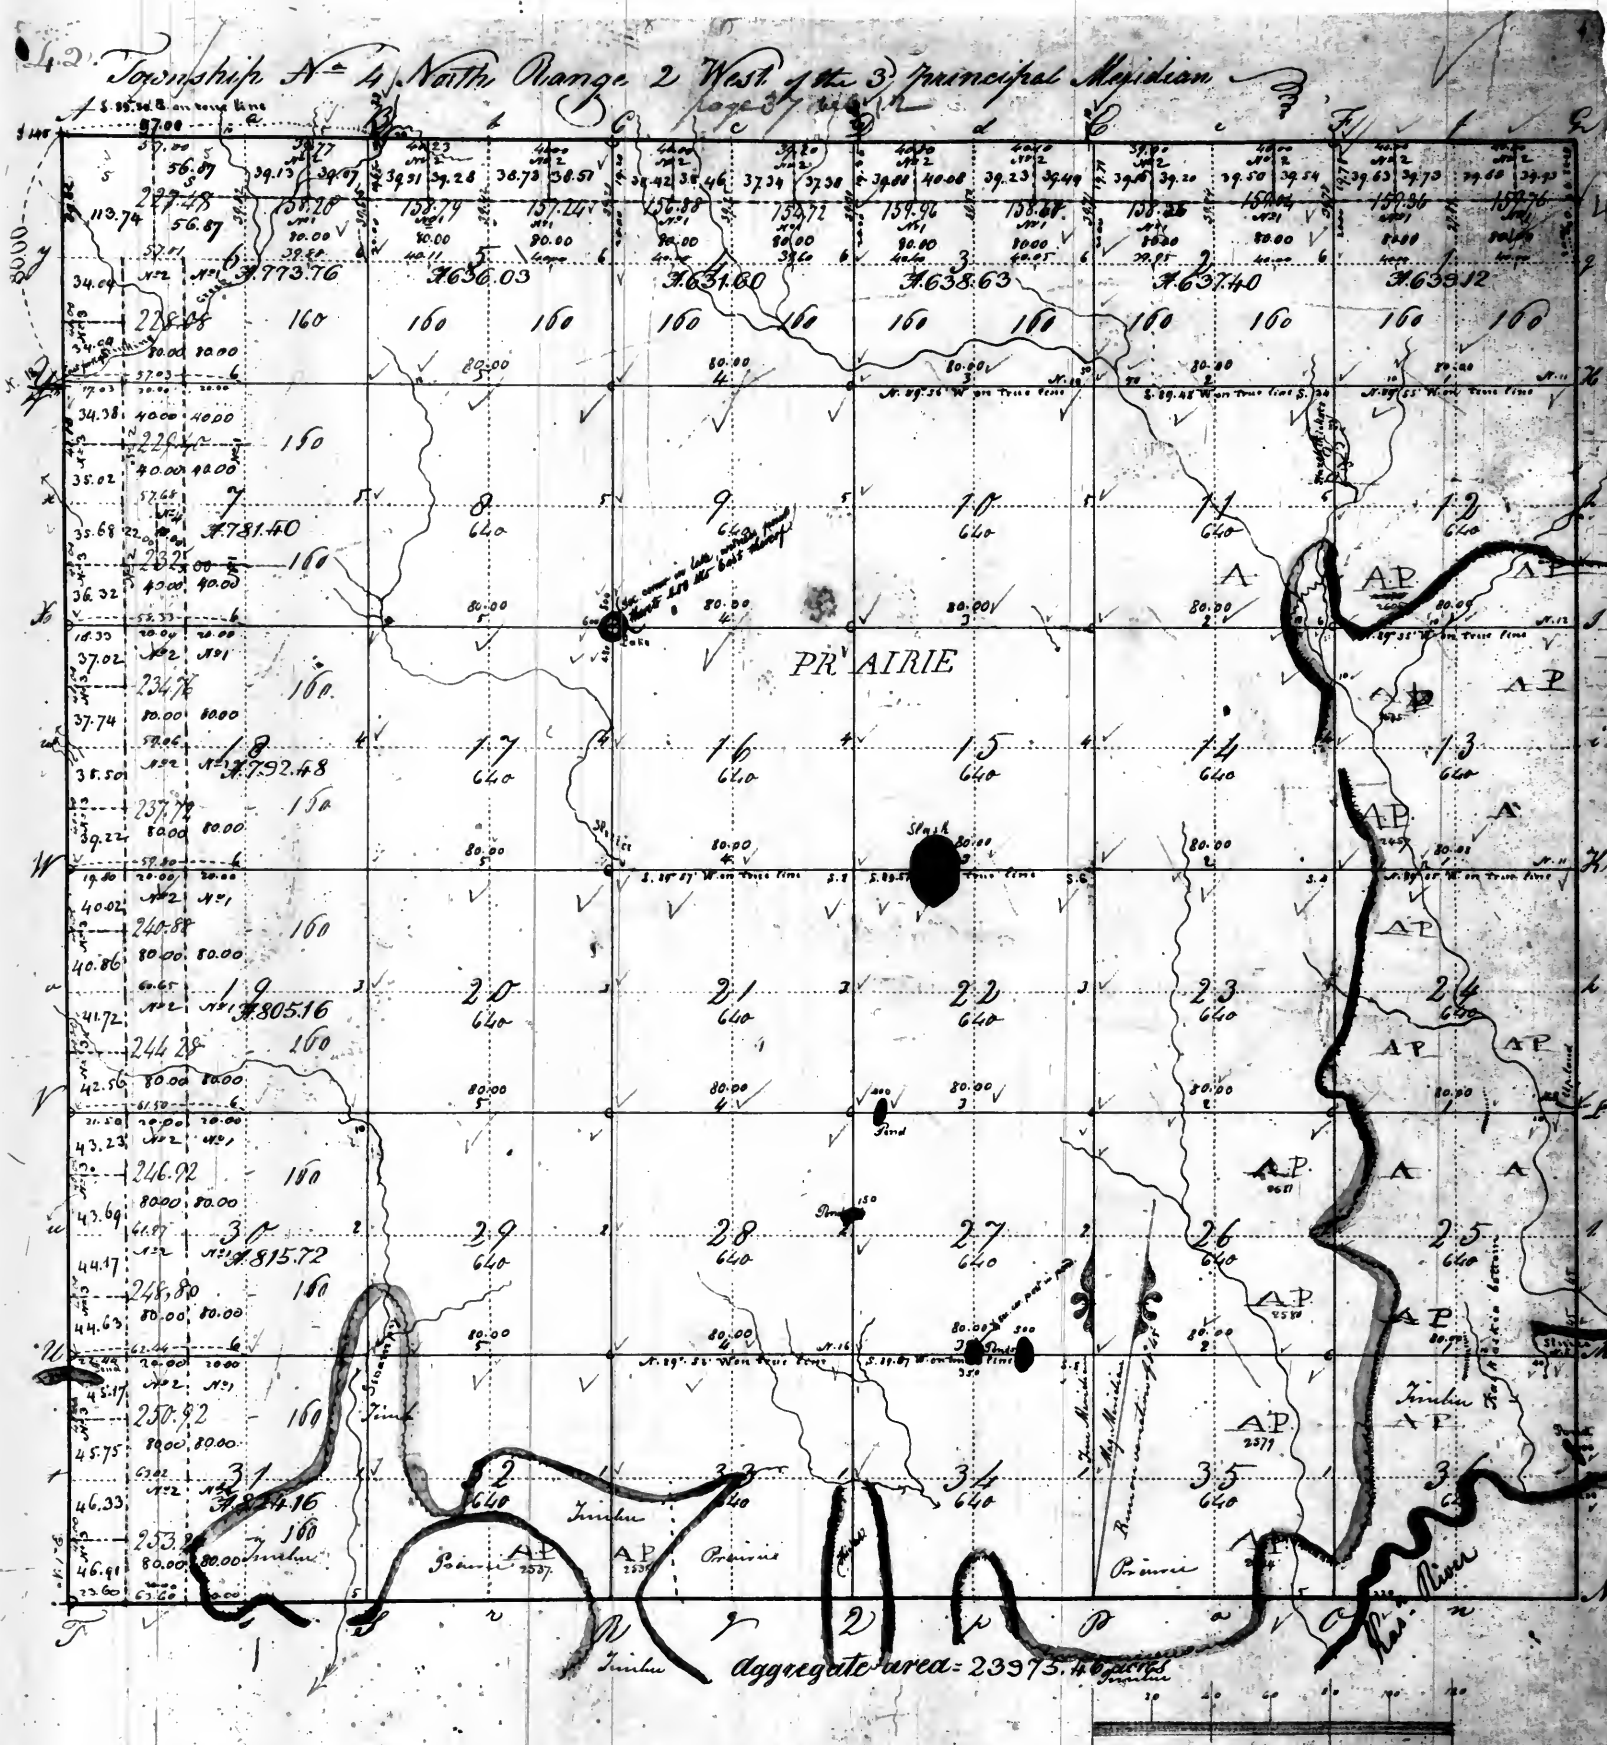

Reference to the field notes of the Survey of this Township by which the lines of this plat have been examined & corrected of the West boundary in Subdivision N 27, - of the South boundary in Subdivision N 42, - of the North & East boundaries and of the Subdivisions in Subdivision N 42. -

Office of the Surveyor General for the State of Illinois and the Mount Pleasant July 19th 1851. The North halves of sections 1, 2, 3, 4 & 5, the North half and the South west quarter of section 6, the West half of sections 7, 18, 19, 30 & 31 subdivided under the act of Congress of the 5th of April 1832 when these North half and West quarter sections 6, subdivided as to conform to previous sales, (marked 54, and a plat sent to the Register and another to the Commissioner of the General Land Office) same day.

Variation 8° 45' East.

Edw. C. Cook

Surveyor

Station October 26th 1857


The West half of section 7, subdivided this day in conformity to the instructions from the Com. of the General Land Office dated October 21st 1857, and on copy of the plat of same sent to the Commissioner and another to the Register of the Land Office at Springfield.

Pursuant to a Contract with and Instructions from Isaac Meigs Surveyor General of the United States bearing date the 20th September 1841 - I have advanced and surveyed the above described Township and hereby certify that it held such Mark and Bound as both natural and artificial as are represented on said Plat and described in the field notes taken thereon and returned with the Plat into the Office of the Surveyor of the Lands of the United States in the Territory of Illinois and Mississippi - Dated this 2nd Day of June 1841.

Surveyor's Office

Records


Township N. 6 North of the Base line, Range N. 2 West of the 3rd Principal Meridian

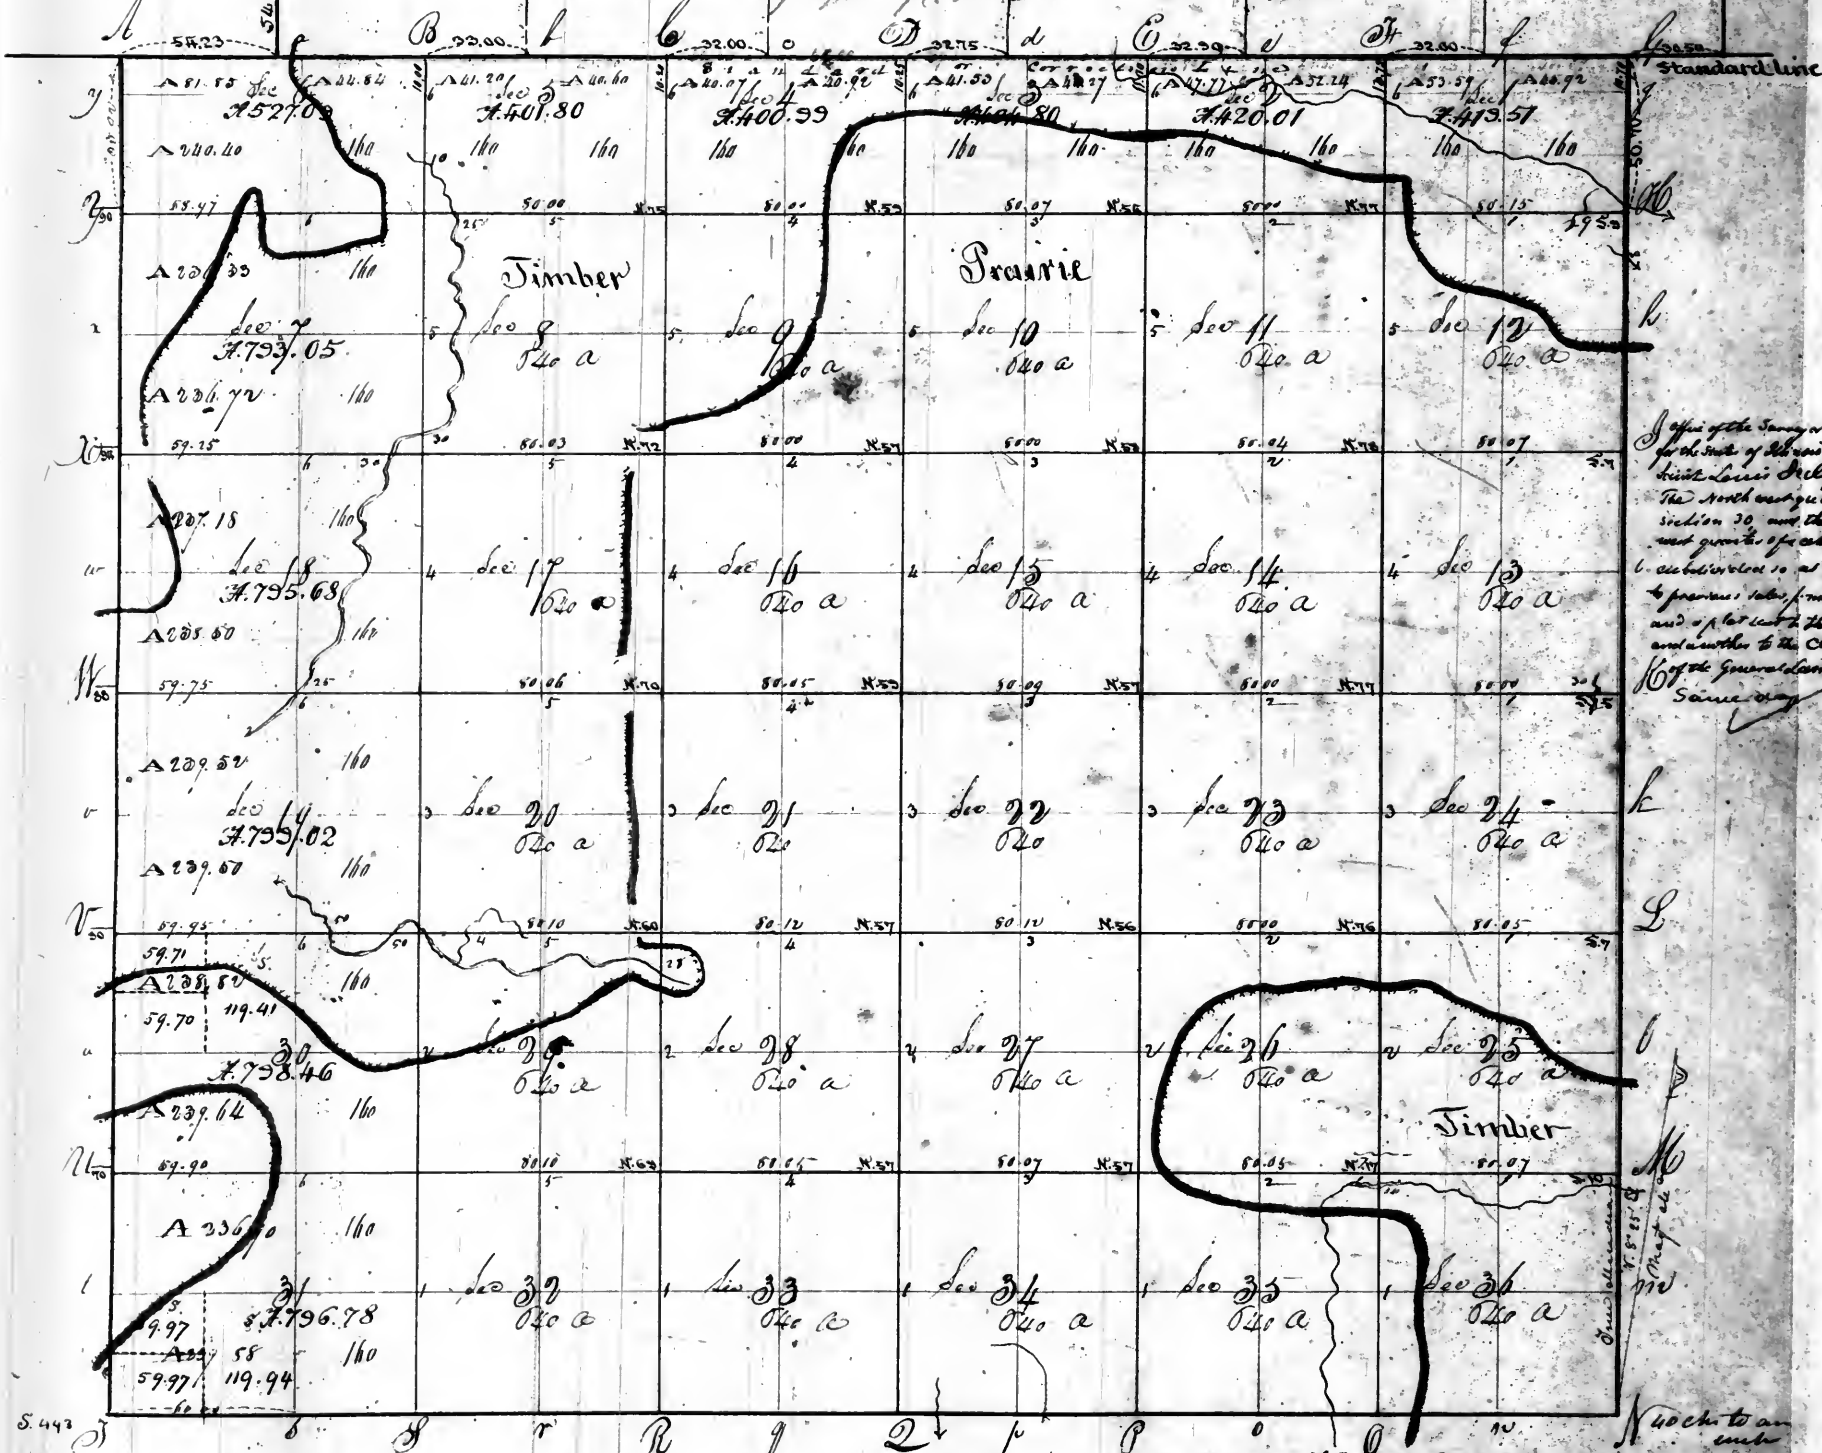

Office of the Surveyor General
 State of Illinois
 July 19th 1888
 The North and South
 and quarter of section 30,
 and quarter of section 31,
 each involved in as to
 to previous sale, marked
 and a plat sent to the
 and another to the
 16th of the General Land Office
 Same day

Aggregate area = 22557.19 acres
 Surveyed by *Thimber Barton*
 May and June 1888

page 43. vol 12

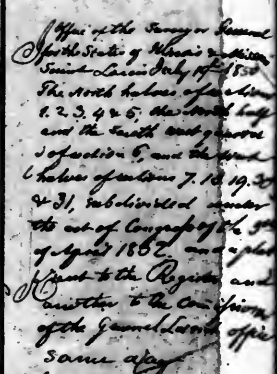


Aggregate area = 23082.22 aars
Surveyed by Hinton Barton Es
July 1868

Record 804

Township N. 11 S. of the Base line, Range N. 2 West of the 3^d principal Meridian.

Office of the Surveyor General
for the State of Illinois and Missouri
St. Louis, Mo. July 19th 1858
The North halves of sections
1, 2 & 5 the North half greater
portion of section 3, the North west
quarter of section 4, the North W
half and the South West quar-
ter of section 6, and the
West halves of sections 7, 18, 19,
30 & 31, included under
the act of Congress of the 5th
of April 1832, and a plat
sent to the Register and under
to the Commissioner of the
General Land office.

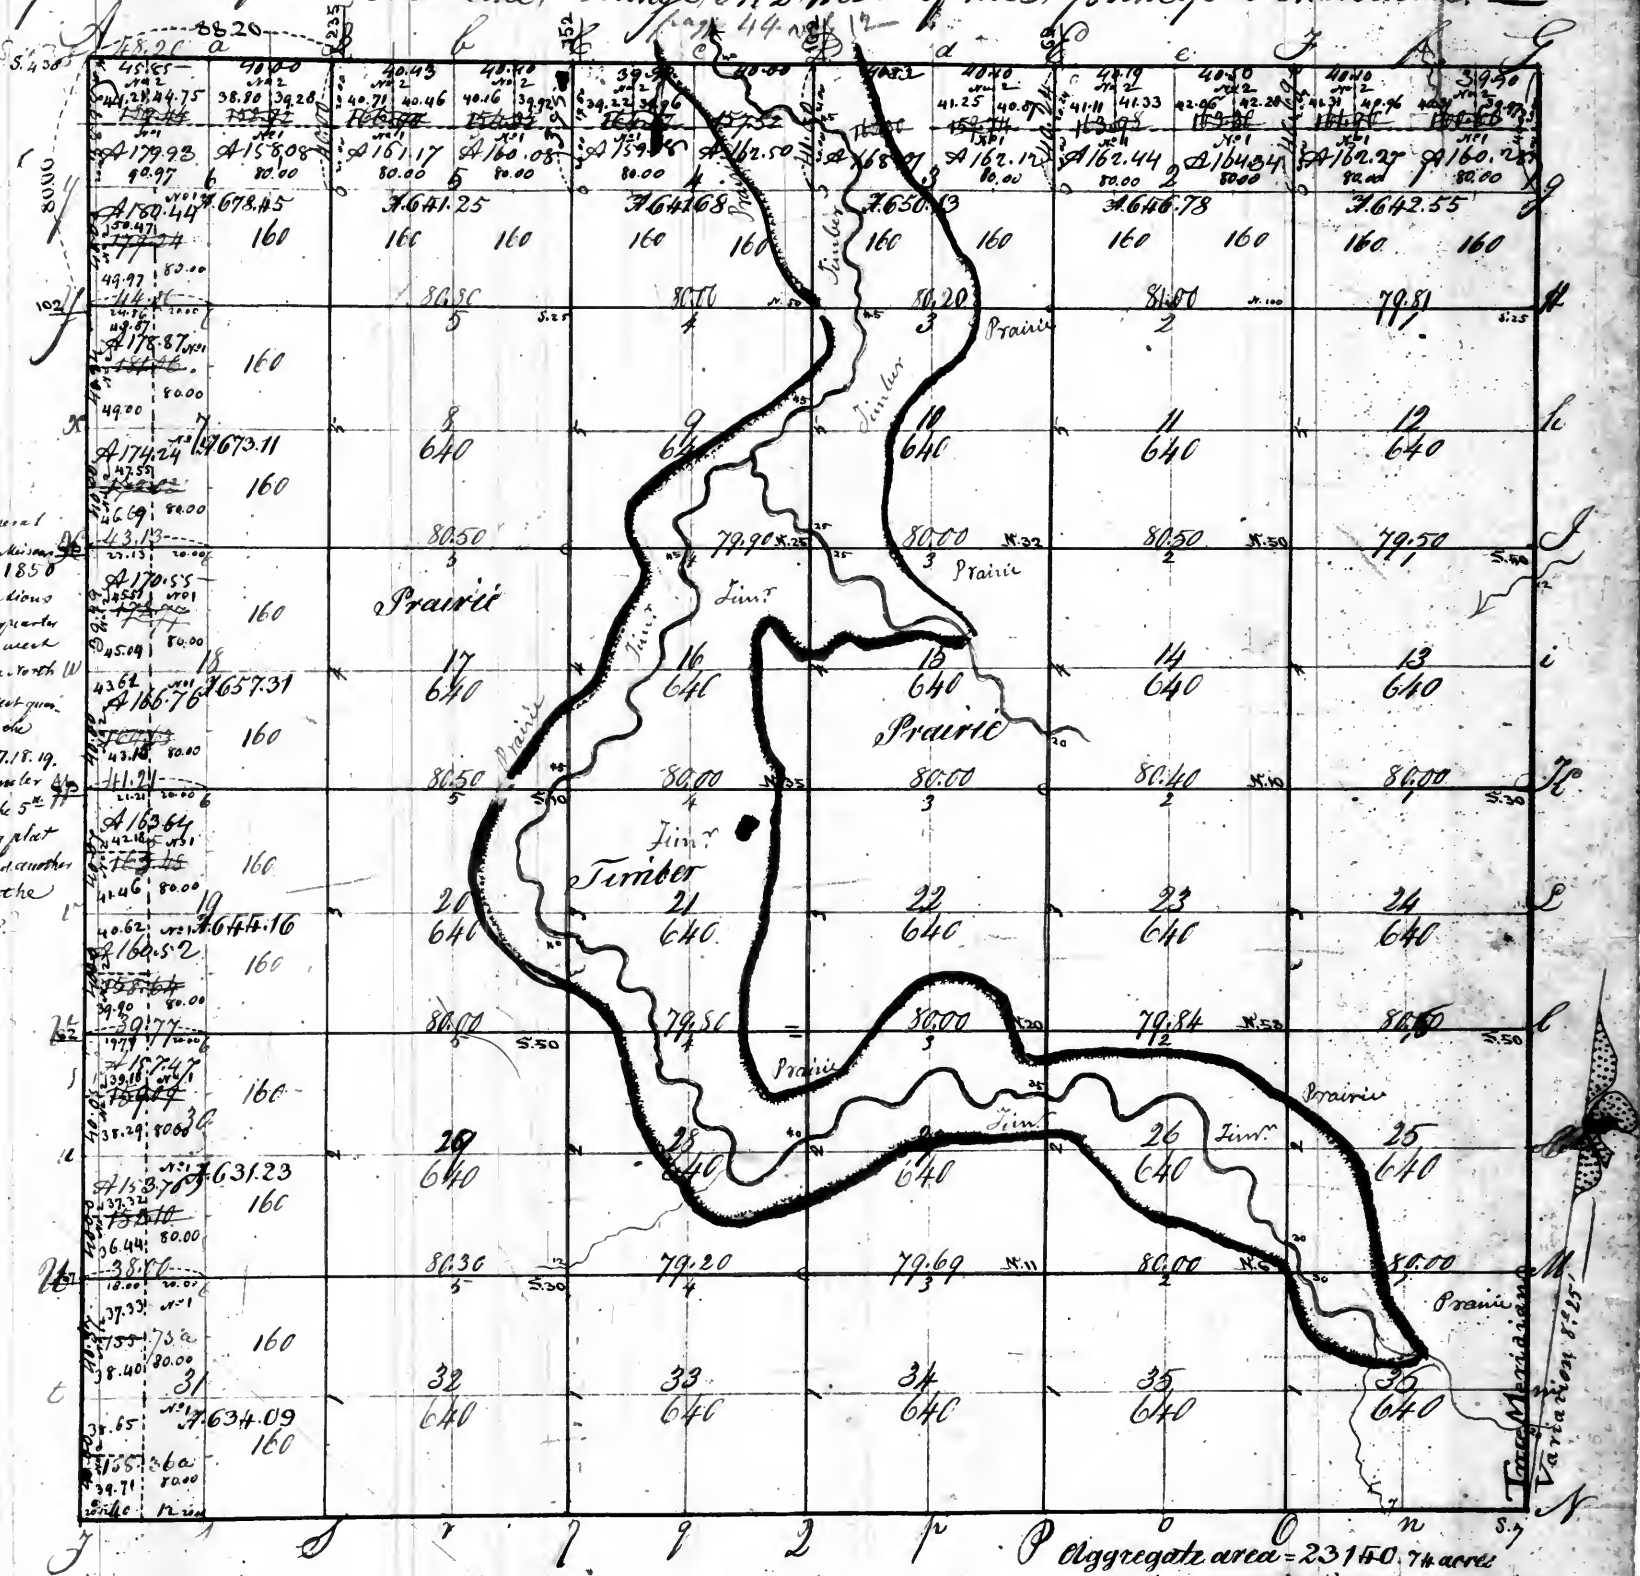


in pursuance to a Contract with, and Instructions from William Reeder Surveyor of the Lands of the
States in the Territories of Illinois and Missouri bearing date the 29th day of Oct. 1818. I have examined laid out
surveyed the above described Township and do hereby Certify that it had such marks and bounds both natural &
artificial as are represented on said plat & described in the field notes made thereof and returned with this plat into
the Office of the Surveyor of the Lands of the U. States for the Territories of Illinois and Missouri.

Certified this 25th day of January 1819.

Enoch Moody D.S.

806

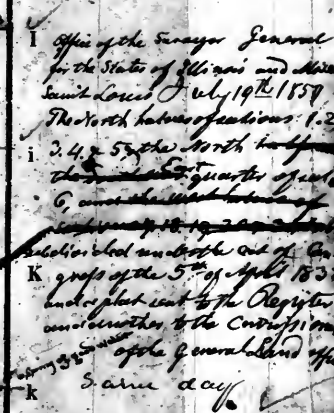

Sent to Genl. Lamm
Office 8th Febr 1844

E. ann. cur.

2391150

2

By Will R. Rector


D. SURVEYOR

2391150

Surveyor of the public lands in
the State of Illinois and Missouri

Reconfort

Township No. 14 North of the base line, Range No. 2 West of the principal Meridian.

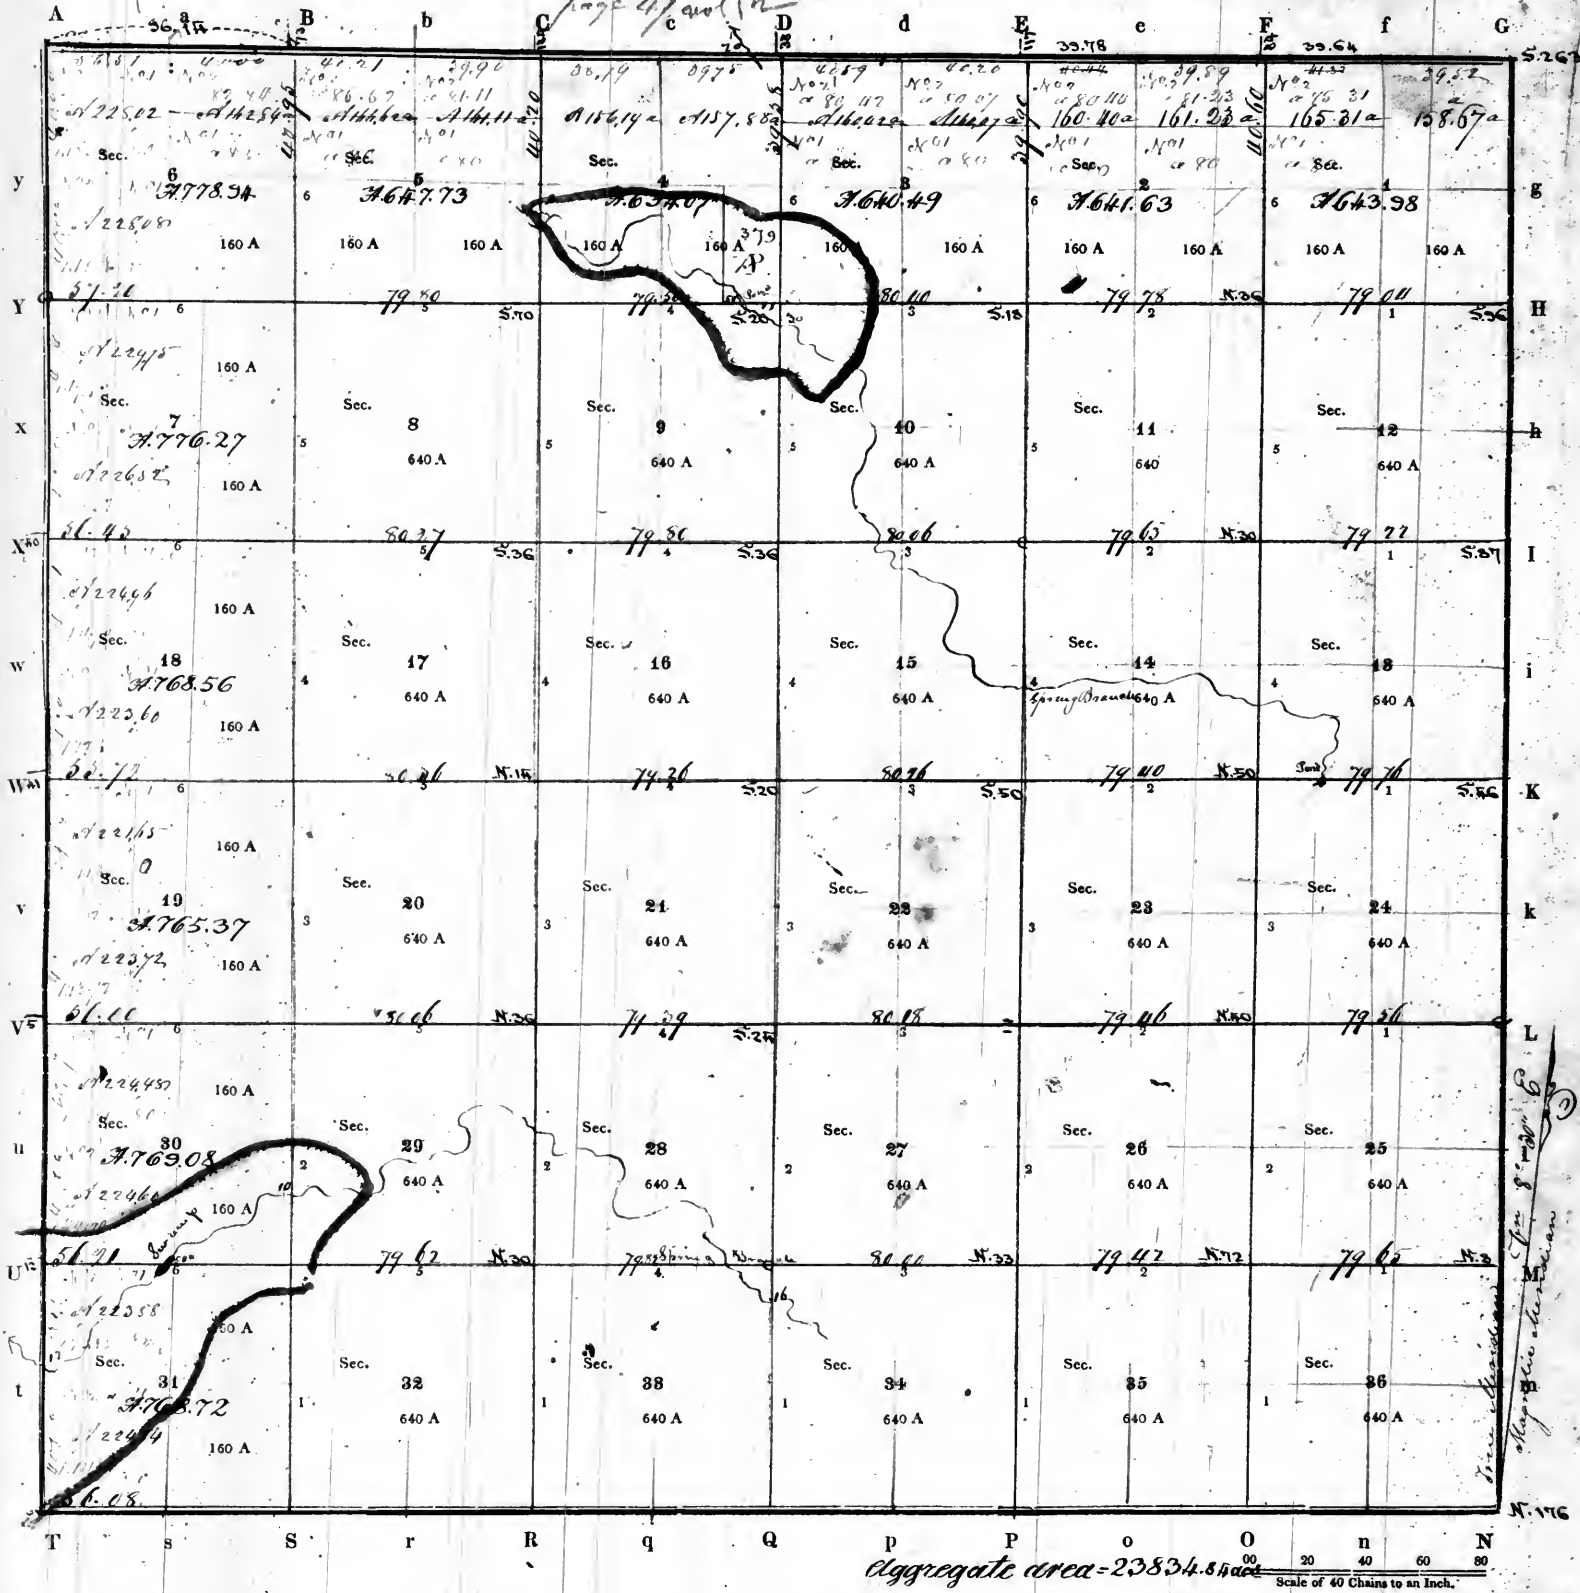

PURSUANT to a contract with, and instructions from WILLIAM RECTOR, Surveyor of the lands of the United States in the State of Illinois, bearing date the nineteenth day of February 1821.

I have admeasured, laid out and surveyed the above described Township; and do hereby certify, that it had such marks and bounds, both natural and artificial, as are represented on said plat, and described in the field notes made thereof, and returned with this plat into the Office of the Surveyor of the lands of the United States, for the State of Illinois and Missouri and Arkansas.


Certified this twelfth day of July 1821

EXAMINED.

William Rector D. SURVEYOR.

Record 808

Township No. 15 North of the base line, Range No. 2 West of the 2^d principal Meridian

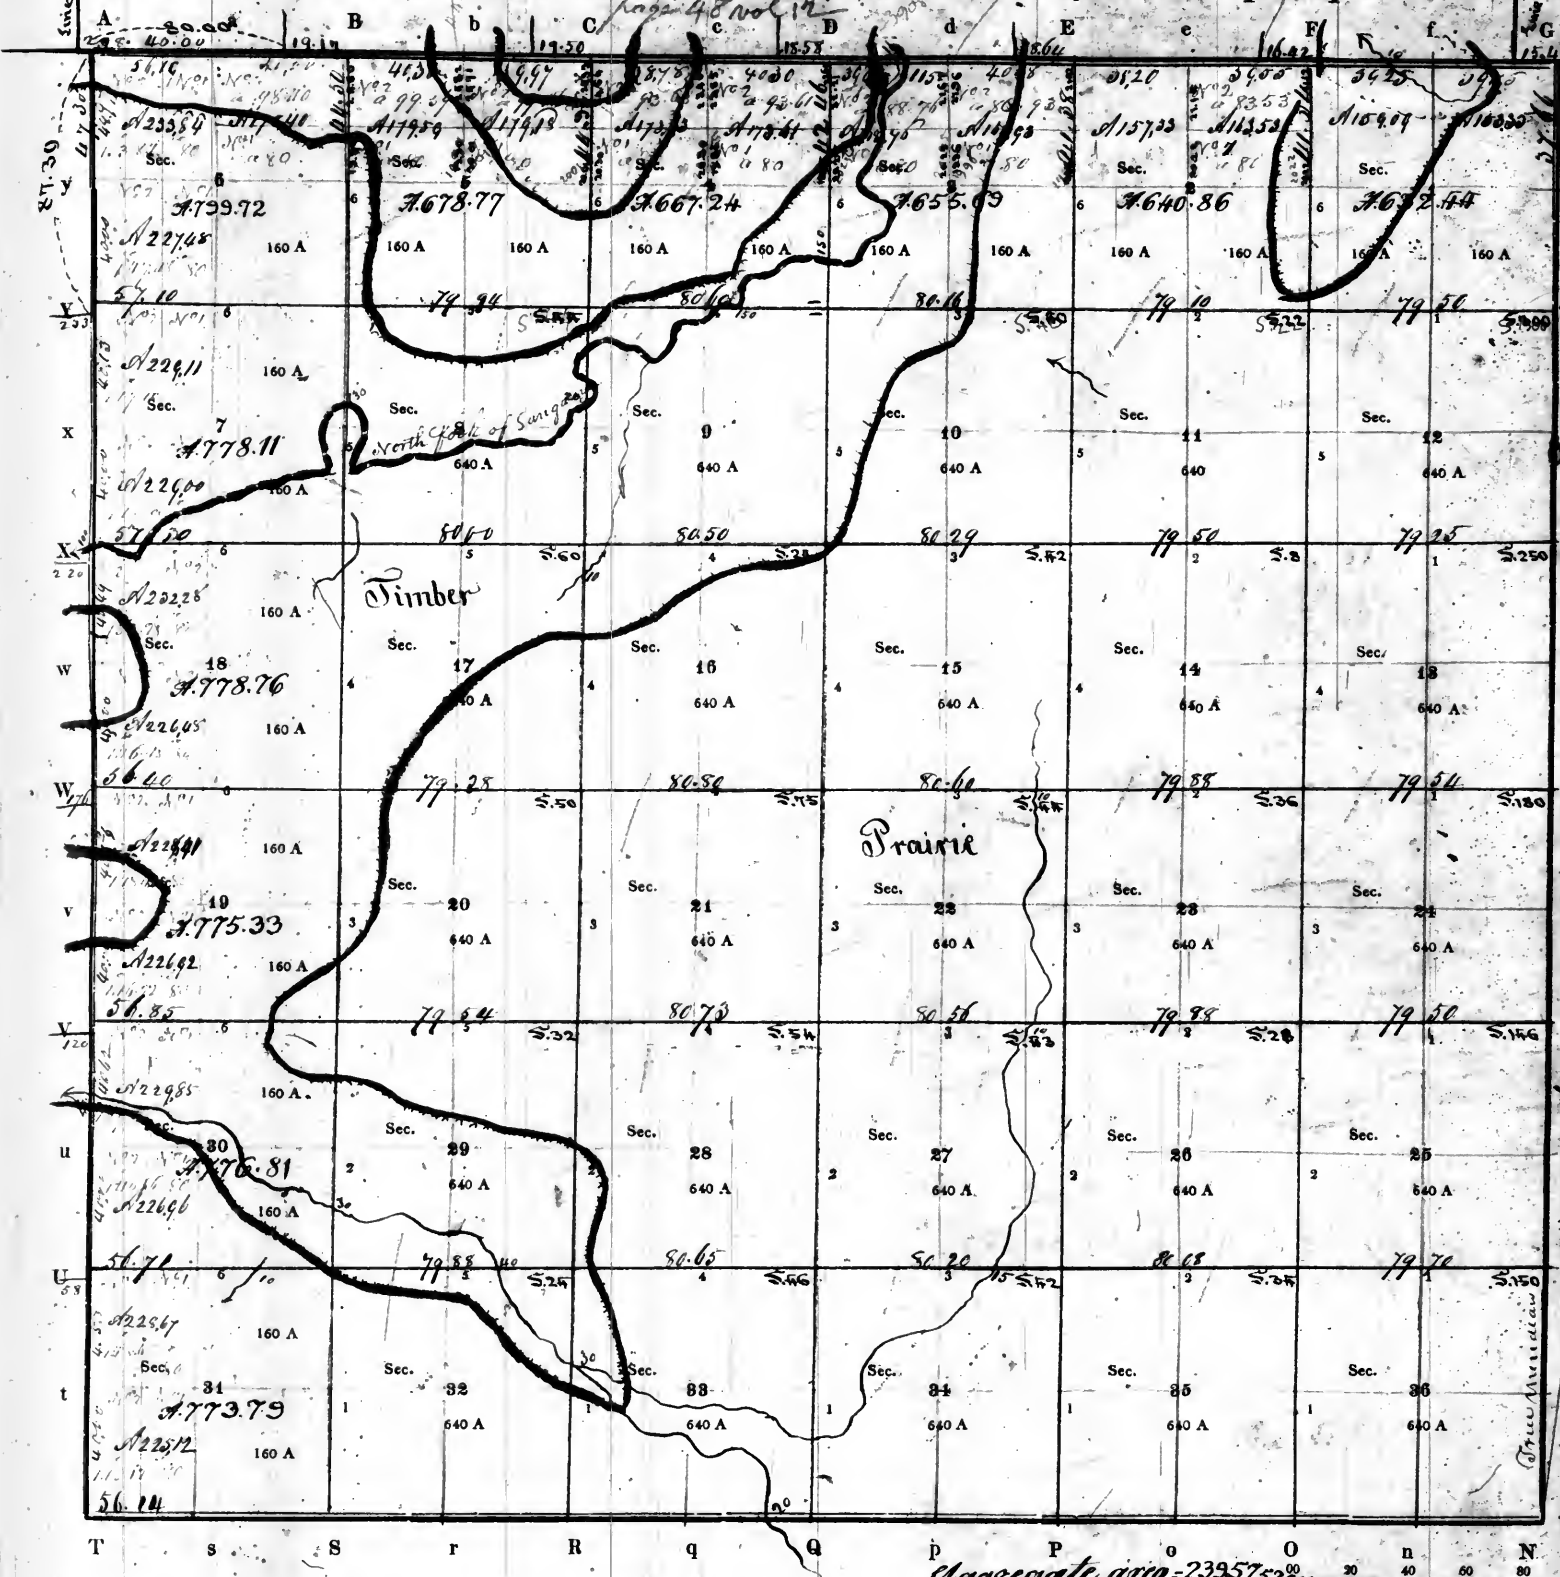

Surveyor's Office
St. Louis, Mo. August 1842.
Plat of the N.E. 1/4 of Sec. 2
of the 15th township of Range 2
W, sent this day to the Comptroller
of the Public L.

PURSUANT to a contract with, and instructions from WILLIAM RECTOR, Surveyor of the lands of the United States in the State of Illinois and Wisconsin and Territory of Arkansas bearing date the Nineteenth day of February 1841

I have admeasured, laid out and surveyed the above described Township; and do hereby certify, that it had such marks and bounds, both natural and artificial, as are represented on said plat, and described in the field notes made thereof, and returned with this plat into the Office of the Surveyor of the lands of the United States, for the State of Illinois and Wisconsin and Territory of Arkansas

Certified this twelfth day of July 1841.


EXAMINED.

WILLIAM RECTOR, SURVEYOR.

809

Recorded

page 49 vol 12

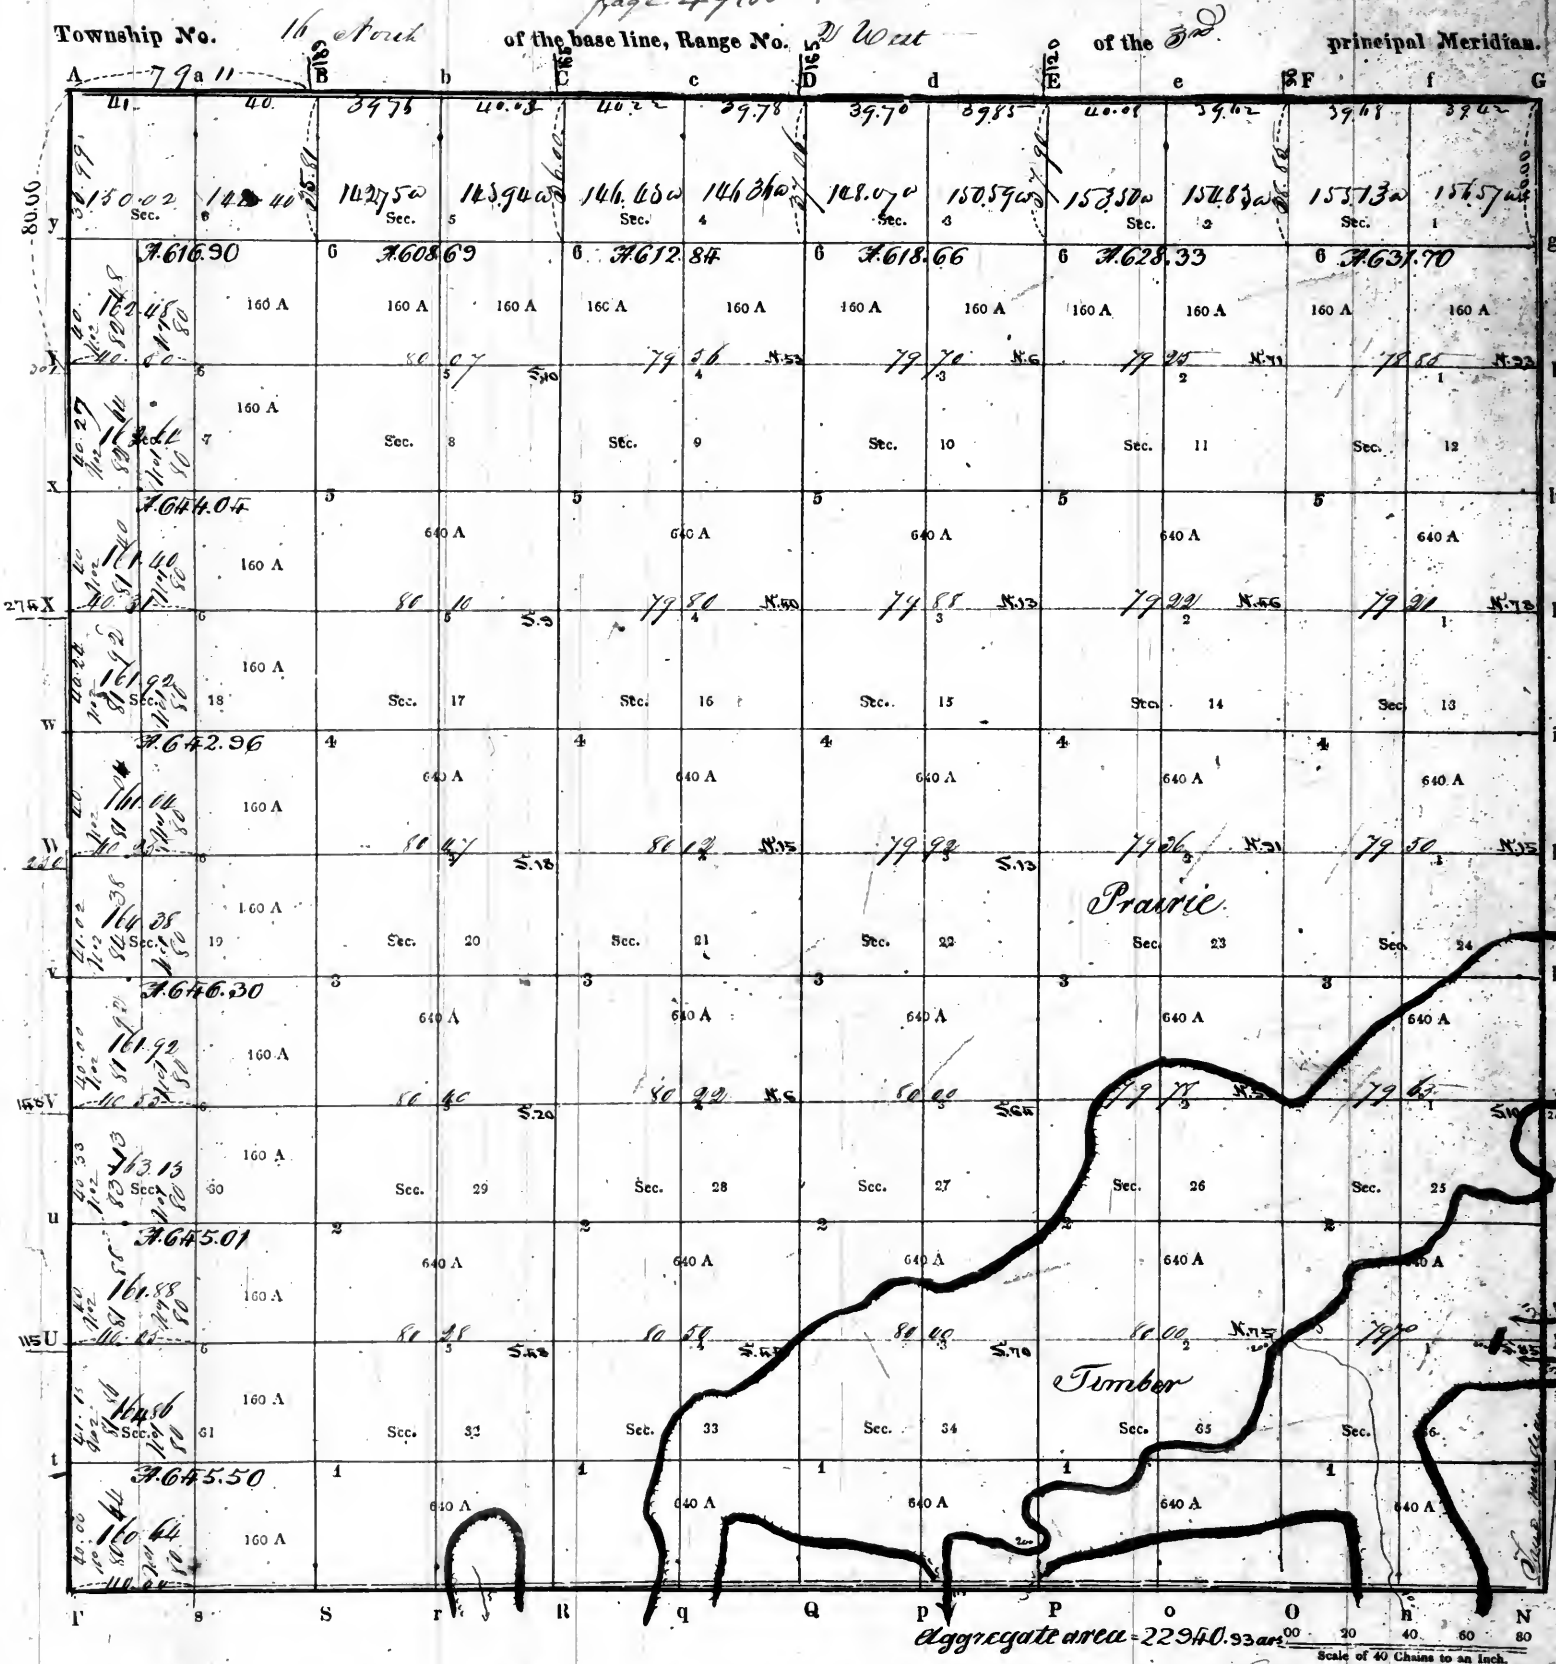

PURSUANT to a contract with, and instructions from William Hector, Surveyor of the lands of the United States in the State of Illinois, bearing date the *twenty* day of *February*, 1821, I have measured, laid out and surveyed the above described Township; and do hereby certify, that it had such marks and bounds, both natural and artificial, as are represented on said plat, and described in the field notes made thereof, and returned with this plat into the Office of the Surveyor of the Lands of the United States, in the State of Illinois.


Certified this *18th* day of *February*, 1821

EXAMINED.

Surveyed by *A. B. Langham* D. SURVEYOR: see his field notes in November & December 1821

Recorded

page 50 vol 12

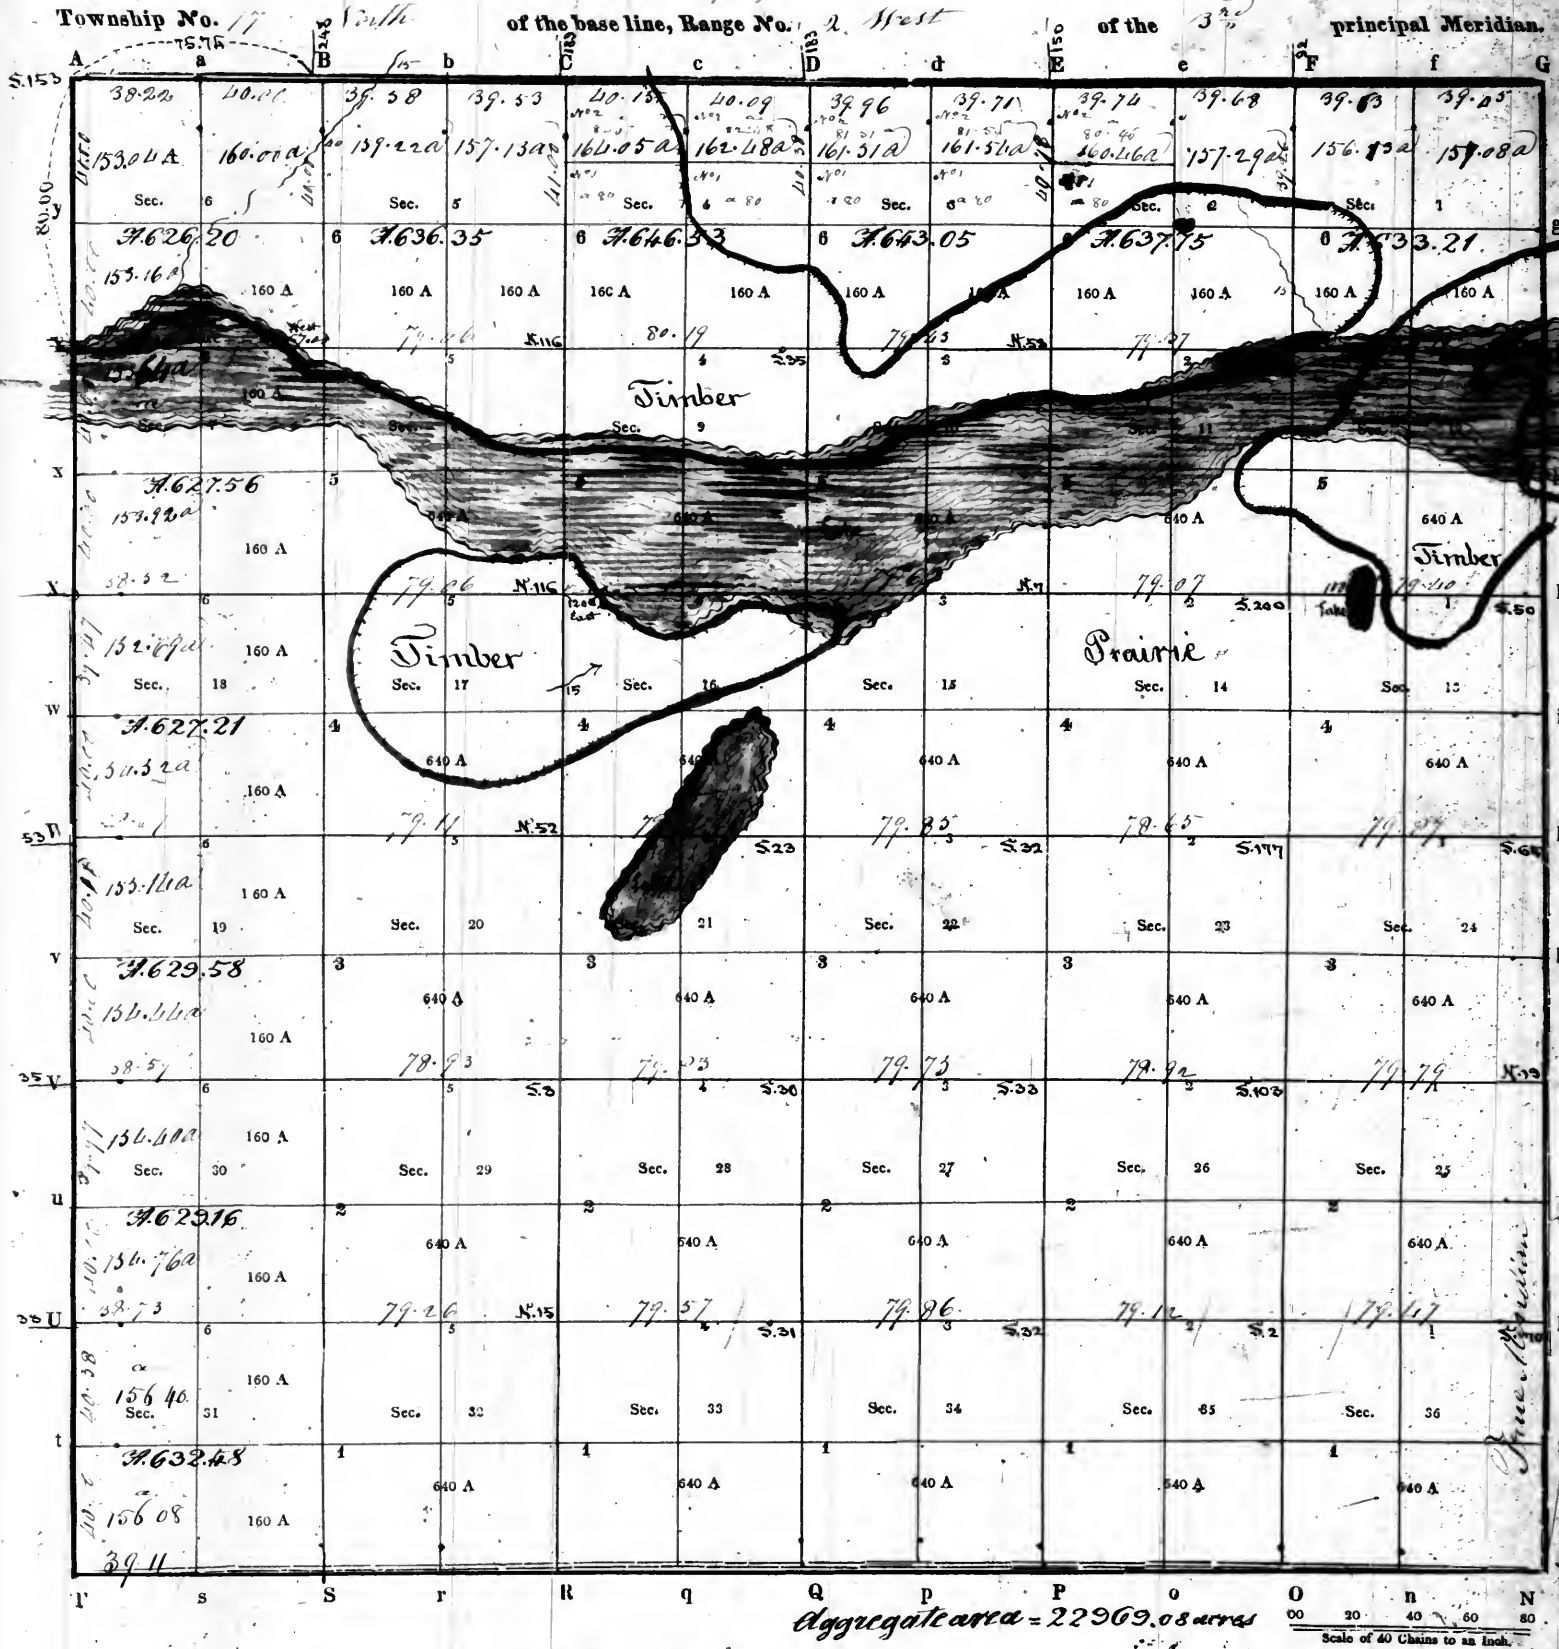

PURSUANT to a contract with, and instructions from William Rector, Surveyor of the lands of the United States in the State of Illinois, Missouri and Territory of Arkansas, bearing date the nineteenth day of February 1882, I have measured, laid out and surveyed the above described Township; and do hereby certify, that it had such marks and bounds, both natural and artificial, as are represented on said plat, and described in the field notes made thereof, and returned with this plat into the Office of the Surveyor of the Lands of the United States, in the State of Illinois, Missouri and Territory of Arkansas.

Certified this day of 1882

EXAMINED.


Wm C Rector D. SURVEYOR.

Approved by D Miller

811.
Reconced

page 51 vol 12

Township No. *18* North of the base line, Range No. *11* West of the *3rd* principal Meridian.

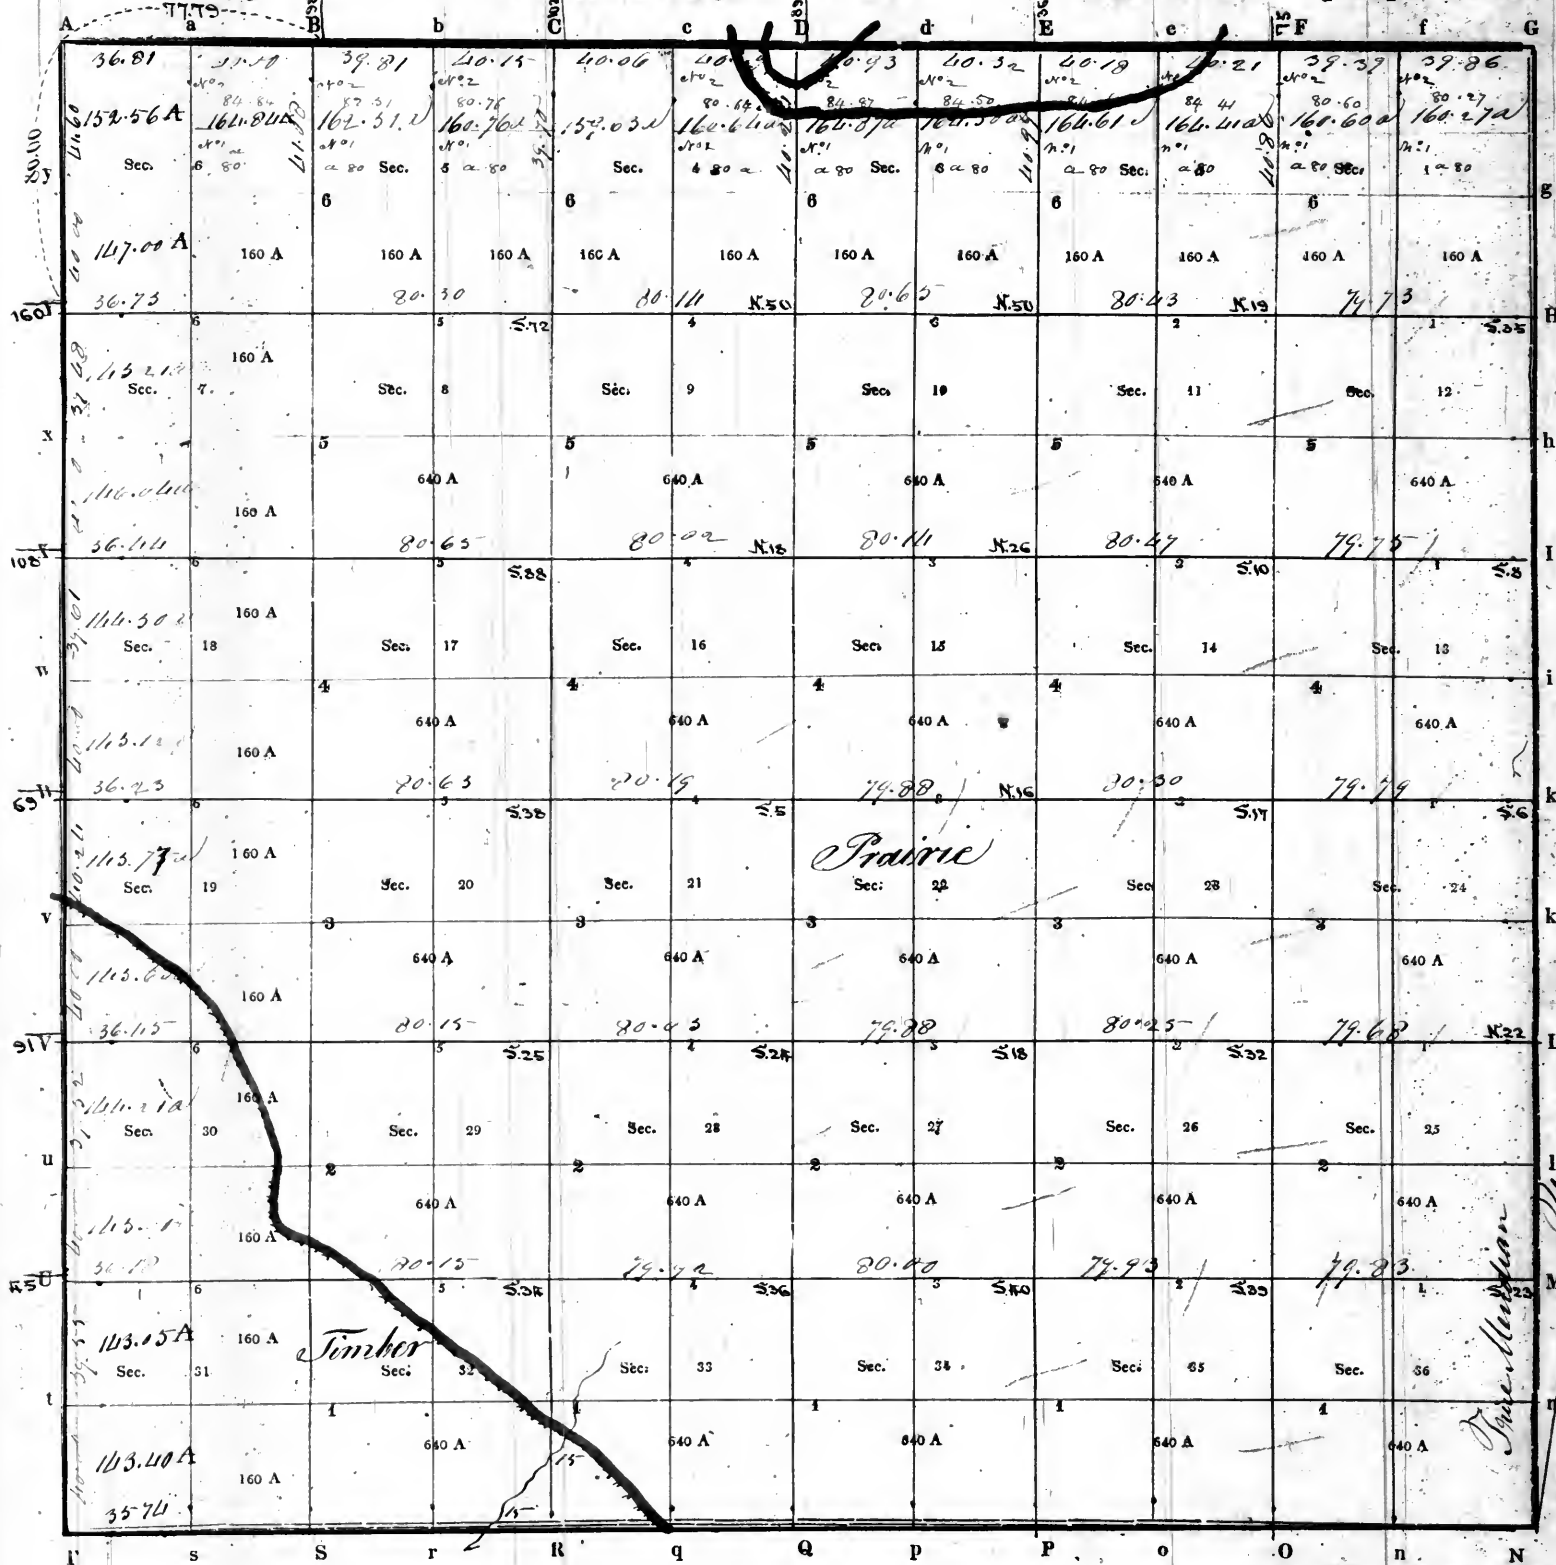

PURSUANT to a contract with, and instructions from William Rector, Surveyor of the lands of the United States in the State of Missouri, Missouri and Territory of Arkansas, bearing date the *nineteenth* day of *February* 1882, I have measured, laid out and surveyed the above described Township; and do hereby certify, that it had such marks and bounds, both natural and artificial, as are represented on said plat, and described in the field notes made thereof, and returned with this plat into the Office of the Surveyor of the Lands of the United States, in the State of Missouri, Missouri and Territory of Arkansas.

Certified this *12* day of *April* 1882
EXAMINED.


Wm Rector SURVEYOR.
Adm by R. M. M. A.

Recovered 12

5

Township N. 19 North of the base line. Range N. 2 West of the 3^d Principal Meridian

page 52 vol 12

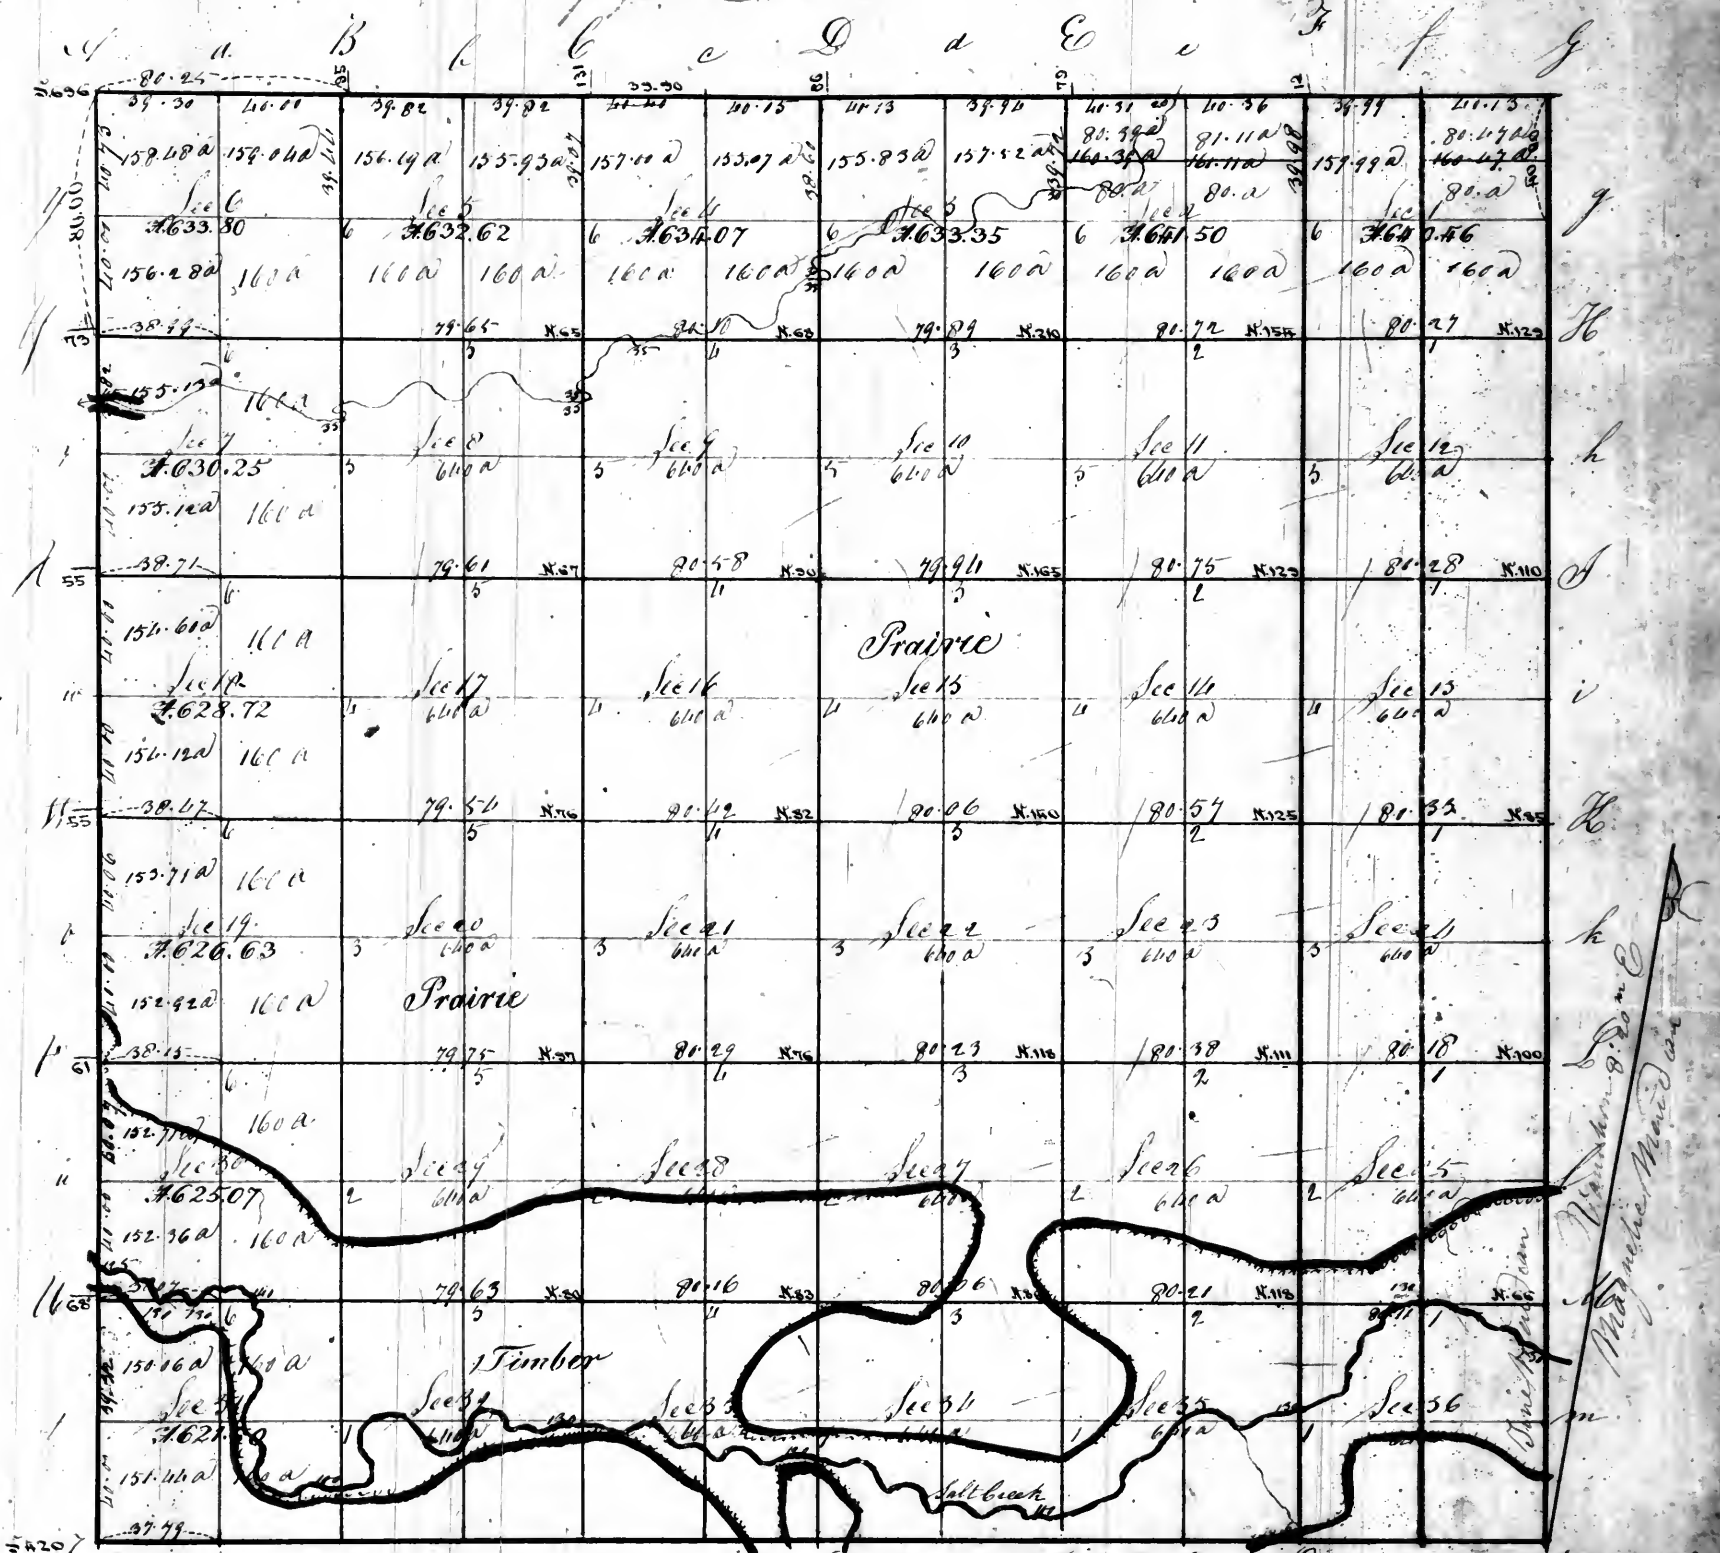

Pursuant to a contract with and instructions from William Reitor Surveyor of the lands of the United States of Illinois Missouri and Territory of Arkansas bearing date the 19th February 1882 I have admeasured laid out and surveyed the above described township, and do hereby certify that it had such marks and bounds both natural and artificial as are represented on said plat and described in the field notes made thereof and returned with this plat into the office of the surveyor of the lands of the United States for the state of Illinois Missouri and Territory of Arkansas


Wm Reitor Dd
 attested by D Miller Dd

Recorded 313

53

Township N. 20. South of the base line Range, N. 2. West of the 3rd Principal Meridian

page 53 vol 12

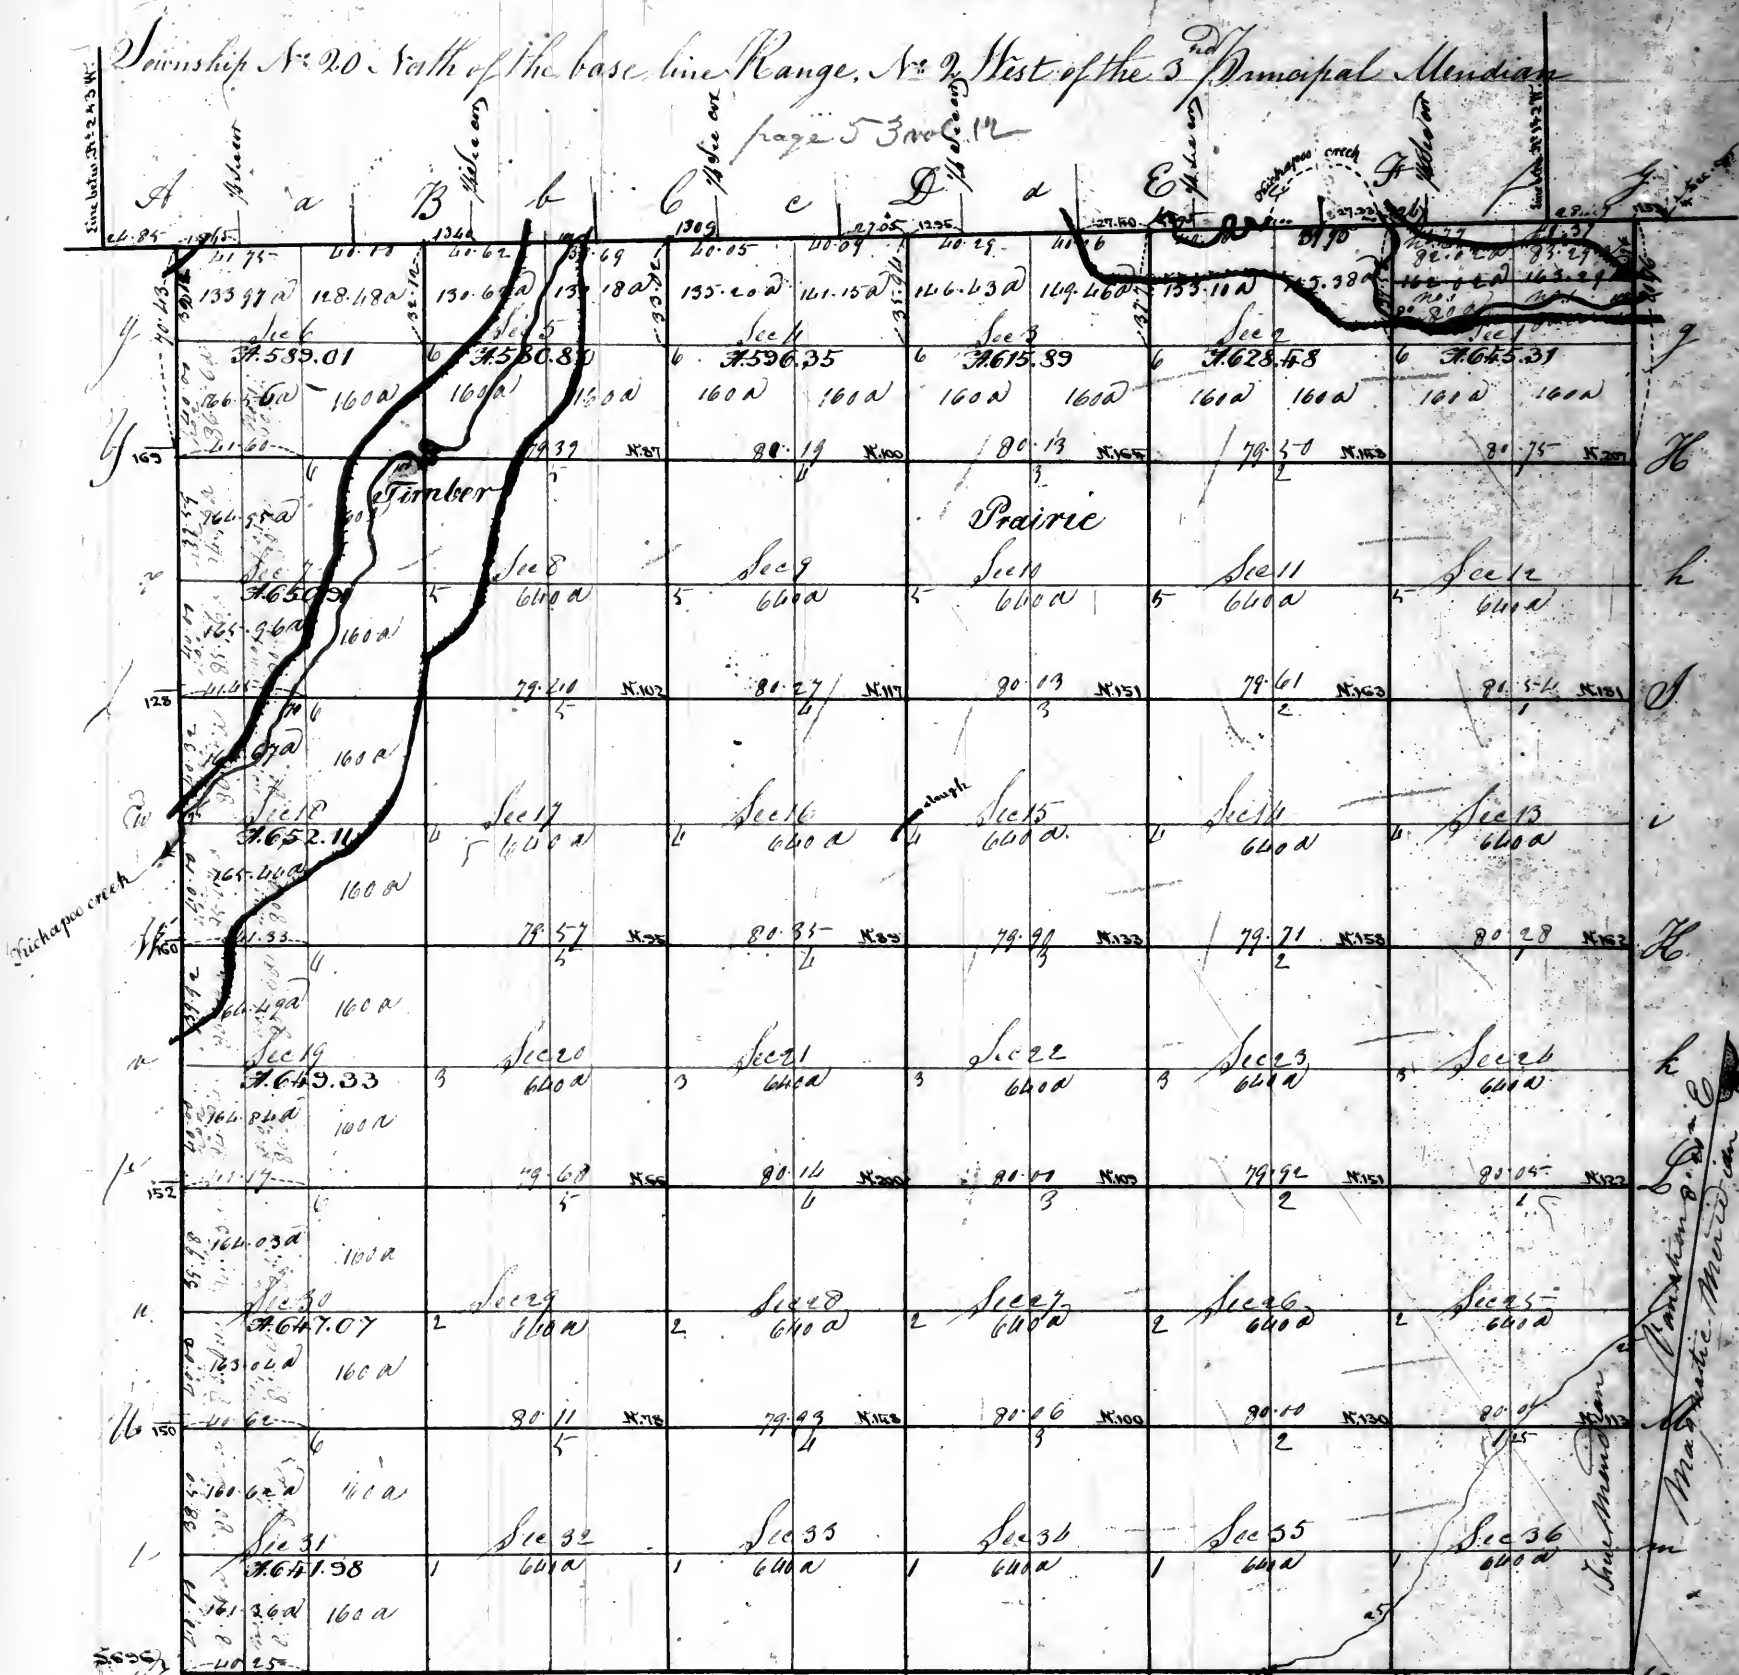


Aggregate area - 22897.24 ac. scale of 1 inch to 1 mile

In pursuance to a contract with and instructions from William Rector Surveyor of the lands of the United States in the States of Illinois Missouri and Territory of Arkansas bearing date the 19th day of April 1823 I have examined laid out and surveyed the above described Township and do hereby certify that it had such marks and bound both natural and artificial as are represented on said plat and described in the field notes made thereof and returned with this plat into the Office of the Surveyor of the lands of the United States for the states of Illinois Missouri and Territory of Arkansas

Testified 12th April 1823

Wm C Rector D.S.
atty by R. M. Miller D.S.

Township N^o 21 North of the Base line Range N^o 2 West of the 3^d principal meridian

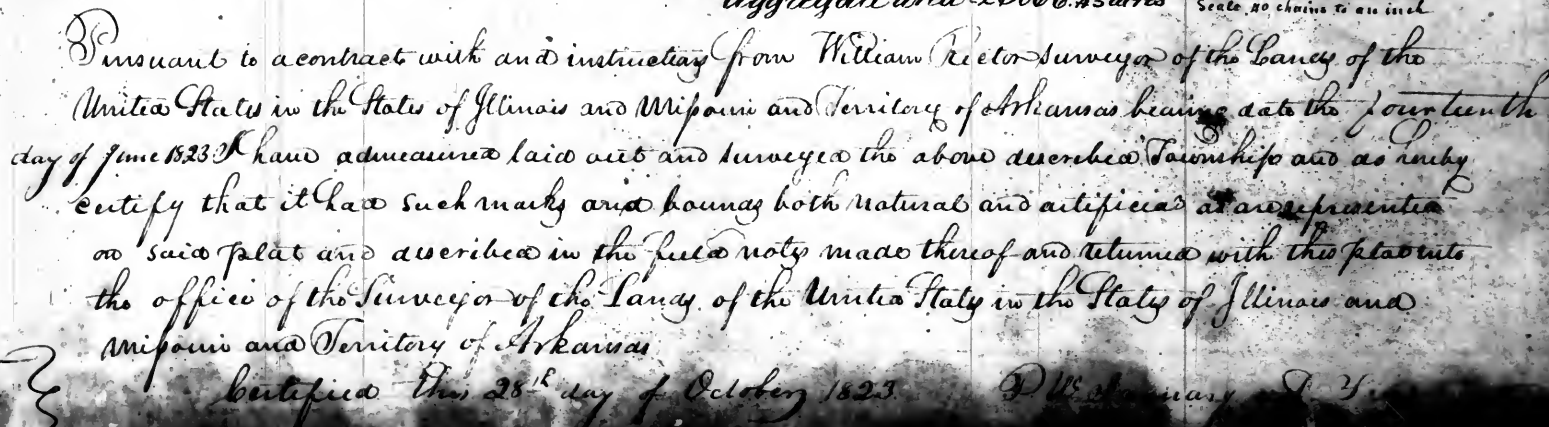


Township N^o 22 North of the Base line Range N^o 2 West of the 3^d Principal Meridian

page 50 Vol 10

Note: The areas in the West
half of sections 7 & 15 altered
in consequence of the length of the
line between sections 7 & 15 being
set down wrong October 9 1827.

The corner 6, 13, 14, 23 & 24
is not described as such. N
and the creek on the
bearing being according
to the monument
to W. W.
1827

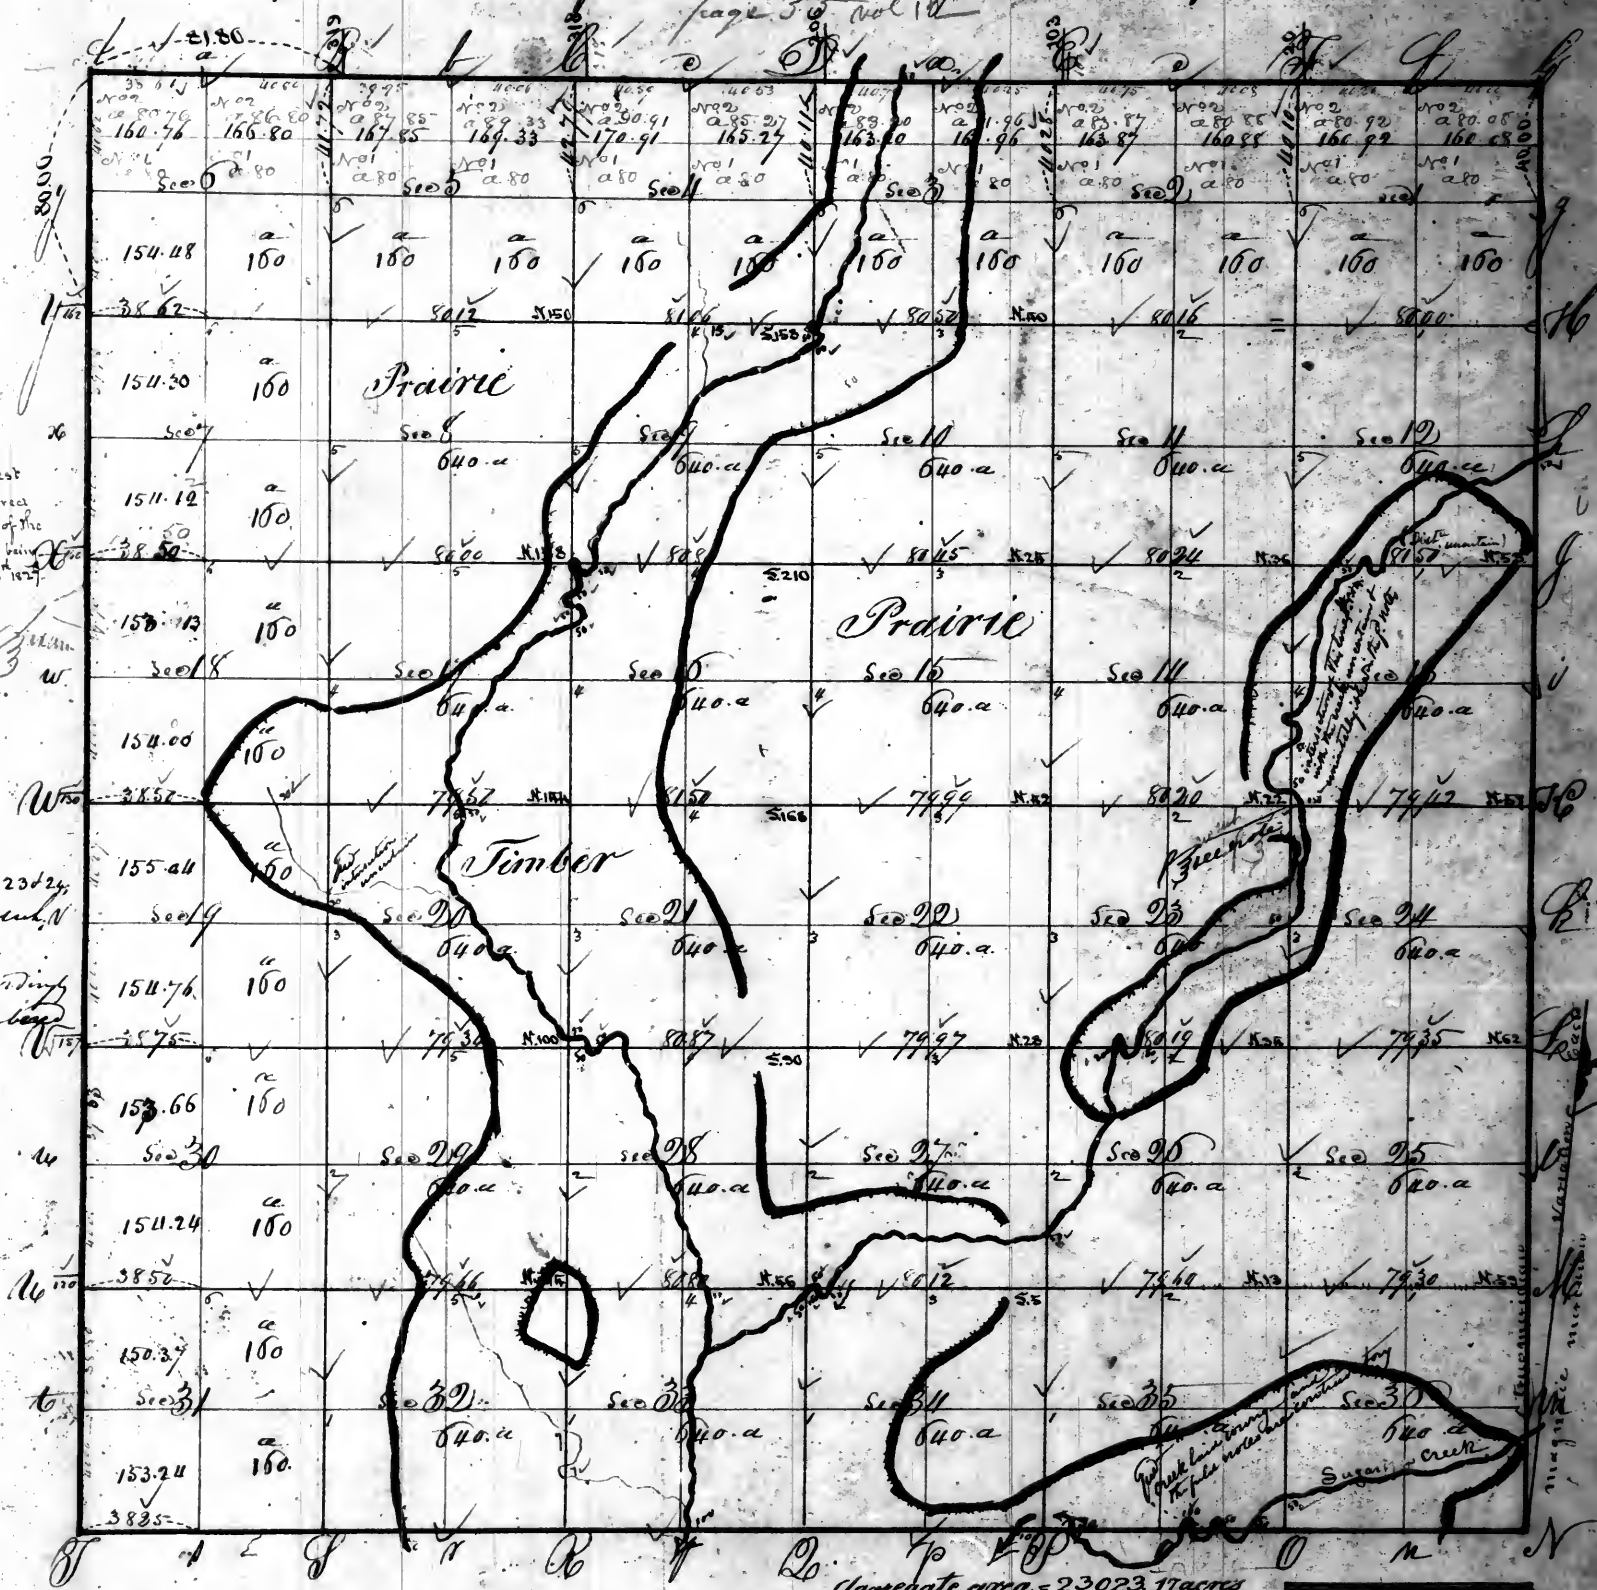


Pursuant to a contract with and instructions from William Reitor Surveyor of the Lands of the
United States in the State of Illinois and Missouri and Territory of Arkansas bearing date the 14th day of June
I have admeasured laid out and surveyed the above described Township and do hereby certify that
it has such marks and points both natural and artificial as are represented on said plat
and described in the field notes made thereof and returned to the office of the Surveyor of the
Lands of the United States in the State of Illinois and Missouri and Territory of Arkansas
Certified the 28th day of October 1823

Examined - 1827
Wm. Reitor
Sur. of Pub. Lands

D. W. January D. Surveyor
checked by H. Rawls D. Surveyor

Township N^o 23 North of the Base line Range N^o 2 West of the 3^d Principal Meridian


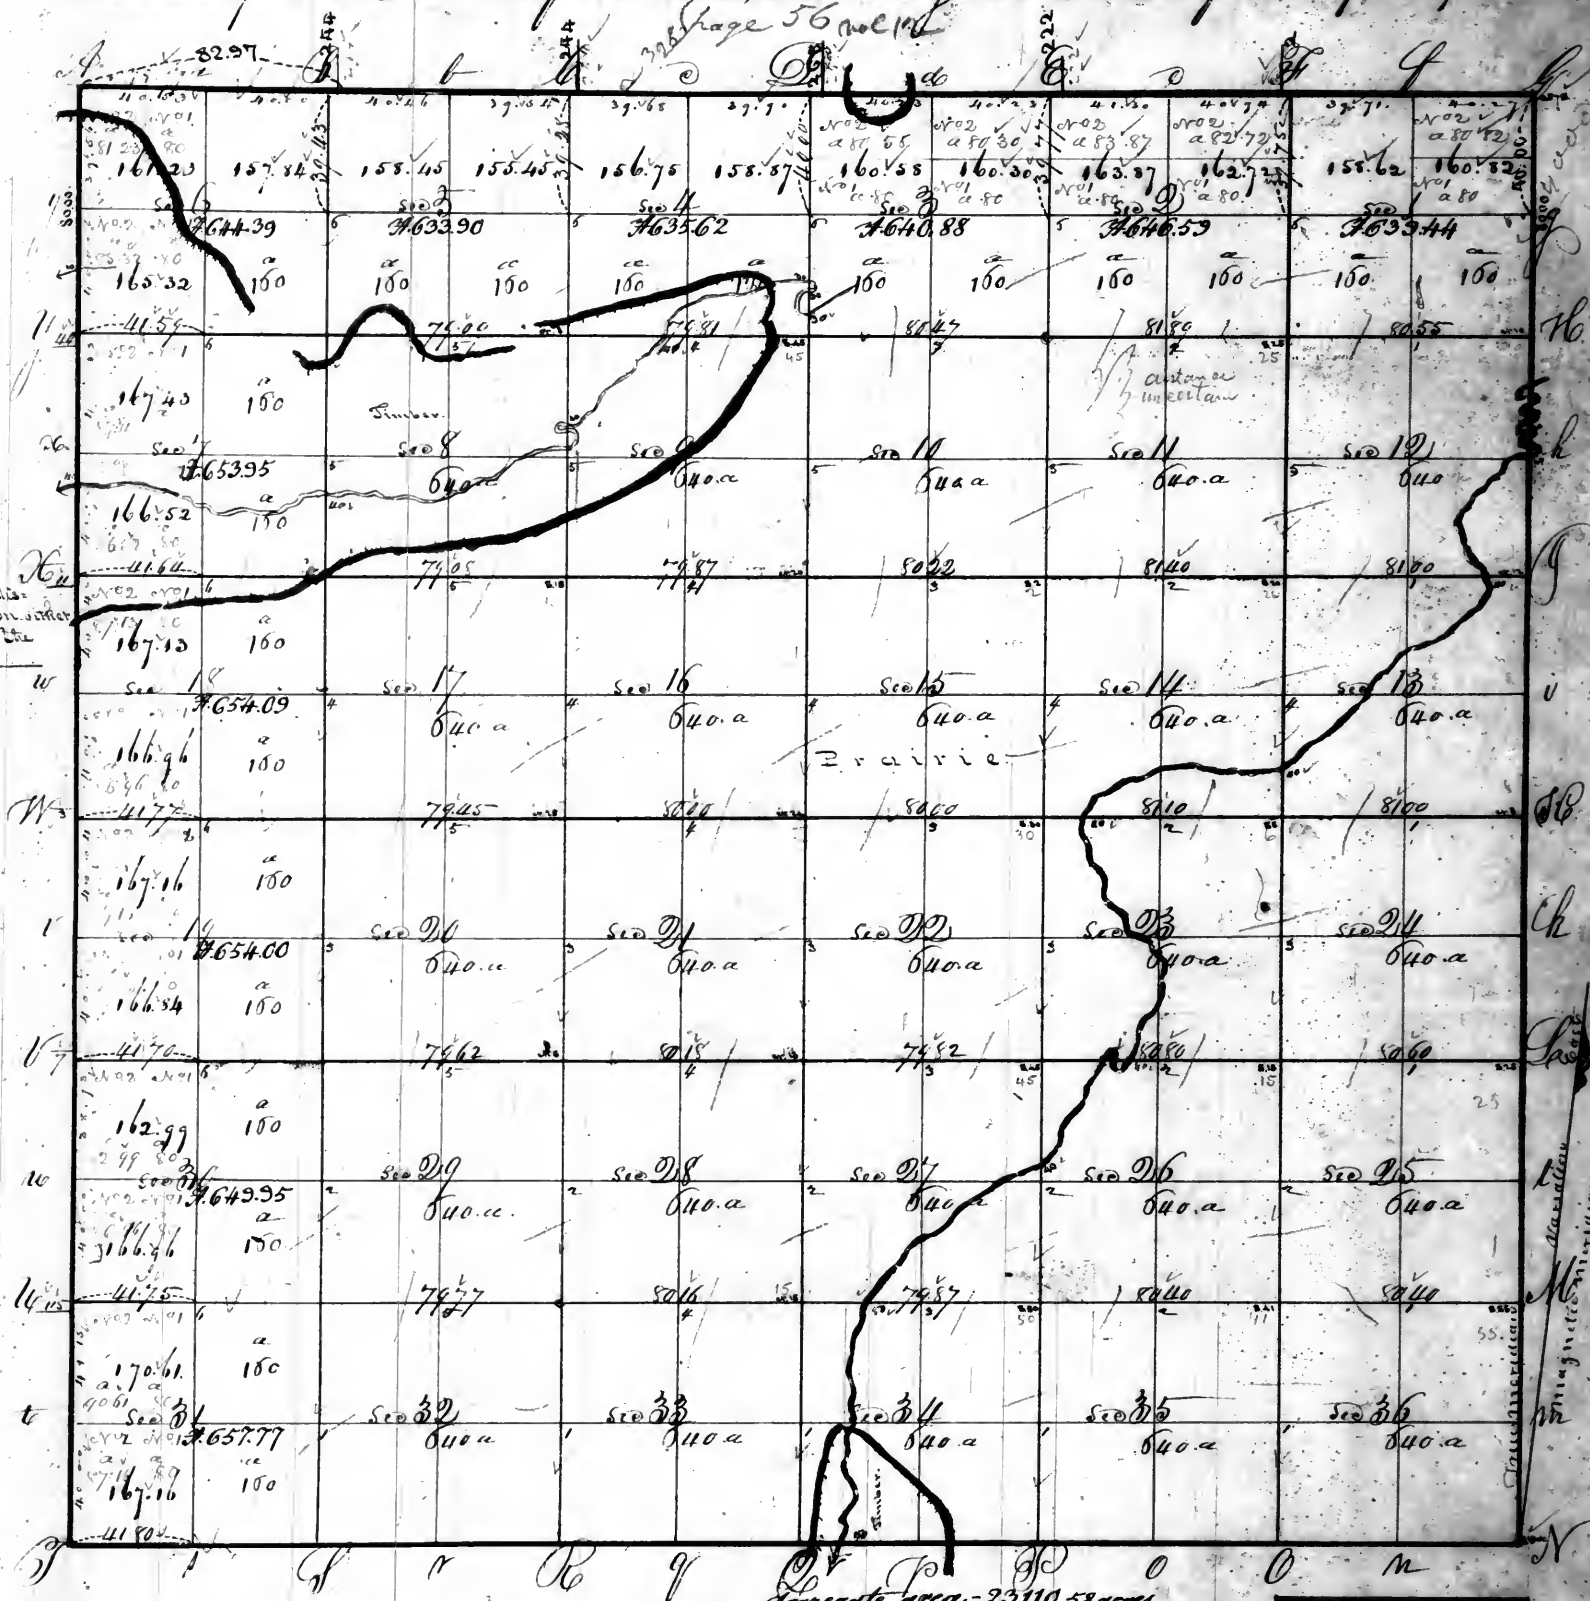

It is not shown in the Original field notes, at what distance the section corner is from the section corner, to which the random was run.

Aggregate area = 23110.53 acres

Scale 40 chains to an inch

Pursuant to a contract with and instructions from William Rector Surveyor of the Lands of the United States in the States of Illinois and Wisconsin and Territory of Arkansas bearing date the 14 of June 1823 I have accordingly laid out and surveyed the above described Township and do hereby certify that it had such marks and bounds both natural as are represented on said plat and ascribed in the field notes made thereof and returned with this plat into the office of the Surveyor of the Lands of the United States in the States of Illinois Wisconsin and Territory of Arkansas


Witnessed this 28th of October 1823

D. W. January D. Surveyor
Assisted by H. Rauls D. Surveyor

Record

Township N 25 North of the Base line Range N 2 West of the 3^d Principal Meridian
 page 58 vol 12

Note: The Boundary line between sections 11, 12, 13, 1000.

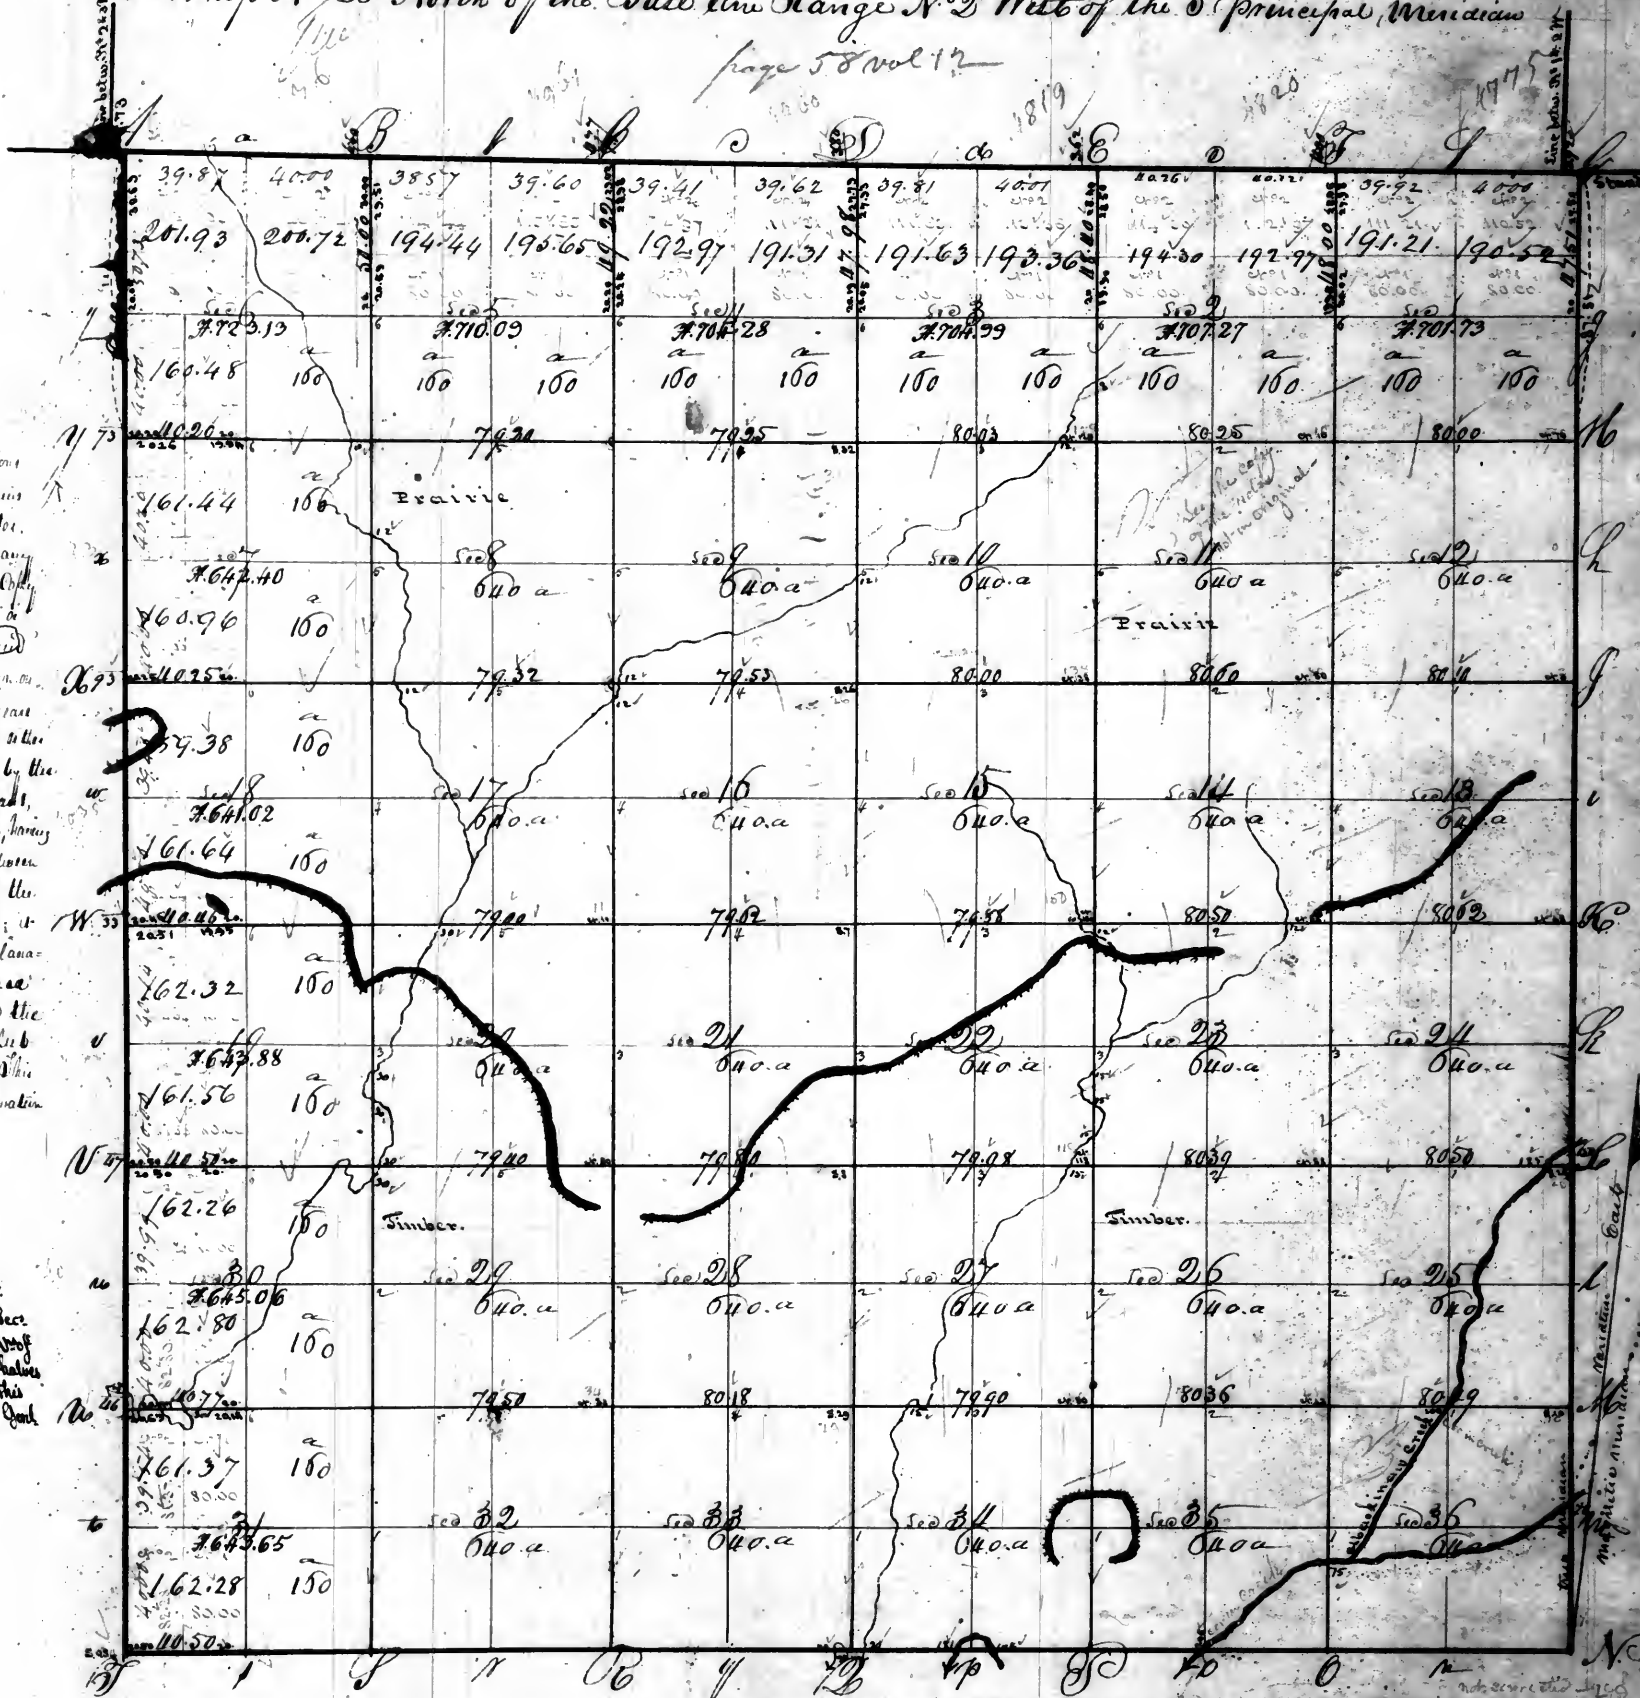

Surveyor's Office
 St Louis 10th August 1822.
 Plat of the North halves of Sec
 12, 13, 14,1000.

Aggregate area = 23467.50 acres


Pursuant to a contract with and instructions from William Peter Surveyor of the Land of the United States in the State of Illinois and Wisconsin and Territory of Arkansas bearing date the 14th day of June 1823 I have examined laid out and surveyed the above described Township and do hereby certify that it has such marks and being both natural and artificial as are represented on said Plat and described the field notes made thereof and returned with this plat into the office of the Surveyor of the Land of the United States in the State of Illinois and Wisconsin and Territory of Arkansas
 Witness this 28th of October 1823

D. C. January D. Surveyor
 Witnessed by W. Rawls J. O.

Recorded

page 59 vol 112

Township No. *Twenty Five* of the base line, Range No. *Two West* of the *Third* principal Meridian.

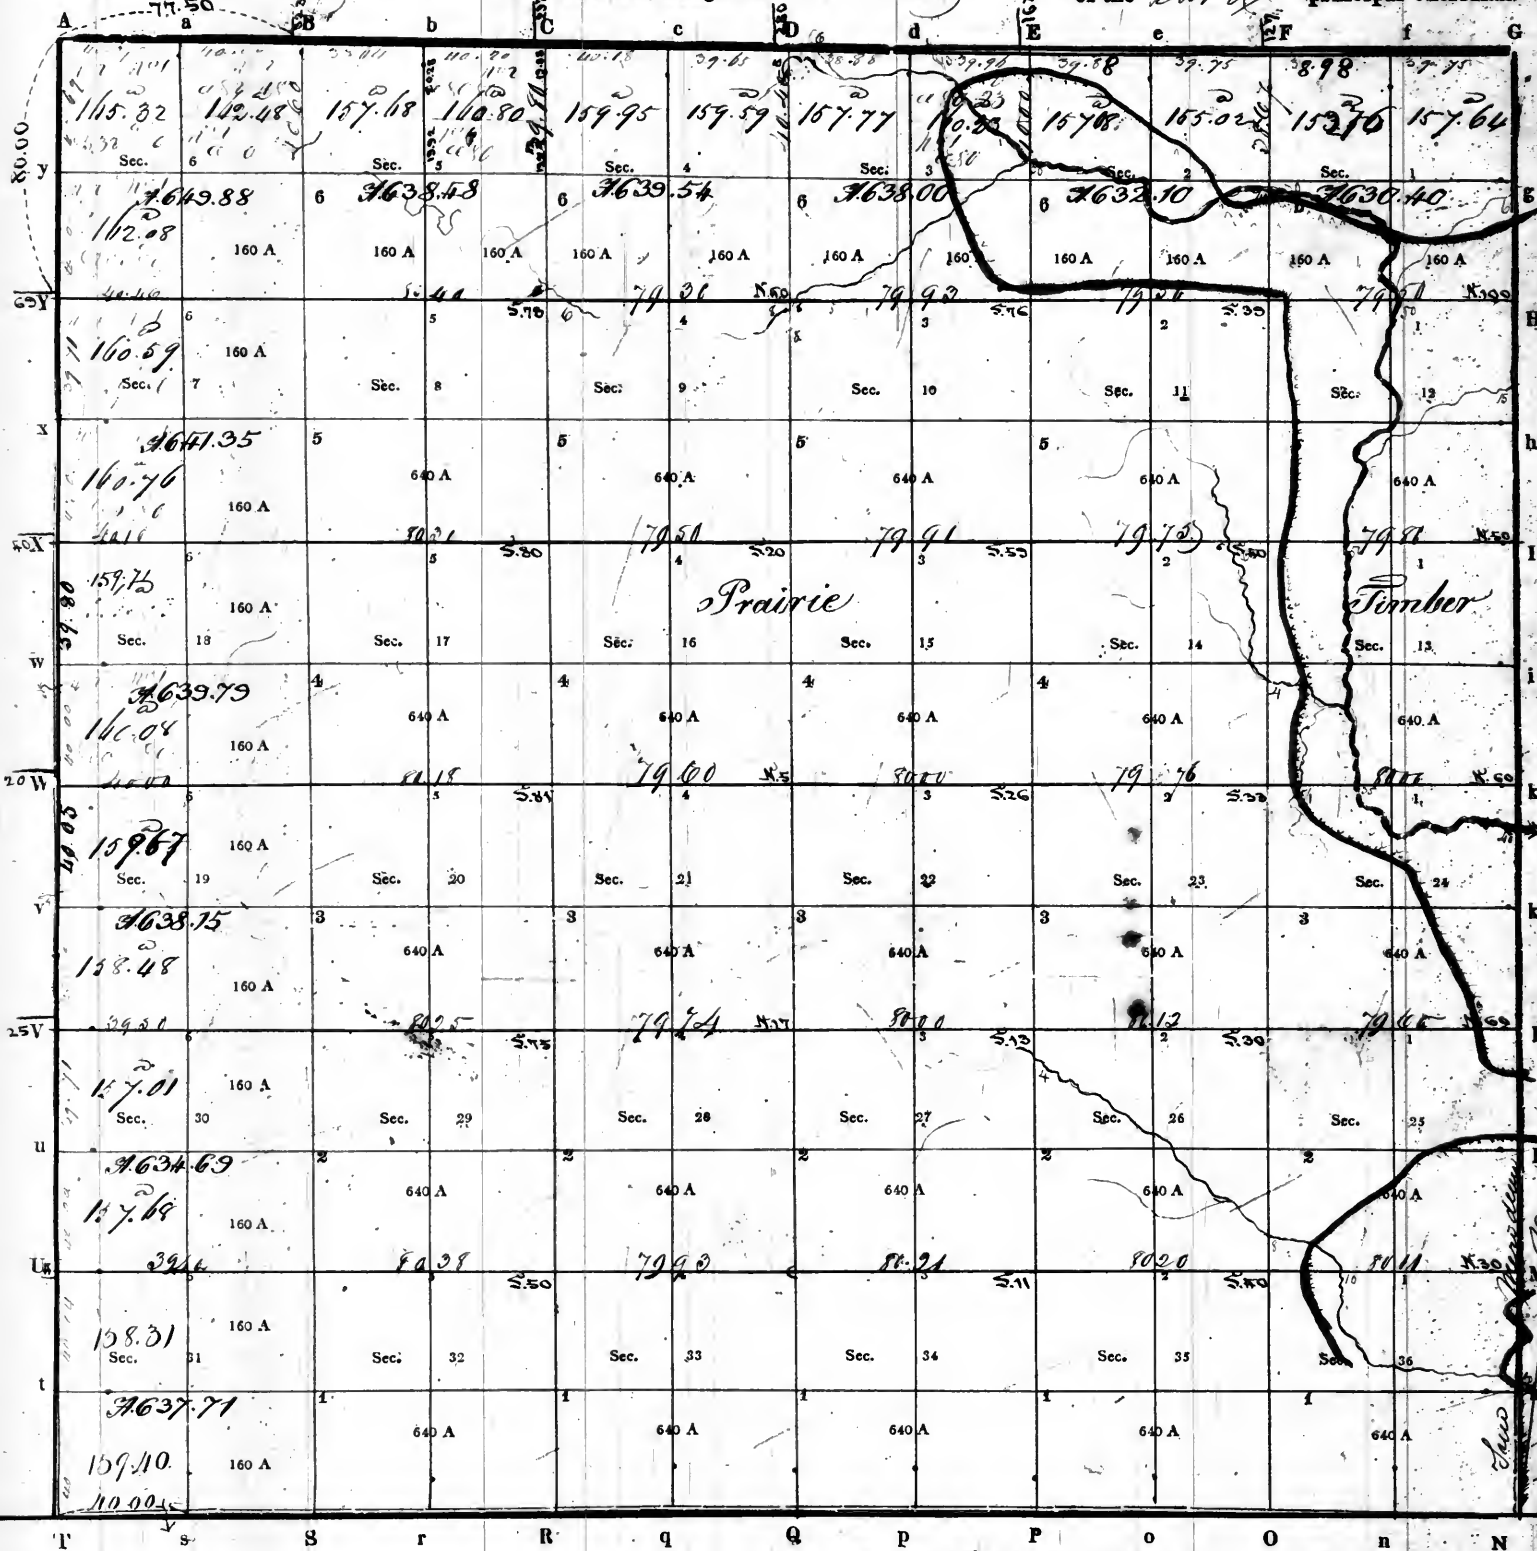

Surveyor's Office
St. Louis 14th August 1842
Plat of the N. E. of Sec. 5 sent
this day to the Commr of the Genl.
Land Office.

Aggregate area - 23020.03 acres

Scale of 40 Chains to an Inch.

PURSUANT to a contract with, and instructions from William Rector, Surveyor of the lands of the United States in the *State of Illinois and Territory of Arkansas* bearing date the *15th* day of *June* 1842 I have measured, laid out and surveyed the above described Township; and do hereby certify, that it had such marks and bounds, both natural and artificial, as are represented on said plat, and described in the field notes made thereof, and returned with this plat into the Office of the Surveyor of the Lands of the United States, in the *State and Territory aforesaid*.

Certified this *19th* day of *June* 1842

EXAMINED.

Wm Clark


William M. B. SURVEYOR

Record

6

Page 60 vol 12

Township No. twenty seven North of the base line, Range No. two West of the third principal Meridian.

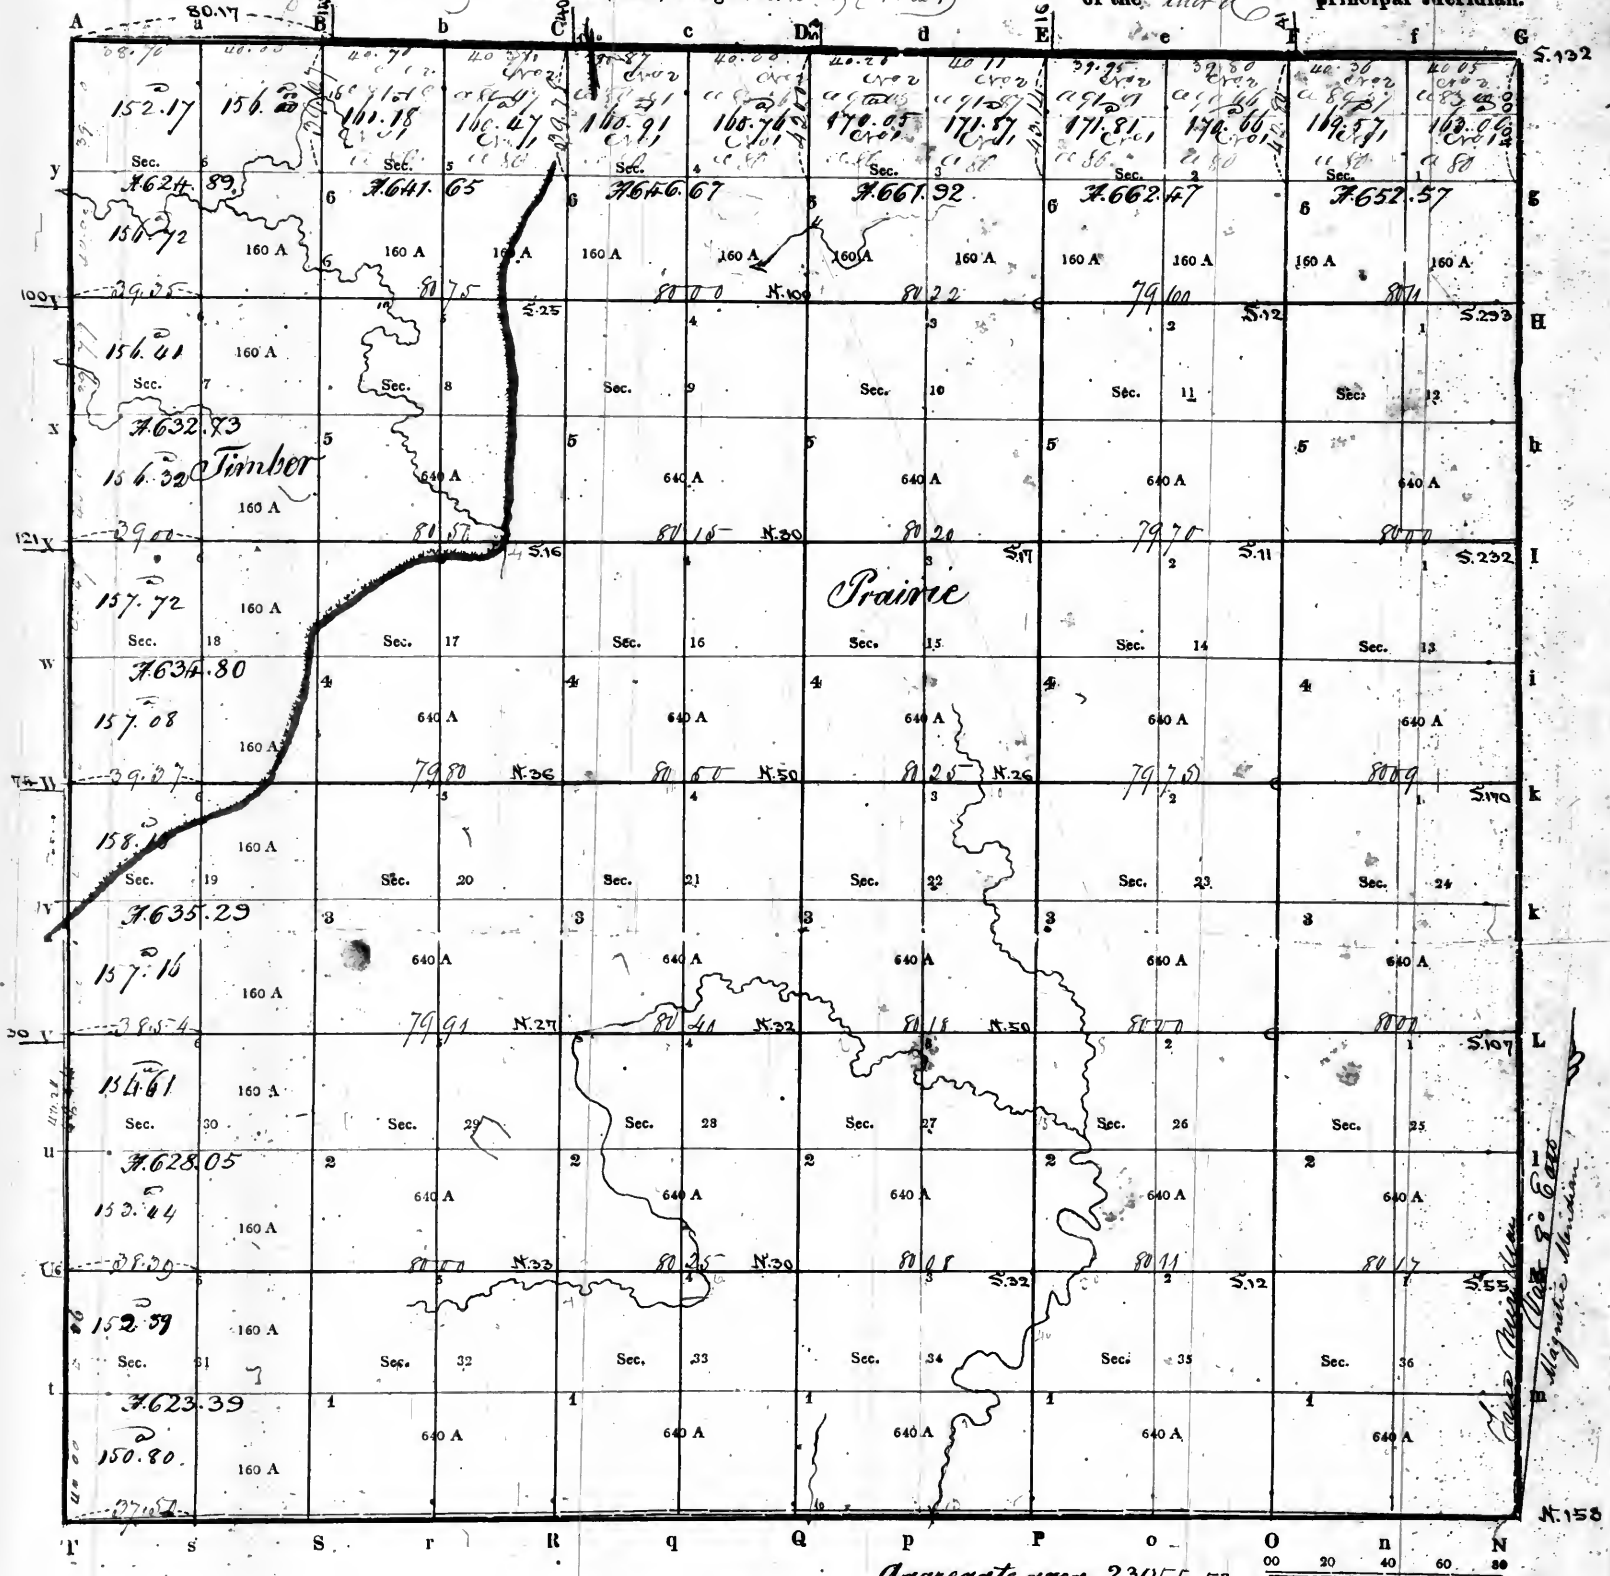

PURSUANT to a contract with, and instructions from William Rector, Surveyor of the lands of the United States in the State of Illinois and bearing date the 15th day of June 1883 I have measured, laid out and surveyed the above described Township; and do hereby certify, that it had such marks and bounds, both natural and artificial, as are represented on said plat, and described in the field notes made thereof, and returned with this plat into the Office of the Surveyor of the Lands of the United States, in the State of Illinois aforesaid.

Certified this 19th day of March 1885

EXAMINED.


Wm Clark

William Rector D. SURVEYOR.

Recorded

61

1861 Nov 12

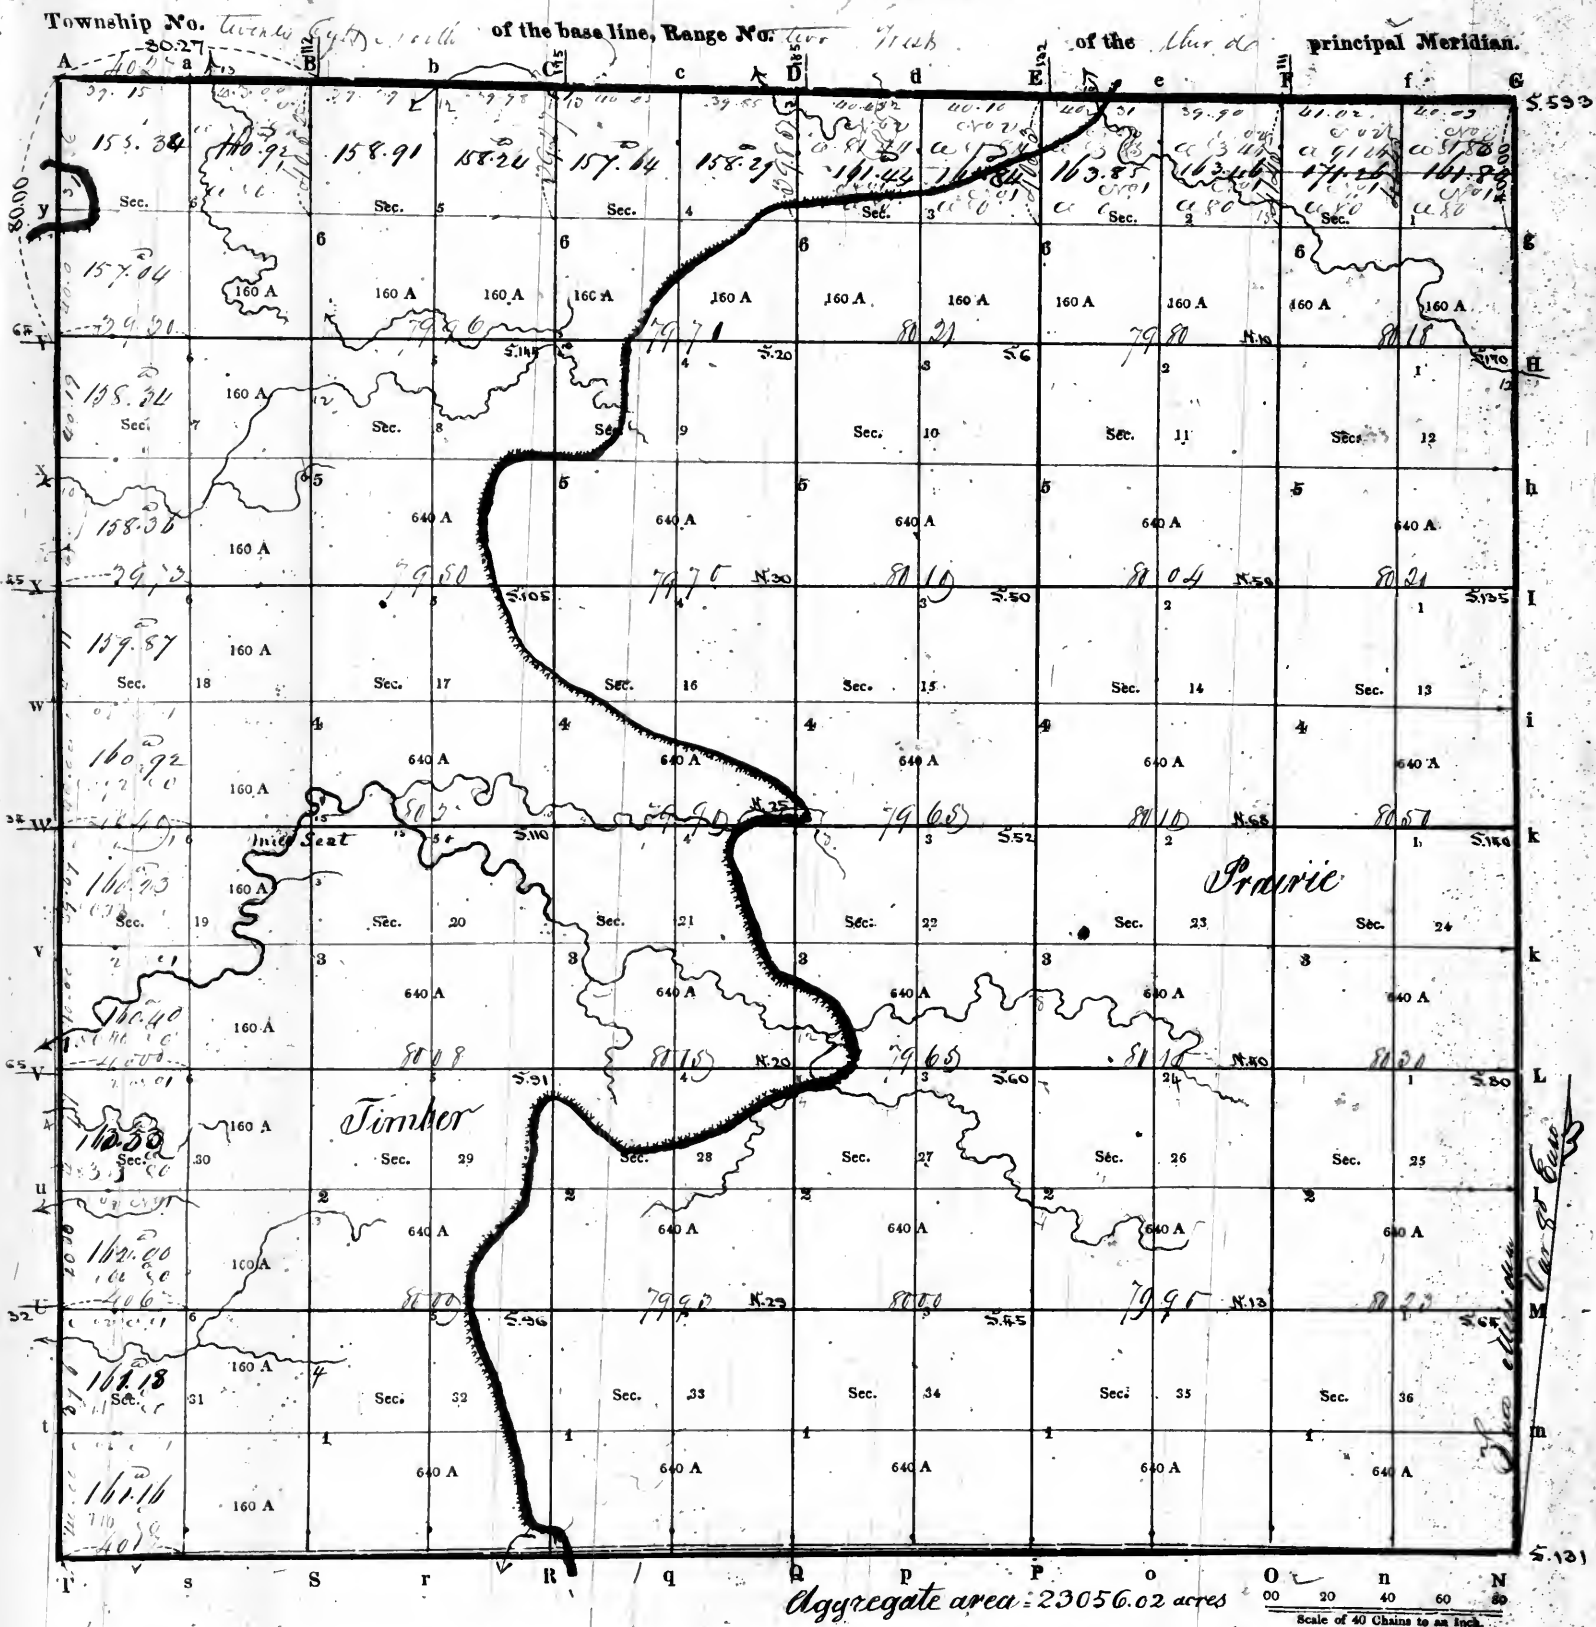

PURSUANT to a contract with, and instructions from William Rector, Surveyor of the lands of the United States in the State of Illinois and bearing date the day of 1861 I have measured, laid out and surveyed the above described Township; and do hereby certify, that it had such marks and bounds, both natural and artificial, as are represented on said plat, and described in the field notes made thereof, and returned with this plat into the Office of the Surveyor of the Lands of the United States, in the State of Illinois.

Certified this 19 day of March 1865

EXAMINED.


W. Clark

William M. D. SURVEYOR.

Recorded

page 62 Vol 12

Township No. *Twenty* *Seven North* of the base line, Range No. *105* *West* of the *third* principal Meridian.

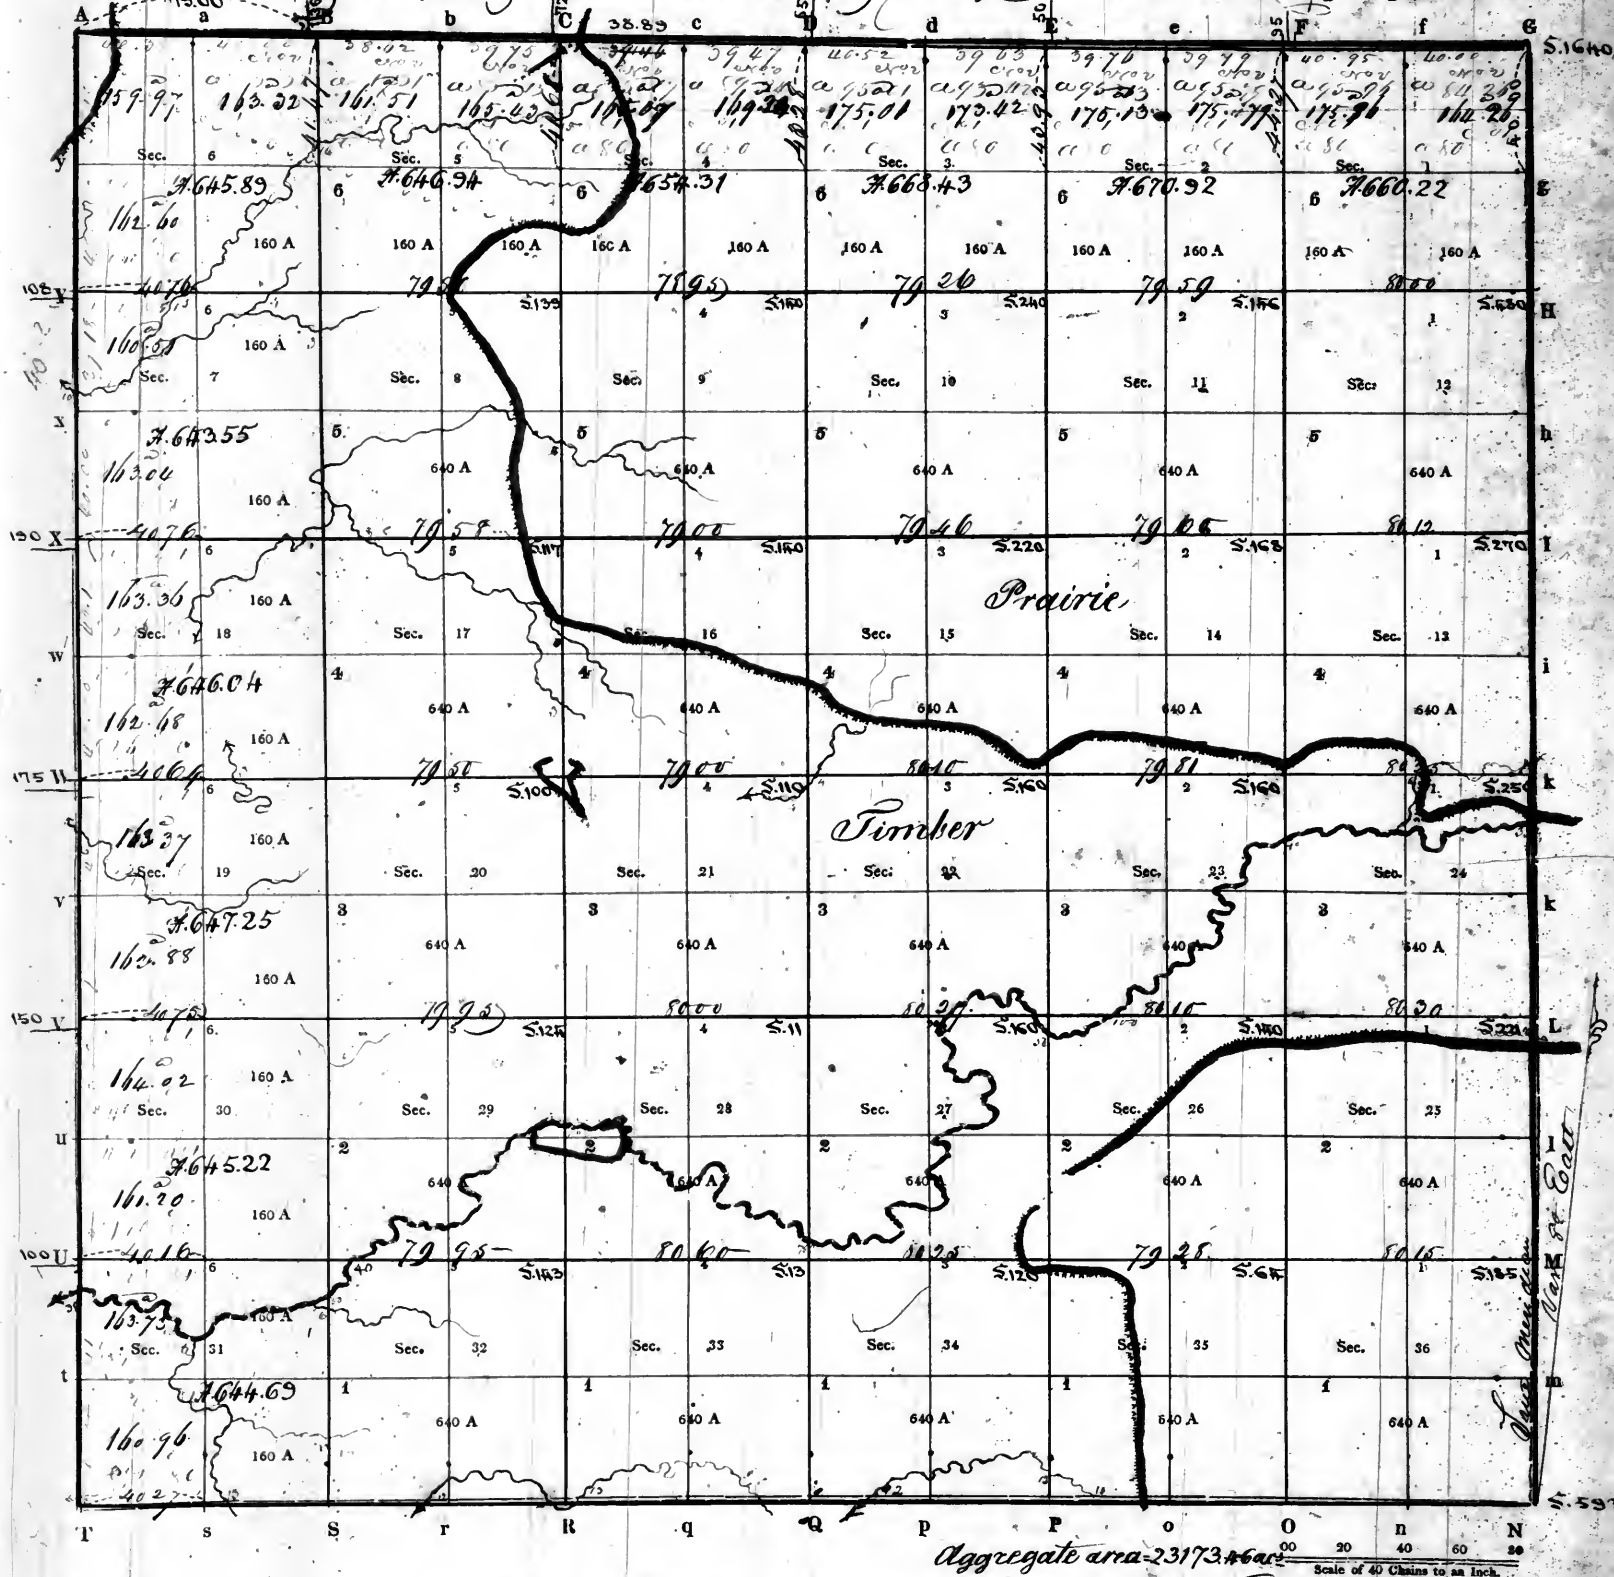

PURSUANT to a contract with, and instructions from William Rector, Surveyor of the lands of the United States in the *State of Illinois and* bearing date the *15th* day of *June* *1825* I have, as directed, laid out and surveyed the above described Township; and do hereby certify, that it had such marks and bounds, both natural and artificial, as are represented on said plat, and described in the field notes made thereof, and returned with this plat into the Office of the Surveyor of the Lands of the United States, in the *State and Territory aforesaid*

Certified this *19th* day of *March* *1825*

EXAMINED.


Wm. Clark

William McArthur D. SURVEYOR

Township N^o thirty North of the base line Range N^o Ten West of the third principal meridian
page 63 vol 12

Recorded

Surveyor's Office St. Louis 26th December 1824 This day a deed was made to the
quarter of Sec 18, under the act of Congress of the 5th of April 1820. and
a plot to the Rep. at Springfield

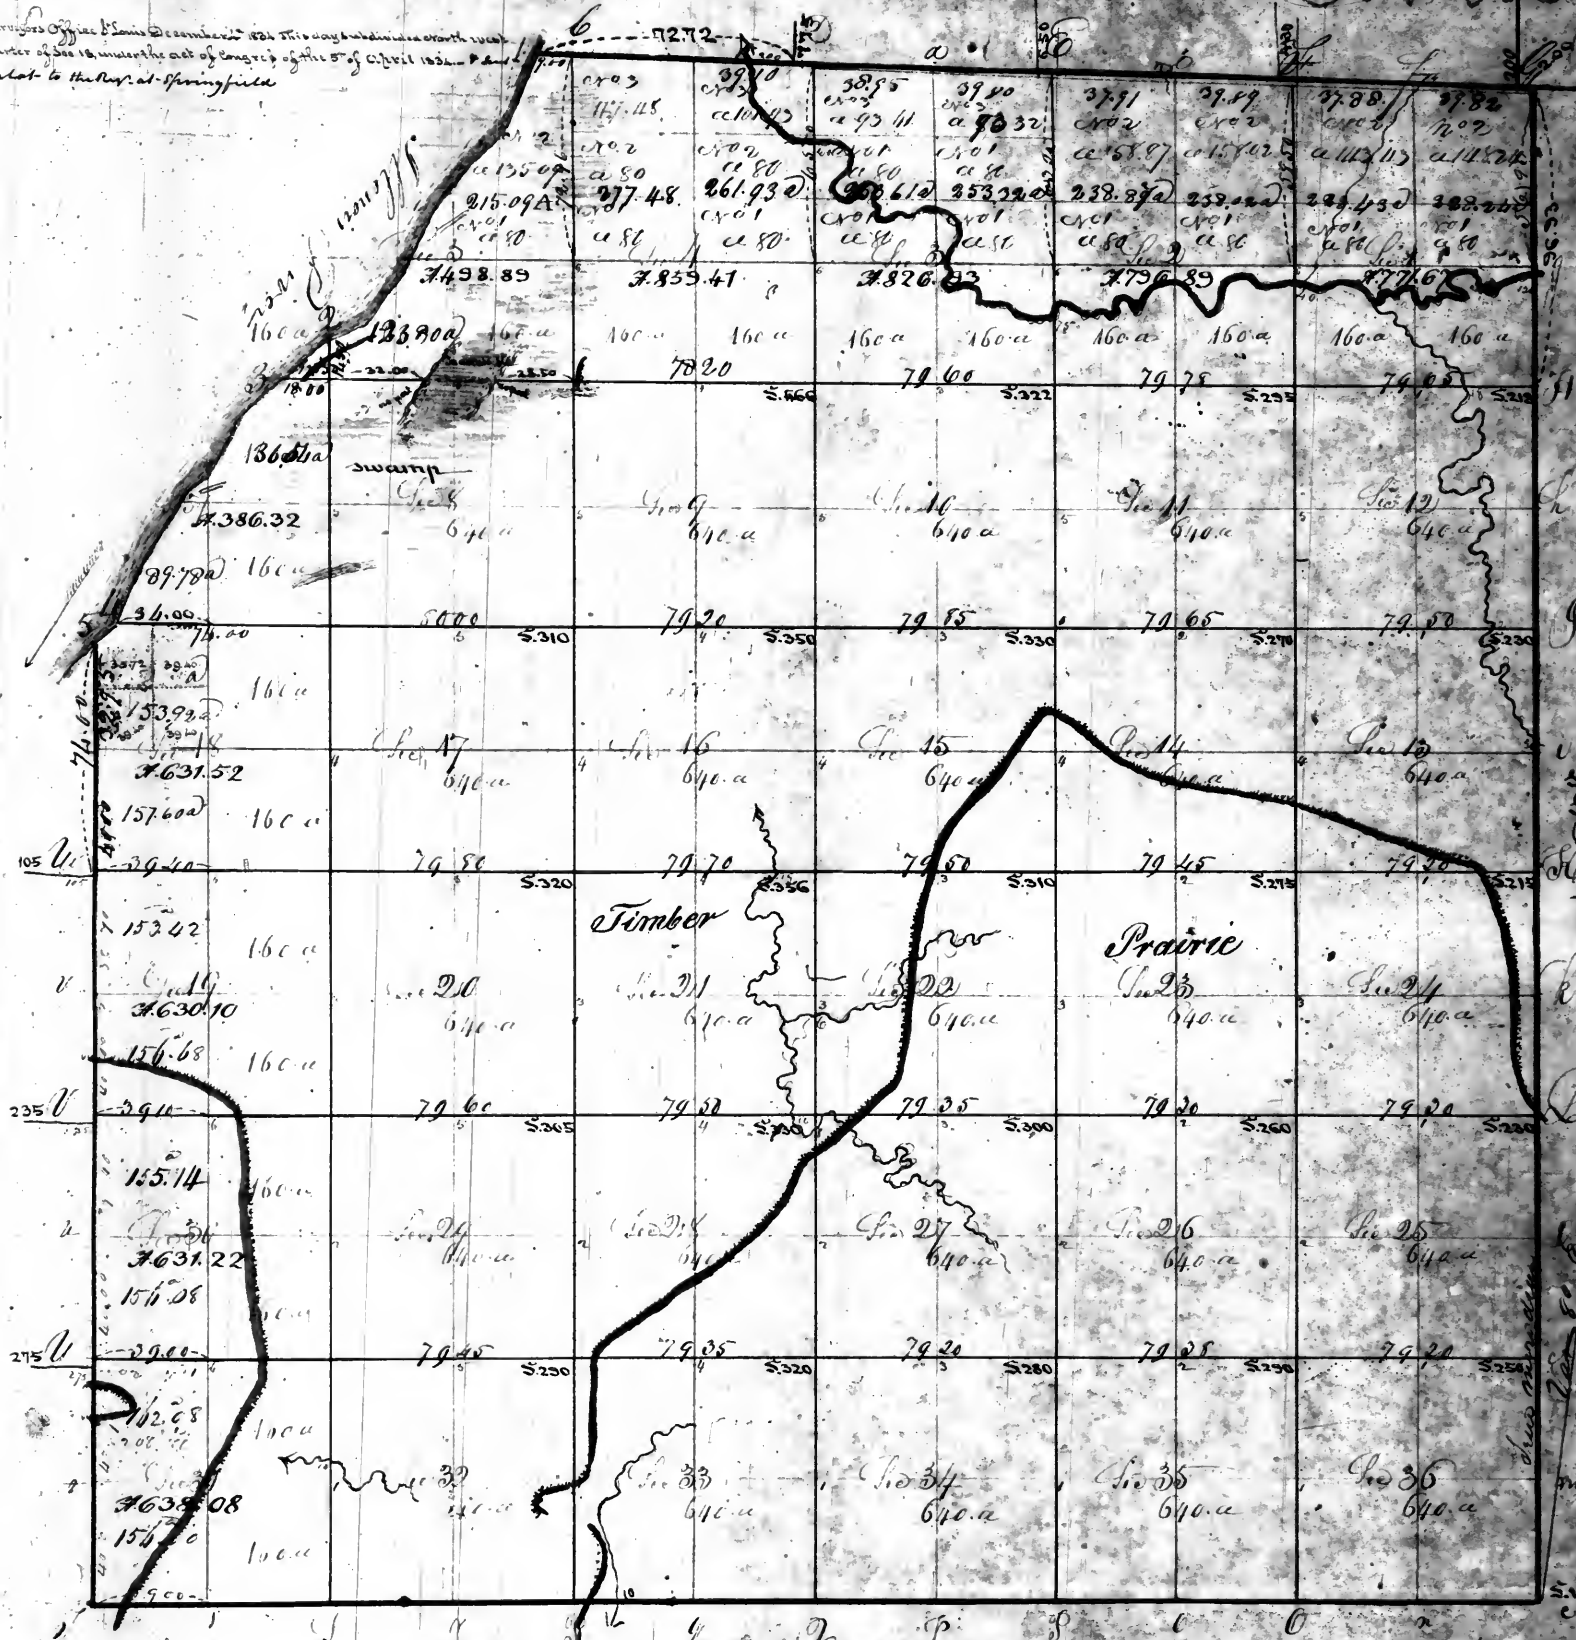

Surveyor's Office
St. Louis 10th August 1825
Deed of the N. W. 1/4
of Sec. 18, sent
this day to the Com.
of the Genl. & C.


Aggregate area - 22684.08 acres

Pursuant to a contract with and instructions from William Reister Surveyor of the Lands of the United States
in the State of Illinois and Missouri and Territory of Arkansas bearing date the 15th day of June 1823
I have with the assistance of B. Murphy L.S.
I have administered land out and Surveyed the above described Township and do hereby certify that it
has been surveyed and bounded both natural and artificial by an upright and said plot and described
in the field notes made thereof and returned with this plot into the office of the Surveyor of the
Lands of the United States in the State of Illinois and Missouri and Territory of Arkansas
Certified this 19th day of March 1825

Wm. Clark

William Williams S^r Surveyor

121.89

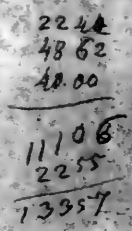

Pursuant to a Contract with and instructions from William Rector Surveyor of the lands of the United States in the States of Missouri and Illinois and Territory of Arkansas bearing date the 10th day of March 1831 --- We have measured laid out and surveyed the above described Tract Township and do hereby certify that it had such Marks and bounds both natural and artificial as are represented on said plat and described in the field notes made thereof and returned with the plat into the office of the Surveyor of the lands of the United States in the States of Missouri and Illinois and Territory of Arkansas.

Certified this _____ day of _____

Surveyed by Peter Popen D. Surveyor
March 1831


Examined

October 18. 21

vol 16

Record 2 1/2 sets

2195
21.23
22 33
22 10
1
69

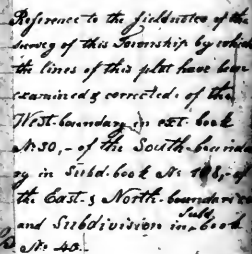

Surveyor's Office
 St. Louis 1st July 1844.
 Subdivided
 under the Act of Congress of the
 5th of April 1820 one Copy of
 the plat filed today one to
 the Register of the District
 Land Office & another to the
 Commr. of the Land-Grant Office
 N.W. quarter of sec. 3.
 N.E. " " " 4.
 Also: subdivided so as
 to conform to previous sales
 as stated by the Register
 on the 4th July 1843, viz
 N.W. quarter of sec. 4.
 N.E. " " " 2.
 N.E. " " " 3.
 N.W. of section 5.
 S.W. qr. of " 6.
 N.W. " " 14750.


Pursuant to a Contract with and Instructions from Jonah Mayo Esq. Surveyor General of the United States bearing date the 6th day of June D 1814 I have accordingly laid out and Surveyed the above Township described and do hereby certify that it had such marks and bounds both natural and artificial as are represented on said plat and described in the field notes made thereof and returned with the plat into the Surveyor General's office. Certified this 27th day of March D 1815

Surveyors Office
St. Louis

The lines of the above plat of Township 10 North of the base line in Range 3 West of the 3rd principal Meridian have been examined by the notes of the survey thereof referred to in the margin and corrected conformably therewith.

Record 2 plots

Township N 2 North of the Base line Range 3 West of the 3rd Principal Meridian

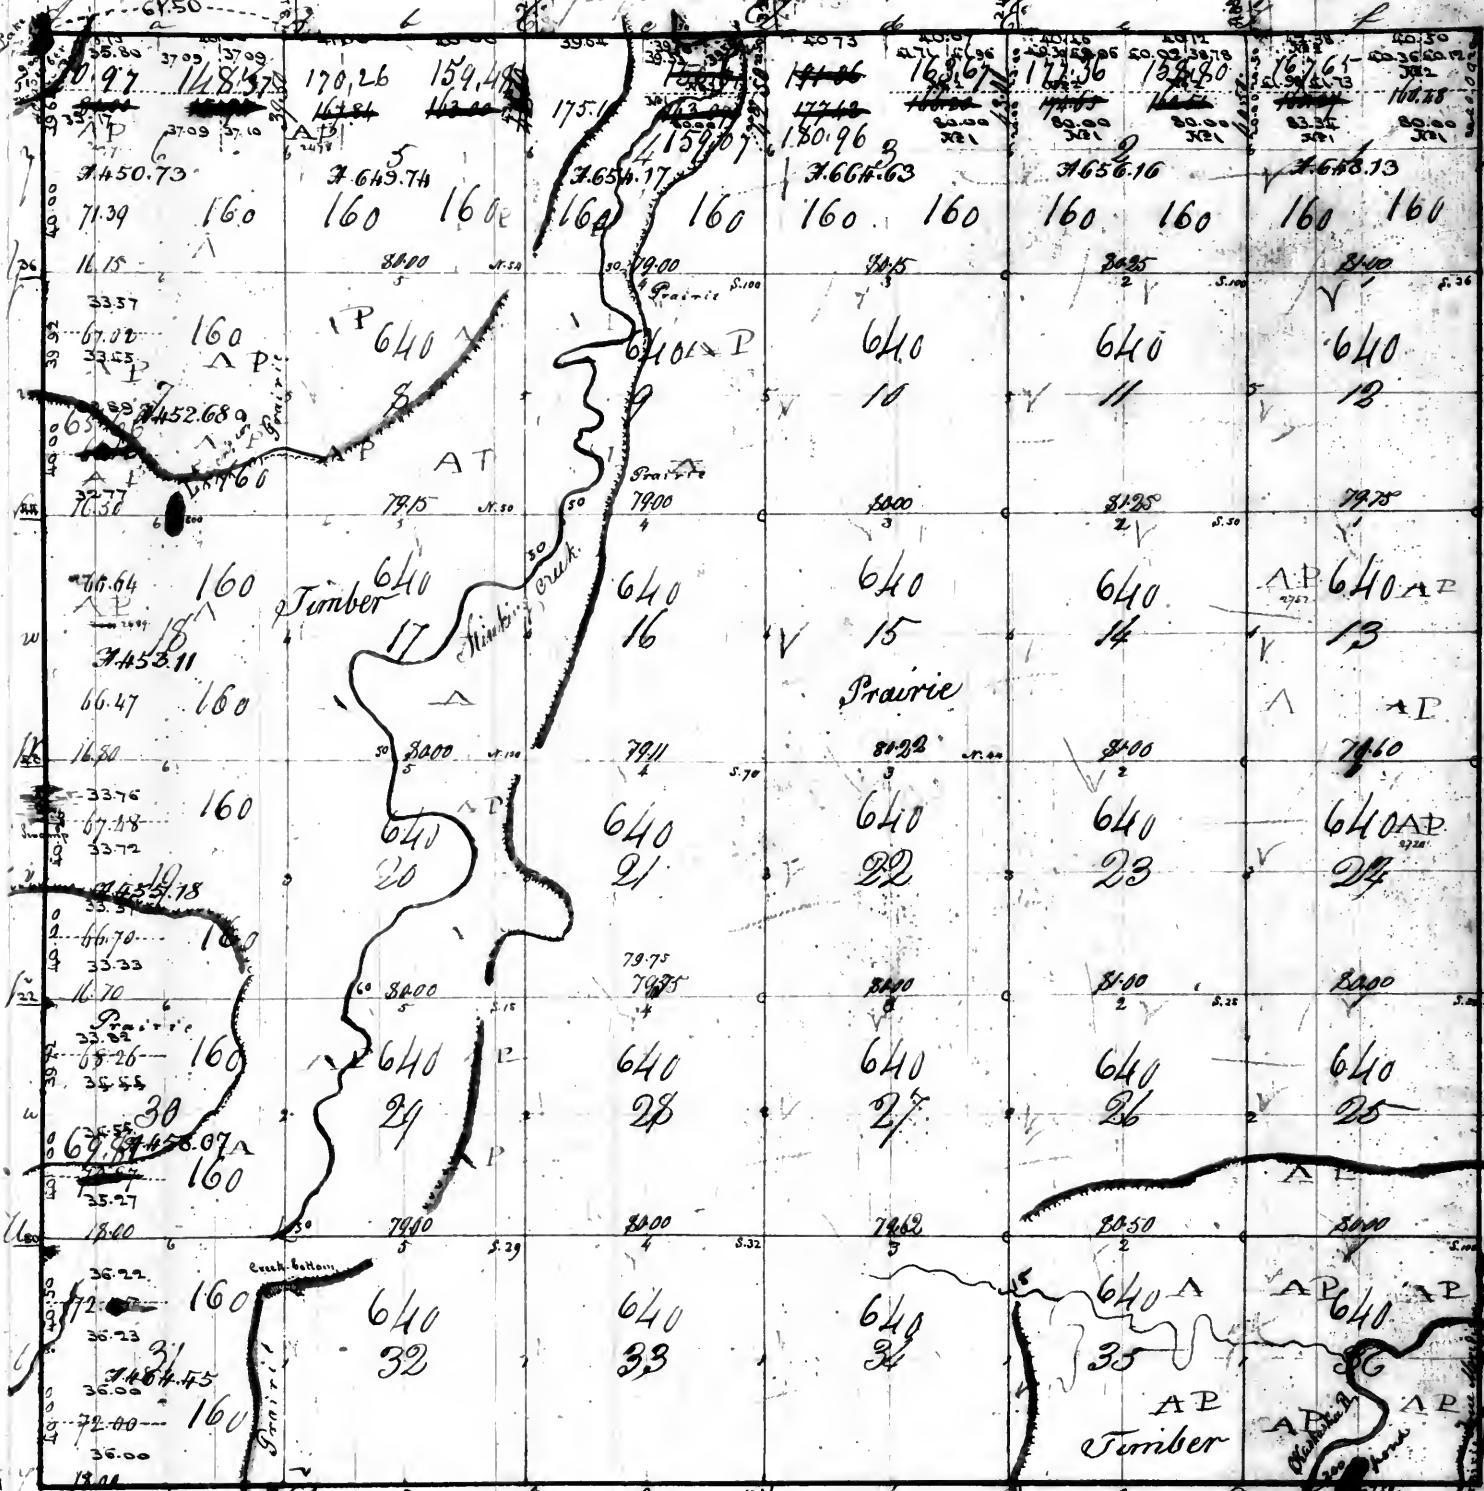



Surveyor's Office
St. Louis, Mo.
under the Act of Congress of the 5th of April 1820 and copies of the plat. Great survey now to the Register of the district Court under the Great Land Office, viz:
1/4th of section 10.
1/4th of section 11.
Pursuant to a contract with and instructions from Smith Meigs Esq. Surveyor General of the United States bearing date the 6th day of June Anno Domini 1814 I have measured laid out and surveyed the above described town and I do hereby certify that it had such marks and bounds both for Natural and Artificial as are represented on said plat and ~~discrepancy~~ in the field notes made thereof and returned with the plat into the Surveyor General's office. Certified this 27th day of March Anno Domini 1815

[Signature]

Surveyors Office
St. Louis

The lines of the above plat of Township 2 North of the base line in Range 3 West of the 3rd principal Meridian have been examined by the notes of the Survey thereof and corrected conformably therewith

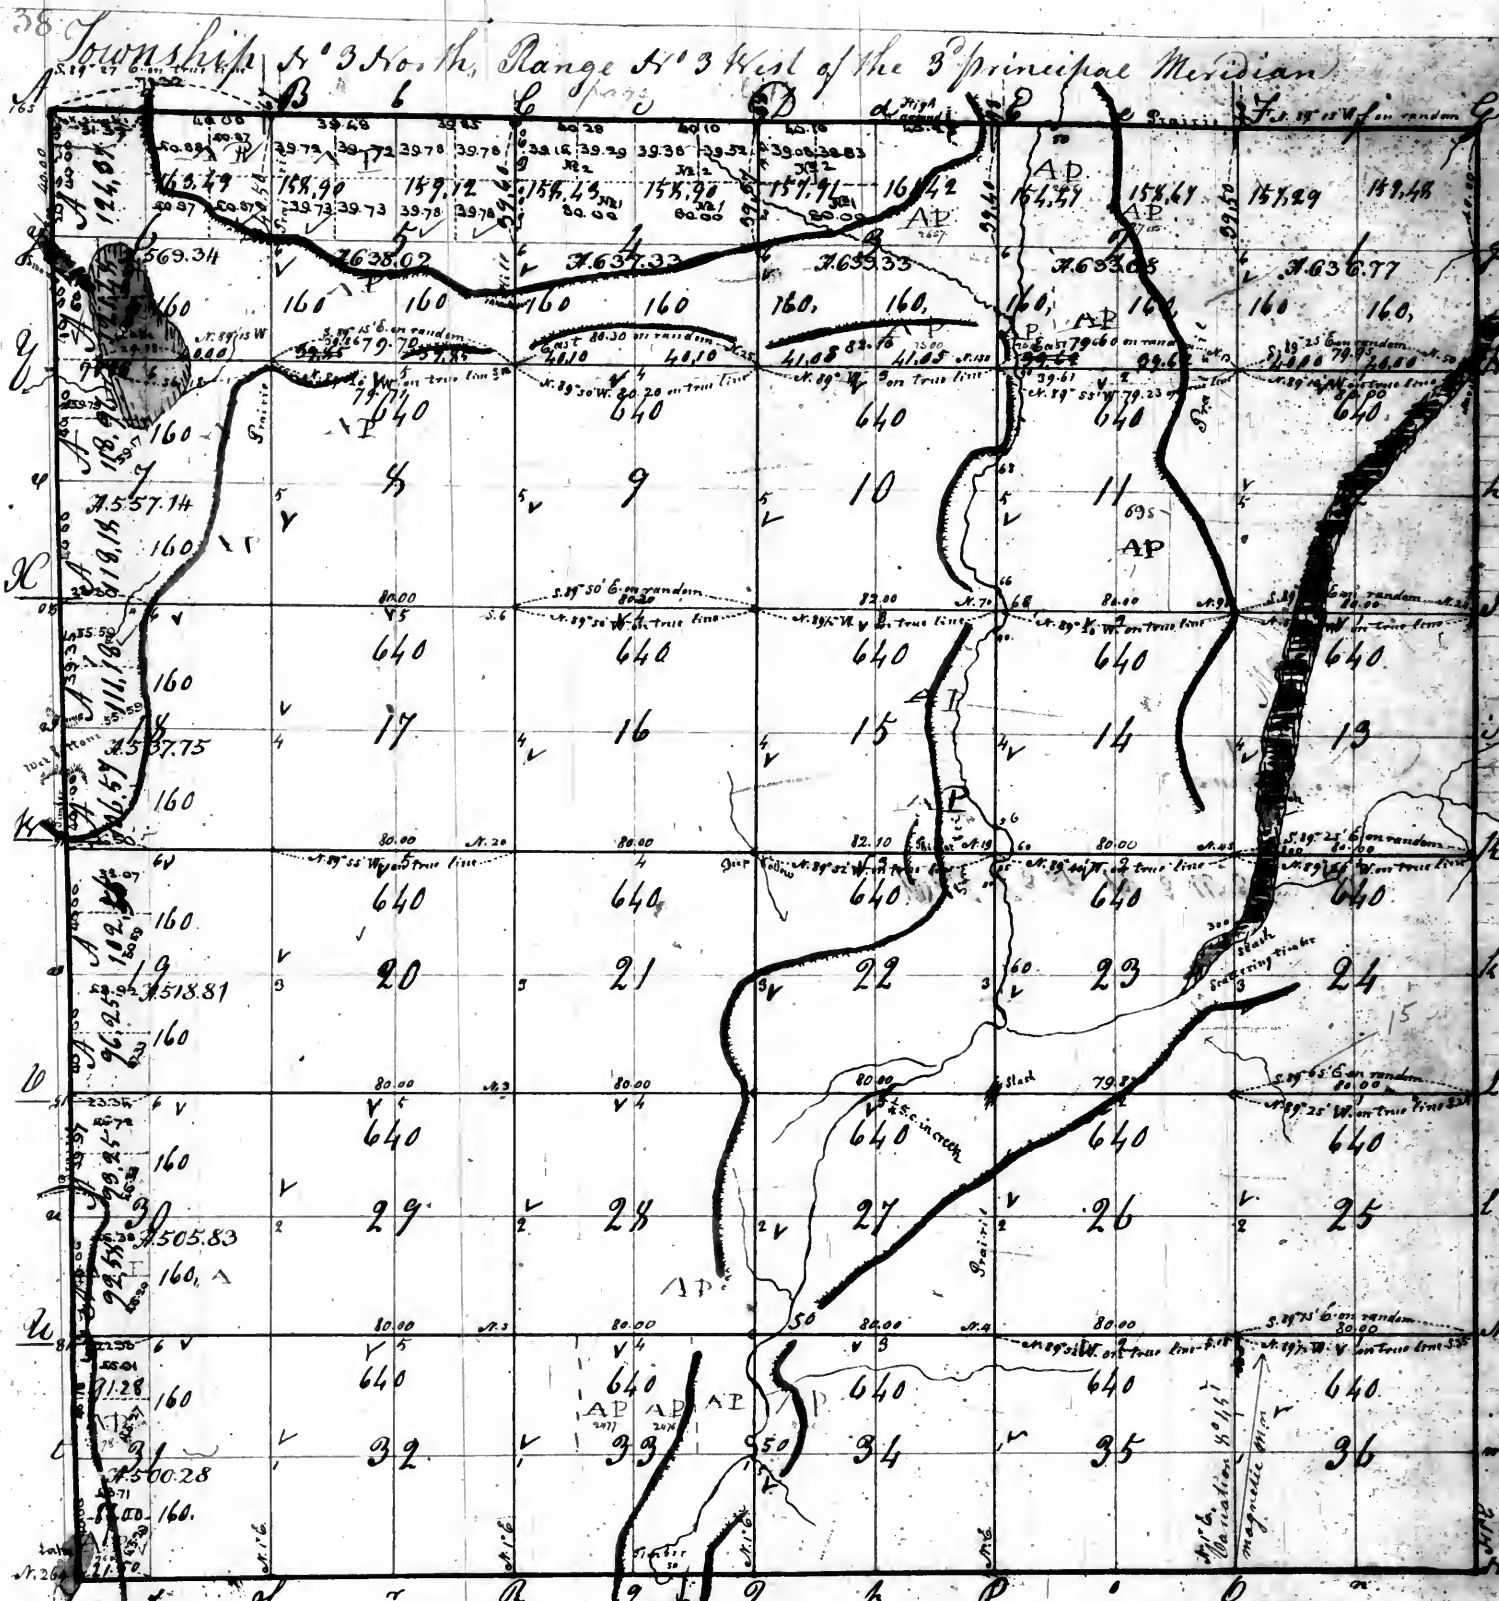

Reference to the fieldnotes of the survey of this Township by which the lines of this plat have been examined & corrected, of the West boundary in sec. 30, - of the South boundary in Sec. 30, - of the North & East boundaries and subdivisions in Sub. Sec. 35. -

The East boundary and Subdivision North & South lines of this Township were run on Feb. 1854. -

The line between Sec. 6 & 7 was surveyed according to the fieldnotes only to the West side of the Lake Sec. 36. 18. ch. 28. 15 W. from the cor. of Sec. 36. 7. 3. -

The true line between Sec. 3 & 4 is stated in the fieldnotes to have been run N. 89° 20' W. through the falling of the random line was S. 12° 10' E. from the post, - and also the line between Sec. 25 & 26 to have been run S. 89° 15' W. although the falling of the random line was S. 35° 10' E. from the post.

Surveyor's Office
St. Louis 1st Feb. 1854.

Subdivided under the Act of Congress of the 5th of April 1820 and copies of the plat sent today one to the Reg^r of the district and another to the Genl. Land office, viz:
NW quarter of section 3.
NW quarter " " 4.
NW quarter " " 7.
NW 1/4 of sections 19 & 30.
NW 1/4 of section 31, - also: Subdivided so as to conform to previous sales as stated by the Register on the 4th July 1843 viz:
NW 1/4 of section 5.
NW 1/4 of section 6.
NW 1/4 of section 18. (2)
on the NW quarter of sec. 31.

Pursuant to a Contract with and instructions from Josiah Meigs Surveyor General of the United States bearing date the day of 1814, I have admeasured, laid out and surveyed the above described Township, and do certify that it has such marks and bounds both natural and artificial, as are represented on said plat and described in the field notes made thereof and returned with this plat into the Surveyor General's Office.


Certified the 23 day of May 1815

J. M. Simpson

Surveyor's Office
St. Louis

The lines of the above plat of Township 3 North of the Base line in Range 3 West of the 5th principal Meridian have been examined by the fieldnotes of the survey thereof referred to in the margin & corrected conformably therewith.

Record 2 plots

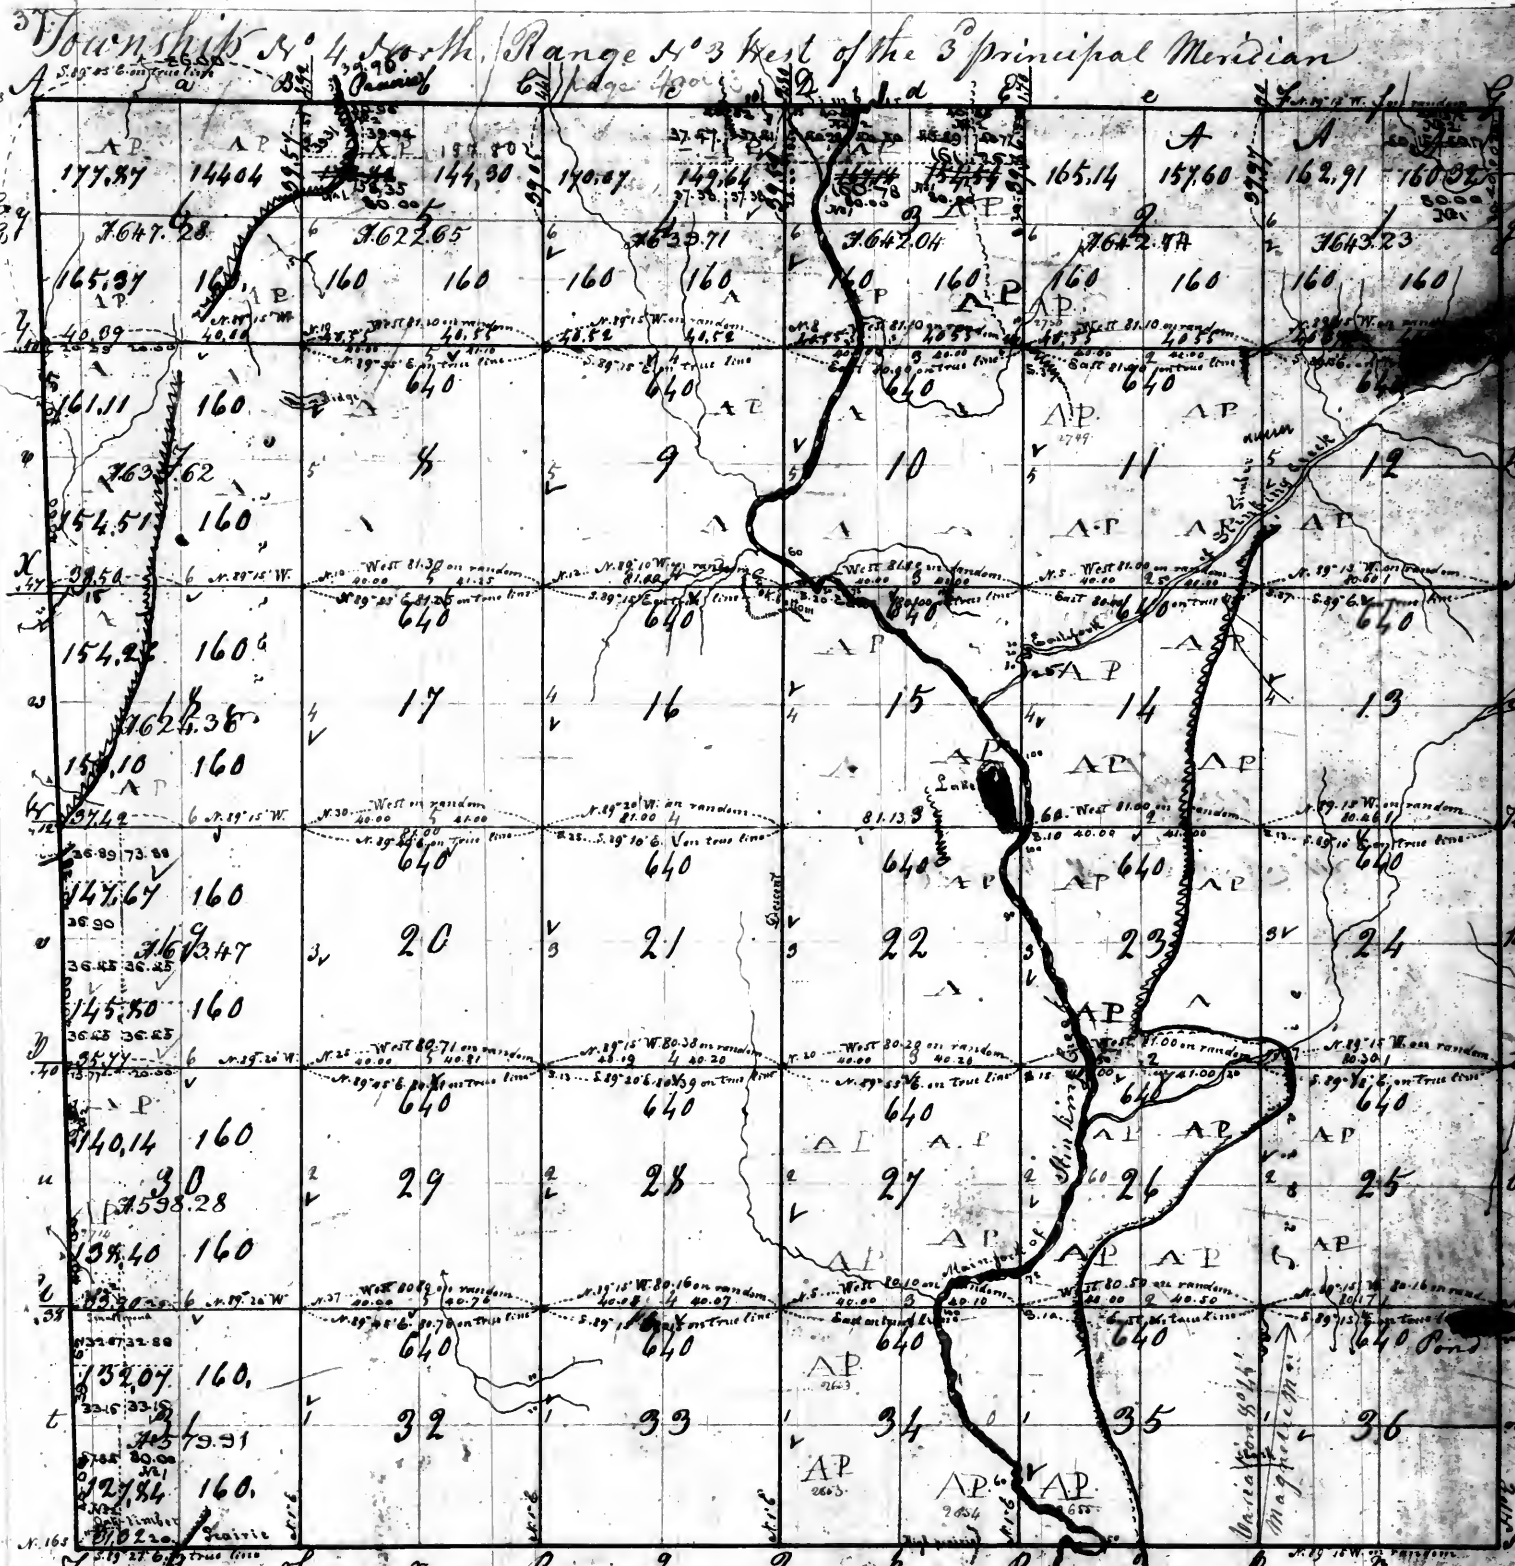

Reference to the fieldnotes of the survey of this Township by which the lines of this plat have been examined and corrected - of the West boundary in act. book 149, - of the South boundary in book 38, - of the North and East boundaries and Subdivisions in Sub. book 137.


Surveyors Office
St. Louis 1st Feb. 1845
Subdivided
under the Act of 1832 (and dated today) copies of the plat one to the Regt. of the District (and another to the General Land Office) viz:
16 quarter of - 1
N. 1/2 3
N. 1/4 gr. 5
N. 1/4 gr. 31
also: subdivided so as to conform to previous sales as stated by the Register on the 4th July 1845, viz:
16 gr. of section 4
N. 1/4 and N. 1/4 gr. sec. 19. and
N. 1/4 gr. of section 31.

Pursuant to a contract with and instructions from Josiah Meigs, Surveyor General of the United States, bearing date the day of 1844 I have admeasured laid out and surveyed the above described Township and do Certify that it had such marks and bound. both natural and artificial as are represented on said plat and described in the field notes made thereof and returned with this plat into the Surveyor General's Office.
Certified this 28th day of May 1845
Meigsinger

Surveyors Office
St. Louis

The lines of the above plat of Township 4 North of the base line in Range 3 West of the 3rd principal Meridian have been examined by the fieldnotes of the survey thereof referred to in the margin and corrected conformably therewith.

Township No. 5 North, Range 3 West of the 3rd principal Meridian

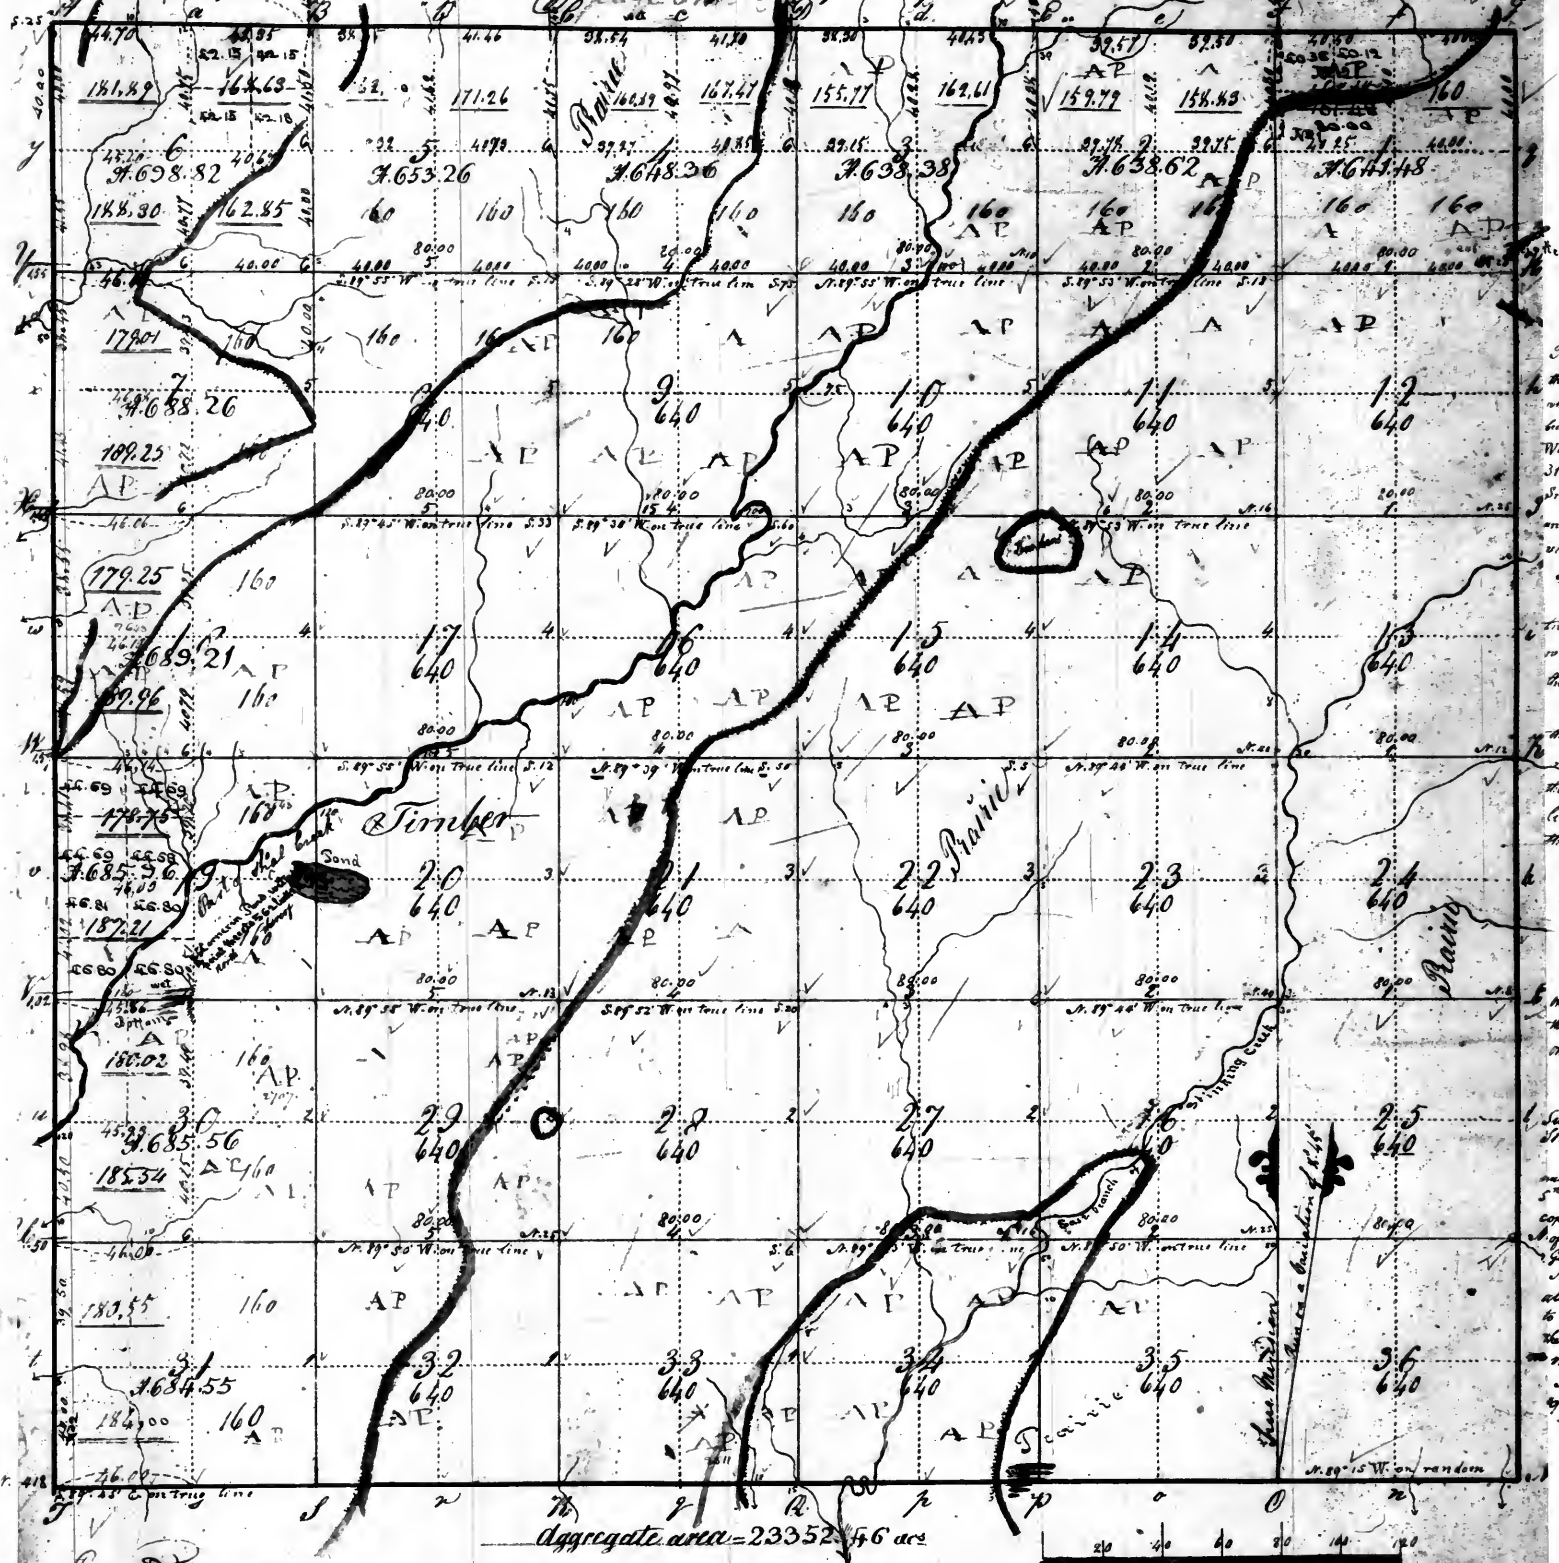

Reference to the field notes of the survey of this Township, which the lines of this plat have been examined & compared, of the West boundary in S. 16, S. 17, S. 18, S. 1000.

Note: A length of the line between Sec. 152 is not placed within the plat of the survey thereof. According to the field notes the true line between Sec. 152 and Sec. 153 was run N. 19° 39' W. along the falling of the sandstone line was 5.50 links from the post.

Variations: In West boundary not stated in the field notes. In all the other lines 8 to 10 links.

Subdivided under the Act of Congress of the 5th of April 1820 and said survey copies of the plat are to the Reg. of the District and another to the Sec. Land Office, viz: NW quarter of section 1, also subdivided so as to conform to previous Sale as stated by the Register on the 11th July 1823. Sec. 6, sec. 19.

Examined and Rectified, Surveyor of the Lands of the United States in the Territory of Missouri.


Pursuant to a Contract with and Instructions from Josiah Meigs Surveyor General of the United States bearing date the 20th day of September, 1814 - I have administered laid out and surveyed the above described Township and do hereby certify that it had such Marks and bounds both natural & artificial as are represented on said Plat and described on the field notes taken thereof and returned with the Plat into the Surveyor's Office. Certified this 21st day of June 1816. J. C. Brown, Surveyor of the Lands of the United States in the Territory of Missouri.

Surveyor's Office St. Louis 3rd of December 1841.

The lines of the above plat of Township 5 North of the base line in Range 3 West of the 3rd principal Meridian is substantially conformable to the field notes of the survey thereof on file in this Office, which have been examined and approved. The west boundary 6 miles was surveyed in January 1814, by John Milton Moore, under the Contract of 20th of July 1813 - The South boundary 6 miles and 8 Ch. was surveyed in April 1815 - The North boundary 6 miles 4.70 chains, and the East boundary 6 miles, was surveyed in January 1816 - and the Subdivision lines were surveyed in January & February 1816, by John Meigs, under Contract of the 20th of September 1814.

Jos. C. Brown, Surveyor of the public land for the District of Missouri & Missouri.

Record

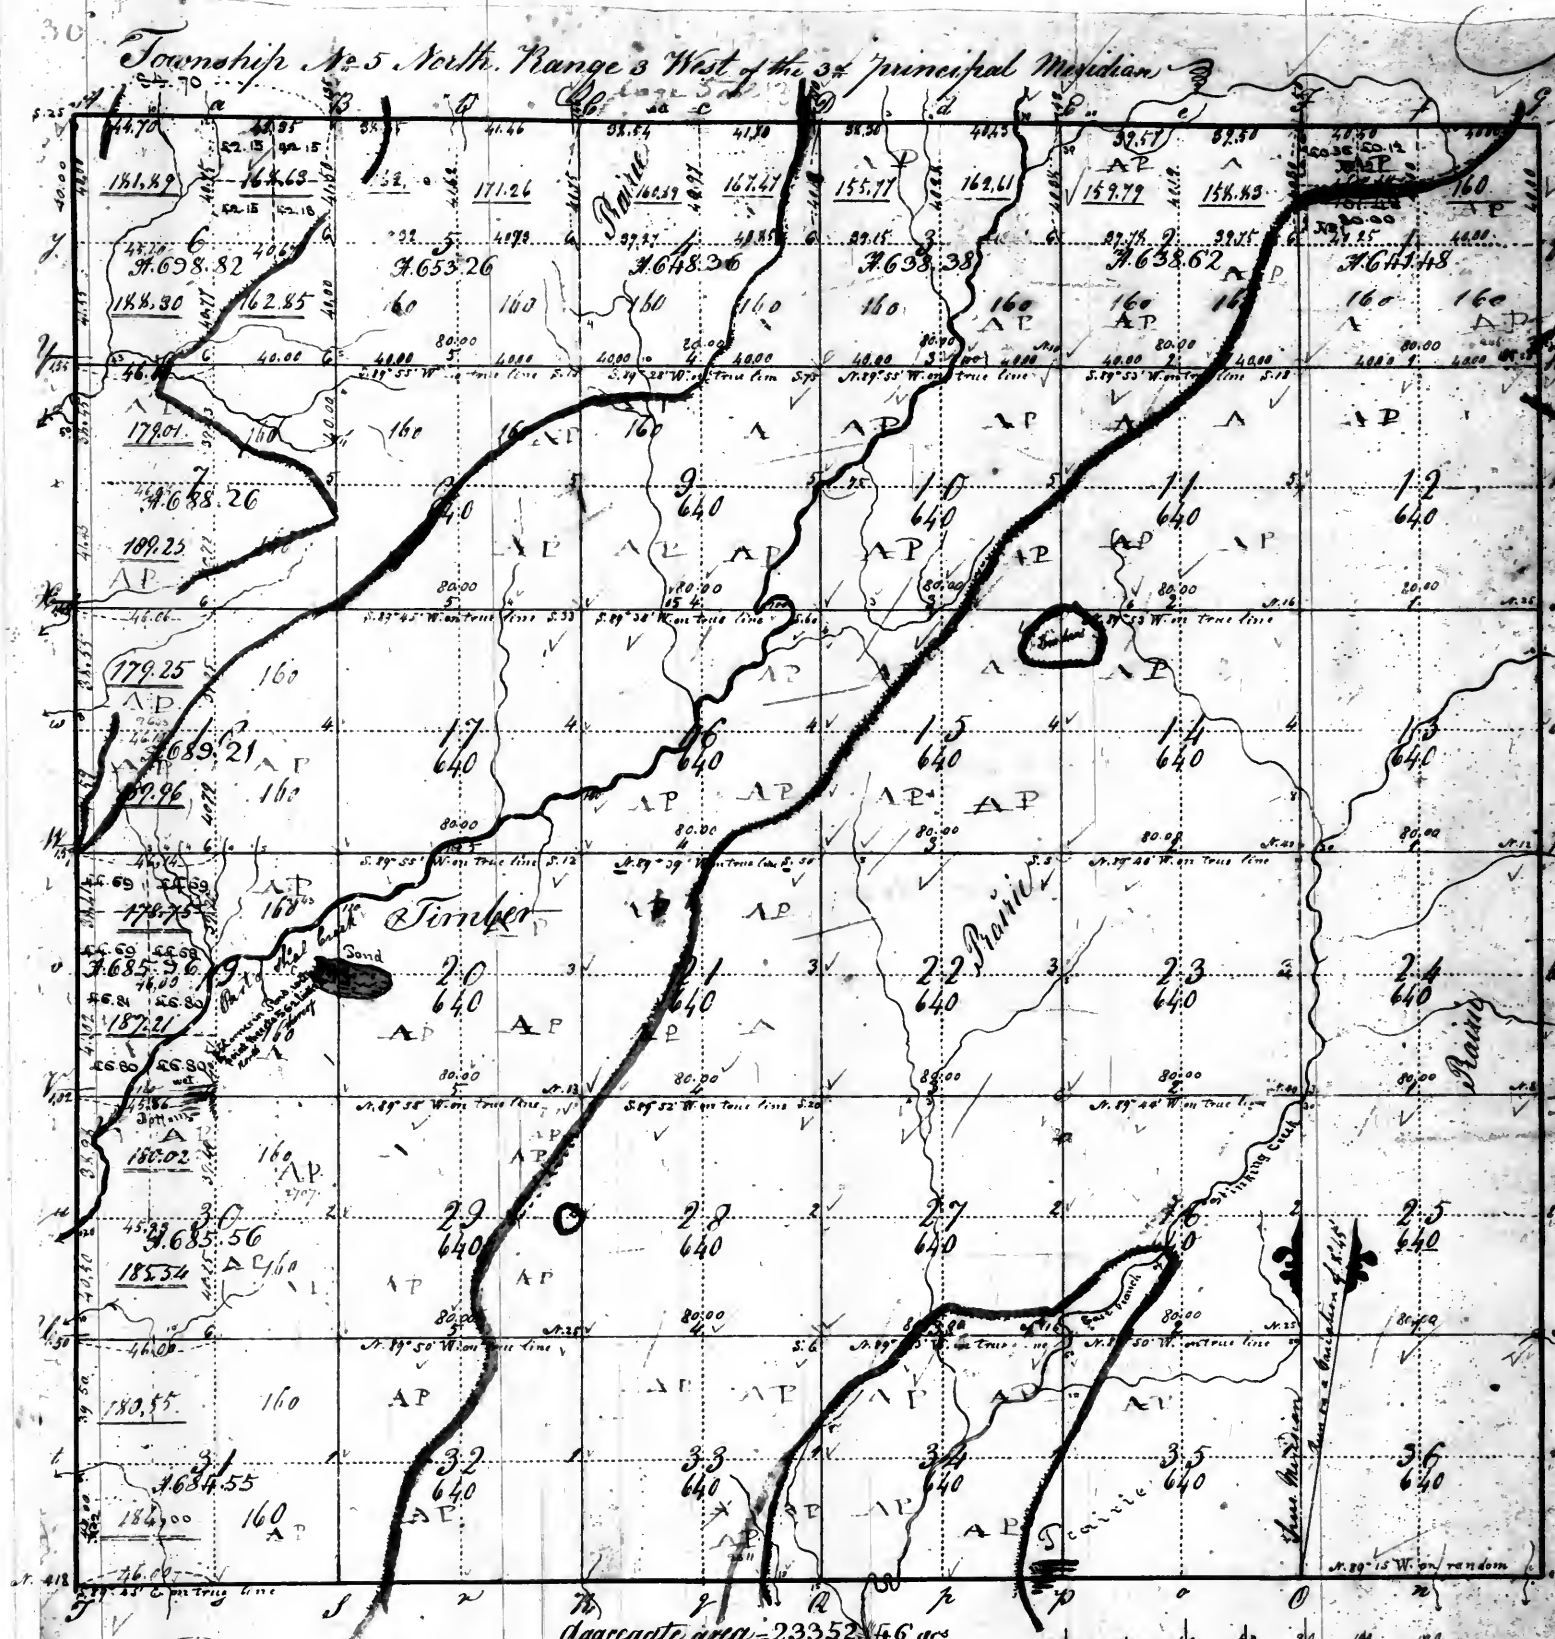

Reference to the field notes of the survey of this Township by which the lines of this plat have been examined & corrected, of the West boundary in Sec. 16, and 31 of the South boundary in Sec. 16 and 31, of the North and East boundaries and Sec. 16, 31, 32, 33,1000.

Variation
in that boundary not stated in the field notes.
in all the other lines 8' 40' East
Survey Office
St. Louis 1st Feb. 1844.
Subdivided
under the Act of Congress of the
5th of April 1820 and sent three
copies of the plat one to the Reg.
of the district and another to the
Genl. Land Office, viz:
NW quarter of section 1.
also Subdivided so as to conform
to previous Sales as stated by
the Register on the 12th July 1843
viz:
NE qr. sec. 6, - NW qr. sec. 19.

Examined and Corrected, Surveyor of the Lands of the
United States in the Territory of Missouri & Illinois


Pursuant to a Contract with and Instructions from Josiah Meigs Surveyor General of the United States bearing date the 20th day of September 1814 - I have admeasured laid out and surveyed the above described Township, and do hereby Certify that it had such Marks and bounds both natural & artificial as are represented on said Plat and described on the field notes taken thereof and returned with the Plat into the Surveyors Office - Certified this 20th day of June 1816
The Commissioner of the Lands of the U. States in the Territory of Missouri & Illinois

Surveyors Office
St. Louis 9th of December 1841.

The lines of the above plat of Township 5 North of the base line in Range 3 West of the 3rd principal Meridian is nearly conformable to the field notes of the survey thereof on file in this Office, which have been examined and approved. The west boundary 6 miles was surveyed in January 1814, by John Milton Moore, under the Contract of Wm. Rector of the 26th of July 1813 - The South boundary 6 miles and 6 Ch. was surveyed in April 1815 - The North boundary 6 miles 4th 70 chains, and the East boundary 6 miles, was surveyed in January 1816 - and the subdivision lines were surveyed in January & February 1816, by John Meigs, under contract of the 20th of September 1814.

Jos. C. Brown
Surveyor of the public land for

Township N. 6 North of the Base line, Range N. 3 West of the 3rd principal Meridian

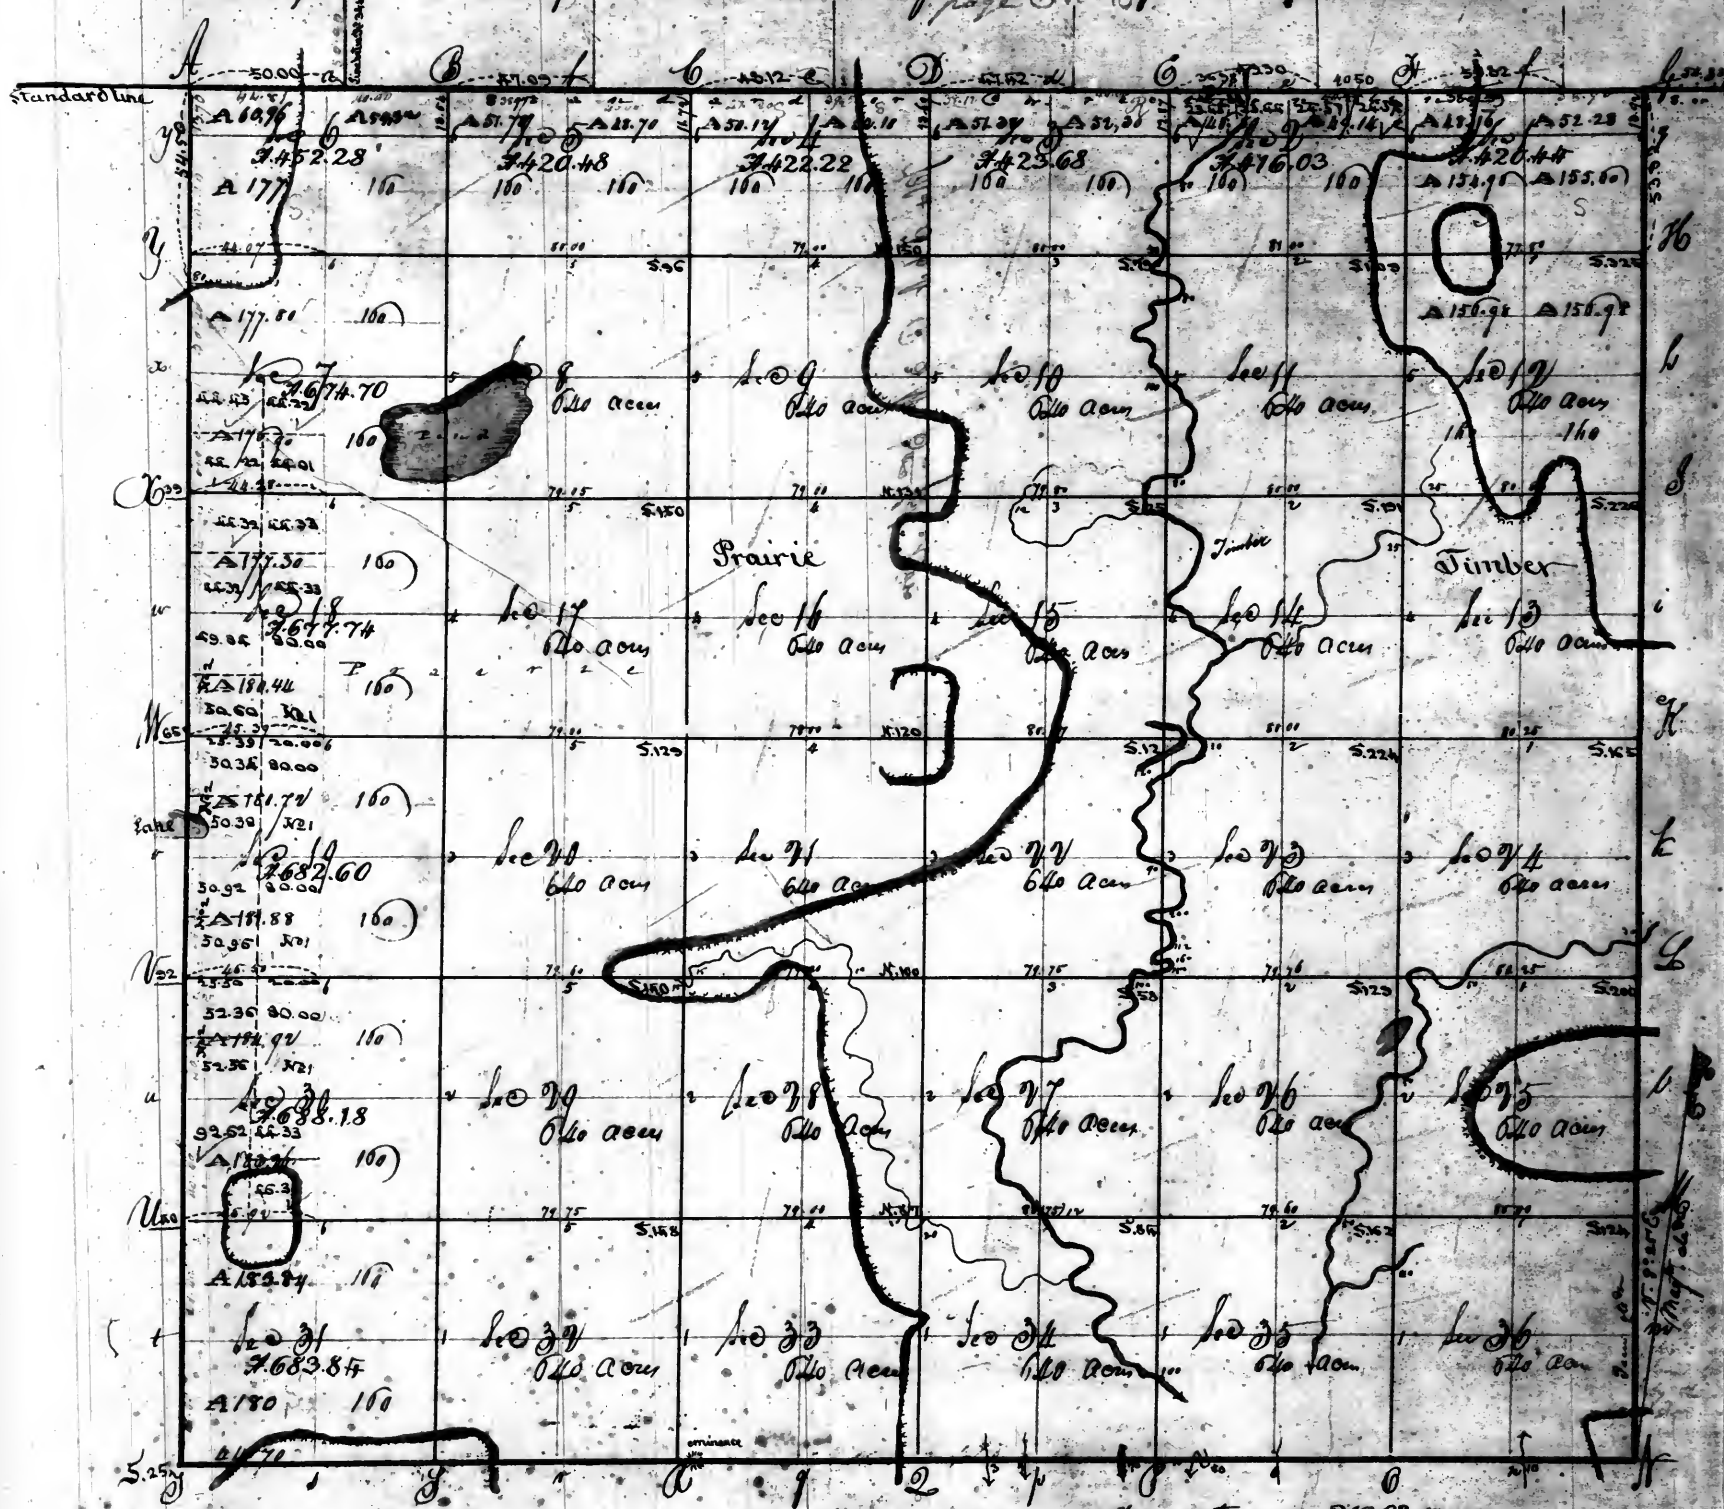

Aggregate area - 21362.13 acres




Surveyed by
St. Louis, Mo. Feb. 10, 1880

2176

Recorded

3917
Township No 7 North of the Base line, Range No 3 West of the 3rd Principal Meridian




Pursuant to a Contract with and instructions from Wisconsin State Surveyor of the Land of the United States in the Territories of Illinois and Missouri bearing date May the 15th 1855 I have ascertained laid out and surveyed the above of Land and so hereby certify that it has been marked and bounded with natural and artificial or man represented the true place and position of the said lines, marks and boundaries with the plat laid the Office of the Survey of the Land of the United States in the Territory of Illinois and Missouri.

Witness my hand and seal of office this 5th day of April 1855
William Bellamy S.S.

Surveyed by the Surveyor of the Land of the United States in the Territory of Illinois and Missouri
under the Act of Congress of the 5th April 1850
and the Act of Congress of the 3rd March 1853
which are to be taken of the said land
north of the General Land Office, viz:
all the gr. sec. 2
all the gr. sec. 3
8

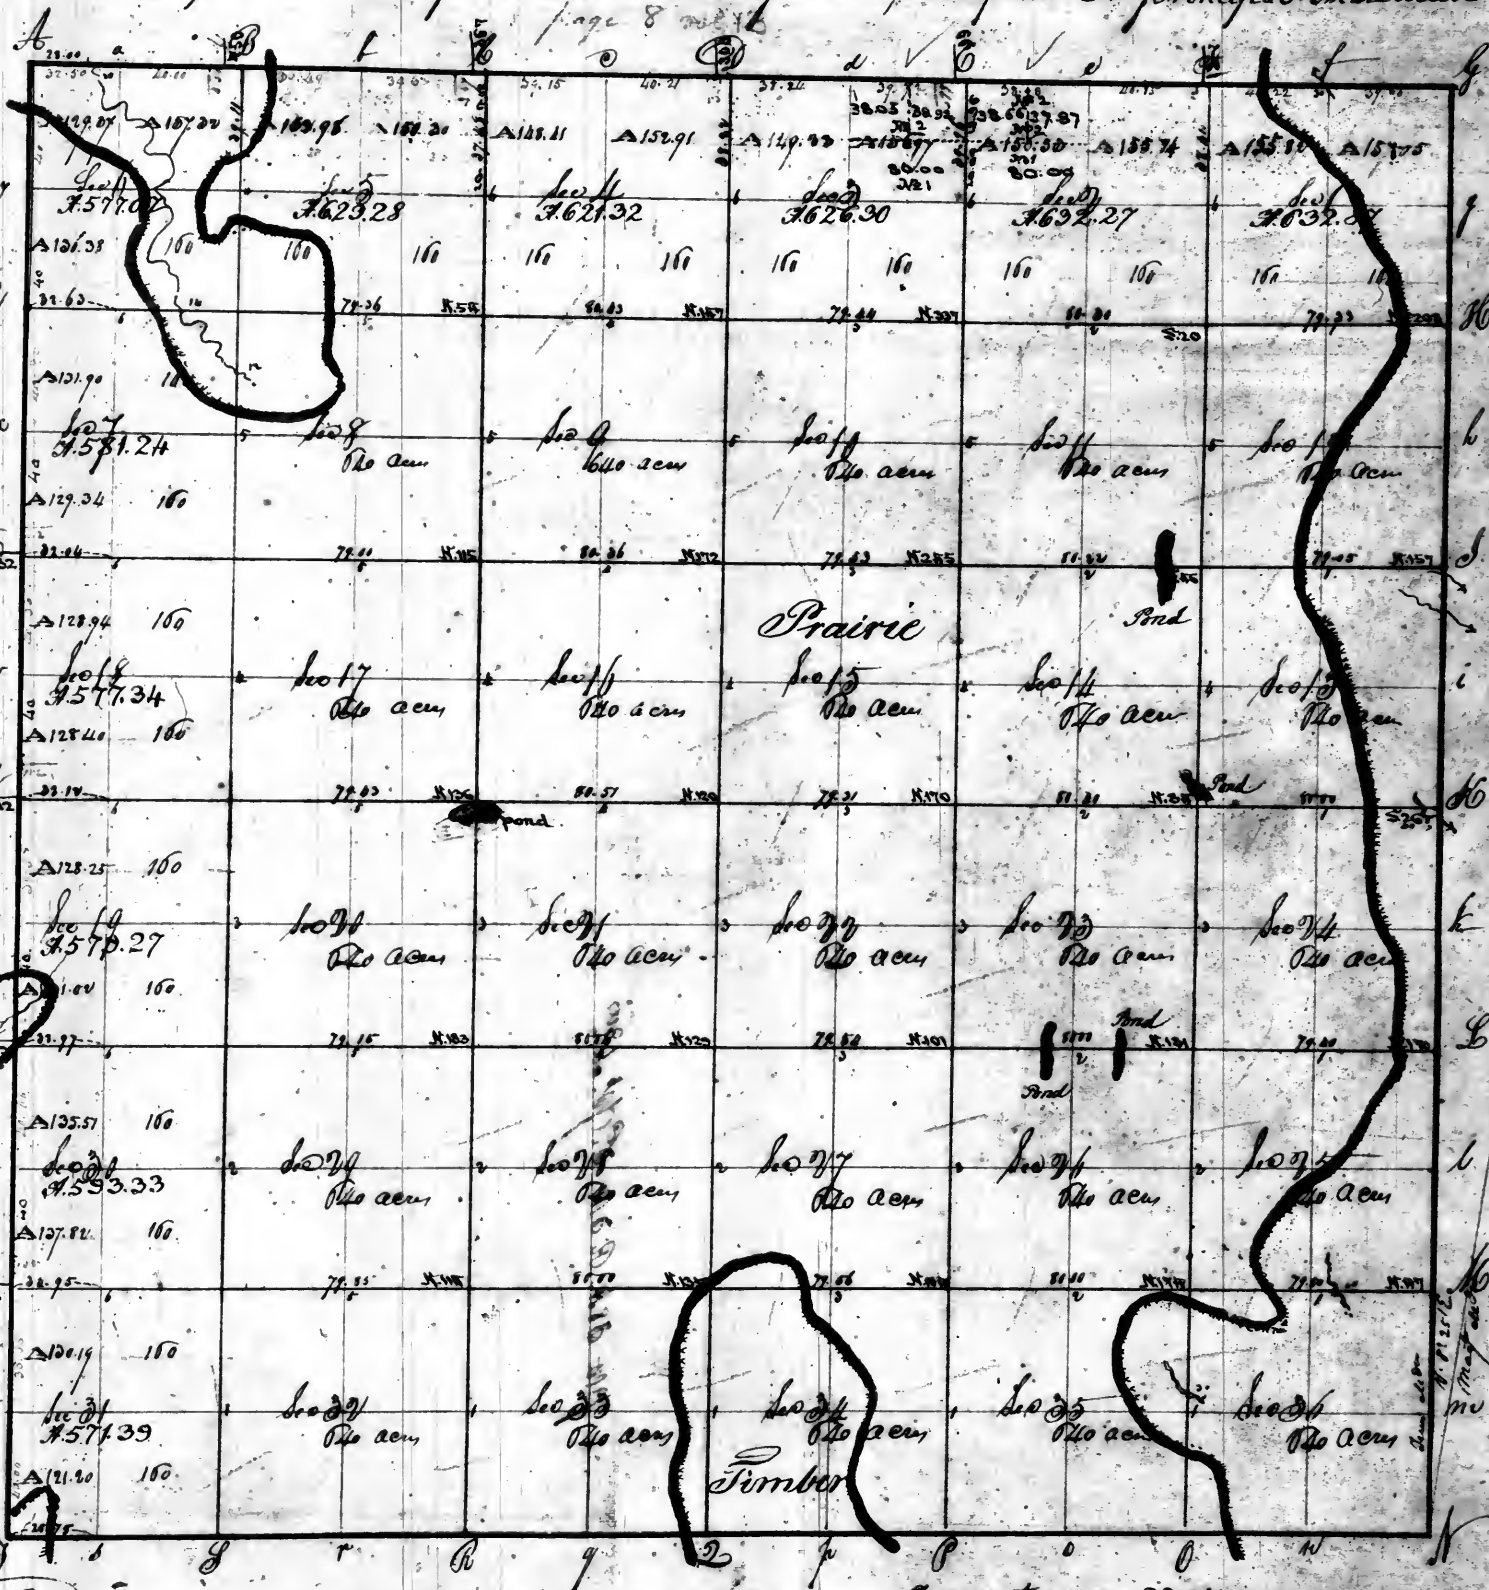

Aggregate area = 22615.68 acs

Pursuant to a contract with and instructions from Mexican Rector, surveyor of the Lands of the United States in the Territories of Illinois and Michigan bearing date May the 15th 1815. I have re-measured said lot and surveyed the adjacent Townships of Land and do hereby certify that it had four bounds and bounds both natural and artificial as described in the said plat and recorded in the field notes made thereof and returned with this plat into the office of the Survey of the Lands of the United States in the Territories of Illinois & Michigan.


Certified this 5th day of November 1918

Marian E May D.D.

Secretary's Office
 Saint Louis - Mo. Feb. 4. 1864.
 Authorised
 Under the Act of Congress of the 5th
 April 1832 (and subsequent copies of the
 plat today sent to the Reg^y of the
 District) - (am united to the Genl
 Land Office, viz
 N^o 1 quarter of section 2 (am
 N^o 2 quarter of " 3.

Recorded

Township No 9 North of the Base line, Range No 3 West of the 3rd Principal Meridian

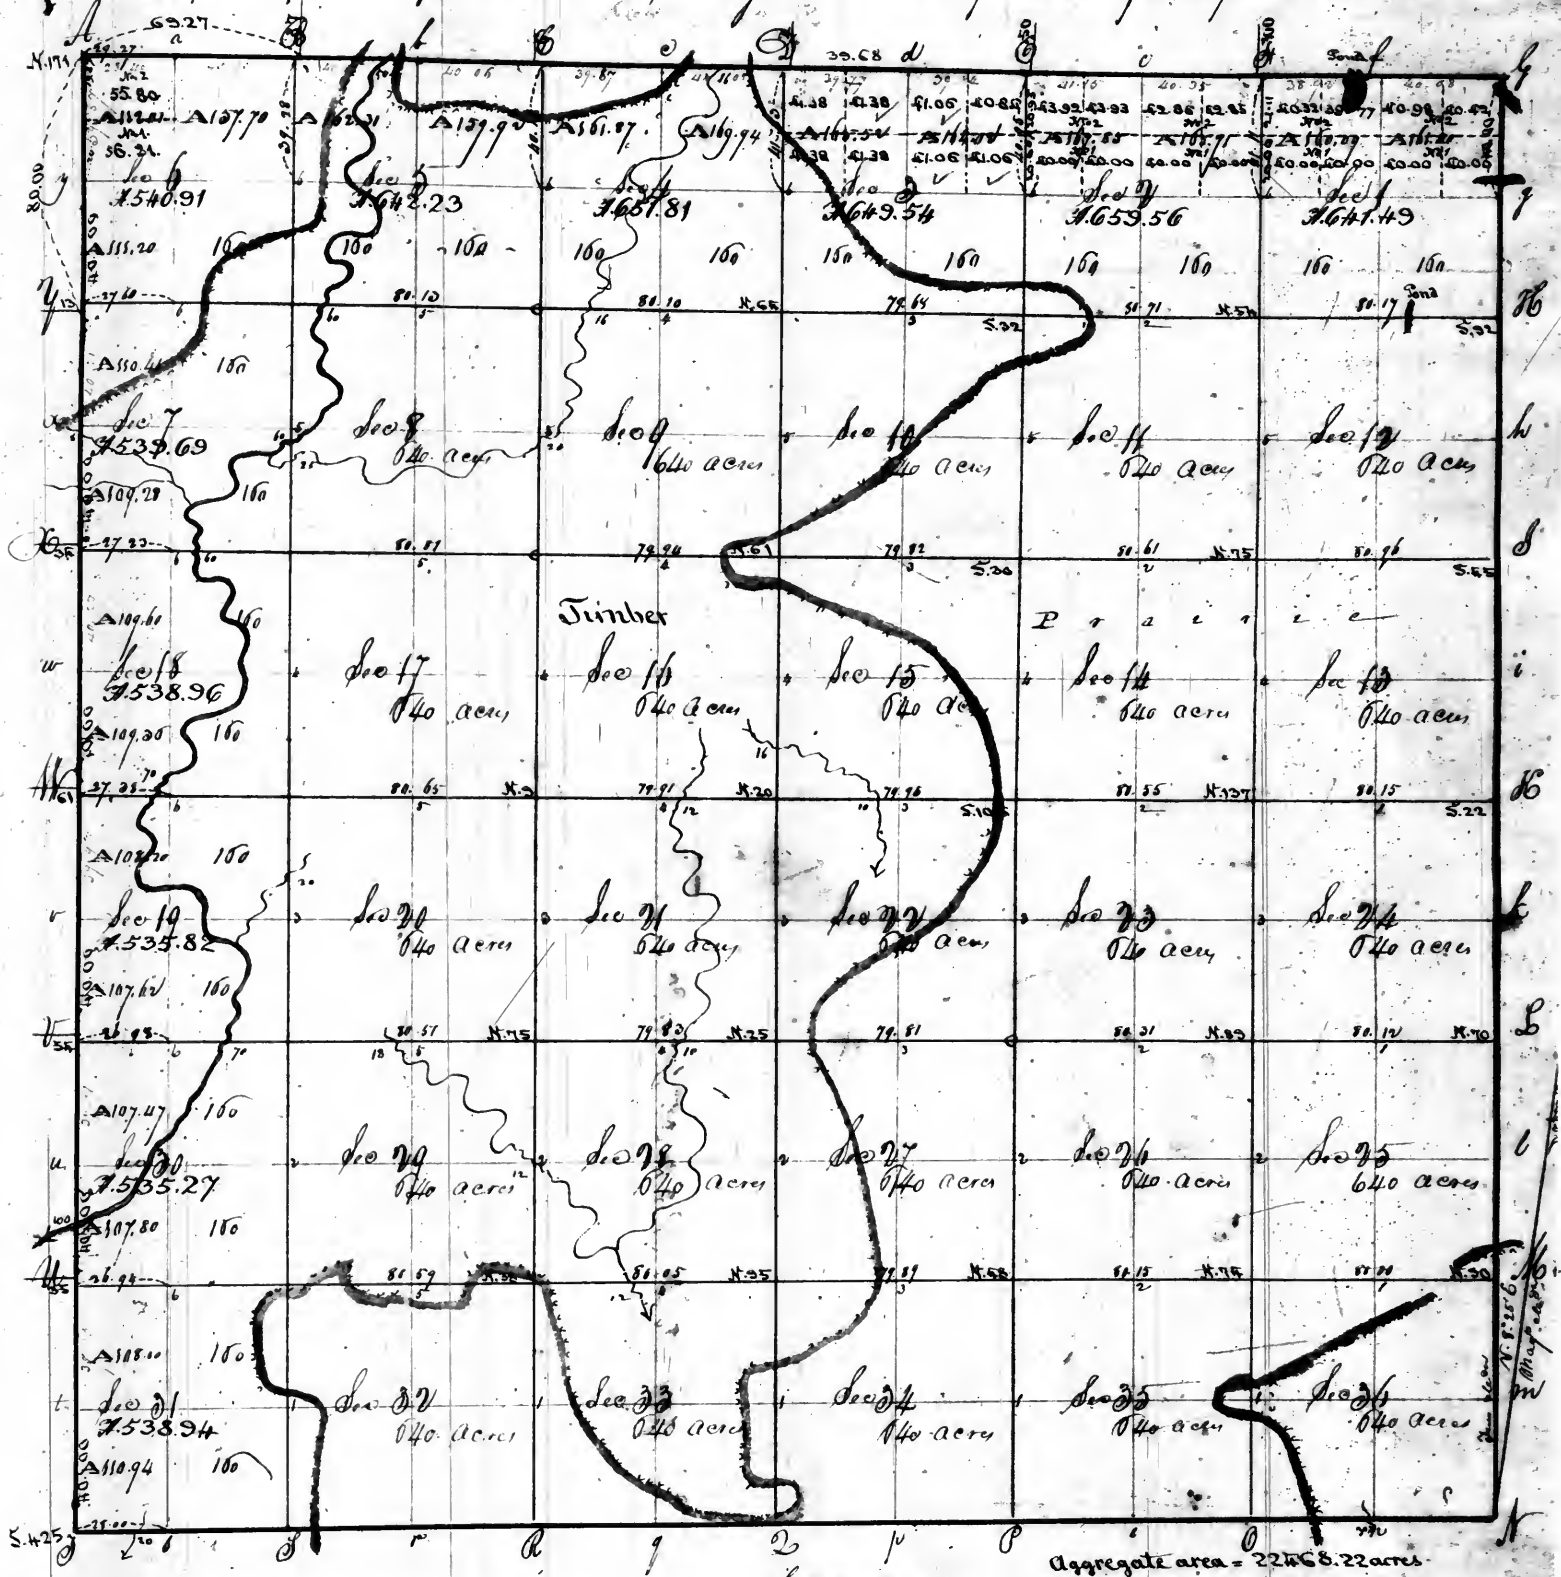


Aggregate area = 22468.22 acres

Surveyors Office
 Saint Louis - 1st Febr 3 1844.

Subdivided under the Act of Congress of the 5th of April 1832 and sent copies of the plat, today, one to the Register of the district - and another to the Genl. Land Office, viz:
 NE quarter of section 1, - NW qr. sec. 1, - NE & NW qr. sec. 2 and NW quarter of section 6 - also subdivided as to conform to previous sales as reported by the Regr on the 4th July 1843, viz: NE and NW quarters of section 3.

Recorded

Township No. 10 North of the Base line, Range No. 3 West of the 2^d principal Meridian

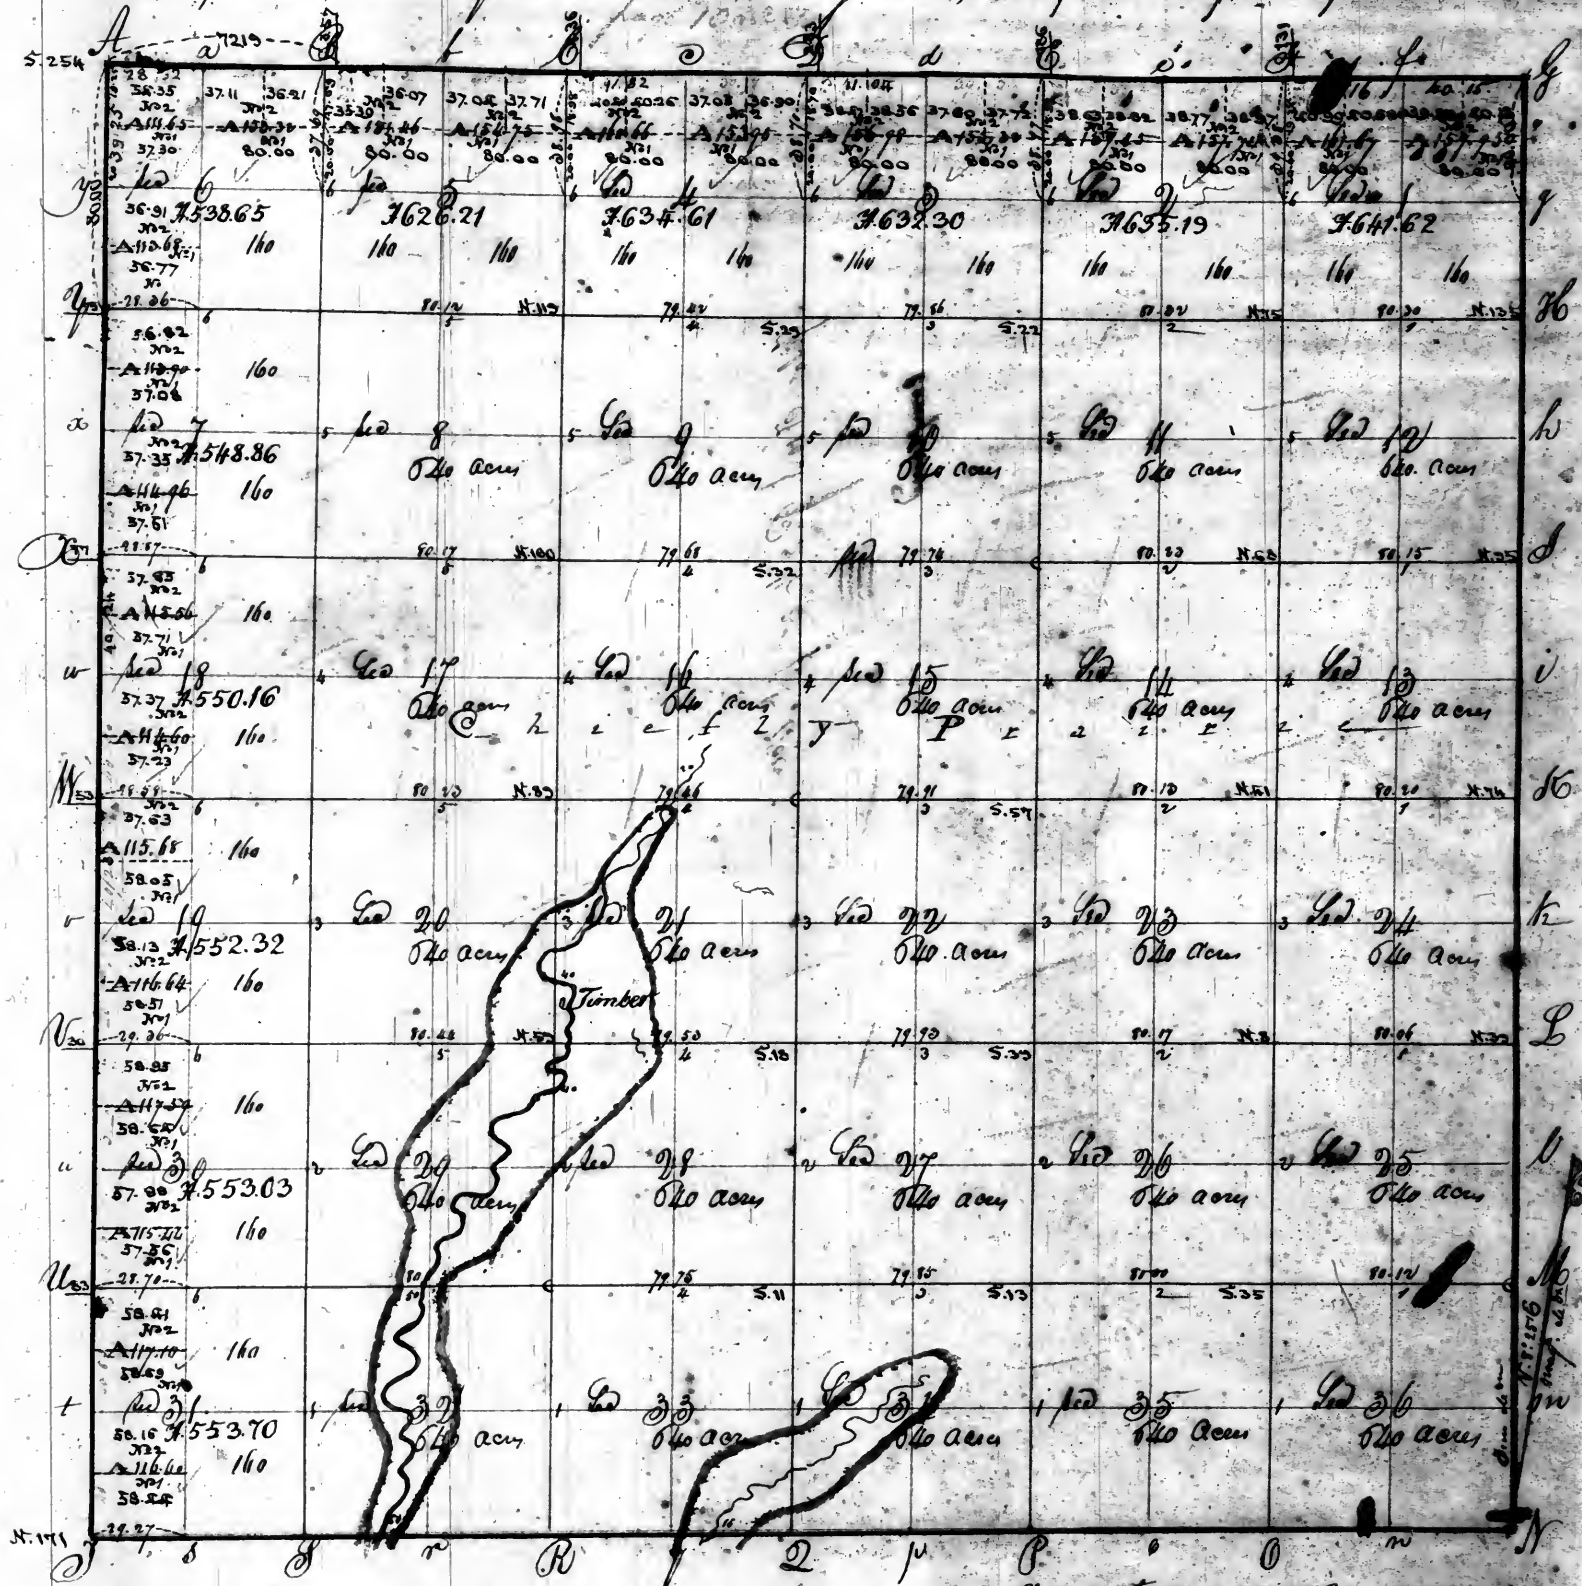

*Sur. Office
Saint Louis 1st Febr. 1854.*

*Subdivided under the Act of Congress
of the 5th of April 1832 the northern and western tier of
quarter sections of this township (and sent copies of the
plat thereof, today, one to the Register of the district and
another to the Commr. of the General Land Office.*

St. Louis, March 20th 1854

*This day was sent a copy of the N. 2^d of Sec. 1, 2, 3, 4, 5, 6, - of
the S. 14th of Sec. 6 and of the W. 2^d of Sec. 7, 18, 19, 20, 21, to the Register
at Edwardsville 1854. (This letter from 27th March 1854)*

Aggregate area - 22466.65 acres

*Surveyed by Joseph Barton and Charles D.
May and June 1850*


Recorded

11

(5)

819

Township N. 11 N. of the Base line, Range N. 3 West of the 3^d principal Meridian

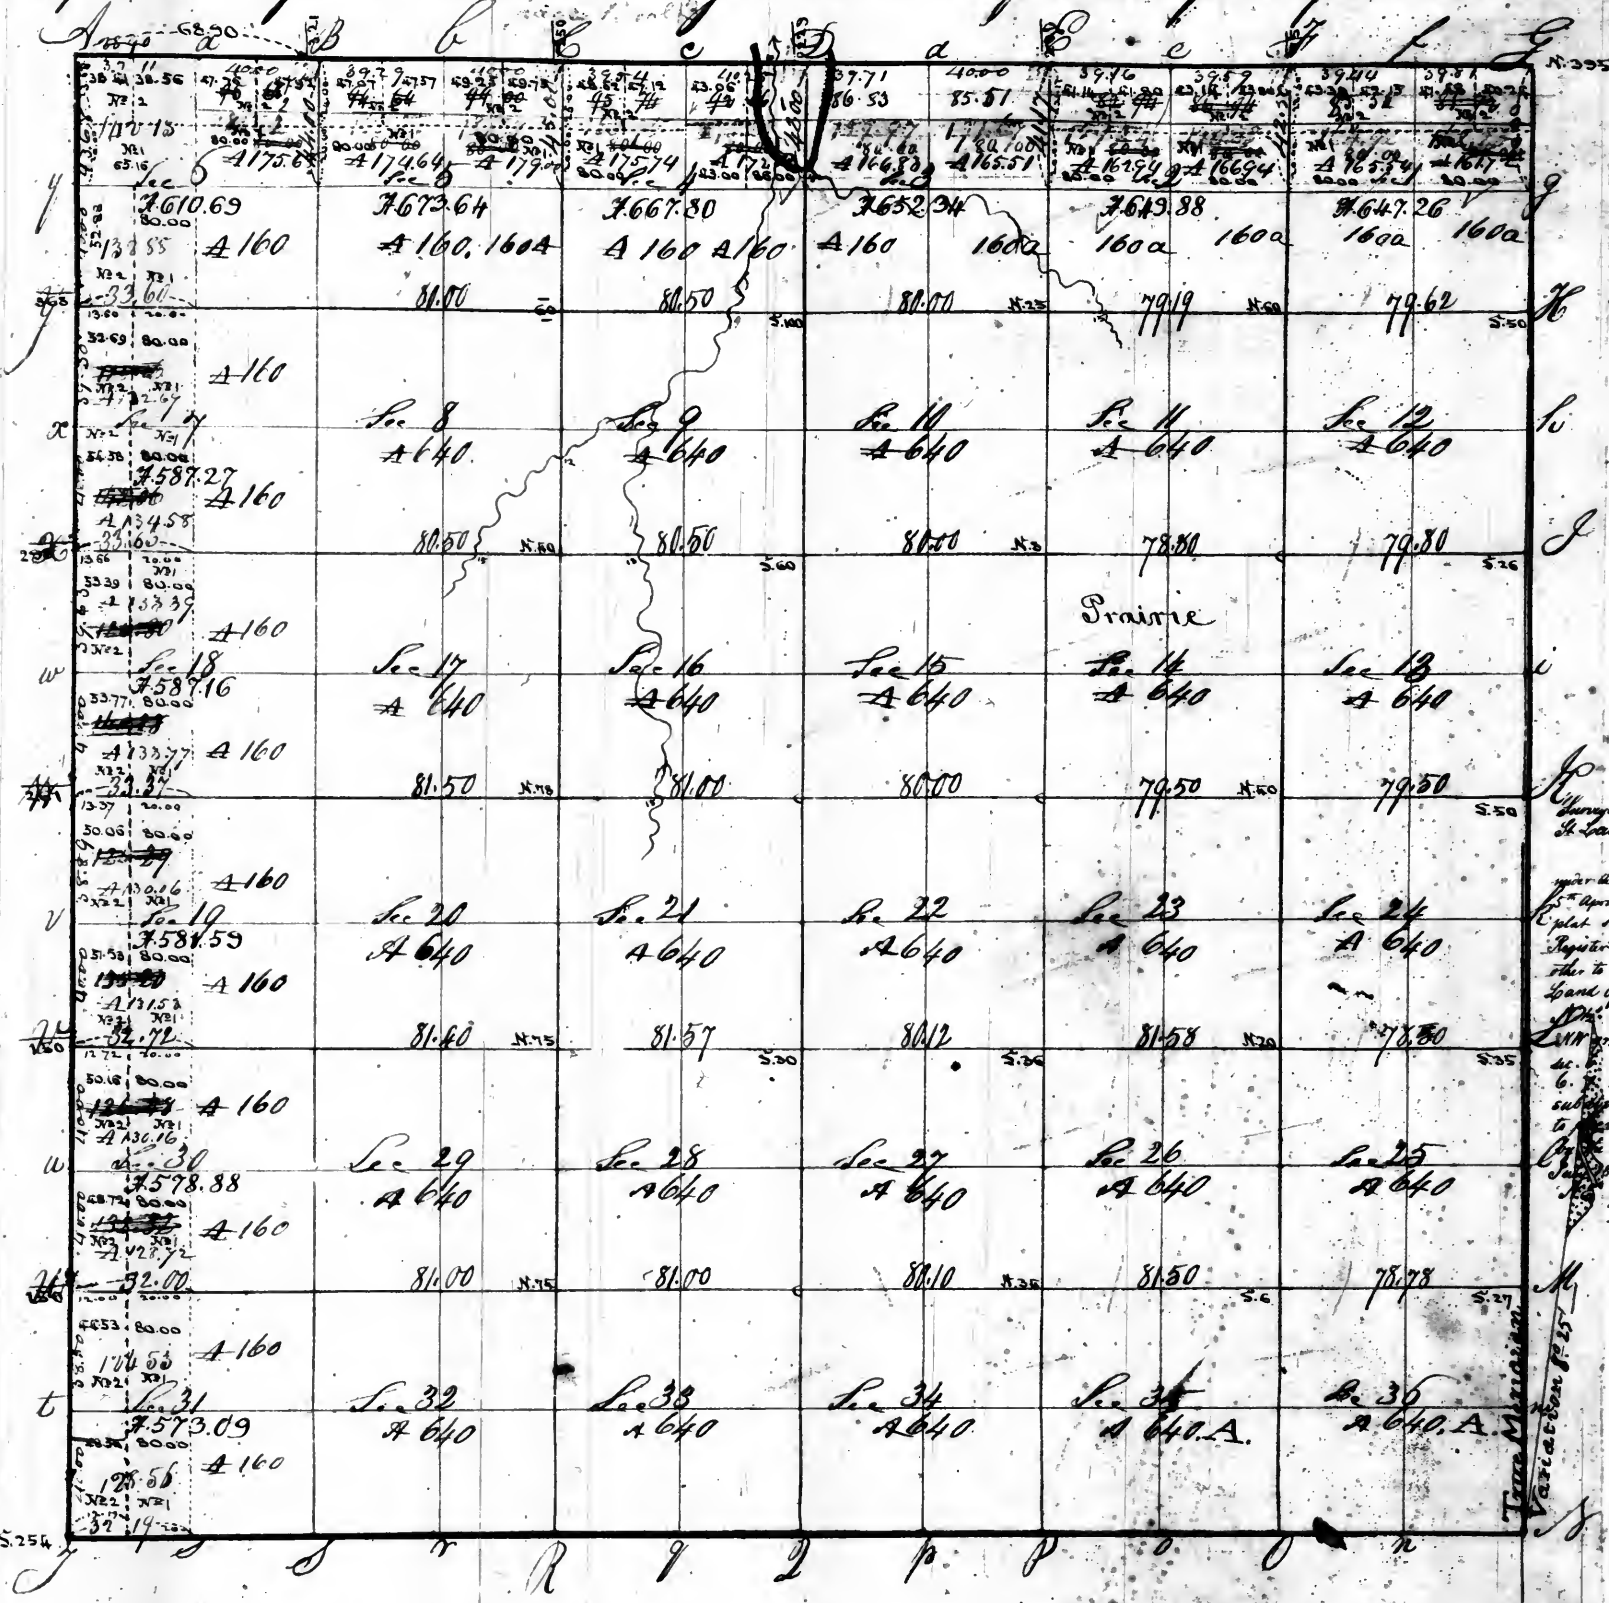


Subdivided
under the Act of Congress of the
15th April 1820 (and copies of the
plat sent today, one to the
Register of the district and one
to the Commr. of the General
Land Office, viz:
as follows:
The quarter of section 11

Pursuant to a contract with and instructions from William Rector Surveyor of the lands of the United States in the Territory of Illinois and Missouri bearing date the 29th day of October 1818 I have admeasured laid out and surveyed the above described Township and do hereby certify that it had such marks and bounds both natural and artificial as are represented on said Plat and described in the field notes thereof and returned with this plat into the Office of the Surveyor of the lands of the United States for the Territory of Illinois and Missouri - Certified this 25th day of January 1819 -

Scale of 40 Chains to an Inch.

Recorded

(6) Township 12 South of the Base line of Range 12 West of 3rd principal meridian

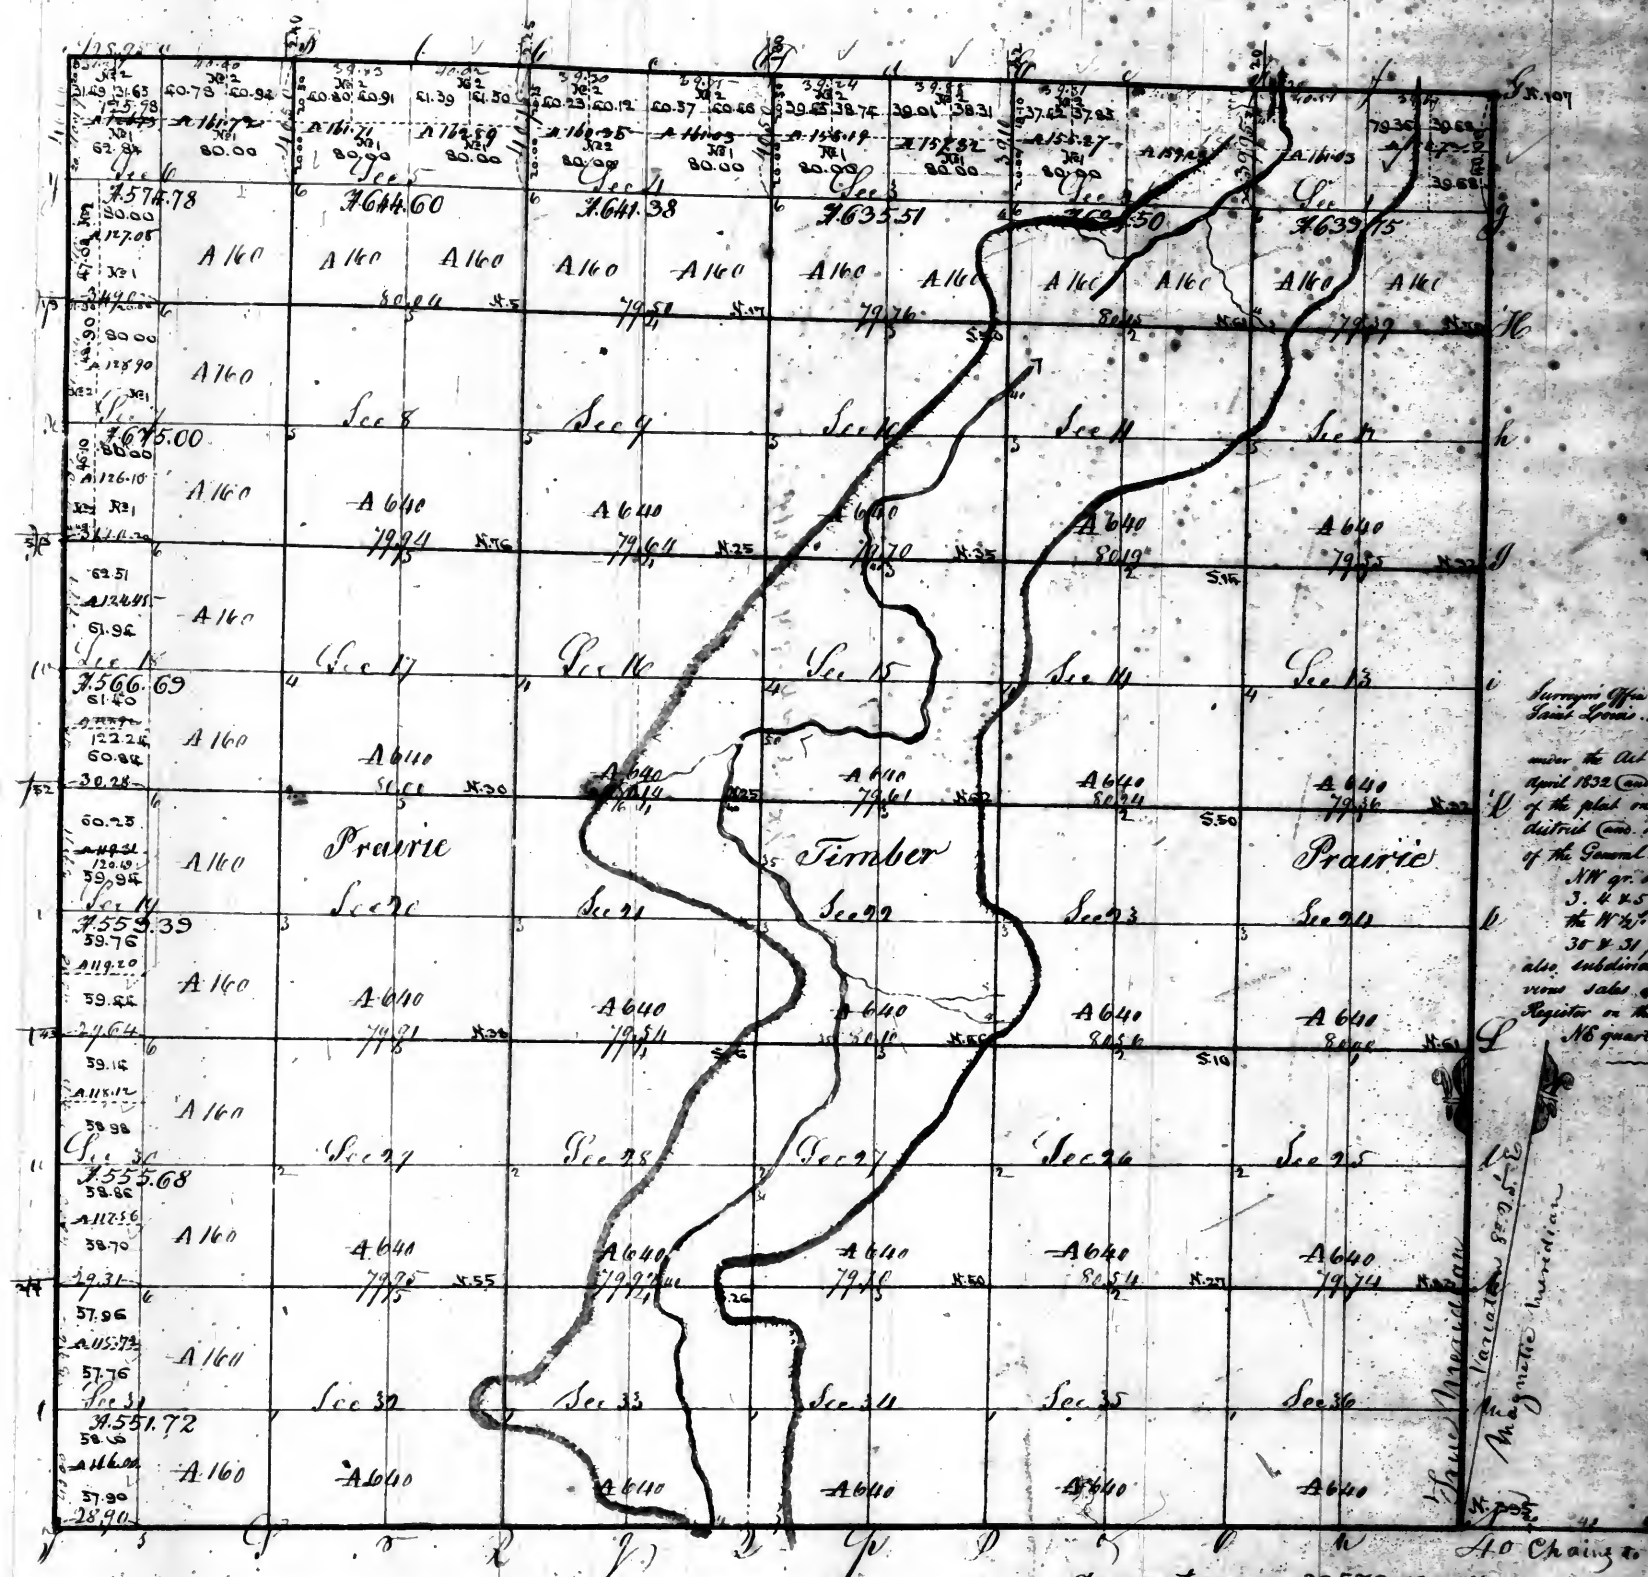

Surveyor's Office
Saint Louis, Mo. Feb. 1844.
Subdivided
under the Act of Congress of the 5th
April 1832 and last, today, copies
of the plat one to the Register of the
district and another to the Comptroller
of the General Land Office, viz:
A 16 gr. sec. 2, - 8 1/2 of sec.
3, 4 & 5 - A 6 gr. sec. 6 (and
the N 1/2 of sec. 6, 7, 18, 19,
35 & 36) -
also subdivided to conform to pre-
vious sales as reported by the S.
Register on the 4th July 1843, viz:
A 6 quarter of section 1.


Aggregate area = 22573.00 acres

Pursuant to a contract with and instructions from William Reector Surveyor of the Lands of the United States in the Territories of Illinois & Missouri bearing date the _____ day of _____ I have admeasured laid out and surveyed the above described Township and do hereby certify that it had such marks and bounds both natural and artificial as are represented on said plat, and described in the field notes made thereof returned with this plat into the office of the Surveyor of the Lands of the United States for the Territories of Illinois and Missouri

Wm Gordon SS
Decr 1848 & January 1849

Recorded

Township No. 10 North of the base line, Range No. 3 West of the 2nd principal Meridian.

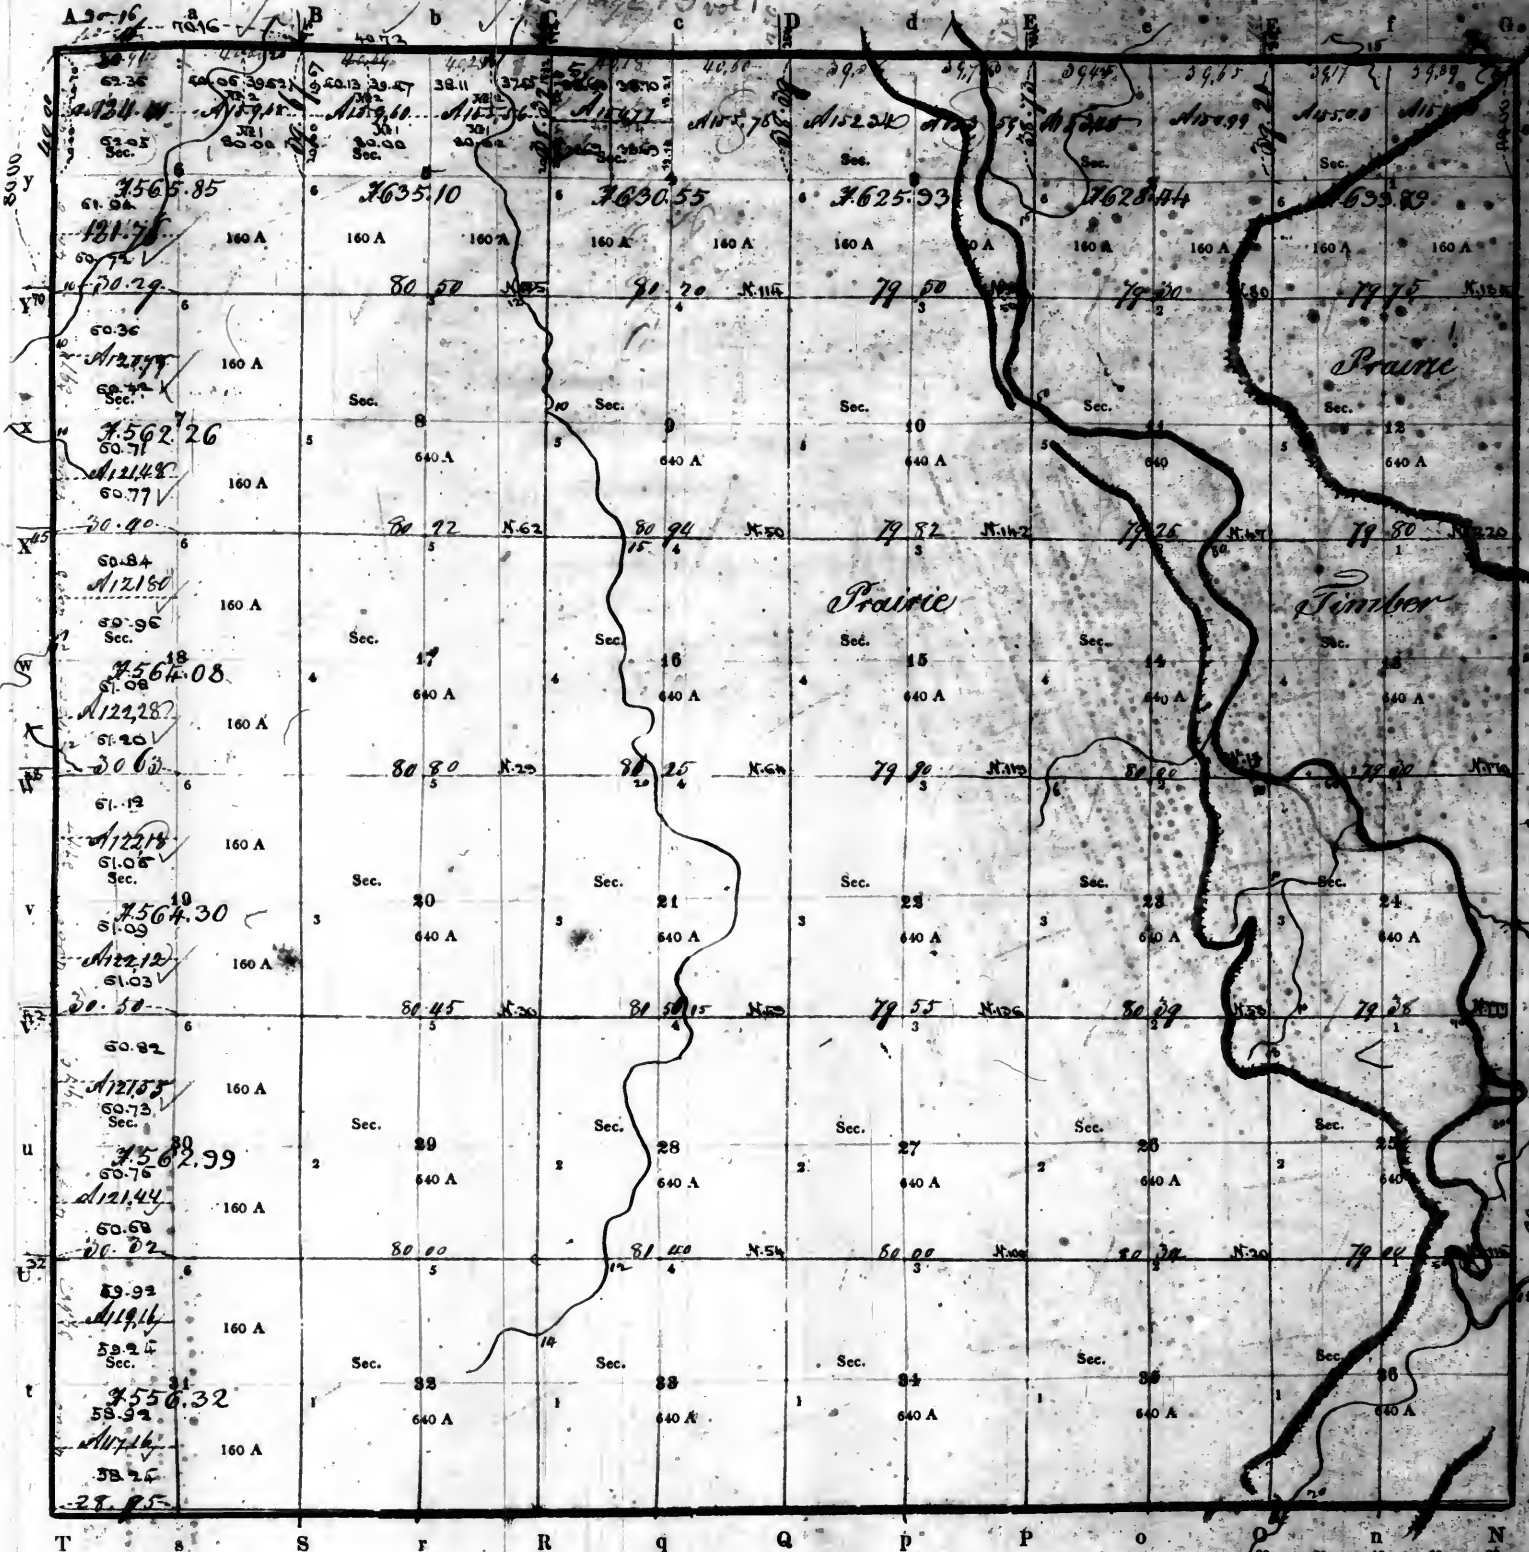

Surveyor's Office
St. Louis, Mo. June 1844
Plat of the N.W. 1/4 Sec. 14, Subdiv.
as to conform to a previous plat
(marked Jackson) and sent a copy
to the Register & a third to the
Comptroller of the General Land Office.

Aggregate area - 22529.67 acres

PURSUANT to a contract with, and instructions from WILLIAM RECTOR, Surveyor of the lands of the United States in the *State of Illinois*
and *Missouri and Territory of Arkansas* bearing date the *twentieth* day of *February* 1821

I have admeasured, laid out and surveyed the above described Township; and do hereby certify, that it had such marks and bounds, both natural and artificial, as are represented on said plat, and described in the field notes made thereof, and returned with this plat into the Office of the Surveyor of the lands of the United States, for the *State of Illinois and Missouri and Territory of Arkansas*

Certified this *twelfth* day of *July* 1821

EXAMINED.

William Rector SURVEYOR


Surveyor's Office
St. Louis, Mo. Feb. 1, 1844

Subdivided under the Act of Congress of the
5th of April 1832 and sent copies of the plat today, one to the
Register of the district and another to the Comptroller of the General
Land Office, as follows: N.W. 1/4 Sec. 5

N.E. 1/4 of section 6
N.W. 1/4 of sec. 6, 7, 18, 19, 20 & 31.

15

use line, Range No. 3
page 14 vol 13

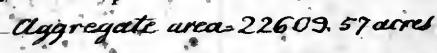


bearing date the nineteenth day of February 1821

Certified this *twelfth* day of *July* 18*91*.

Will Rector SURVEYOR.

Recorded

Township No. 10 North of the base line, Range No. 3 West of the 1st principal Meridian

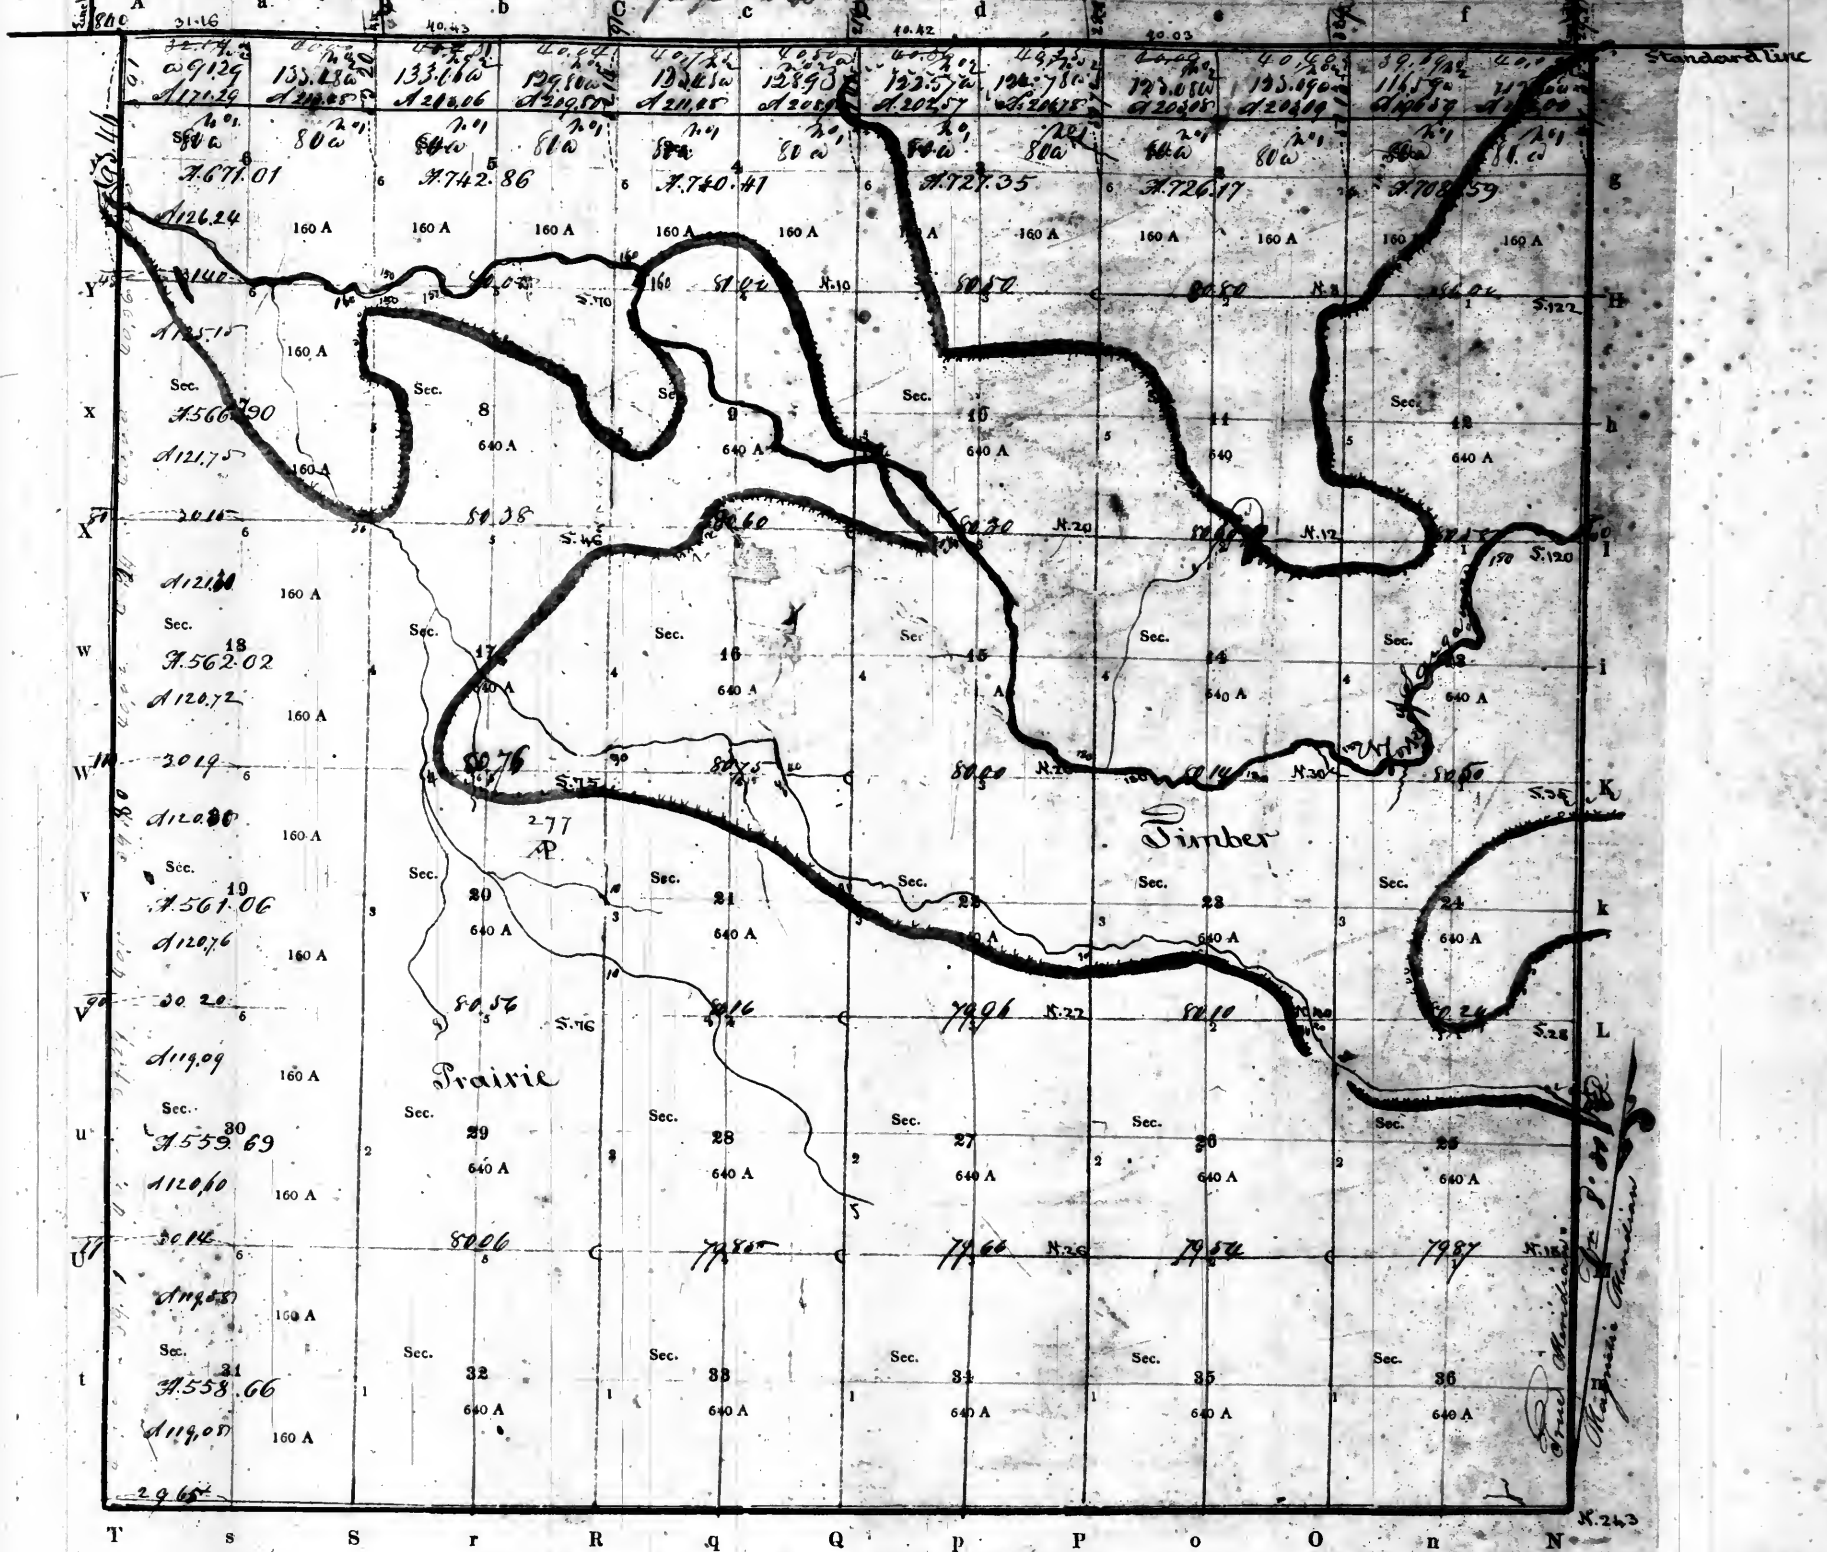

Aggregate area = 23124.72 acres

PURSUANT to a contract with, and instructions from WILLIAM RECTOR, Surveyor of the lands of the United States in the State of Illinois and Missouri and Territory of Arkansas bearing date the 10th day of February 1821

I have admeasured, laid out and surveyed the above described Township; and do hereby certify, that it had such marks and bounds, both natural and artificial, as are represented on said plat, and described in the field notes made thereof, and returned with this plat into the Office of the Surveyor of the lands of the United States, for the State of Illinois and Missouri and Territory of Arkansas


Certified this 12 day of July 1821

EXAMINED.

J. H. Rector D. SURVEYOR

in Henry R. 1821

Township No. 16 North of the base line, Range No. 10 West of the 5th Principal Meridian

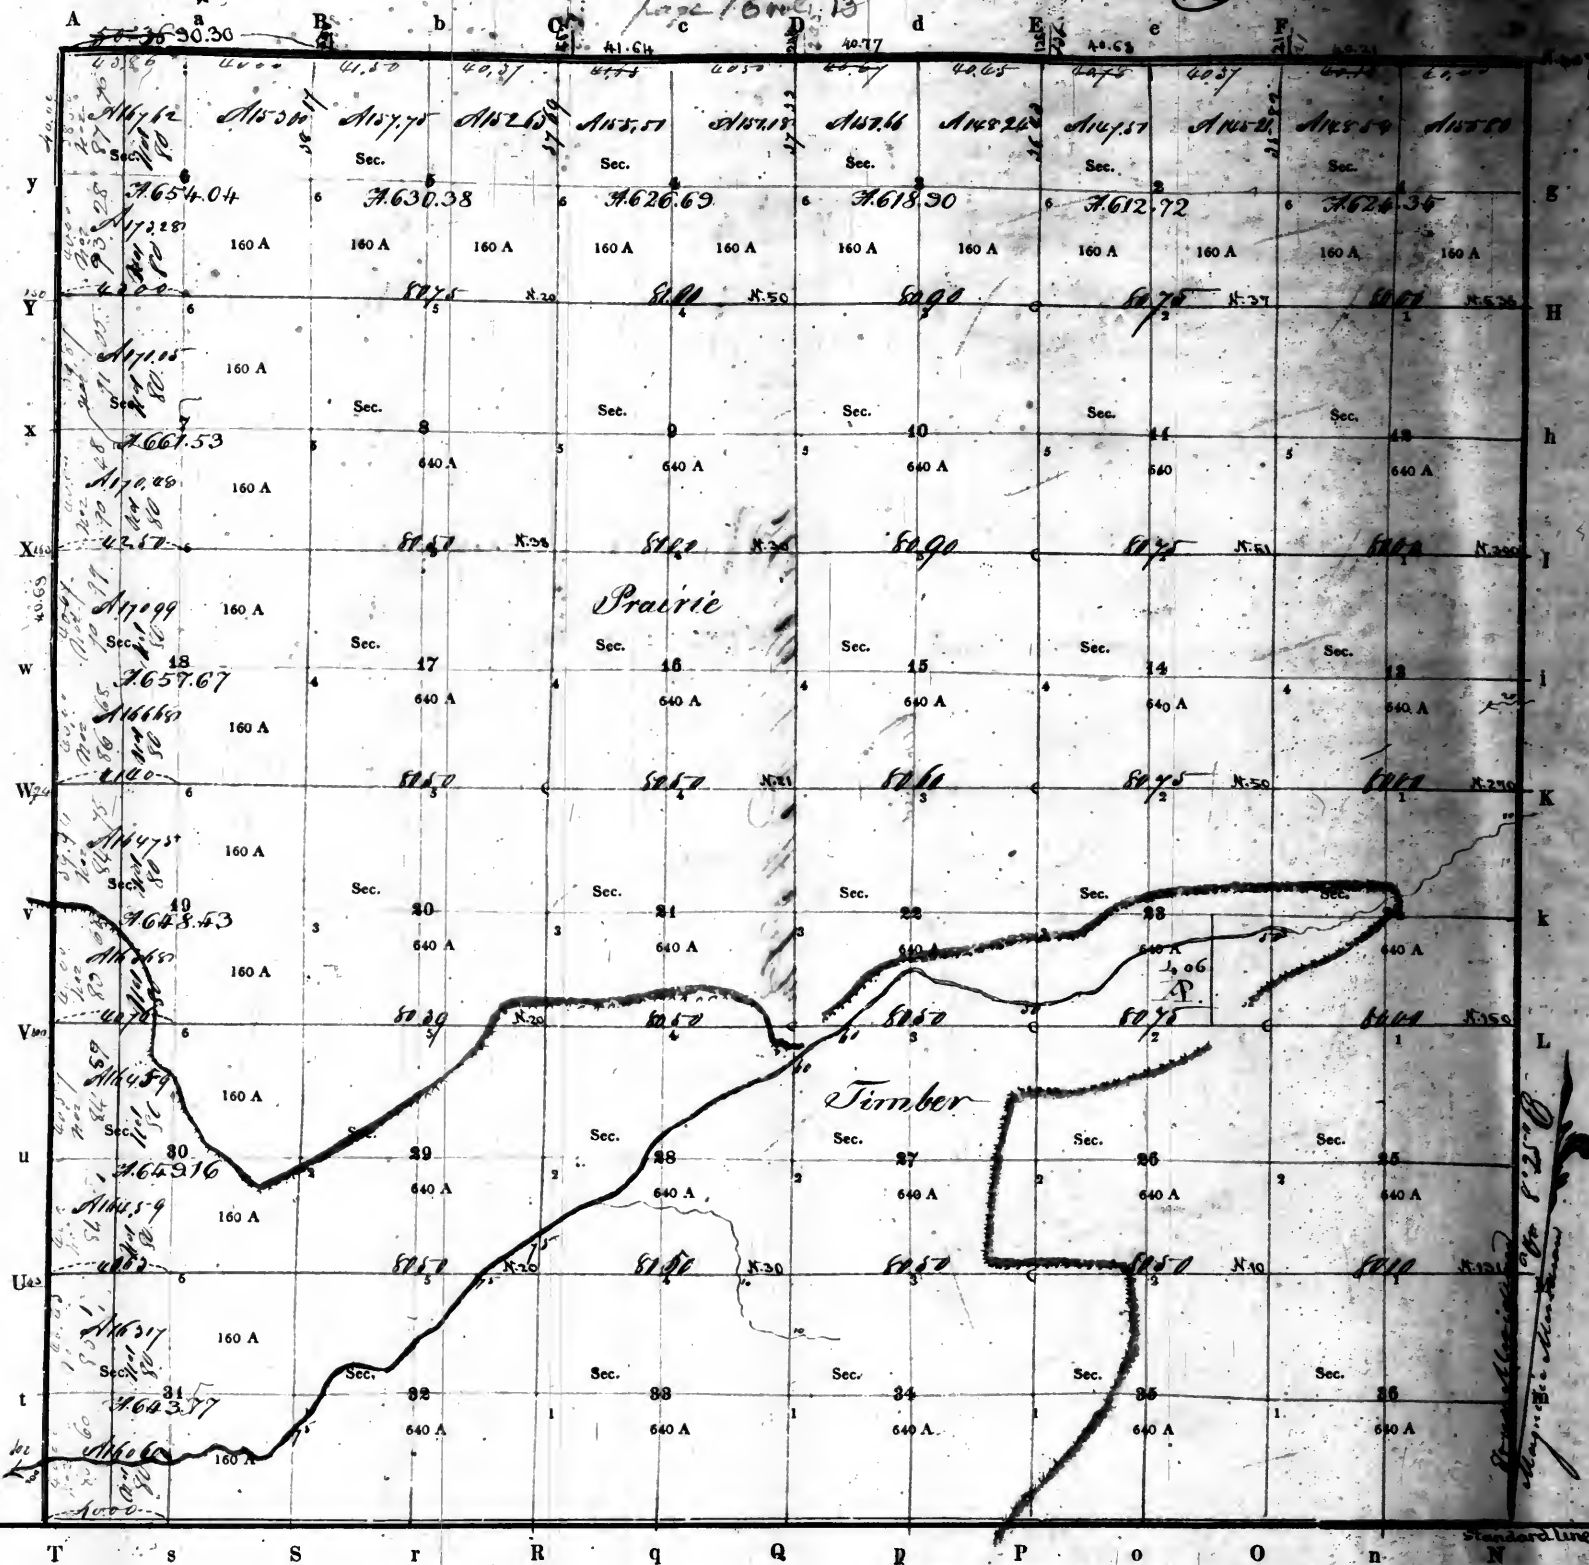

Aggregate area - 23027.63 acres

Scale of 40 Chains to an Inch.

PURSUANT to a contract with, and instructions from WILLIAM RECTOR, Surveyor of the lands of the United States in the States of Missouri and Territory of Arkansas bearing date the twenty seventh day of February 1831

I have admeasured, laid out and surveyed the above described Township; and do hereby certify, that it had such marks and bounds, both natural and artificial, as are represented on said plat, and described in the field notes made thereof, and returned with this plat into the Office of the Surveyor of the lands of the United States, for the States of Missouri and Territory of Arkansas

Certified this day of


Surveyed by J. P. Langham
in June & July 1831

EXAMINED.

Township N. 17 South of the base line, Range N. 3 West of the 3rd Principal Meridian.

page 17 of 13

A a B b C c D d E e F f G g

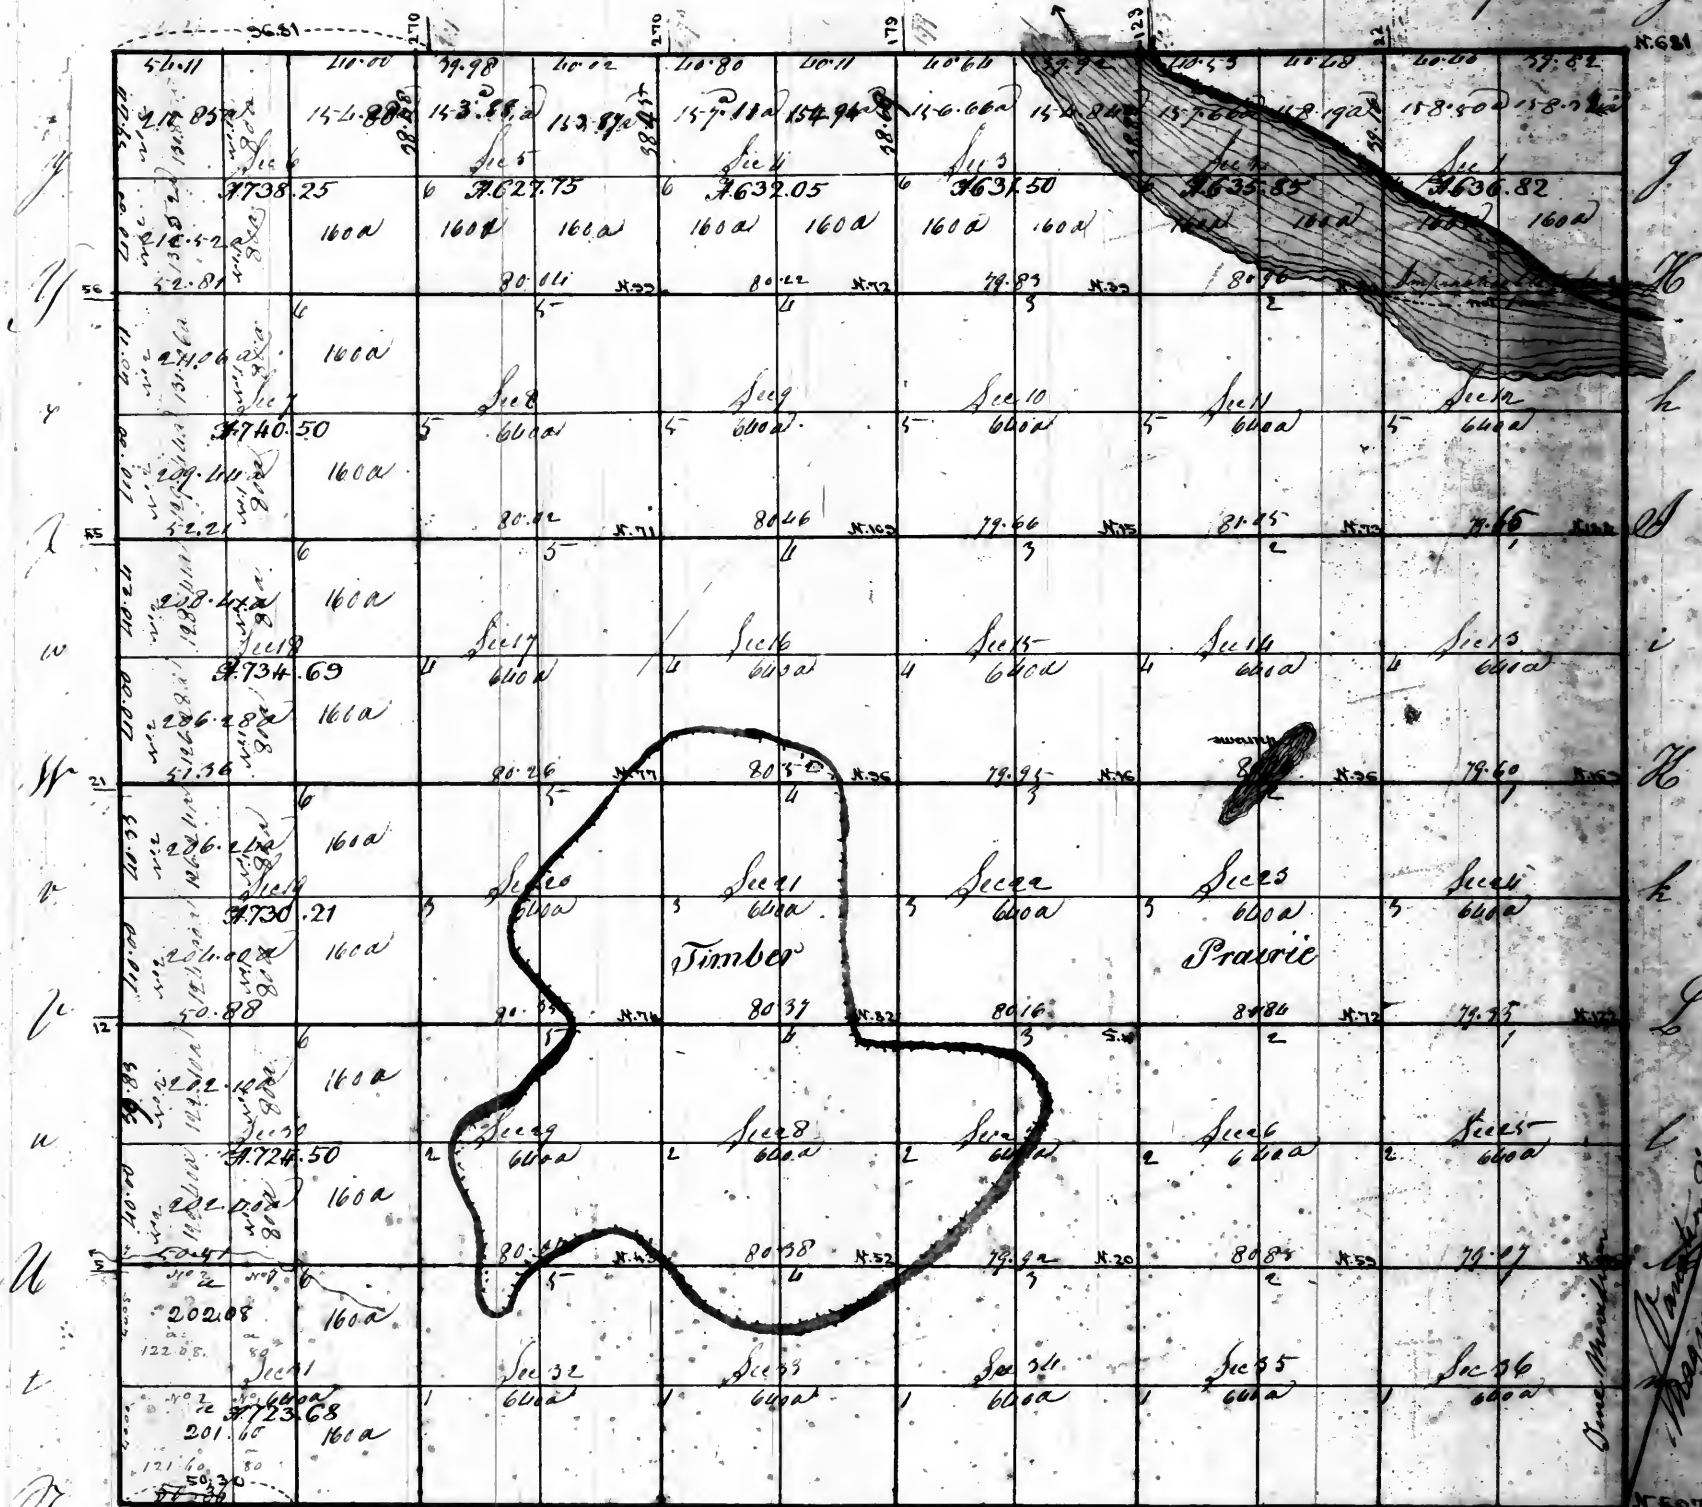


Aggregate area 23555.80

Scale of 10 ch. to an inch

In pursuance to a contract with and instructions from William Victor Surveyor of the lands of the United States in the States of Illinois, Missouri and Territory of Arkansas bearing date the 1st day of January 1854, I have examined, laid out and surveyed the above described township, and do hereby certify that it had such marks and bounds both natural and artificial as are represented on said plat and described in the field notes made thereof and returned with this plat into the office of the Surveyor of the lands of the United States for the States of Illinois, Missouri and Territory of Arkansas.

Township No 18 North of the Base line Range No 3 West of the 3rd Principal Meridian.

page 18 and 13

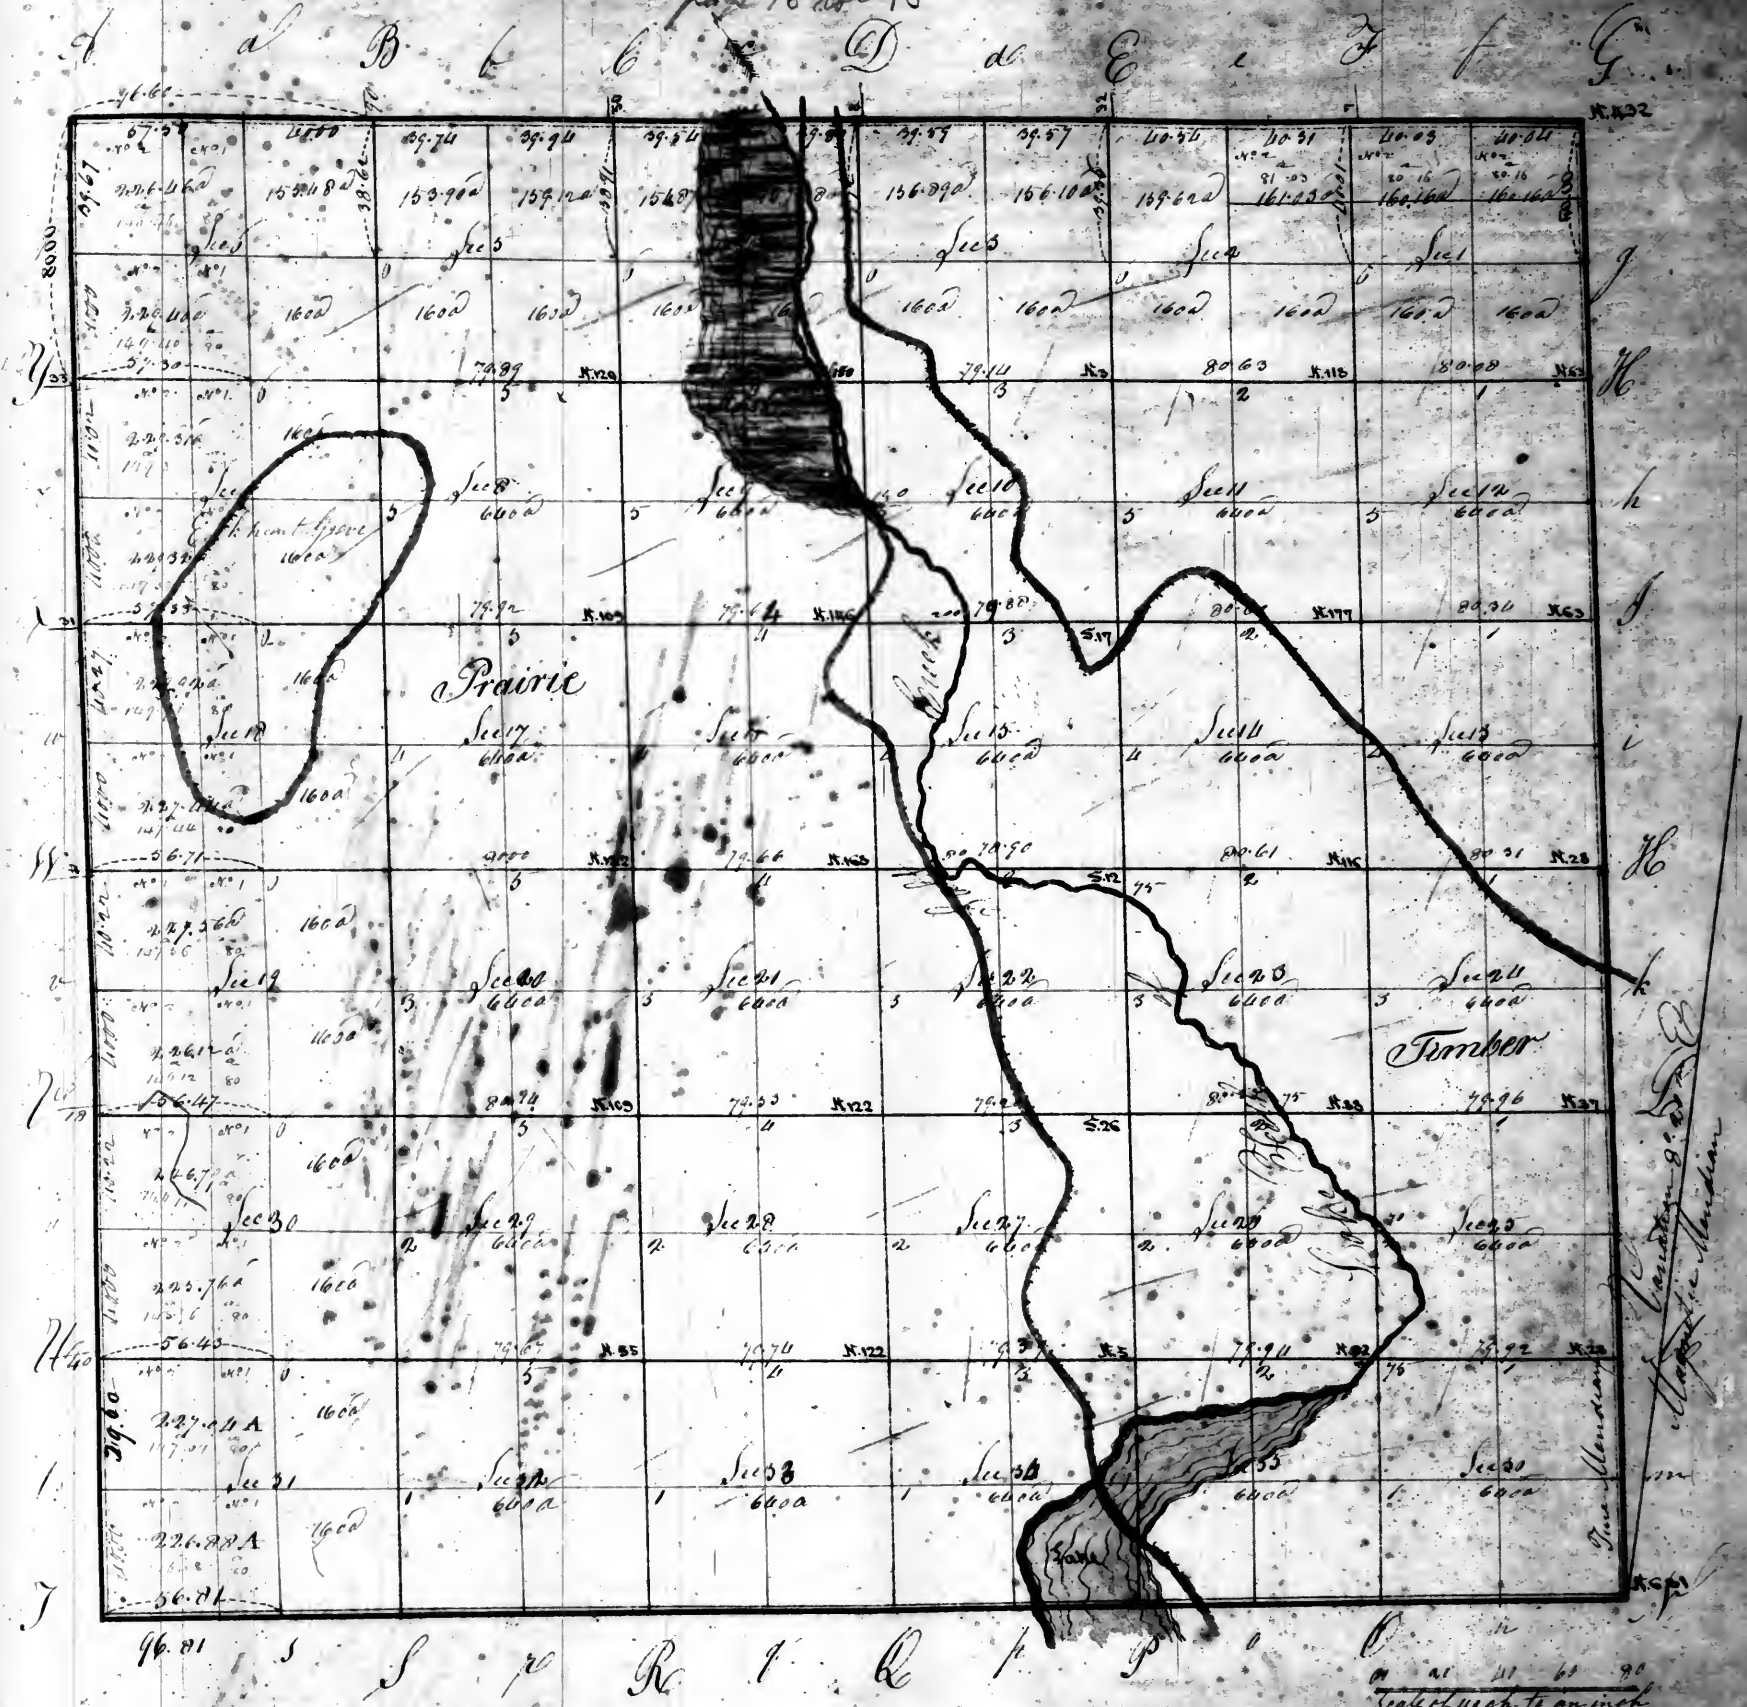

Pursuant to a contract with and instructions from William Reector Surveyor of the lands of the United States in the States of Illinois, Missouri and Territory of Arkansas bearing date the 17th Day of February 1822. I have admeasured laid out and Surveyed the above described Township and do hereby certify that it had such marks and bounds both natural and artificial as are represented on said plat and described in the field notes made thereof and returned with this plat into the Office of the Surveyor of the lands of the United States in the State of Illinois, Missouri and Territory of Arkansas.


Witness my hand and seal this 1st day of April 1825

Wm. Reector

Asst. by J. M. Smith

Page 19 of 13

100

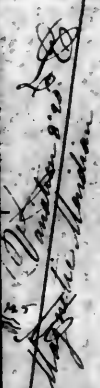


Scale of rock is an inch.

Pursuant to a contract with and instructions from William Bester Surveyor of the lands of the United States in the States of Illinois, Missouri and Territory of Arkansas bearing date the 19th Day of February 1822. Do admit and laid out and surveyed the above described Townships and do hereby certify that it had such marks and bounds both natural and artificial as are represented on said plat and described in the field notes made there and returned with this plat into the Office of the Surveyor of the lands of the United States in the States of Illinois, Missouri and Territory of Arkansas.

Approved by D. Miller

Township N. 20 South of the base line. Range N. 3 West of the 3^d Principal Meridian

page 20 of 13

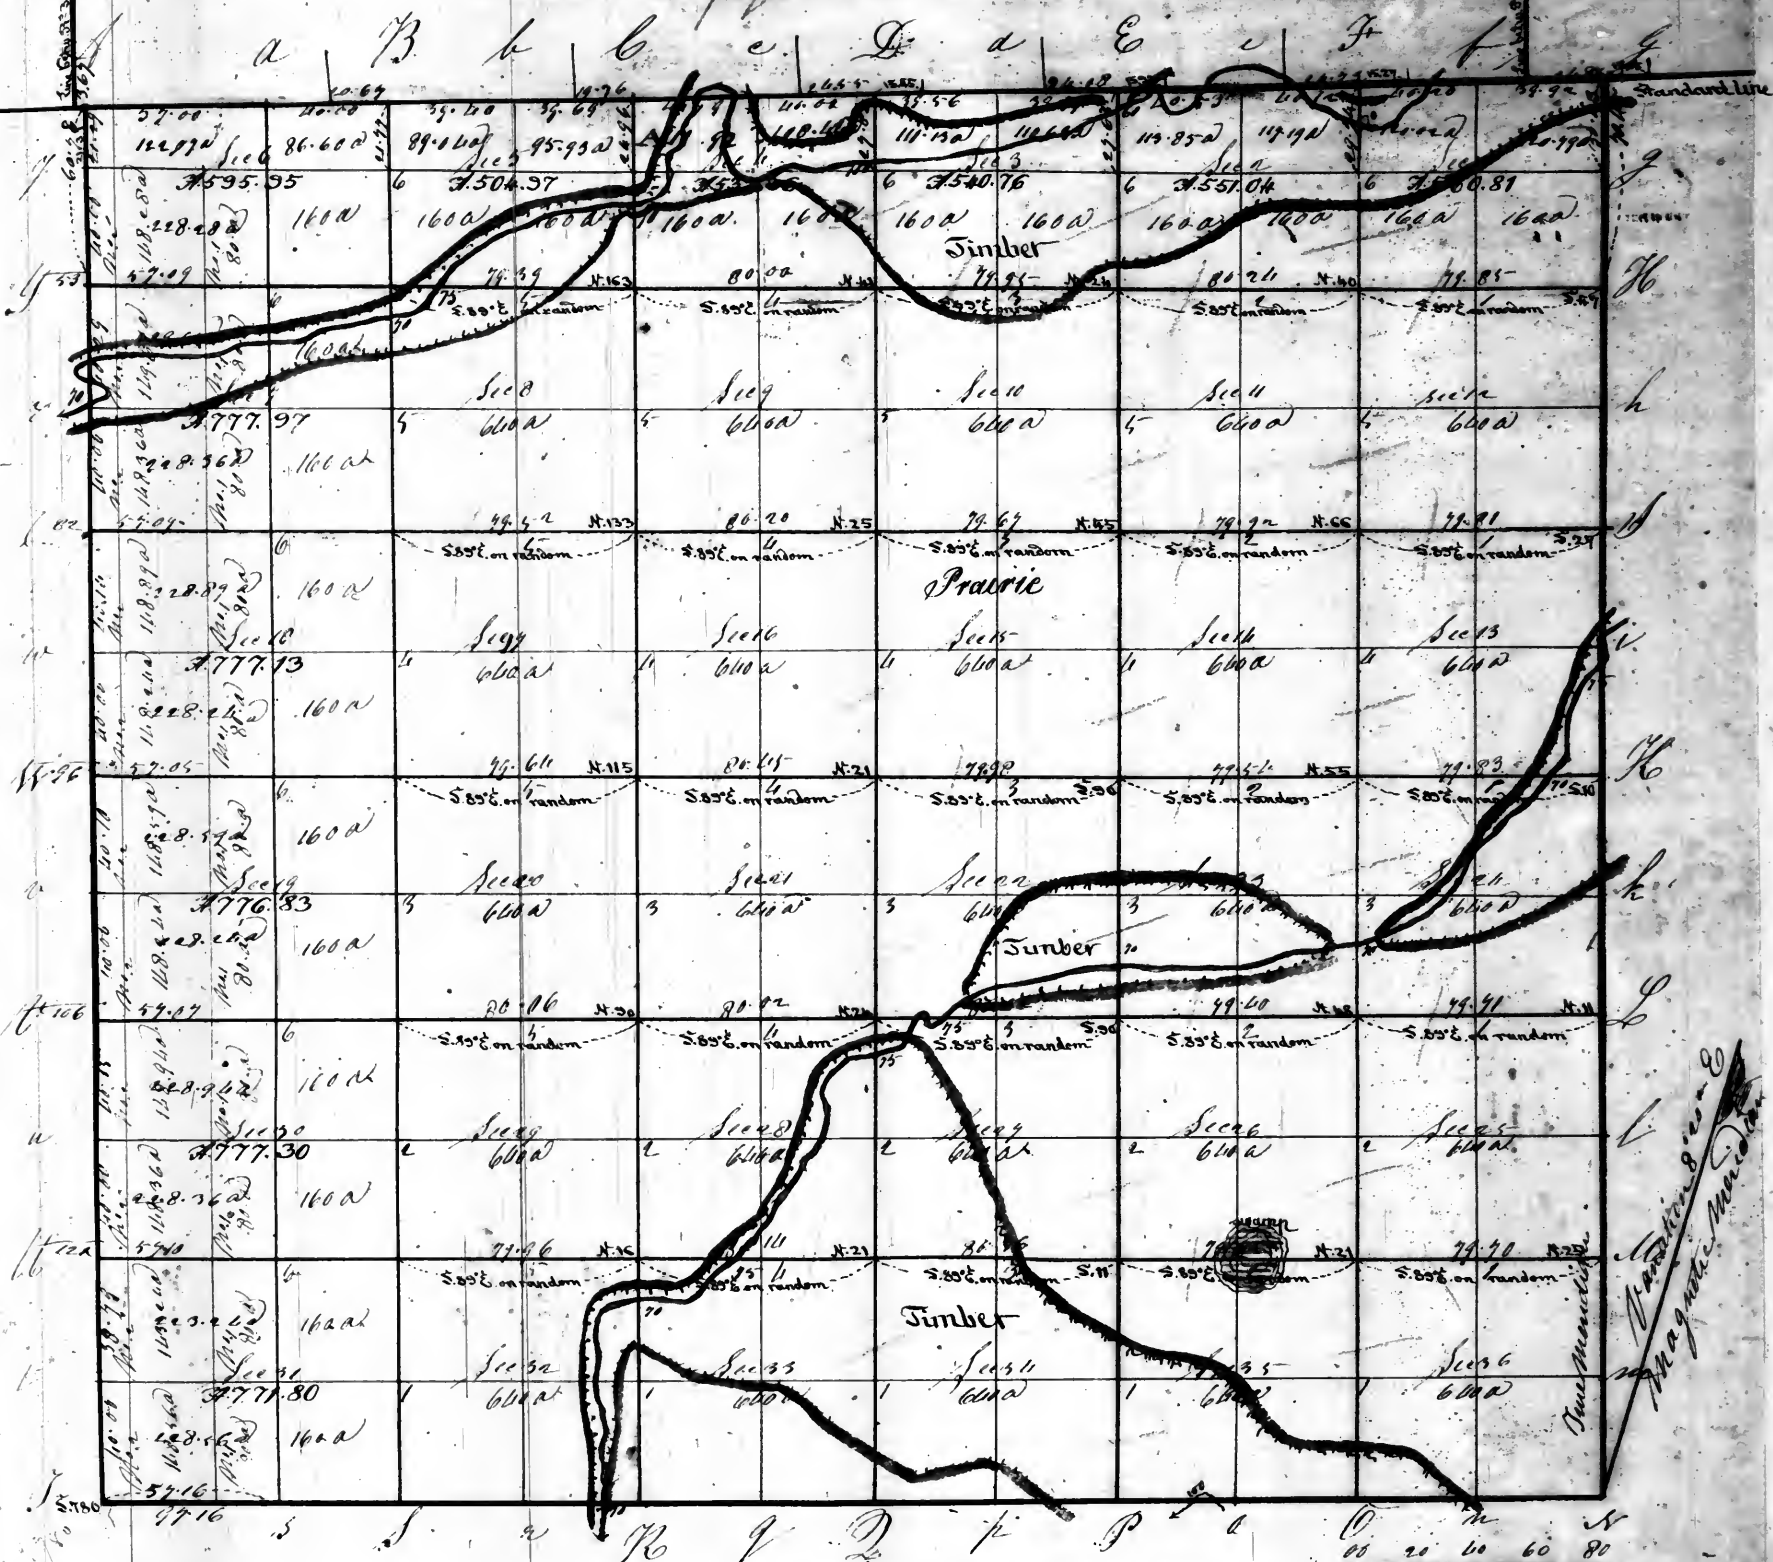

Aggregate area = 23167.92 acres

scale of 40 ch to an inch

in pursuance to a contract with and instructions from William Reiter Surveyor of the Lands of the United States in the States of Illinois, Missouri and Territory of Arkansas, bearing date the 19th Feb'y 1822 —
I have admeasured laid out and surveyed the above described township and do hereby certify that it had true marks and bounds both natural and artificial as are represented on said plat and described in the field notes made thereof and returned with this plat into the office of the Surveyor of the Land of the United States for the States of Illinois, Missouri and Territory of Arkansas
Certified 12th April 1823


Wm Reiter
Asst by R Miller

Recorded

page 2 of 13

Township No. 21 North of the base line, Range No. 3 West of the principal Meridian.

to corner station to section 6-7

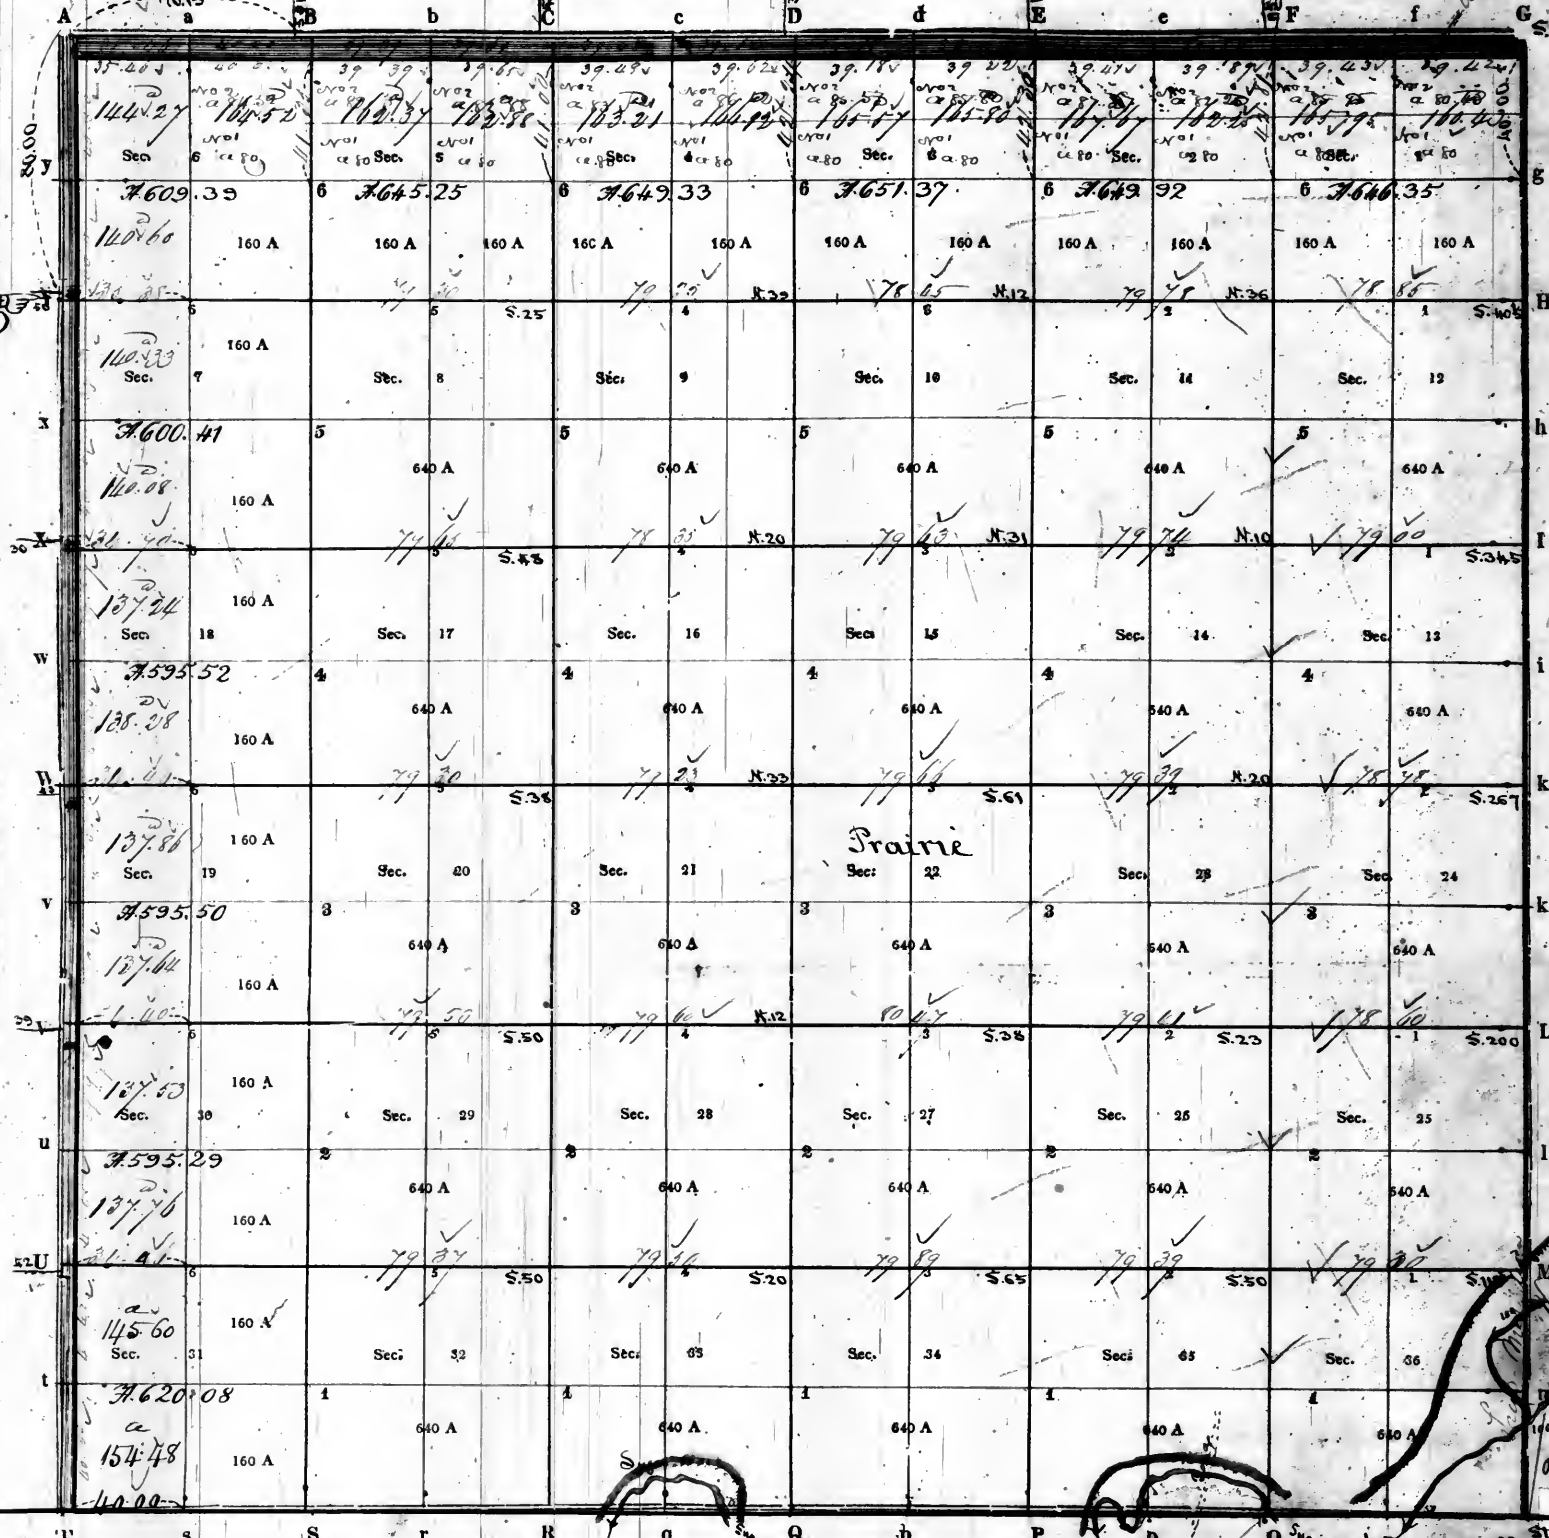

Aggregate area = 22858.41 acres

PURSUANT to a contract with and instructions from William Rector, Surveyor of the lands of the United States in the State of Illinois and Territory of Arkansas bearing date the 10th day of August 1820 we have measured, laid out and surveyed the above described Township; and do hereby certify, that it had such marks and bounds, both natural and artificial, as are represented on said plat, and described in the field notes made thereof, and returned with this plat into the Office of the Surveyor of the Lands of the United States, in the State of Illinois and Territory of Arkansas

Certified this 10th day of August 1820

EXAMINED.

Examined Wm. Rector

William Rector SURVEYOR. Stephen Rector

Recorded

8012
2013
189

22


page 22 vol 13

Township No. 22 North

of the base line, Range No. 5 West

of the

principal Meridian.

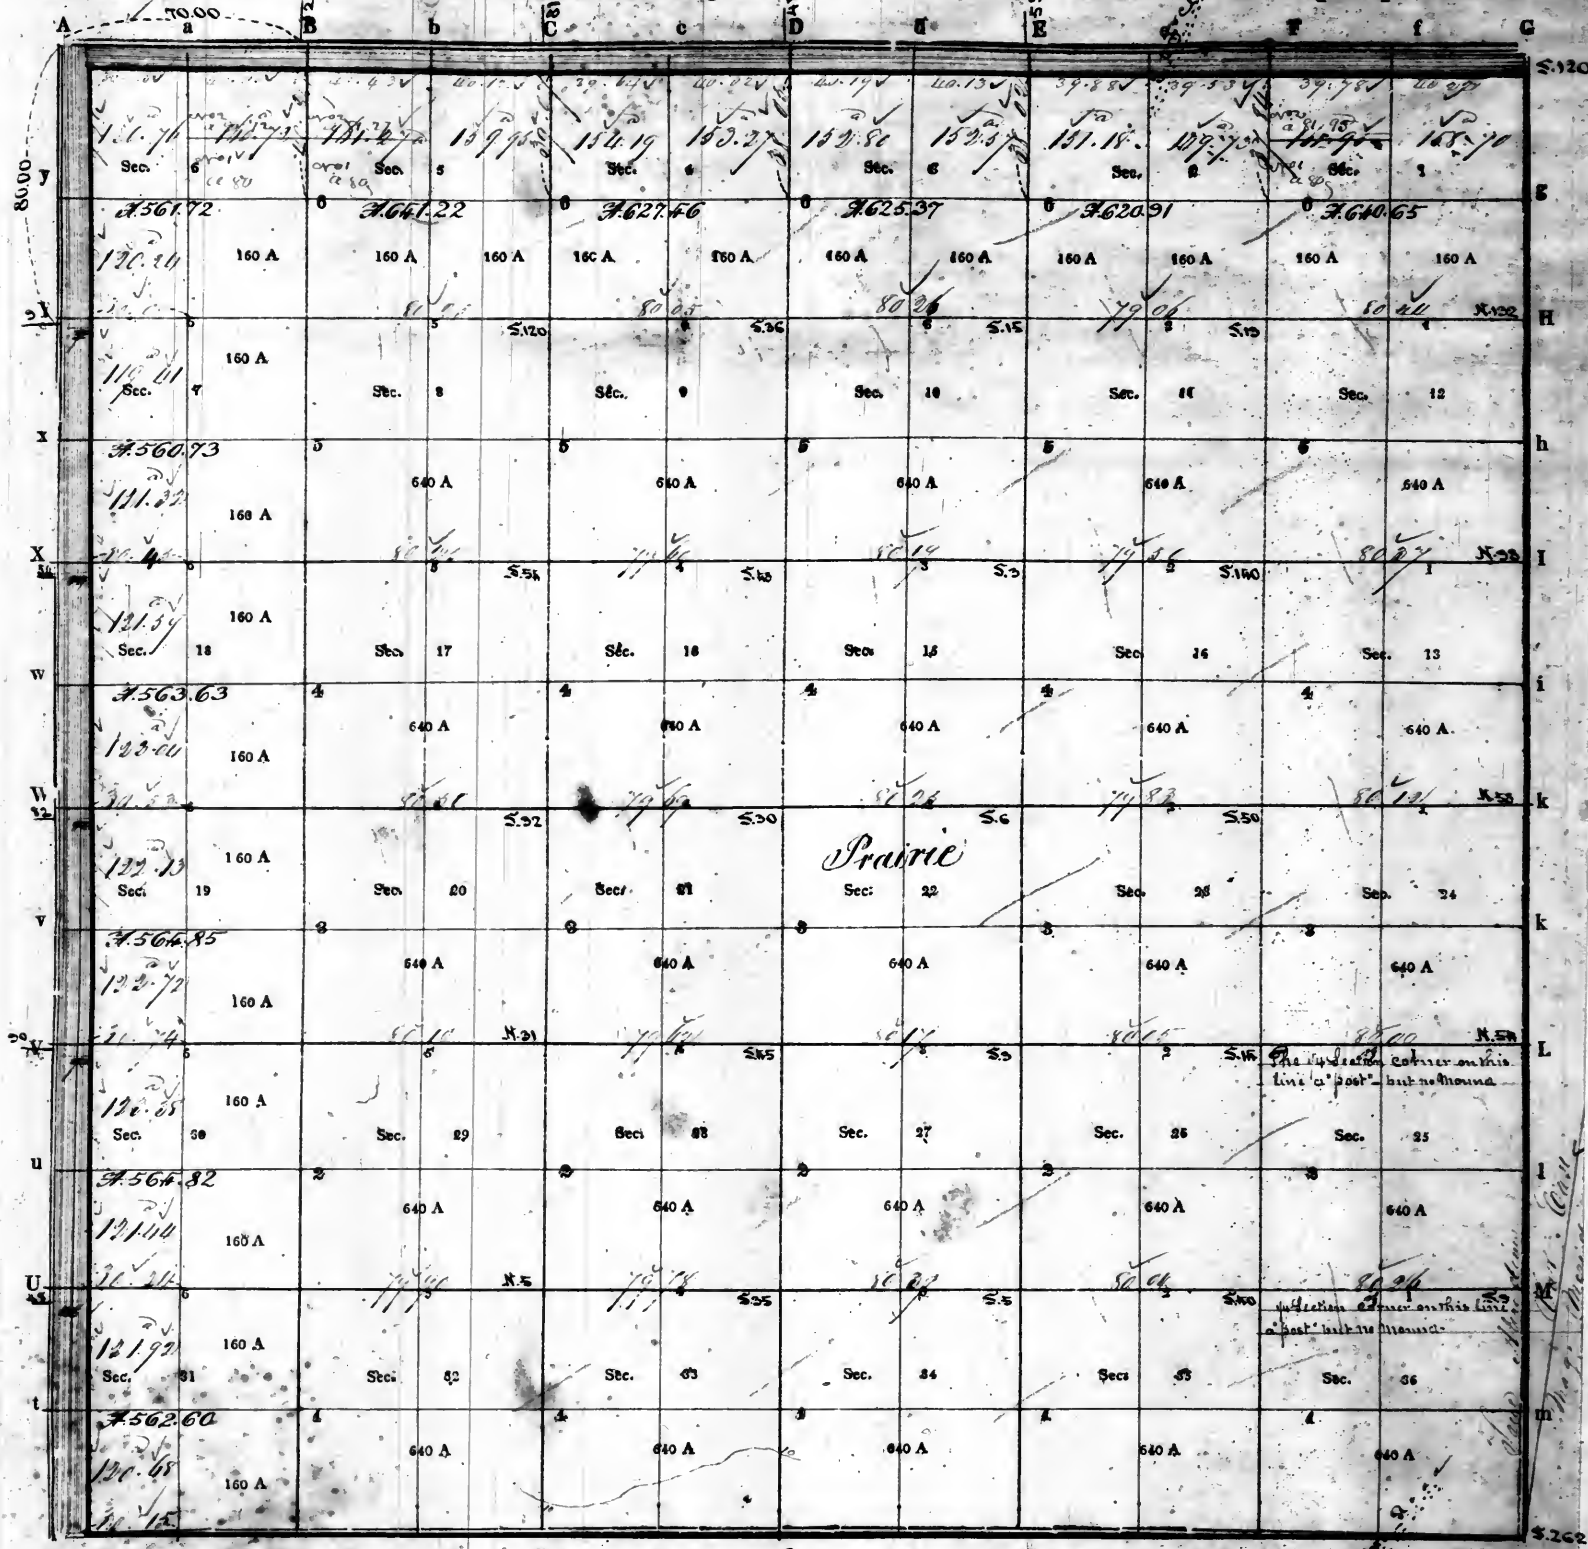

Aggregate area 22533.92 ac

Scale of 40 Chains to an inch.

PURSUANT to a contract with, and instructions from William Rector, Surveyor of the lands of the United States in the State of Illinois and Territory of Arkansas, I have measured, laid out and surveyed the above described Township; and do hereby certify, that it had such marks and bounds, both natural and artificial, as are represented on said plat, and described in the field notes made thereof, and returned with this plat into the Office of the Surveyor of the Lands of the United States, in the State of Illinois and Territory of Arkansas.

Certified this day of



EXAMINED.

Examined
W. M. Rector

William Rector
Surveyor of the Lands of the United States

Recorded

Township N° 20 North of the base line Range N° 3 West of the 3^d Principal Meridian
page 23 vol 13

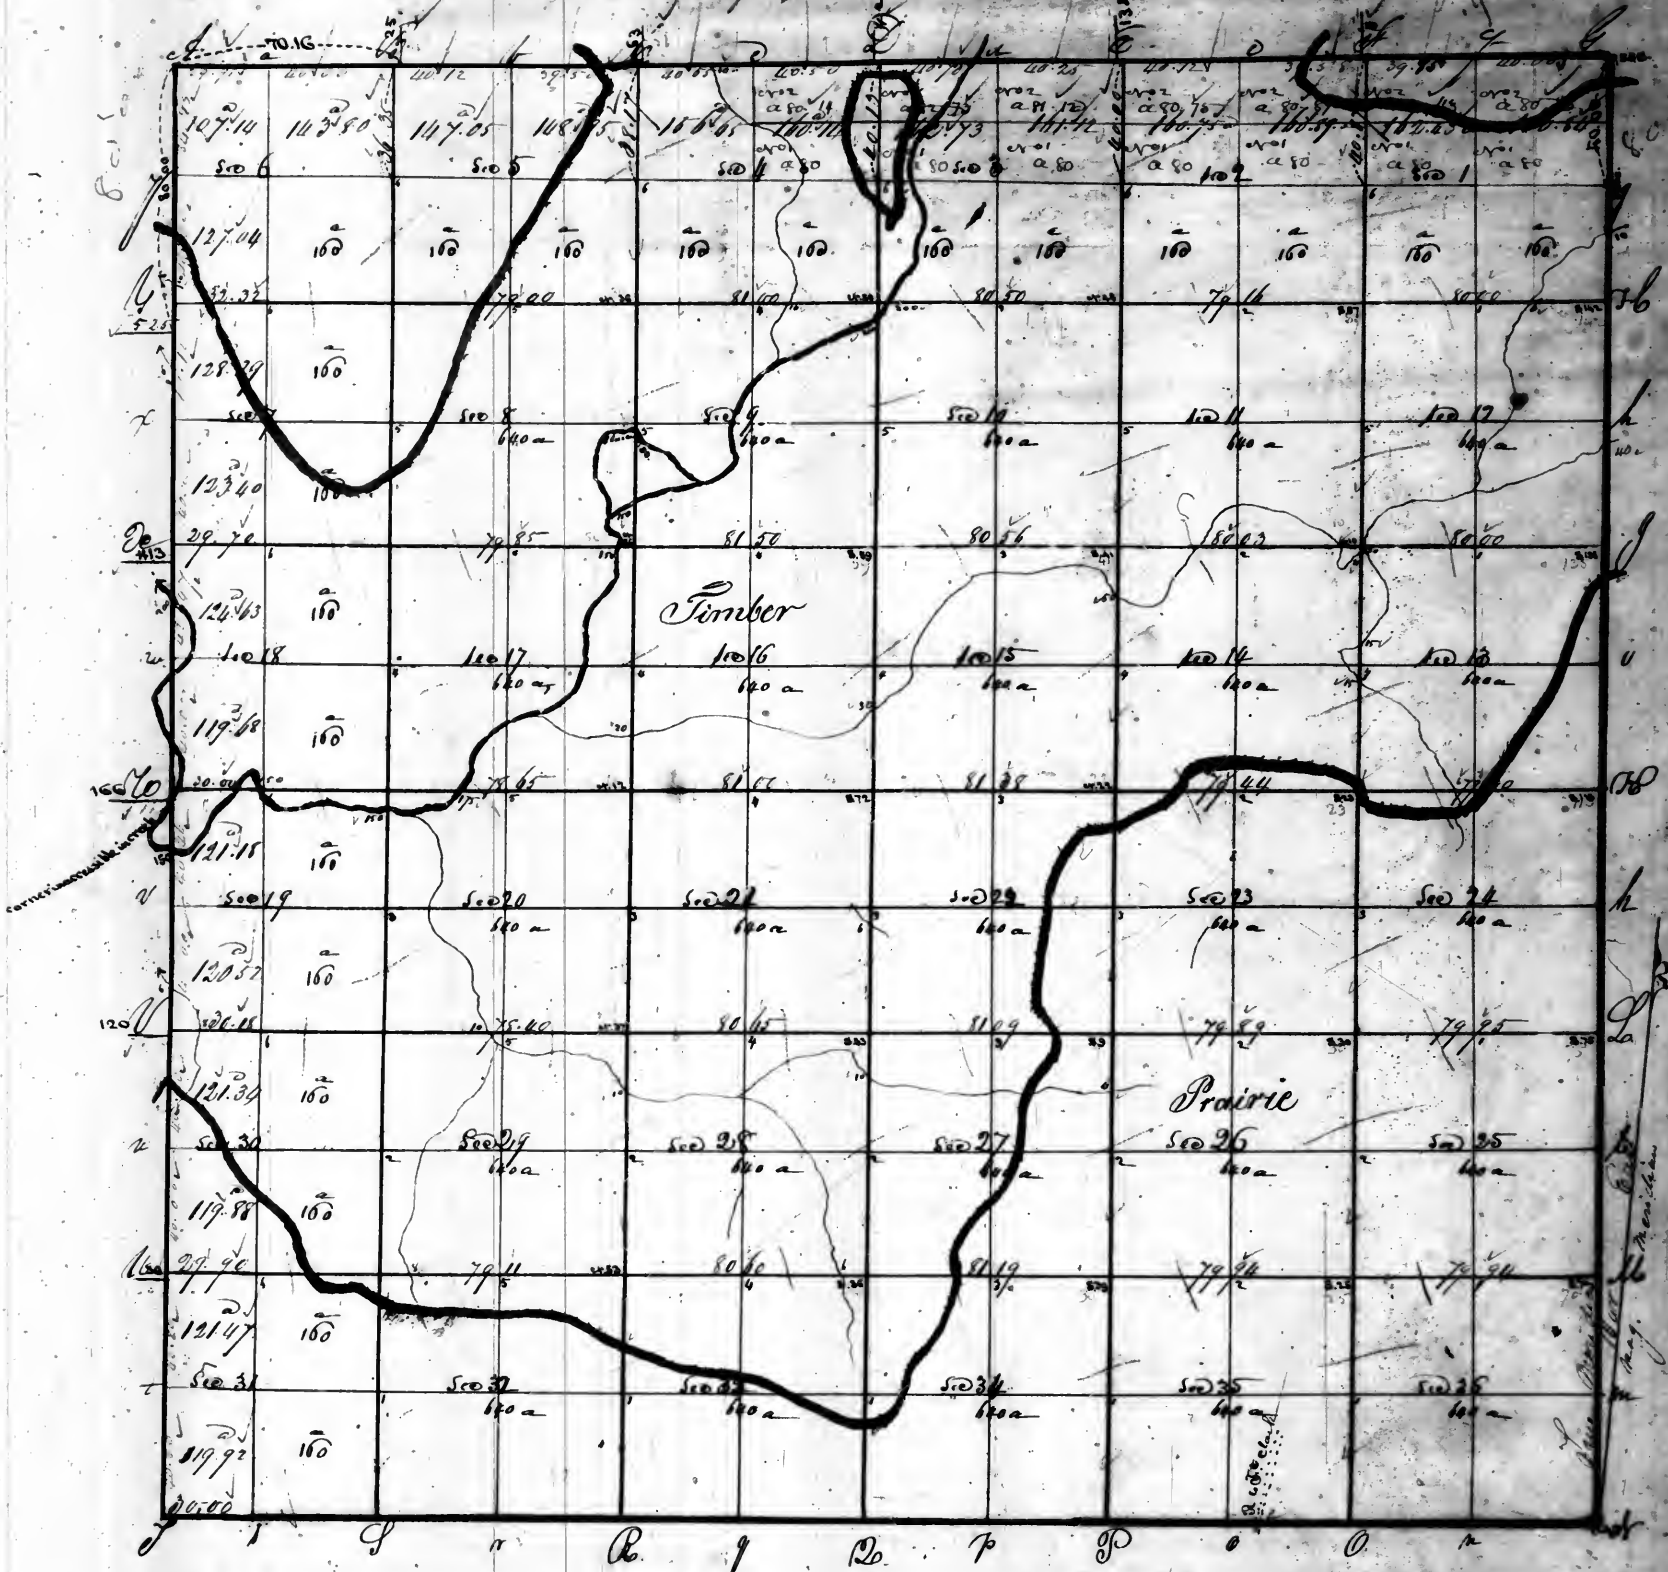


Pursuant to a contract with and instructions from William Banta Surveyor of the Land of the United States in the States of Illinois and Missouri and Territory of Arkansas bearing date the first day of August 1852 we have measured laid out and surveyed the above described Township and do hereby certify that it has such marks and boundary both natural and artificial as are represented on said plat and as described in the field notes made thereof and returned with this plat into the office of the Surveyor of the Land of the United States in the State of Illinois and Missouri and Territory of Arkansas

Testified

William Banta Surveyor
Stephen Porter De Witt

Recorded

Township No. 24 North of the base line, Range No. 24 West of the 3rd principal Meridian.

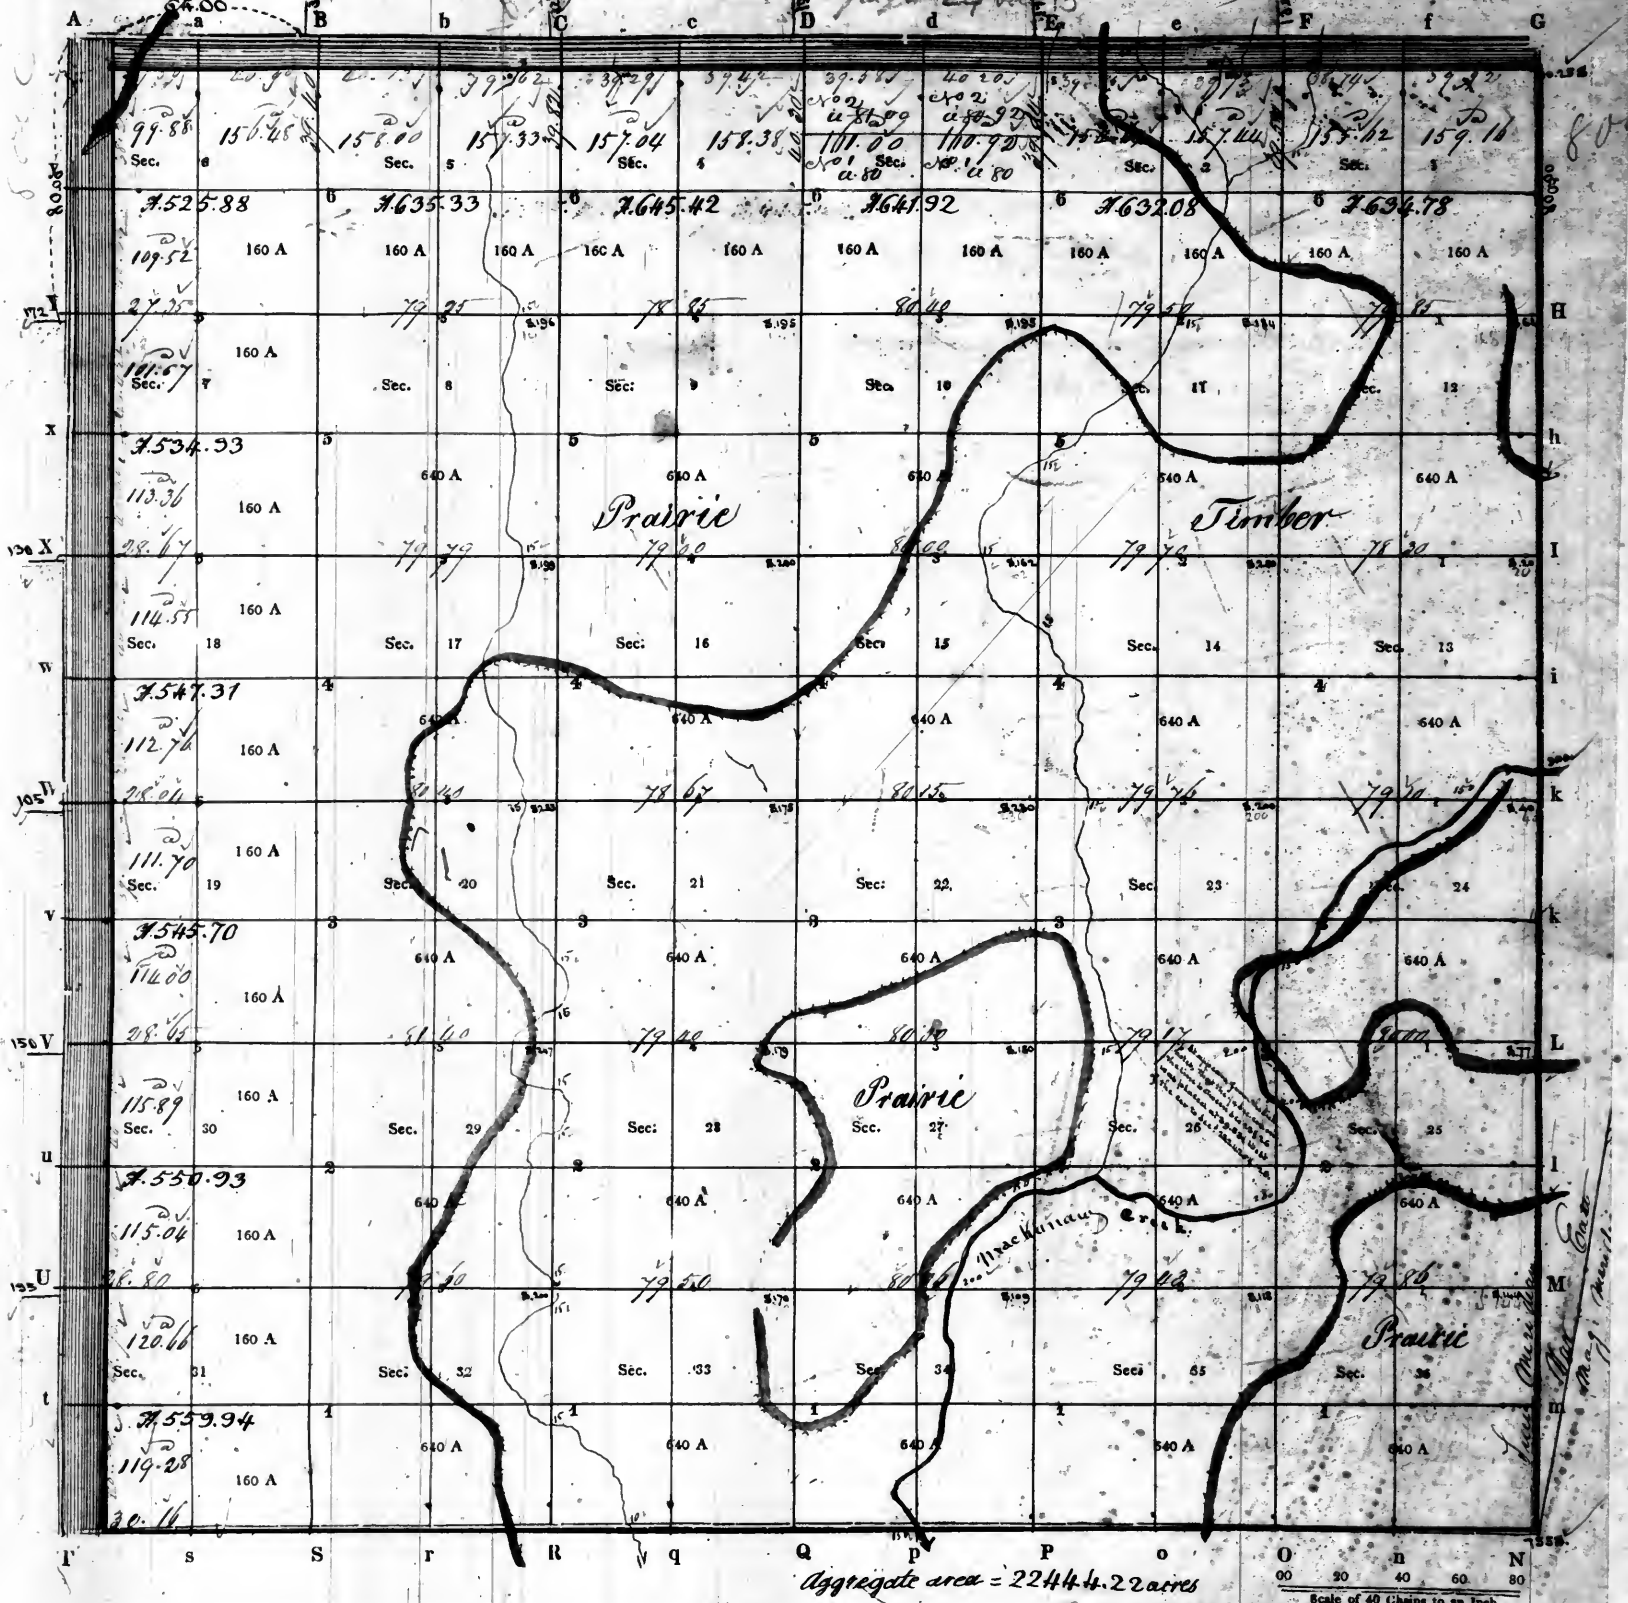

Aggregate area = 22444.22 acres


PURSUANT to a contract with, and instructions from William Rector, Surveyor of the lands of the United States in the States of Missouri and Territory of Arkansas bearing date the day of 182 I have measured, laid out and surveyed the above described Township; and do hereby certify, that it had such marks and bounds, both natural and artificial, as are represented on said plat, and described in the field notes made thereof, and returned with this plat into the Office of the Surveyor of the Lands of the United States, in the States of Missouri and Territory of Arkansas.

Certified this day of 182

EXAMINED,

William Rector D. SURVEYOR.

page 25 vol 13

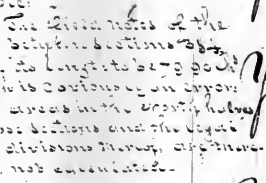


The notes of the line between
Sections 34 & 35 all for in-
serting the Standard line
at 7920 ft.
This is so obvious an
error and there being
no doubt but 7920
is the length of that line
the plot is constructed
accordingly. *and*



12. 1889 - The above place is (with the exception of the North Indian of West 3)
the only one of the Cap. surveys on file in this office. Wm. C. Rowland

Township N. 26 North of the Base line of Range N. 3 West of the 3rd P. M. S.
page 26 vol 13

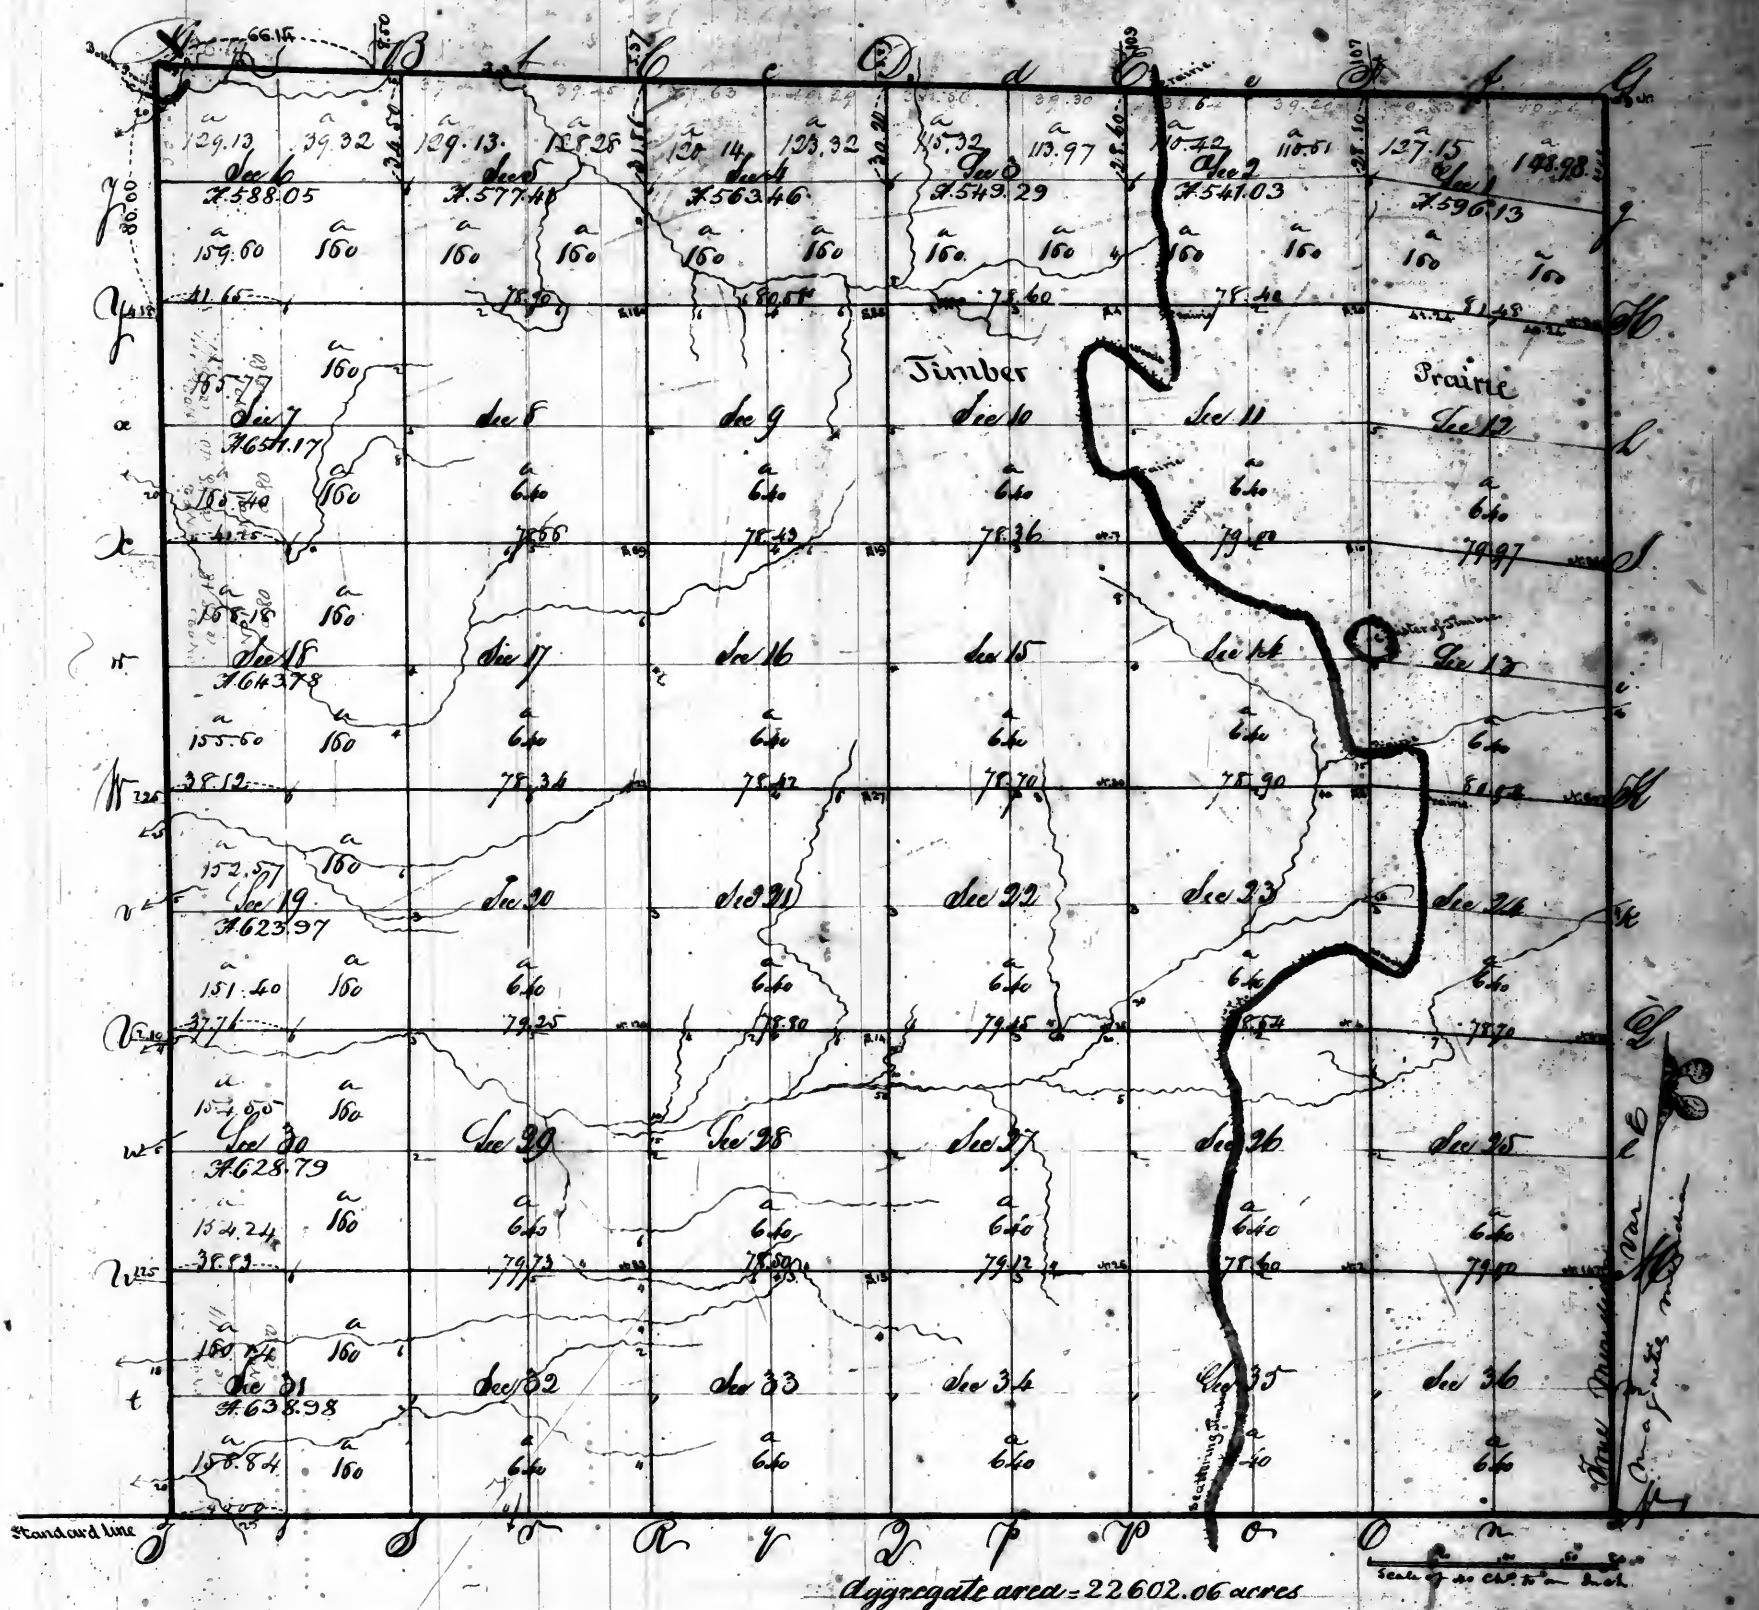

Pursuant to a contract with and instructions from William Reister, Surveyor of the lands of the United States in the States of Illinois and Missouri and the Territory of Arkansas bearing date the ... day of ... We have admeasured laid out and surveyed the above described Township and do hereby certify that it had such marks and bounds both natural and artificial as are represented on said plat and described in the field notes thereof and returned with this plat into the Office of the Surveyor of the Lands of the United States in the State of Illinois and Missouri and the Territory of Arkansas.


Witnessed this ... day of ... 1824

Examined

William Reister, Surveyor
Stephen Foster, Deputy

Recorded

Tract of Township N 23 North of the base line Range N 3 West of the 3rd principal meridian
page 28 vol 4

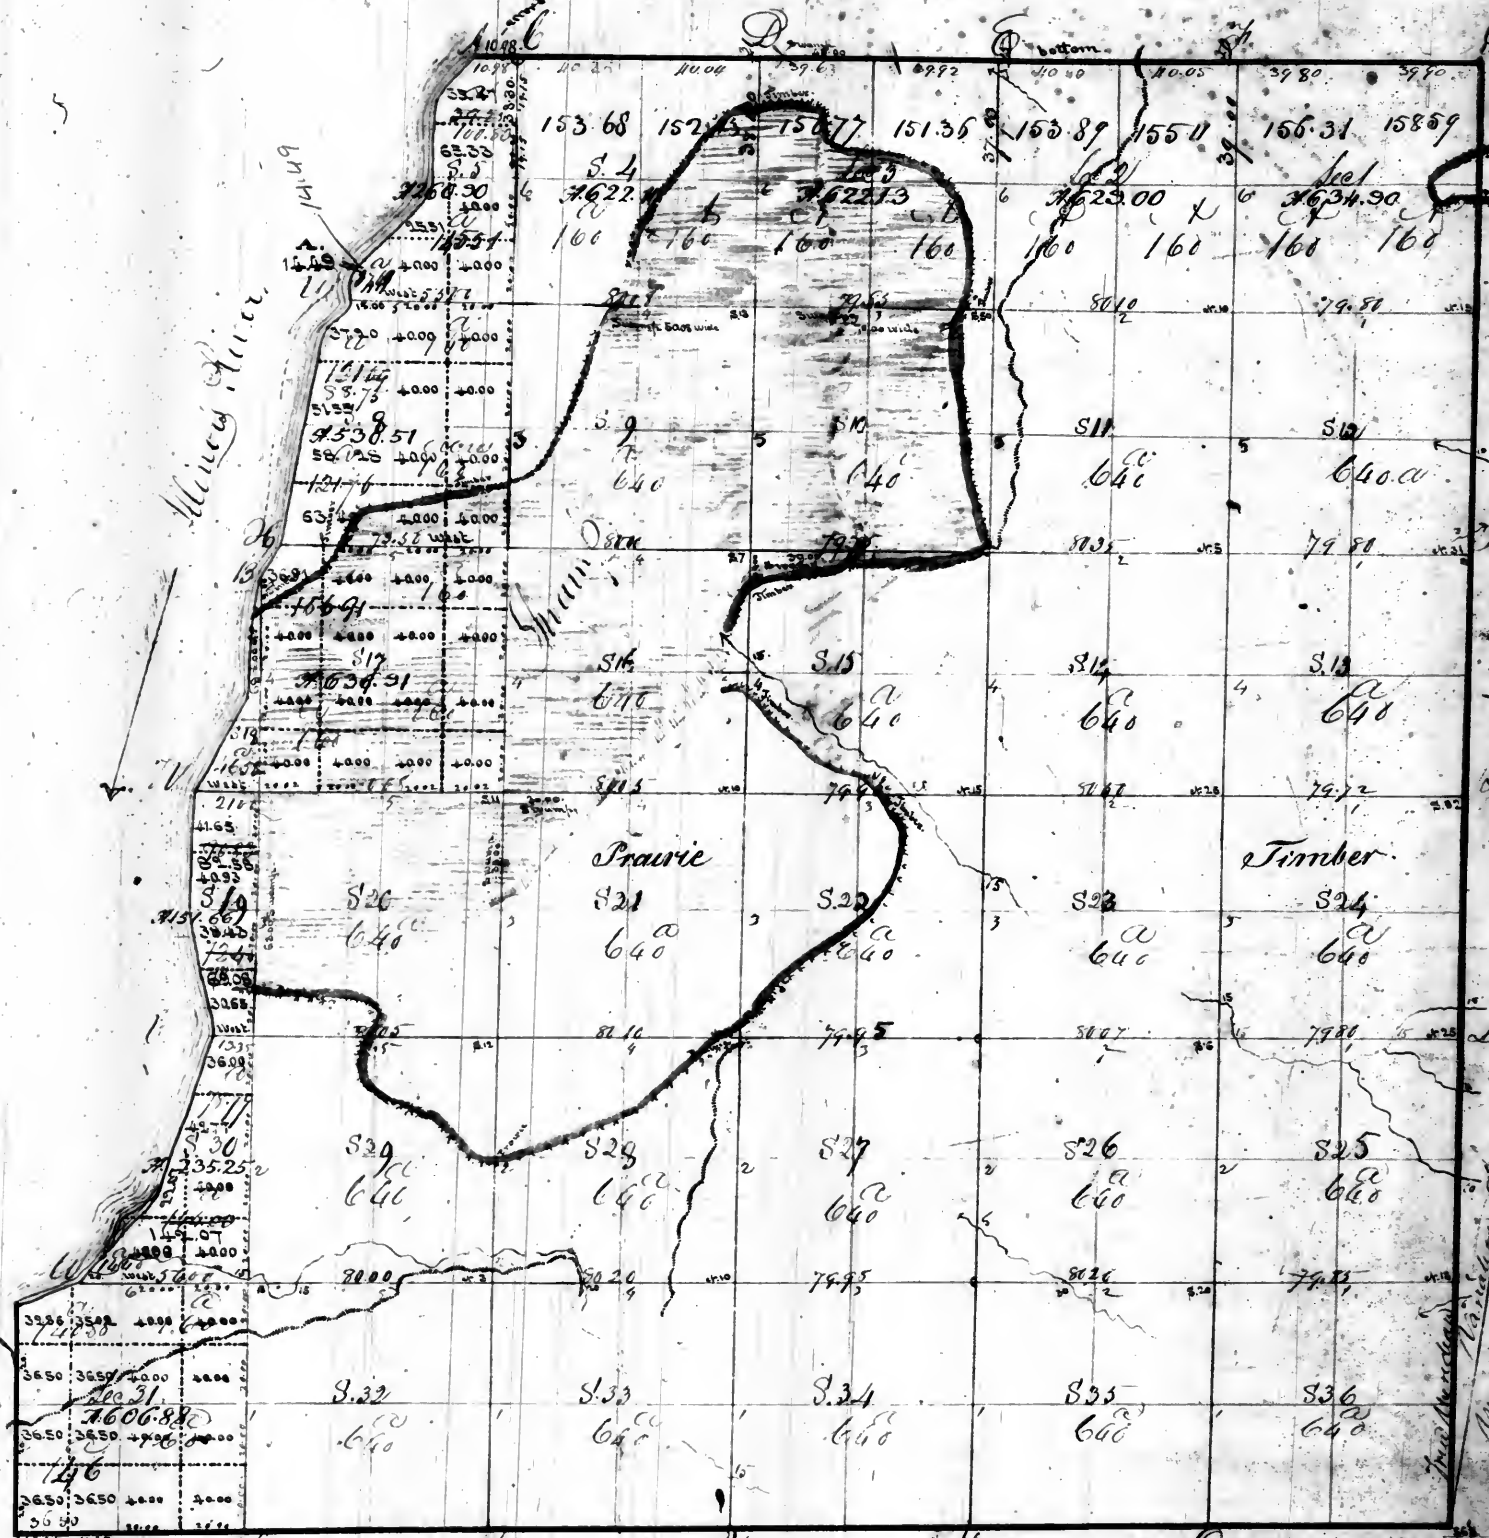

Surveyor's Office
St. Louis 10th August 1824
Plat of the Sec 5, 11, 19, 20, 21, sent this day to the Commr of the Genl O.

Aggregate area, 196 96.82 acres
Scale of 40 Ch to an Inch
Pursuant to contract made and instructions from William Lister, Surveyor of the lands of the United States, the State of Illinois and Missouri and Territory of Arkansas, bearing date, 14th June 1823.
I have attested, laid out and surveyed the above described fractional corners and do hereby certify that
had such mark, and bounds, both natural and artificial, as are represented in the field notes made
by me and returned with this plat to the office of the Surveyor of the Lands of the United States in the State of Illinois and Missouri and Territory of Arkansas.
Certified this 20th day of March 1824.
Jno. B. Sanford Surveyor

156.09
428.77
271.38


160.

Records

29

Fractional Township N. 29 North of the base line Range 1 West of the 3rd Meridian

page 29a

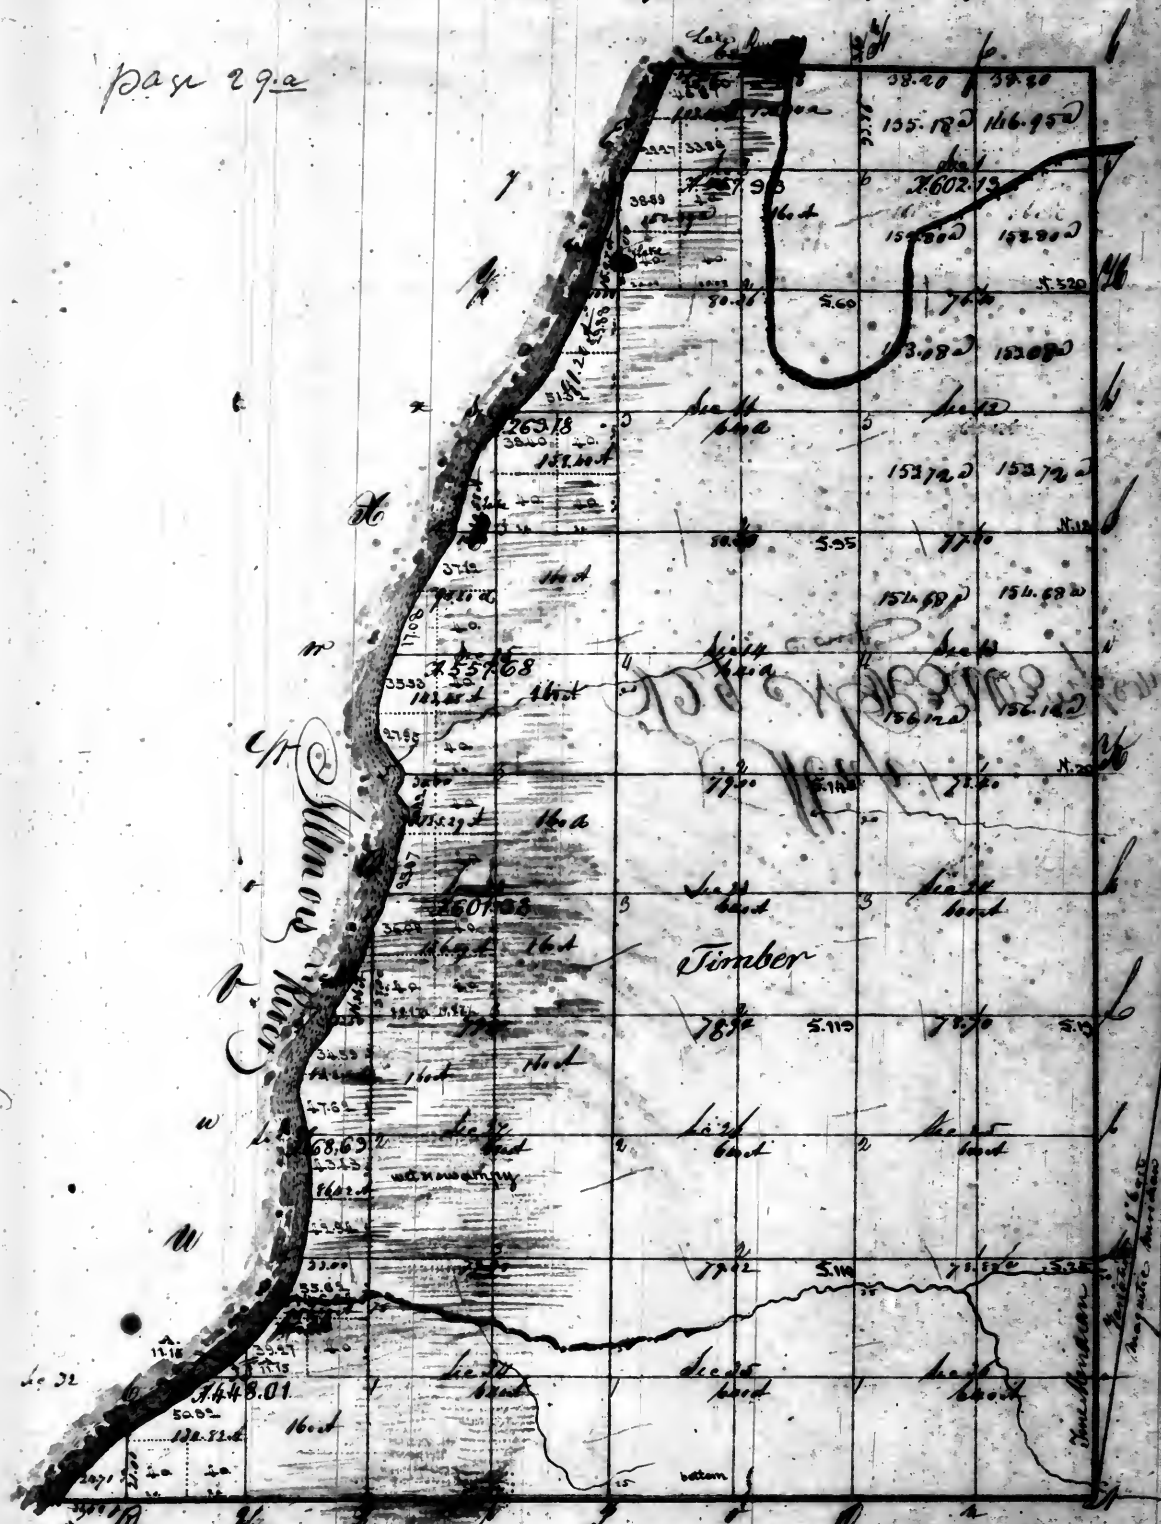

April 18th 1855
The following Submissions
have been made and put down on file
Plat the N.W. 1/4 Sec 2
N.W. 1/4 Sec 10
N.W. 1/4 Sec 15
N.W. 1/4 Sec 22
N.W. 1/4 Sec 33
frac. 25
and a copy thereof sent to the Register
this 18th April 1855


Surveyor's Office
St. Louis 10th August 1842.
Plat of Grad. Sects 2, 3, 10, 15, 21, 22, 23, 31
and 33 sent this day to the Commr. of the
Genl. L.O.

Aggregate area = 10342.48 acres
Pursuant to a contract with and instructions from William Hector, Surveyor of the lands of the
United States in the State of Illinois and Territory of Arkansas bearing date the 15th of June
1853, I have, as directed, laid out and surveyed the above described Fractional Township and do
hereby certify that it has been made and found both natural and artificial as an representation of the plat
and is shown in the field notes made therefor and returned with the plat into the office of the
Surveyor of the lands of the United States for the State of Missouri and Territory of Arkansas
Certified by O. M. Smith 1855
William M. Mather 73

Plot of Township 1 North of the Base line in Range 4 West of the 3rd principal Meridian.

Vol. 16
opposite p. 31

Recorded

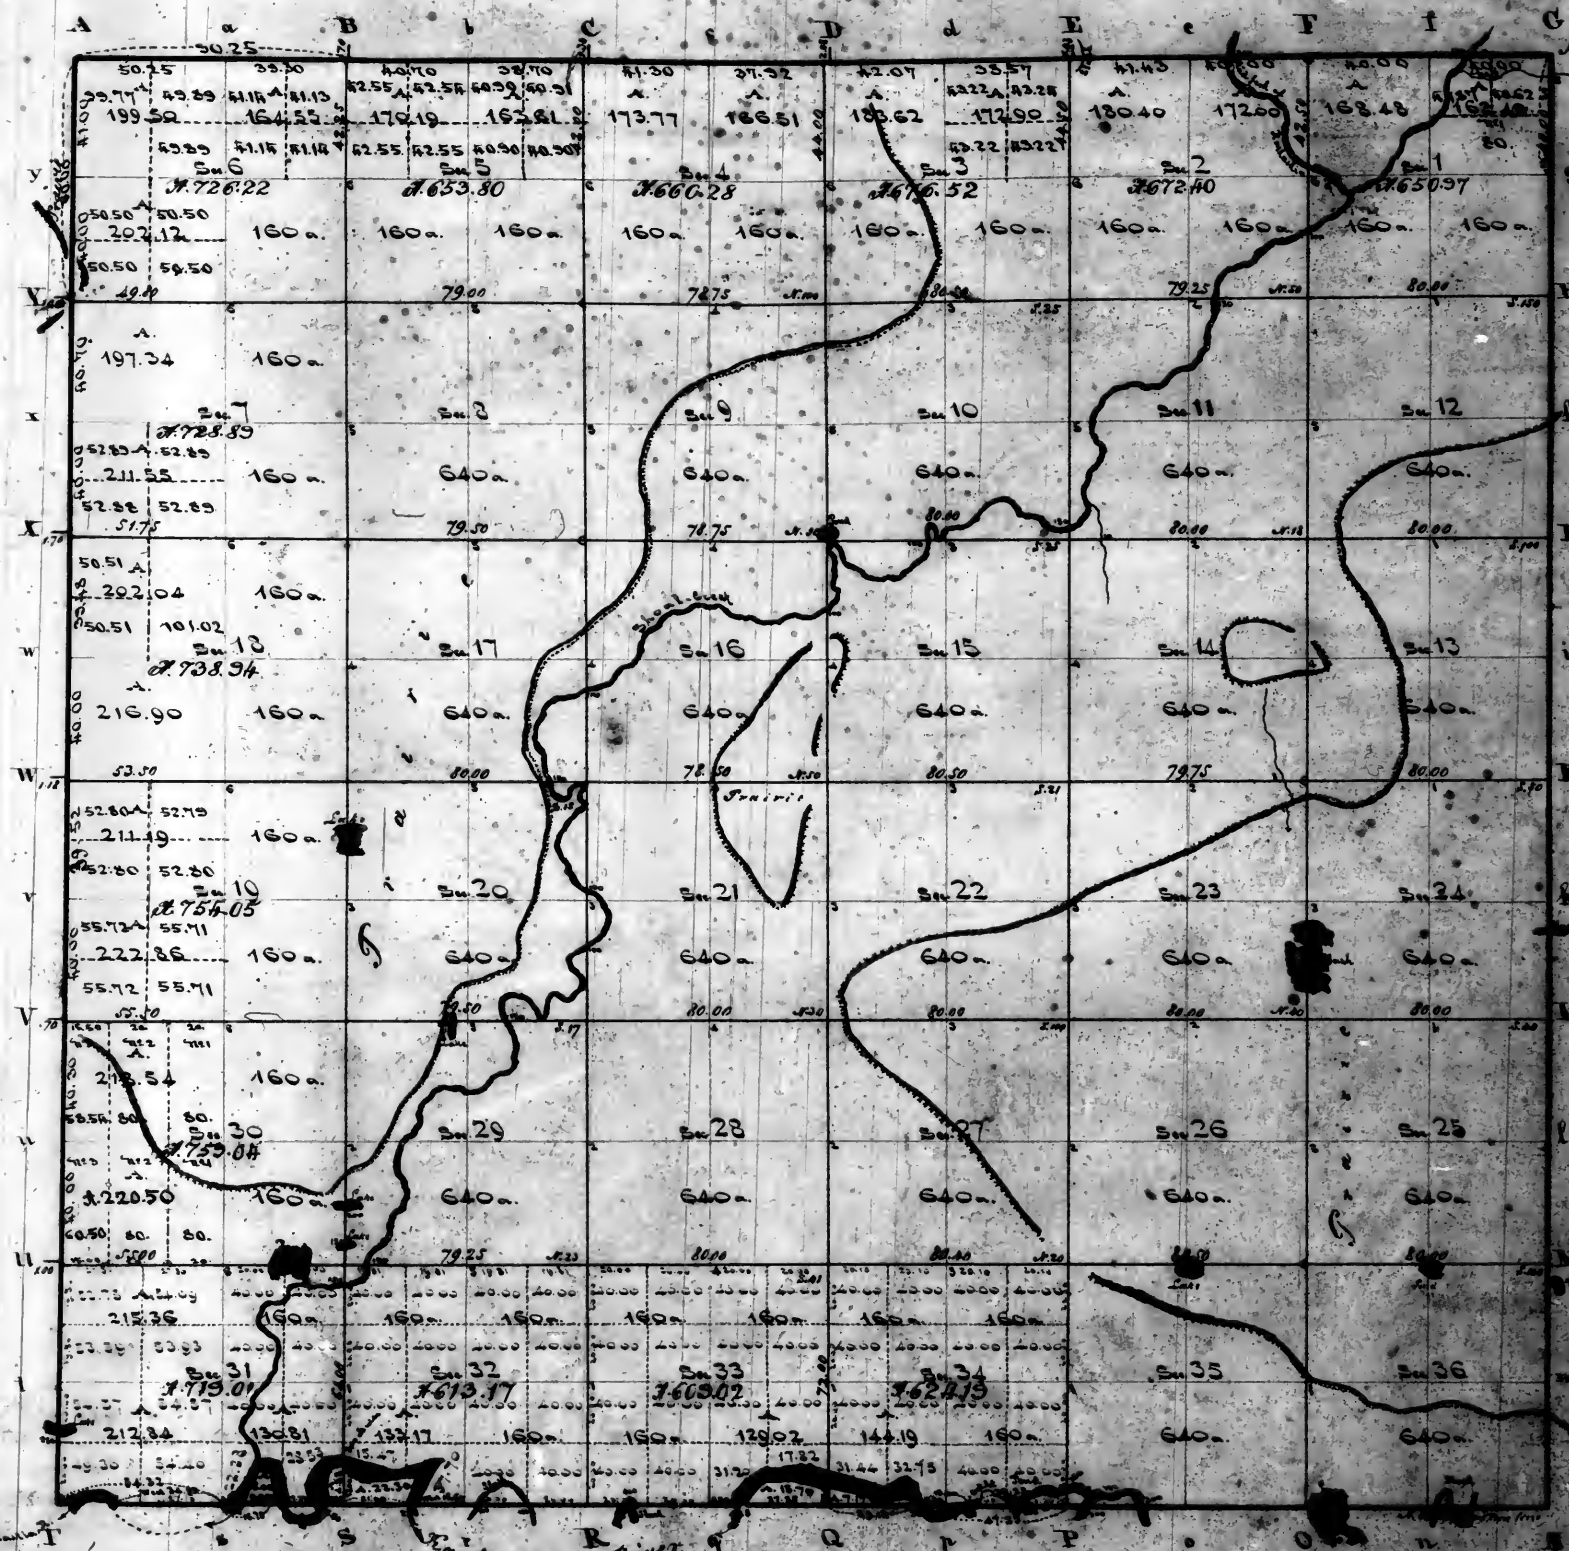

Note. The 6 corners of the South boundary in T. 1 N. R. 4 W. are used as 1/2 c. in this Township, in calculating the areas of the North halves of sections 1, 2, 3, 4, 5 & 6.

Surveyor's Office
St. Louis 14th July 1842.
Plot of Sections 11, 22, 33, 34, 35
and was sent to the Commissioner of
the General Land Office.

Variation 17° 20' East


Surveyor's Office
St. Louis

Scale of 40 chains to one inch
Aggregate area 23724.66 acres

copy of the plot thereof on file in this office

8070
115
95

Recorded on last page

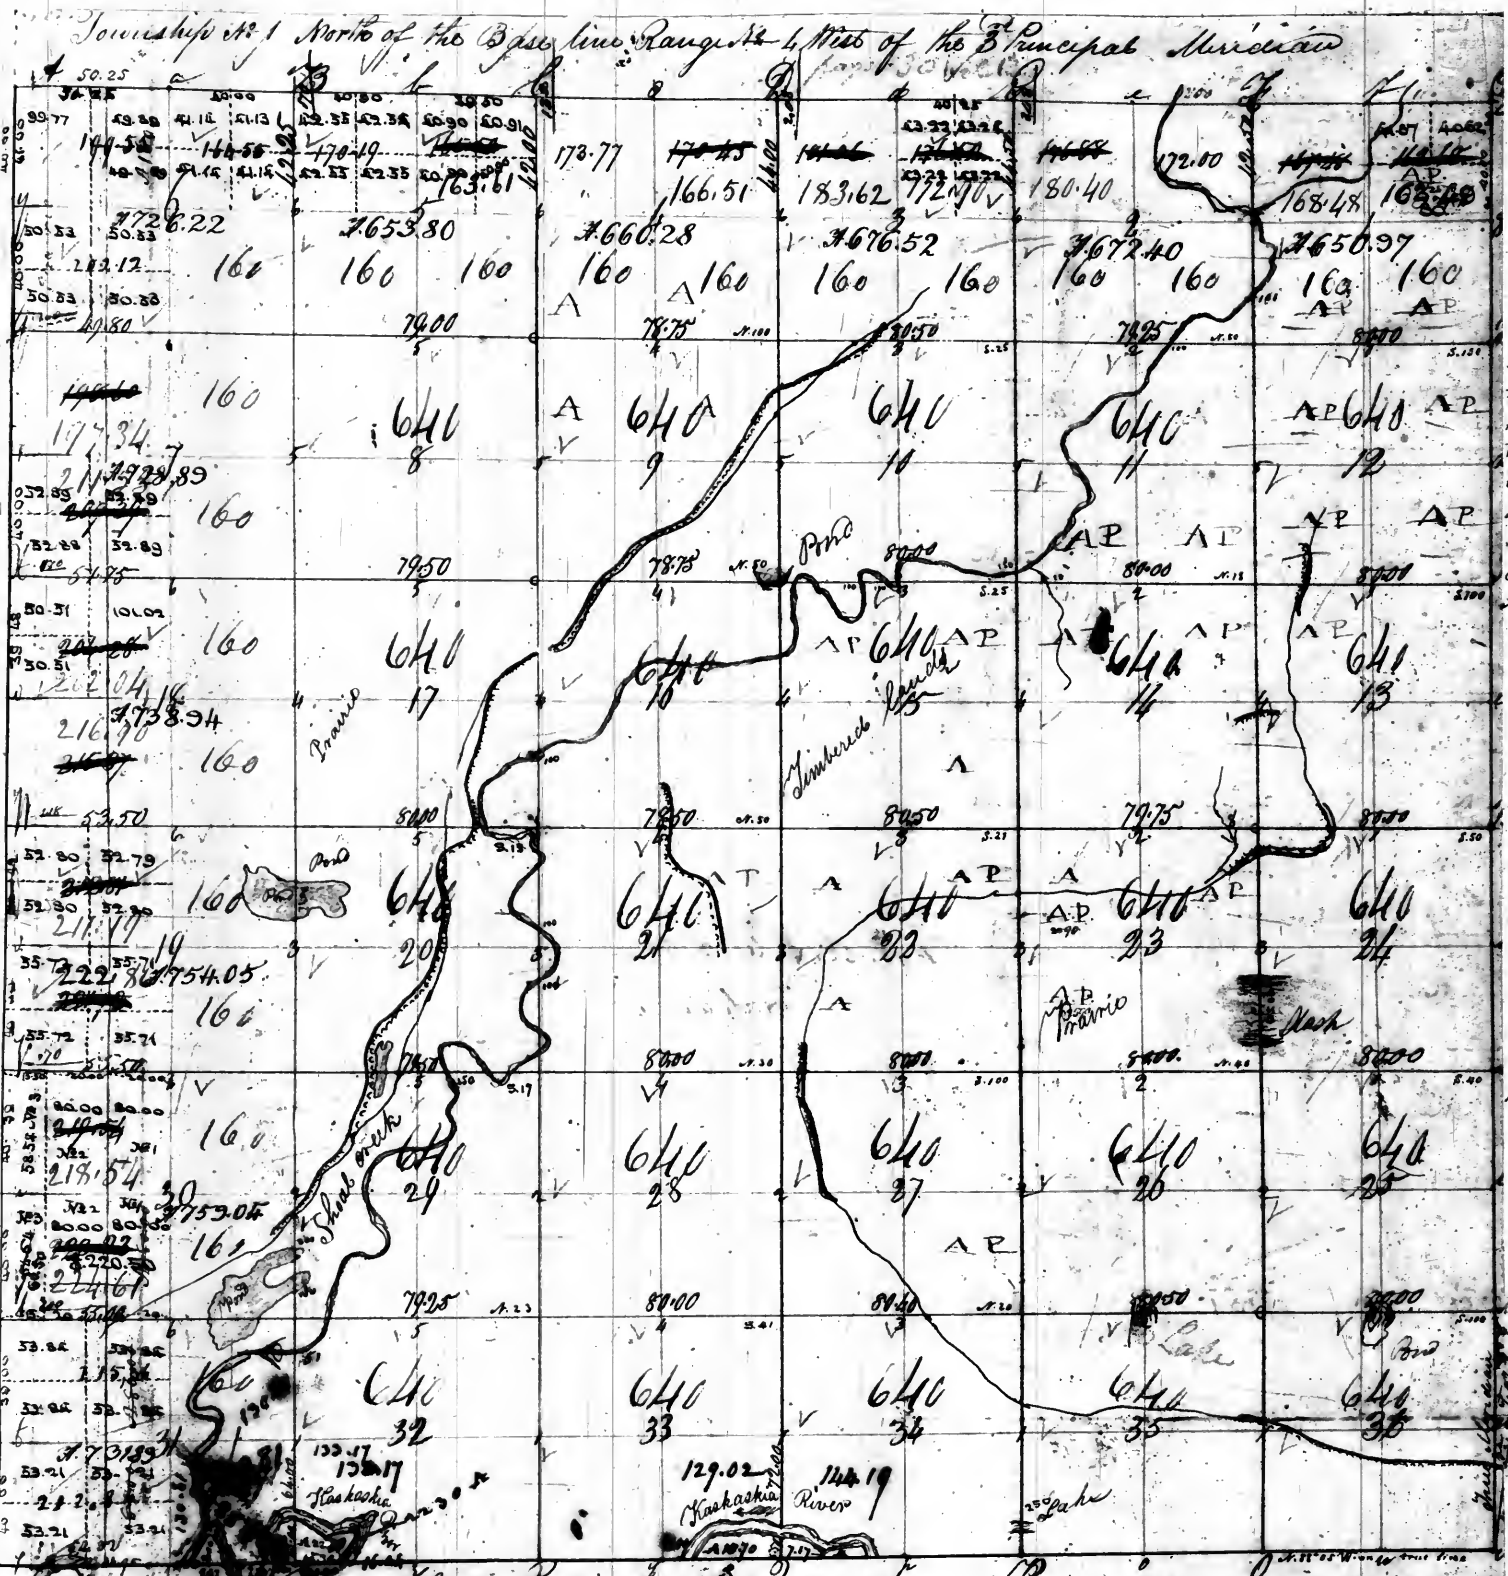

Reference to the fieldnotes of the survey of this Township by which the lines of this plat have been examined & corrected, of the North, West and East boundaries in act. book 20, - of the South boundary in act. book 29 & 55 and Subd. book 2, 96 A & G, - of the Subdivisions and measures of Kaskaskia River in book 20.

Surveyor's Office
St. Louis 1st Feb^y 1844.
Subdivided under the Act of Congress of the 5th of April 1832 (an act equal of the plat, to day, one to the Register of the district - (and another to the Com^r of the General Land Office, viz:
West half of section 30.
also subdivided to conform to previous sales as reported by the Register on the 4th July 1843 viz:
S. 1/2 of section 5 & 6.
S. 1/2 of sec. 10 & 11.
NW. 1/4 sec. 13.
NW. 1/4 of sec. 19 & 31 and the 1/2 quarter of sec. 3.

Surveyor's Office
St. Louis June 20th 1851
Sent this day copy of plat of S.W. 1/4 Sec. 30 to the Register, and another copy to the Com^r of the Gen^l Land Office.

Pursuant to a contract, with and instructions from Louis Kings Esq^r Surveyor General of the United States bearing date the 5th day of June A.D. 1844, I have examined laid out and surveyed the above described Township and do hereby certify that it had such marks and bounds both Natural and artificial as are represented on said plat and as noted in the field notes made thereof and returns with the plat into the Surveyor General's Office

Certified this 20th day of April A.D. 1845

Wm. L. C. Esq^r


11th Augst 1843 sent to the Reg^r a plat of the NW 1/4 Sec. 1 & another to the Com^r on the 16th Augst 1843

Surveyor's Office
St. Louis

The lines of the above plat of Township 1 North of the Base line in Range 2 West of the 3rd principal Meridian (except those of Sec. 31, 32, 33 & 34) have been examined by the fieldnotes of the survey thereof referred to in the margin and corrected uniformly therewith

Record

Township N. 2 North of the Base line, Range N. 4 West of the 3rd principal Meridian

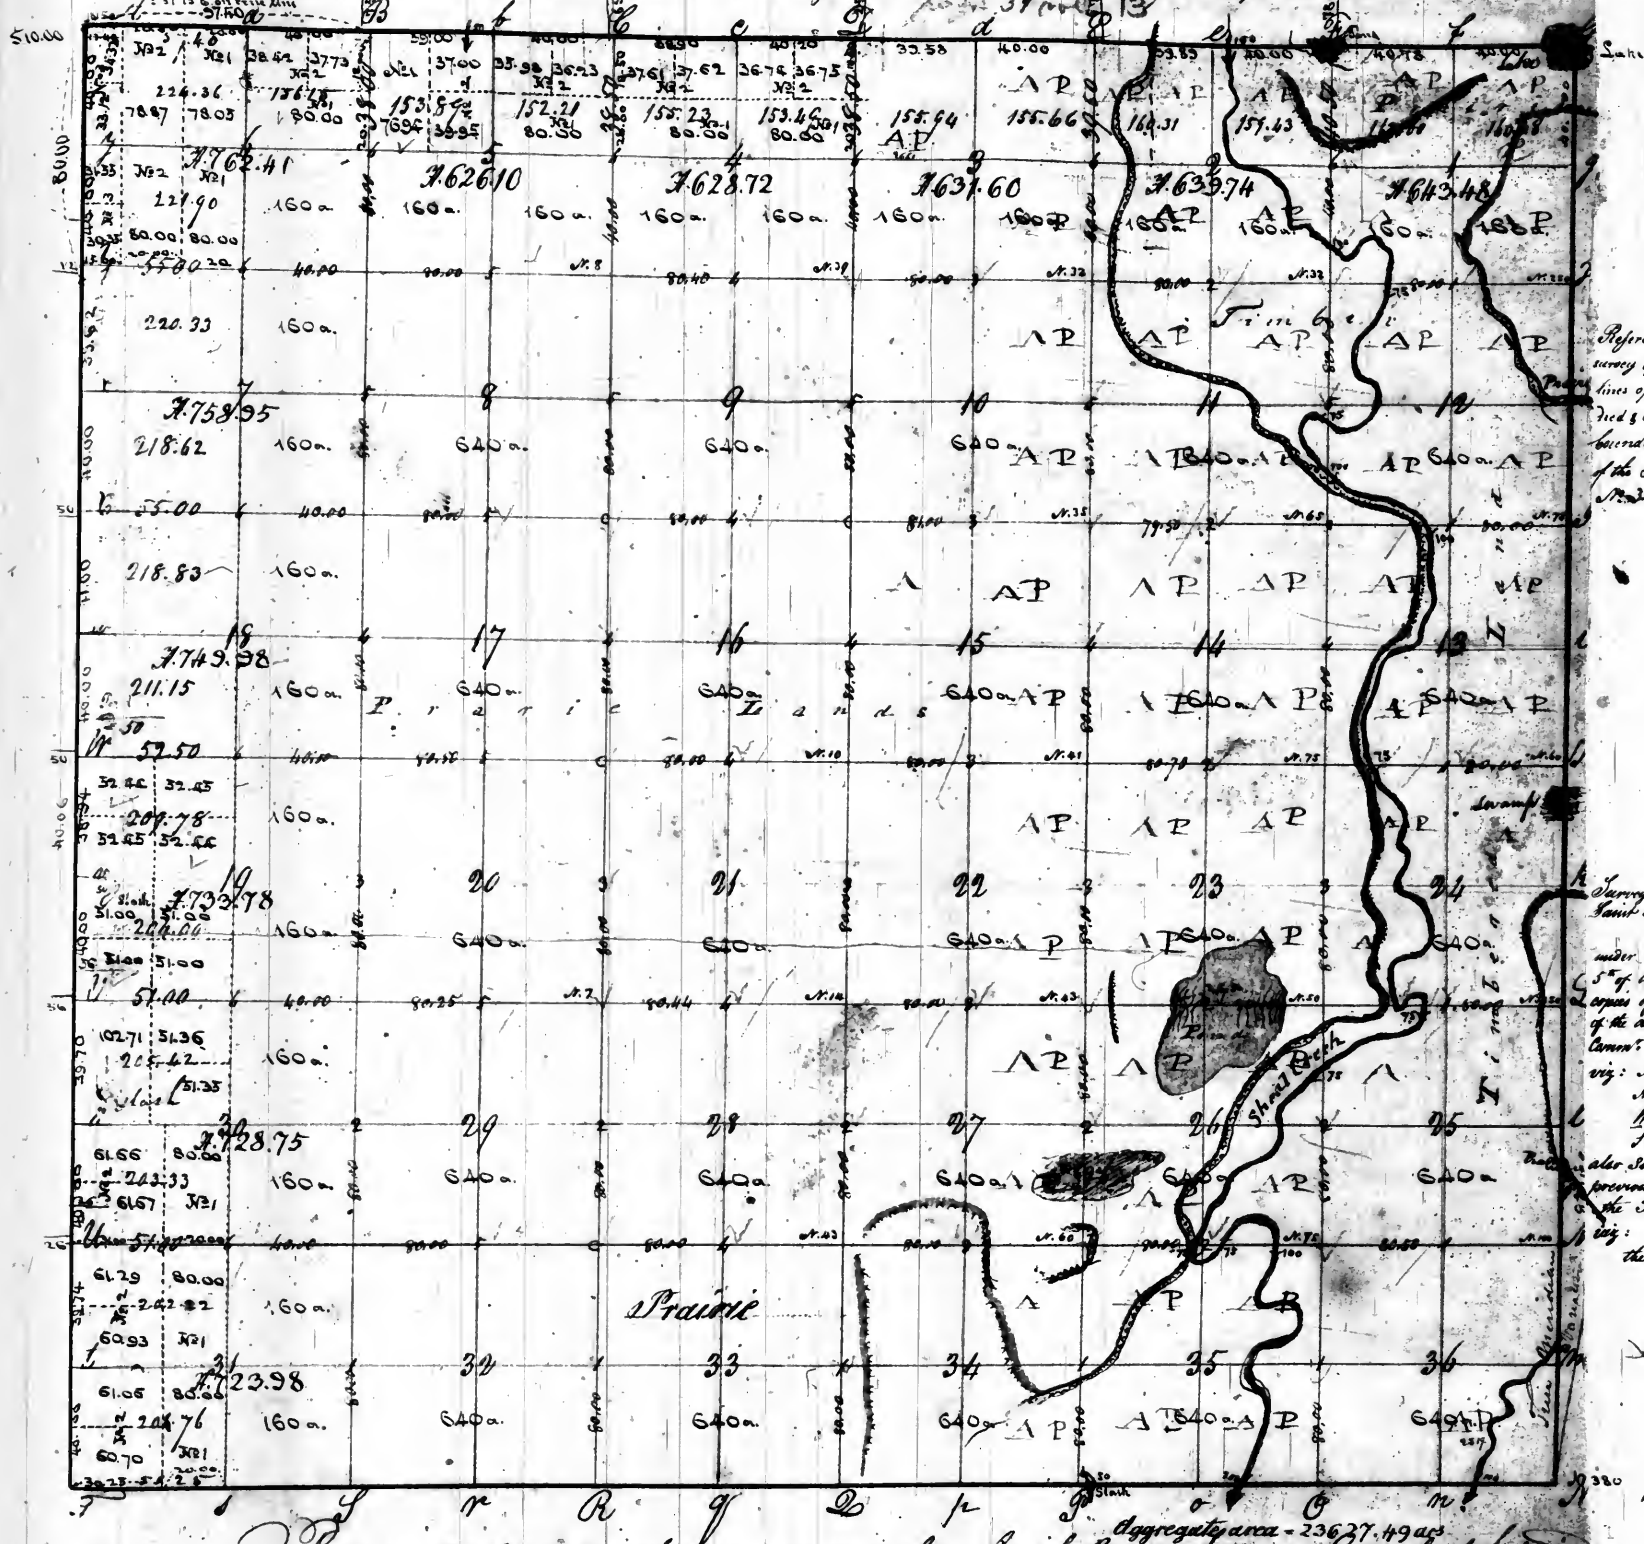

Reference to the field notes of the survey of this Township by which the lines of this plat have been examined & corrected, of the exterior boundaries in extent of 50.00 of the subdivisions in field book No. 24.

Surveyor's Office
Saint Louis, Mo. Feb. 3, 1844.
Subdivided under the Act of Congress of the 5th of April, 1832 (and sent today) copies of the plat one to the Reg. of the District and another to the Commr. of the Genl. Land Office viz: N. 1/2 of section 4
N. 1/2 of sec. 5 & 6
N. 1/2 of sec. 30
also subdivided to conform to previous sales, as reported by the Reg. on the 4th July 1843 viz: N. 1/2 of section 19 and the N. 1/2 of sec. 30.

Pursuant to a contract with, and instructions from Josiah Meigs, Surveyor General of the United States, bearing date the 26th day of July 1813. I have admeasured, laid out, and surveyed the above described Township, and do certify that it had such marks and bounds both natural and artificial as are represented on this plat, and described in the Field Notes made thereof and returned with this plat into the Surveyor General's Office. Certified the 16th day of July 1814.

Wm. Rector, D.S.


Surveyor's Office
St. Louis

7th July 1843. sent to the Reg. a plat of the N. 1/2 of Sec. 5. subdivided so as to contain environ to a previous sale of the N. 1/2 containing 75.94 acres, and sent to the Comr. of the Genl. Land Office 10th July 1843.

The lines of the above plat of Township 2 North of the Base line in Range 4 West of the 3rd principal Meridian have been examined by the notes of the full survey thereof referred to in the margin and corrected conformably therewith.

Record

Township N 3 North of the Base line Range N 4 West of the 3^d Meridian

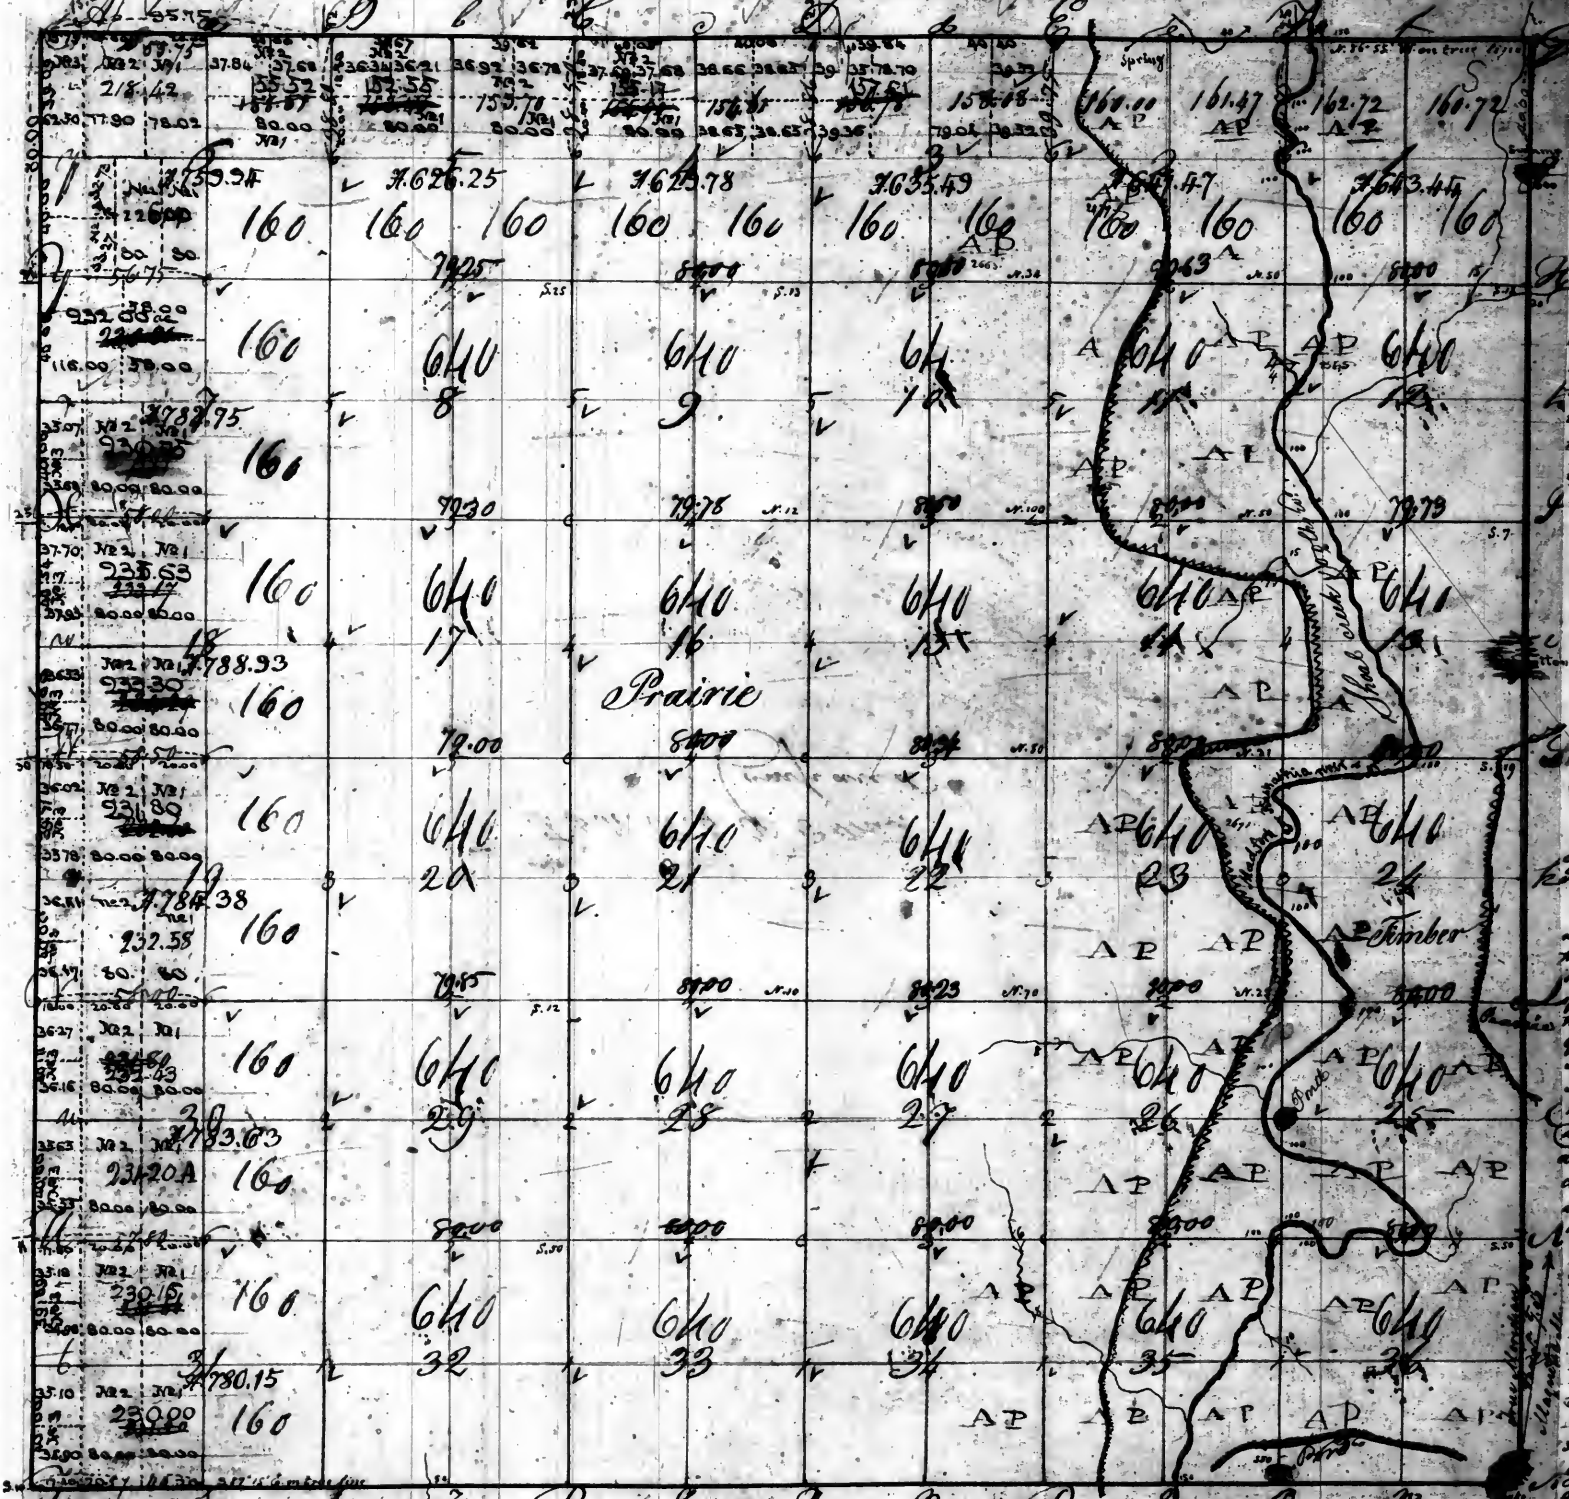

Reference to the fieldnotes of the survey of this township by which the lines of this plat have been examined & corrected, of the anterior General view in art. book N 50, of the subdivision in field book at 33 A & B.

Surveyor's Office
St Louis
Subdivided under the Act of Congress of the 5th of April 1832 (and parts) of the district, and under the terms of the General Land Office, viz:
11th gr. sec. 4, - 1/2nd of sec. 5 & 6, - 11th gr. sec. 7, - 1/2nd of sec. 18, 34 & 35, and the 11th gr. of sec. 19, also subdivided as to conform to previous values as reported by the Register on the 12th July 1843, viz: 1/2nd of sec. 3 (and the 11th quarter of section 7).

Office of the Surveyor General
for Missouri & Arkansas
St Louis August 7th 1850
Subdivided the 11th gr. sec. 19, as sent copy to the Register, & another copy to the Comptroller of the Genl Land Office on the 25th Dec. 1850

Pursuant to a certificate with and instructions from Joseph Meigs Esq Surveyor General of the United States bearing date the 6th day of June A.D. 1845 I have examined said plat and surveyed the above described Town, &c. and hereby certify that it has such marks and bounds both natural and artificial as are represented on said plat and described in the field notes made thereof and returned to the plat into the Surveyor General's office

Certified this 20th day of April A.D. 1845

Joseph Meigs Esq

Surveyor's Office
St Louis

25th Aug 1850 subdivided a plat of 514th & 516th Sec 6 and section 18 with 29th of Aug 1843.

The lines of the above plat of Township 3 North of the Base line in Range 4 West of the 3^d principal Meridian have been examined by the fieldnotes of the survey thereof referred to in the margin and corrected conformably therewith

Record



Pursuant to a contract with and instructions from Josiah Meigs Esquire Surveyor General of the United States bearing date the 26th day of July 1843. I have admeasured laid out and surveyed the above described Township and do certify that it had such marks and bounds both natural and artificial as are represented on this plat, and described in the Field Notes made thereof and returned with this plat into the Surveyor General's Office

Certified this 15th day of June 1844

J. Meigs

Surveyors Office
St. Louis

The lines of the above plat of Township N. 4 North of the Base line in Range 4 West of the 3rd principal Meridian have been examined by the fieldnotes of the survey thereof referred to in the margin and corrected conformably therewith

Record



Reference to the fieldnotes of the survey of this Township by which the lines of this plat have been examined & corrected, of the North boundary in section 27, 49, - of the West boundary in section 26, - of the North and East boundaries of section 31 in section 31 A & B.

Note. The field notes of the survey of the line between Sec. 10 & 15 do not state that a temporary quarter Sec. corner was set in run. Using the random line between said Sections.

Surveyors Office
 Saint Louis 1st July 1849.
 Subdivided
 under the Act of Congress
 of the 5th of April 1832, and made
 copies of the plat, today, one
 to the Register of the district
 and another to the Commr. of
 the Gen. Land Office, viz:
 NW & NE gr. of sec. 18,
 and NW gr. of sec. 30 & 31
 also subdivided so as to con-
 form to previous sales as re-
 ported by the Register on
 the 4th July 1843: viz:
 NW gr. sec. 1, - NE gr. sec.
 5, - NW & NE gr. sec. 6
 and NW gr. sec. 7.

Suro. Office
St. Louis, 20th July 1843.
Plat of the S. W. 1/4 of Sec.
20 & 21, sent this day to
the Register at Newarkville
& to the Commissioner of the
Genl. Land Office.


Pursuant to a contract with and instructions from Josiah Meigs Esquire Surveyor General of the United States bearing date the 28th day of July 1813. I have admeasured laid out and surveyed the above Township, and do certify that it had such marks and bounds, both natural and Artificial, as are represented on this plat and described in the Field Note, made thereof and Returned with this plat into the Surveyor General's Office Certified the 16th day of June 1844

Surveyors Office
St. Louis

The lines of the above plat of Townships 5 North of the Base line in Range 4 West of the 3^d principal Meridian have been examined by the fieldnotes of the survey thereof referred to in the margin and corrected conformably therewith.

Township N. 6 N. of the Base line, Range N. 4 West of the 3^d Principal Meridian.


Recorded

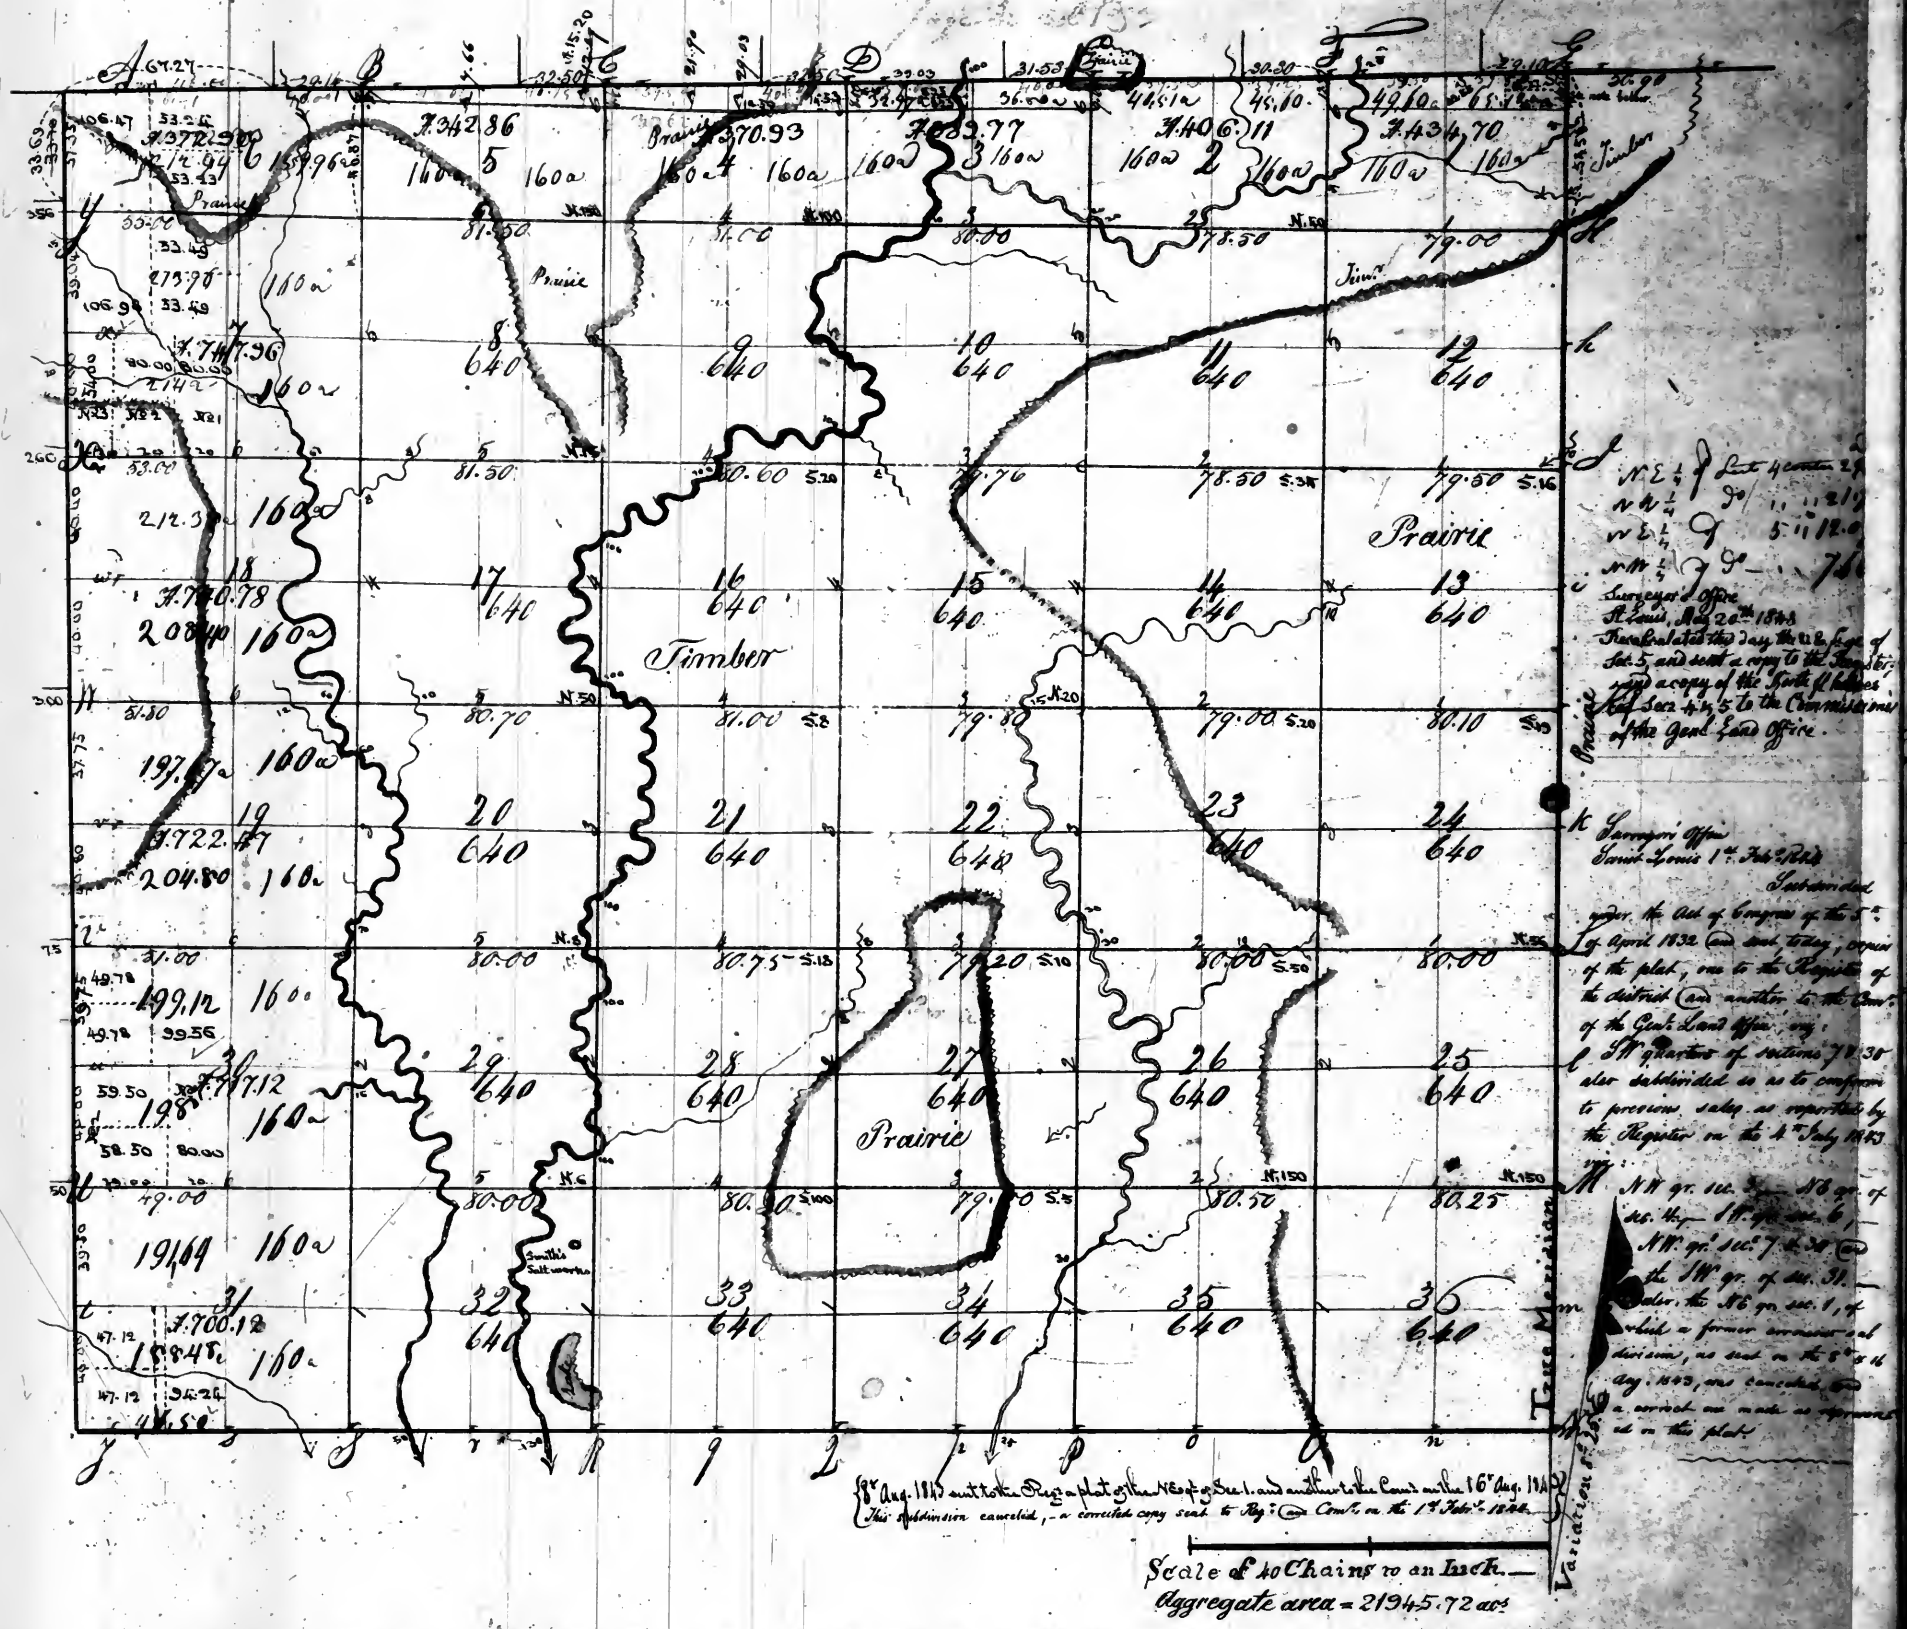

Pursuant to a Contract with, and instructions from William Rector, Surveyor of the lands of the United States in the Territories of Illinois and Missouri bearing date the 15th day of May 1818, I have admeasured, laid out and surveyed the above described township and do hereby certify, that it had such marks and bounds both natural and artificial, as are represented on said plat, and described in the field notes made thereof and returned with this plat into the office of the Surveyor of the lands of the United States, for the Territories of Illinois and Missouri. - Certified this 14th day of July 1818. -

Milton Moore D. S.


Page 36 of 13

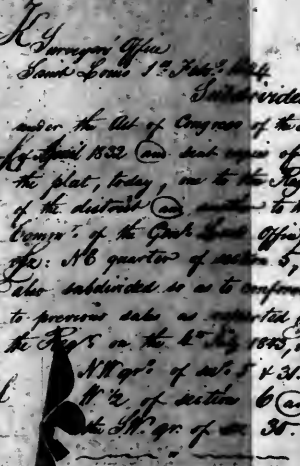


Pursuant to a Contract with and Instructions from William Rector Surveyor of the lands of the U. S. in the Territories of Illinois and Missouri, bearing date the 15th day of May 1818. I have admeasured laid out and surveyed the above described Township, and do hereby Certify, that it had such marks and bounds both natural and artificial, as are represented on said plat, and described in the field notes made thereof, and returned ^{with} this plat into the Office of the Surveyor of the lands of the U. S. for the Territories of Illinois and Missouri. Certified this 7th day of Aug. 1818.

Milton

Township N. 8 N. of the Base line. Range N. 4 W. of the 3. Principal Meridian. 851.

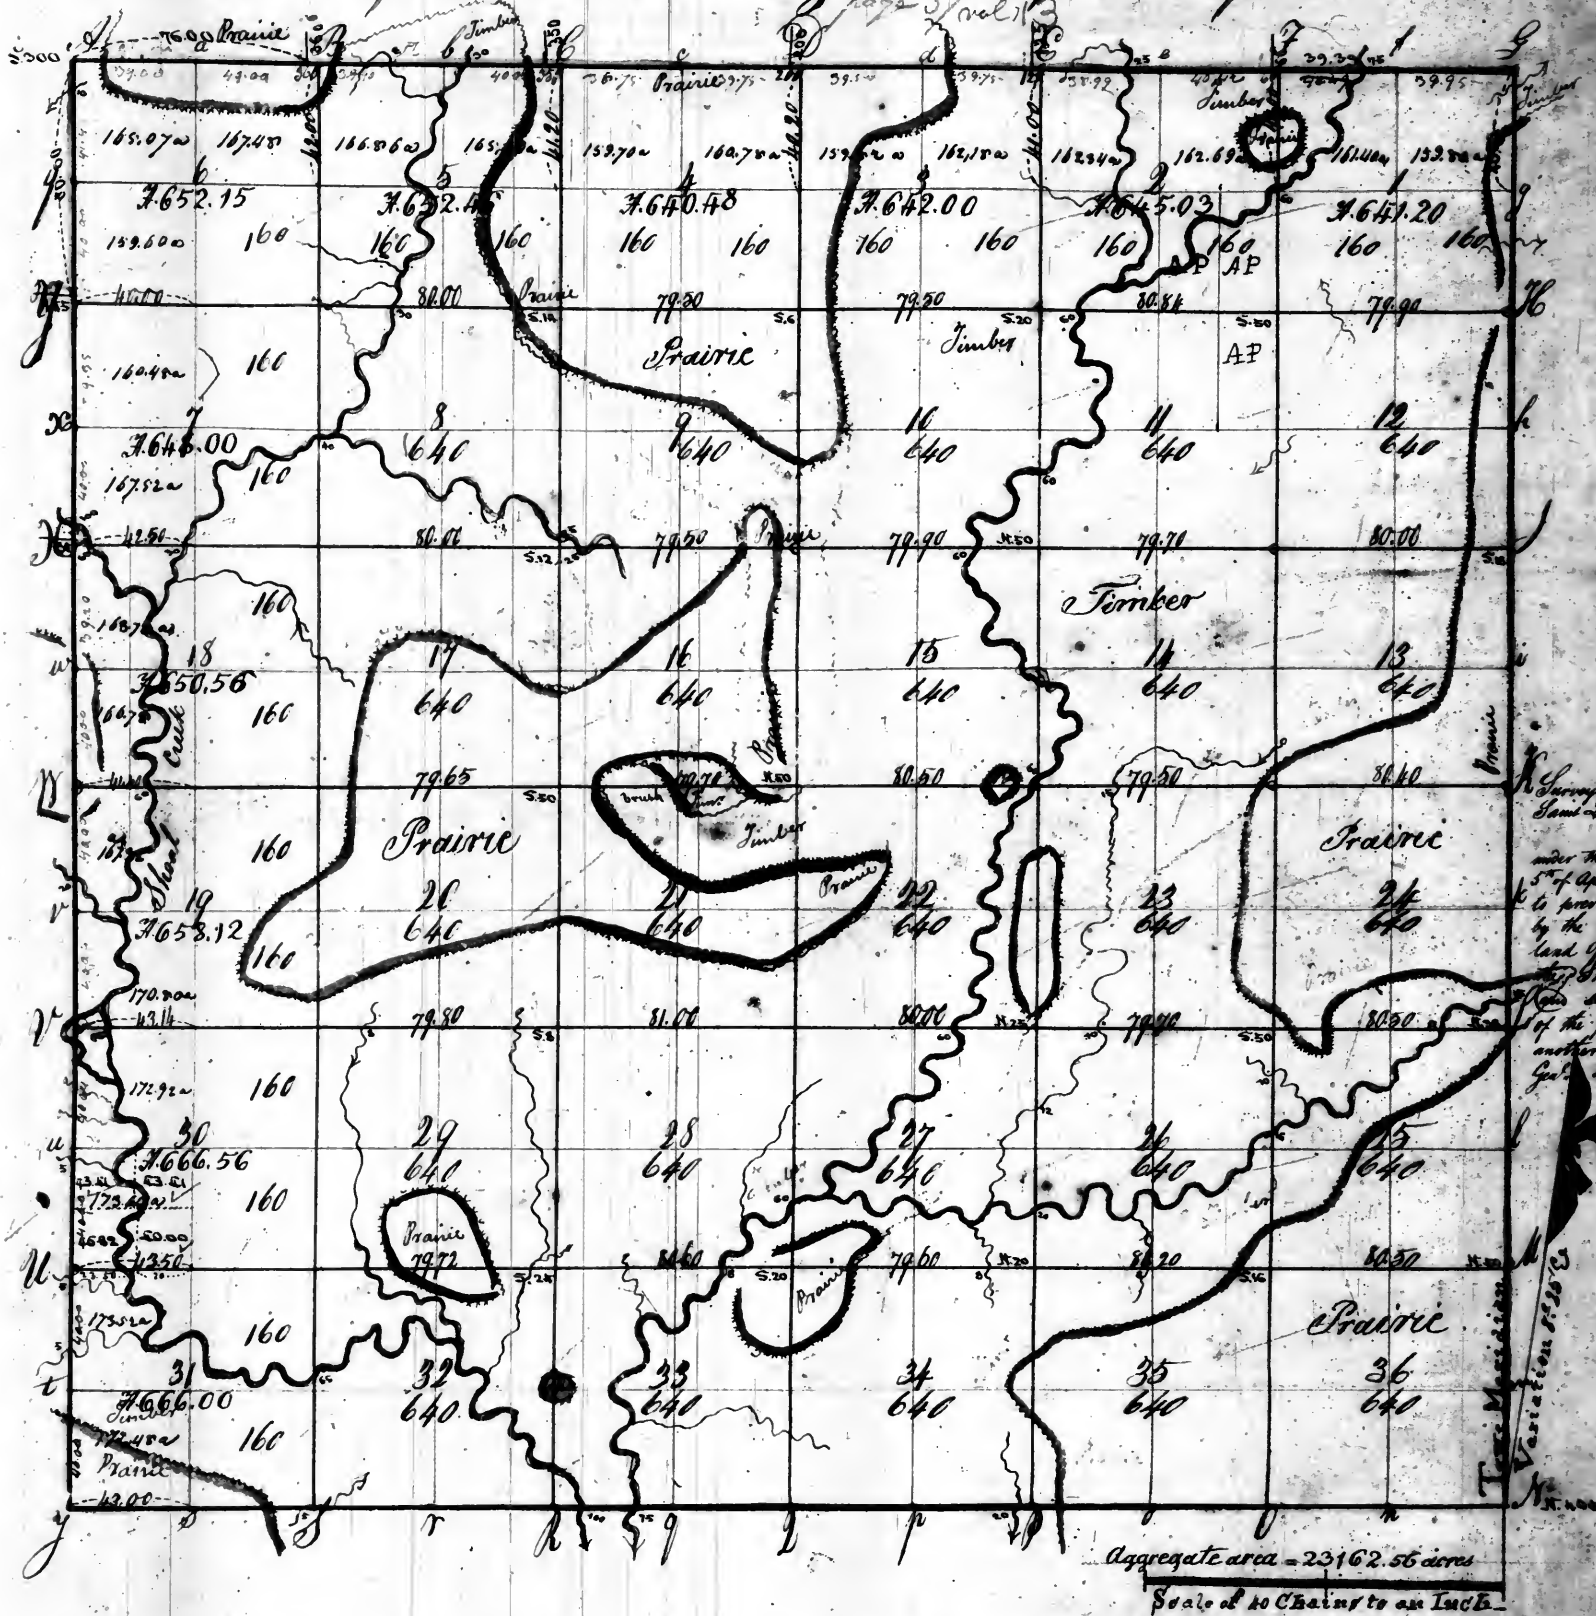


want to a contract with and Instructions from William Rector, Surveyor of the lands of the U. States in the Territories of Illinois & Missouri bearing date the 15th day of May 1818. I have admeasured, laid out and surveyed the above described Township, & do hereby Certify that it had such marks & bounds both natural & artificial, as are represented on said plat, and ascribed in the field notes made thereof and returned with this plat into the Office of the Surveyor of the Lands of the U. S. for the Territories of Illinois and Missouri. -  - Done this 7th day of Aug^r 1818. -

Sutton Moore D.

Township N. 9 N. of the Base line, Range N. 4 W. of the 3^d principal Meridian—

page 38

Record

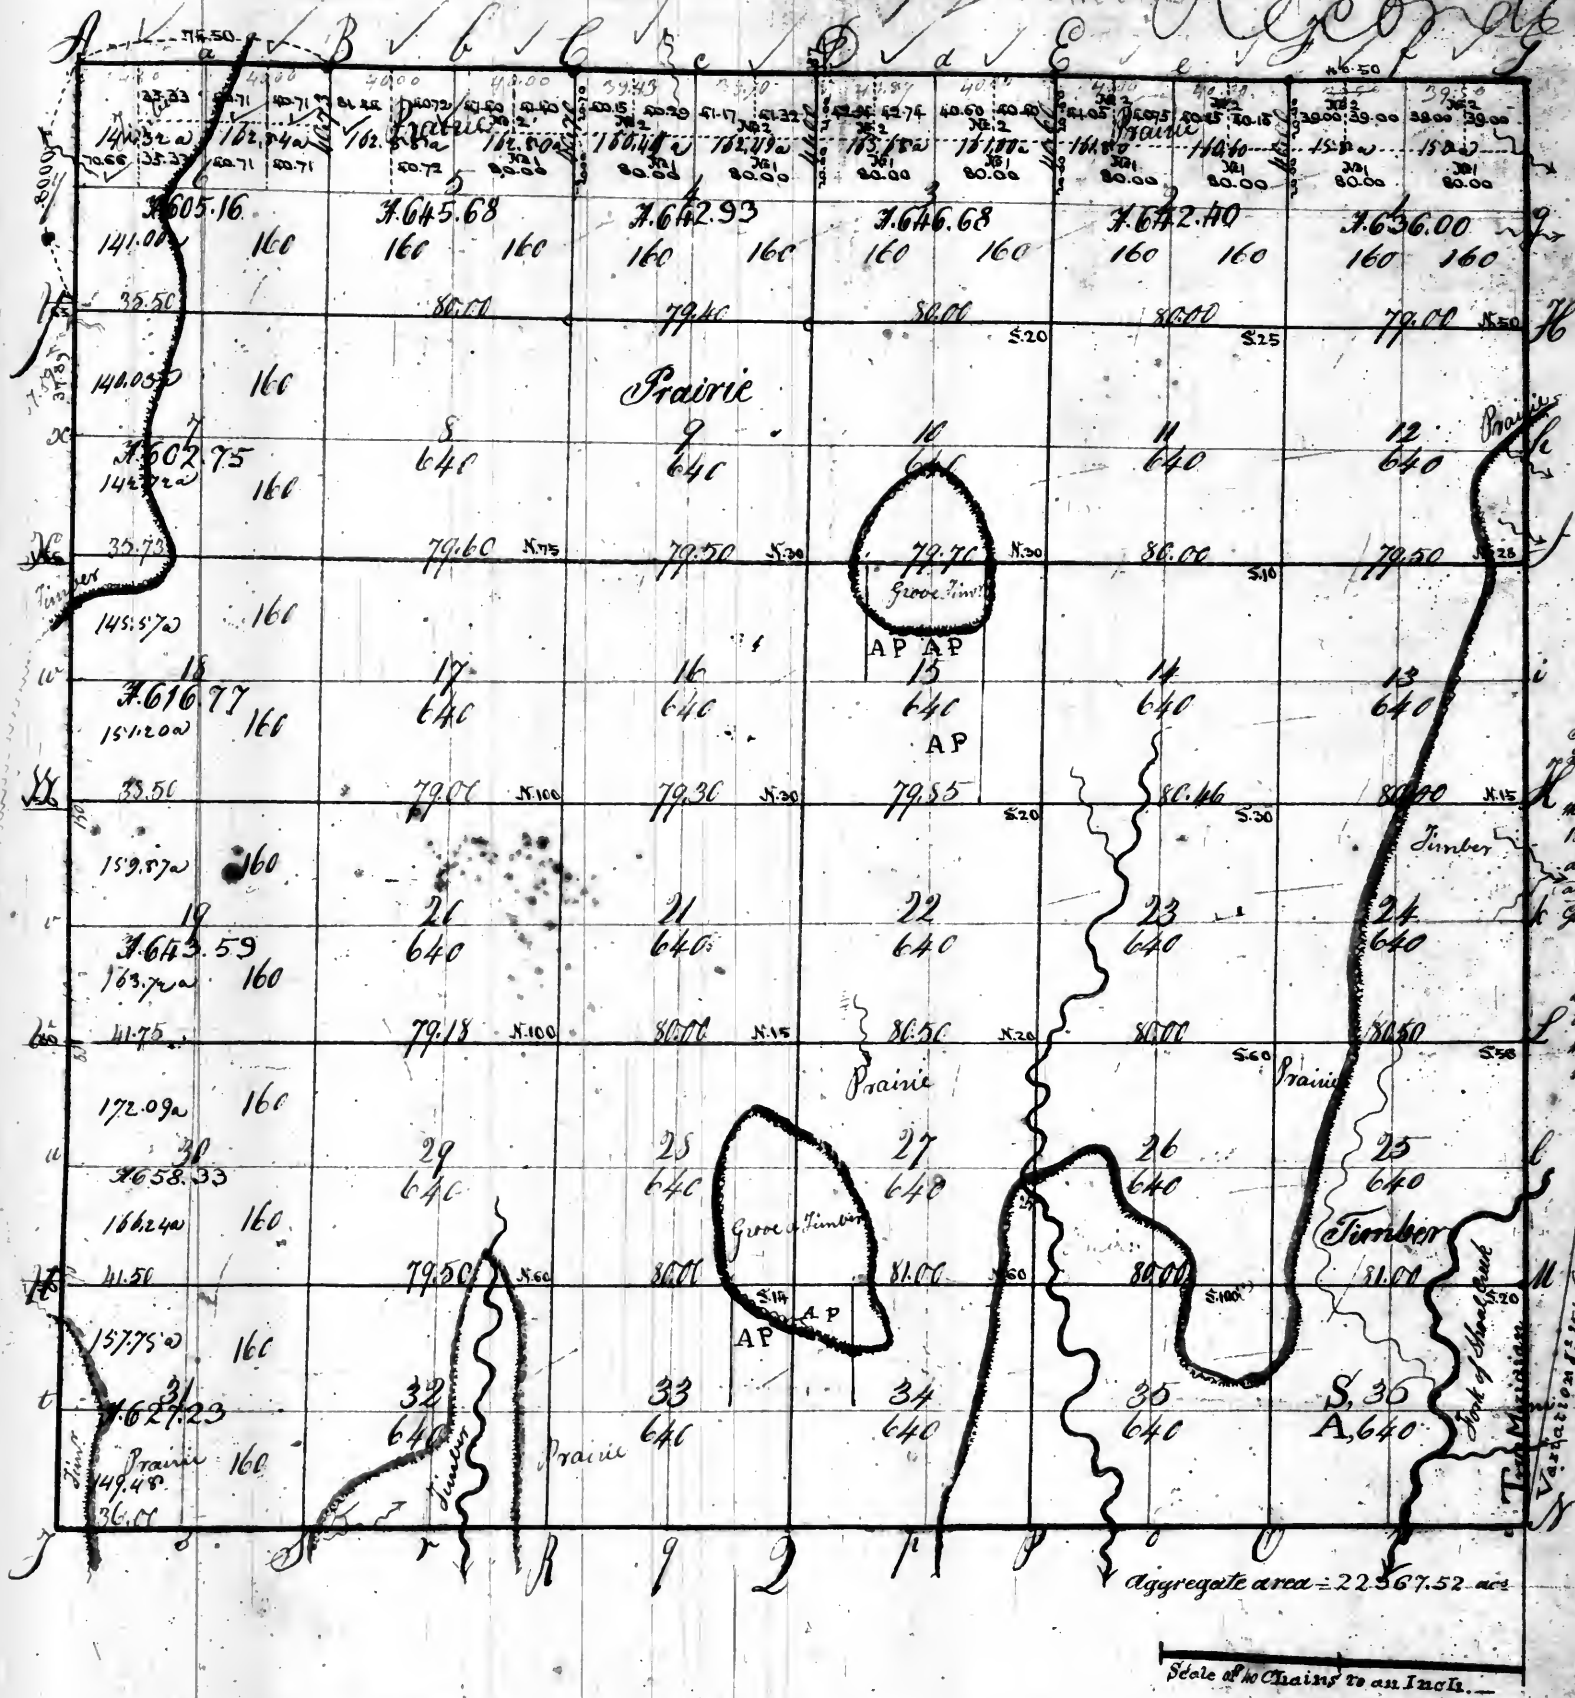

Surveyors Office
Saint Louis 1st Feb. 4 1844.
Subdivided under
the Act of Congress of the 5th April
1832 and sent copies of the plat to
day, one to the Reg^r of the district
and another to the Comm^r of the
Genl. Land Office, viz:
N. 1/2 of Secs. 1, 2, 3 & 4
NE quarter of sec. 5,
also subdivided so as to conform
to previous sales as reported by
the S. Reg^r on the 4th Aug. 1843
viz: the NW q. sec 5 and the
N. 1/2 of section 6.

Pursuant to a contract with, and Instructions from William Rector, Surveyor of the lands of the U. States in the Territories of Illinois and Missouri, bearing date the 15th day of May 1818, I have admeasured laid out & Surveyed the above described Township and do hereby Certify that it had such marks & brands both natural and artificial as are represented on said plat, and described in the field notes made thereof and returned with this plat into the Office of the Surveyor of the lands of the U. S. for the Territories of Illinois and Missouri.— Certified this 7th day of Aug. 1818.—


Milton Moore

Reconded

833

Township N. 10 North of the base line Range N. 4 West of the 3. Principal meridian

page 39 of 113

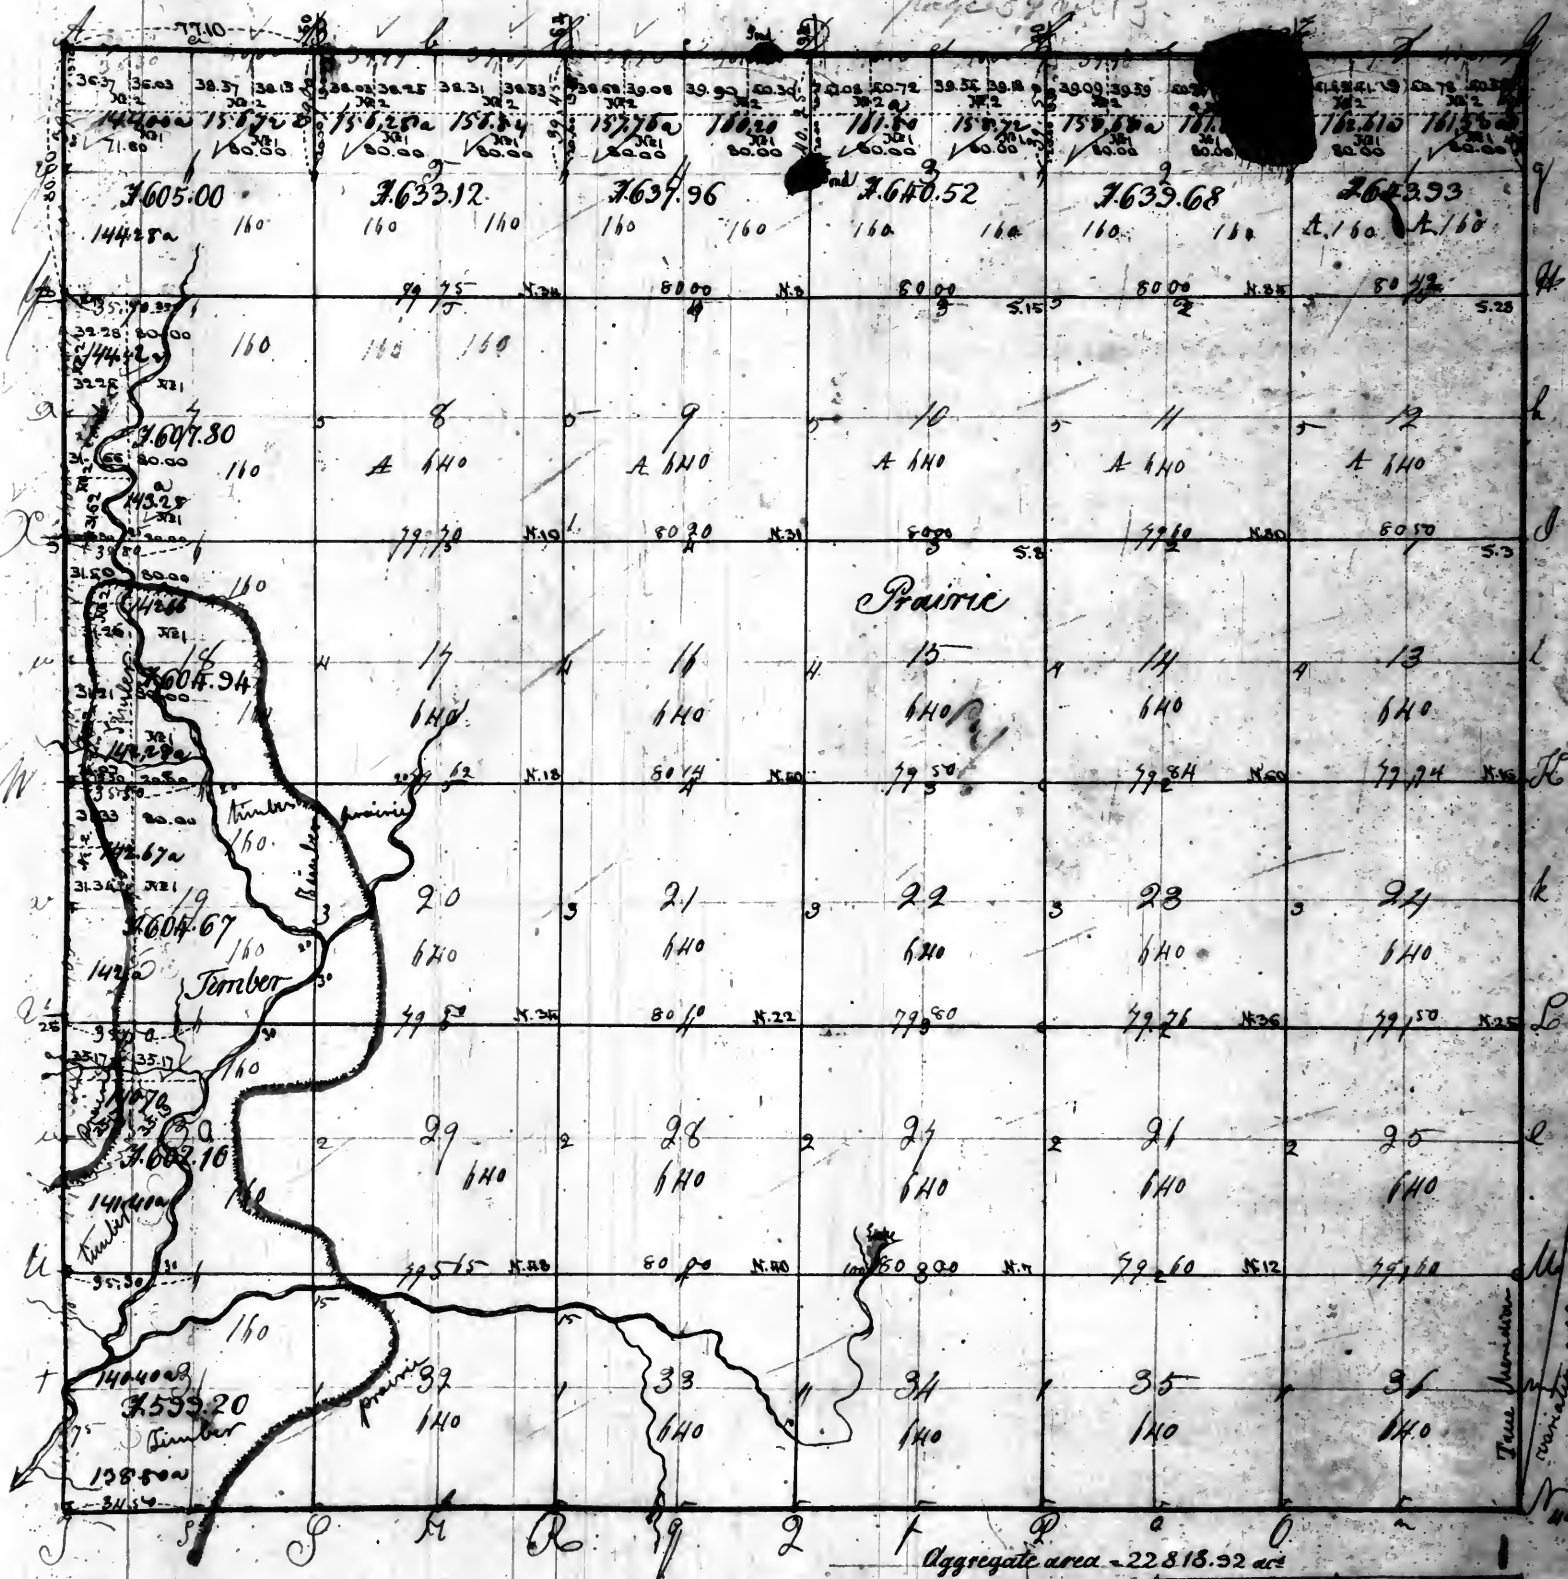

Surveyor's Office
Saint Louis 1st Feb. 1844.
Subdivided under the Act of Congress
of the 5th April 1833 and sold, copies of the plat are
to the Reg^r of the district and another to the Comm^r of the
Gen^l Land Office, viz
the N^W 1/4 of sections 1, 2, 3, 4, 5, & 6
the N^W 1/4 of section 7 and 18 and
the N^W quarter of section 19, - also subdivided
and so as to conform to previous sales as reported by the Reg^r
on the 2nd July 1843, viz
the N^W quarter of section 30.

Surveyed by John Milton Moore DS
June 1843


Scale of 40 chains to an inch

Record

52

(7)

Township 1st N. 10th of the Base line of Range 4th West of 3rd Principal Meridian 834.

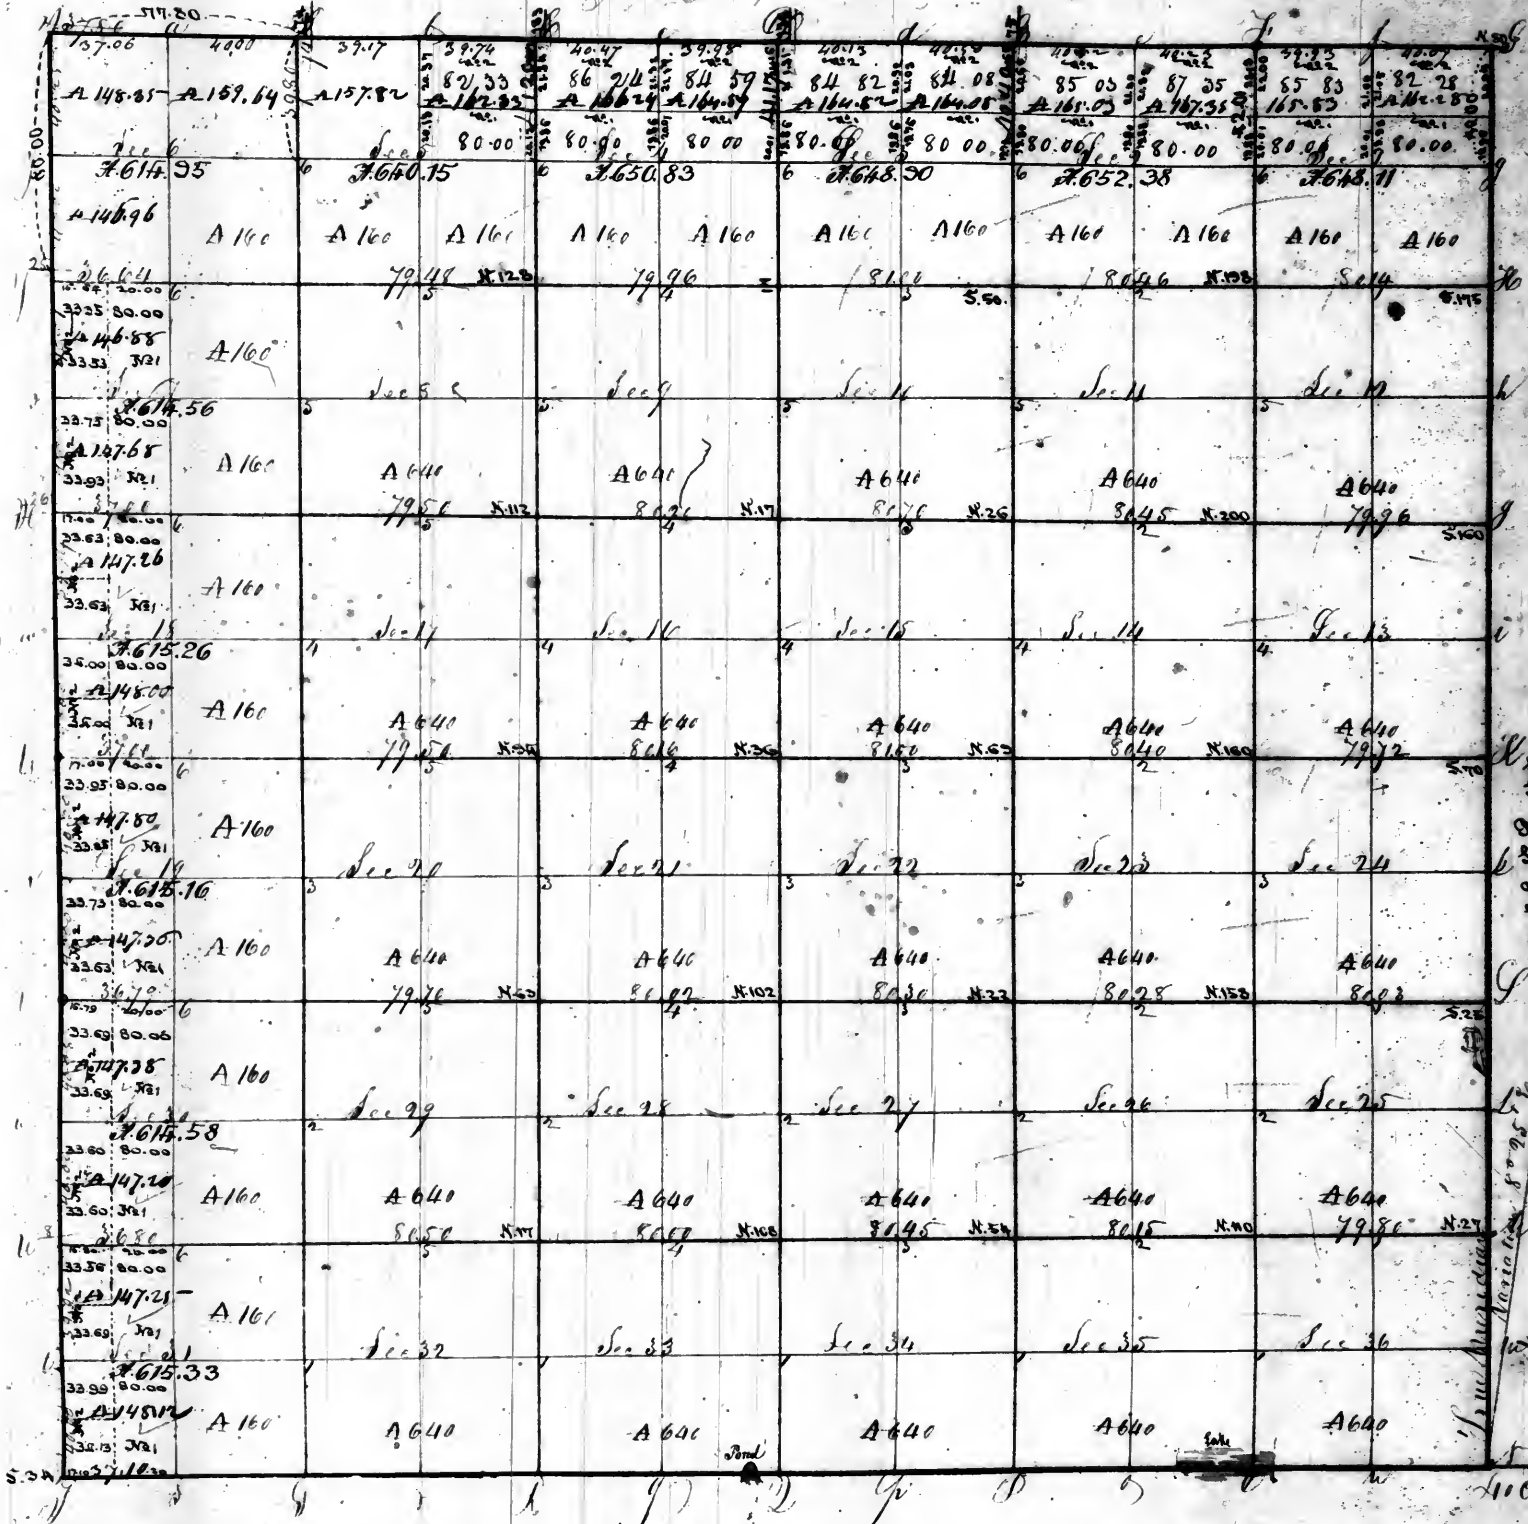

Surveyor's Office
St. Louis 10th May 1842.
Plat of the North halves of
Secs 1, 2, 3, 4, 5 and of the N.E.
quarter of Sec 6, and this day
to the Comptroller of the Genl.
Land Office

Pursuant to a contract with and instructions from William Rector Surveyor of the Lands of the United States in the Territories of Illinois & Missouri bearing date the _____ day of _____ I have measured laid out and set the above described Township and do hereby certify that it had such marks and bounds both natural and artificial as are represented on said plat and described in the field notes made thereof and returned with this plat into the Office of the Surveyor of the Lands of the United States for the Territory of Illinois

Surveyor's Office
Saint Louis 1st Feb 1844.


Wm Gordon DS

Subdivided under the Act of Congress of the
5th April 1832 and sent, today, copies of the plat one to the Reg^y
of the district and another to the Comm^r of the Genl. Land Office
viz: the West halves of sections 7, 18, 19, 30 and 31.

Dec 1842

Township 12 North of the Base line of Range 12 West of 5th Meridian

835

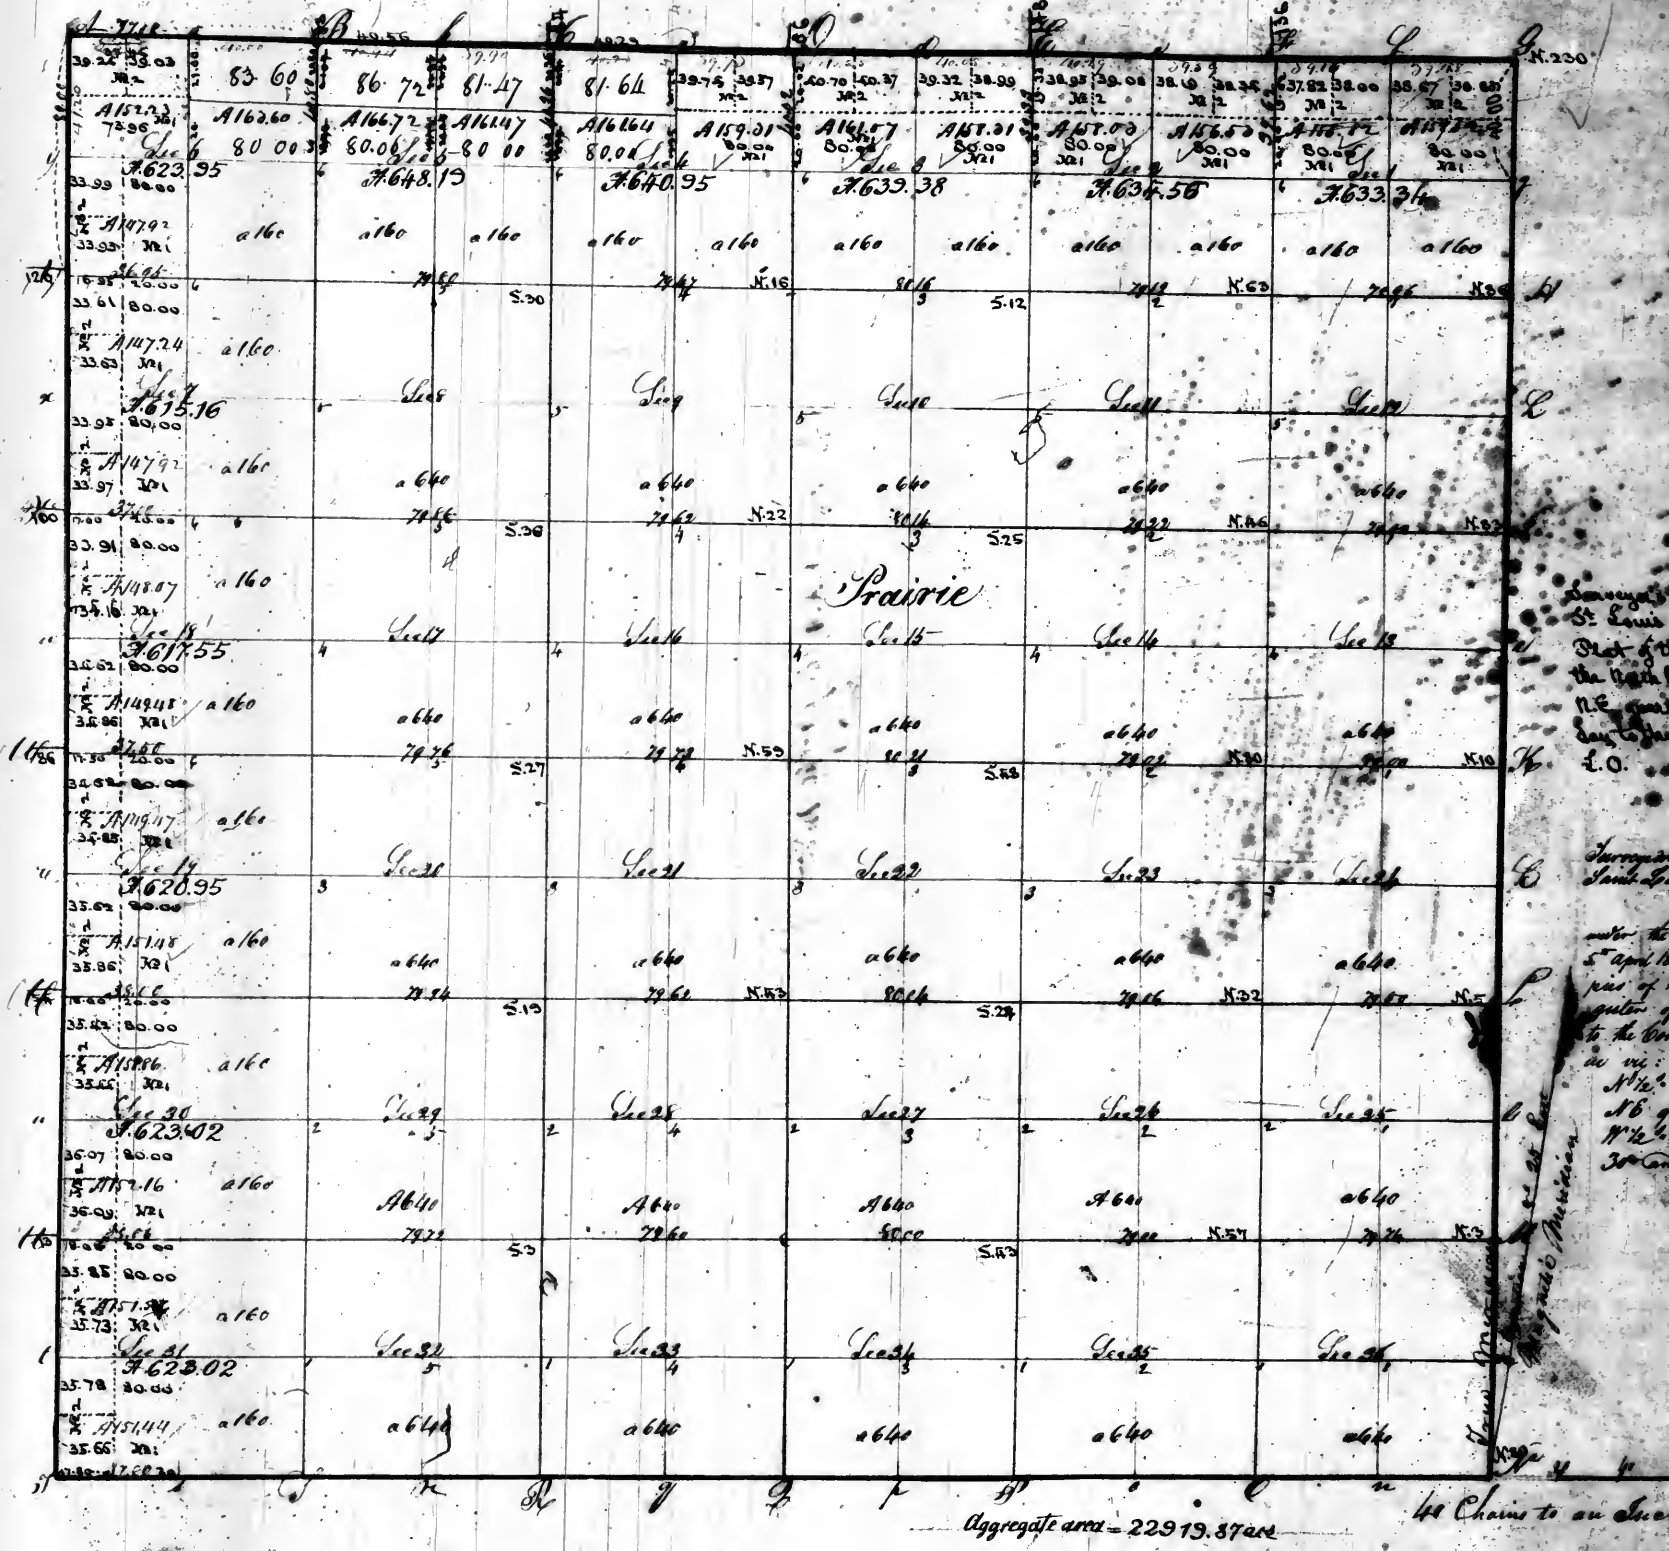

Surveyor's Office
St. Louis Mo July 1842
Plat of the N.W. 1/4 of Sec. 5 of
the North half of Sec. 5 and of the
N.E. quarter of Sec. 6, sent this
day to the Commissioner of the Genl.
L.O.

Surveyor's Office
St. Louis Mo 14 Feb 9, 1844
Subdivided
under the Act of Congress of the
5 April 1820 (and sent today, a
copy of the plat, one to the Re-
gulator of the District (and another
to the Commissioner of the Genl. Land Off
as per
N.W. 1/4 of Sec. 1, 2 and 3, 1/4
N.E. 1/4 of Sec. 4 and the
N.W. 1/4 of Sec. 6, 7, 18, 19
30 and 31.

Pursuant to a contract with, and instruction from William Hester, Surveyor of the Lands of the United States in the Territories of
and Missouri bearing date the day of I have advantage laid out and surveyed the above described township, and as being
off, that it had such marks and bounds, both natural and artificial, as are represented on said plat, and ascertained in the field notes made
returned with this plat into the Office of the Surveyor of the Lands of the United States, for the Territories of Illinois and Missouri


Wm Gordon DS
Decr 1848

$$\begin{array}{r} 8112 \\ 55 \\ \hline 8057 \\ 2072 \\ \hline 4045 \end{array}$$

Scale of 40 Chains to an Inch

Subdivided under the Act of Congress of the
5th of April 1820. Had sent, to-day, copies of the plat, one to
the Register of the district - and another to the General of the
General Land Office, viz.
The West halves of sec^s. 18, 19, 30 and 31,
also subdivided so as to conform to previous sales as reported
by the Register on the 2^d July 1820 viz.
the N.E. quarter of section 5 and
the West half . . . 7.

Township No. 14 North of the base line, Range No. 4 West of the 3rd principal Meridian.

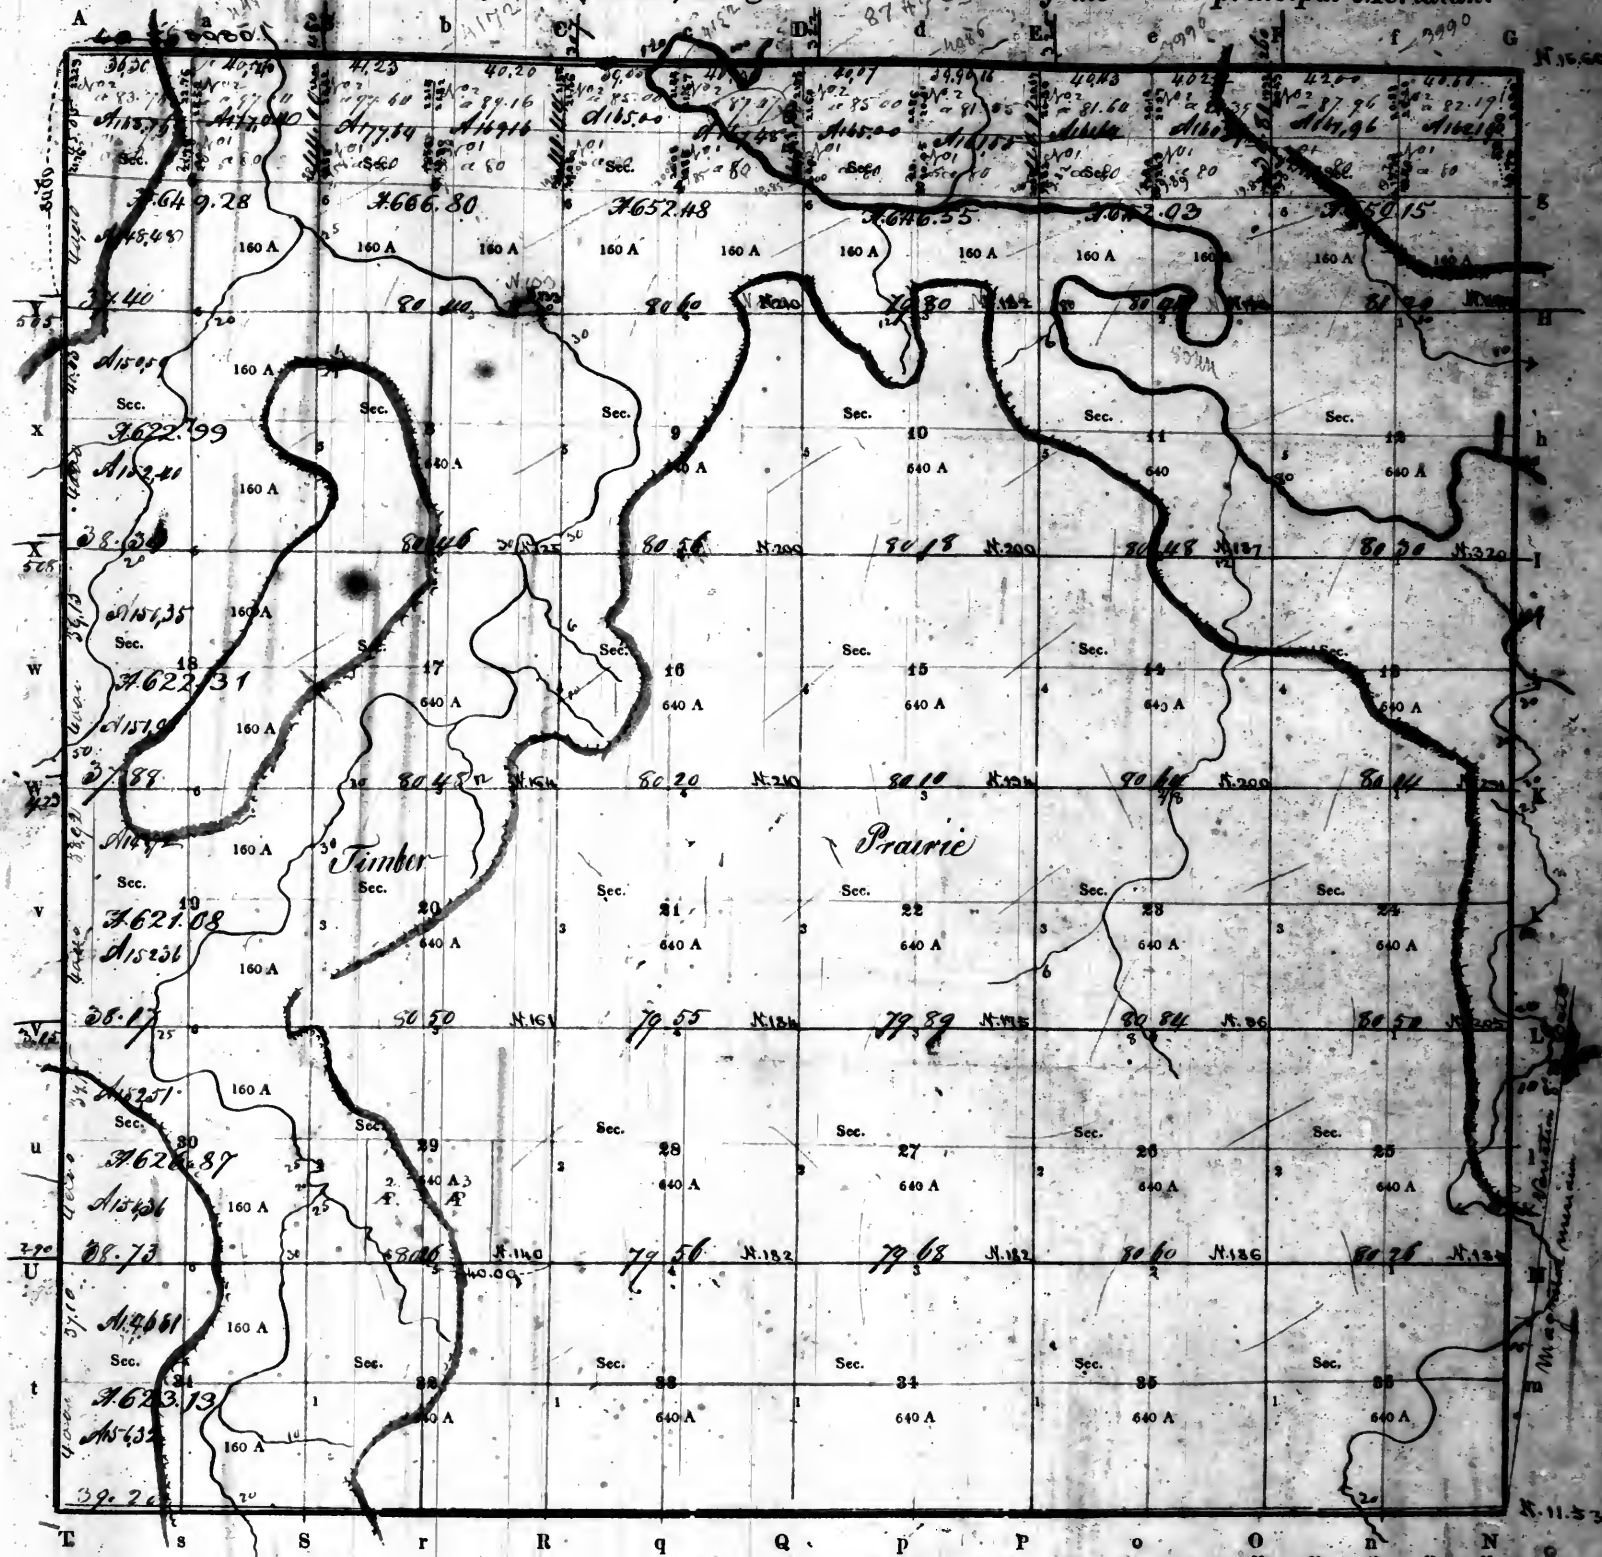

Aggregate area = 23023.67 acres

Scale of 40 Chains to an Inch

PURSUANT to a contract with, and instructions from WILLIAM RECTOR, Surveyor of the lands of the United States in the *States of Illinois and Territory of Arkansas*

bearing date the *nineteenth* day of *February* 1871


I have admeasured, laid out and surveyed the above described Township; and do hereby certify, that it had such marks and bounds, both natural and artificial, as are represented on said plat, and described in the field notes made thereof, and returned with this plat into the Office of the Surveyor of the lands of the United States, for the *States of Illinois and Territory of Arkansas*

Certified this *10th* day of *July* 1871

EXAMINED.

William Rector SURVEYOR

Township No. 15 North of the base line, Range No. 4 West of the 3^d principal Meridian.

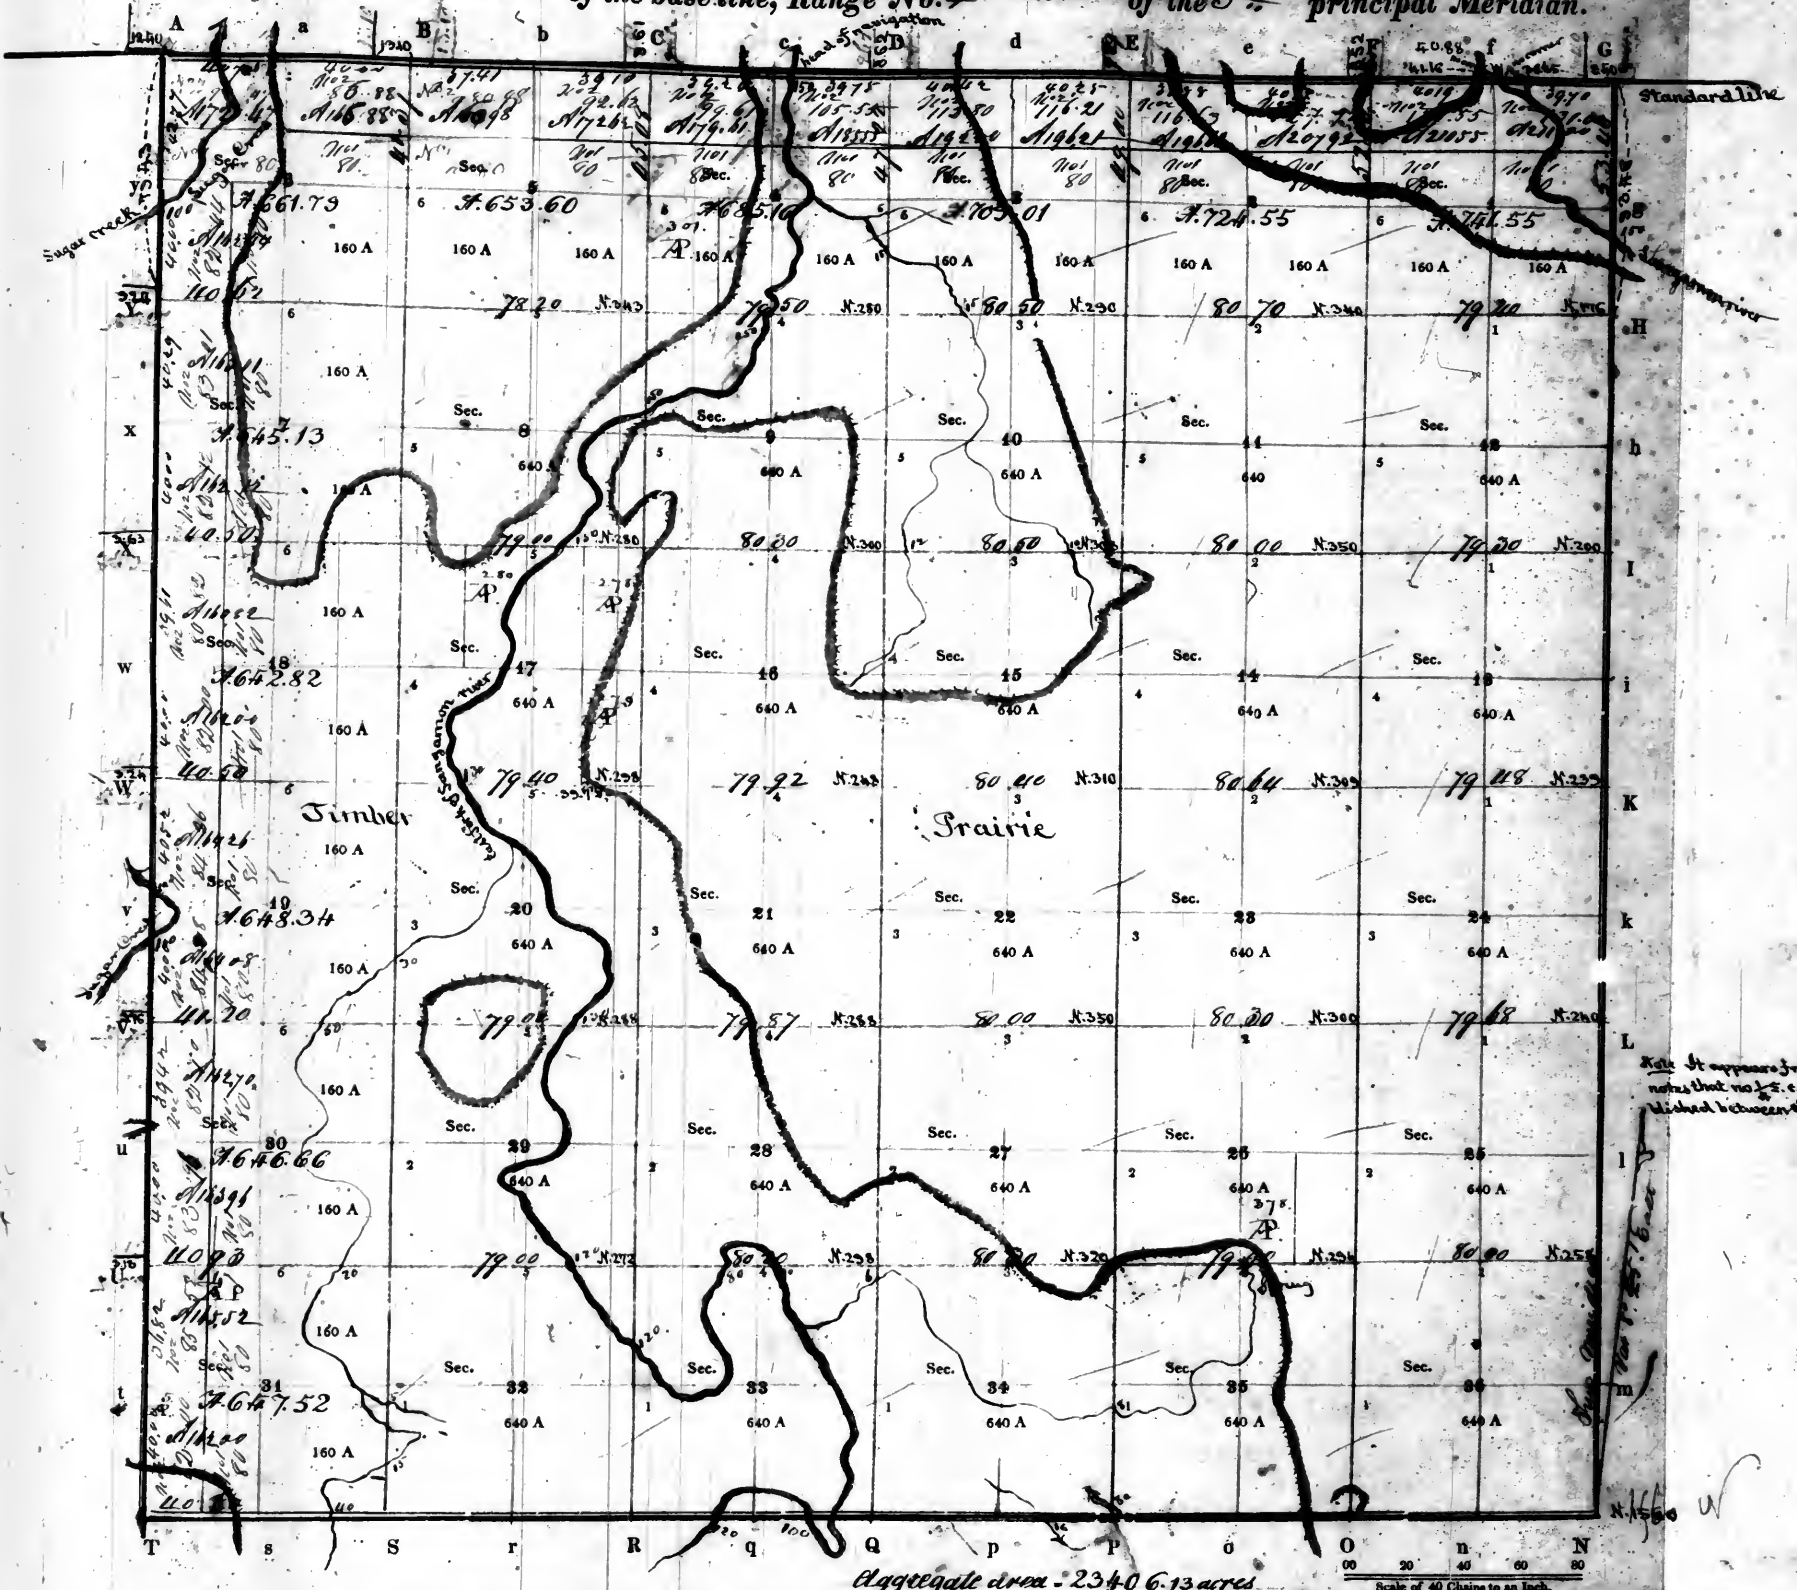

Note: It appears from the field notes that no. 1 & 2 were not marked between Sec. 24 & 25.

PURSUANT to a contract with, and instructions from WILLIAM RECTOR, Surveyor of the lands of the United States in the State of Illinois and Territory of Arkansas, bearing date the nineteenth day of February 1821

I have admeasured, laid out and surveyed the above described Township; and do hereby certify, that it had such marks and bounds, both natural and artificial, as are represented on said plat, and described in the field notes made thereof, and returned with this plat into the Office of the Surveyor of the lands of the United States, for the State of Illinois and Territory of Arkansas.


Certified this Twelfth day of July 1821

EXAMINED.

Wm. Rector D. SURVEYOR

Recorded 839

Township 10 N. North of the base line Range 10 E. East of the 5th Principal Meridian.

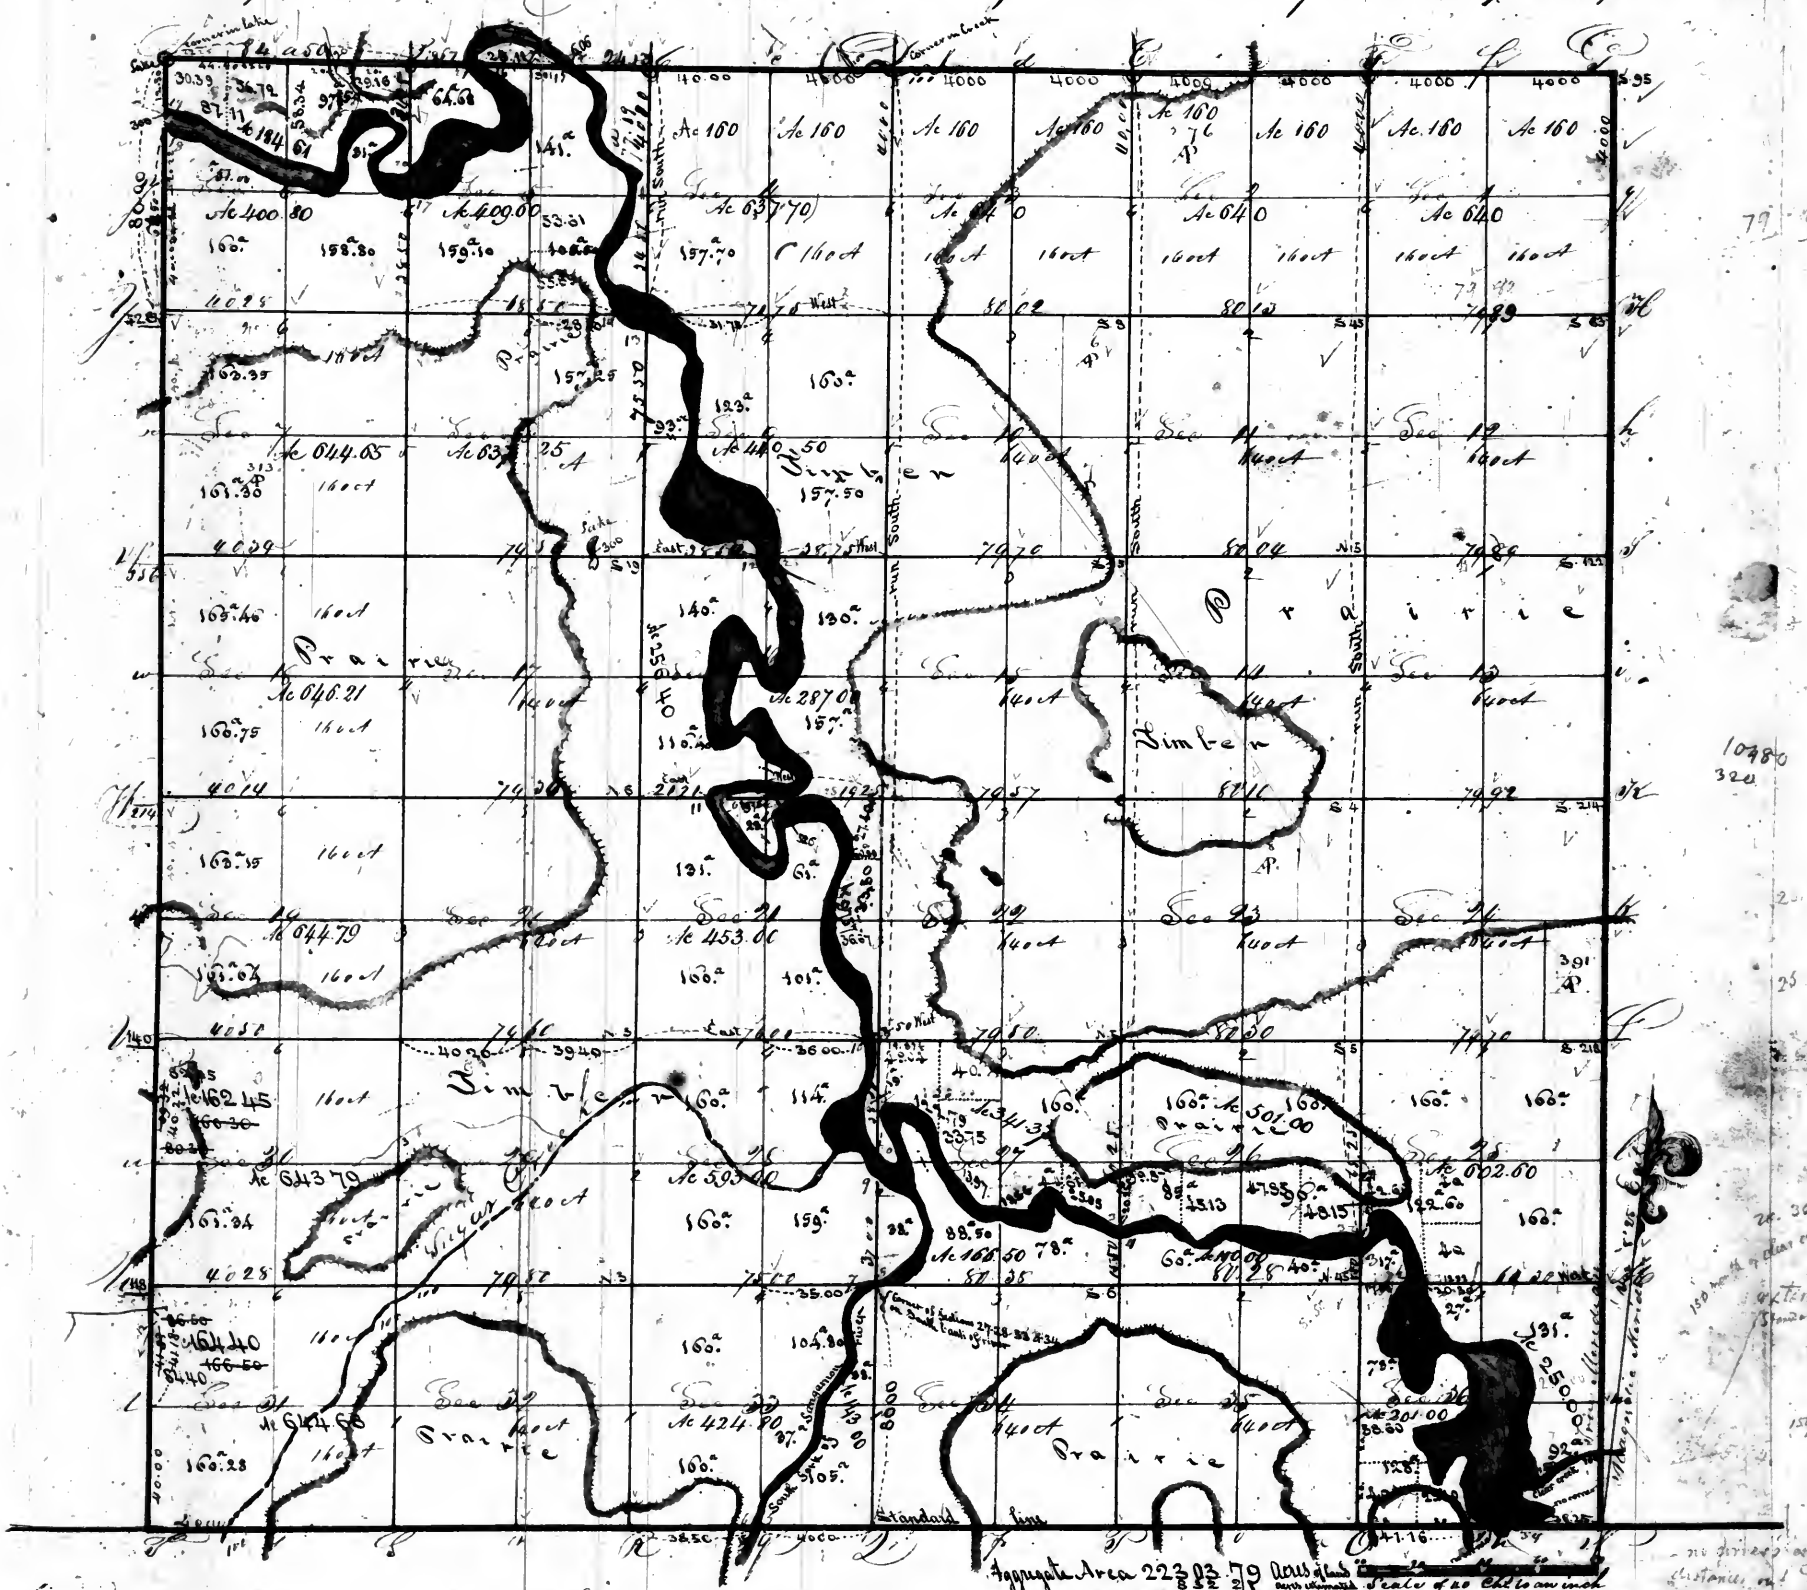

Pursuant to a contract with and instructions from William Hector Surveyor of the lands of the United States in the States of Illinois and Missouri and Territory of Arkansas bearing date the fifth day of April 1821 I have admeasured laid out and surveyed the above described Township and do hereby certify that it had such marks and bounds both natural and artificial as are represented on said plat and described in the field notes made thereof and returned with this plat into the Office of the Surveyor of the lands of the United States for the States of Illinois and Missouri and Territory of Arkansas
 Certified this Twentieth day of December 1821

August 24th 1835 the North part of the N.W. & N.E. q^{rs} of Sec. 6; the West part of the S.E. q^{rs} of Sec. 5;— Of that part of Sec 24, the N.W. S.W. & S.E. q^{rs} of Sec. 26; the S.W. & S.E. q^{rs} of Sec 26 & the S.W. q^{rs} of Sec. 25 which lies on the right or N.E. side of the Sanjames River and the S.W. q^{rs} of Sec 36 have this day been subdivided and put down on this plat & one copy sent to the Gen. Land Office & one to the Reg^y.

A. V. Langham J. Surryon


Survivors. Office. Sam. Louis 28th of January 1841. The above plat of township 16 north of the base line, range 4 west of the 3rd principal meridian, is strictly conformable to the field notes of the survey thereof on file in this office, which have been examined and approved - The south boundary was surveyed in March 1821, by A. L. Langham, under contract of the 2nd of February of that year - The north boundary - the east boundary were surveyed in April 1821 by A. L. Langham - and the subdivision lines and the meanders of both banks of Sangamon river, ^{and of the South fork thereof} were surveyed in June 1821, by S. J. Gill and A. L. Langham, under the contract of the said Langham of the 5th of April of the same year.

Surveyor of the public lands in
the State of Illinois and Missouri.

Recorded

Township N. 17 North of the Base Line, Range N. 6 West of the 5th Principal Meridian

Page 116 vol 13

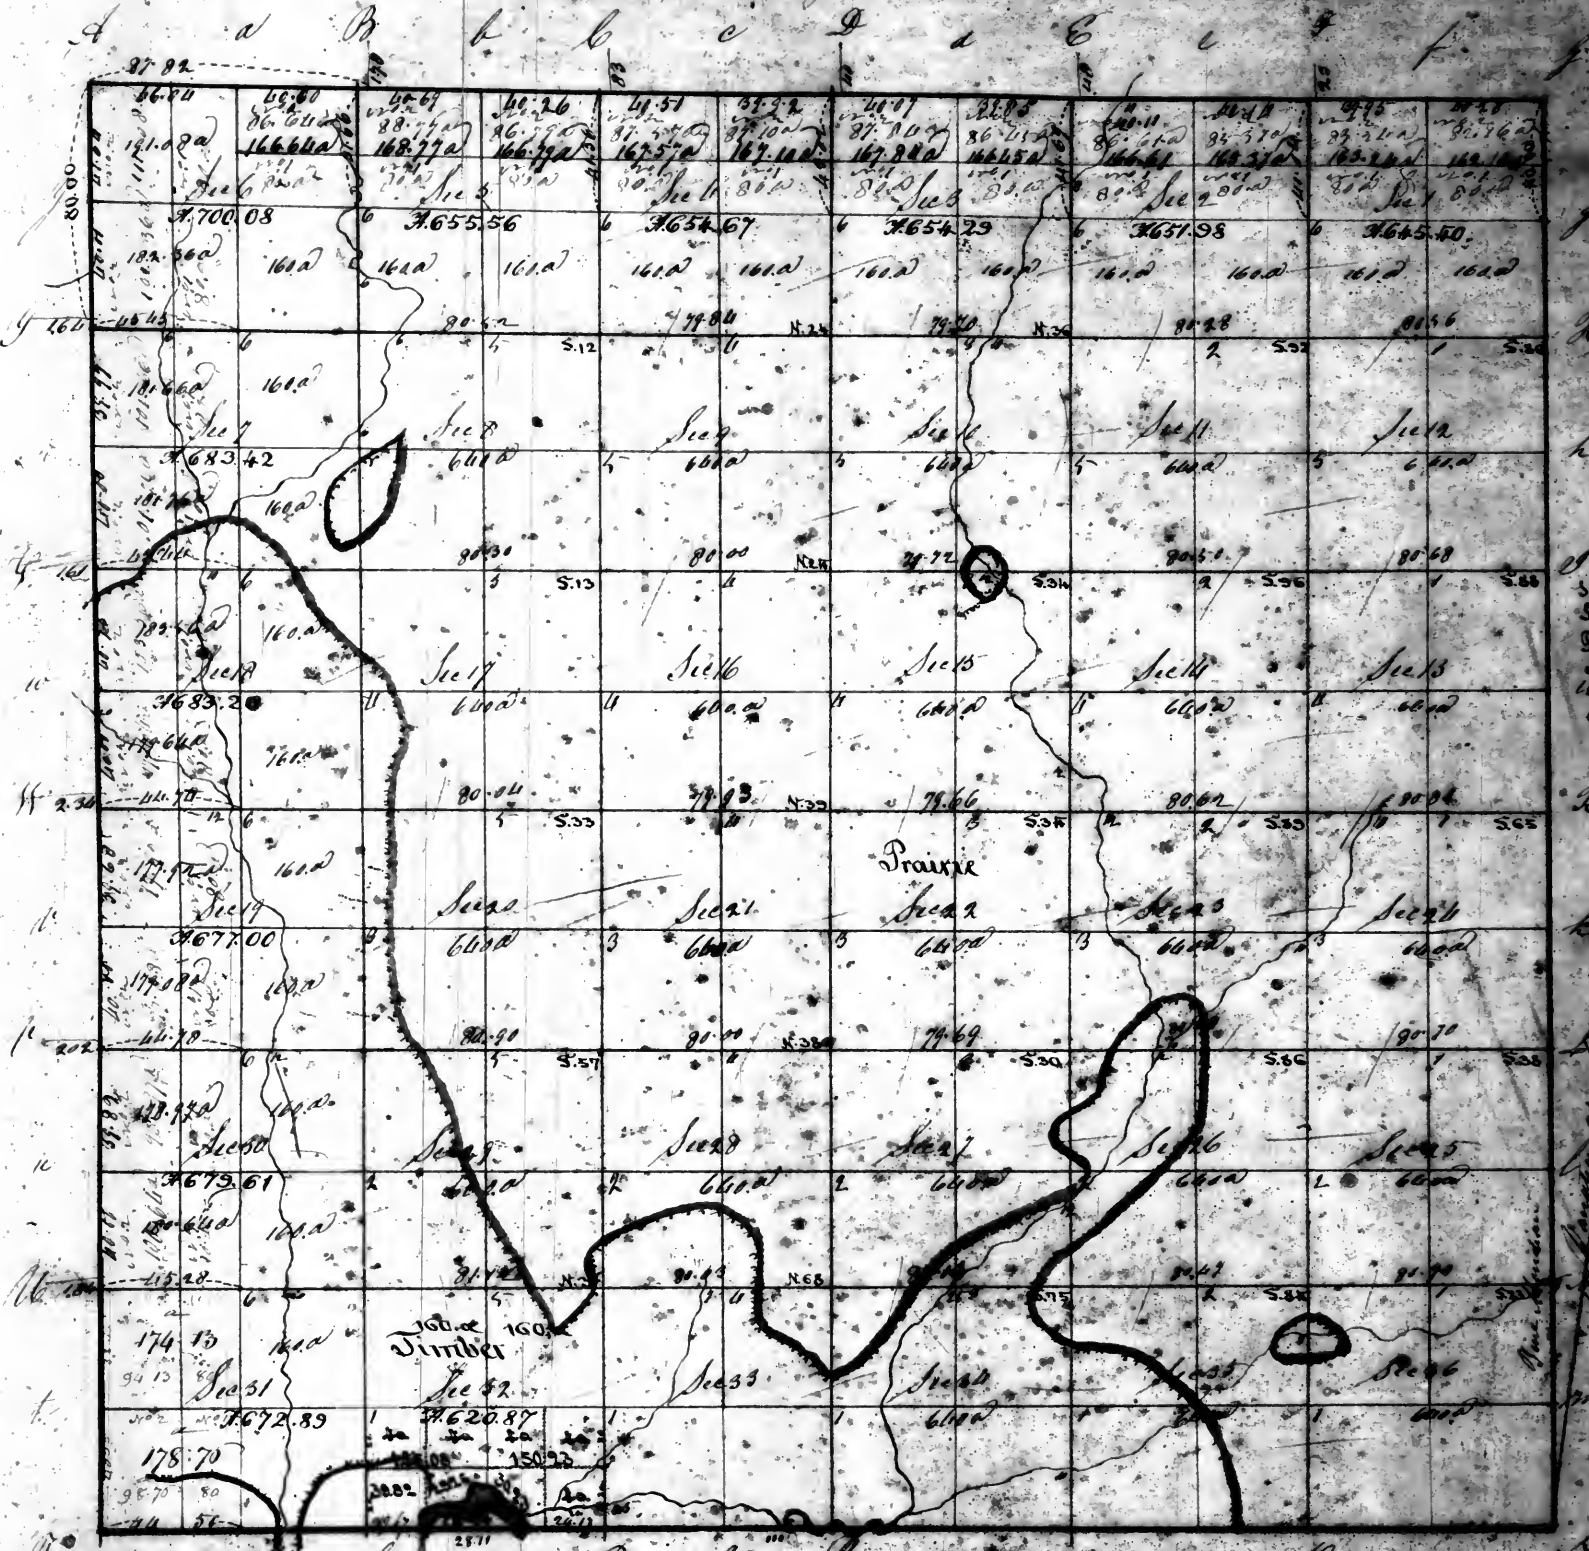

Surveyor's Office
St. Louis Mo. Aug. 1855
Plot of the South half
of Sec. 32 and this day
to the Comptroller of the
Land O. O.

August 31. 1855 The S.E. & S.W. 1/4 of Sec 32 have this day been subdivided & put down on
this plat of one copy sent to the Gen. Land Office & one to the Register.

Aggregate area = 2334.65 acres


Pursuant to a contract with and instructions from William Rector, Surveyor of the lands of the United States in the State of Illinois, Missouri and Territory of Arkansas, bearing date the 1st day of January 1855, I have measured, laid out and surveyed the above described Township and do hereby certify that I had such marks and bounds both natural and artificial as are represented on said plat and described in the field notes made thereof and returned with this plat into the Office of the Surveyor of the lands of the United States for the State of Illinois, Missouri and Territory of Arkansas.

A a B b c D d E e F f G

[illegible]



Page 48 of 13
Township No 19 North of the Base line. Range No 1 West of the 3rd Principal Meridian.

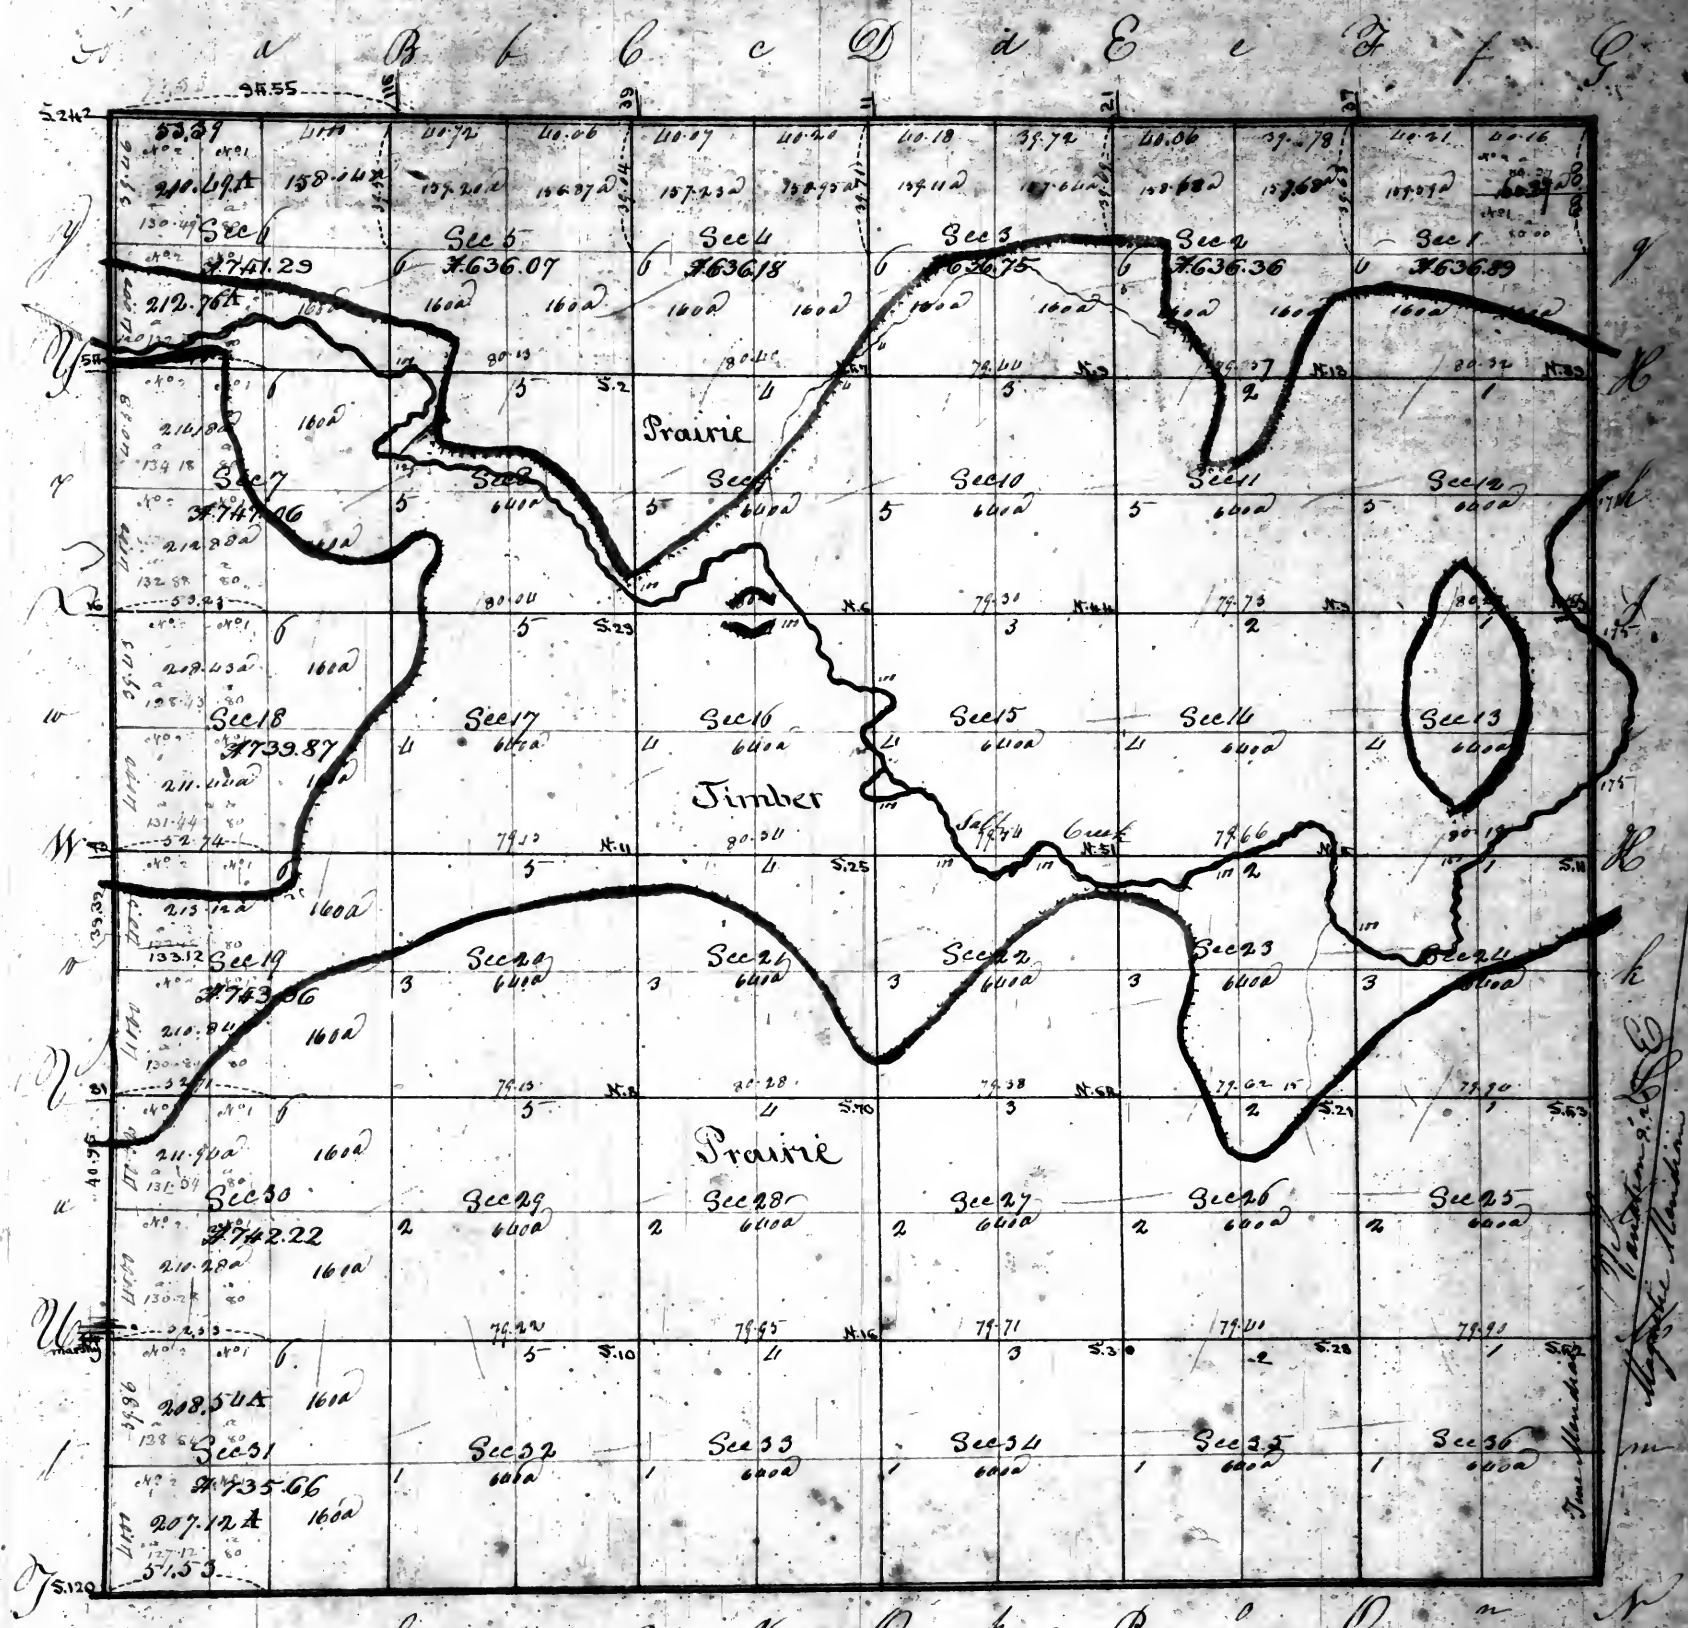

Aggregate area - 2363.528 acres

Pursuant to a contract with and instructions from William Reiter Surveyor of the lands of the United States in the States of Illinois, Missouri and Territory of Arkansas, bearing date the 15th of February 1824, I have admeasured laid out and surveyed the above described Township, and do hereby certify that it had such marks and bounds both natural and artificial as are represented on said plat and described in the field notes made thereof and returned with this plat into the Office of the Surveyor of the lands of the United States in the States of Illinois, Missouri and Territory of Arkansas.

J. S. Richards
Agent for the Surveyor


Recorded

51

Dec 4 1823

843

Township N^o 20 North of the base line, Range N^o 1 West of the 3^d Principal Meridian

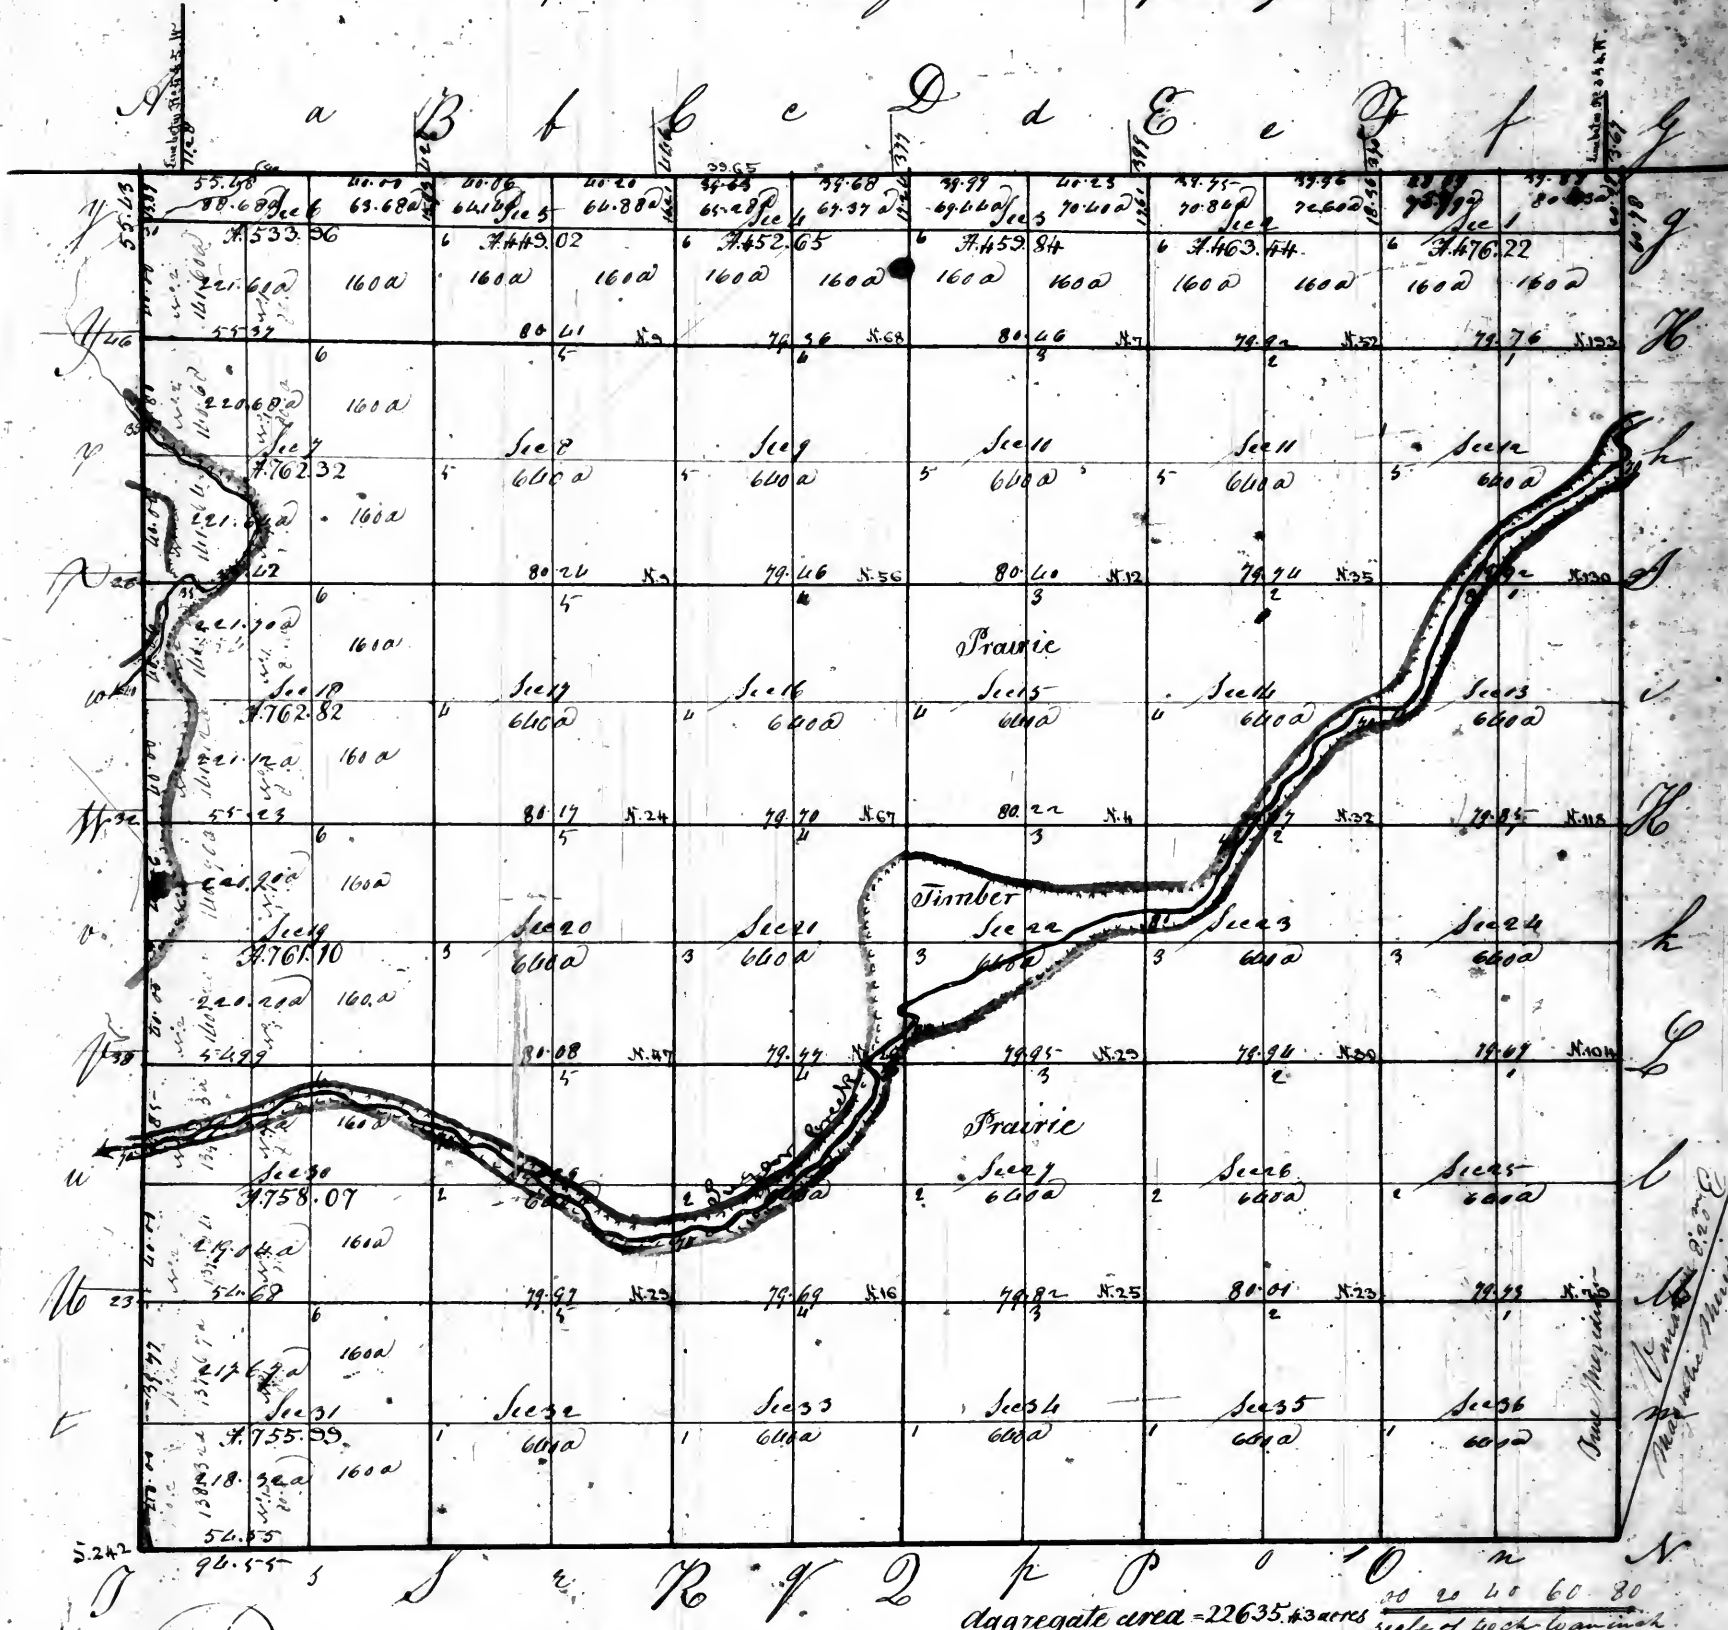

aggregate area - 22635.43 acres scale of 1 inch to 40 rods


In pursuance to a contract with and instructions from William Reiter Surveyor of the lands of the United States in the State of Illinois, Missouri and Territory of Arkansas bearing date the 19th Oct 1823. I have admeasured laid out and surveyed the above described Township, and do hereby certify that it had such marks and bounds both natural and artificial as are represented on said plat and described in the field note made thereof and returned with this plat into the office of the surveyor of the lands of the United States for the State of Illinois, Missouri and Territory of Arkansas.

Catipex 12th April 1823

J. C. Richards
J. P. R. Miller

Wm. Munroe D. SURVEYOR.
Stephen Baxter

Page 51 of 13

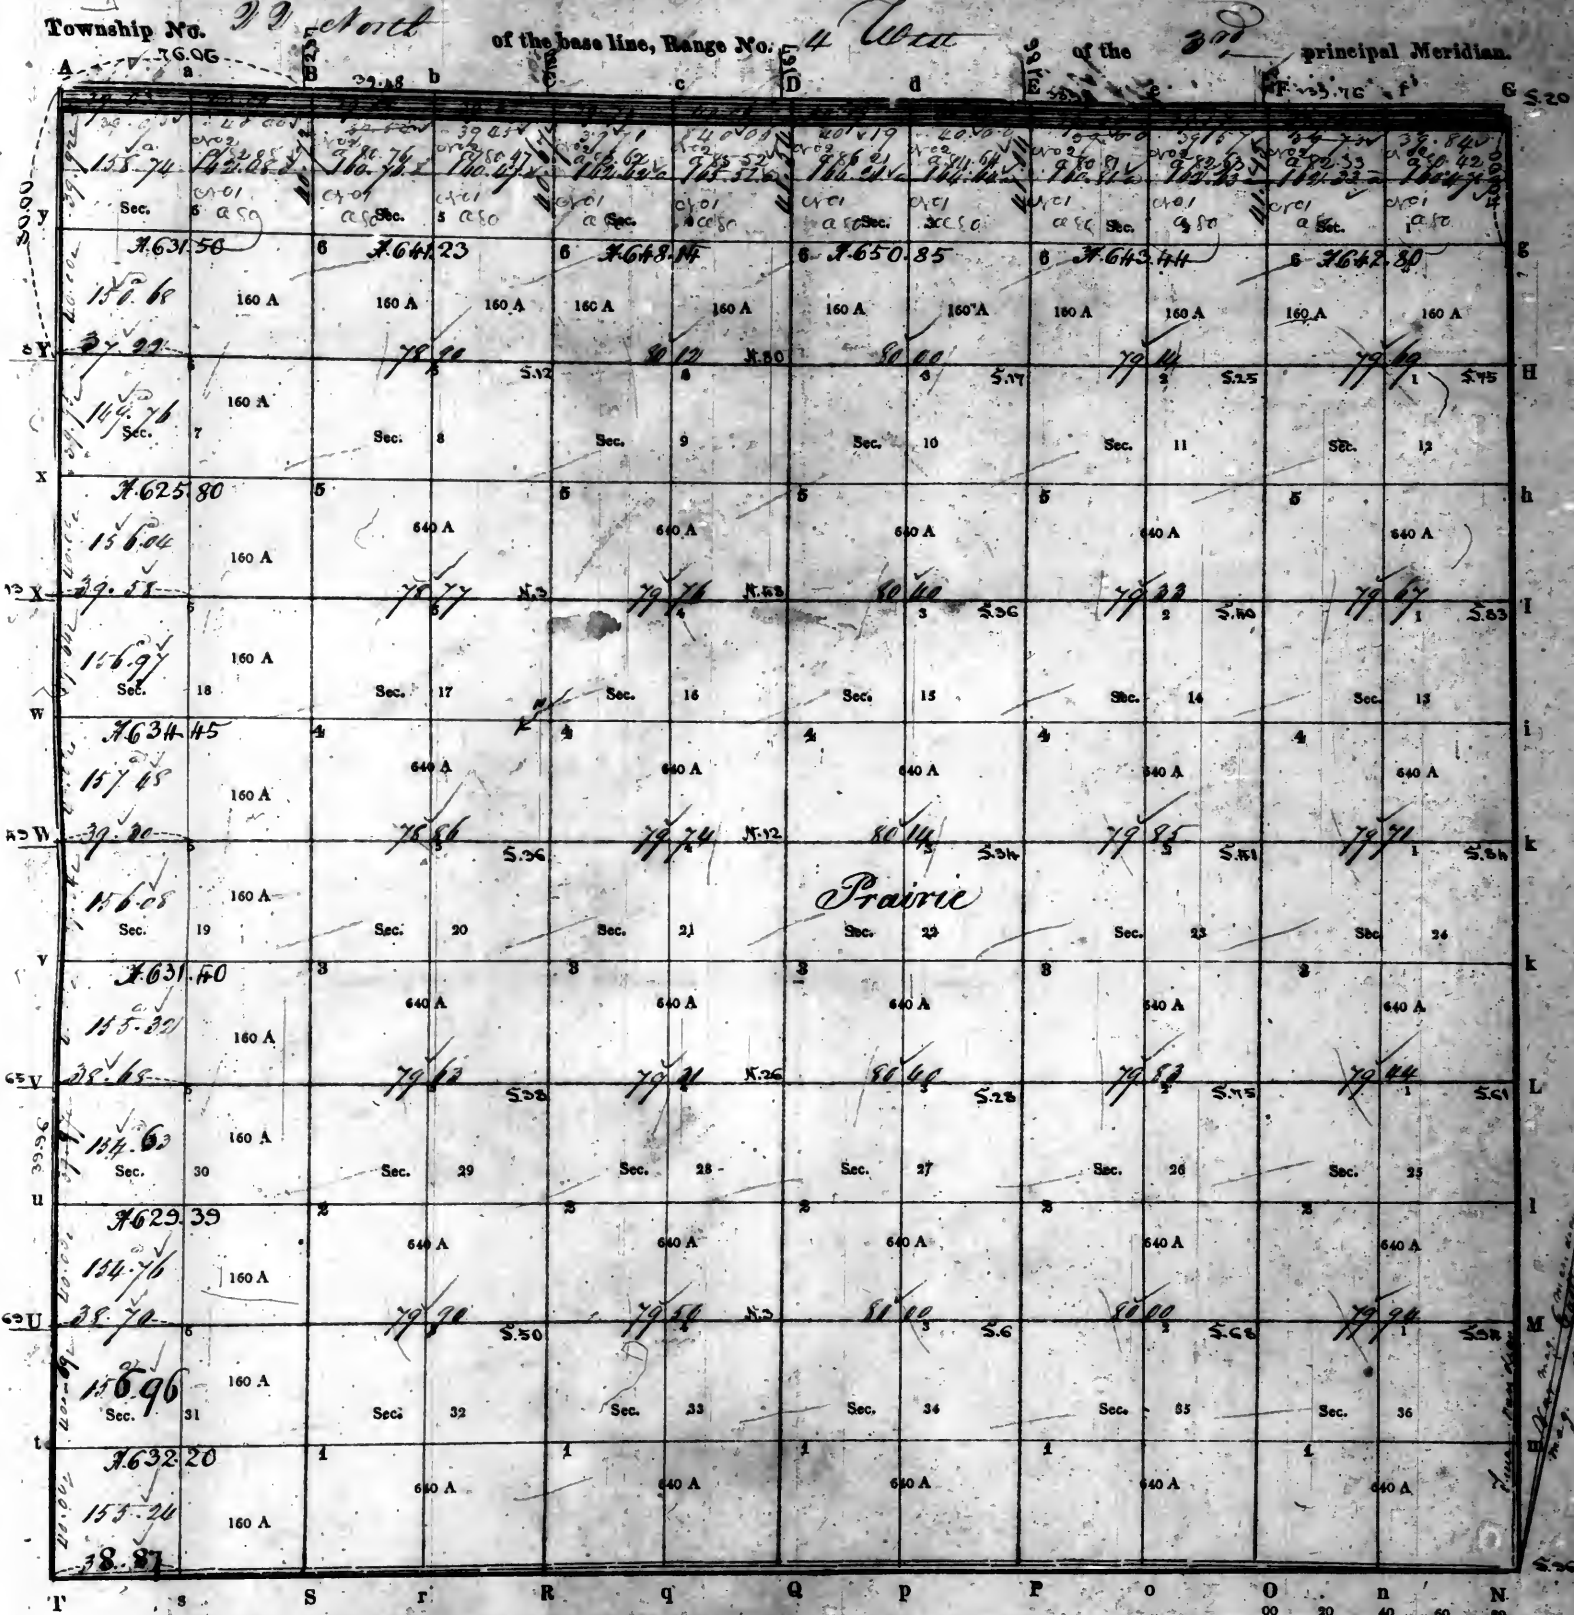


PURSUANT to a contract with, and instructions from William Rector, Surveyor of the lands of the United States in the State of Illinois, and Secretary of Arkansas, bearing date the *1st* day of *February* 1883, I have admeasured, laid out and surveyed the above described Township; and do hereby certify, that it had such marks and bounds, both natural and artificial, as are represented on said plat, and described in the field notes, made thereof, and returned with this plat into the Office of the Surveyor of the Lands of the United States, in the State of Illinois and Secretary of Arkansas.

Certified this *18th* day of *February* 1883

EXAMINED.

William Rector
Surveyor

Stephen Rector
D. SURVEYOR

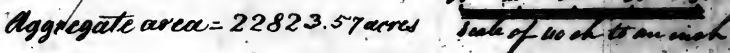

Pursuant to a contract with and instructions from William Rector Surveyor of the lands of the United States in the State of Illinois, Missouri and Territory of Arkansas bearing date the first Day of August 1835 We have admeasured laid out and Surveyed the above described Township and do hereby certify that it had such marks and bounds both natural and artificial as are represented on said plat and described in the field notes made thereof and returned with this plat into the Office of the Surveyor of the lands of the United States for the State of Illinois Missouri and Territory of Arkansas

Wm. Rector
Surveyor


Scale of 40 Chains to an Inch.

Stephen J. Foster

Township N 26 North of the Base line in Range R 10 West of 3rd Meridian

Page 54 of 13

Sec 31
Sec 32
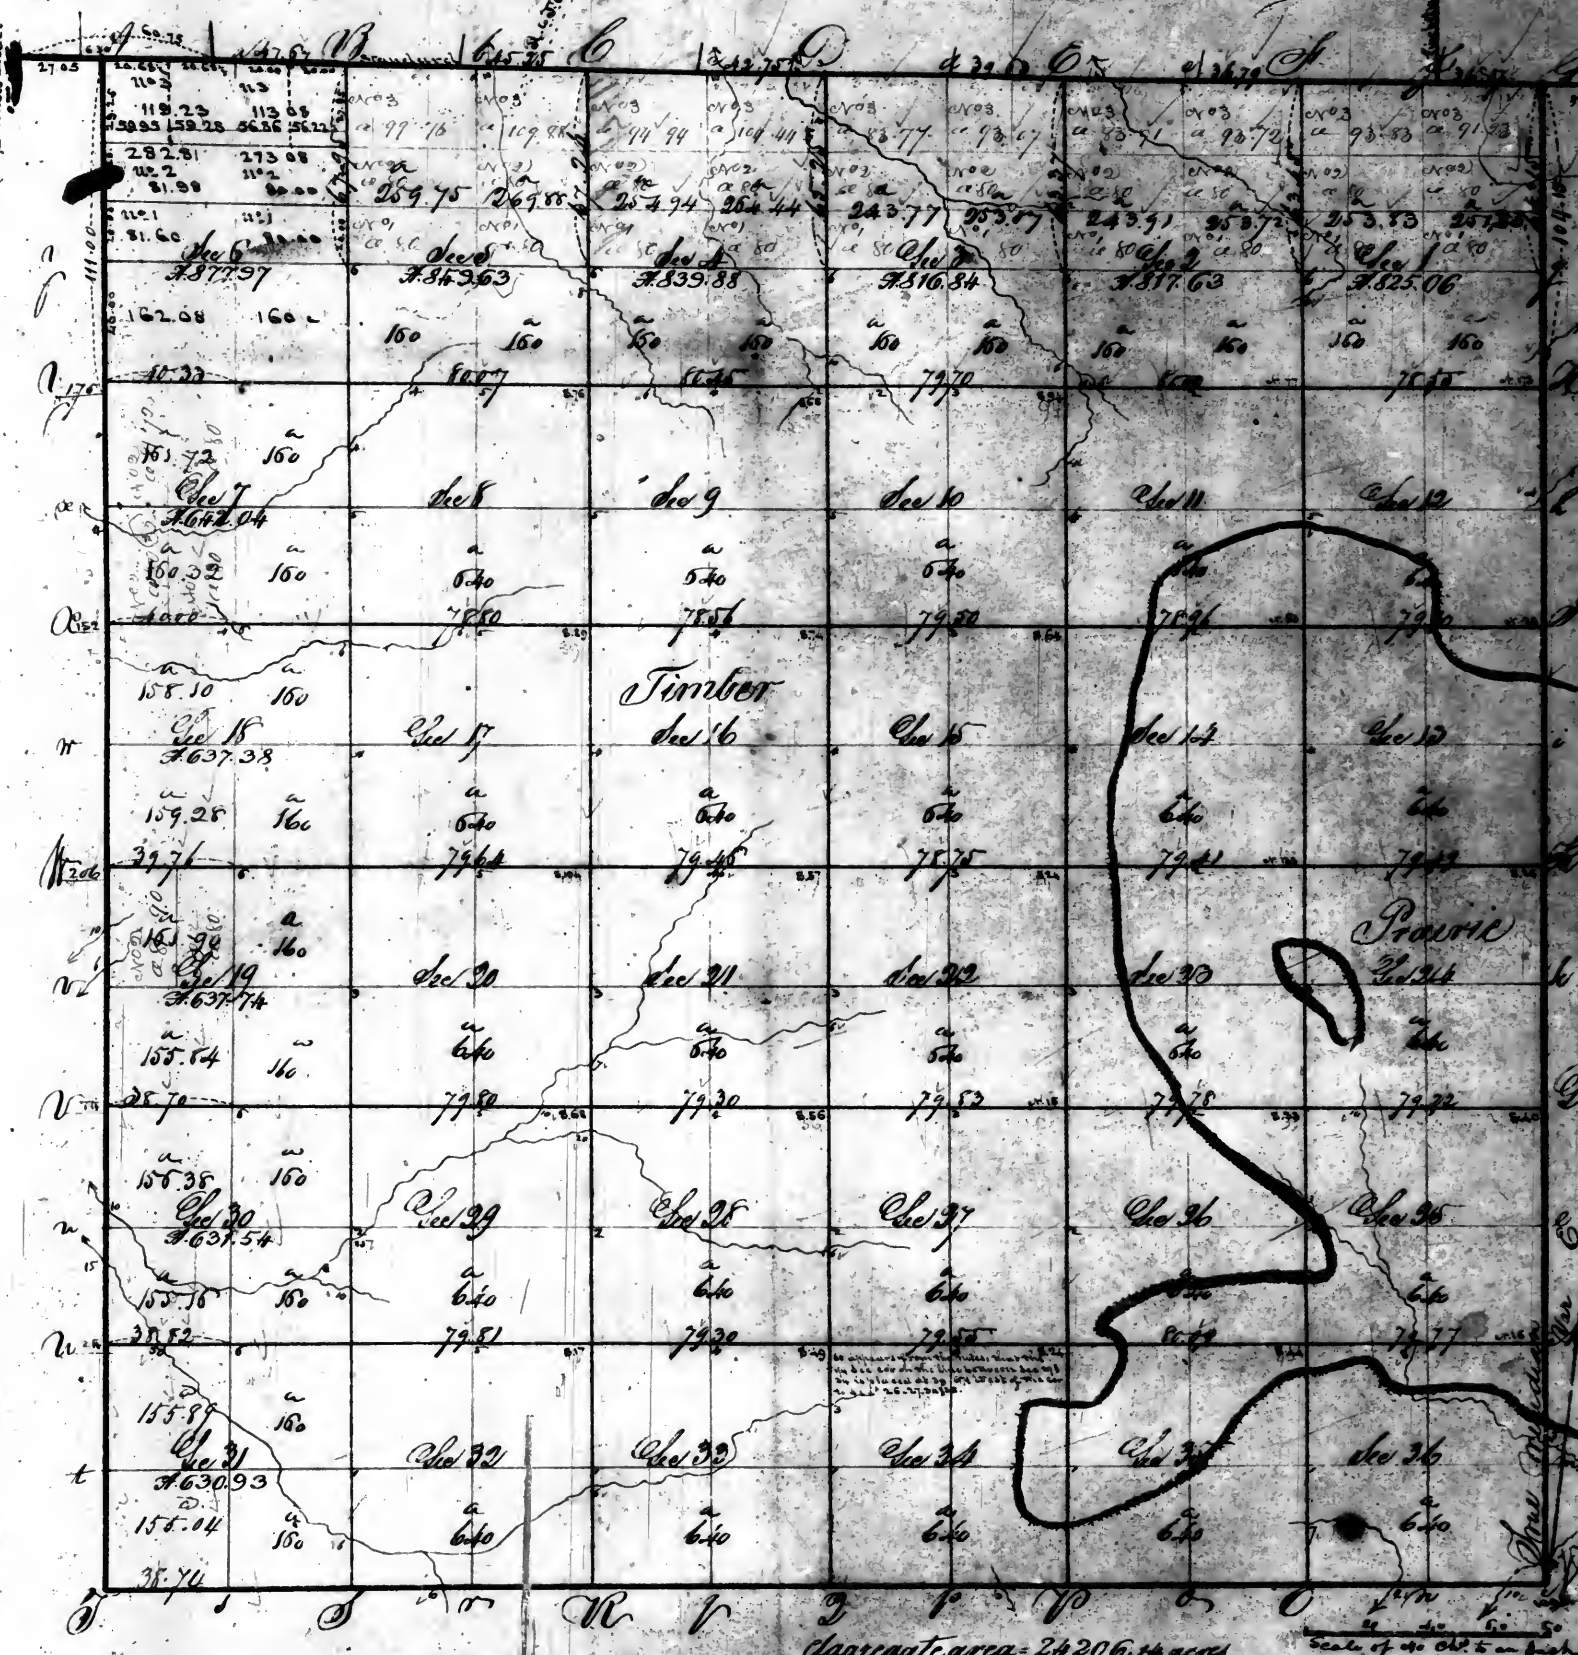

Surveyor's Office
St Louis 14 August
1895
In consequence of
the urgent demand
for a plat of section
36 of this township, which
is dependent for the
determination of its
area upon the intersection
of the East boundary
of section 1, T26N
R10W; and it being
uncertain from what
source the original note relating
thereto, and from the
concurrent evidence
of the adjoining survey
that the said East
boundary of section 1
intersects the standard
line 6.30 chains East
of the 1/4 section corner
on the South boundary
of section 31, T26N
R10W, that has been
taken as the true
intersection, and the
plat of section 36 has
been constructed and
its area calculated
accordingly, a
copy sent to the
land owner to the
land office.


Aggregate area - 24206.14 acres
Scale of 40 Ch. to an inch

Pursuant to a contract with and instructions from William Rector, Surveyor of the Lands of the United States in the States of Illinois and Missouri and the Territory of Arkansas, bearing date the day of
We have admirably laid out and surveyed the above described Township and its lands, certify that it had such map and bounds both natural and artificial as are represented on said plat and described in the field notes made thereof and returned with this plat into the Office of the Surveyor of the Lands of the United States in the States of Illinois and Missouri and the Territory of Arkansas.
Certified this day of 1894
Examined
J. H. McQuay, D. Surveyor
Stephen Rector, J. Surveyor

Recorded

Fractional Township N. 26 North of the Base line of Range 10 East of the 3rd Principal Meridian

T. 3. N. 26. 8 E. of the 4th pr. Mer.

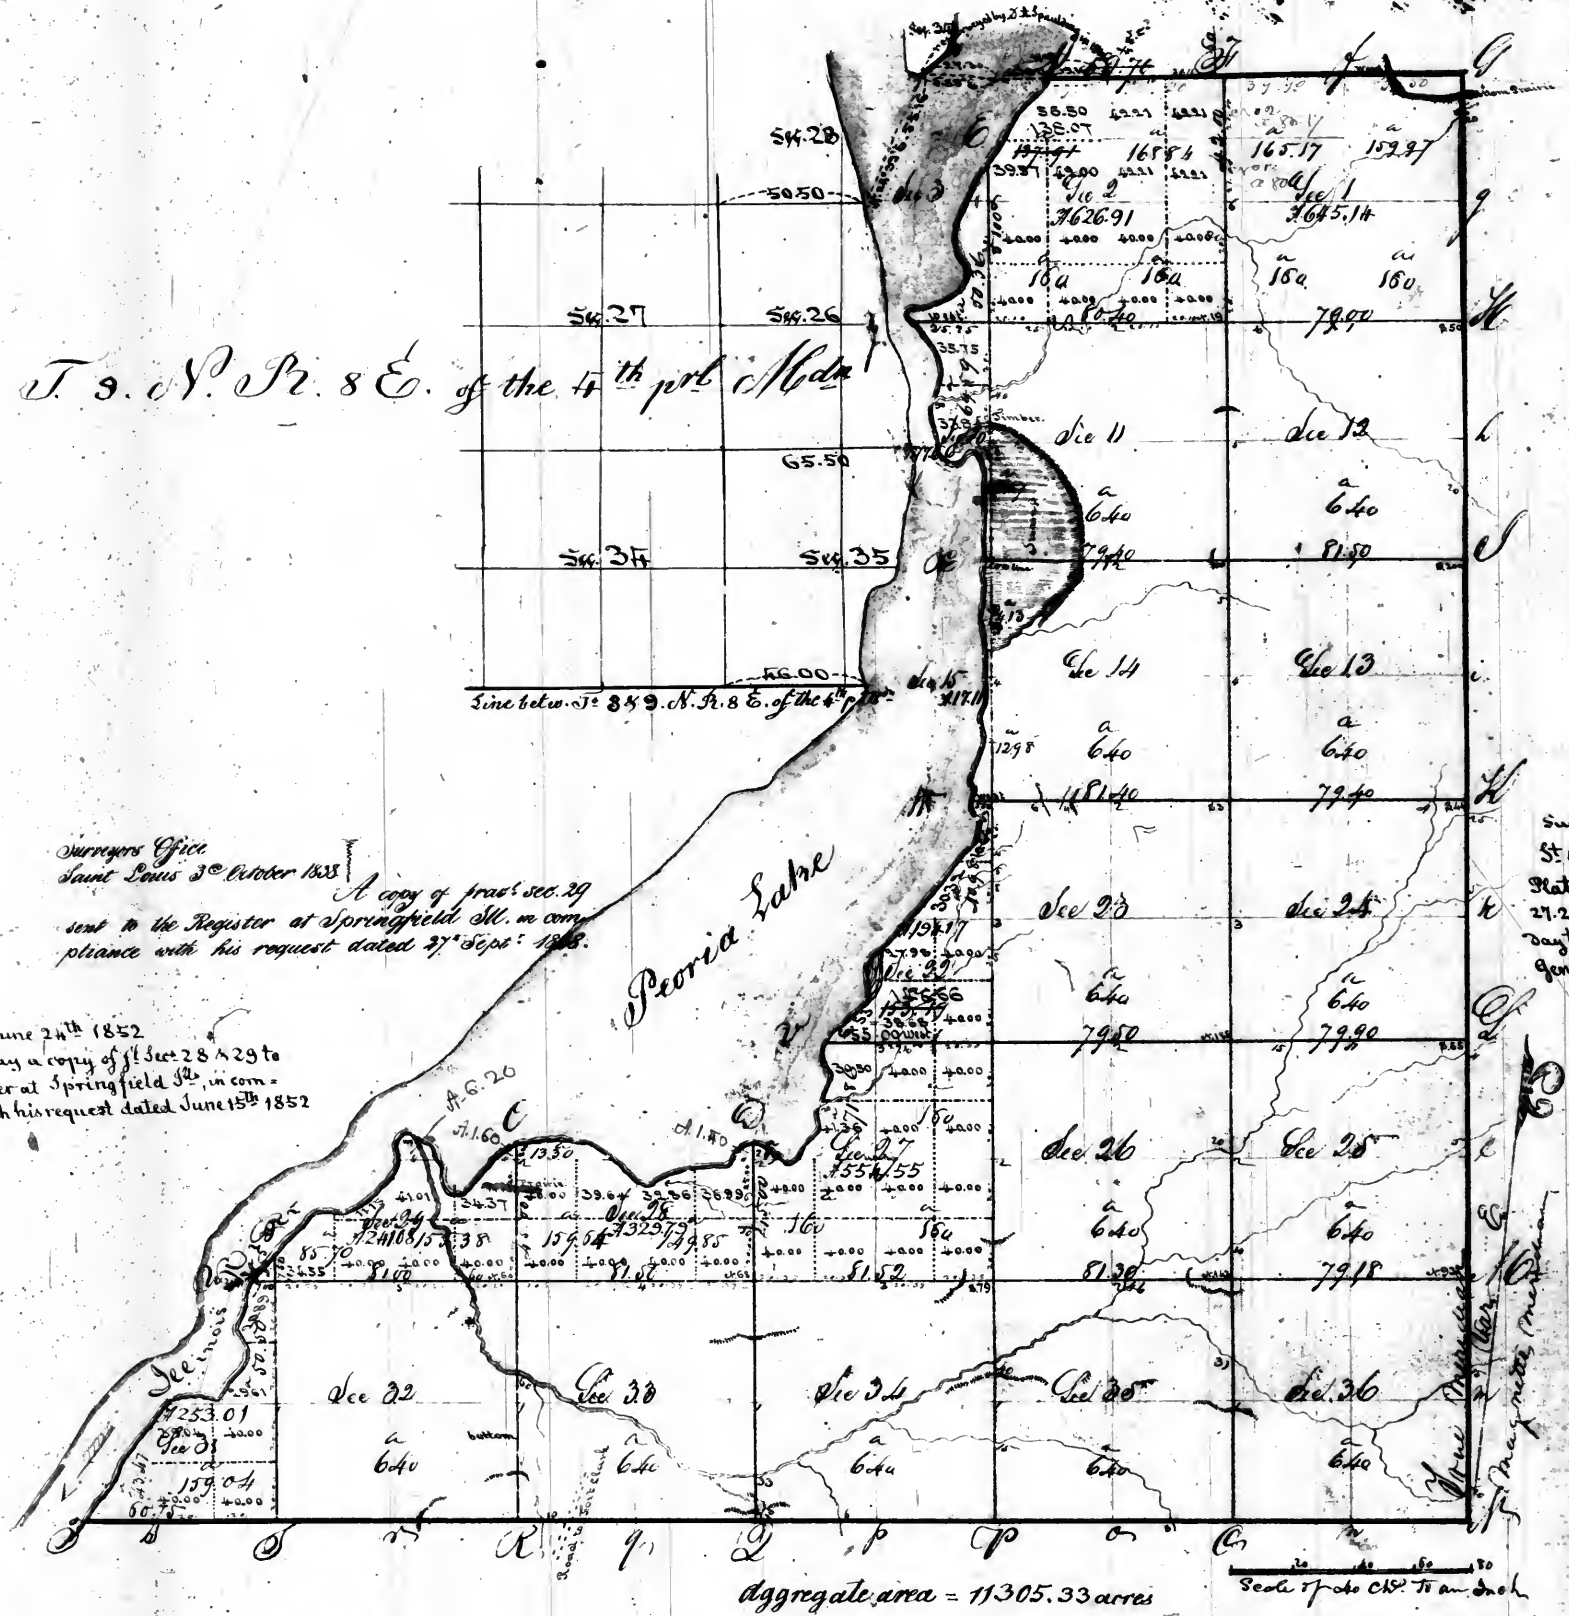

Surveyors Office
Saint Louis 3rd October 1852
A copy of tract sec. 29
sent to the Register at Springfield Ill. in com-
pliance with his request dated 27th Sept. 1852.

St. Louis, June 24th 1852
Sent this day a copy of 1st Sect 28 & 29 to
the Register at Springfield Ill. in com-
pliance with his request dated June 15th 1852

Surveyor's Office
St. Louis, Mo. May 18th 1852.
Plat of 1st Sect 2, 3, 10, 22,
27, 28, 29, 30 & 31, sent this
day to the Commr of the
genl. L.O.

Whereas a contract with and instructions from William Richter Surveyor of the Lands of the United States, in
the States of Illinois and Missouri and the Territory of Arkansas bearing date the _____ day of _____
We have admeasured, laid out and surveyed the above described Fractional Township and do hereby certify
that it had such marks and bounds both natural and artificial as are represented on said plat and described
in the field notes made therefor, and returned with this plat into the Office of the Surveyor of the Lands of
the United States in the States of Illinois and Missouri and the Territory of Arkansas,
Certified True _____ day of _____ 1854
Surveyor


Examined

Stephen R. R. J. R. R.

Recorded

Tract Township 18 N. 2 E. 38 E. 1st of the baseline Range 5 W. 1st of the 3rd P.M.

27-56-12

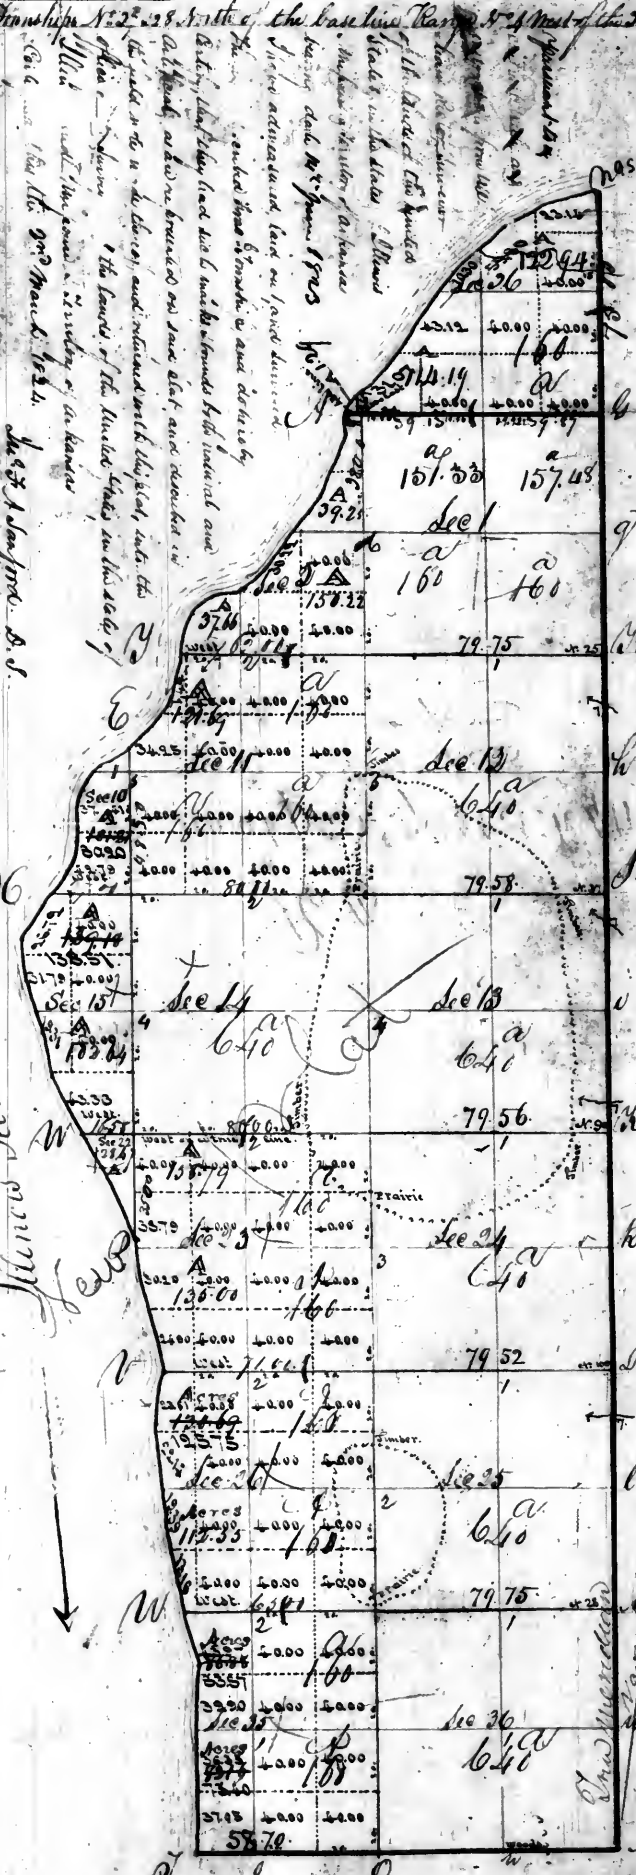

122 94
114 19
161 29
398 42
10 30
408 72
7 43

Surveyor's Office
St. Louis 10th August 1842.
Sect of each Sect 25 & 36 in fil Town
ship 28 N. 2 E. 38 E. of the 3rd P.M.
and of each Sect 2, 10, 11, 15, 21, 23, 26
& 35 in fil T. 27 N. 2 E. 38 E. of the 3rd P.M.
sent this day to the Commfr. of the Genl L.

Scale of 40 chs to an inch

Recorded






